
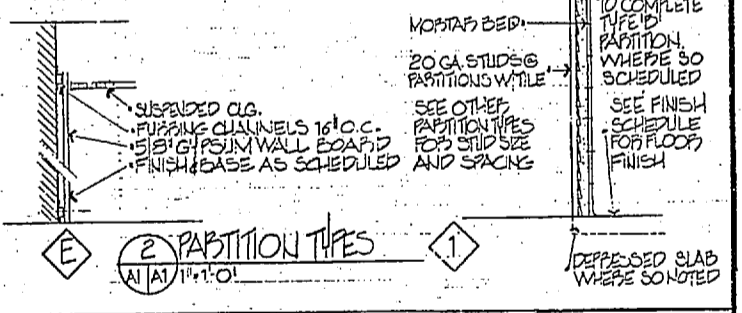
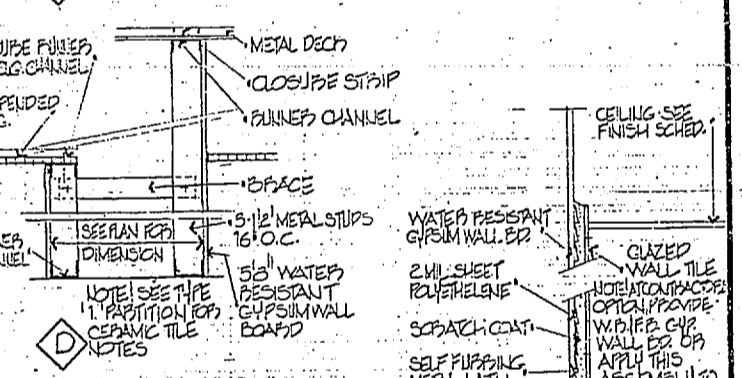
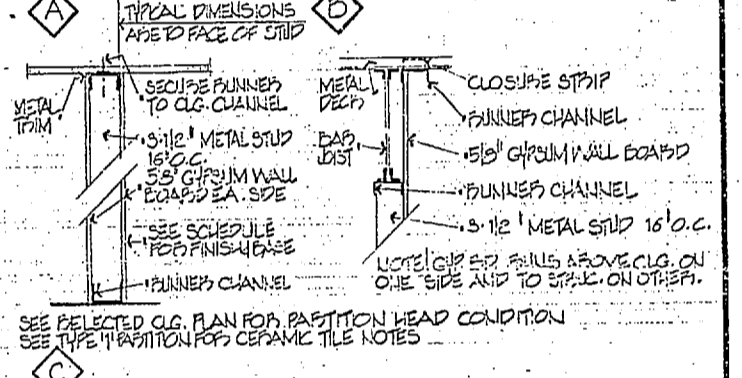


REVISIONS			
NO.	DESCRIPTION	DATE	APPROVED
1	REVISED AS-BUILT	6-8	7-13-83 G.E.

- PARTITION SCHEDULE**
- 1. 2" CMU, 2" HP FACE, 2" VERTICALLY REINFORCED 1/2" O.C. WITH 4" BRICK FULL VOIDS W/ GROUT
 - 2. 2" x 8" CA. METAL STUDS 16" O.C. 2 LAYERS 5/8" PIPE COUPLER WALL BOARD EACH SIDE (USE 20GA STUPL AT ROOM 115)
 - 3. 1/2" x 1/2" x 5/8" METAL STUDS 16" O.C. 1 LAYER 5/8" PIPE COUPLER WALL BOARD EACH SIDE
 - 4. GYPSUM WALL BOARD 5/8" CA. METAL STUDS 16" O.C. 2 LAYERS 5/8" PIPE COUPLER WALL BOARD EACH SIDE
 - 5. 1/2" x 1/2" x 5/8" METAL STUDS 16" O.C. 2 LAYERS 5/8" PIPE COUPLER WALL BOARD EACH SIDE

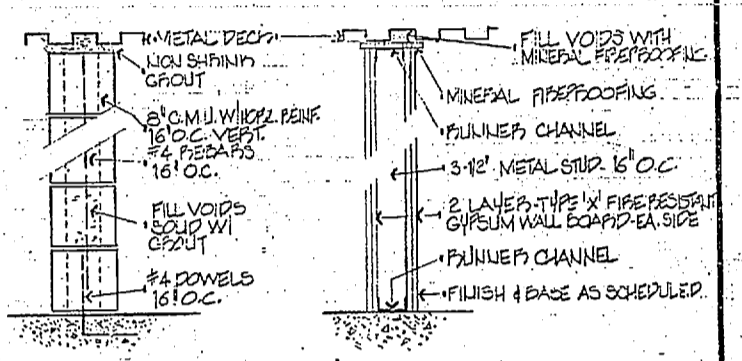

RECORD DRAWING
LETTER DATED 08 JUL 1983

J. N. PEASE ASSOCIATES ARCHITECTS - ENGINEERS - PLANNERS CHARLOTTE, NORTH CAROLINA		DEPARTMENT OF THE NAVY NAVAL FACILITIES ENGINEERING COMMAND DIVISION ATLANTIC	
MR. A. J. JELAPPA, LEAD ARCHITECT MR. J. W. WALKER, ARCHITECT		MARINE CORPS EXCHANGE MARINE CORPS AIR STATION HELICOPTER NEW RIVER, JACKSONVILLE, NORTH CAROLINA	
FLOOR PLAN - PARTITION TYPES		SHEET NO. 80091 CONSTRUCTION NO. 16227-16-D-109 DATE 05-76-6109	

1 FLOOR PLAN FFE 25.0'
A1 1/8" = 1'-0"

