



REVISIONS			
SYM	DESCRIPTION	DATE	APPROVED
'A'	ALTRNS. TO PLMD IN CAFETERIA & COCKTAIL LOUNGE	3-26-73	C.D. SMITH
'D'	AS BUILT	11-9-73	EG JONES

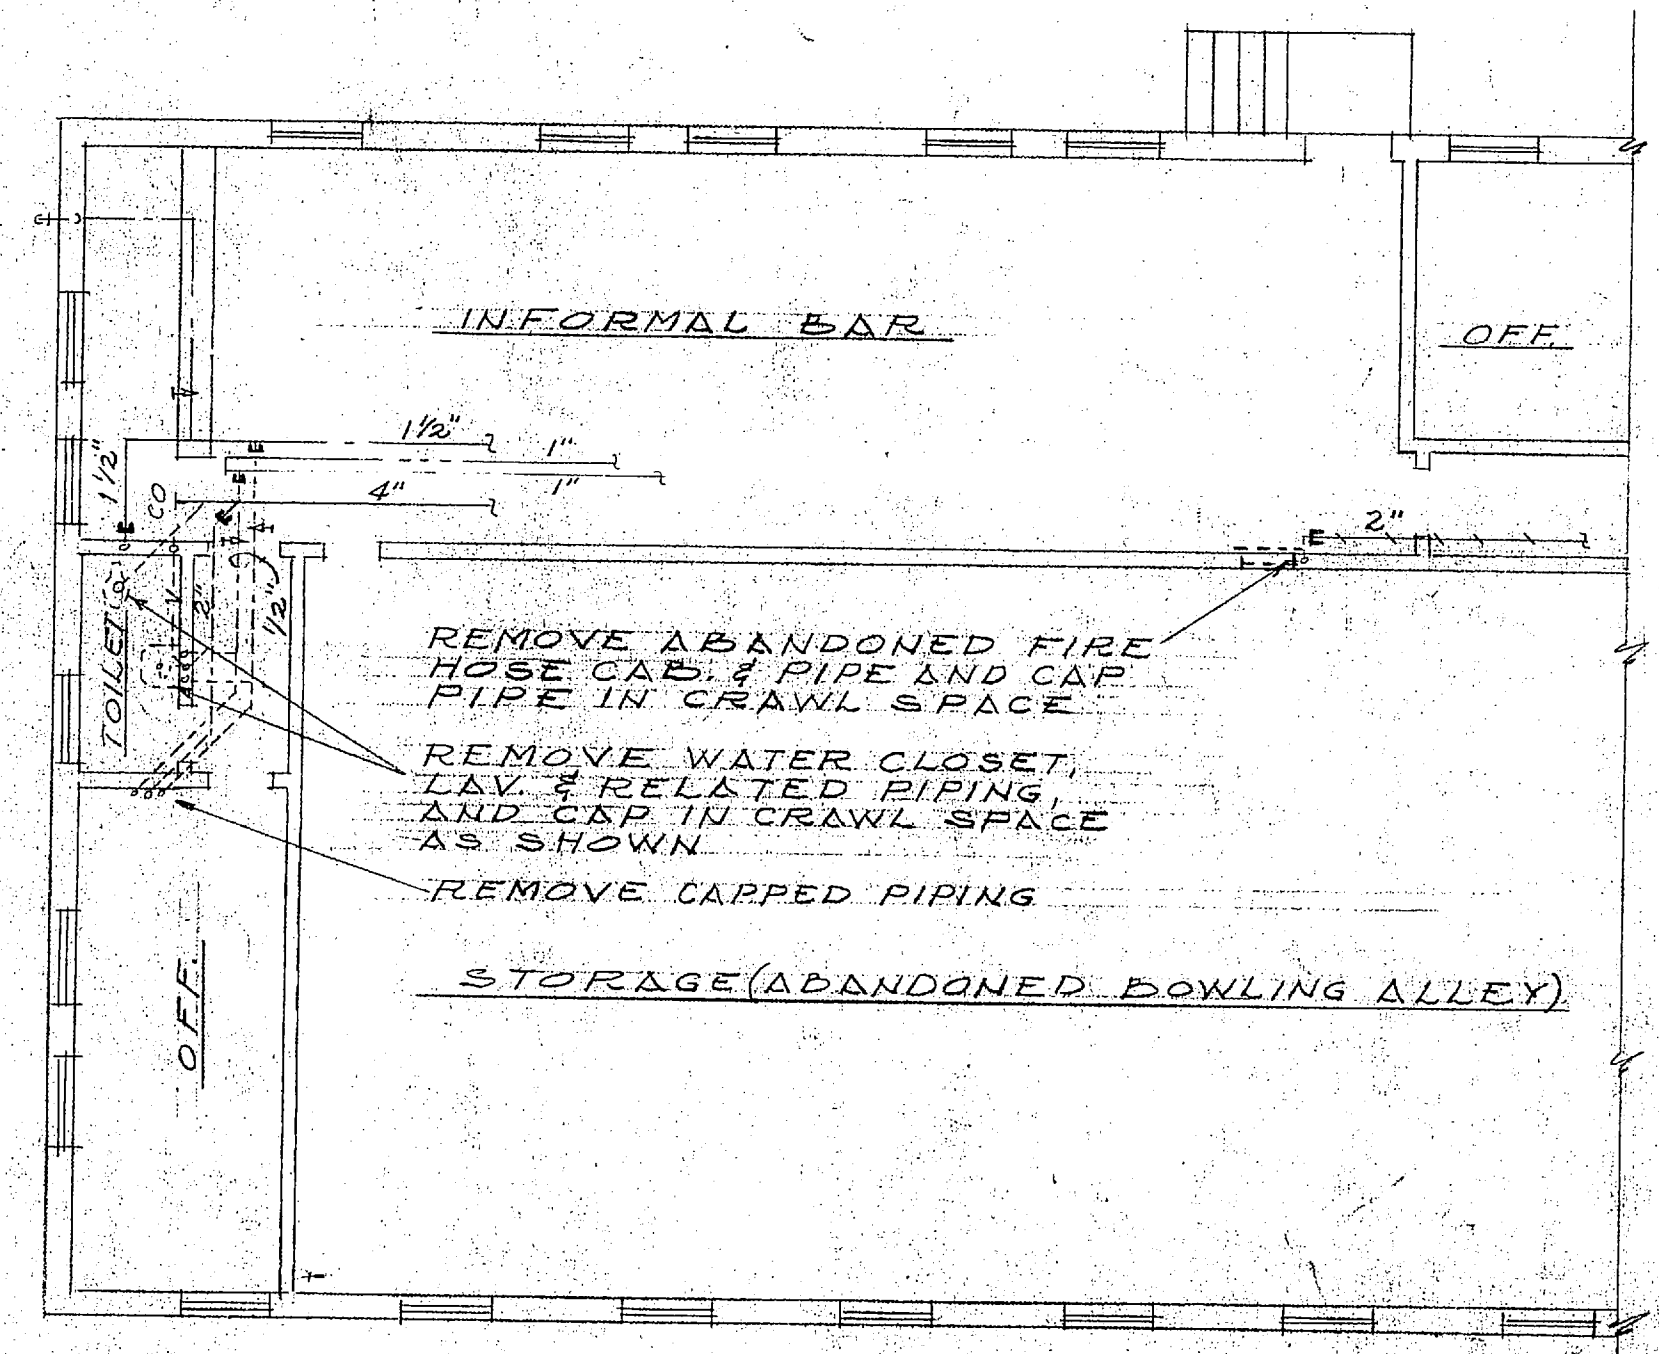


PART PLAN WEST WING DEMOLITION
SCALE: 1/8"=1'-0"

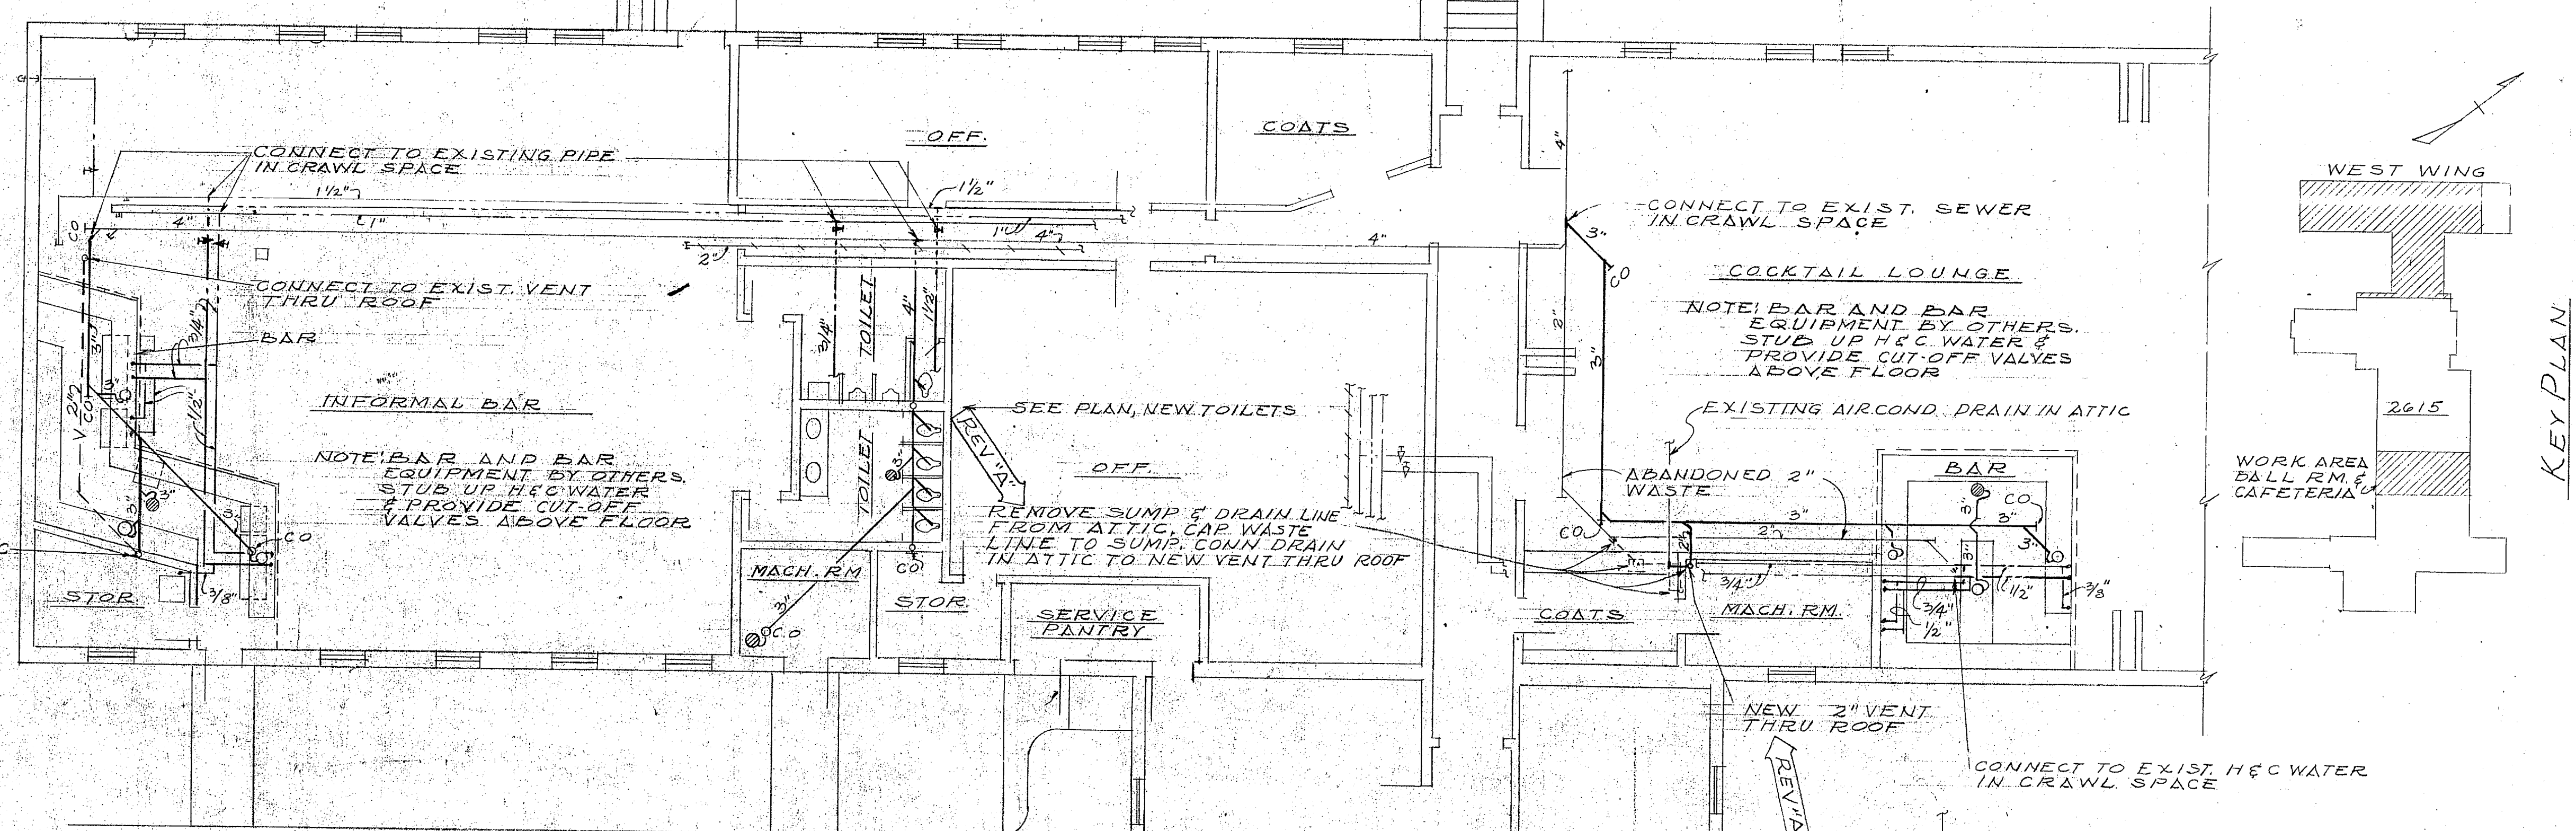


PART PLAN WEST WING & CONNECTING WING
SCALE: 1/8"=1'-0"


SCHEMATIC ALTERATIONS TO WASTE & VENT PIPING
NO SCALE

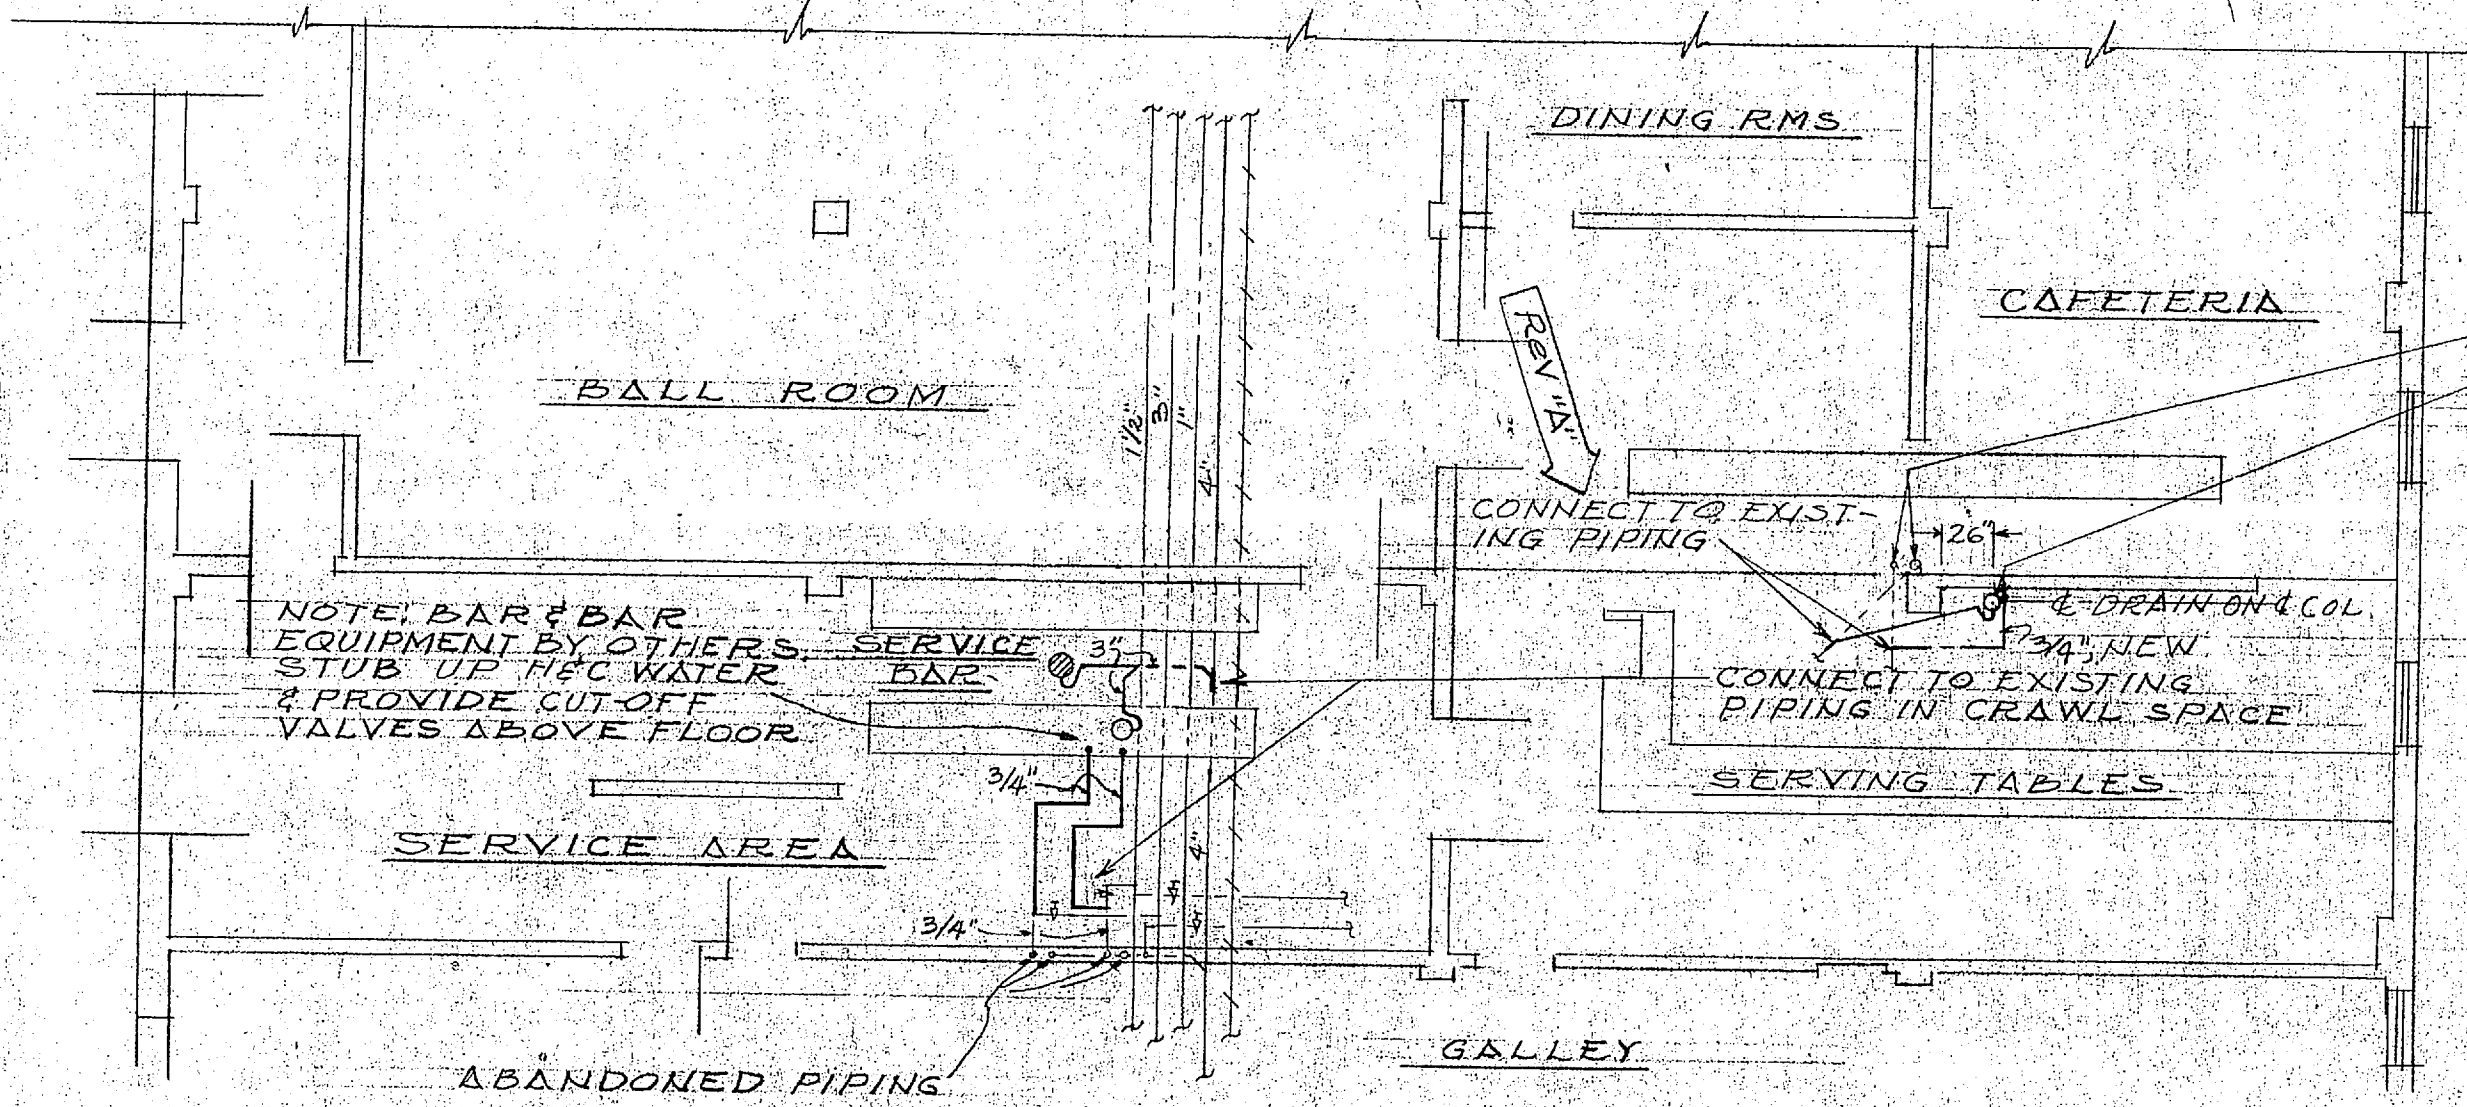

PART PLAN BALL ROOM & CAFETERIA (SERVICE BAR)
SCALE: 1/8"=1'-0"

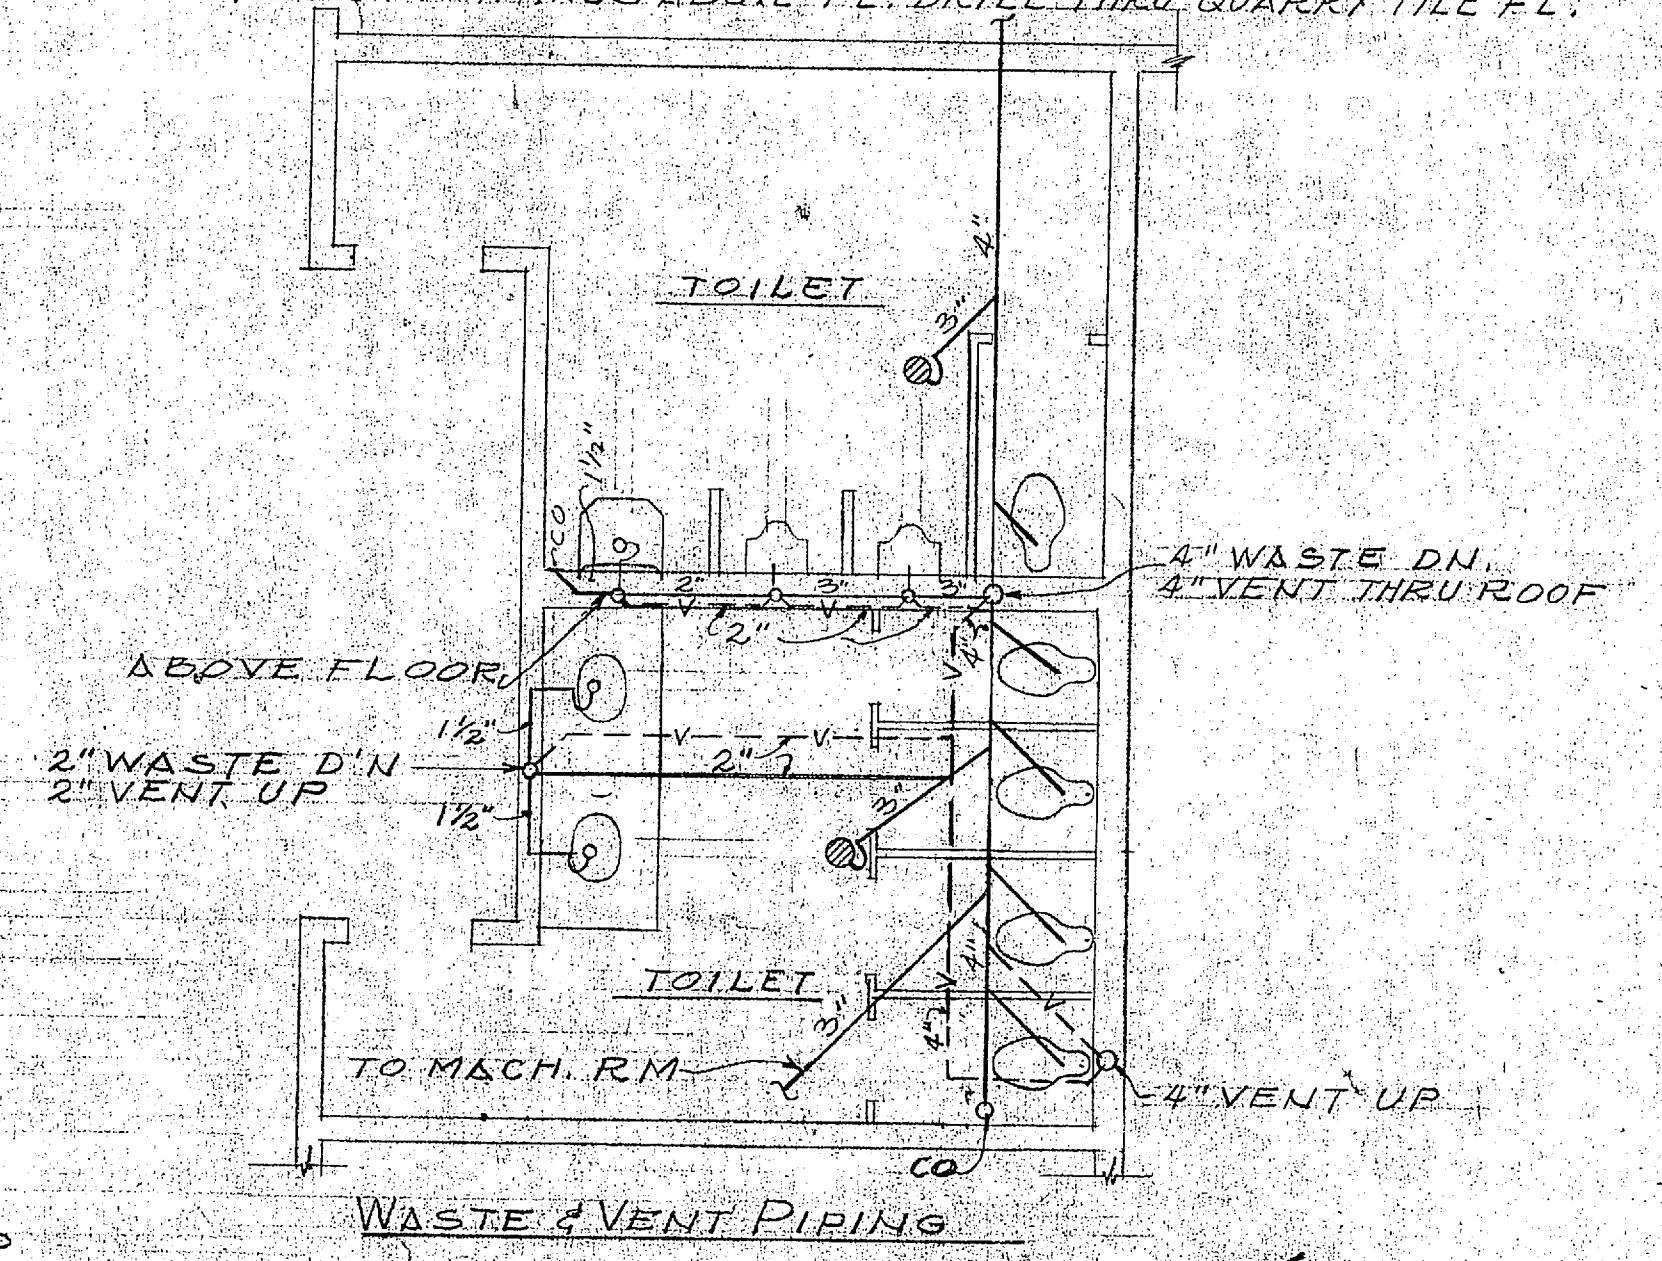


PLAN NEW TOILETS WEST WING
SCALE: 1/4"=1'-0"

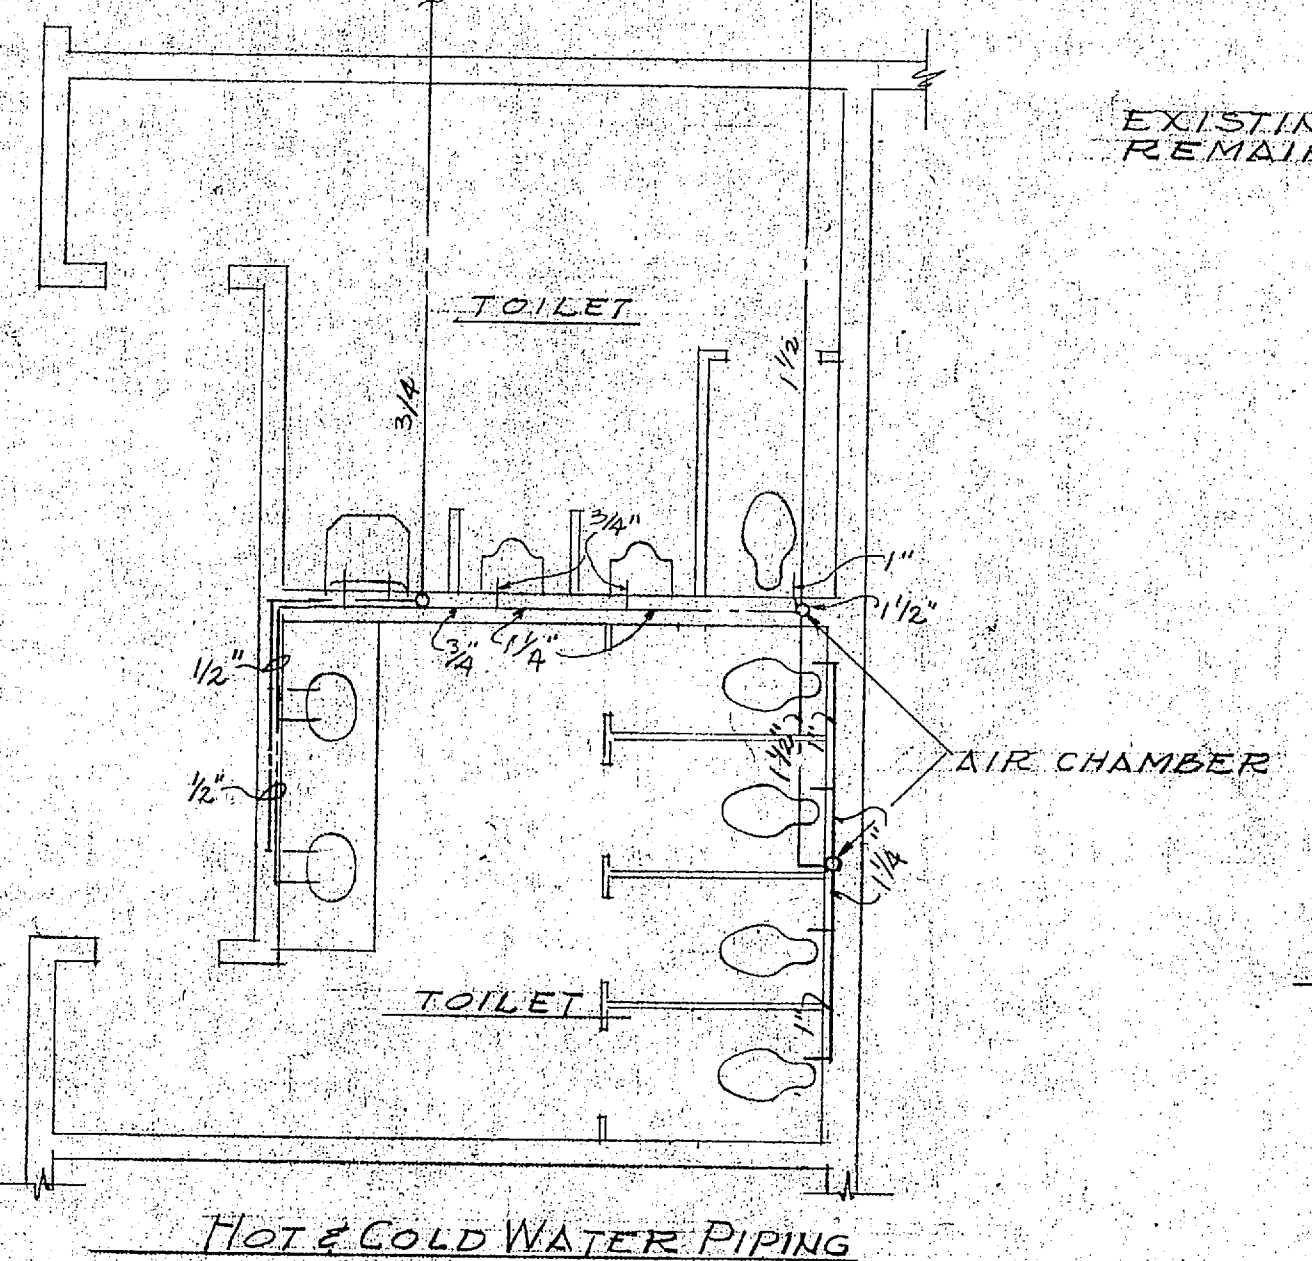

SCHEMATIC ALTERATIONS TO HOT & COLD WATER PIPING
NO SCALE

- LEGEND**
- LAVATORY - LAV.
 - LAVATORY - TABLE TYPE
 - ⊕ WATER CLOSET - W.C.
 - ⊕ URINAL - UR.
 - FLOOR FIRE LINE
 - COLD WATER LINE
 - HOT WATER LINE
 - HOT WATER RETURN
 - SEWER OR WASTE LINE WITH CLEANOUT
 - PIPING TO BE REMOVED
 - NEW PIPING
 - FLOOR DRAIN, 3"
 - FUNNEL DRAIN, 3"
 - NEW VALVE
 - EXIST. VALVE
 - VENT PIPING
 - CAPPED OR PLUGGED PIPE

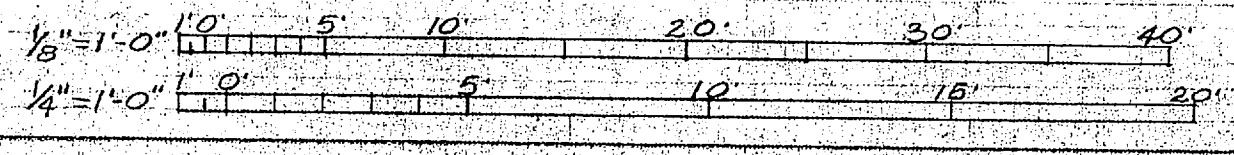

SATISFACTORY TO: *[Signature]*
OFFICER IN CHARGE, C.O.M.
DATE: 19 APR 73

PUBLIC WORKS DEPT. MARINE CORPS BASE CAMP LEJEUNE, N.C.		DEPARTMENT OF THE NAVY NAVAL FACILITIES ENGINEERING COMMAND ATLANTIC DIVISION NORFOLK, VIRGINIA	
DESIGNED BY: <i>[Signature]</i> CHECKED BY: <i>[Signature]</i> DRAWN BY: <i>[Signature]</i> APPROVED BY: <i>[Signature]</i> PUBLIC WORKS OFFICER		MARINE CORPS BASE, CAMP LEJEUNE, N.C. RENOVATION OF COMMISSIONED OFFICERS' MESS (OPEN) BLDG. NO. 2615 MECHANICAL; PLUMBING	
COMMANDING GENERAL: <i>[Signature]</i>	SIZE: F	CODE/IDENT NO: 80091	NAVFAC DRAWING NO: 4006896
APPROVED BY: <i>[Signature]</i>	DATE: 4/11/73	CONSTR CONTR NO: N62470-73-B-0874	SHEET 14 OF 14
DATE: 19 APR 73		SCALE GRAPHIC	SPEC: 05-73-0874

Base Maint

AS-BUILTS TO
BASE PRINT
ENCL (1) 05-73-0874