


SCHEMATIC DIAGRAM
PRESSURE RELIEF VALVE ASSEMBLY
NO SCALE


RADIATOR SCHEDULE				
RADIATOR	NO. REQUIRED	NO. OF SECTIONS	TOTAL SQ. FT.	RUN OUTS TO RAD.
A	12	40	80	3/4"
B	14	20	40	3/4"
C	6	36	72	3/4"
D	19	24	46	3/4"

NOTE
All radiators to be 4-tube, 25" high, wall hung, cast iron

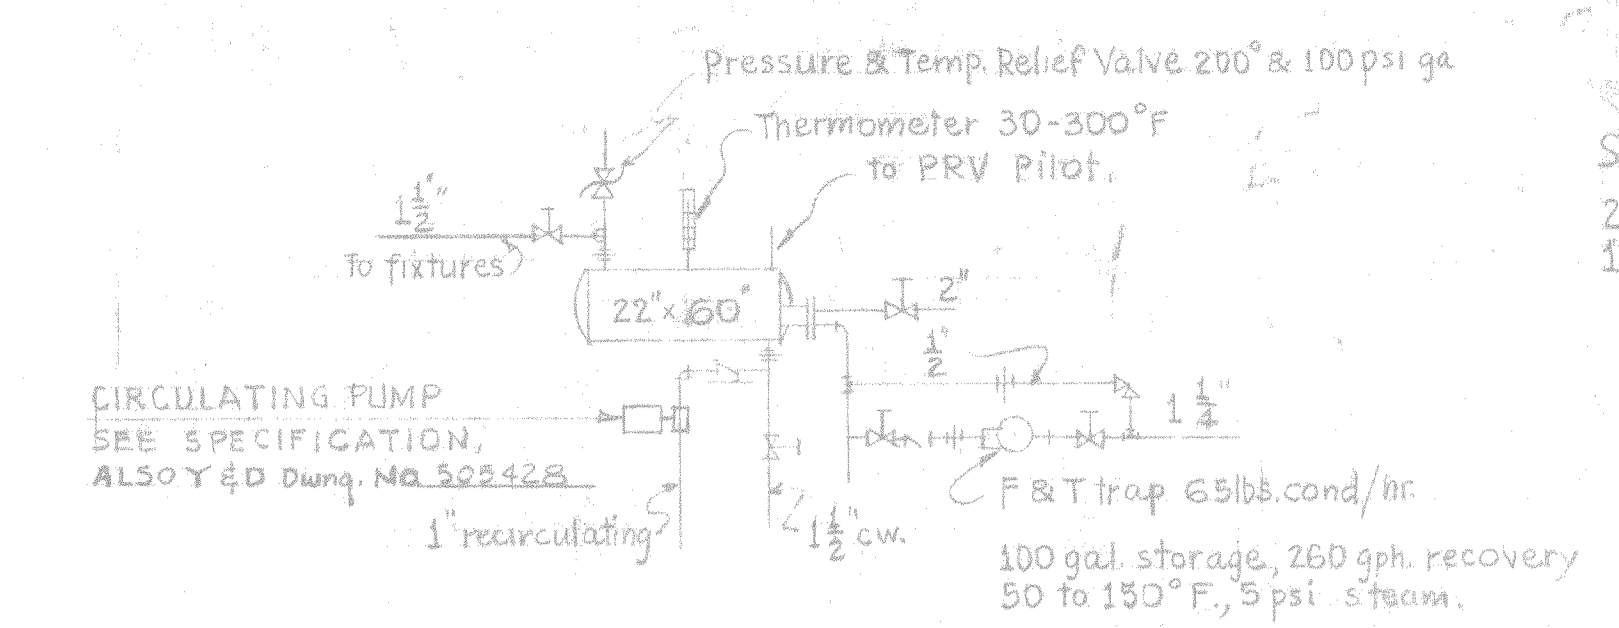


SCHEMATIC DIAGRAM
PIPING AT WATER HEATER
NO SCALE

STORAGE TANK
2 STORY AS SHOWN 22" X 60" 260 G.P.H. RECOVERY
1 " 18" X 60" 60 GAL. STORAGE, 30 G.P.H. RECOVERY

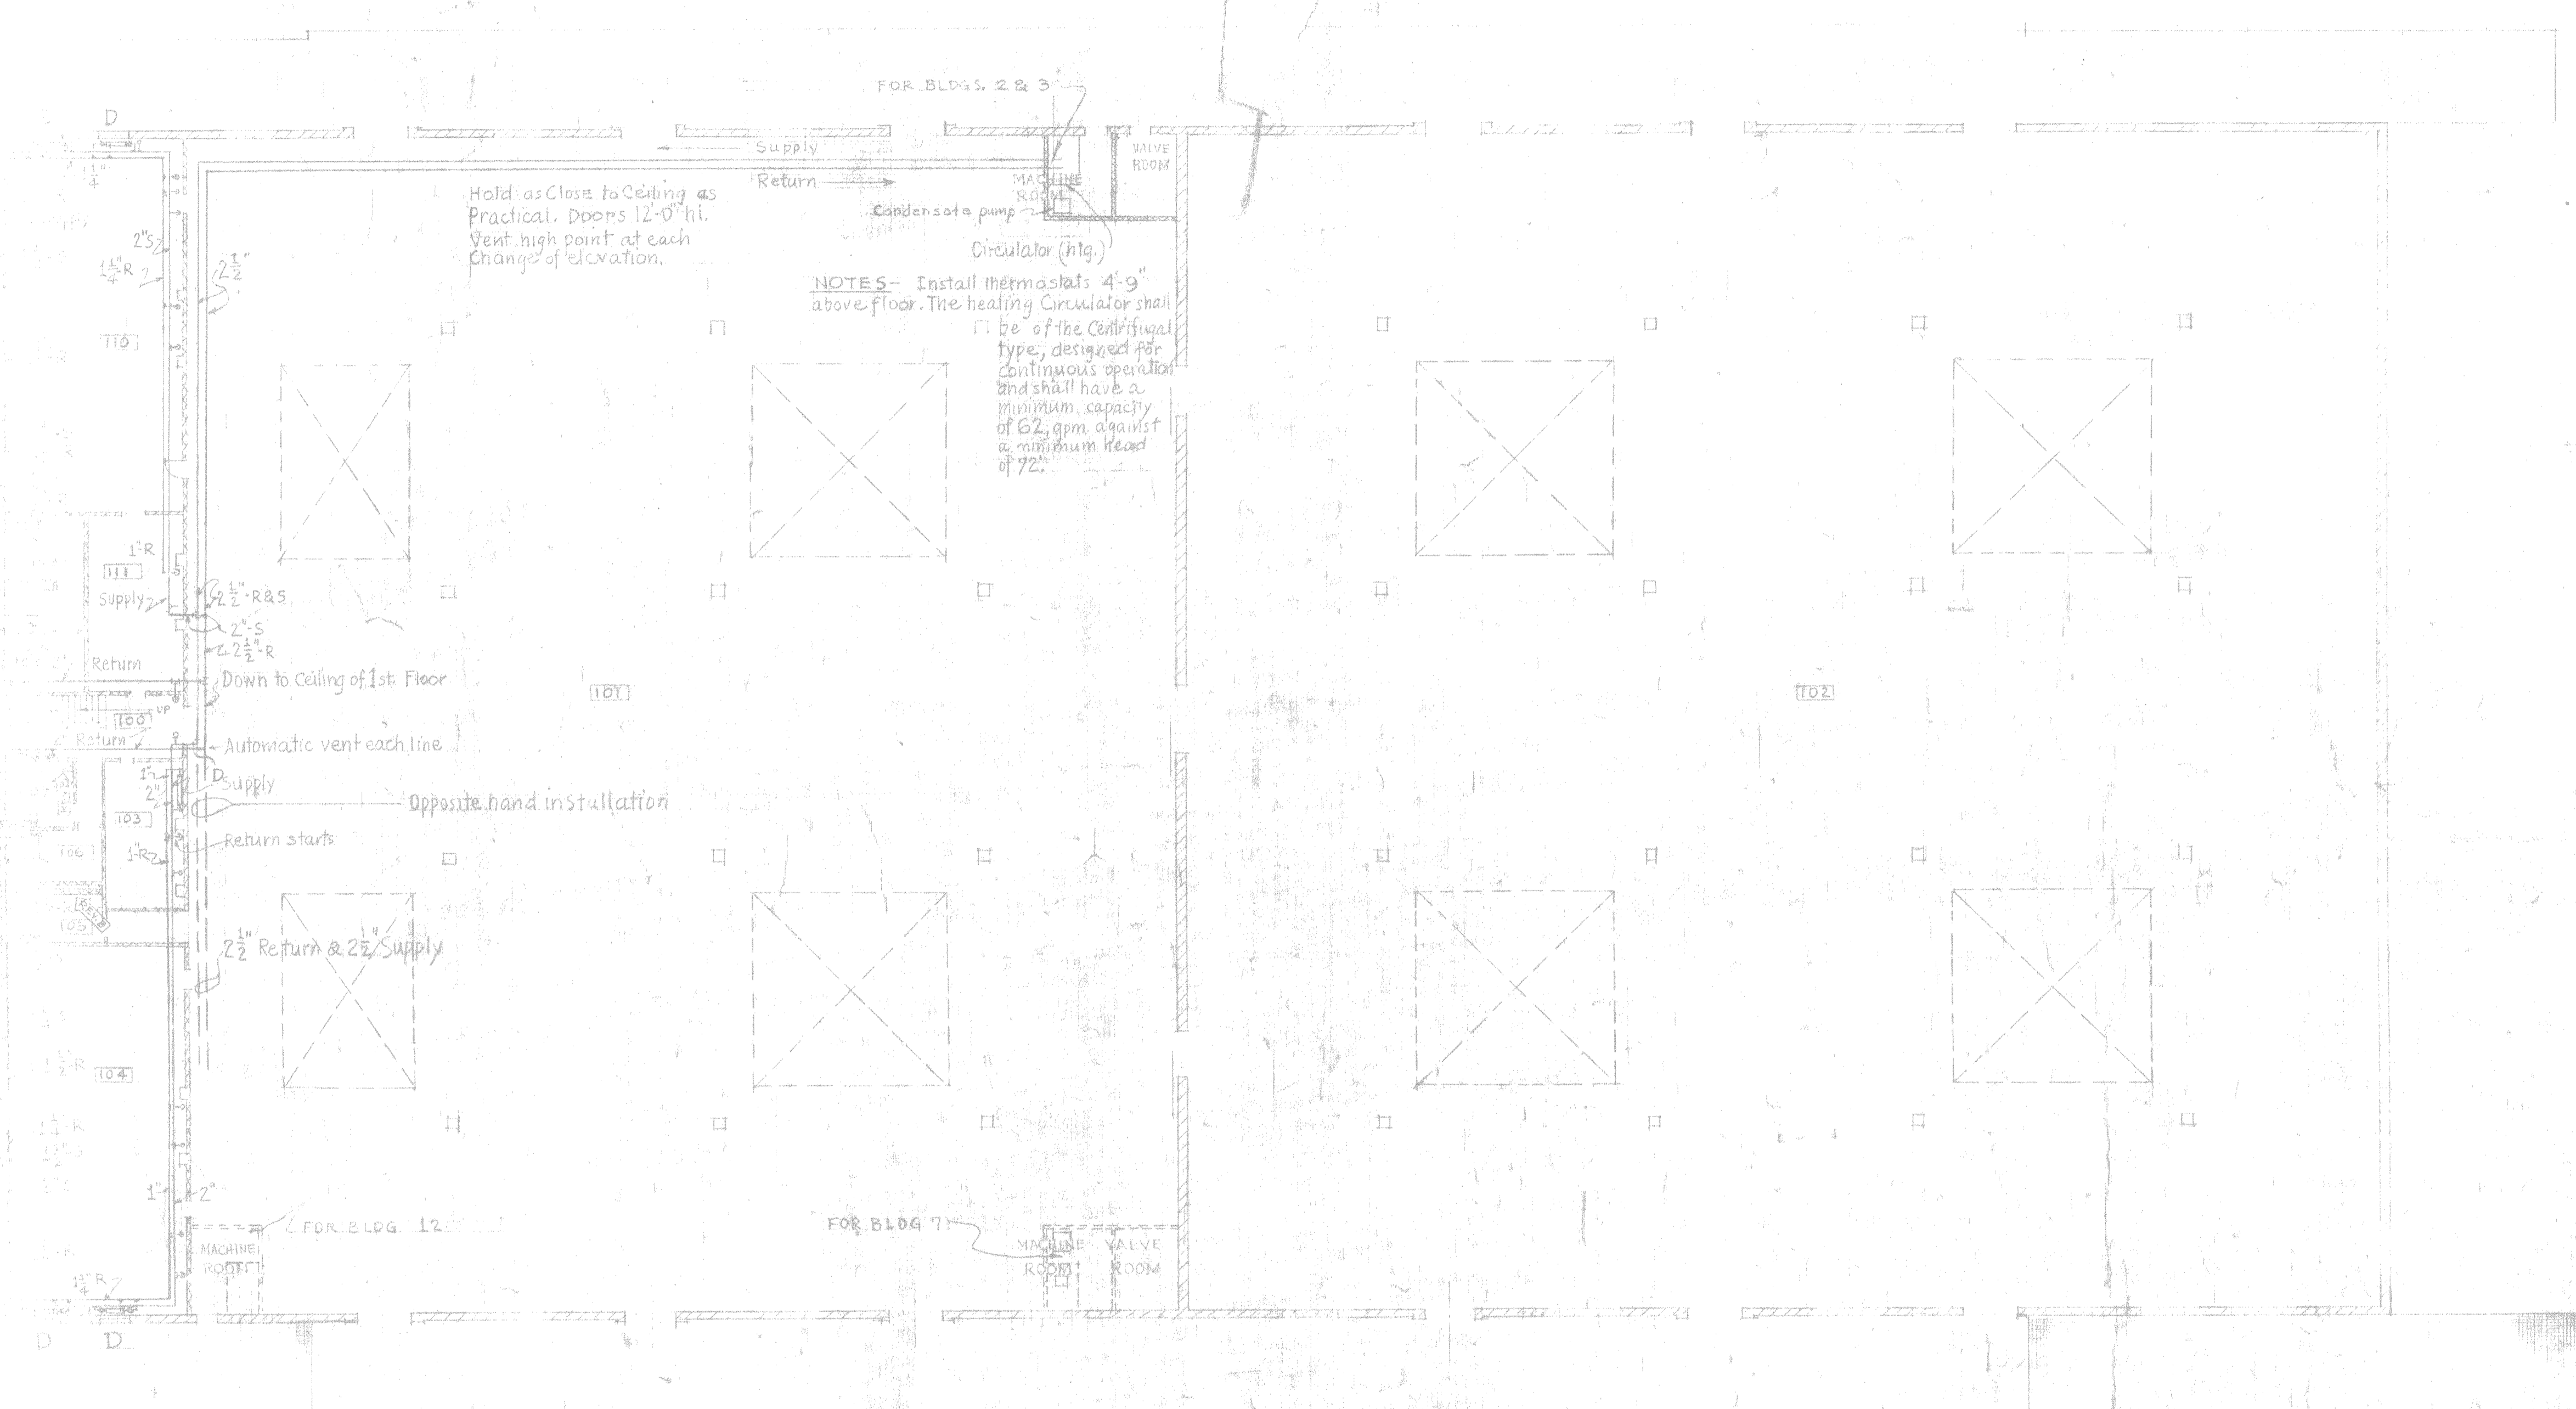


NOTE:
R - RETURN PIPE
S - SUPPLY PIPE


PLAN
Scale 1/8" = 1'-0"

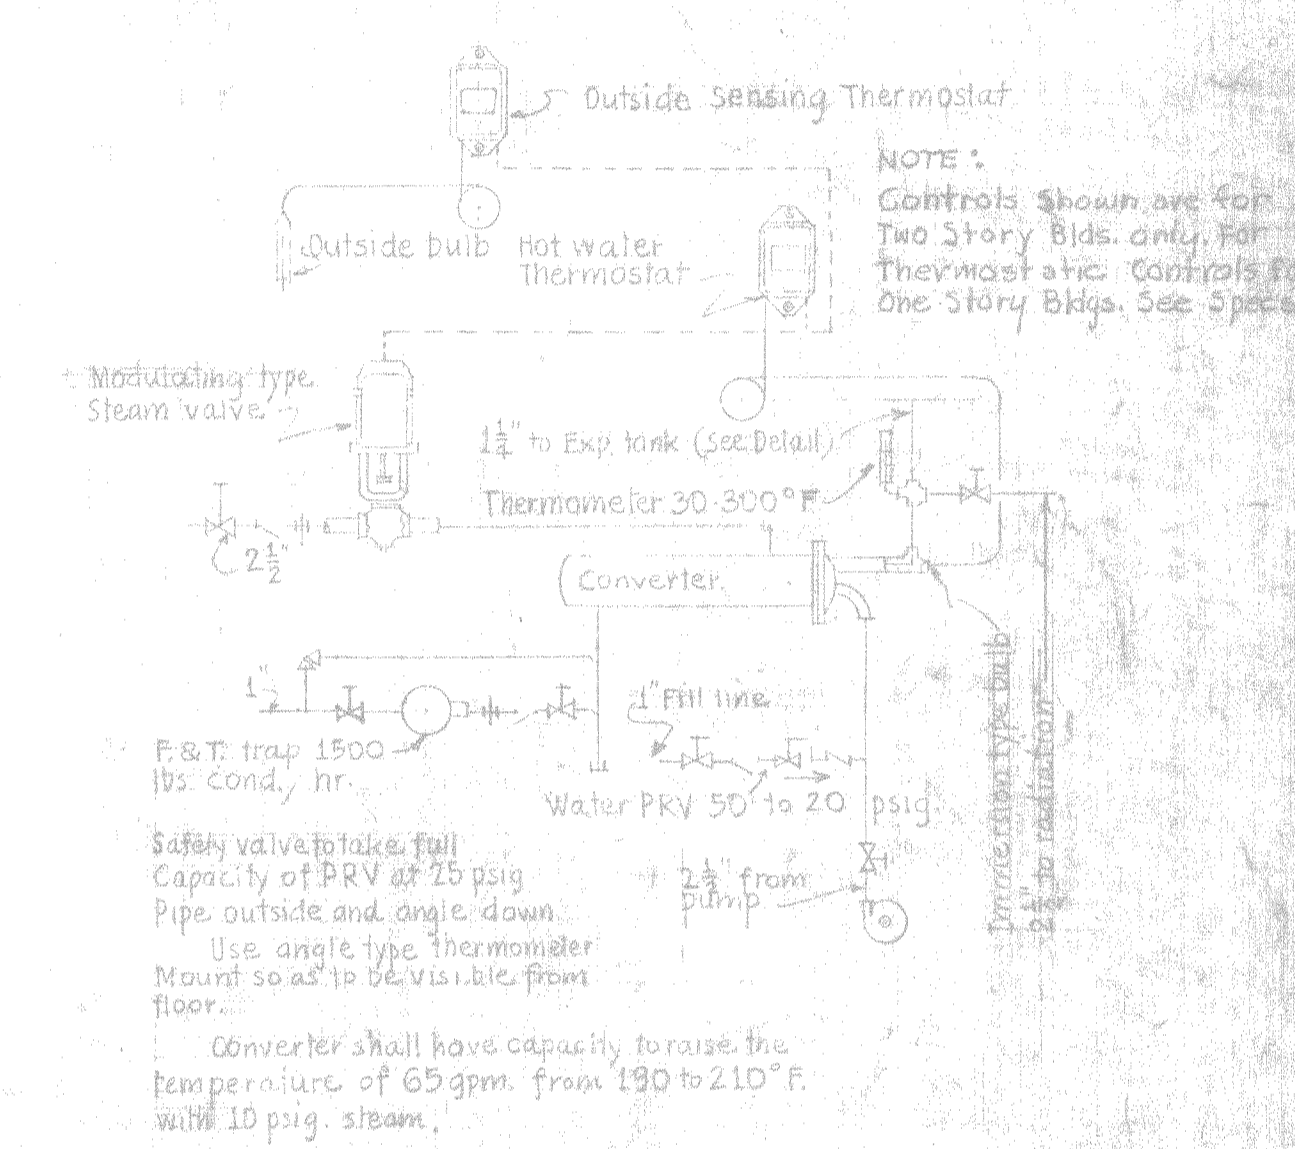

SCHEMATIC DIAGRAM
ELECTRICAL CONTROL SYSTEM
AND PIPING AT CONVERTER
HOT WATER HEATING SYSTEM

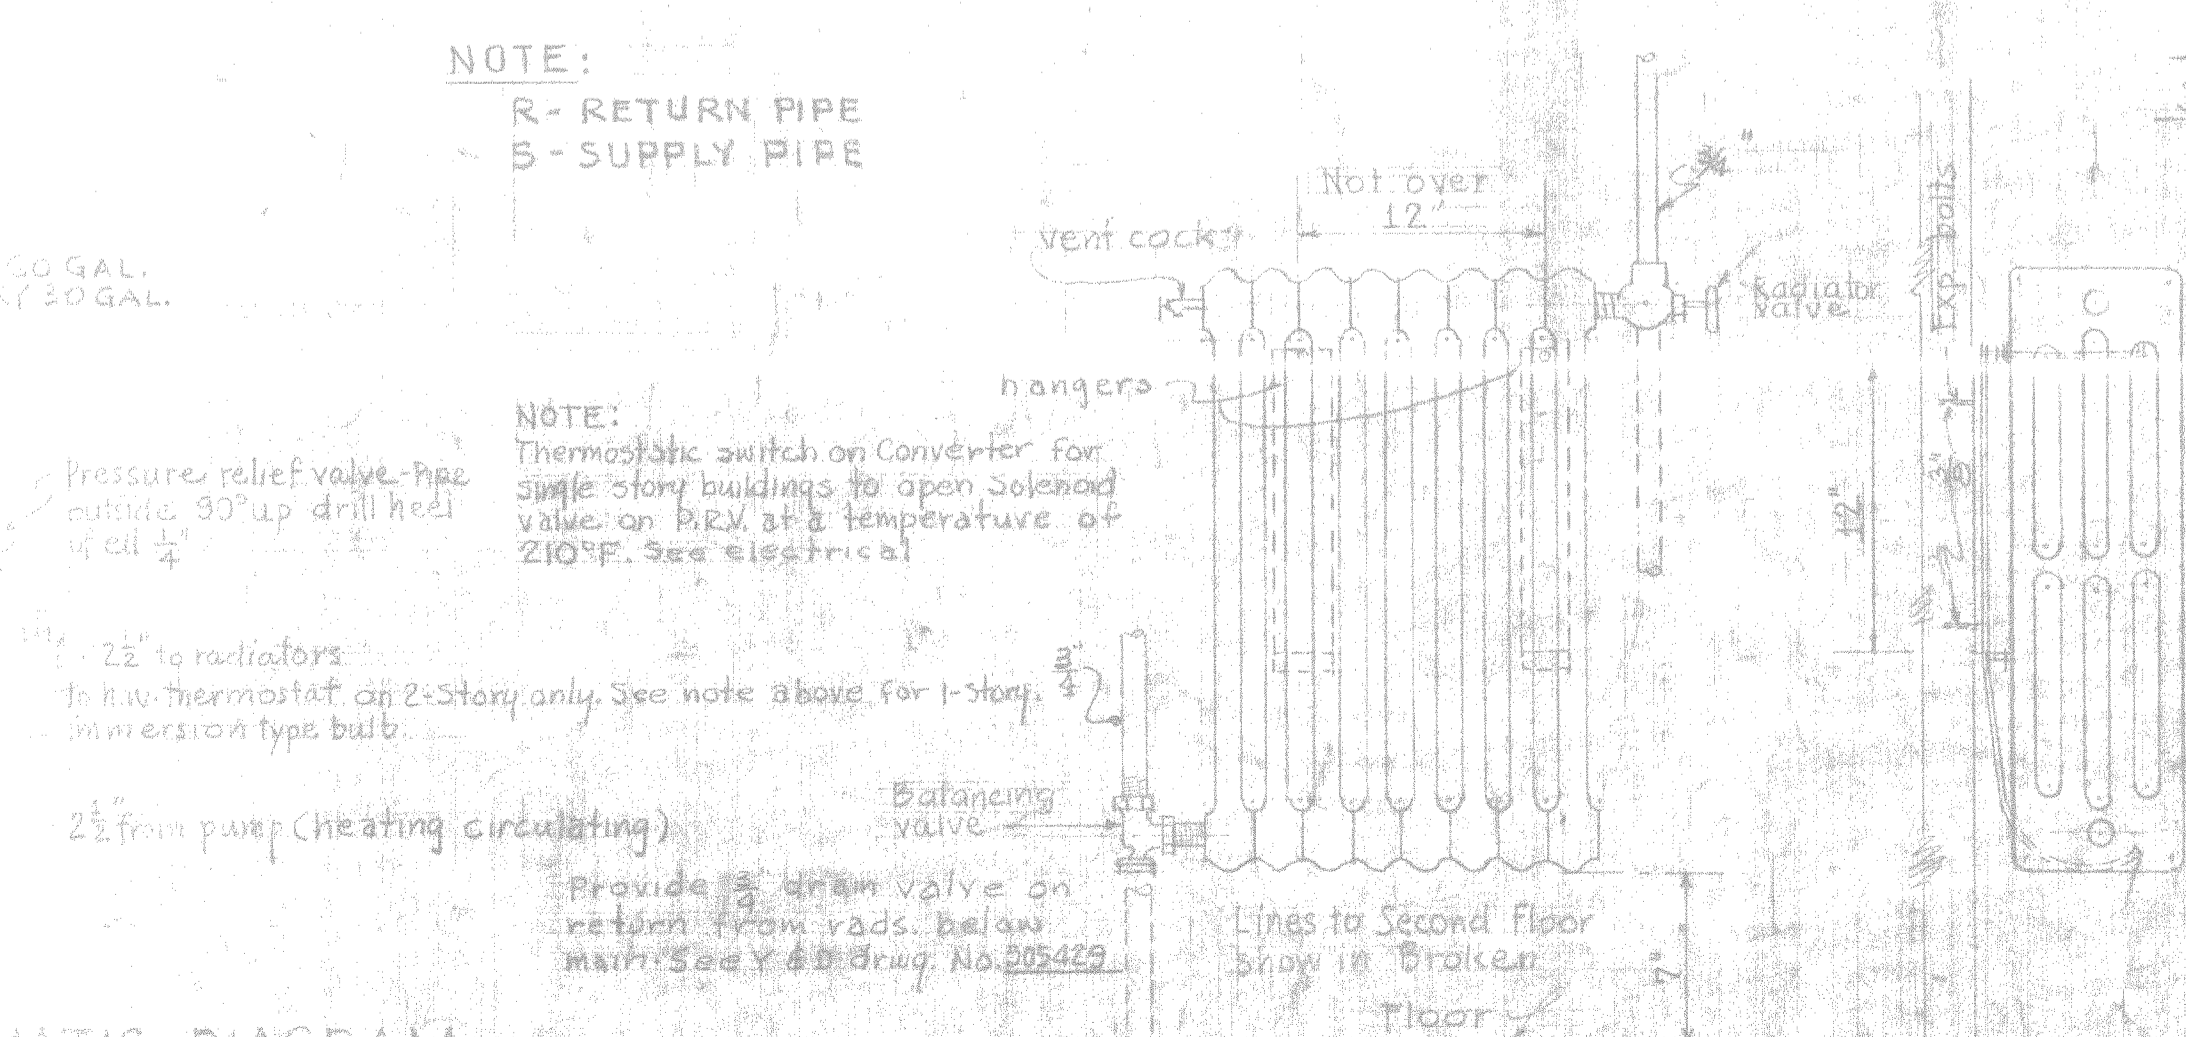

RADIATOR & HANGER DETAIL
NO SCALE

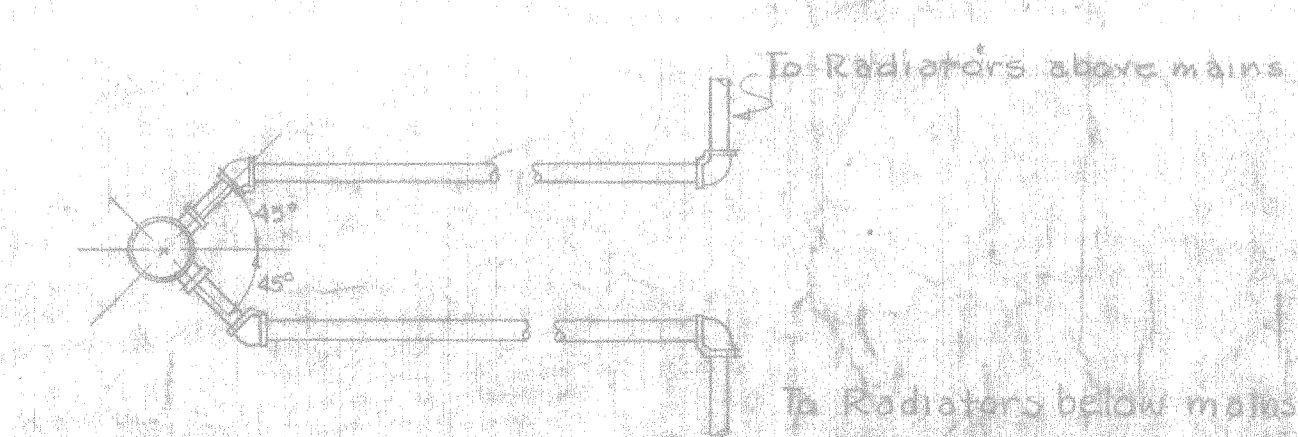

DETAIL - RISER RUNOUTS
NO SCALE

SCHEMATIC DIAGRAM
PIPING TO CONDENSATE PUMP
FOR ALL BUILDINGS
NO SCALE

SCHEMATIC DIAGRAM
PIPING ON TANK ASSEMBLY
NO SCALE

REVISION		DATE	BY
C	AS-BUILT REVISION		
B	REVISED FOR ADDITION OF PIPE CHASES		
A	REVISED IN ACCORDANCE WITH ADDEN. NO. 2		

DESIGNER	DRWN	TR	CHK	SUPV	IN CHARGE

REVISION DATE	APPRO.	DESCRIPTION	BY

P.W. DRAWING NO.		MARINE BARRACKS CAMP LEDEWATER, N.C.	
8430		QUARTERMASTER WAREHOUSES HEATING TWO STORY TYPE PLANS AND DETAILS	
APPROVED	DATE	SCALE AS NOTED	SPEC 3221B
			SHEET 31 OF 12 NOV 1962
THE QUARTERMASTER GENERAL OF THE MARINE CORPS		P.W.D. DRAWING NO. 505430	

