

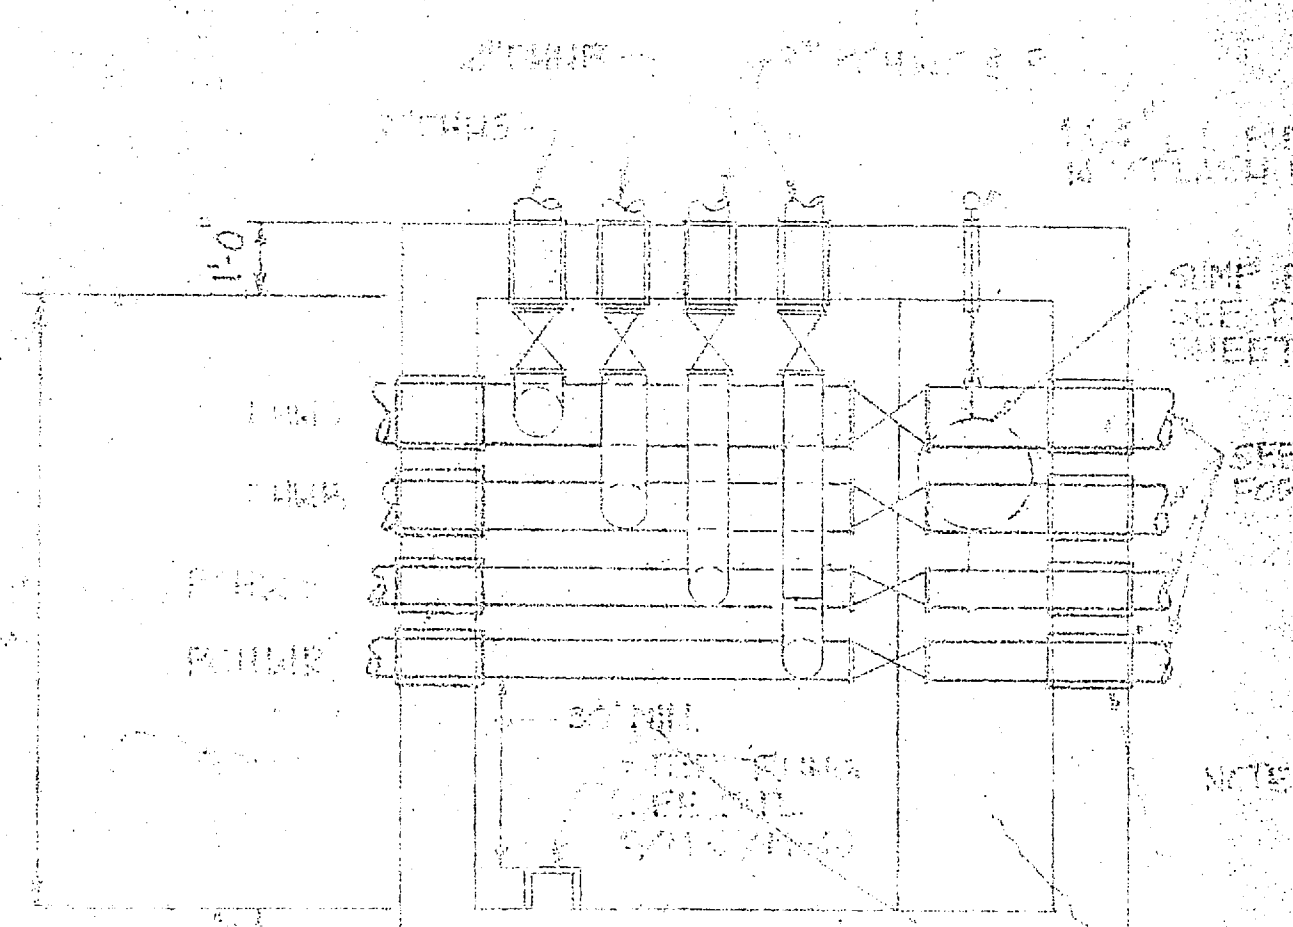


NO.	REVISION	DATE	APPROVED

VALVE PIT # 12,3 DETAIL

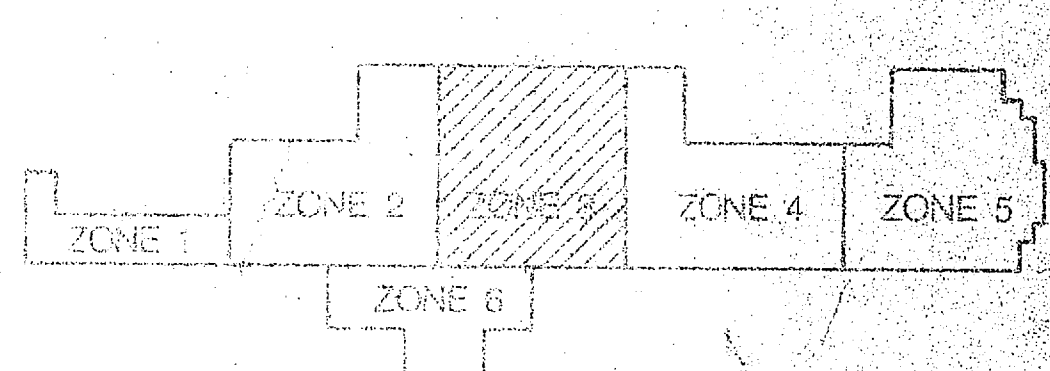


VALVE PIT # 4 DETAIL

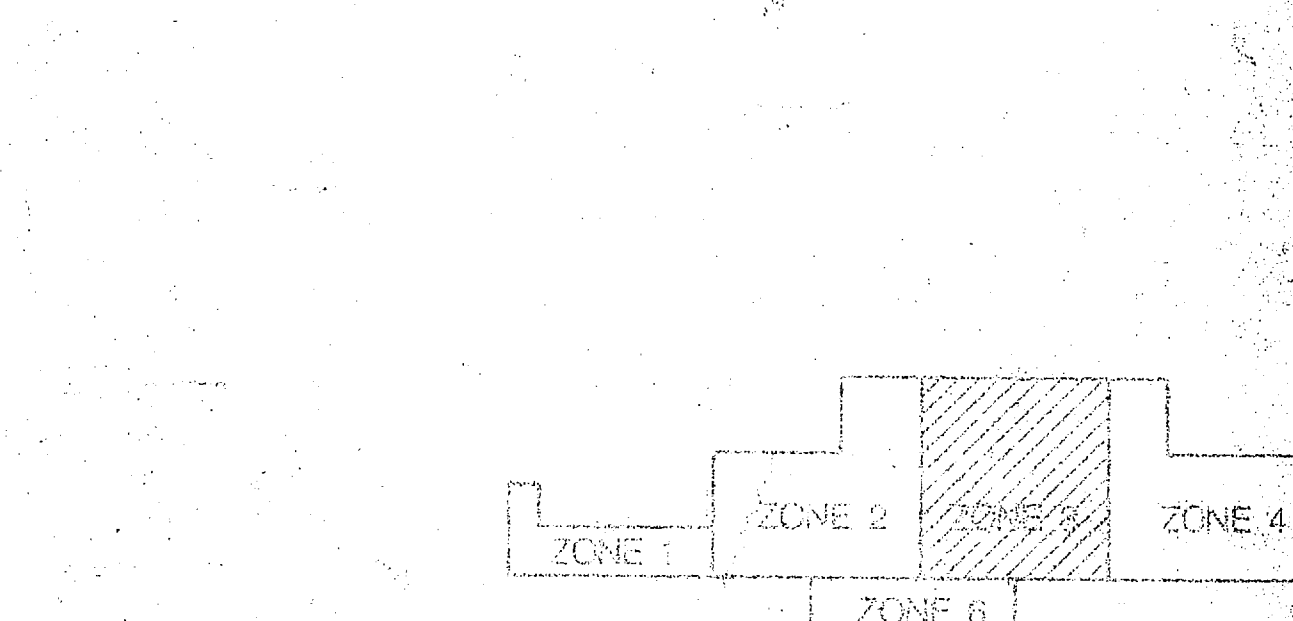


SHEET KEY

GRAPHIC SCALE

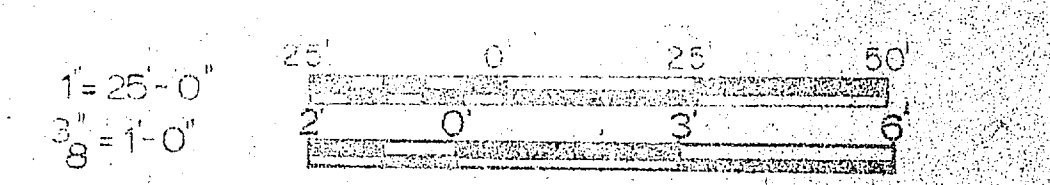

M-12

	PROJECT: <b>MECHANICAL</b> DRAWING NO.: <b>M-12</b> TITLE: <b>SITE PLAN - ZONE 3</b>	ARCHITECT: <b>J. B. REESE ASSOCIATES</b> ENGINEER: <b>J. B. REESE</b> DATE: <b>11/15/50</b>	DIVISION: <b>ATLANTIC</b> COMMAND: <b>MARINE CORPS BASE CAMP LEJEUNE, N.C.</b> DRAWING NO.: <b>MECHANICAL SITE PLAN - ZONE 3</b>
	PROJECT: <b>MECHANICAL</b> DRAWING NO.: <b>M-12</b> TITLE: <b>SITE PLAN - ZONE 3</b>	ARCHITECT: <b>J. B. REESE ASSOCIATES</b> ENGINEER: <b>J. B. REESE</b> DATE: <b>11/15/50</b>	DIVISION: <b>ATLANTIC</b> COMMAND: <b>MARINE CORPS BASE CAMP LEJEUNE, N.C.</b> DRAWING NO.: <b>MECHANICAL SITE PLAN - ZONE 3</b>

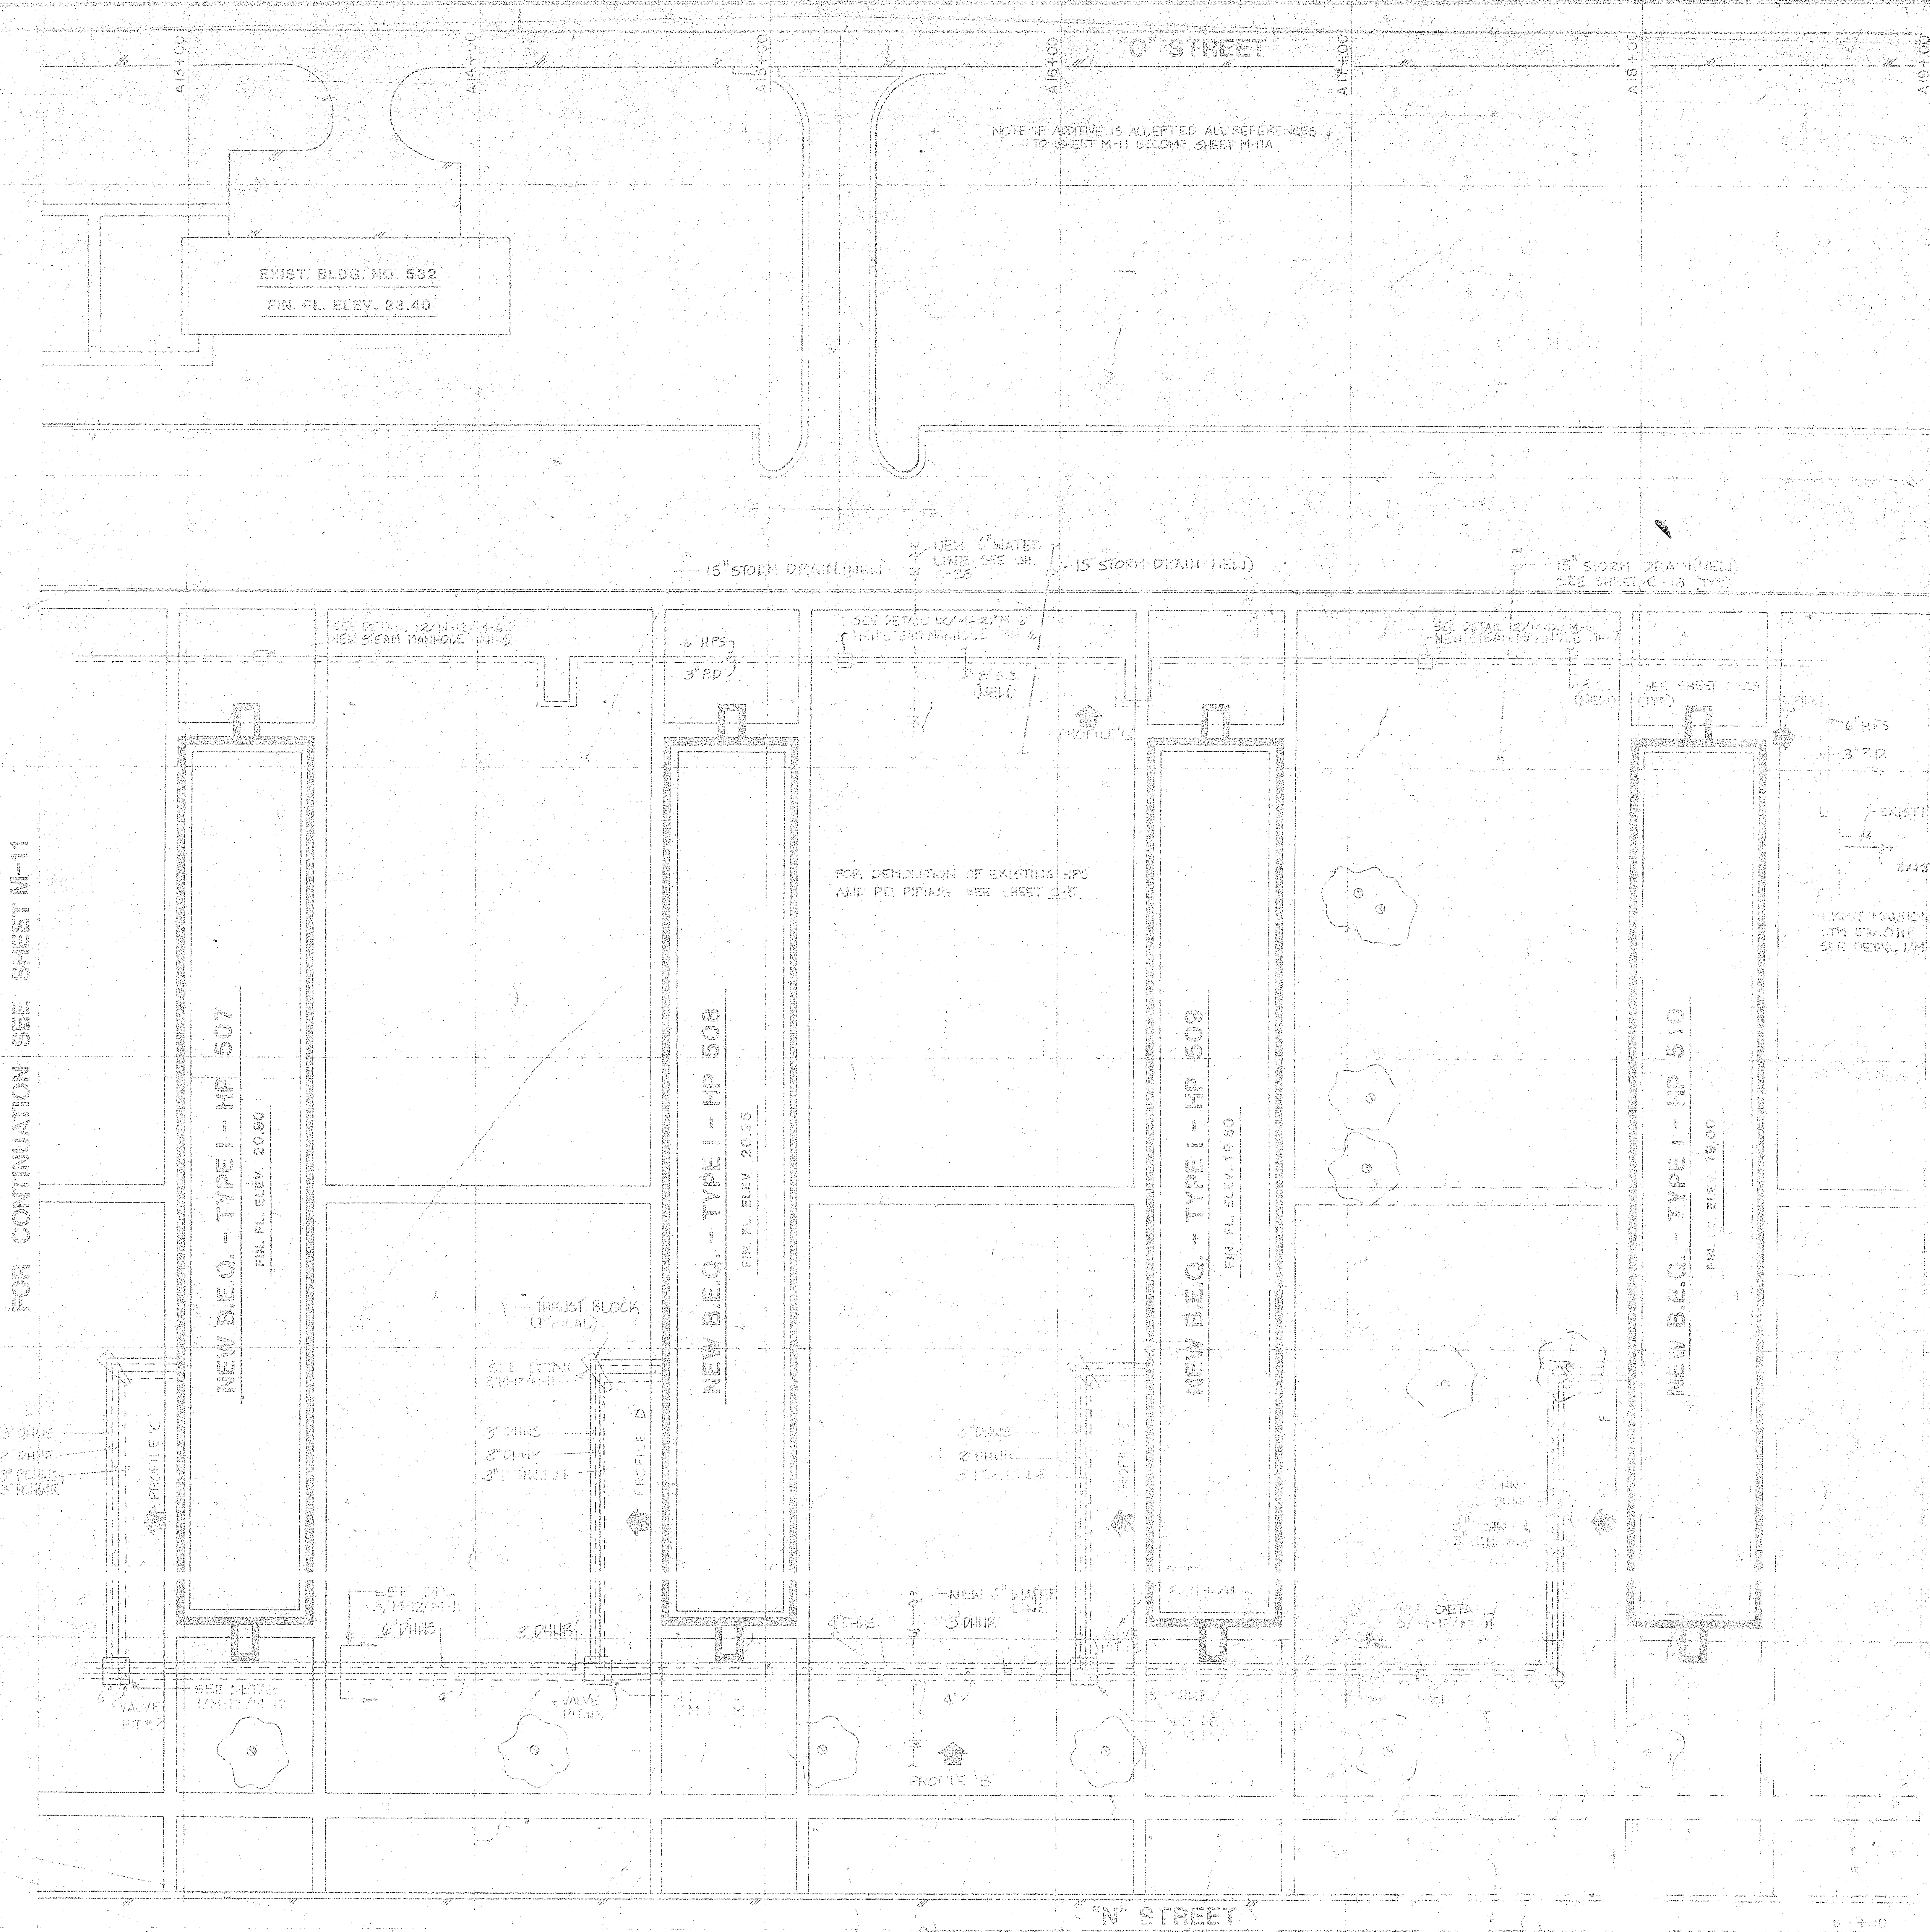

FOR CONTINUATION SEE SHEET M-11

NO.	REVISION	DATE	APPROVED

NOTE: IF ABOVE IS ACCEPTED ALL REFERENCES TO SHEET M-11 BECOME SHEET M-12A

EXIST. BLDG. NO. 502  
FIN. FL. ELEV. 28.40

NEW B.E.O. - TYPE I - HP 507  
FIN. FL. ELEV. 20.80

NEW B.E.O. - TYPE I - HP 508  
FIN. FL. ELEV. 20.25

NEW B.E.O. - TYPE I - HP 508  
FIN. FL. ELEV. 19.80

NEW B.E.O. - TYPE I - HP 510  
FIN. FL. ELEV. 19.00

510+0.

518+00

517+00

516+00

514+00

513+00

NORTH





N STREET

C STREET







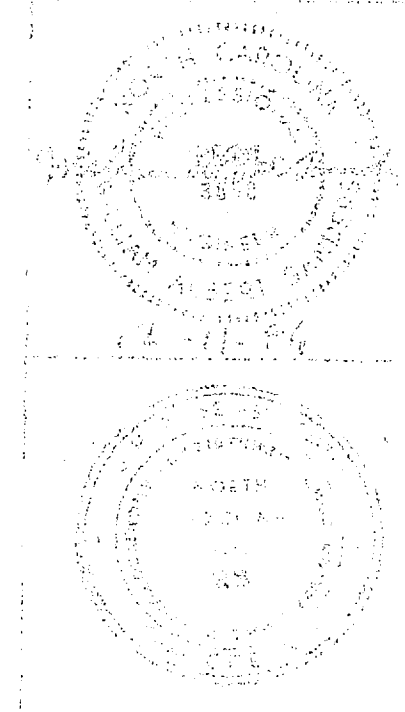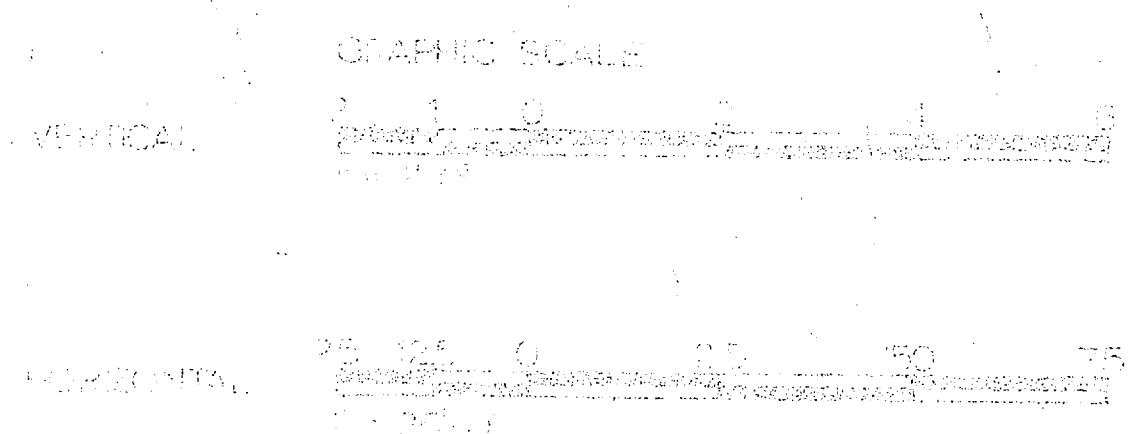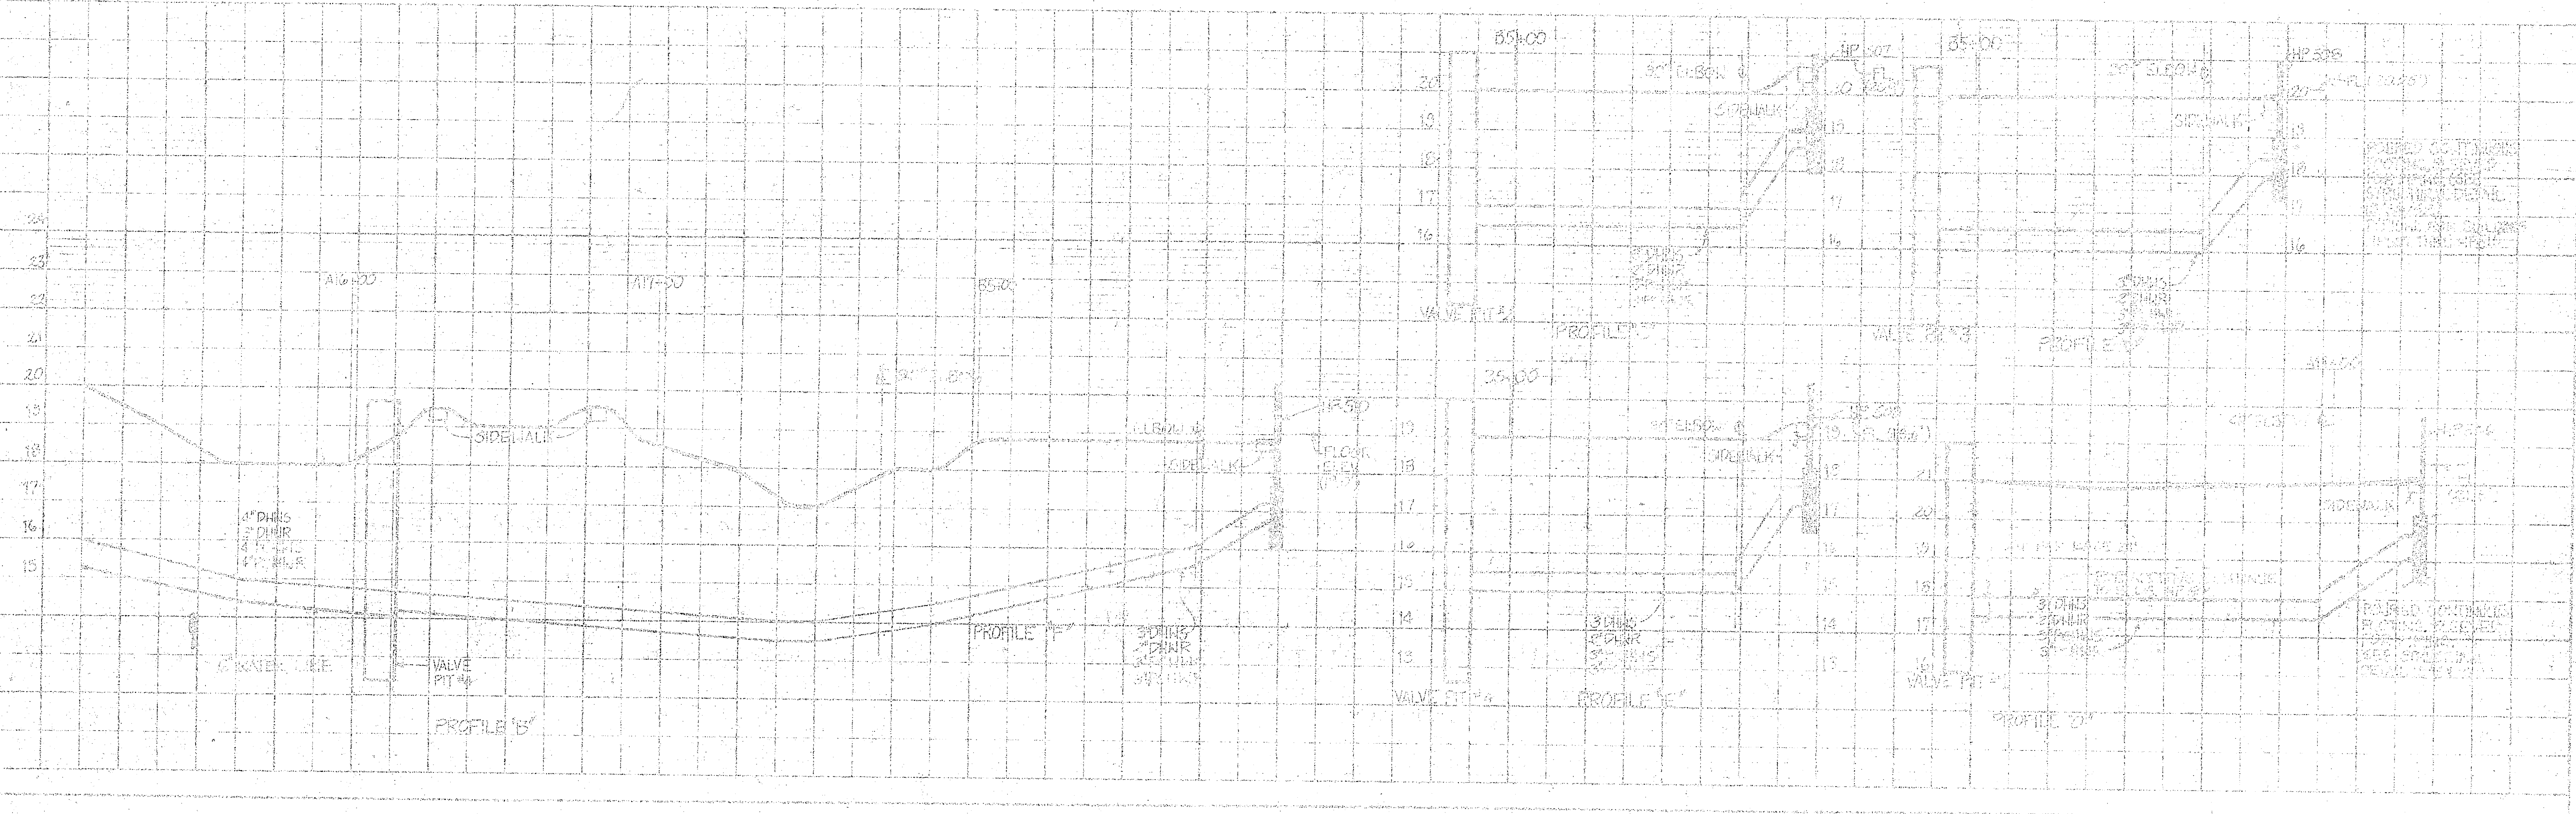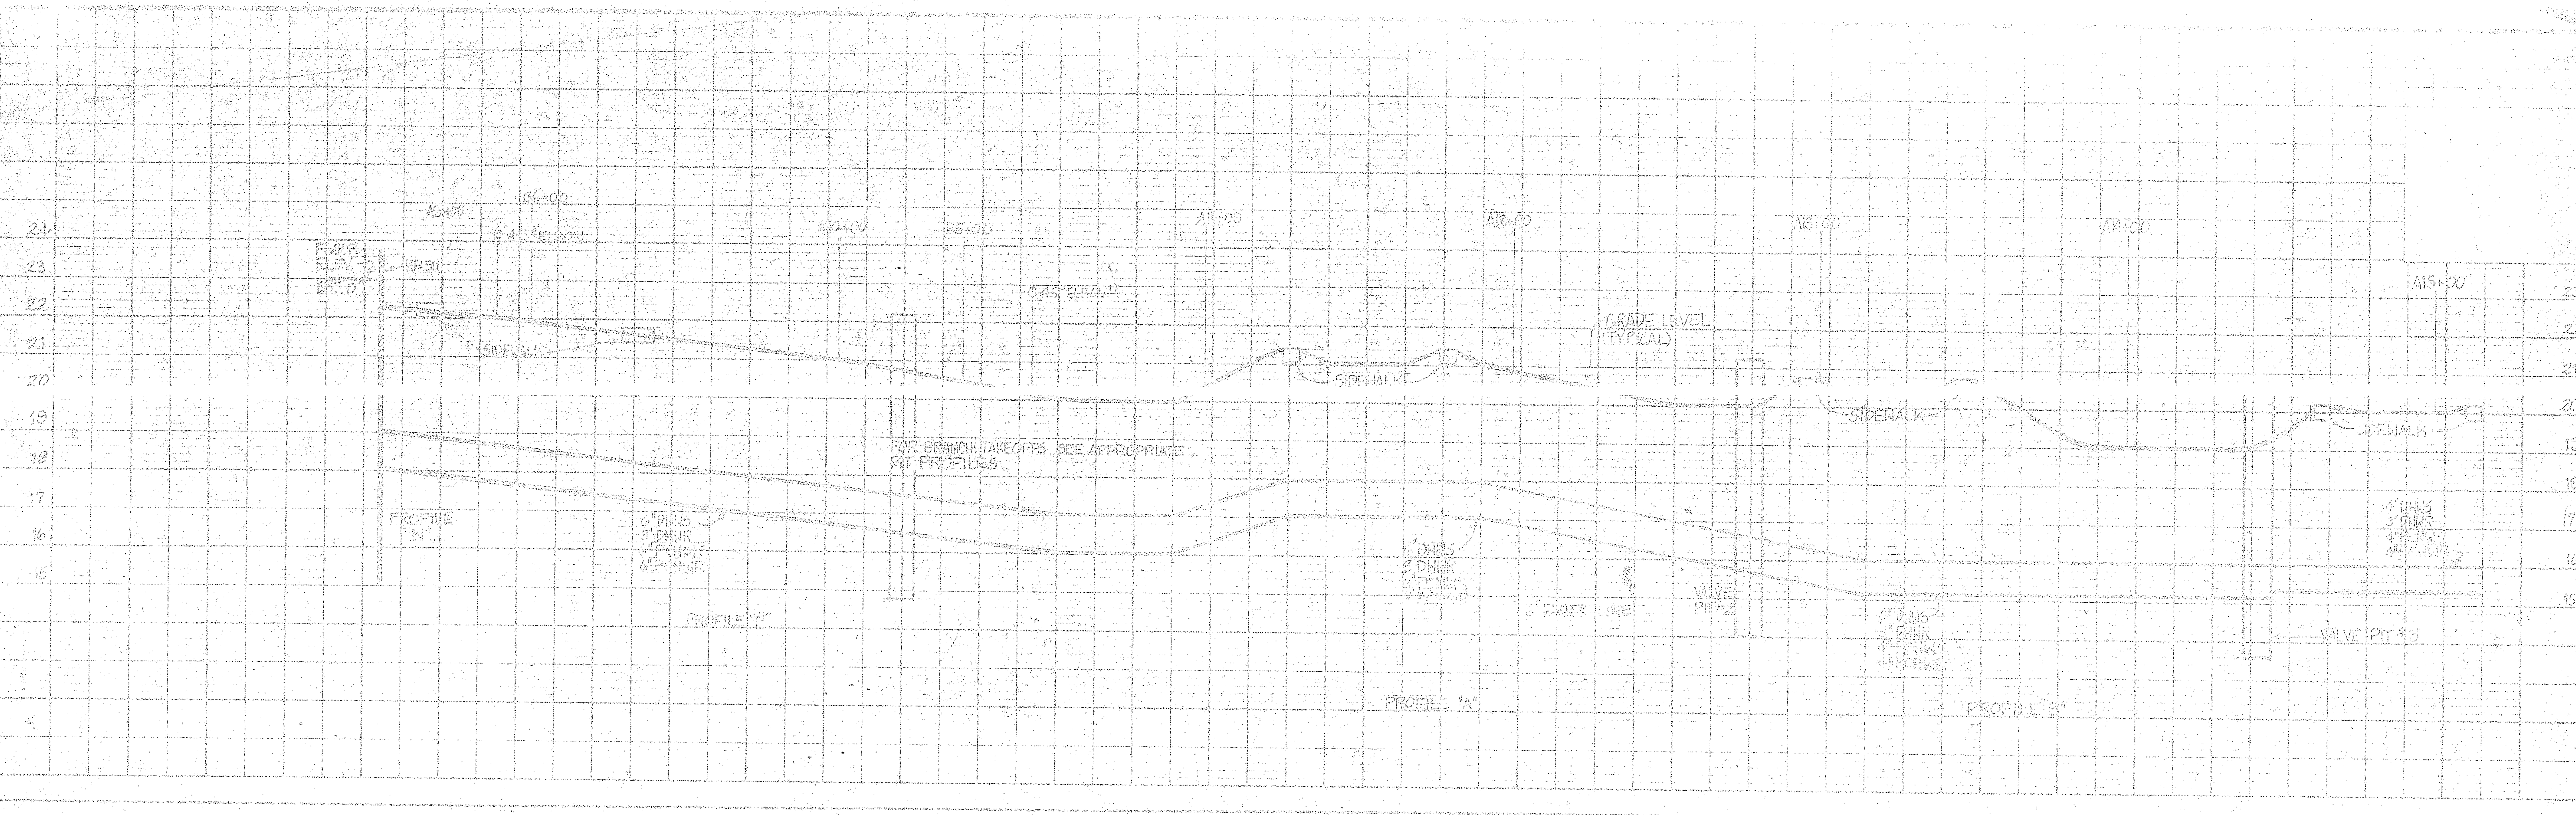

M-14

ATLANTIC DIVISION

MARINE CORPS BASE CAMP LAUREL, N.C.  
 BACHELOR ENLISTED QUARTERS  
**PROFILES-PCHWS/R &  
 CHWS/R DISTRIBUTION**

4153188  
 4153188  
 4153188





















REV	DESCRIPTION	DATE

### CONTROL LEGEND






- AO AQUASTAT
- CR CONTROL RELAY
- TS TEMPERATURE SENSOR
- MS MANUAL SWITCH
- DTZ DATA TERMINAL CABINET
- SEN SENSOR
- NO NORMALLY CLOSED
- NC NORMALLY OPEN
- COM COMMON
- FS FLOW SWITCH
- TL LOW LIMIT THERMOSTAT
- HL HIGH LIMIT THERMOSTAT
- TTR RETURN AIR TEMP TRANSMITTER
- DTZ DATA TERMINAL CABINET
- TD TEMP INDICATOR
- RC RESET CONTROLLER
- OLC THERMAL OVERLOADS
- DM DAMPER MOTOR
- EP ELECTRIC PNEUMATIC SWITCH
- NO NORMALLY OPEN CONTACT
- NC NORMALLY CLOSED CONTACT
- PL PILOT LIGHT
- FUSE FUSE
- SW SWITCH
- TS TEMPERATURE SENSING SWITCH
- FS FLOOR SWITCH

DESIGN CONDITIONS		
MODE	OUTSIDE	INSIDE
SUMMER	90°F DB / 74°F WB	78°F DB / 50% RH
WINTER	35°F DB	68°F DB

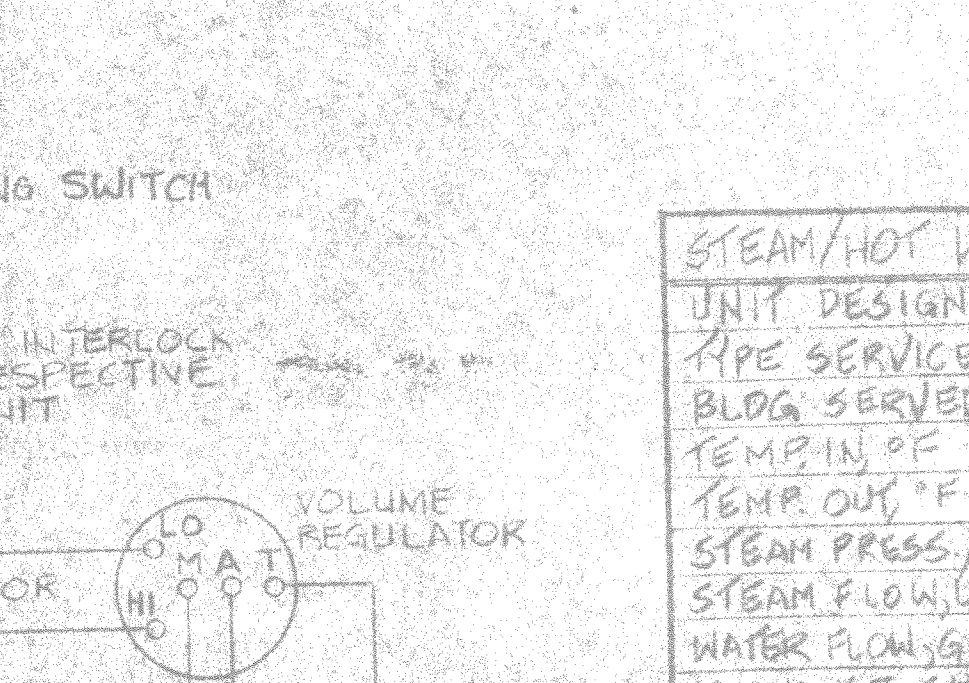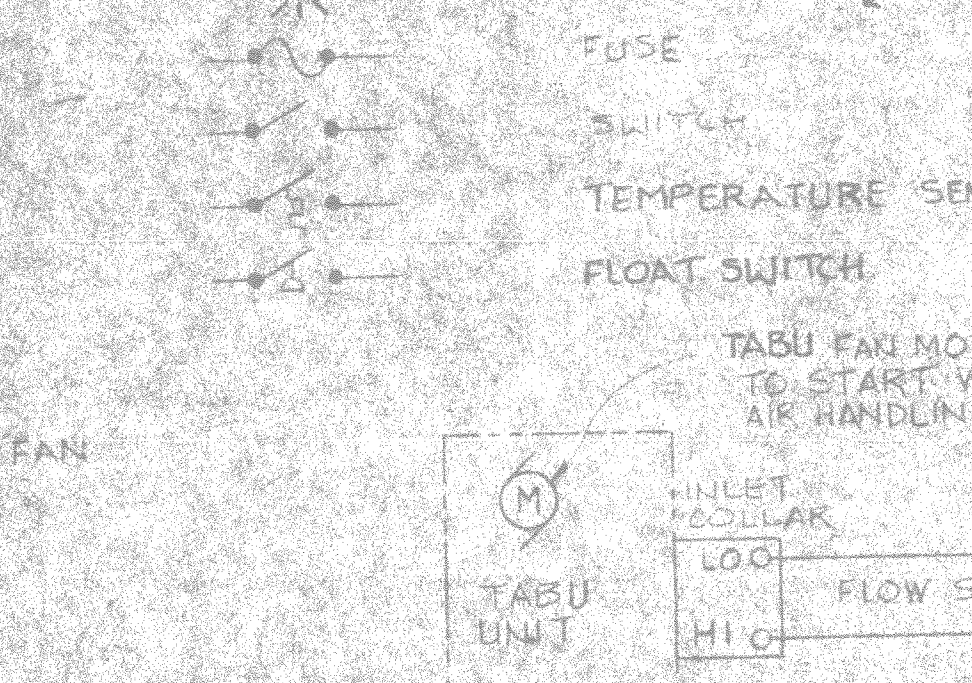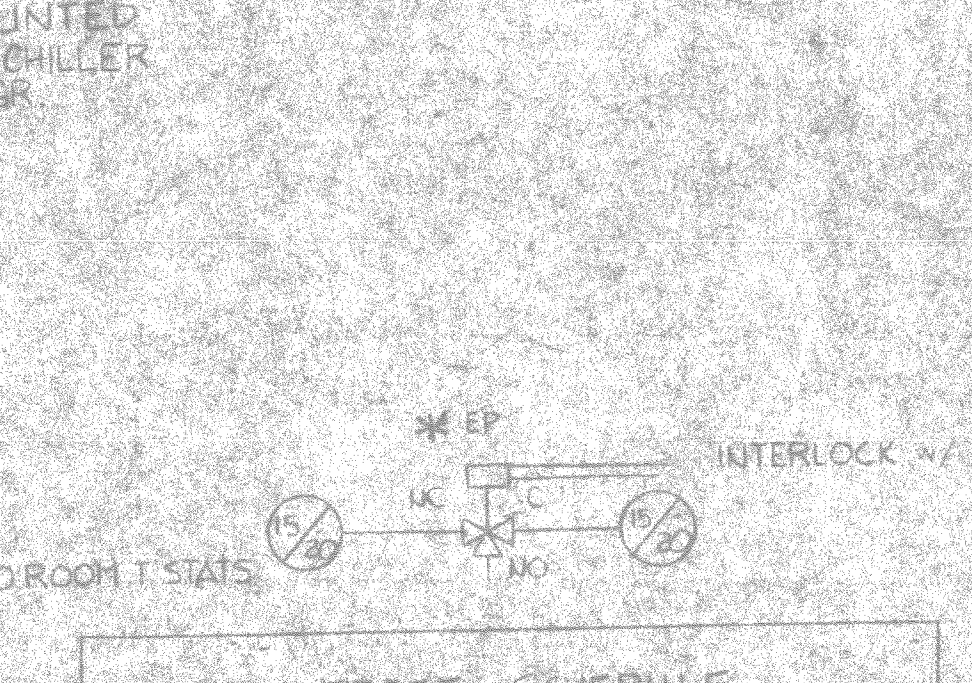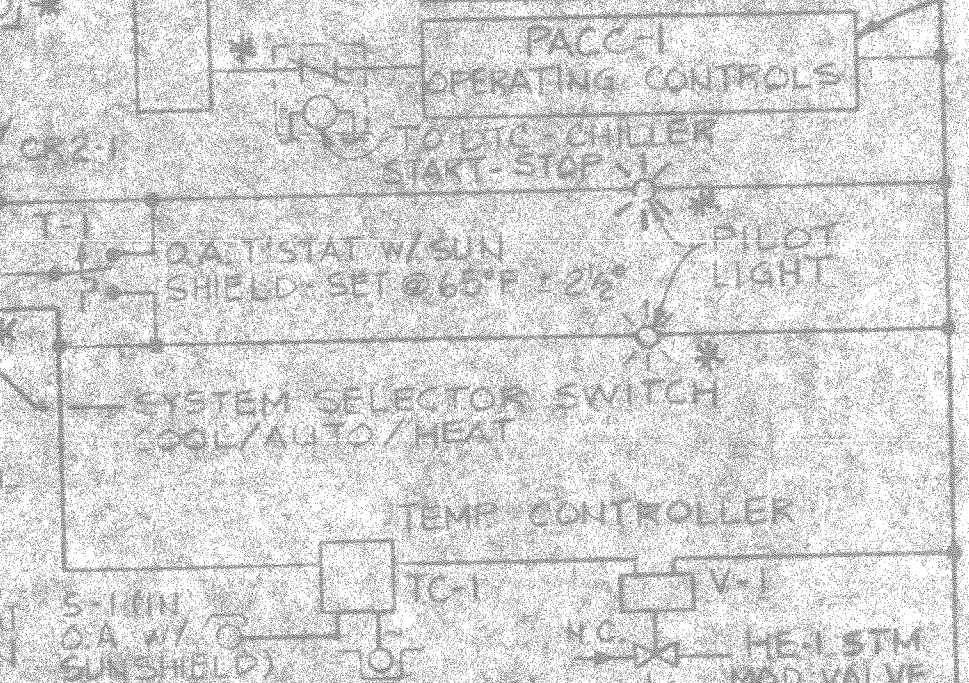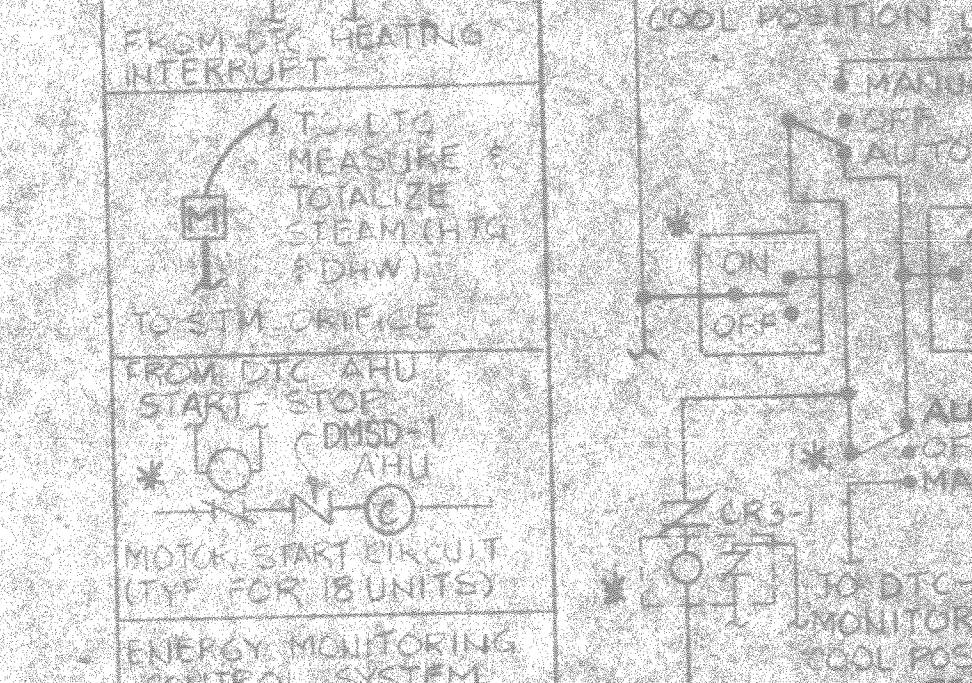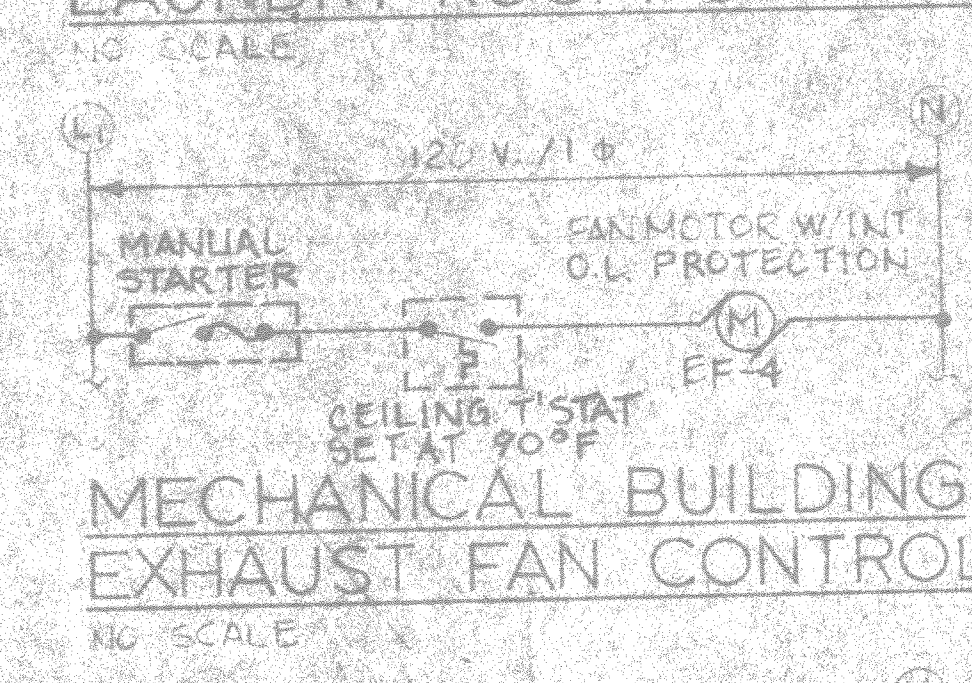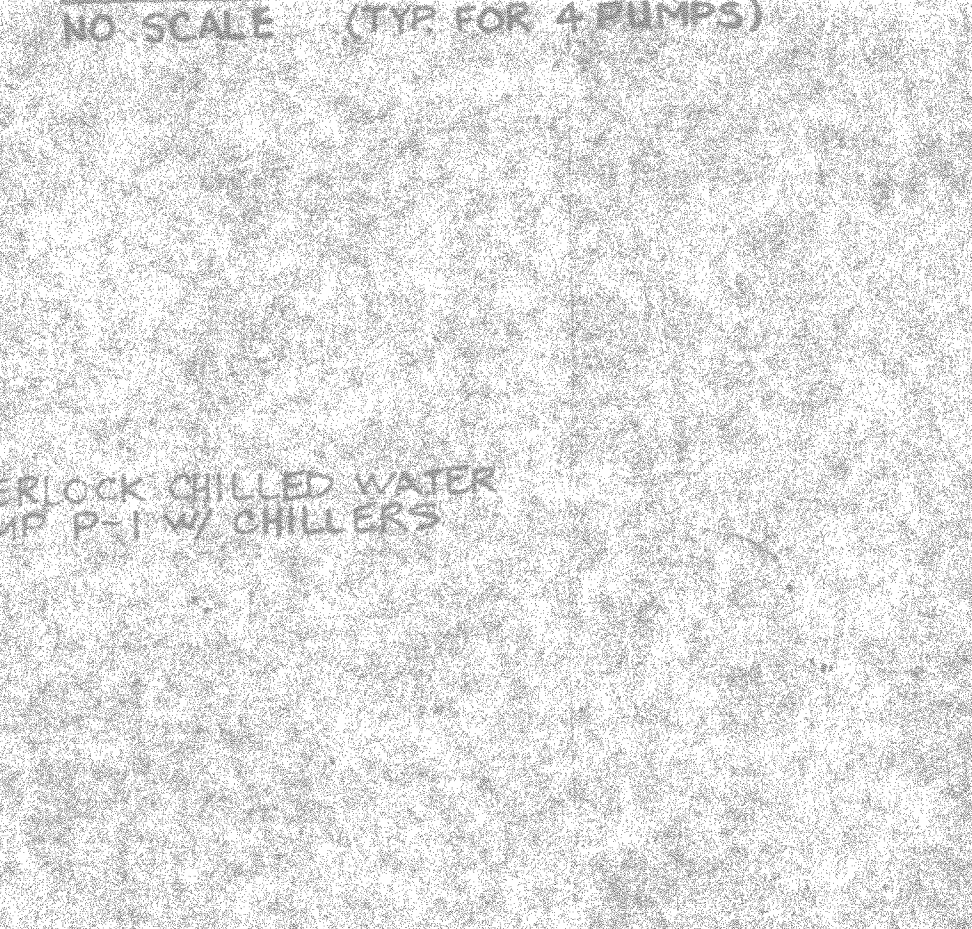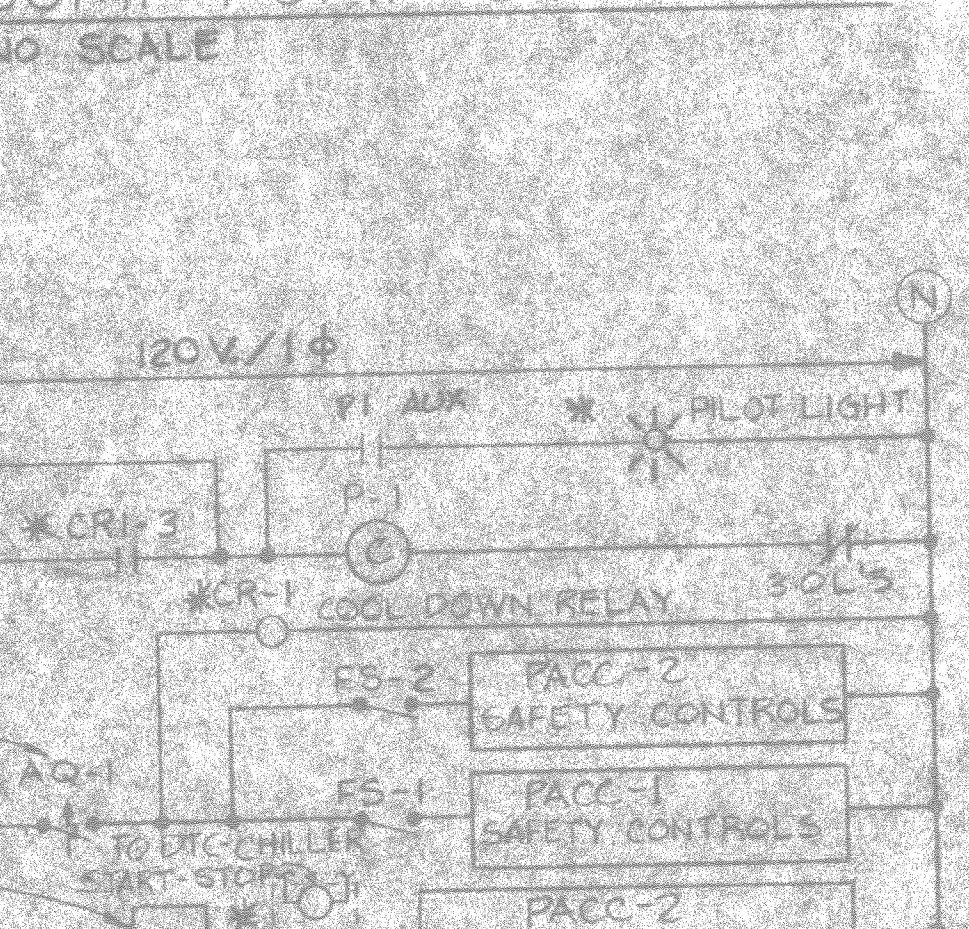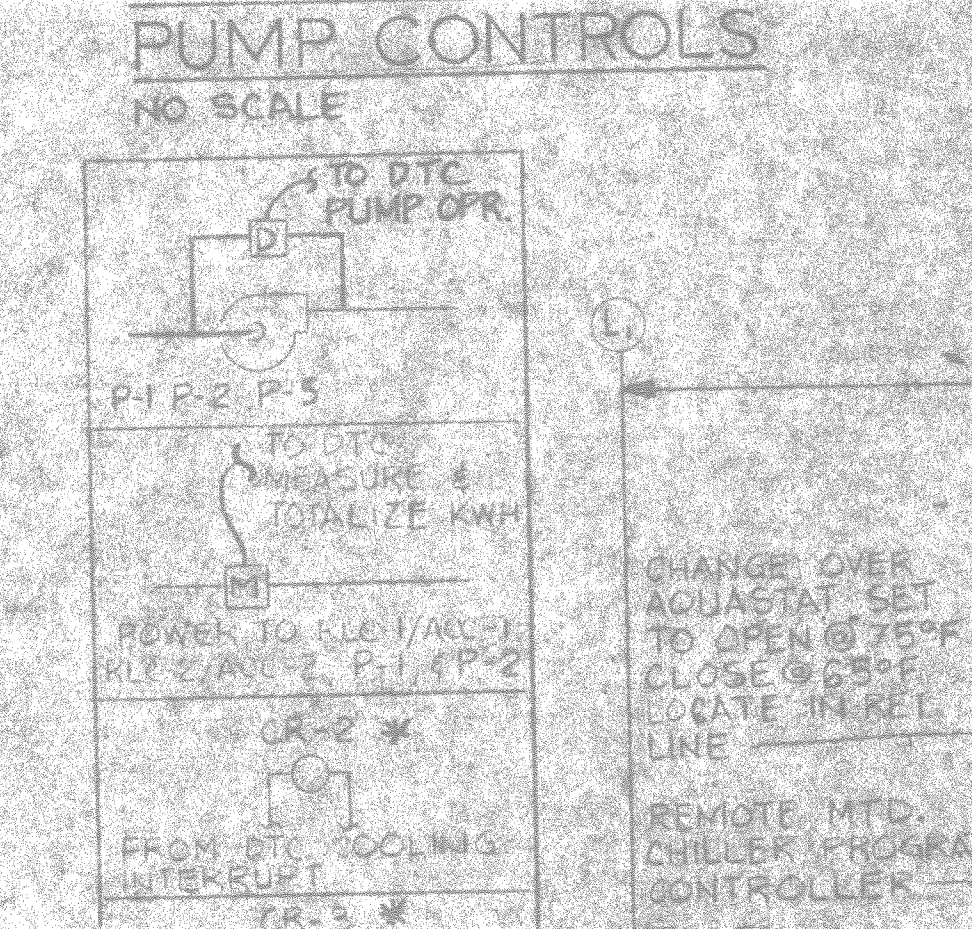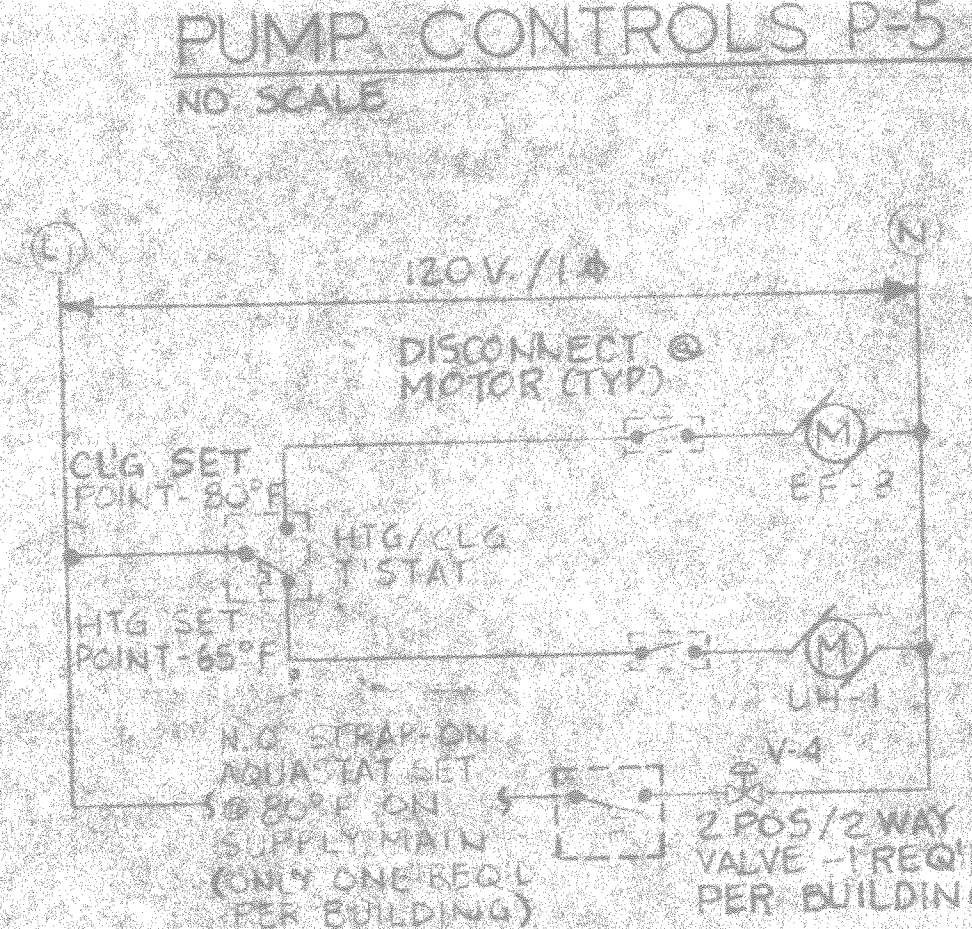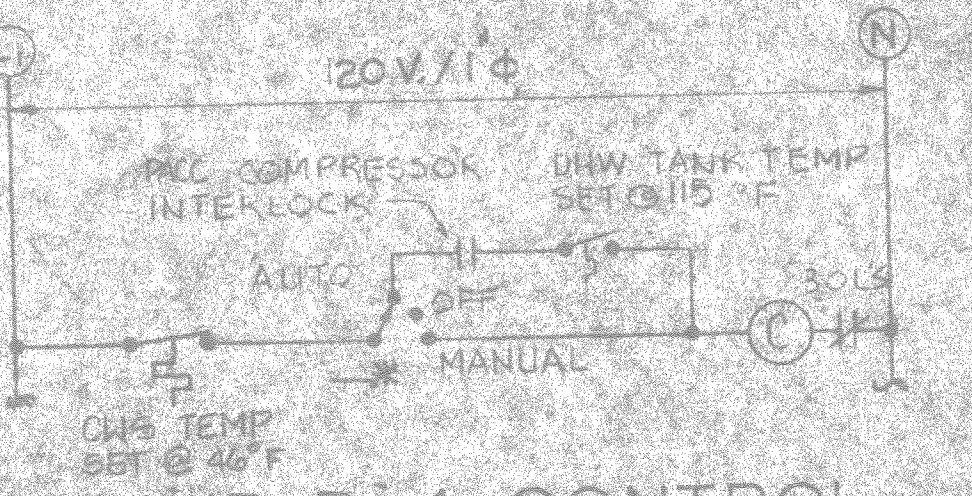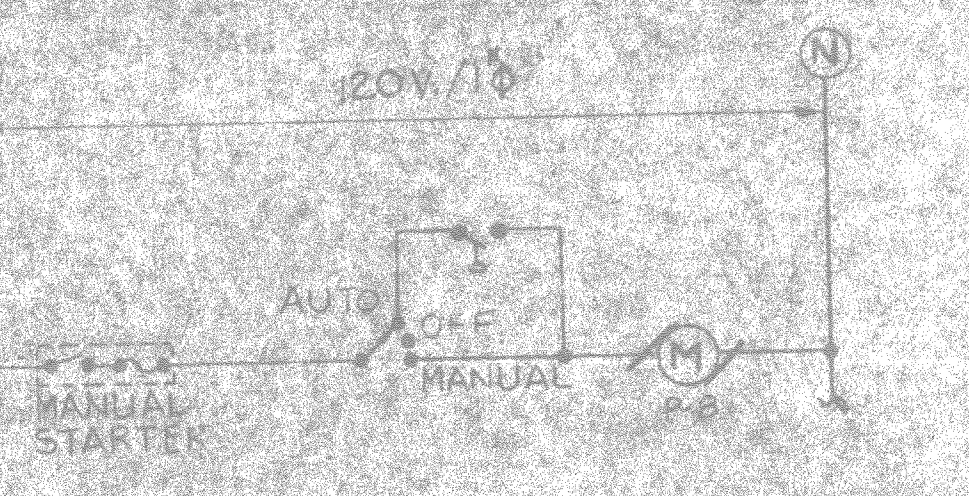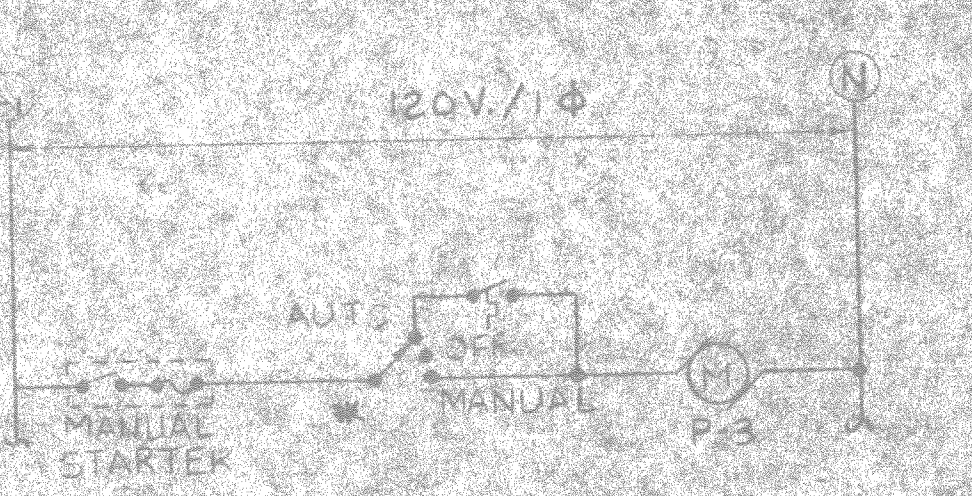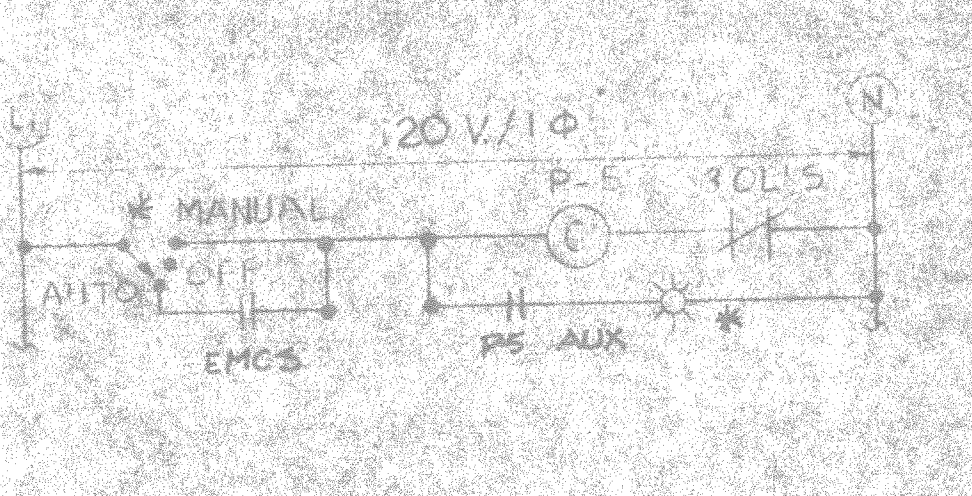





UNIT DESIGNATION	HE-1
TYPE SERVICE	HEATING
BLDG SERVED	HP-300-510
TEMP IN °F	180°
TEMP OUT °F	180°
STEAM PRESS, PSIG	15
STEAM FLOW, LB/HR	4557
WATER FLOW, GPM	426
EXCHANGE TYPE	SHELL/TUBE

NOTES:  
 1 MAX TUBE VEL - 7 FEET PER SECOND  
 2 MAX PRESS DROP - 5 FT WATER GAUGE  
 3 SCALE FACTOR = 0.0005  
 4 1/2" x 40" LONG

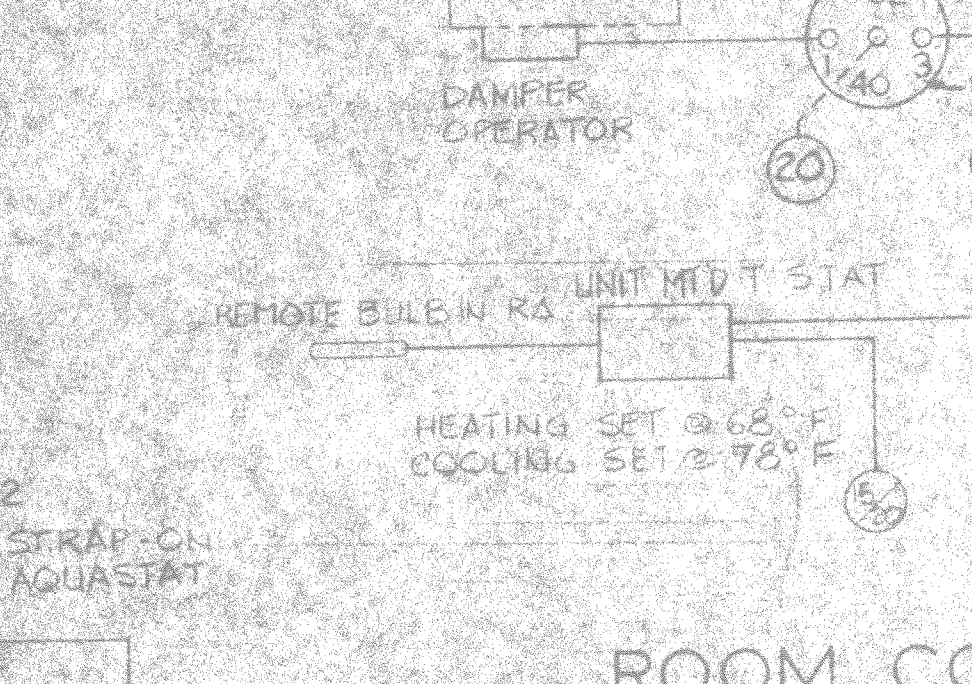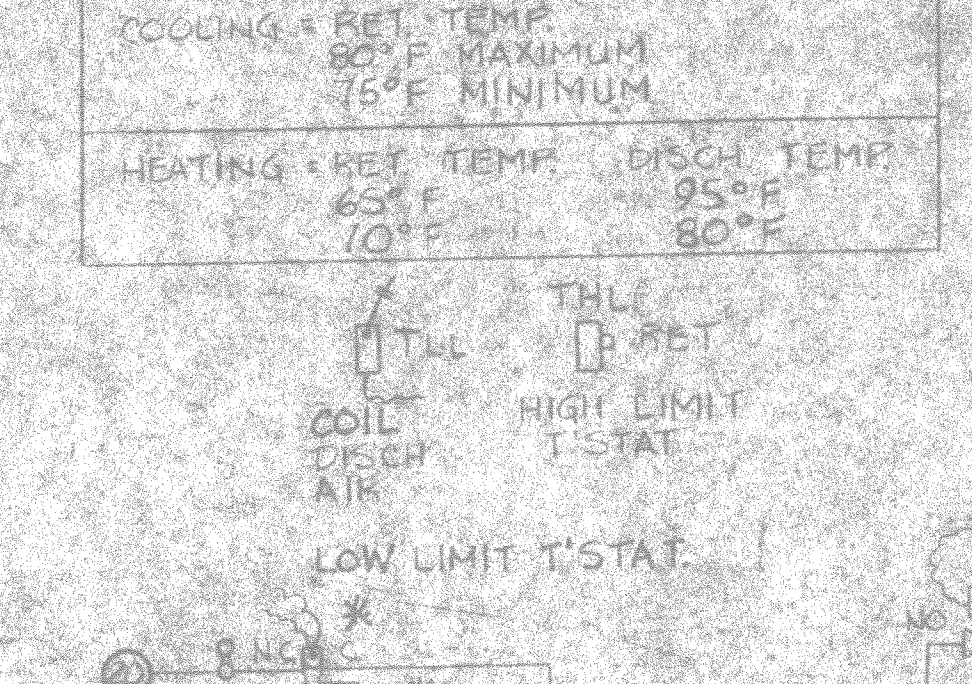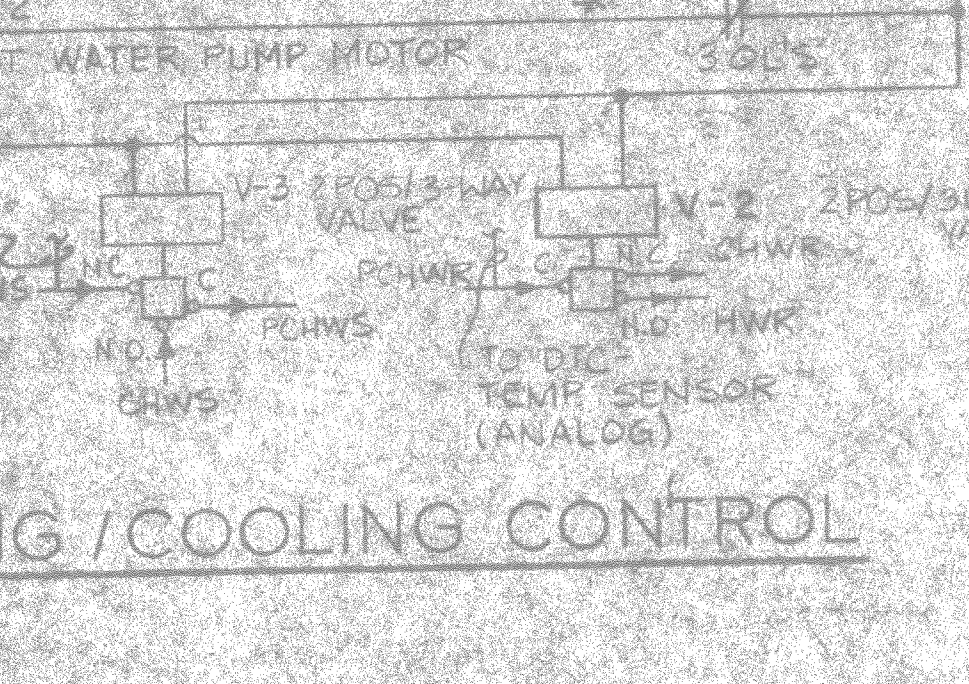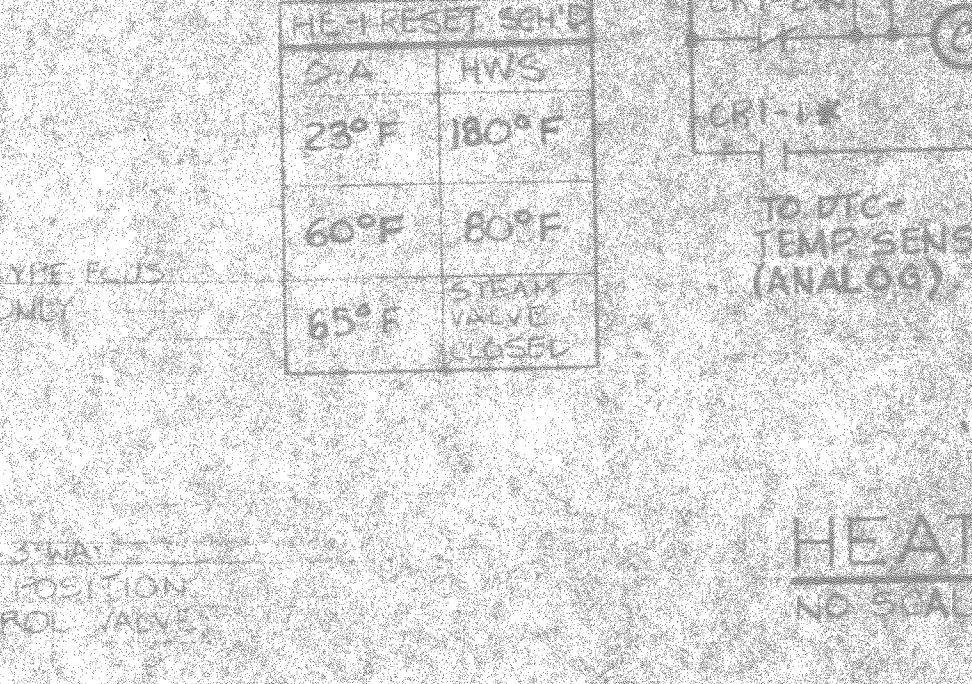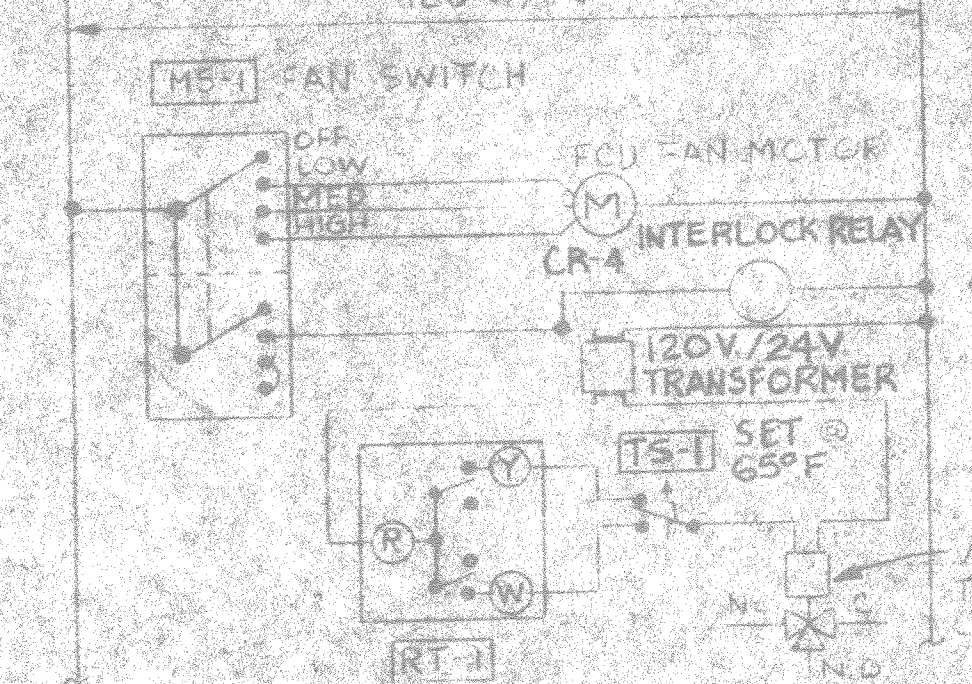

UNIT DESIGNATION	UH-1
AREA SERVED	LAUNDRY
MIN CAP, BTUH	8245
ENT AIR TEMP °F	60
WATER TEMP °F	180
WATER TEMP DROP °F	20
MAX MOTOR HP	1/20
W.B./PASSAGE	120/1160
HEATER TYPE	HORIZONTAL
G.R.M./W.P.D.	1/2

NOTES:  
 1 DIRECTIONAL DISCHARGE DOWN  
 2 500 CFM NOMINAL  
 3 FOLING FACTOR = 0.0005

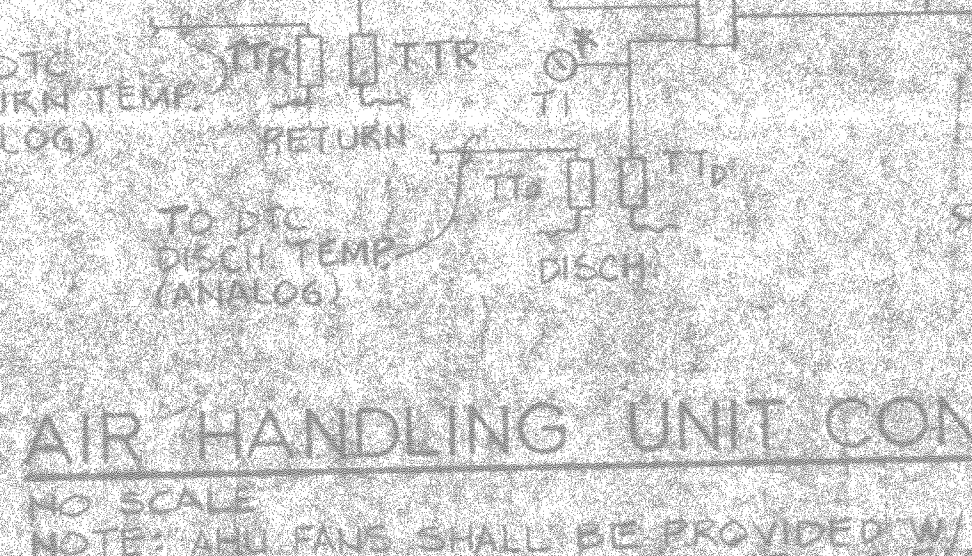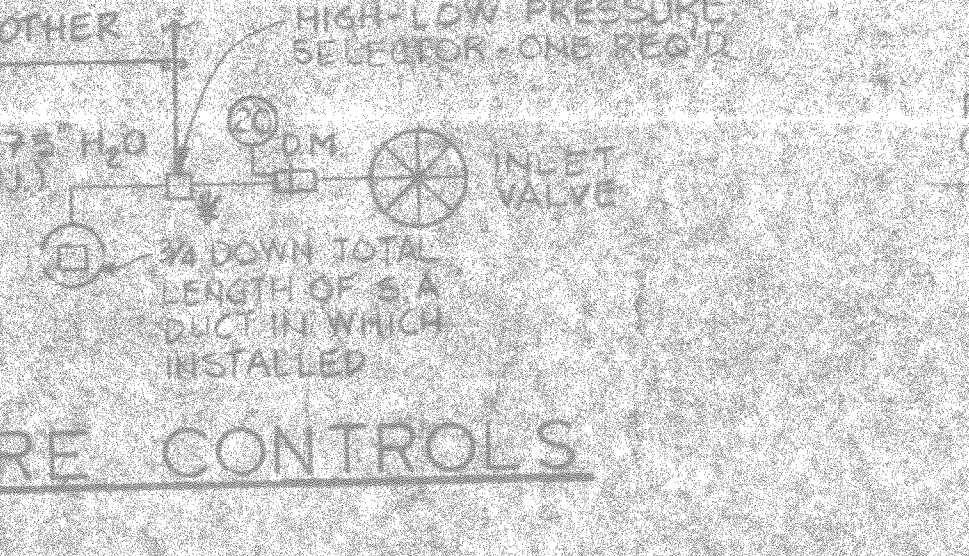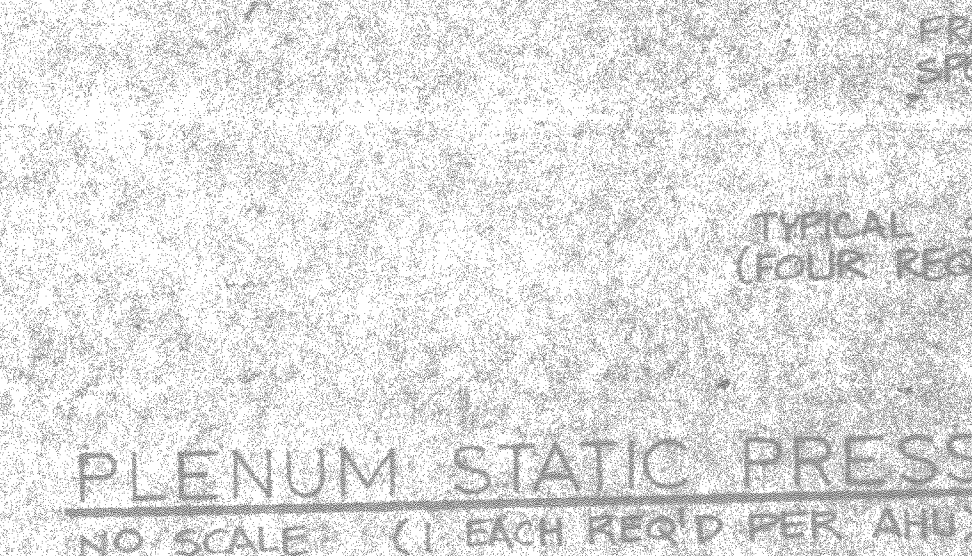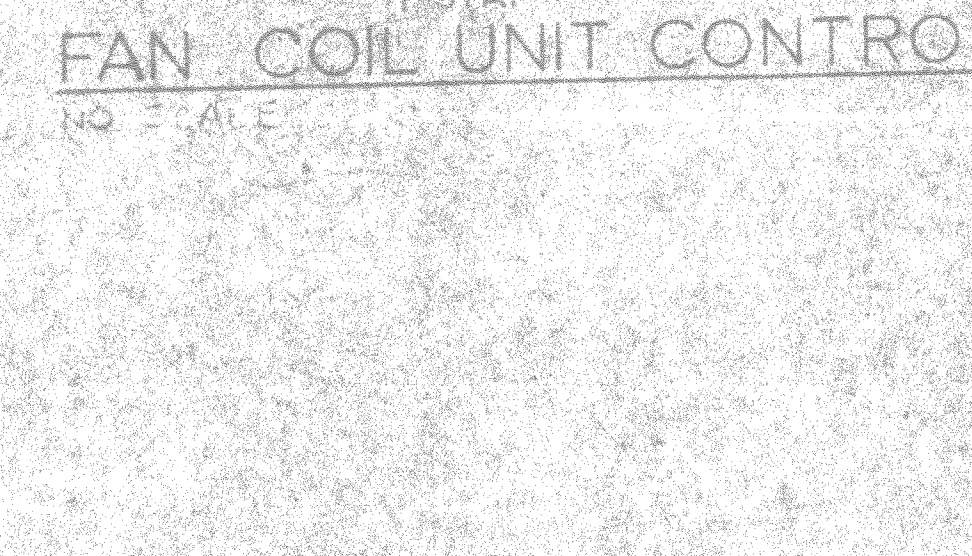

UNIT DESIGNATION	UH-1
AREA SERVED	LAUNDRY
MIN CAP, BTUH	8245
ENT AIR TEMP °F	60
WATER TEMP °F	180
WATER TEMP DROP °F	20
MAX MOTOR HP	1/20
W.B./PASSAGE	120/1160
HEATER TYPE	HORIZONTAL
G.R.M./W.P.D.	1/2

NOTES:  
 1 DIRECTIONAL DISCHARGE DOWN  
 2 500 CFM NOMINAL  
 3 FOLING FACTOR = 0.0005

FAN COIL UNIT SCHEDULE		
UNIT DESIGNATION	①	②
NOTES	1	2
NOMINAL CFM	600	200
COIL SELECTION, GPM	600	200
MAXIMUM CHILLED WATER FLOW GPM	6	1
MINIMUM COIL CAPACITY TOTAL BTUH	17,502	3780
MINIMUM COIL CAPACITY SENSIBLE BTUH	35,020	5130
ENTERING AIR TEMP, DB °F	83.0	78
ENTERING AIR TEMP, WB °F	70.9	65
LEAVING WATER TEMP °F	42	42
MINIMUM COIL CAPACITY TOTAL BTUH	19,894	5832
ENTERING AIR TEMP, DB °F	49.3	68
ENTERING AIR TEMP, WB °F	19.0	18.0
CFM OUTSIDE AIR	250	0
PIPING RUNOUT SIZE, SUPPLY RETURN	1	1
MAXIMUM MOTOR WAYLAGE	35	15
MAXIMUM HOT WATER FLOW, GPM	6	1

NOTES:  
 1 HORIZONTAL TYPE W/ OUTSIDE AIR INTAKE  
 2 VERTICAL TYPE W/ OUTSIDE AIR INTAKE  
 3 SELECT UNITS TO MEET SENSIBLE CAPACITY @ HIGH FAN SPEED  
 4 0.005 FOLING FACTOR  
 5 UNITS ARE 120 V/1ϕ  
 6 MAXIMUM COIL WATER PRESSURE DROP = 150 FT  
 7 MAXIMUM COIL WATER PRESSURE DROP = 50 FT

PACKAGED AIR COOLED CHILLER		
UNIT DESIGNATION	PAC-1	PAC-2
BUILDING SERVED	HP-500 THRU HP-210	HP-500 THRU HP-210
MINIMUM TOTAL CAPACITY, BTUH	107,500	107,500
ENTERING WATER TEMP °F	52	52
LEAVING WATER TEMP °F	42	42
WATER FLOW GPM	25.9	25.9
AMBIENT AIR TEMP, DB °F	83	83
MAXIMUM WATER PRESSURE DROP, FT HG	197	197
MAXIMUM UNIT KW	440/360	440/360
VOLTS/PHASE/HERTZ	440/3/60	440/3/60

CHILLER SHALL HAVE MINIMUM OF 4 STEPS OF CAPACITY REDUCTION  
 COILING FACTOR: 0.0005 STARTERS SUPPLIED BY UNIT MANUFACTURER  
 REFRIGERANT: R-22

PUMP SCHEDULE								
UNIT DESIGNATION	P-1	P-2	P-3	P-4	P-5	P-6	P-7	P-8
TYPE SERVICE	CHILLED WATER	DOM. HW	HEATING	HEATING	HEATING	HEATING	HEATING	HEATING
BLDG SERVED	HP-200-510	HP-200-510	HP-200-510	HP-200-510	HP-200-510	HP-200-510	HP-200-510	HP-200-510
WATER FLOW, GPM	518	426	20	30	55	30	30	20
TOTAL HEAD, FT W.G.	190	80	25	30	55	30	30	20
R.F.M./URMA STR	1750/5	1750/2	1750/00	1750/00	1750/00	3500/00	3500/00	1750/00
MAX MOTOR HP	30	20	1/2	1/2	5	3	3	1/2
VOLTS/PHASE/HERTZ	440/3/60	440/3/60	440/3/60	120/1/60	208/3/60	440/3/60	120/1/60	120/1/60
PUMP TYPE	BASE MTD	BASE MTD	IN-LINE	IN-LINE	IN-LINE	CENTRIFUGAL	CENTRIFUGAL	SUE

EXHAUST FAN SCHEDULE						
UNIT DESIGNATION	EF-1	EF-2	EF-3	EF-4	EF-5	EF-6
HP/PS	1	1	2	1	1	1
AIR FLOW, CFM	120	140	500	210	104	240
TOTAL STATIC PRESSURE IN W.G.	1.05	1.25	1.25	1.25	1.25	1.25
LOCATION	ROOF	ROOF	WALL	ROOF	CEILING	LOUNGE 308
AREA SERVED	WALL CASSET	ELECT ROOM	LAUNDRY	MECH. BLDG.	TOILETS	LOUNGE 308
MAX MOTOR HP	3/4	1/2	1/2	1/2	1/2	1/2
VOLTS/PHASE/HERTZ	120/1/60	120/1/60	120/1/60	120/1/60	120/1/60	120/1/60
FAN TYPE	CENTRIFUGAL	CENTRIFUGAL	PROP.	CENTRIFUGAL	CENTRIFUGAL	LINEAR

NOTES:  
 1 PROVIDE MOTOR OPERATED DAMPER, DISCONNECT SWITCH & BIRD SCREEN  
 2 20 V/1ϕ  
 3 DAMPER & DISCONNECT SWITCH  
 4 PROVIDE ALUMINUM SELF-FLASHING  
 5 MAX SOUND LEVEL TO BE 65 DB  
 6 QUALITY LOCK W/ LIGHT SWITCH  
 7 BIRD SCREEN NOT REQUIRED ON EF-5  
 8 PUMP SCHEDULE NOTES:  
 9 60 DB-2000 SQUARE FEET  
 10 GAS CAL RECEIVER CAPACITY  
 11 COMPLEX W/ CAST IRON RECEIVER  
 12 HIGH ALTERNATOR  
 13 4000 REQ'D \*\*\* FIVE REQ'D

ROOM CONTROL		
UNIT DESIGNATION	RC-1	RC-2
AREA SERVED	LAUNDRY	MECH. BLDG.
MIN CAP, BTUH	8245	8245
ENT AIR TEMP °F	60	60
WATER TEMP °F	180	180
WATER TEMP DROP °F	20	20
MAX MOTOR HP	1/20	1/20
W.B./PASSAGE	120/1160	120/1160
HEATER TYPE	HORIZONTAL	HORIZONTAL
G.R.M./W.P.D.	1/2	1/2

STEAM/HOT WATER HEAT EXCHANGER		
UNIT DESIGNATION	HE-1	
TYPE SERVICE	HEATING	
BLDG SERVED	HP-300-510	
TEMP IN °F	180	
TEMP OUT °F	180	
STEAM PRESS, PSIG	15	
STEAM FLOW, LB/HR	4557	
WATER FLOW, GPM	426	
EXCHANGE TYPE	SHELL/TUBE	

NOTES:  
 1 MAX TUBE VEL - 7 FEET PER SECOND  
 2 MAX PRESS DROP - 5 FT WATER GAUGE  
 3 SCALE FACTOR = 0.0005  
 4 1/2" x 40" LONG

UNIT HEATER SCHEDULE		
UNIT DESIGNATION	UH-1	
AREA SERVED	LAUNDRY	
MIN CAP, BTUH	8245	
ENT AIR TEMP °F	60	
WATER TEMP °F	180	
WATER TEMP DROP °F	20	
MAX MOTOR HP	1/20	
W.B./PASSAGE	120/1160	
HEATER TYPE	HORIZONTAL	
G.R.M./W.P.D.	1/2	

NOTES:  
 1 DIRECTIONAL DISCHARGE DOWN  
 2 500 CFM NOMINAL  
 3 FOLING FACTOR = 0.0005

1. N. PEASE ASSOCIATES  
 ARCHITECTS-ENGINEERS-PLANNERS  
 CHARLOTTE, NORTH CAROLINA

DEPARTMENT OF THE NAVY  
**ATLANTIC DIVISION**  
 NAVAL STATION  
 MARINE CORPS BASE CAMP LEJEUNE, N.C.  
 BACHELOR ENLISTED QUARTERS

DATE: 12-11-86  
 DRAWING NO: 80091  
 SHEET NO: 3-30-87

**CONTROLS & SCHEDULES**  
 4155164  
 80091  
 12-11-86







# AIR HANDLING UNIT SCHEDULE

\*NEMA STARTER SIZE 1,208/3/60

UNIT NO.	LOCATION	FAN DATA					DUAL TEMPERATURE COIL										REMARKS										
		TOTAL CFM	MIN. Q.A. CFM	MIN. CV. CFM	TEMP. (°F)	APPROX. T.S.P. (W.G.)	MIN. H.P. #	COOLING PERFORMANCE DATA					HEATING PERFORMANCE														
							COIL C.F.M.	TOTAL LOAD B.T.U.H.	TOTAL SENS. B.T.U.H.	MAX. FACE VEL. FT./MIN.	ΔT. °F	ΔT. °F	ΔT. °F	ΔT. °F	COIL GRM.	E.L.T. °F	WAT. PD. MAX.	AIR PD. MAX.	MIN. FLOW	COIL C.F.M.	TOTAL LOAD B.T.U.H.	MAX. FACE VEL. FT./MIN.	E.A.T. °F	L.A.T. °F	COIL GRM.	E.L.T. °F	
AHU-1	HP-506-510	4850	200	1700	108	2.5	4850	134680	109998	500	78.5	65.5	57.5	56.3	23.3	45	8	0.7	4	4850	130478	500	66.2	91.1	13.0	180	1 <sup>ST</sup> FLOOR, UNIT H
AHU-2																											2 <sup>ND</sup> FLOOR, UNIT H
AHU-3																											3 <sup>RD</sup> FLOOR, UNIT H
AHU-4		4850		1700	108		4850	134680	109998					23.3						5200	130067		66.3	89.4		180	3 <sup>RD</sup> FLOOR, UNIT H
AHU-5		5200		1880	113		5200	142740	116813					23.8						5200	130067	500	66.3	89.4	13.0	180	3 <sup>RD</sup> FLOOR, UNIT H
AHU-6	HP-506-510	5200	200	1880	110	2.5	5200	142740	116813	500	78.5	65.5	57.5	56.3	23.8	45	8	0.7	4	5200	130067	500	66.3	89.4	13.0	180	3 <sup>RD</sup> FLOOR, UNIT H

REV.	DESCRIPTION	PREP. BY	DATE	APPROVED

## HOT WATER STORAGE GENERATOR

UNIT NO.	SERVICE	LOCATION	STEAM PRESS.	HR/HR	RECOV. WATER	ENT. WATER	LEAVE WATER	GAL	TANK SIZE	ELECT. VOLT	PHASE	REMARKS
DHW-1	HP-506-510	HP-611	15 PSIG	1964	2765	40°F	120°F	4600	800/210	120	3	

FOR CONTROLS & INTEGRAL PUMP


### SEQUENCE OF OPERATION:

- HEATING/COOLING CONTROL: SYSTEM SHALL BE ENERGIZED WHENEVER MANUAL "ON-OFF" SWITCH IS IN "ON" POSITION, AND SYSTEM MODE SHALL BE CONTROLLED BY "COOL-AUTO-HEAT" SELECTOR SWITCH. WITH THE SELECTOR SWITCH IN THE AUTO POSITION, A NORMALLY OPEN THERMOSTAT (T-1), LOCATED IN THE OUTSIDE AIR, SHALL CONTROL THE SYSTEM "CHANGEOVER". ABOVE 65 DEGREES F., OUTSIDE TEMPERATURE THE SYSTEM SHALL BE IN THE COOLING MODE, AND BELOW 65 DEGREES F. THE SYSTEM SHALL BE IN THE HEATING MODE. WHEN SYSTEM IS IN THE HEATING MODE THE HEATING HOT WATER PUMP SHALL BE ENERGIZED AND THE SWITCHOVER 3-WAY VALVES (V-2 AND V-3) SHALL BE IN THE HEATING (NORMALLY OPEN) POSITIONS. WHEN SYSTEM IS IN THE COOLING MODE A REMOTE BULB THERMOSTAT (AO-1), ACTING AS HIGH LIMIT SAFETY, WITH ELEMENT LOCATED IN THE RETURN WATER LINE SHALL PREVENT SYSTEM CHANGEOVER UNTIL WATER TEMPERATURE IS BELOW A PREDETERMINED SETTING (85 DEGREES F. ADJ.). UNTIL CHANGEOVER TEMPERATURE IS MAINTAINED, HOT WATER PUMP SHALL CONTINUE TO OPERATE WITHOUT SHORT CYCLING. CIRCULATING WATER FOR COOL DOWN, AND THE CONVERTER STEAM VALVE V-1 SHALL BE MAINTAINED IN THE CLOSED POSITION DURING COOLING MODE. RELAY (CR-1) SHALL BE ENERGIZED WHEN (AO-1) CLOSURE, TO START CHILLED WATER PUMP, STOP HOT WATER PUMP, AND POSITION 3-WAY VALVES (V-2 AND V-3), TO COOLING MODE.
- CHILLER CONTROL: THE AIR COOLED WATER CHILLER SHALL HAVE SELF-CONTAINED CONTROLS WHICH WILL START ON A DEMAND FOR COOLING, AND FLOW SWITCHES (FS-1 AND FS-2) SHALL BE INTERLOCKED TO PREVENT CHILLERS FROM STARTING UNLESS THERE IS PROOF OF FLOW IN THE CHILLED WATER LINE. AN ELECTRICAL INTERLOCK BETWEEN CHILLED WATER PUMP AND CHILLER SHALL PREVENT CHILLER FROM STARTING UNLESS PUMP IS ENERGIZED. THE TEMPERATURE CONTROLLER SHALL ARRANGE THE UNLOADING STAGES TO PREVENT SHORT CYCLING OF EITHER MACHINE AND MAINTAIN SYSTEM CHILLED WATER TEMPERATURE WITHIN PLUS OR MINUS 0.2 DEGREES F. OF THE SYSTEM DESIGN. CHILLER CONTROL SEQUENCER SHALL ALLOW LEAD MACHINE TO OPERATE UP TO GREATER THAN 50 PERCENT (ADJUSTABLE) OF THE SYSTEM LOAD BEFORE ENERGIZING THE SECOND MACHINE. AS THE TOTAL LOAD DECREASES, THE LAG MACHINE SHALL REMAIN IN OPERATION UNTIL LESS THAN 50 PERCENT (ADJUSTABLE) OF THE SYSTEM LOAD IS REACHED. MACHINE SHALL HAVE A LEAD-LAG SELECTOR SWITCH. THE LEAVING WATER TEMPERATURE FROM EITHER MACHINE SHALL NOT FALL BELOW 58 DEGREES F. OR MANUFACTURER'S RECOMMENDATIONS, WHICHEVER IS HIGHER.
- AIR HANDLER UNIT CONTROL (FOR EACH A.H. UNIT): UNITS SHALL BE STARTED AND STOPPED MANUALLY.
  - THE AH UNIT AND ROOM CONTROLS SHALL BE INDEXED FOR HEATING OR COOLING FROM A SENSOR (AO-2) IN THE CV/WH SUPPLY PIPING FROM CENTRAL SYSTEM. WHEN 75 DEGREES F. OR ABOVE WATER TEMPERATURE IS SENSED, THE SYSTEM SHALL BE INDEXED FOR HEATING. WHEN 65 DEGREES F. OR BELOW WATER IS SENSED, THE SYSTEM SHALL BE INDEXED FOR COOLING.
  - WITH AH UNITS OPERATING AND SYSTEM INDEXED FOR HEATING, THE RETURN AIR SENSOR SHALL RESET THE DISCHARGE AIR TEMPERATURE OVER A PREDETERMINED SCHEDULE. ON A FALL IN DISCHARGE TEMPERATURE, CONTROLLER (RC) SHALL REPOSITION THREE-WAY VALVE (V-6) SUPPLYING HOT WATER TO THE UNIT COIL.
  - WITH THE AH UNIT OPERATING AND SYSTEM INDEXED FOR COOLING, THE DISCHARGE AIR CONTROLLER (YTD) SHALL BE AUTOMATICALLY SET TO MAINTAIN 55 DEGREE F. CONSTANT DISCHARGE AIR TEMPERATURE. THE RETURN AIR SENSOR SHALL BE LOCKED OUT.
  - PROVIDE A TEMPERATURE LOW LIMIT THERMOSTAT (TLL) TO SHUT THE AH UNIT DOWN AT 38 DEGREES F.
  - PROVIDE A TEMPERATURE HIGH LIMIT THERMOSTAT (THL) TO SHUT THE AH UNIT DOWN AT 135 DEGREES F.
  - ROOM CONTROL: WITH THE ROOM THERMOSTAT INDEXED FOR HEATING, THE ROOM THERMOSTAT SHALL ON A FALL IN TEMPERATURE MODULATE THE TAB SUPPLY AIR DAMPER, OPEN SIMULTANEOUSLY CLOSING THE ROOM RETURN AIR DAMPER. WITH THERMOSTAT INDEXED FOR COOLING, THE THERMOSTAT SHALL ON A RISE IN TEMPERATURE MODULATE TO OPEN THE TAB SUPPLY AIR SIMULTANEOUSLY CLOSING THE ROOM RETURN. INDEXING FOR HEATING AND COOLING SHALL BE AUTOMATIC BY CENTRAL SOURCE.


- AN UNIT STATIC PRESSURE CONTROL: A STATIC PRESSURE CONTROL (SPO) SHALL BE PROVIDED FOR EACH SUPPLY PLENUM (FOUR PER AH UNIT) WITH THE SENSING TIPS LOCATED IN THE SUPPLY PLENUM 3/4 DOWN TOTAL LENGTH OF SUPPLY AIR DUCT IN WHICH INSTALLED AND IN THE AH EQUIPMENT ROOM. ON A RISE IN STATIC ABOVE THE CONTROLLER SETPOINT (1-75 INCH ADJ.) THE CONTROLLER SHALL MODULATE THE INLET VALVE ON THE AH UNIT FAN, THROUGH A HIGH-LIMIT PRESSURE SELECTOR (ONE PER AH UNIT). THE CONTROLLER SET POINT IS ADJUSTABLE.
- HOT WATER STORAGE HEATERS: A SELF-CONTAINED CONTROL VALVE WITH A CAPILLARY BULB IN THE DOMESTIC HOT WATER TANK SHALL MODULATE THE NORMALLY CLOSED STEAM VALVE TO CONTROL THE WATER TEMPERATURE SET AT 110 DEGREES F. DOMESTIC WATER CIRCULATION PUMP P-3 SHALL BE CONTROLLED AUTOMATICALLY BY AQUASTAT LOCATED IN DOMESTIC HOT WATER RETURN SET AT 110 DEGREES F. AND WHEN TEMPERATURE DROPS BELOW 110 DEGREES F. WILL START PUMP P-3. A SELF-CONTAINED TEMPERING VALVE V-8 SET AT 110 DEGREES F. WITH BULB LOCATION IN THE DOMESTIC HOT WATER SUPPLY LINE SHALL MAINTAIN THE DESIRED DOMESTIC HOT WATER TEMPERATURE TO THE BUILDINGS.
- EX-1 AND EX-2 EXHAUST FAN CONTROL: WITH HIGH LIMIT THERMOSTAT AND DISCONNECT SWITCH CLOSED, EXHAUST FAN RUNS CONTINUOUSLY.
- ENERGY MONITORING CONTROL SYSTEM (EMCS): A CENTRAL ENERGY MANAGEMENT AND CONTROL SYSTEM WILL BE INSTALLED IN THE FUTURE WHICH WILL CONNECT BUILDINGS HP-506, HP-507, HP-508, HP-509, & HP-510 AND THE MECHANICAL BUILDING HP-511. DATA TERMINAL UNITS (DTU) SHALL BE FURNISHED THAT WILL INCORPORATE THE FOLLOWING POINTS INTO THE EMS. ALL EQUIPMENT SHALL BE COMPATIBLE FOR CONNECTING TO THE FUTURE FIELD INTERFACE DEVICE AND TO THE CENTRAL SYSTEM.
  - MECHANICAL BUILDINGS:
    - CHILLED/HOT WATER SUPPLY AND RETURN -- TEMPERATURE SENSOR (DEGREE F) AND FLOW (GPM)
    - CHILLER PACC-1 -- START-STOP, ALARMS STATUS, CHILLED WATER RESET AND CHILLER PROFILE AND SELECT
    - CHILLER PACC-2 -- START-STOP, ALARMS STATUS, CHILLED WATER RESET AND CHILLER PROFILE AND SELECT
    - STEAM LINE -- MEASURE STEAM FLOW (LBS./HOUR) (CORTEX)
    - STEAM LINE -- TOTALIZE STEAM FLOW
    - ELECTRICAL ENERGY -- MEASURE AND TOTALIZE KWH, KND, CHILLER PACC-1 AND 2, P-1 AND P-2
    - MONITOR HEAT OR COOL CONTROL POSITION
    - PUMPS NO. 1 AND 2 -- MONITOR OPERATION, START-STOP (FOR DEMAND LIMITING)
  - DEPH BUILDINGS:
    - POINTS LISTED ARE REQUIRED IN EACH BUILDING
    - MEASURE TEMPERATURE OF SUPPLY AND RETURN AIR TEMPERATURE OF EACH AIR HANDLER (6 PER BUILDING)
    - BUILDING AIR HANDLERS (6 PER BUILDING) START-STOP FOR DEMAND LIMITING AND DUTY CYCLING, FAN STATUS
    - HUMIDITY MONITORING, EACH BUILDING AIR HANDLERS, (6 PER BUILDING)
    - TERMINAL AIR BLENDER CONTROL (ONE PER AIR HANDLING UNIT) -- HIGH AND LOW TEMPERATURE
  - PUMP P-3 CONTROL (TYPICAL FOR FOUR PUMPS) PUMP P-3 SHALL BE ENERGIZED WHEN THE TEMPERATURE OF THE WATER IN THE DOMESTIC HOT WATER TANKS BEGINS TO FALL BELOW 115 DEGREES F. HOWEVER, THE PUMP SHALL BE STOPPED BEHIND THE PUMP. THE TANK TEMPERATURE SHALL NOT BE STOPPED UNTIL THE PUMP WITH NOT OPERATE UNLESS THE CHILLED WATER TEMPERATURE IN THE RETURN LINE IS BELOW 58 DEGREES F. OR MANUFACTURER'S RECOMMENDATIONS, WHICHEVER IS HIGHER.

## CONTROL VALVE SCHEDULE


MARK	UNIT SERVED	SERVICE	TYPE	ACTION	CAPACITY LBS./HR.	GPM	STEAM PRESS. INLET	STEAM PRESS. OUTLET	C.V.	MAX. HP D. FT. H <sub>2</sub> O	NORMAL SIZE	LOCATION	
PRV-1		STEAM	2-WAY	MODULATING	1964		150	25	5.0		1"	MECHANICAL BUILDING	
PRV-2		STEAM	2-WAY		4557		150	25	11.5		1 1/2"	MECHANICAL BUILDING	
PRV-3	EJECTOR PUMPS	STEAM	2-WAY		800		150	75	3.4		3"	STEAM PITS	
V-1	HE-1	STEAM	2-WAY	MODULATING	4557		25	15	85		3"	MECHANICAL BUILDING	
V-2	CHANGE OVER	CHWR	3-WAY	Z POSITION			345			19.0	7	4"	MECHANICAL BUILDING
V-3	CHANGE OVER	CHWR	3-WAY				346			19.0	7	4"	BEG LOUNGES
V-4	UNIT HEATER	CHWR	2-WAY				3			6.3	1.6	1/2"	BEG LOUNGES
V-5	FCU (D)	CHWR	3-WAY				6			3.5	7	1/2"	BEG OFFICES
V-6A	FCU (C)	CHWR	3-WAY	Z POSITION			1			0.4	7	1/2"	BEG TOP FLOOR
V-7	AHU-5 & 6	CHWR	3-WAY	MODULATING			23.8			15.3	7	1 1/2"	BEG 1 <sup>ST</sup> & 2 <sup>ND</sup> FLOOR
V-8A	AHU T-1	CHWR	3-WAY				23.3			13.3	7	1 1/2"	MECHANICAL BUILDING
V-7	DHW (1)	STEAM	2-WAY		1964		25	15	35		2"	MECHANICAL BUILDING	
V-8	DHW (1)	DHW	3-WAY	MODULATING	475					330	7	6"	MECHANICAL BUILDING

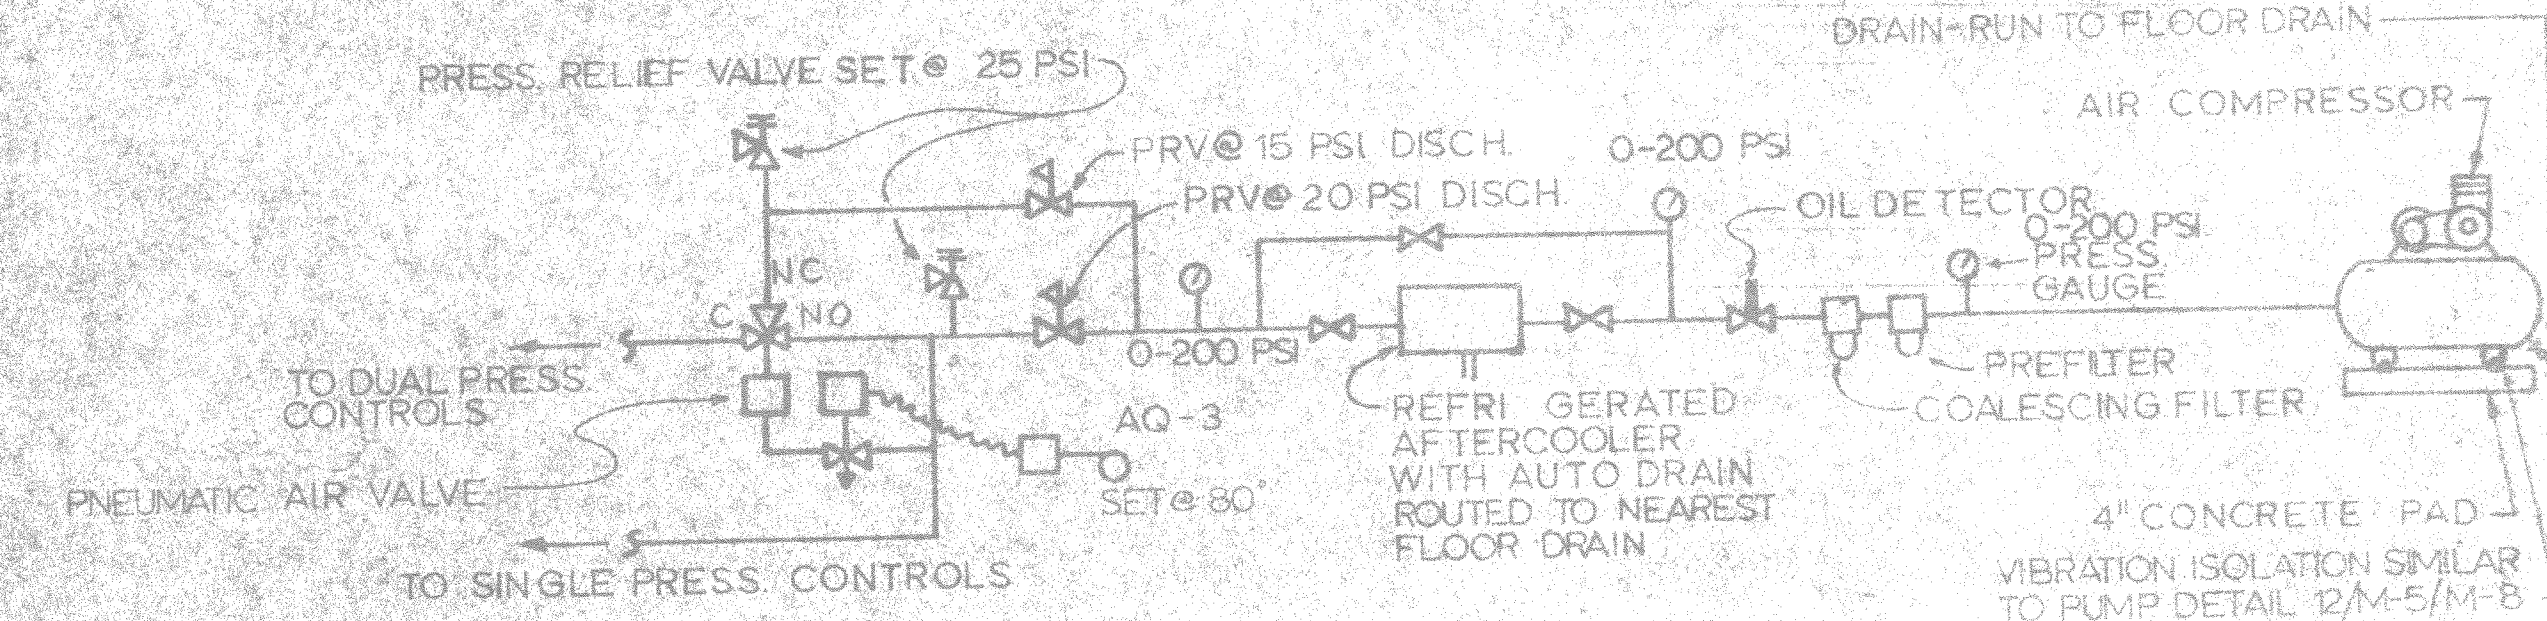

DETAIL CONTROL AIR COMPRESSOR NO SCALE

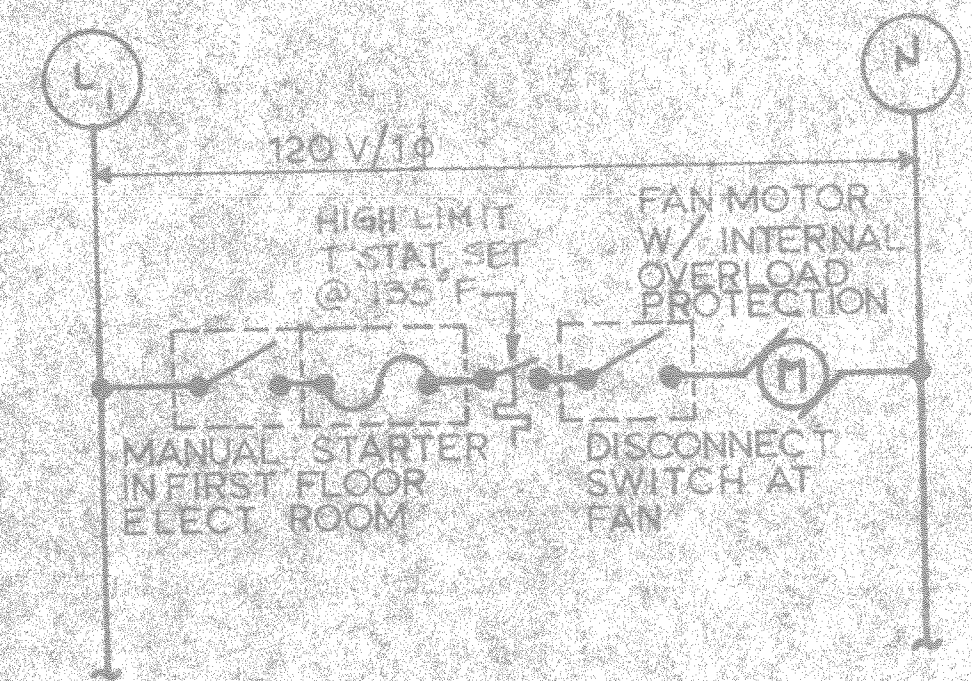

FAN EF-1 CONTROL (TYP FOR EF-2) NO SCALE

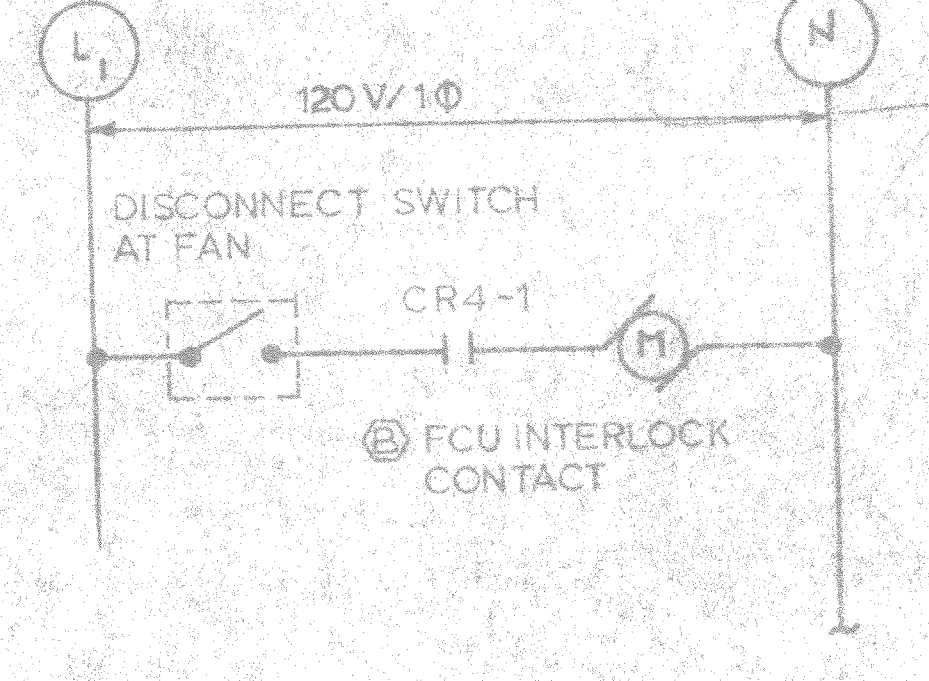

FAN EF-6 CONTROL NO SCALE

**M-9**

**ATLANTIC DIVISION**

MARINE CORPS BASE CAMP LEJEUNE, N.C.  
BACHELOR ENLISTED QUARTERS

**CONTROLS & SCHEDULES**

F 80091

DRAWN BY: [Signature] DATE: 10-30-81

CHECKED BY: [Signature] DATE: 11-18-81

SCALE: AS SHOWN

PROJECT NO. 05-85-5142


DATE: 11-18-81

253193









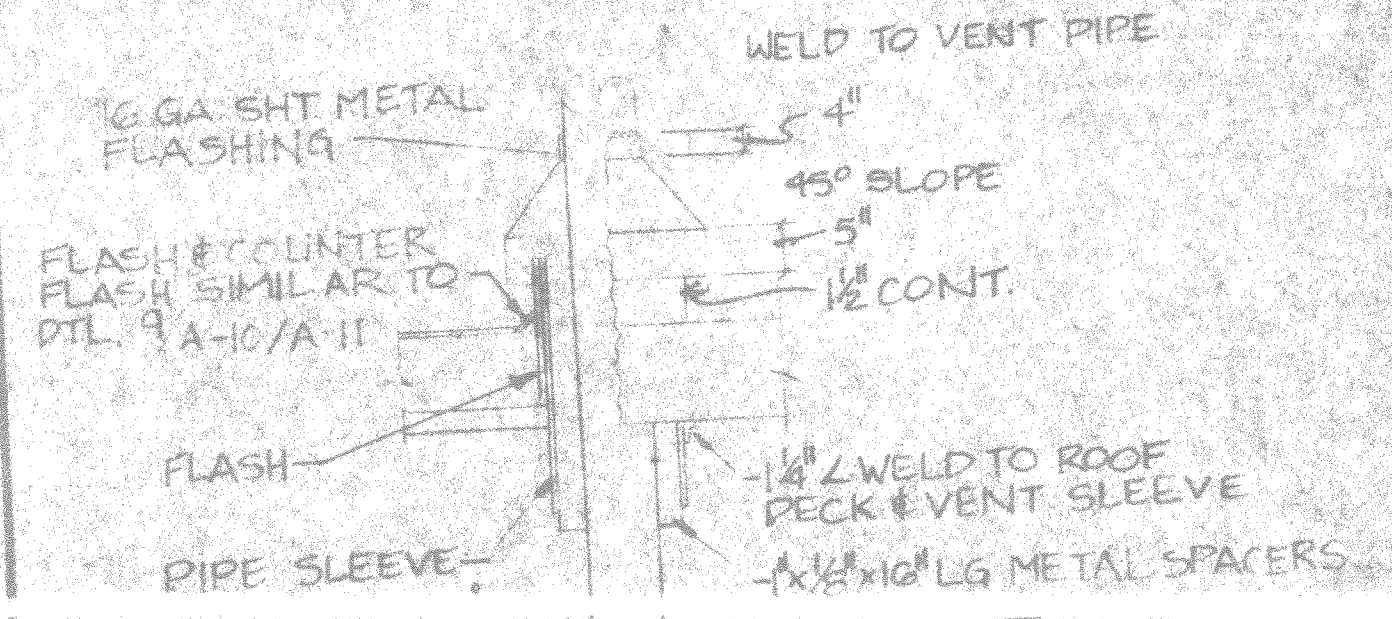


1.5/16" DETAIL - HOT VENT  
NO SCALE

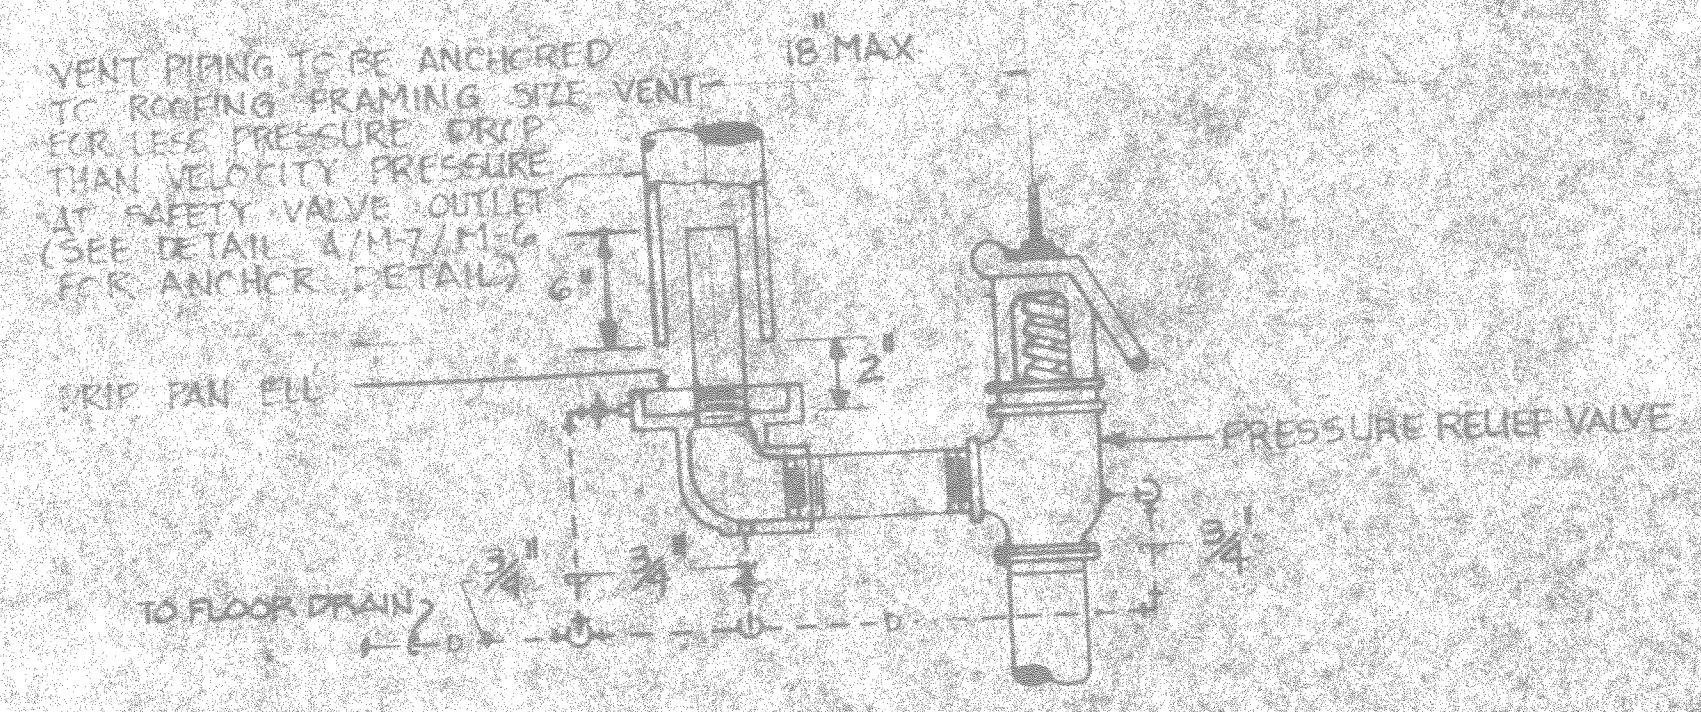


2.5/16" DETAIL - DRIP PAN FILL  
NO SCALE

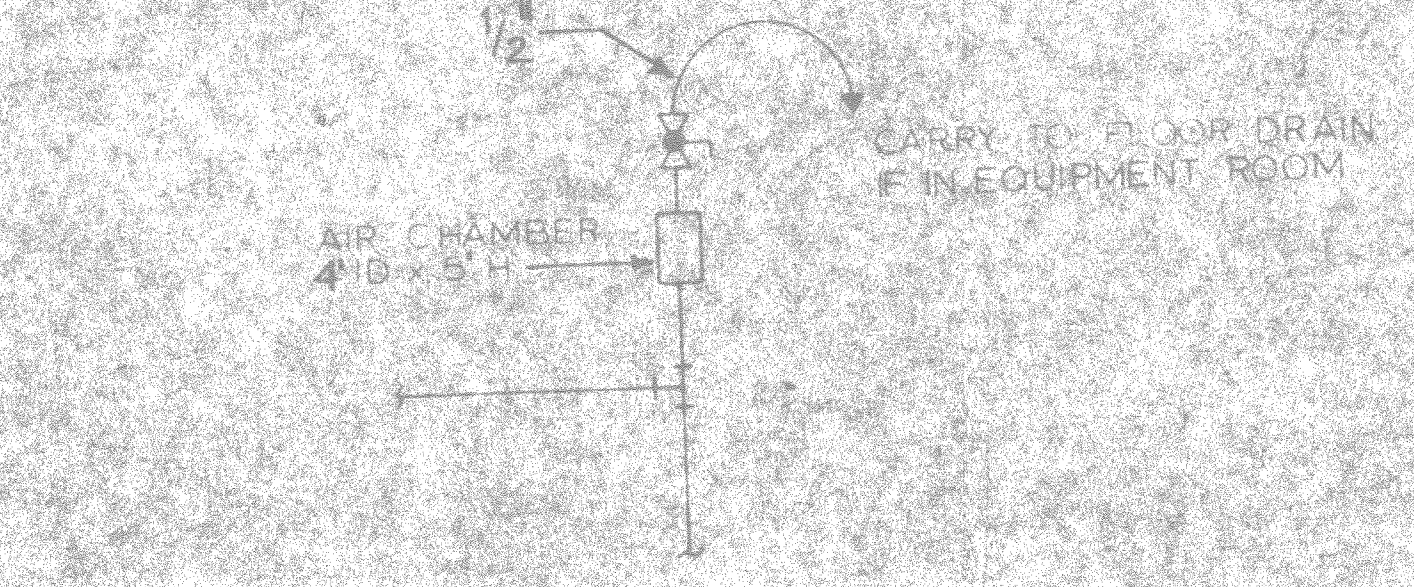


3.5/16" DETAIL - MANUAL AIR VENT  
NO SCALE

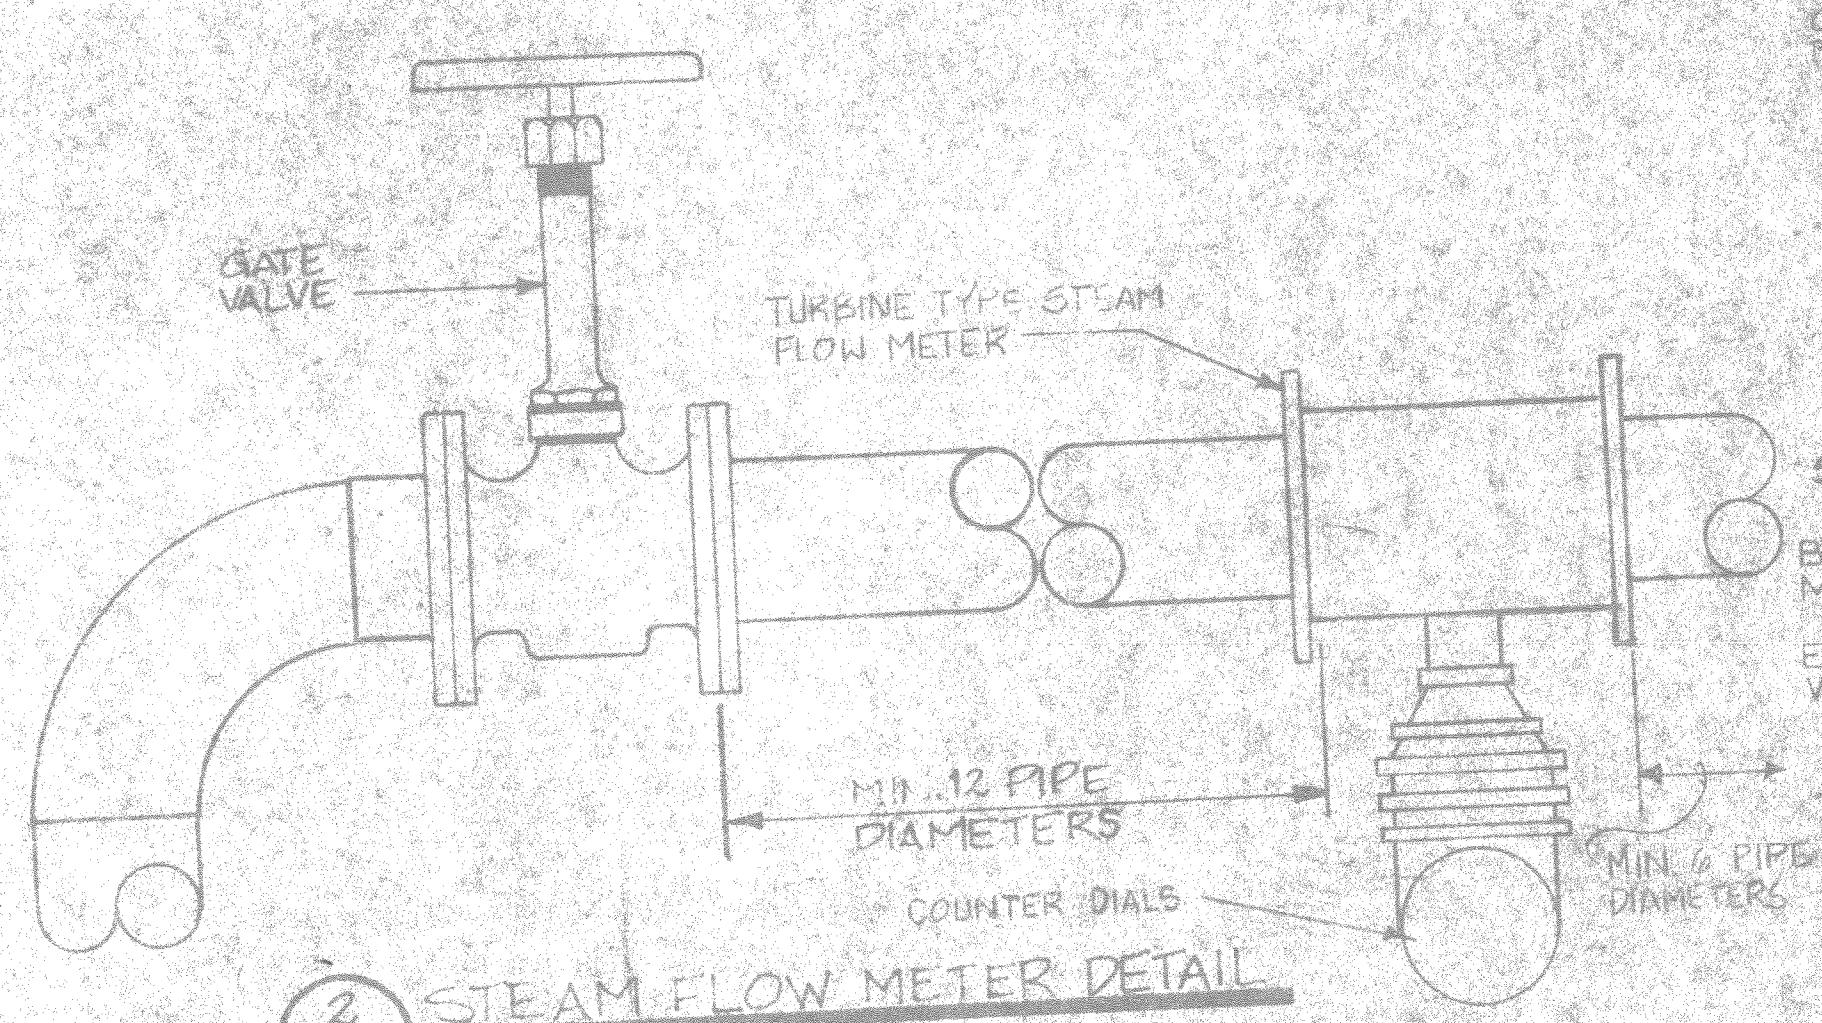


2.5/16" STEAM FLOW METER DETAIL  
NO SCALE

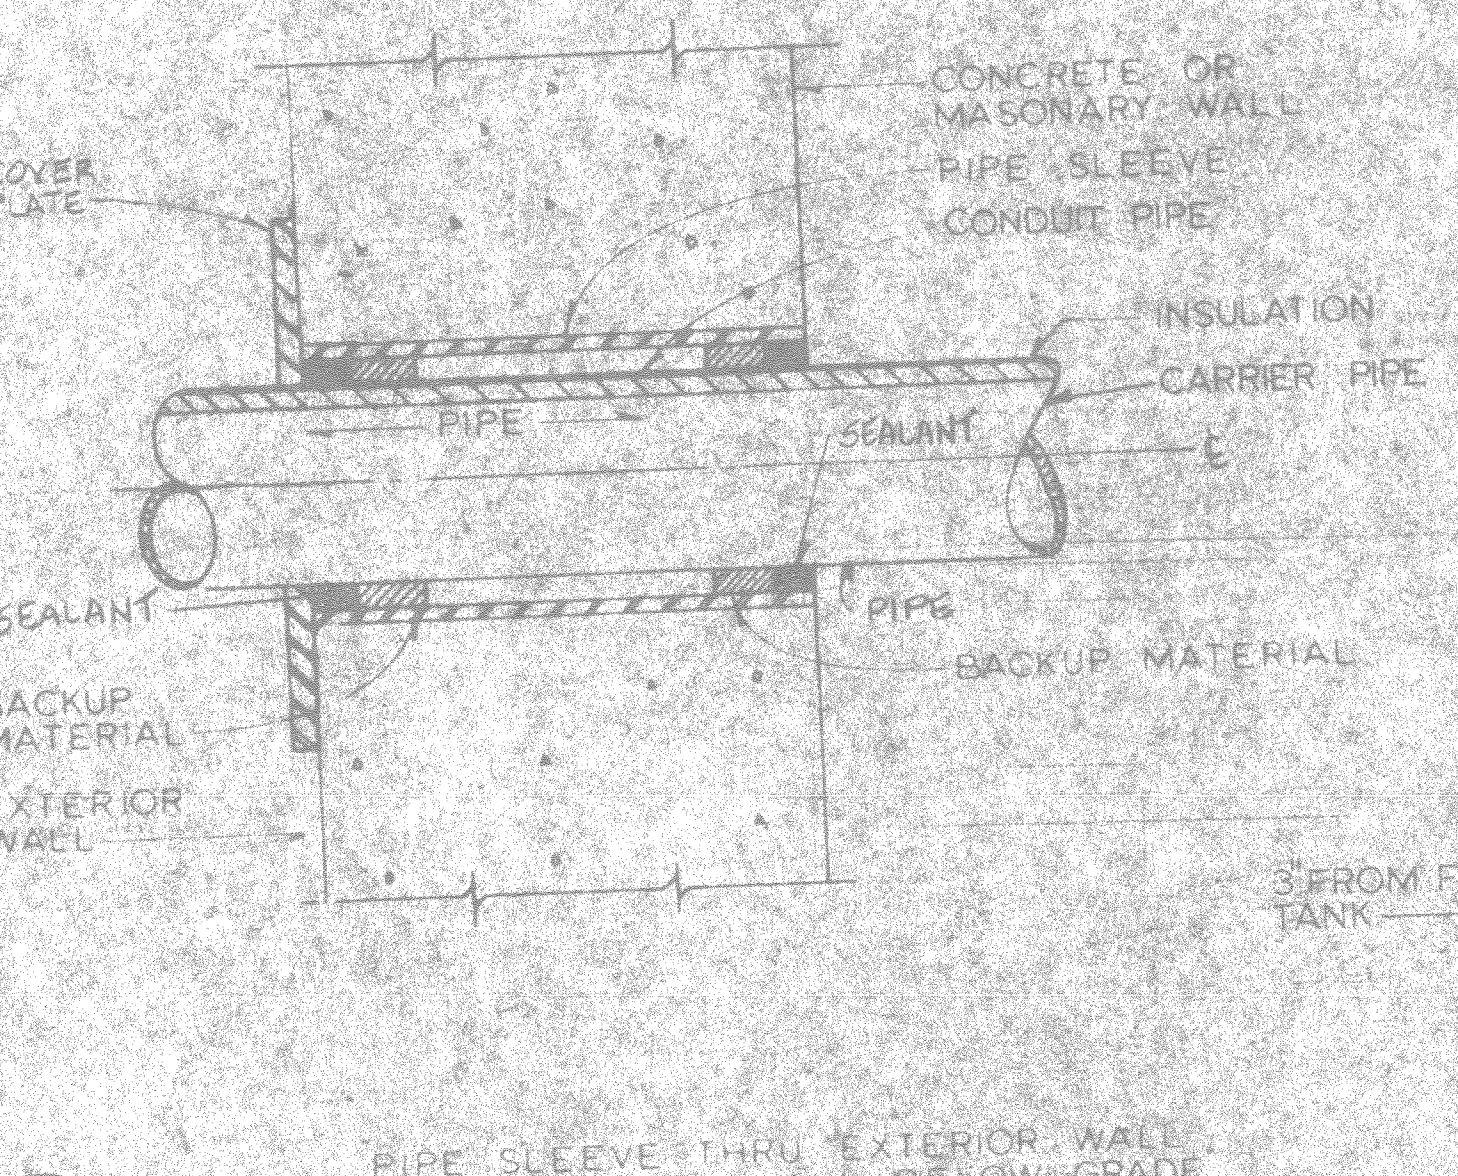


5.5/16" DETAIL - PIPE SLEEVE THRU EXTERIOR WALL OR FOUNDATION WALL BELOW GRADE  
NO SCALE

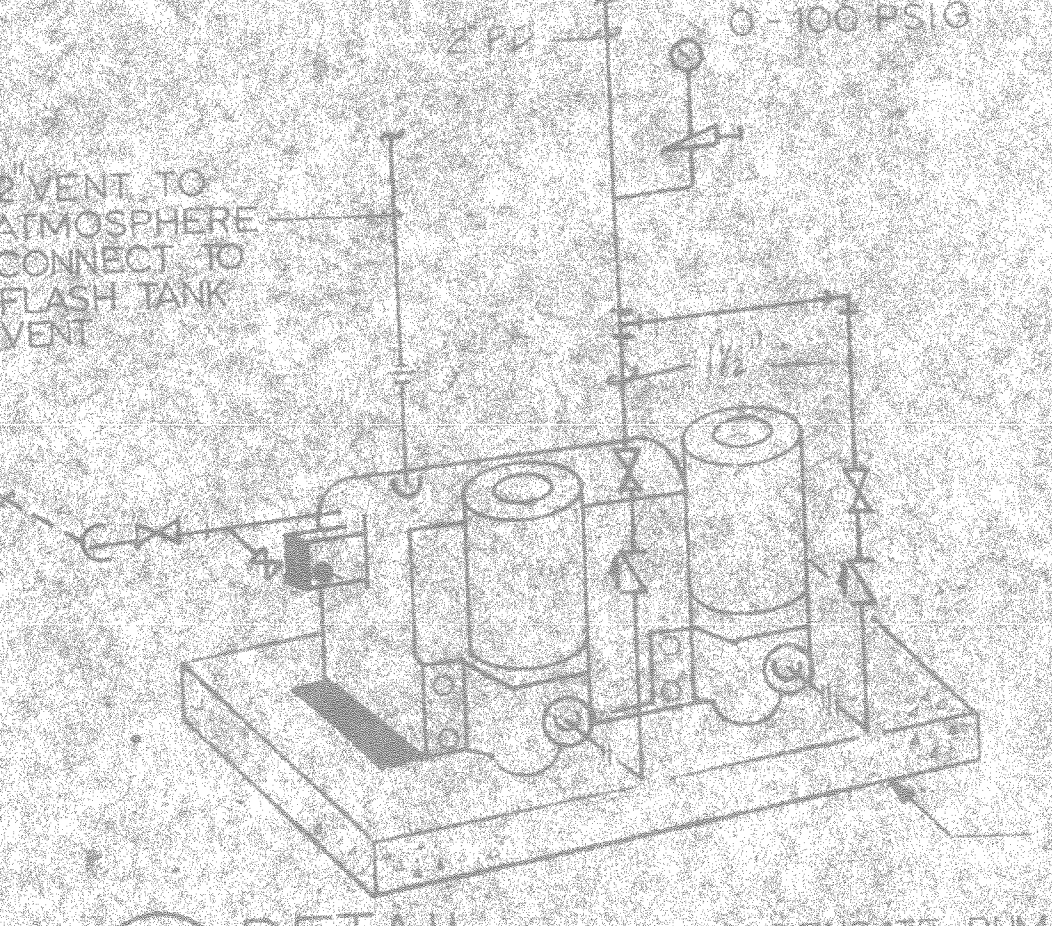


9.5/16" DETAIL - DUPLEX CONDENSATE PUMP  
NO SCALE

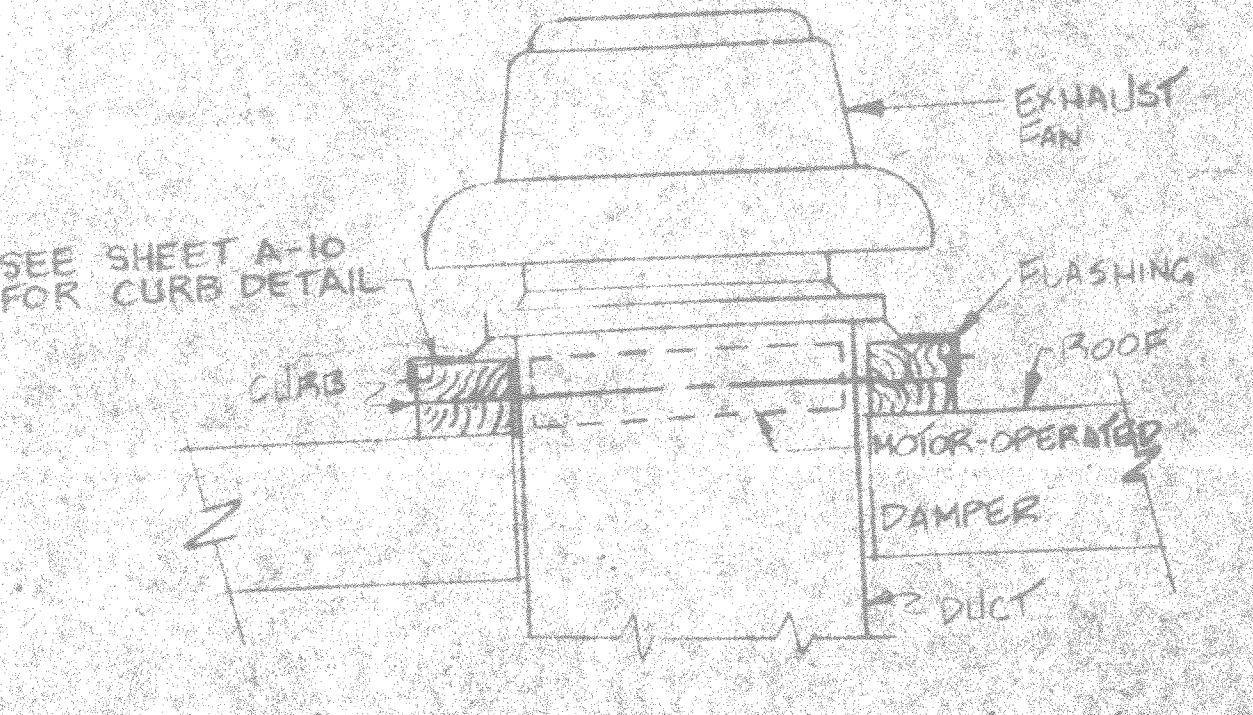


3.5/16" DETAIL - ROOF EXHAUST FAN INSTALLATION  
NO SCALE

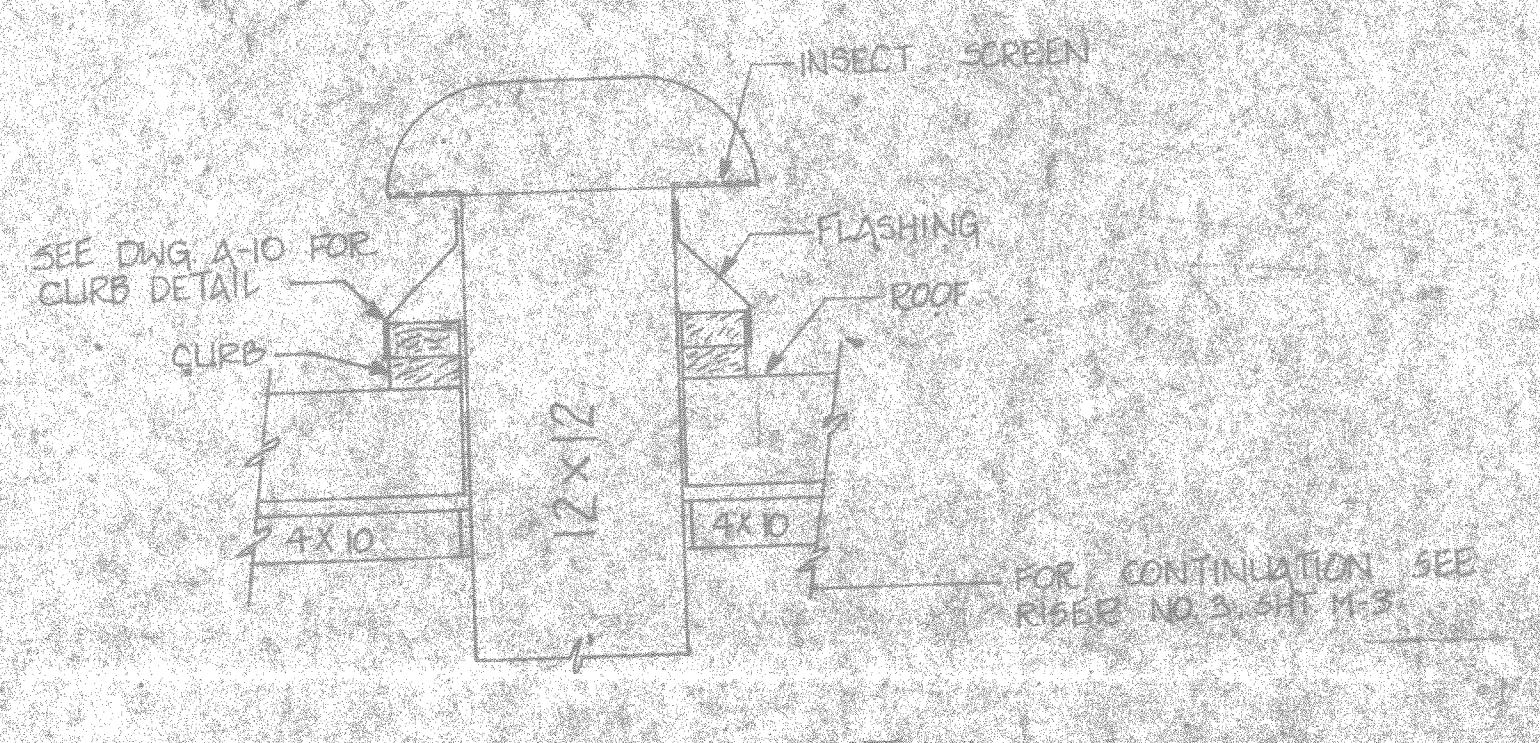


6.5/16" EXHAUST HOOD DETAIL  
NO SCALE

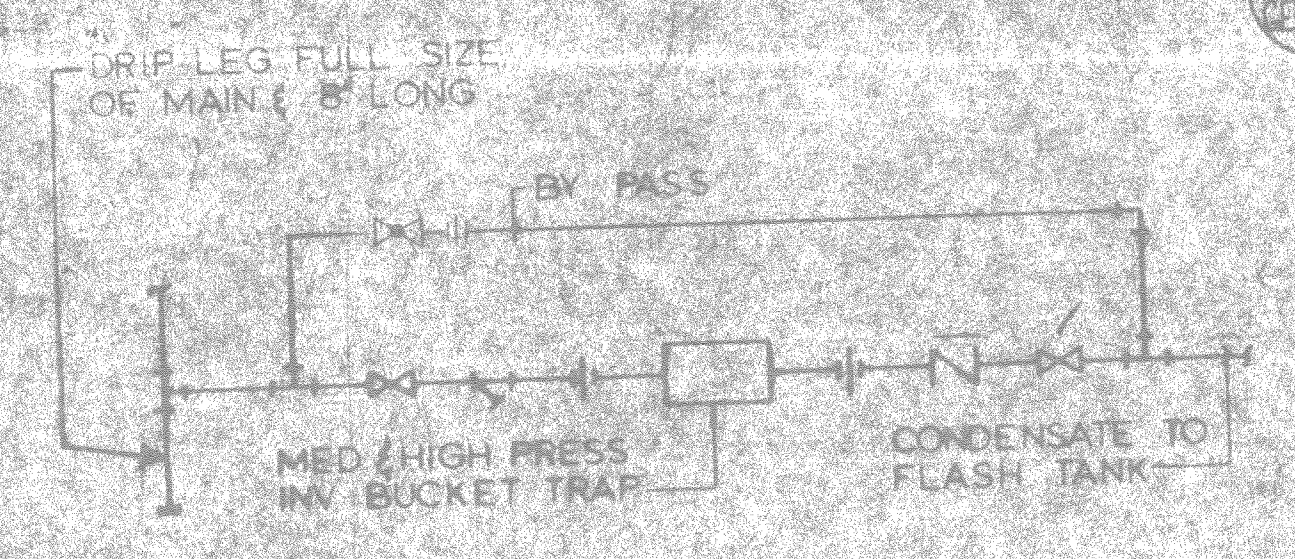


10.5/16" DETAIL - MED/HIGH PRESSURE DRIP ASSEMBLY  
NO SCALE

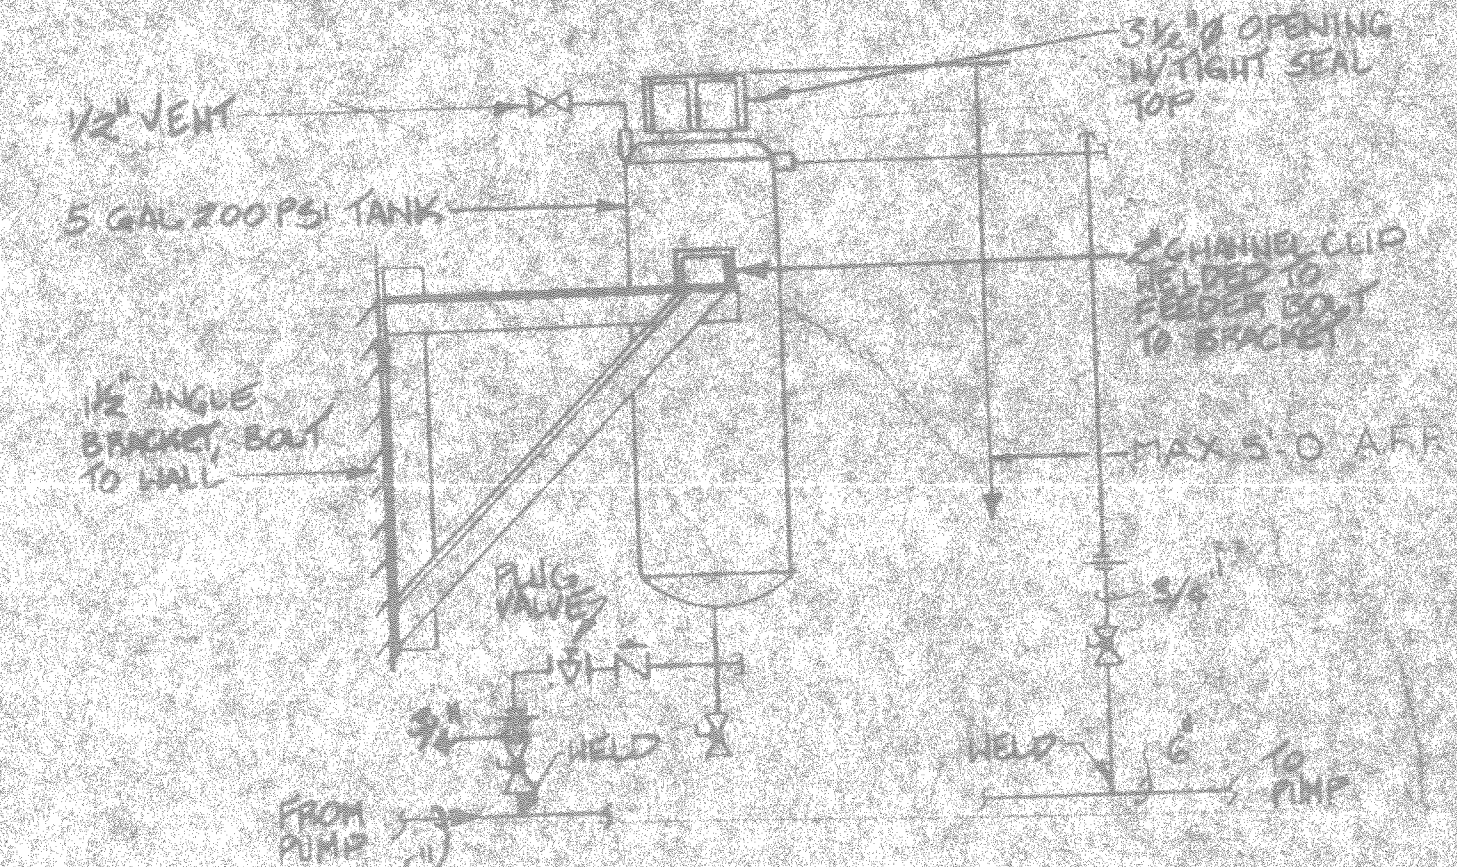


7.5/16" DETAIL - CHEMICAL FEEDER  
NO SCALE

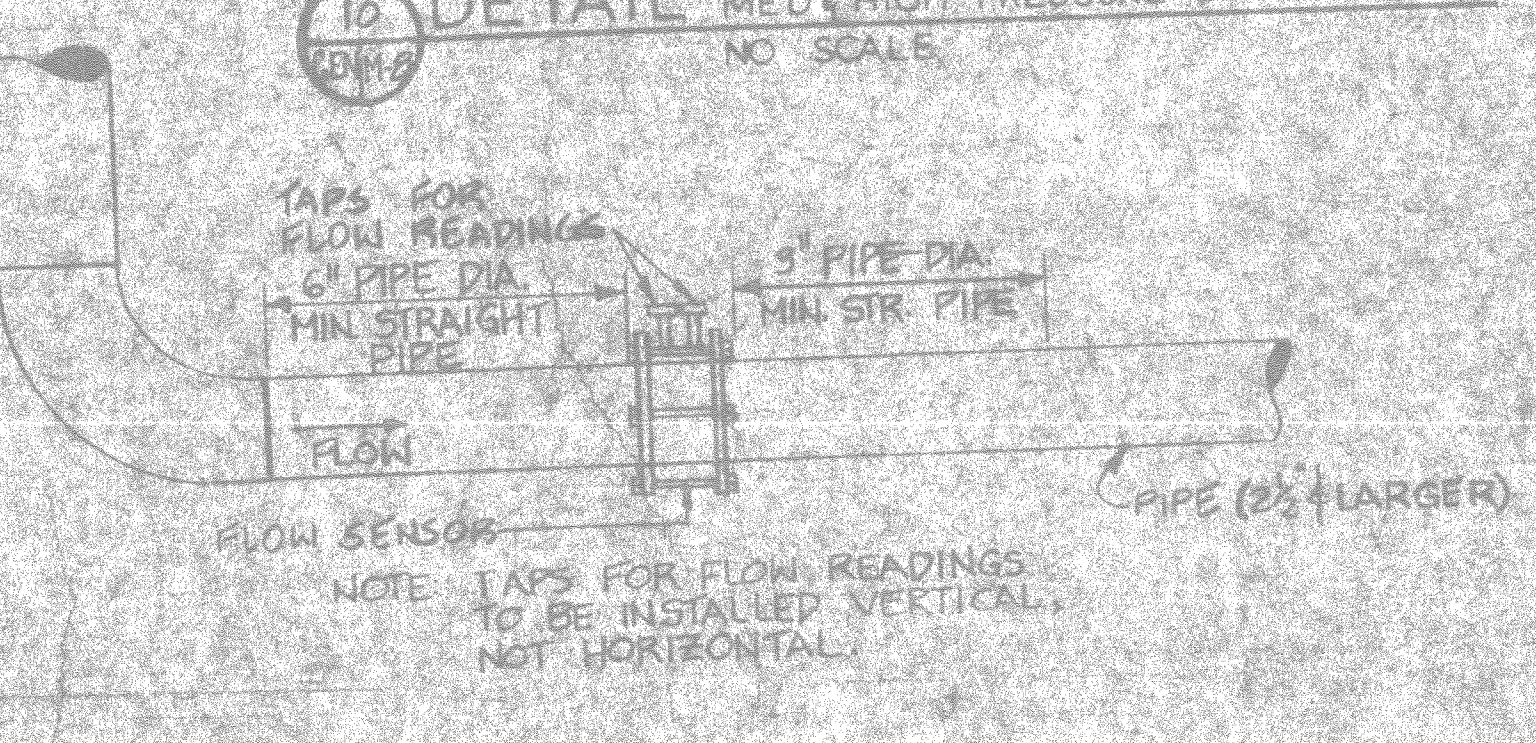

11.5/16" DETAIL - WATER FLOW INDICATING STATION  
NO SCALE

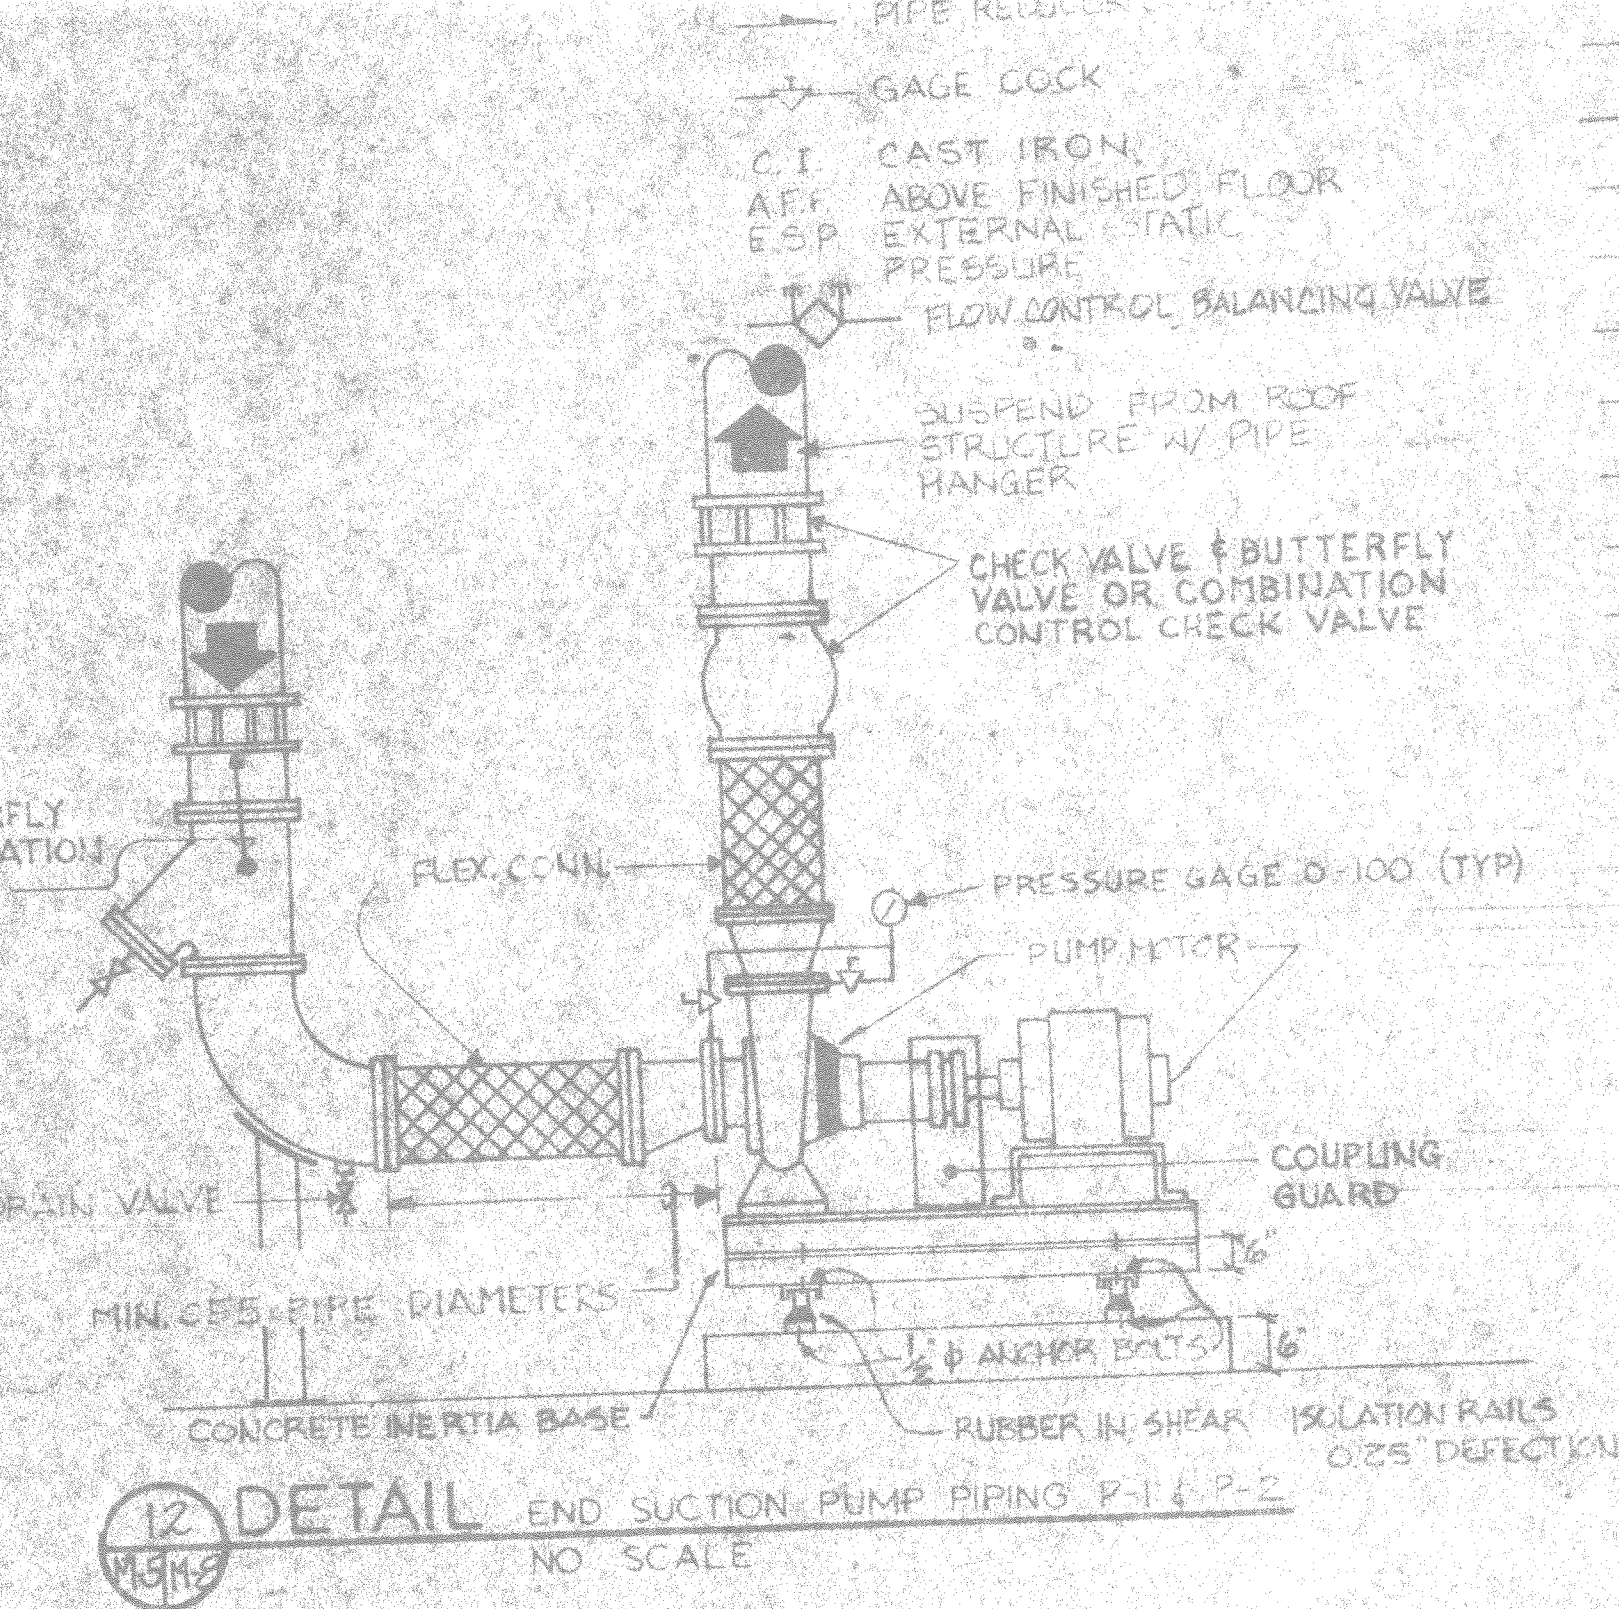

12.5/16" DETAIL - END SUCTION PUMP PIPING P-1 & P-2  
NO SCALE

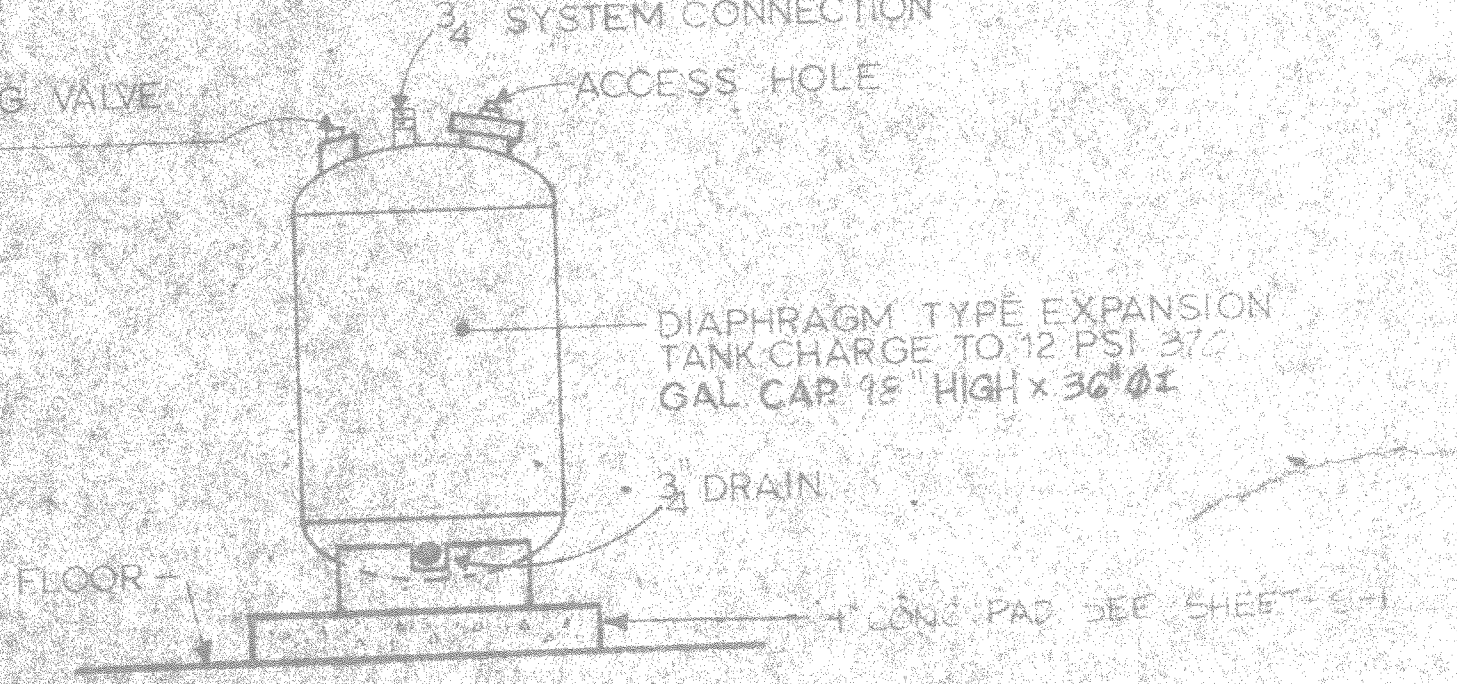

13.5/16" DETAIL - EXPANSION TANK INSTALLATION  
NO SCALE

SYMBOL LEGEND

(TV)	THERMOSTAT (VENTILATION)	DMSD	DUCT MOUNTED SMOKE DETECTOR
(THC)	THERMOSTAT (HEATING & COOLING)	O.V.	OUTLET - VELOCITY
(TH)	THERMOSTAT (HEATING)	CHWS	CHILLED HOT WATER SUPPLY
(B)	FAN COIL UNIT DESIGNATION	CHWR	CHILLED HOT WATER RETURN
(C)	CONNECT NEW TO EXISTING	CWS	CHILLED WATER SUPPLY
(C)	CONNECT NEW TO EXISTING	CWR	CHILLED WATER RETURN
(C)	CONNECT NEW TO EXISTING	(C)	GATE VALVE
(C)	CONNECT NEW TO EXISTING	(C)	HOSE END GATE VALVE
(C)	CONNECT NEW TO EXISTING	(C)	BUTTERFLY VALVE
(C)	CONNECT NEW TO EXISTING	(C)	GLOBE VALVE
(C)	CONNECT NEW TO EXISTING	(C)	STRAINER
(C)	CONNECT NEW TO EXISTING	(C)	2-WAY CONTROL VALVE
(C)	CONNECT NEW TO EXISTING	(C)	3-WAY CONTROL VALVE
(C)	CONNECT NEW TO EXISTING	(C)	UNION
(C)	CONNECT NEW TO EXISTING	(C)	PIPE REDUCTION CONCENTRIC
(C)	CONNECT NEW TO EXISTING	(C)	PRESS. GAUGE W/ GAUGE LOCK
(C)	CONNECT NEW TO EXISTING	(C)	THERMOMETER
(C)	CONNECT NEW TO EXISTING	(C)	CHECK VALVE
(C)	CONNECT NEW TO EXISTING	(C)	MANUAL AIR VENT
(C)	CONNECT NEW TO EXISTING	(C)	MANUAL VOLUME DAMPER
(C)	CONNECT NEW TO EXISTING	(C)	PRESS. REG. VALVE
(C)	CONNECT NEW TO EXISTING	(C)	FAN COIL UNIT
(C)	CONNECT NEW TO EXISTING	(C)	UNIT HEATER
(C)	CONNECT NEW TO EXISTING	(C)	TERMINAL AIR BLENDER
(C)	CONNECT NEW TO EXISTING	(C)	DESUPER HEATER
(C)	CONNECT NEW TO EXISTING	(C)	FLOOR DRAIN
(C)	CONNECT NEW TO EXISTING	(C)	OPPOSED BLADE DAMPER
(C)	CONNECT NEW TO EXISTING	(C)	ENERGY MONITORING CONTROL SYSTEM
(C)	CONNECT NEW TO EXISTING	(C)	MOTOR OPERATED DAMPER
(C)	CONNECT NEW TO EXISTING	(C)	ACCESS DOOR
(C)	CONNECT NEW TO EXISTING	(C)	FIRE DAMPER
(C)	CONNECT NEW TO EXISTING	(C)	BELOW FINISHED FLOOR
(C)	CONNECT NEW TO EXISTING	(C)	THERMOSTAT
(C)	CONNECT NEW TO EXISTING	(C)	HUMIDITY SENSOR
(C)	CONNECT NEW TO EXISTING	(C)	HOT WATER SUPPLY
(C)	CONNECT NEW TO EXISTING	(C)	HOT WATER RETURN
(C)	CONNECT NEW TO EXISTING	(C)	MEDIUM PRESSURE STEAM
(C)	CONNECT NEW TO EXISTING	(C)	FLOW DIRECTION
(C)	CONNECT NEW TO EXISTING	(C)	HIGH PRESSURE STEAM
(C)	CONNECT NEW TO EXISTING	(C)	DOOR GRILLE
(C)	CONNECT NEW TO EXISTING	(C)	PIPE ANCHORS
(C)	CONNECT NEW TO EXISTING	(C)	PRIMARY CHILLED HOT WATER SUPPLY
(C)	CONNECT NEW TO EXISTING	(C)	PRIMARY CHILLED HOT WATER RETURN
(C)	CONNECT NEW TO EXISTING	(C)	DOMESTIC HWS
(C)	CONNECT NEW TO EXISTING	(C)	DOMESTIC HWR
(C)	CONNECT NEW TO EXISTING	(C)	RECLAIM HOT WATER
(C)	CONNECT NEW TO EXISTING	(C)	PUMP DISCHARGE
(C)	CONNECT NEW TO EXISTING	(C)	VENT TO ROOF
(C)	CONNECT NEW TO EXISTING	(C)	MED PRESS. DRIP ASSEMBLY
(C)	CONNECT NEW TO EXISTING	(C)	HIGH PRESS DRIP ASSEMBLY
(C)	CONNECT NEW TO EXISTING	(C)	HOT GAS LINE
(C)	CONNECT NEW TO EXISTING	(C)	LIQUID LINE
(C)	CONNECT NEW TO EXISTING	(C)	CONTROL VALVE ASSEMBLY
(C)	CONNECT NEW TO EXISTING	(C)	PACKAGE AIR COOLED CHILLER
(C)	CONNECT NEW TO EXISTING	(C)	EXPANSION LINE
(C)	CONNECT NEW TO EXISTING	(C)	CONNECT TO EXISTING


**M-8**

	J. N. PEASE ASSOCIATES, INC. ARCHITECTS - ENGINEERS - PLUMBERS CHARLOTTE, NORTH CAROLINA DATE: 12-17-96	DEPARTMENT OF THE NAVY <b>ATLANTIC DIVISION</b> MARINE CORPS BASE CAMP LEJEUNE, N.C. BACHELOR ENLISTED QUARTERS
	PROJECT NO. 352 DRAWING NO. 12-17-96 DATE: 12-17-96 APPROVED: [Signature] FOR THE ARCHITECT: [Signature]	DRAWING NO. 4155182 CONTRACT NO. N62470-85-B-5142 SHEET NO. 05-85-5142 OF 13










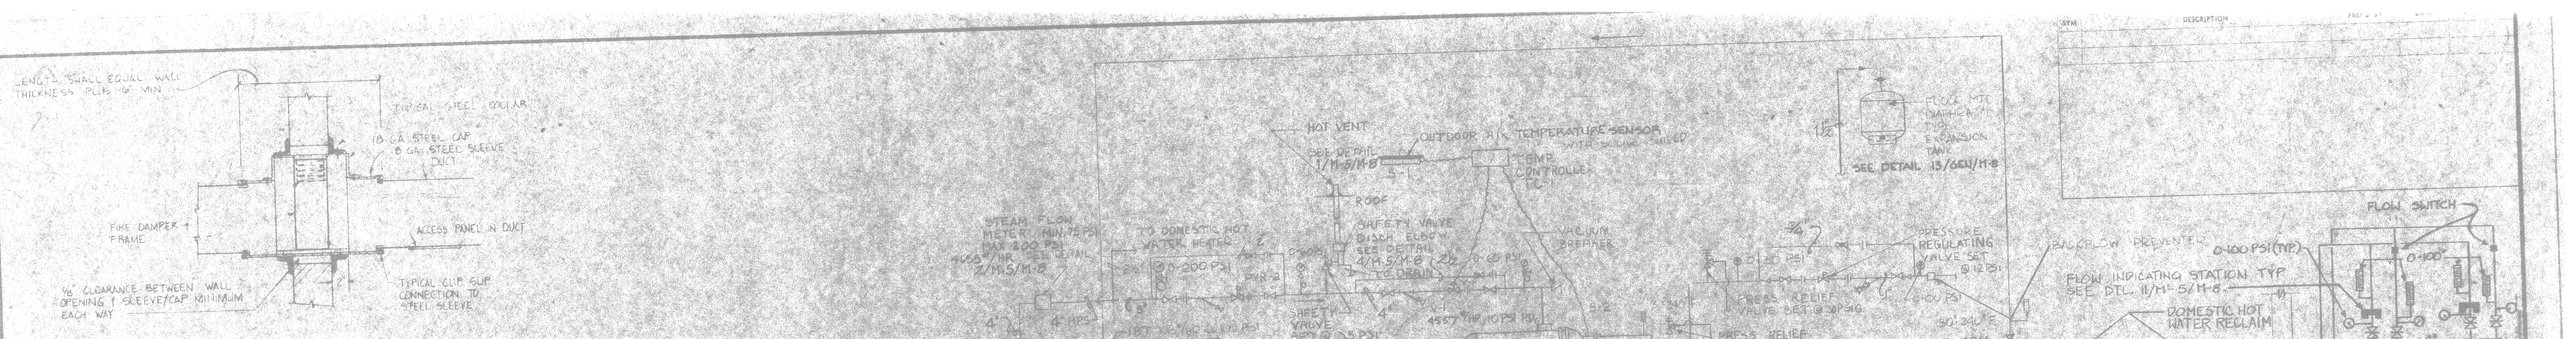


1 DETAIL DUCT THRU AIR PARTITION  
NO SCALE

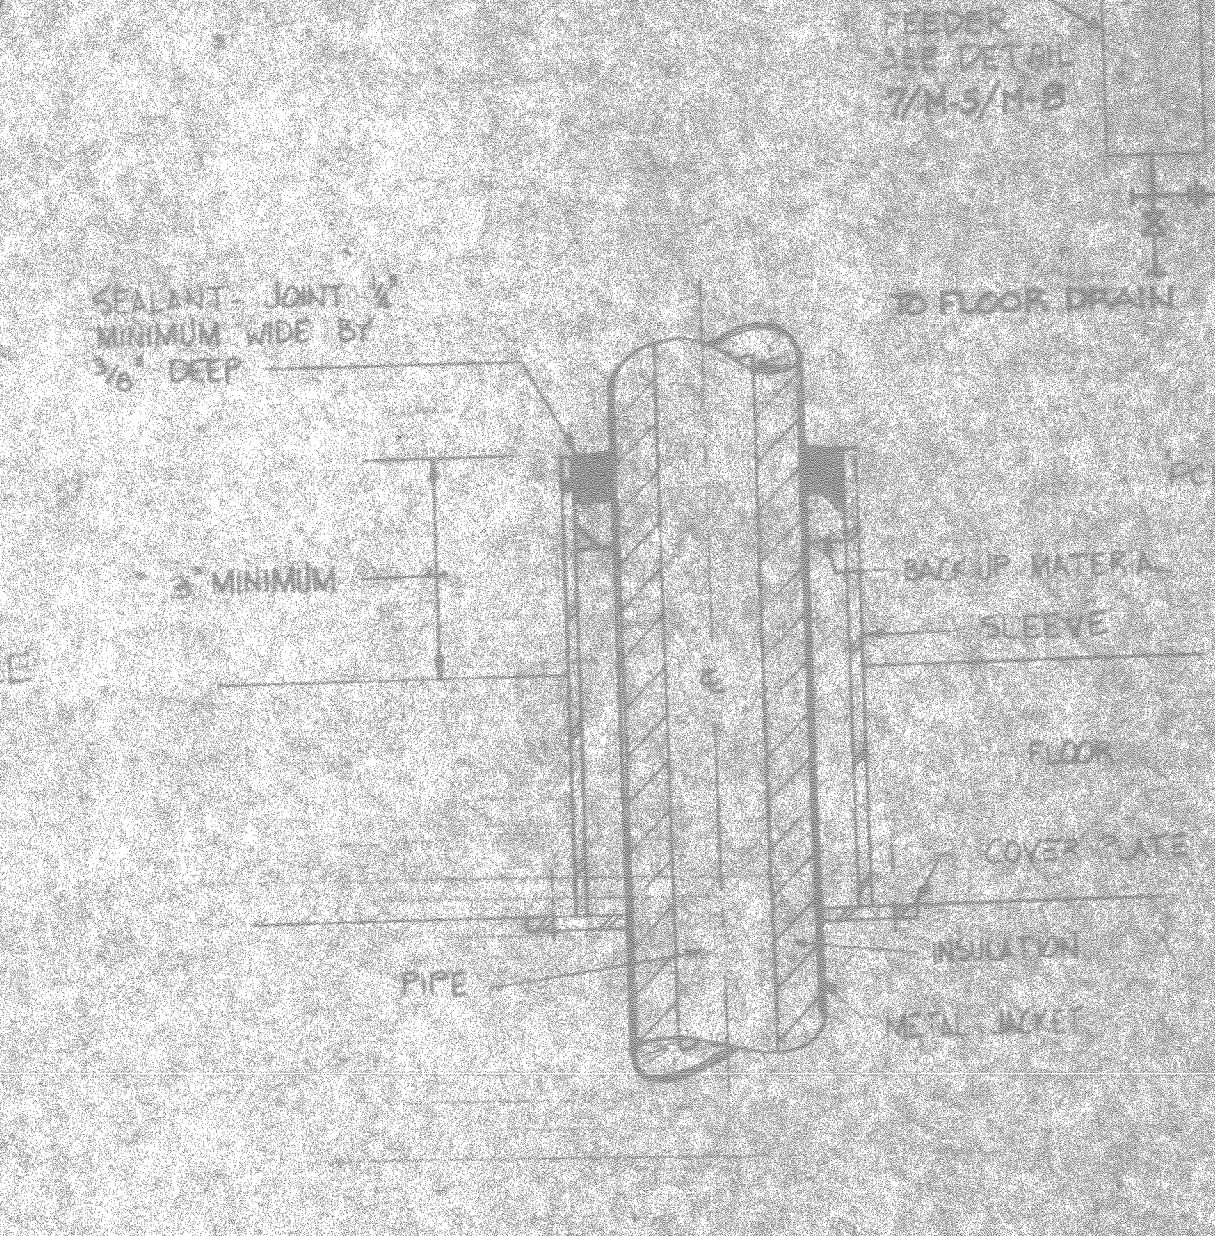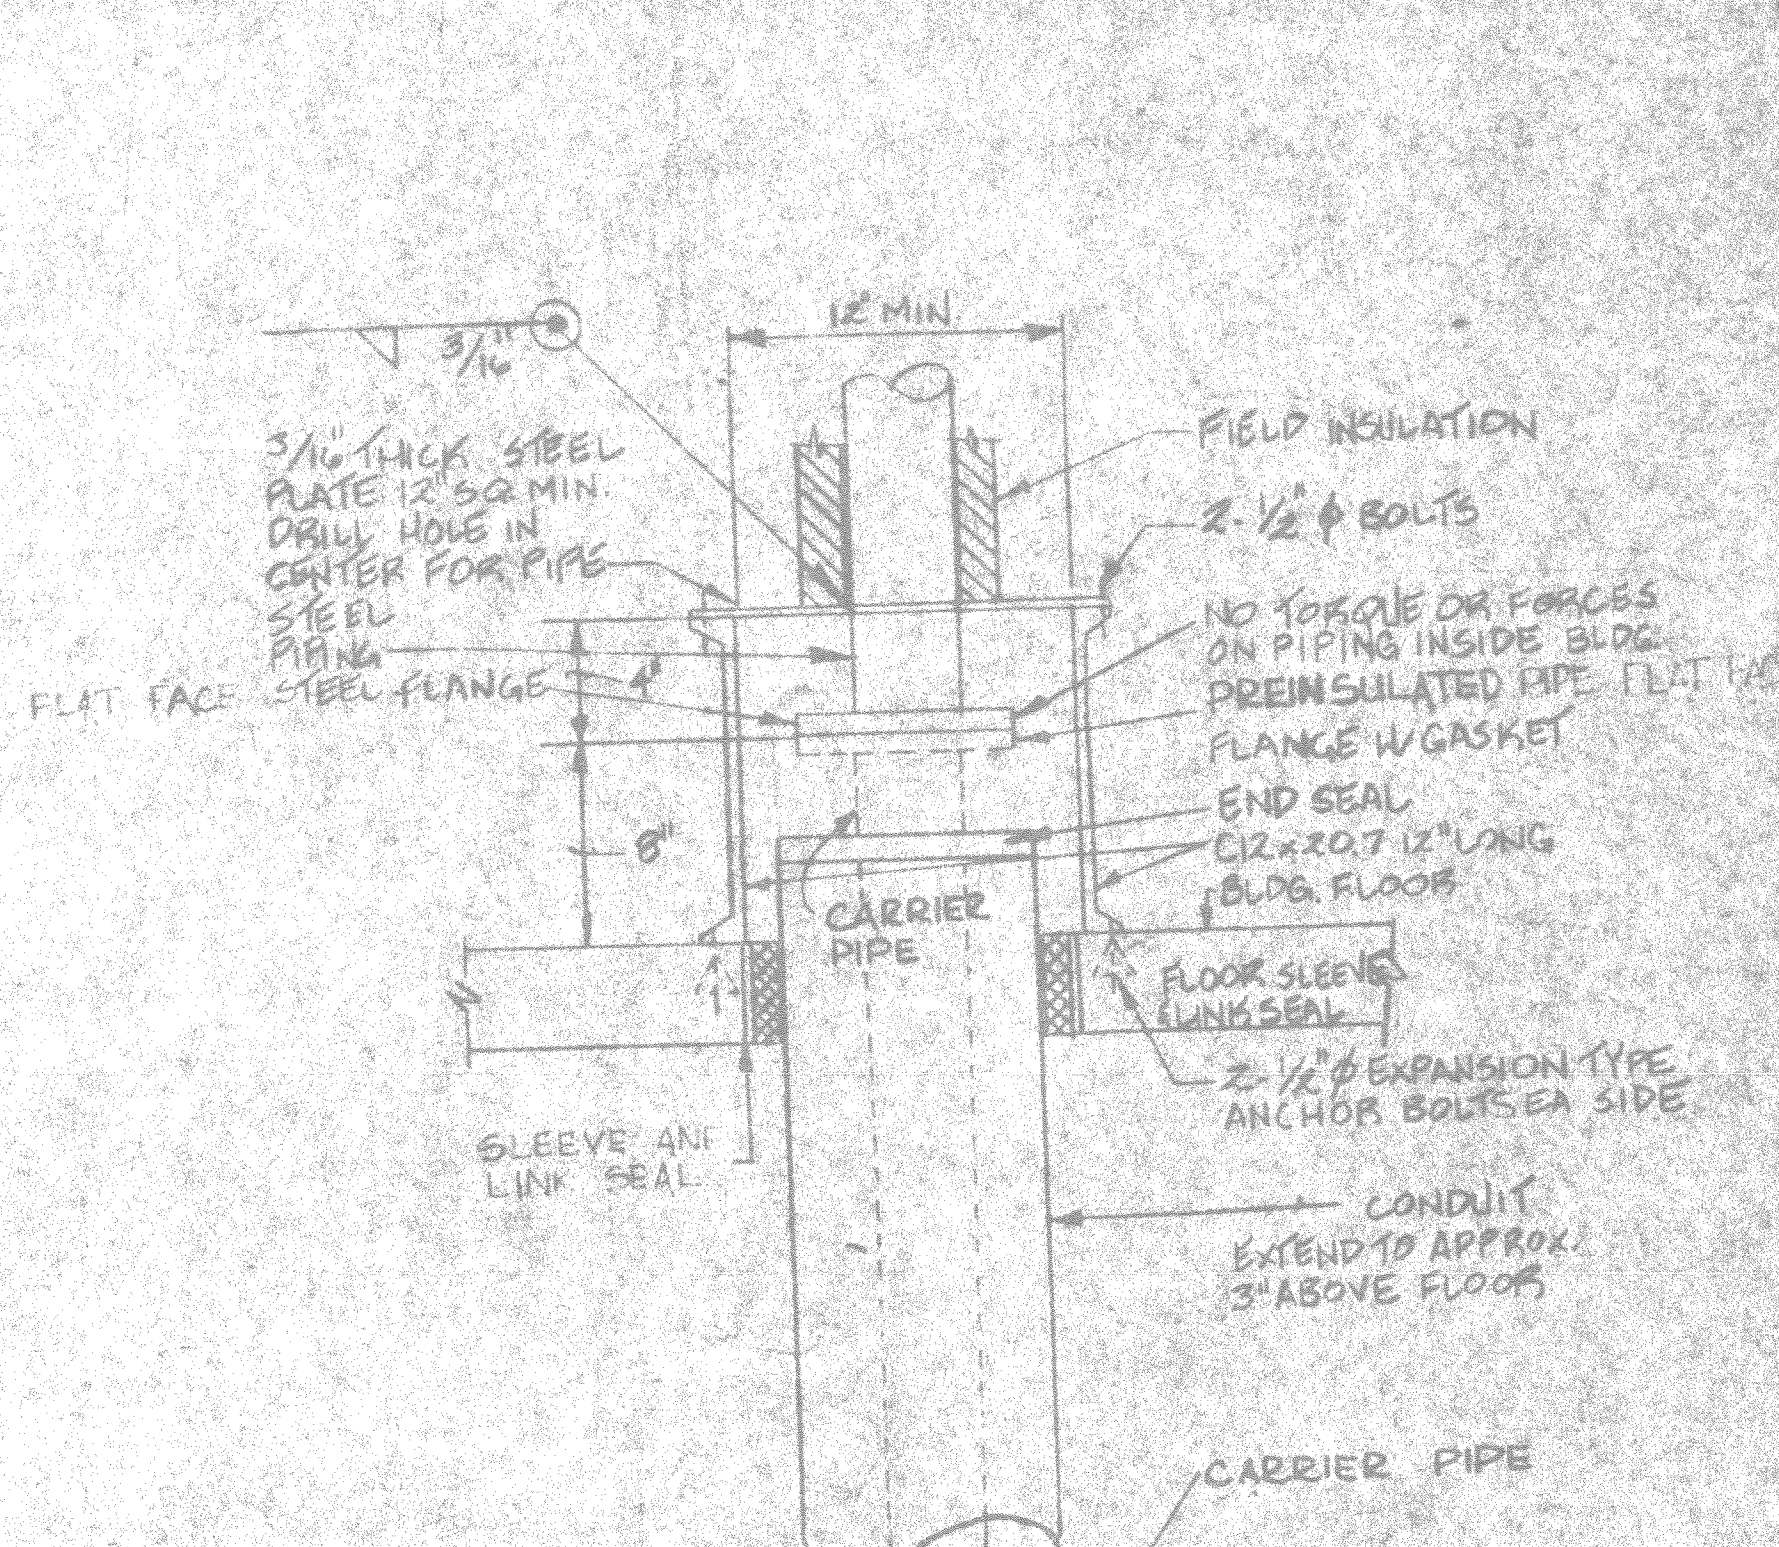


2 DETAIL PREINSULATED PIPE TO STEEL PIPE CONN @ BLDG ENTRANCE  
NO SCALE

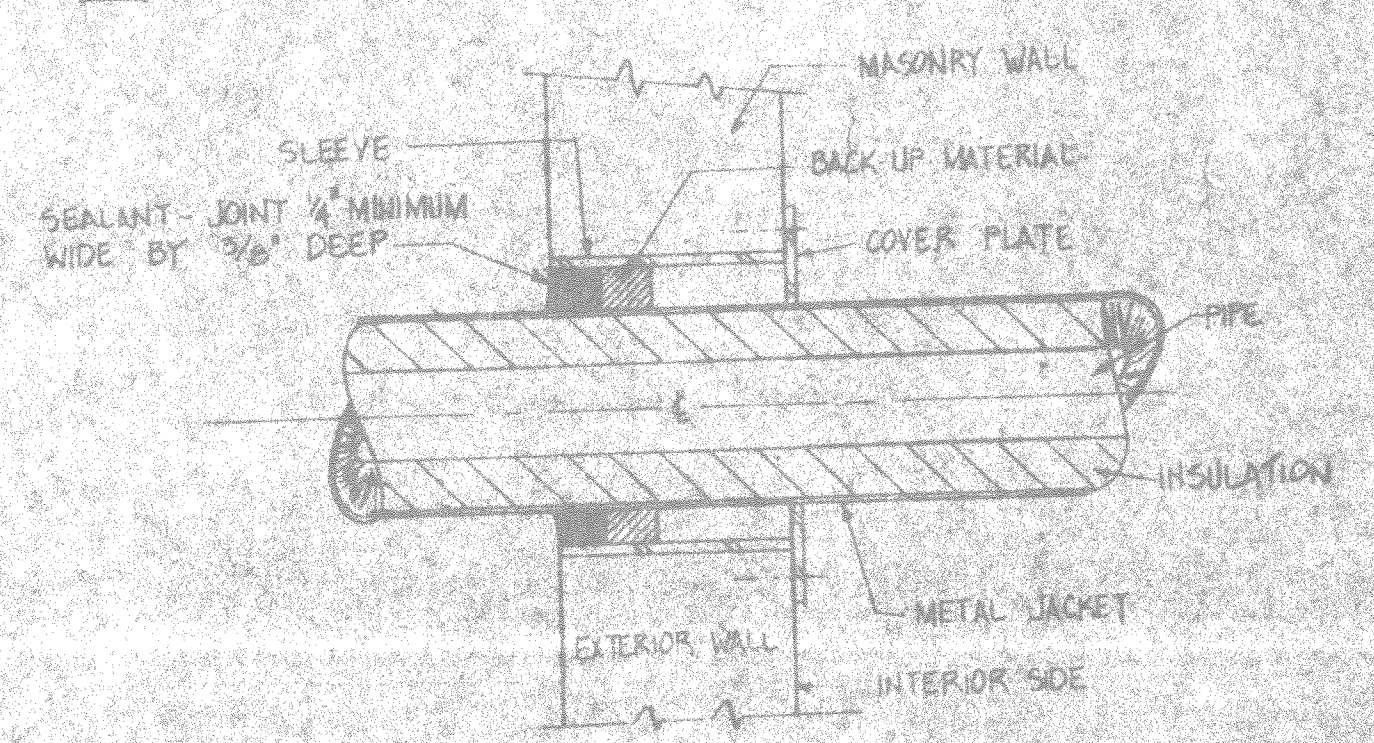


3 DETAIL PIPE SLEEVE FOR INSULATED PIPE THRU WALL - ABOVE GRADE  
NO SCALE

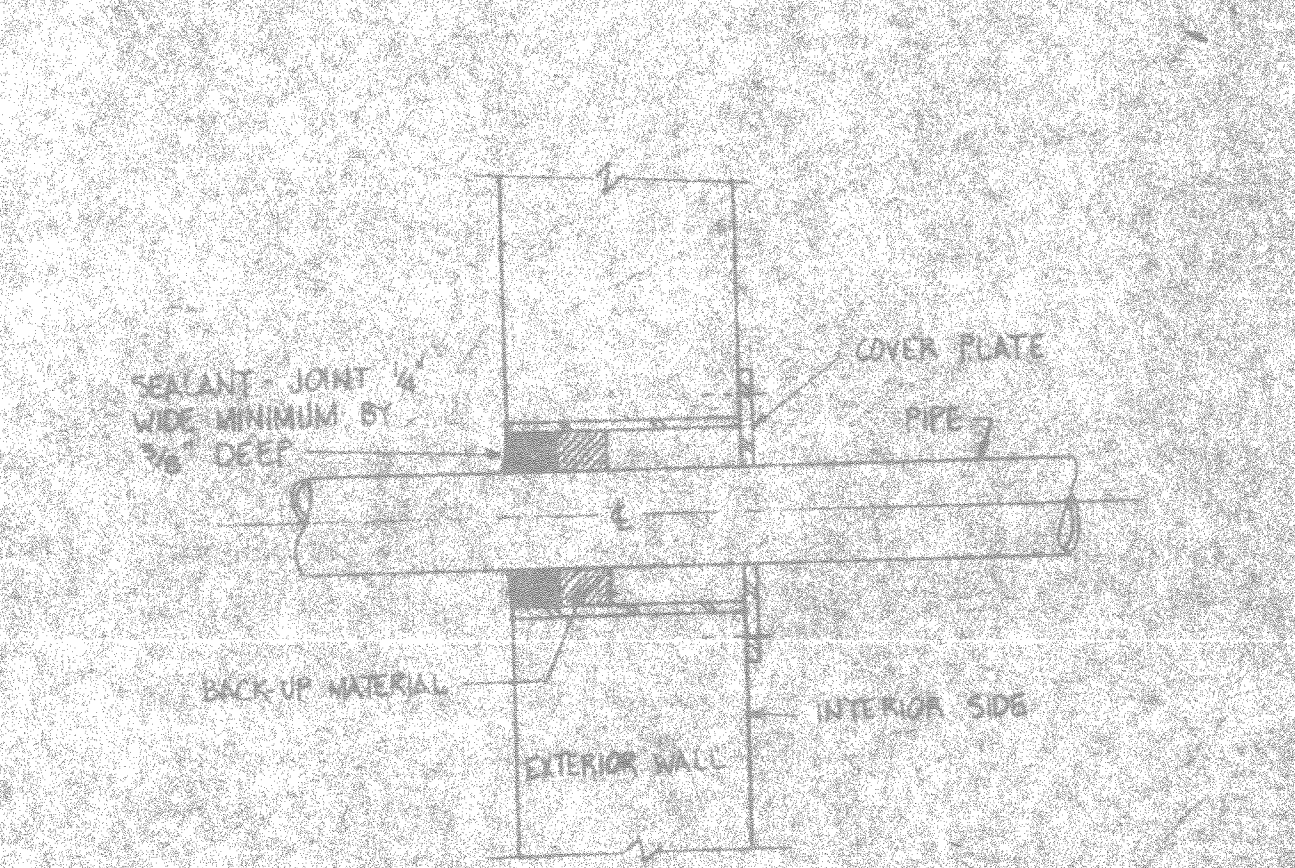



4 DETAIL PIPE SLEEVE FOR BARE PIPE THRU WALL - ABOVE GRADE  
NO SCALE

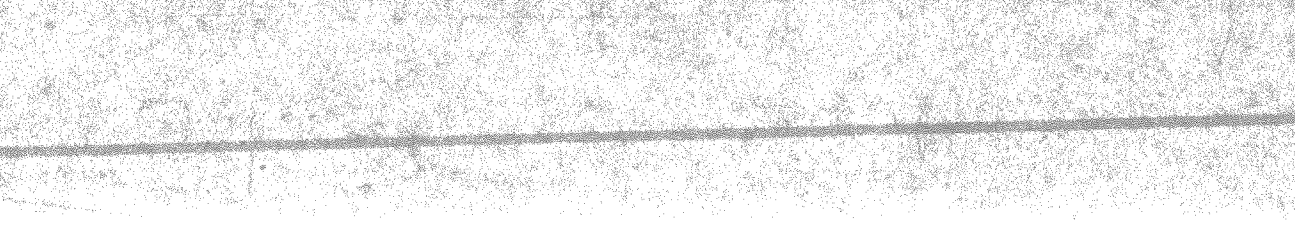

5 DETAIL PIPE PENETRATION THRU CONCRETE FLOOR  
NO SCALE

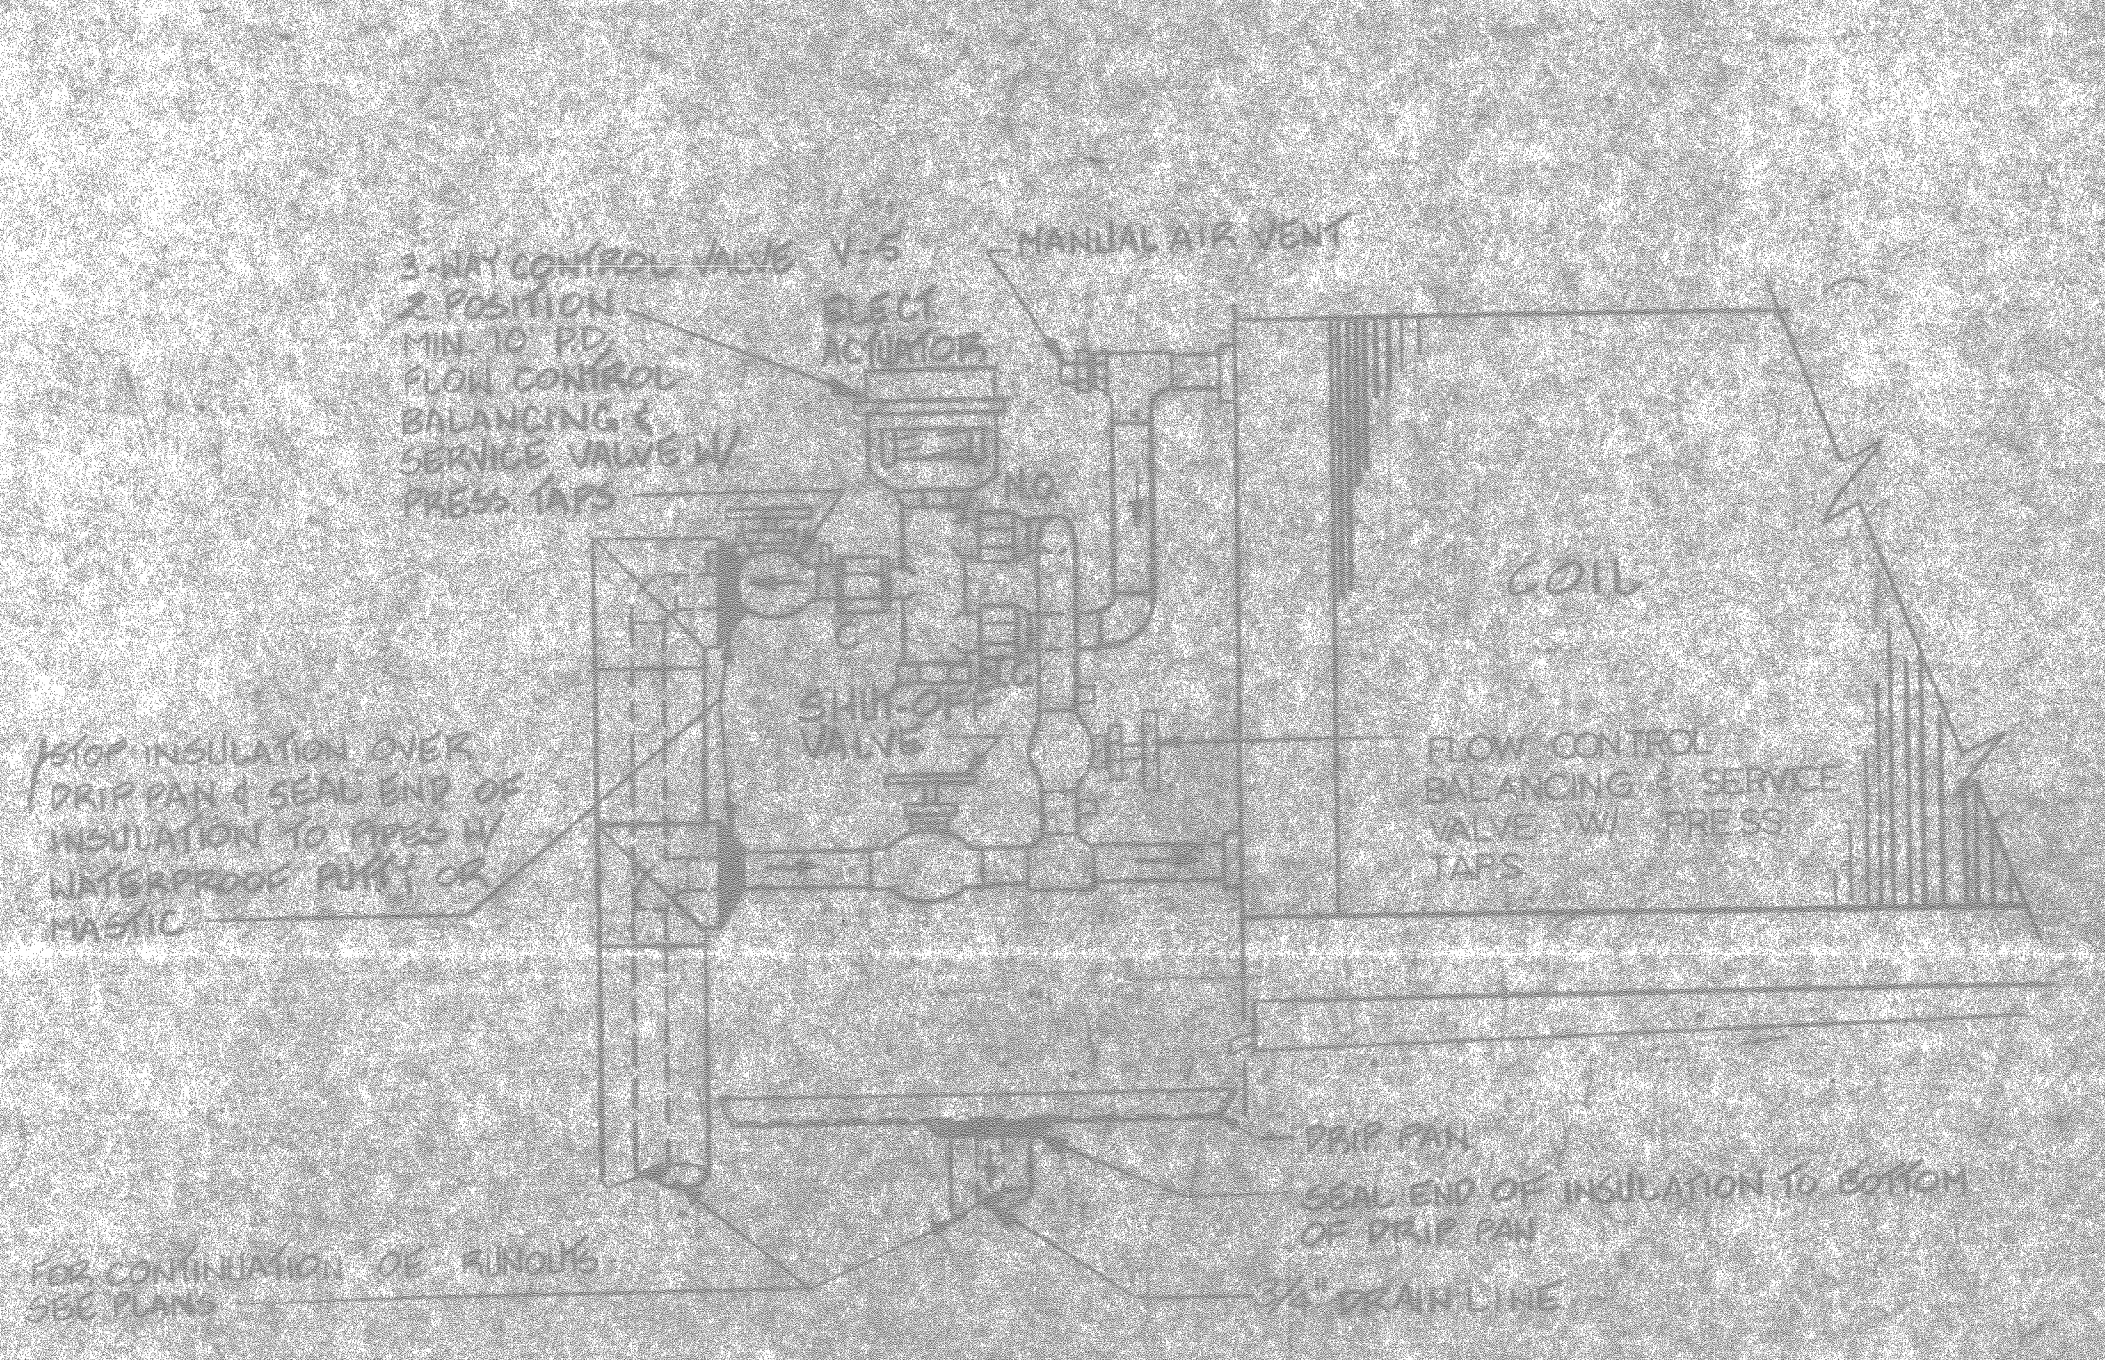

6 FAN COIL UNIT PIPING DETAIL  
NOT TO SCALE

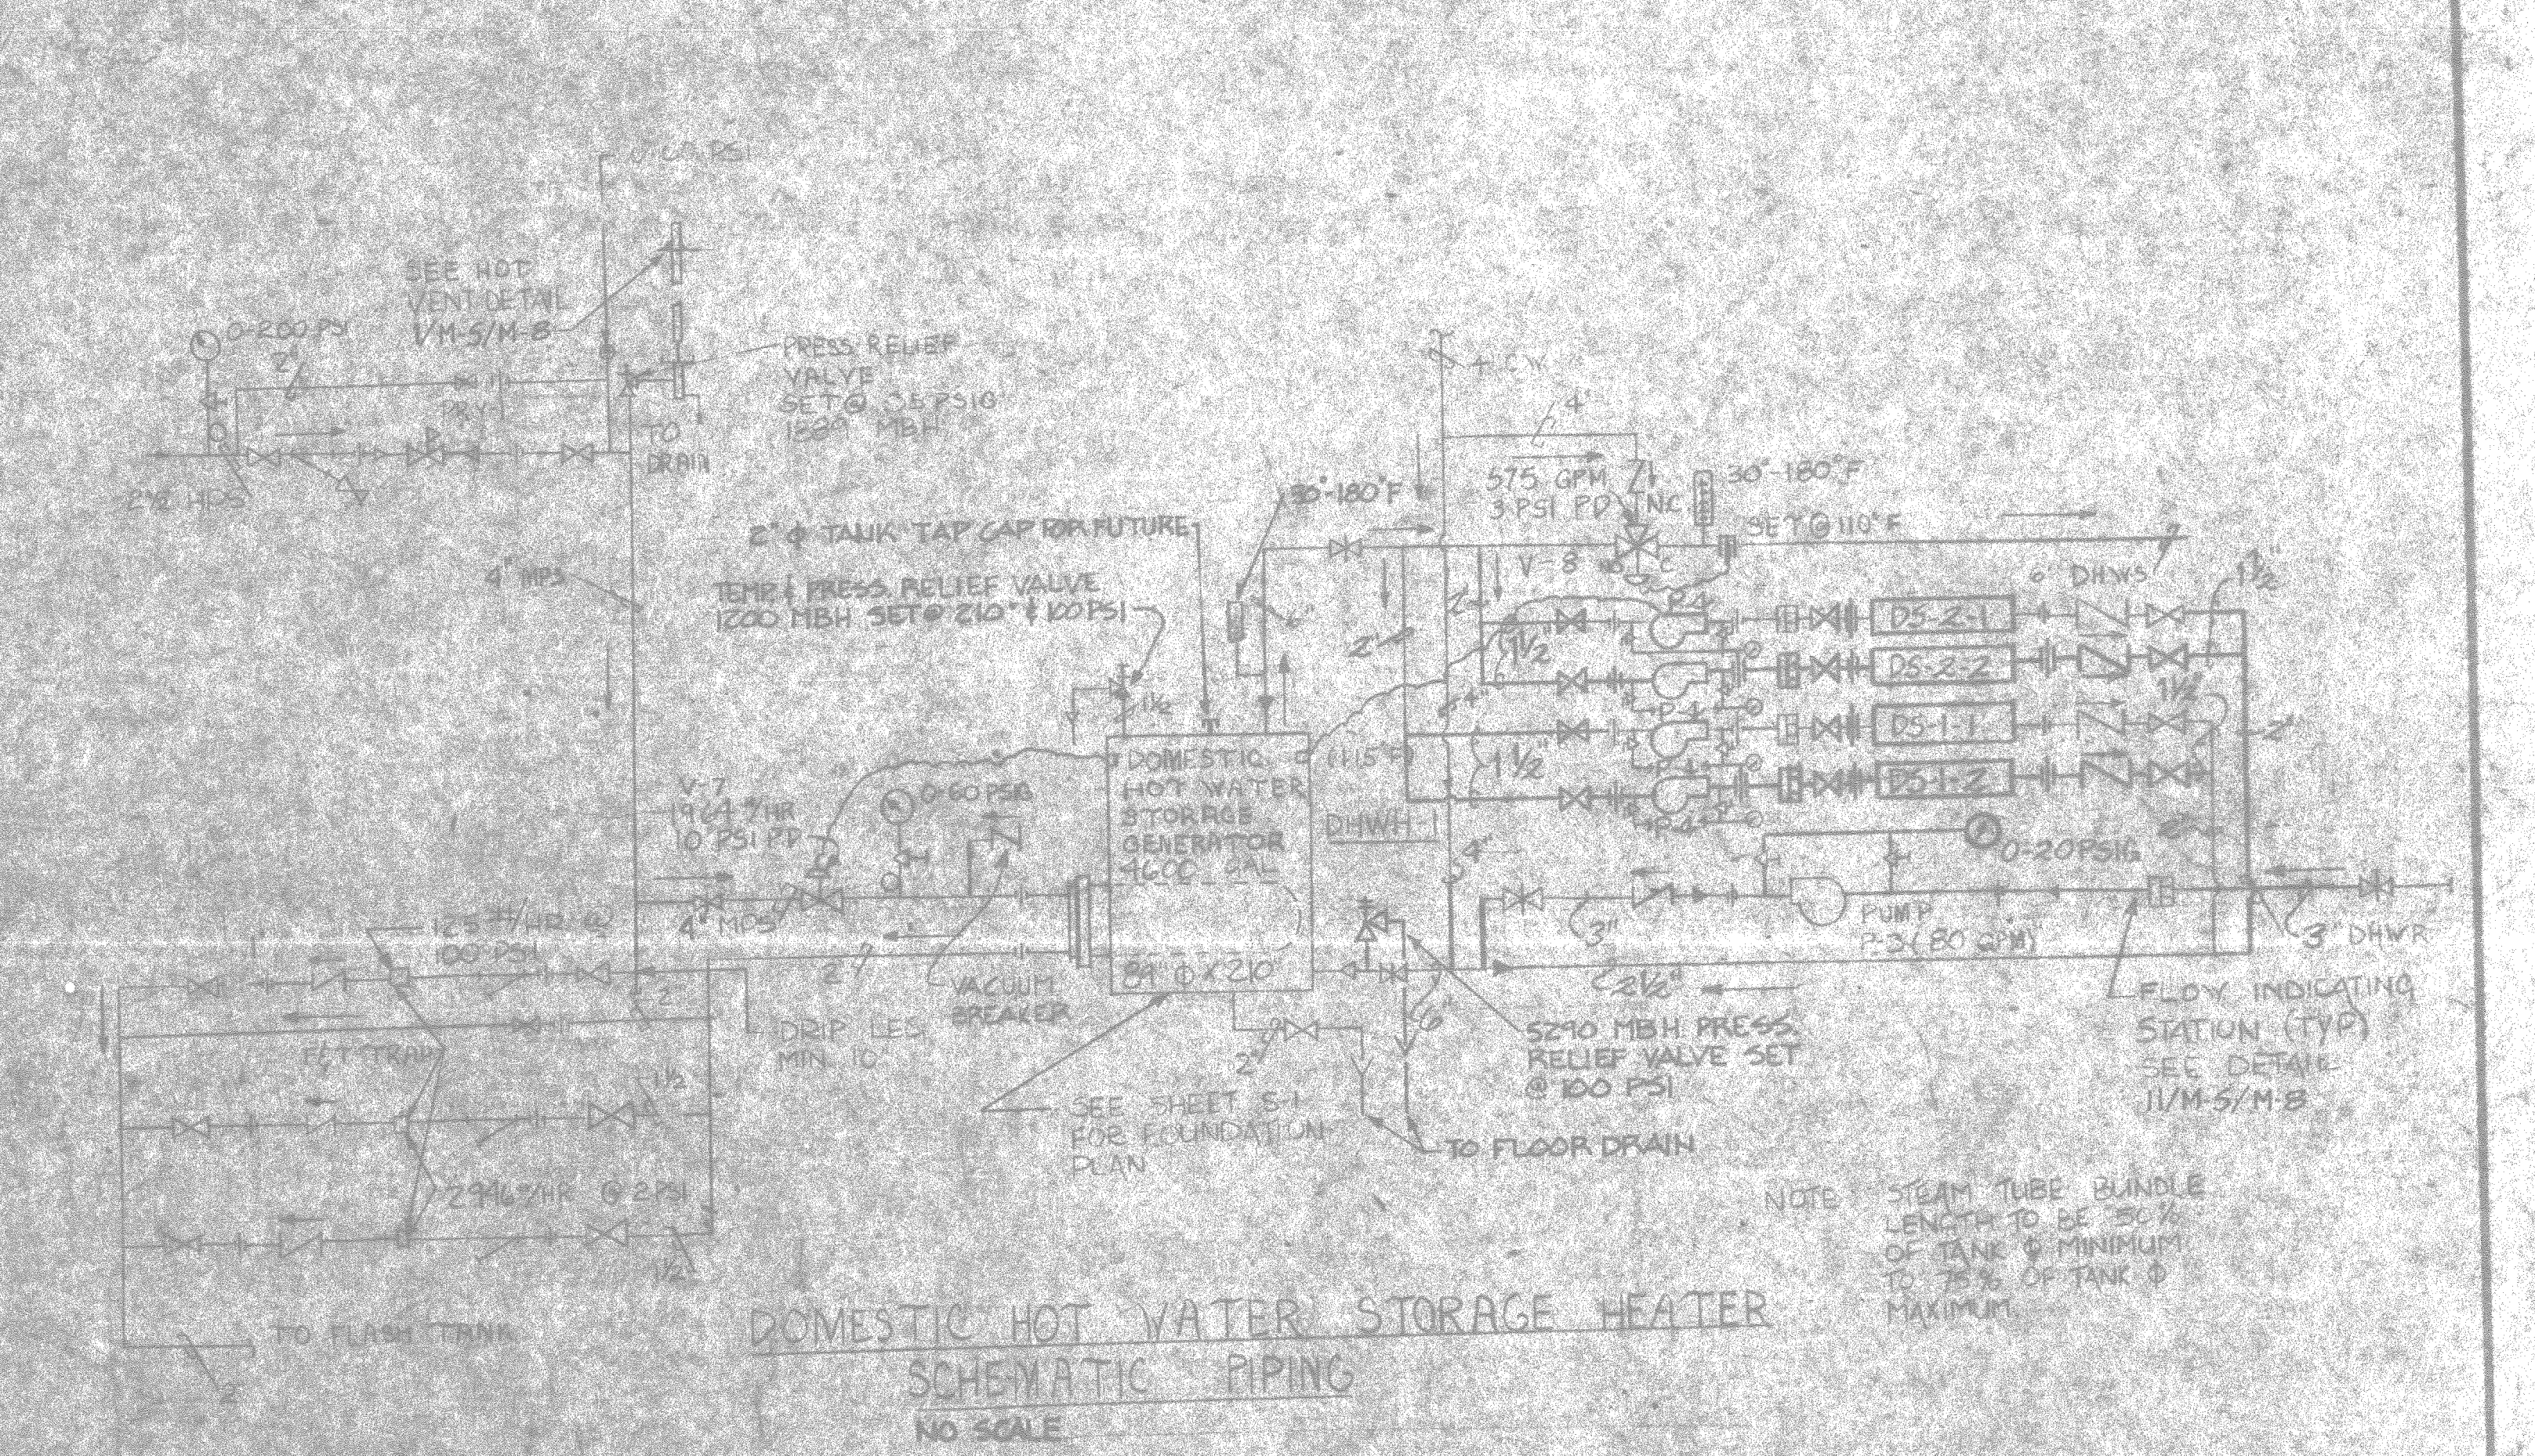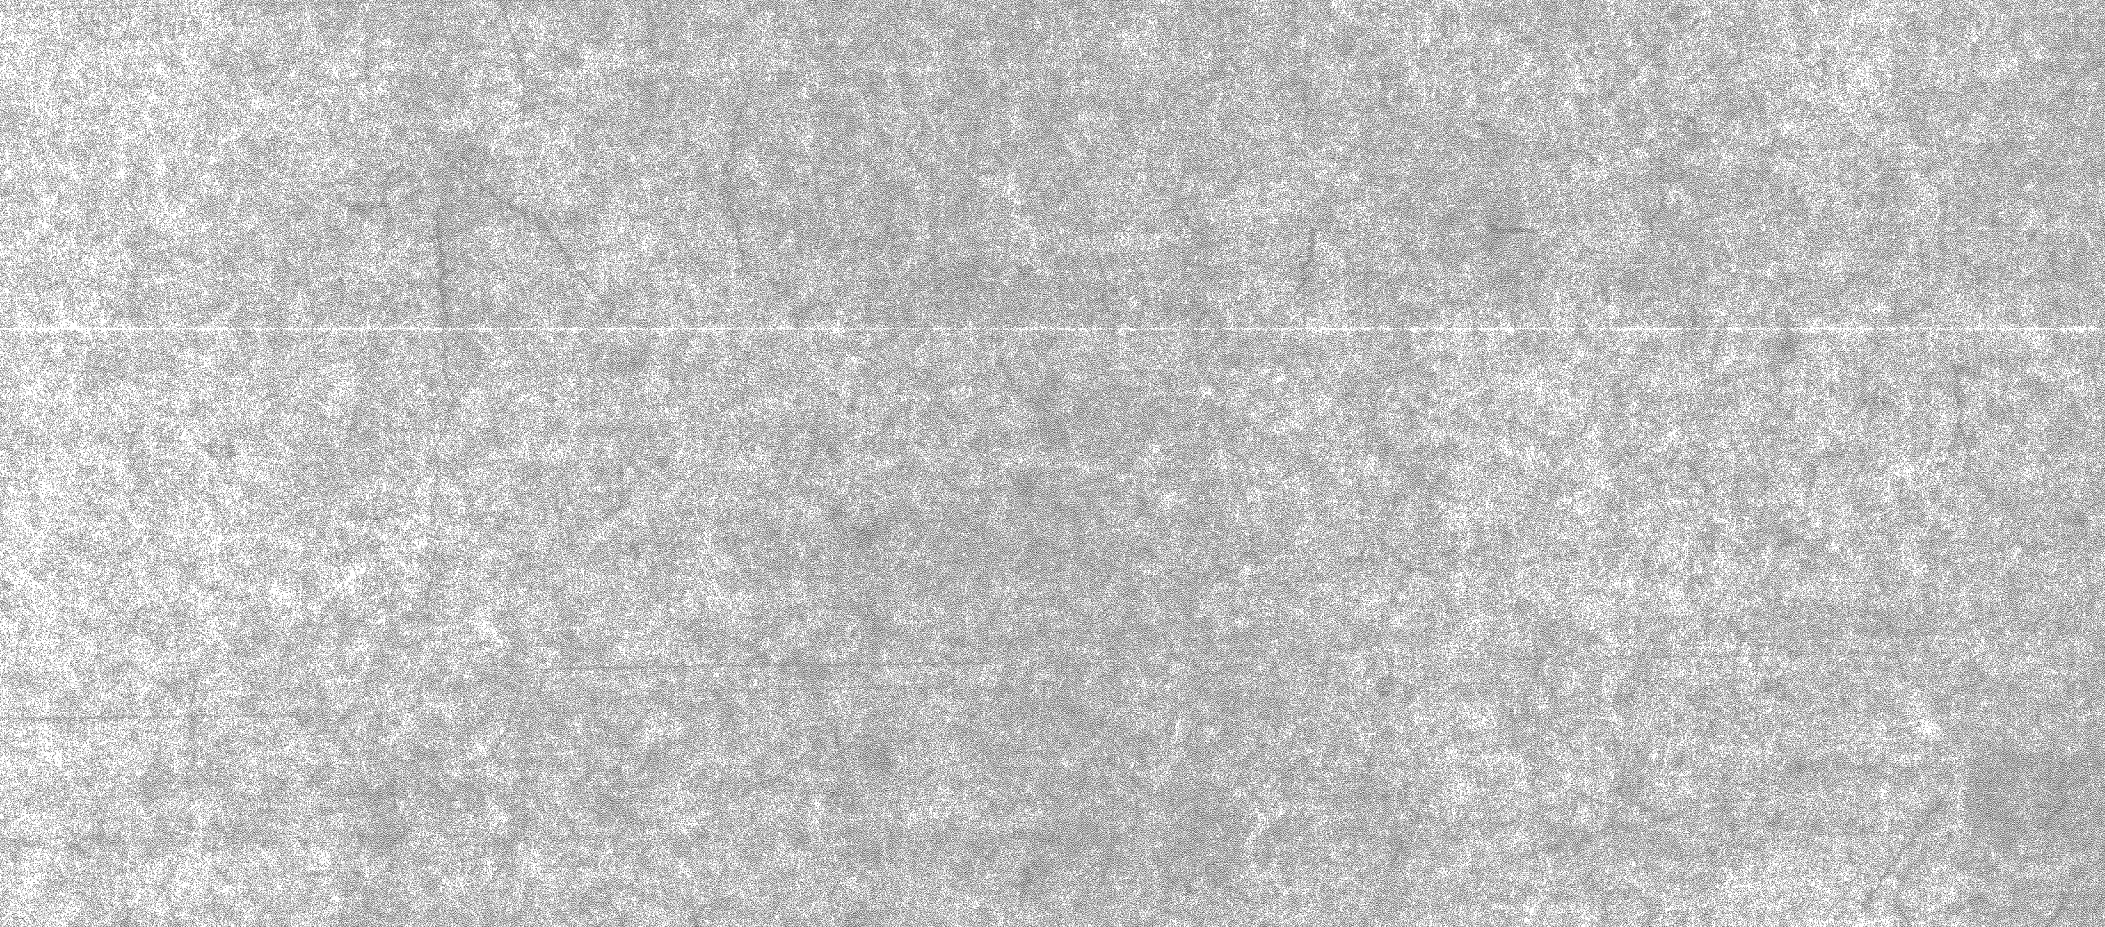




		<b>M-5</b>	
J. N. PEASE ASSOCIATES ARCHITECTS, ENGINEERS, PLANNERS CHARLOTTE, NORTH CAROLINA		ATLANTIC DIVISION MARINE CORPS BASE CAMP LEJEUNE, N.C. BACHELOR ENLISTED QUARTERS	
PROJECT NO. 4200 SHEET NO. 511		DETAILS & PIPING SCHEMATICS	
DATE: 11/20/54		DRAWING NO. 4156179	
PROJECT: CAMP LEJEUNE B2470-85-B-5142		SHEET NO. 28 OF 116	
DATE: 05/25/54		EXD. SHEET NO. 265179	








REVISIONS				
NO.	DESCRIPTION	PREP BY	DATE	APPROVED

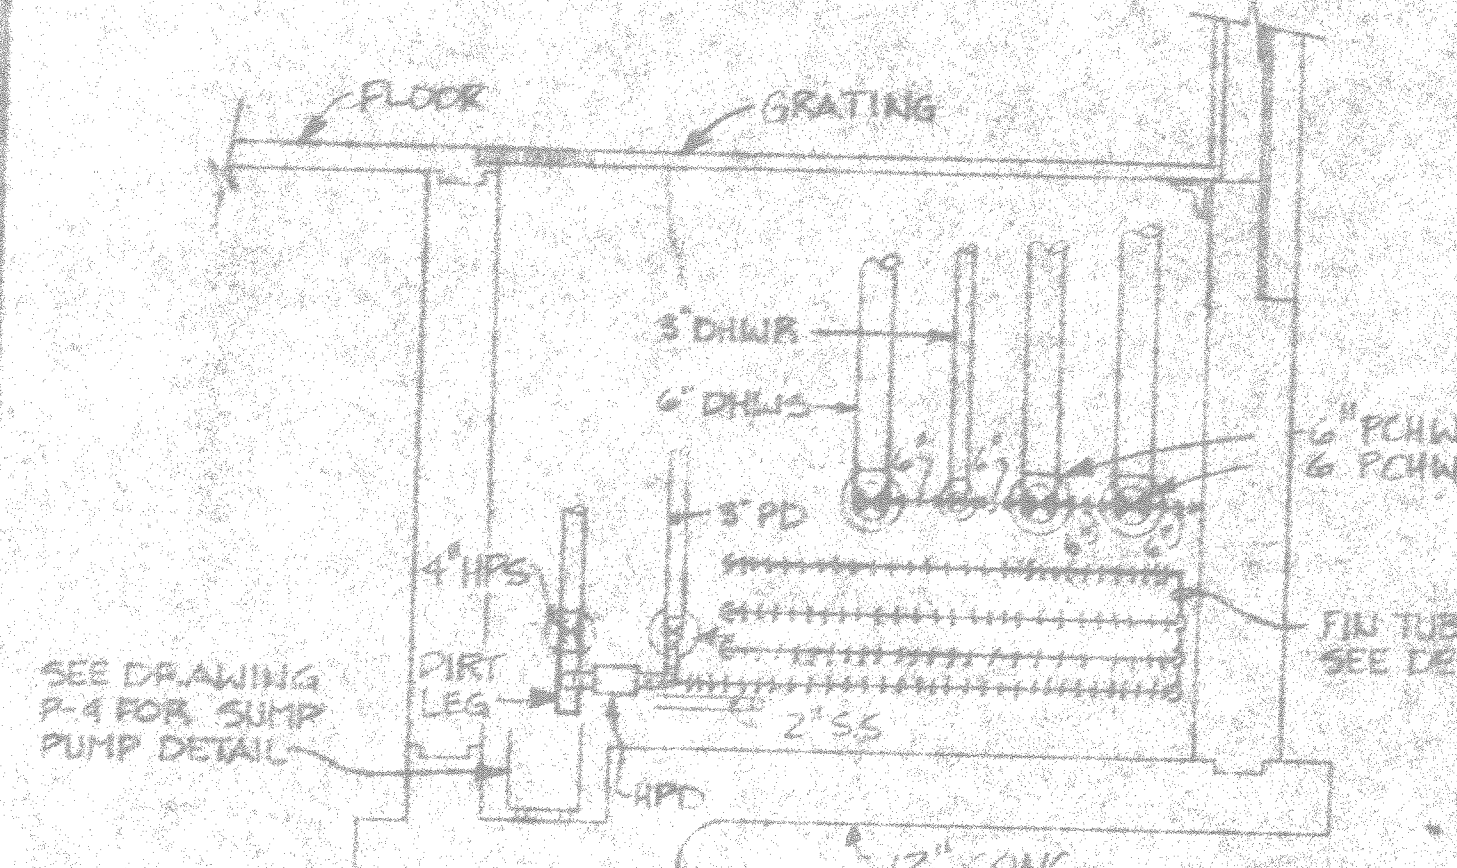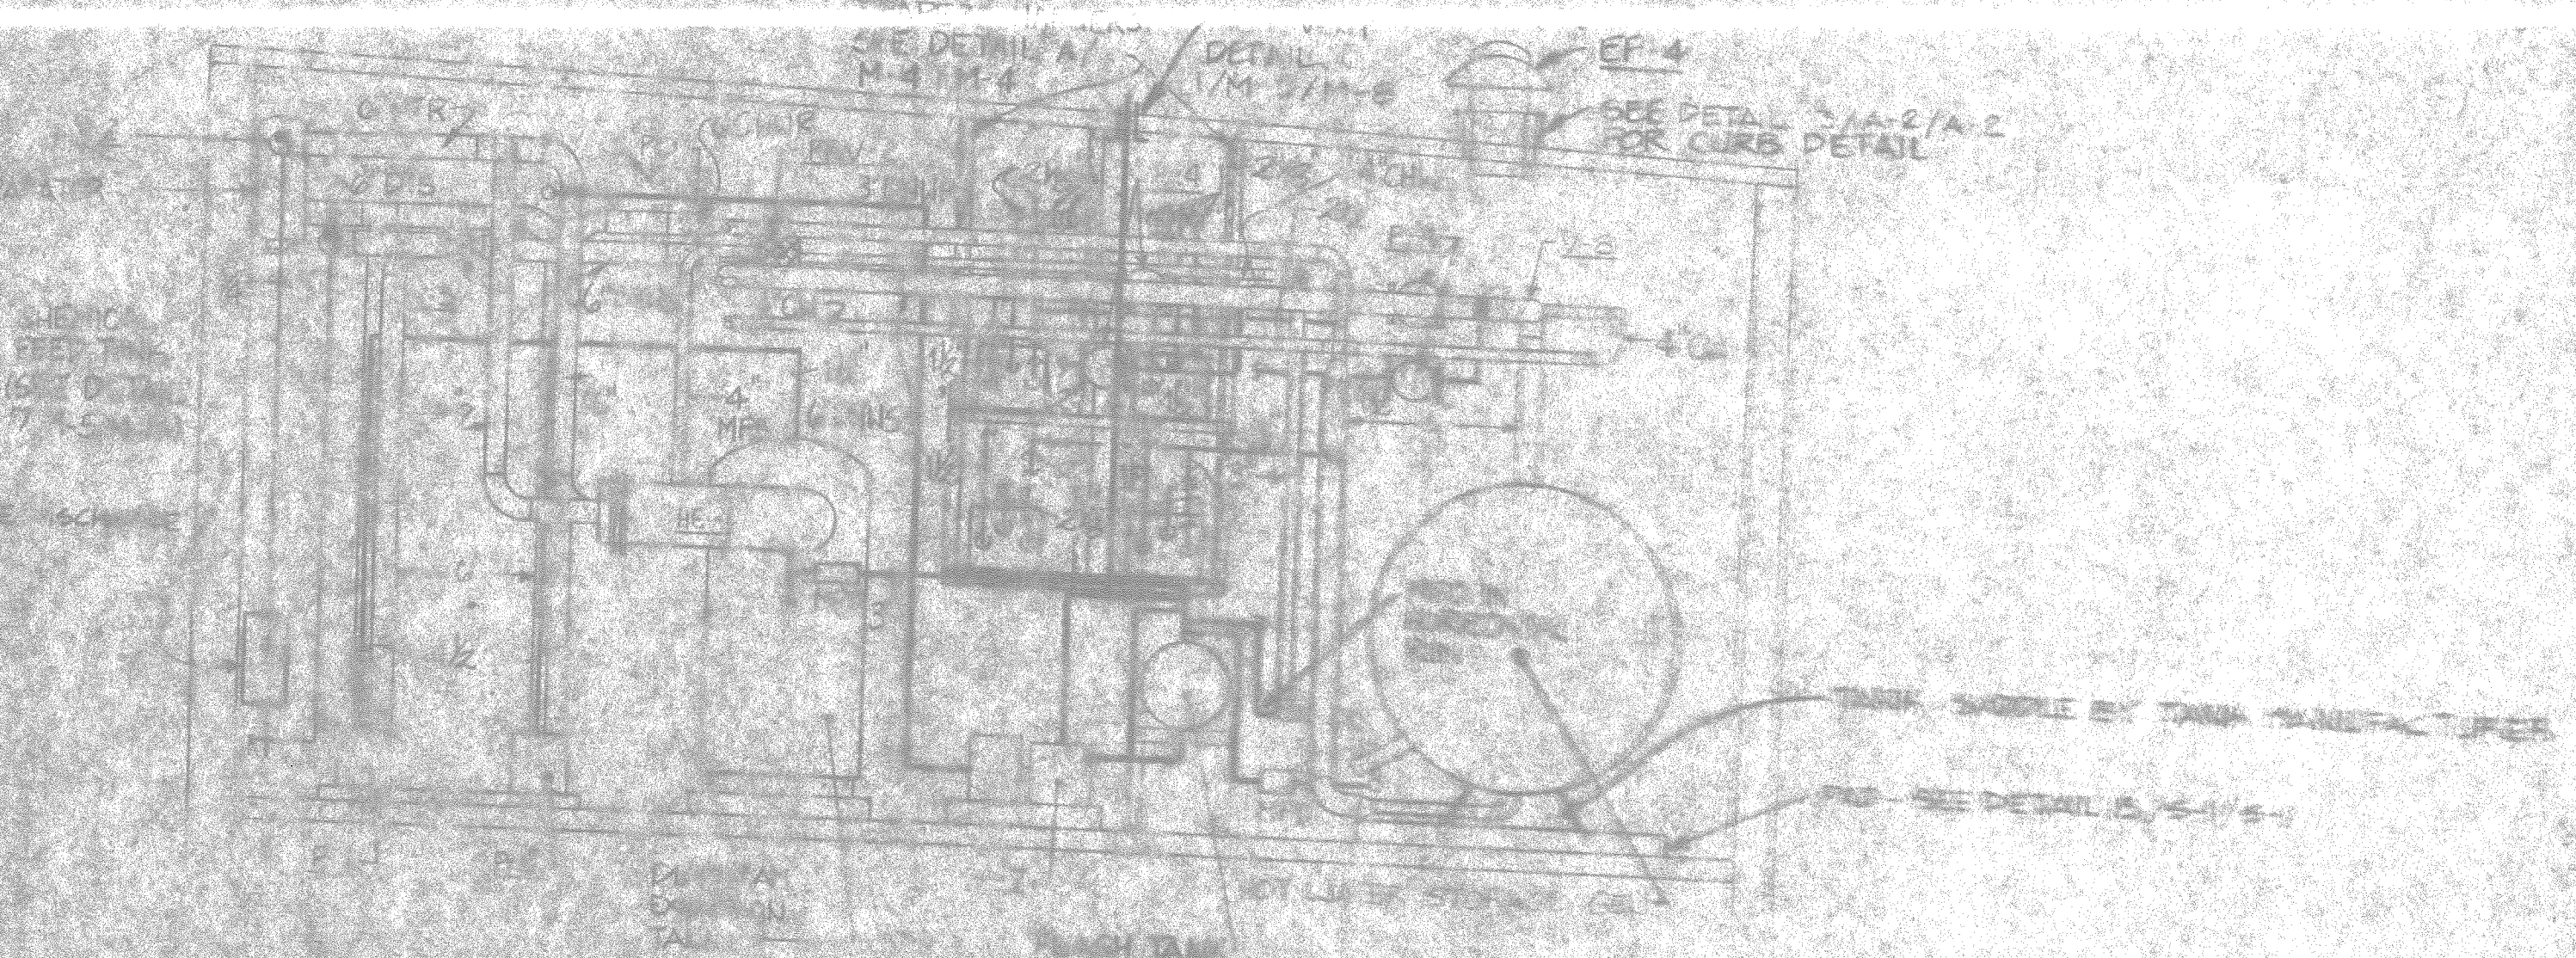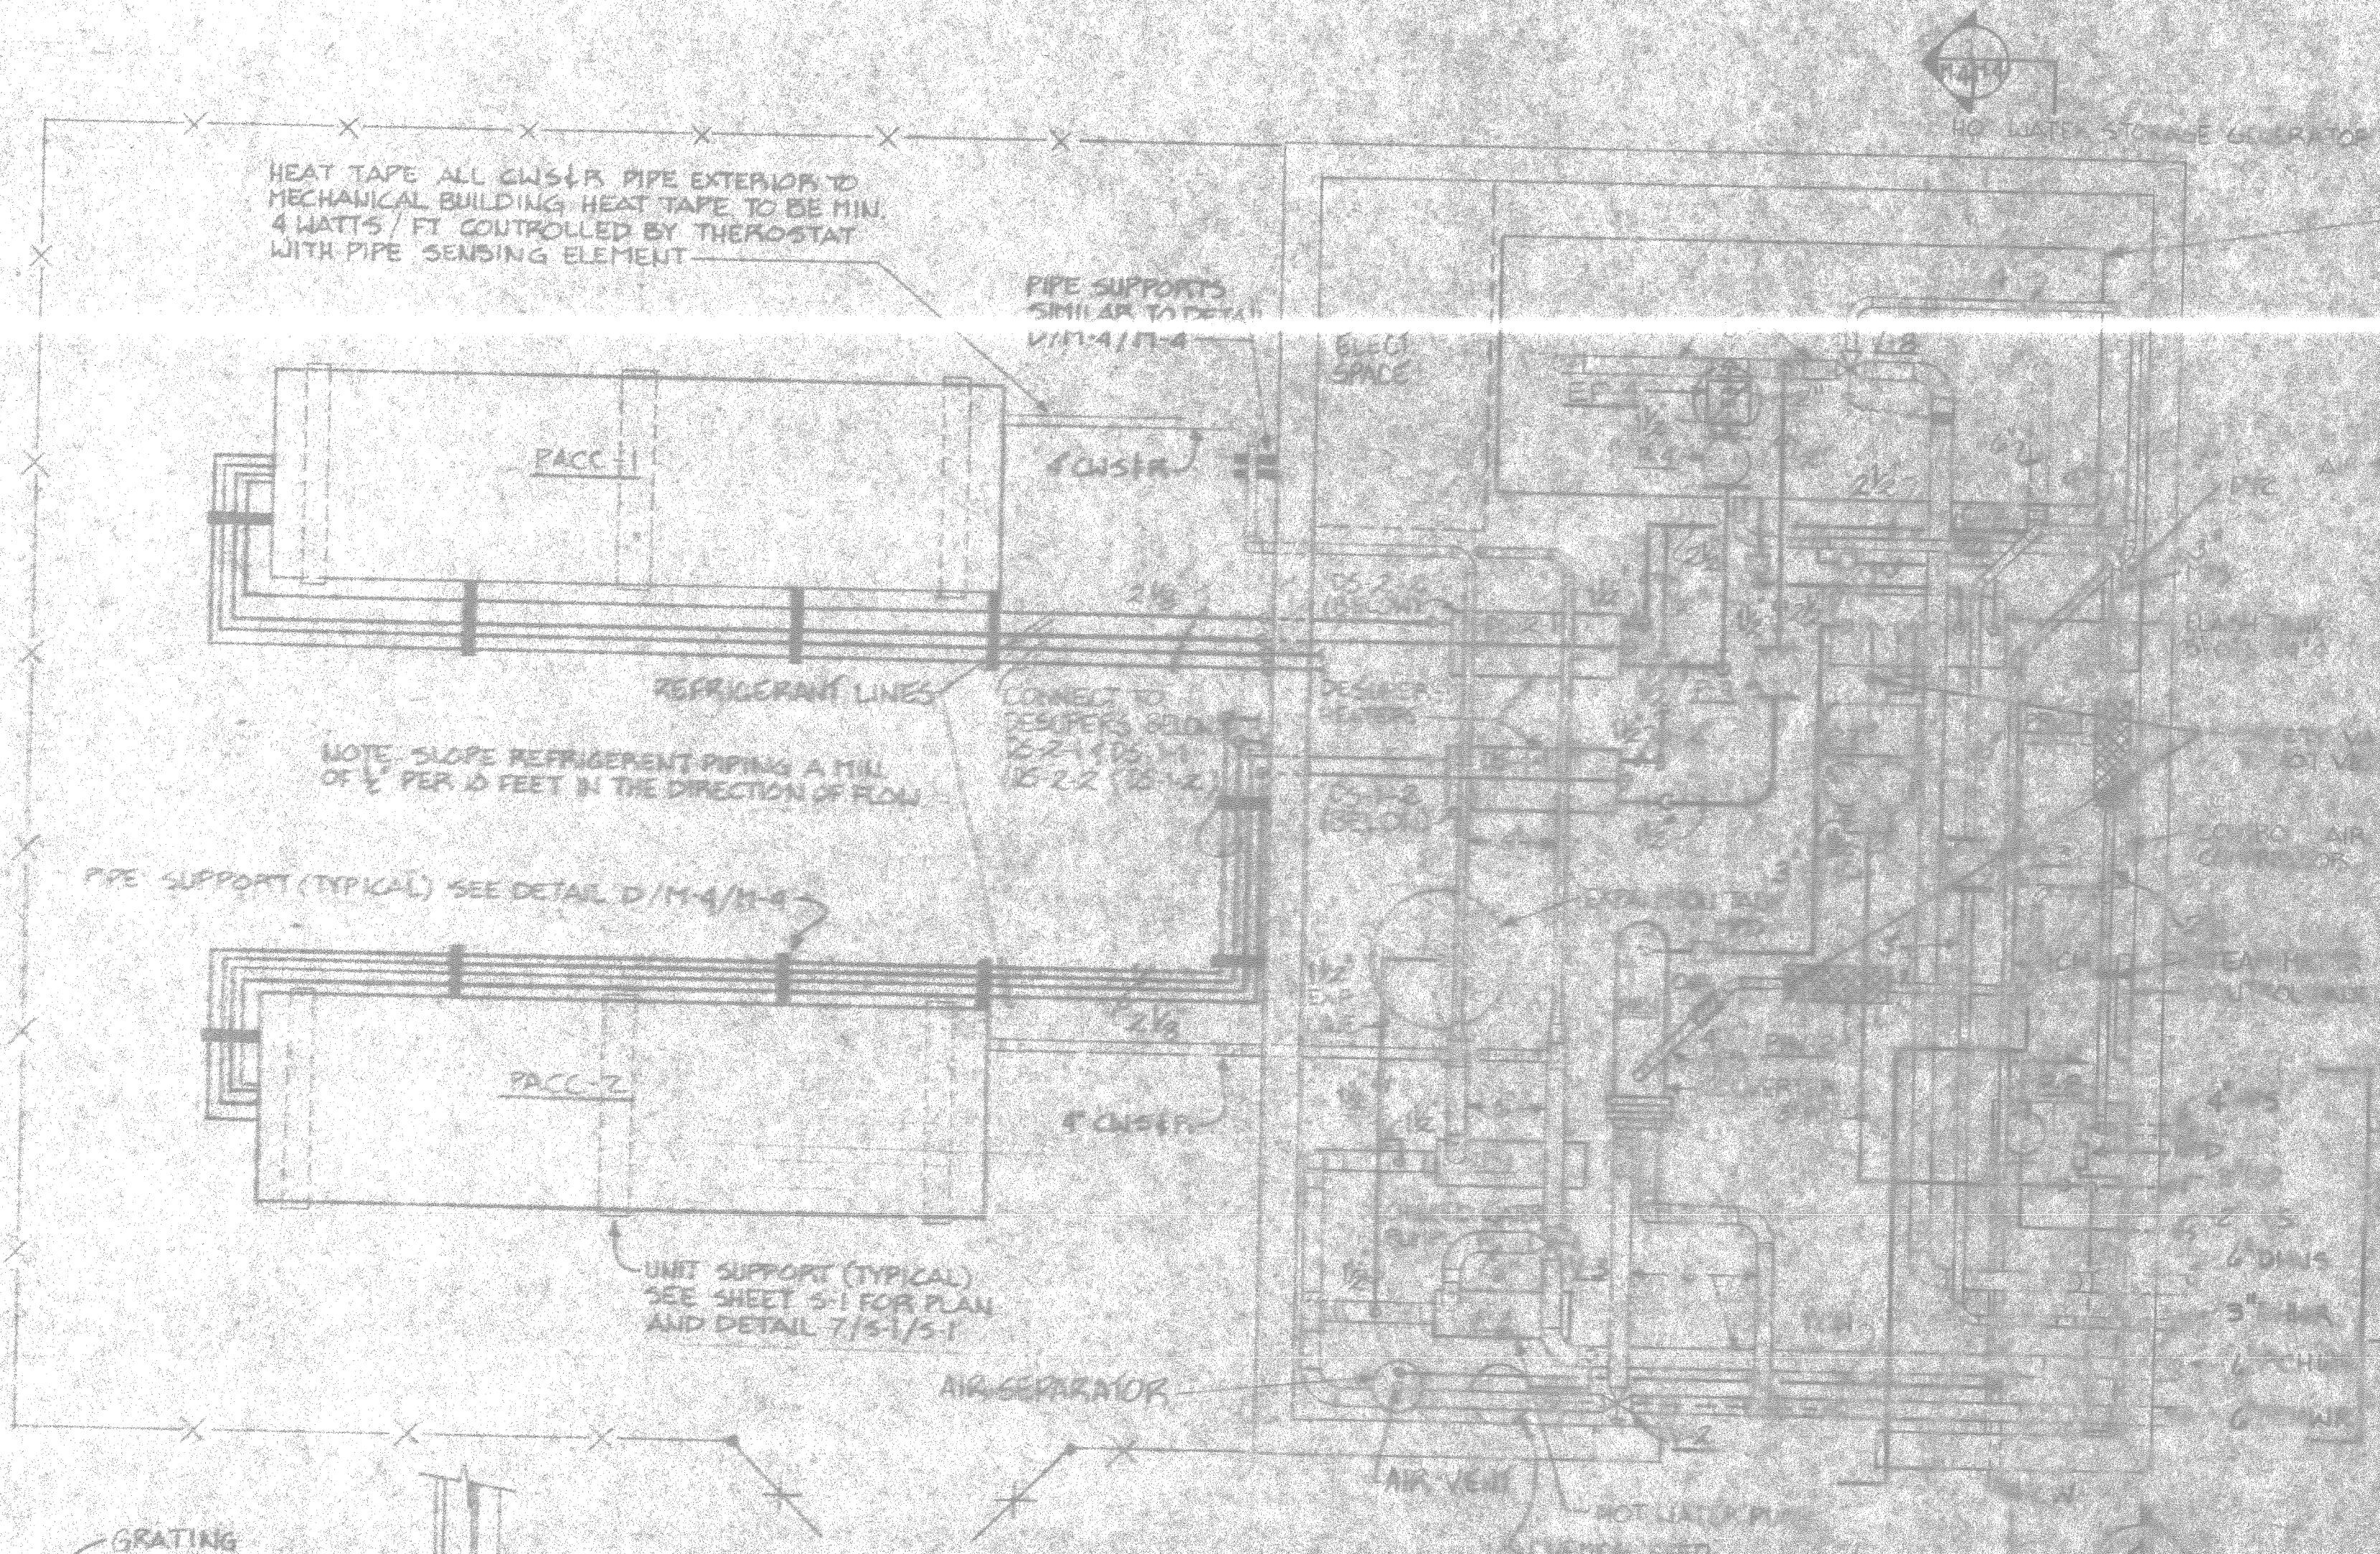


**MECHANICAL BUILDING FLOOR PLAN**


4 SECTION  
3/8" = 1'-0"

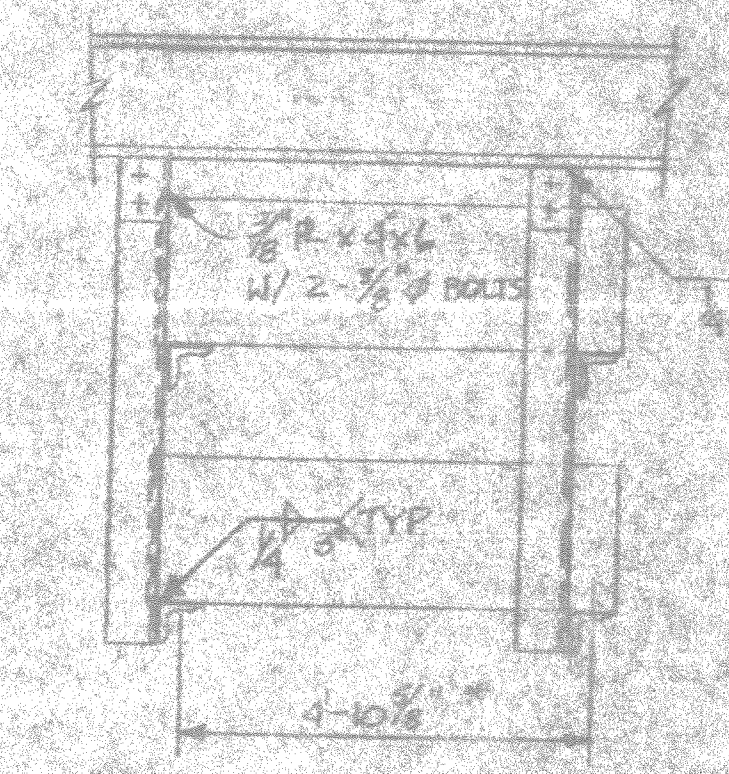

3 SECTION  
NO SCALE

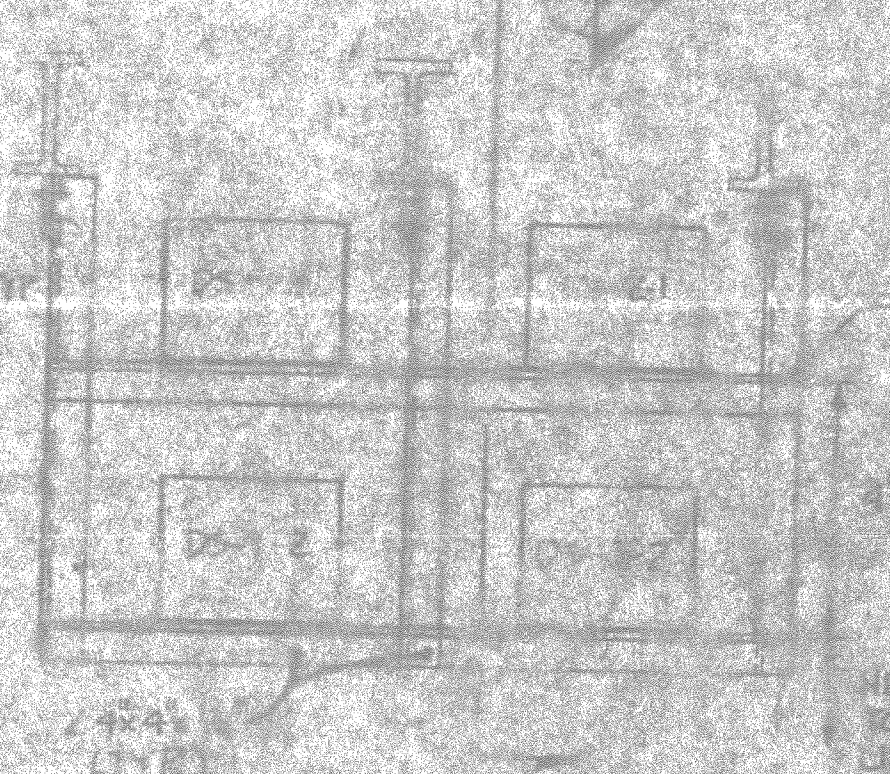


A DETAIL  
NO SCALE

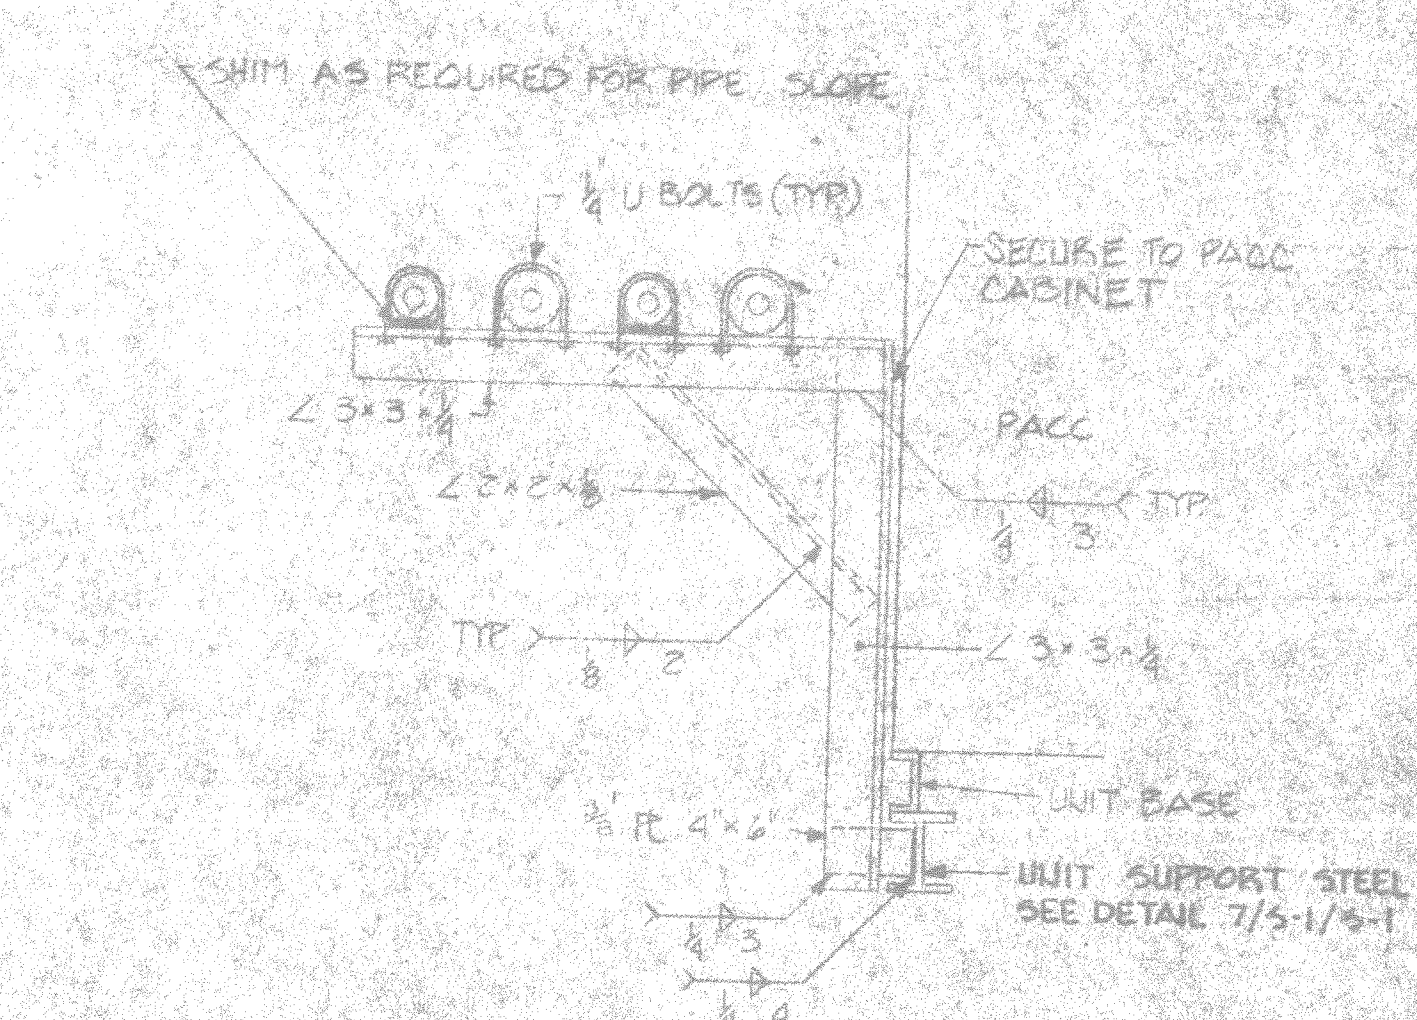


D DETAIL  
NO SCALE


SECTION  
1/4" = 1'-0"

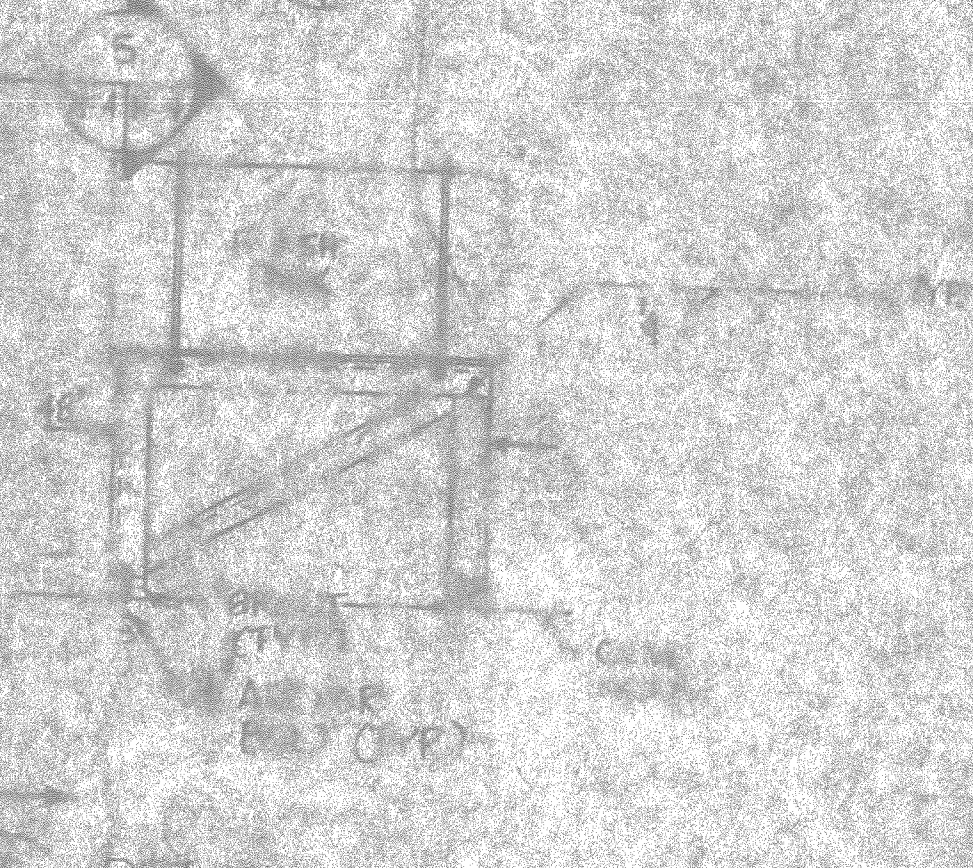

5 SECTION  
NO SCALE

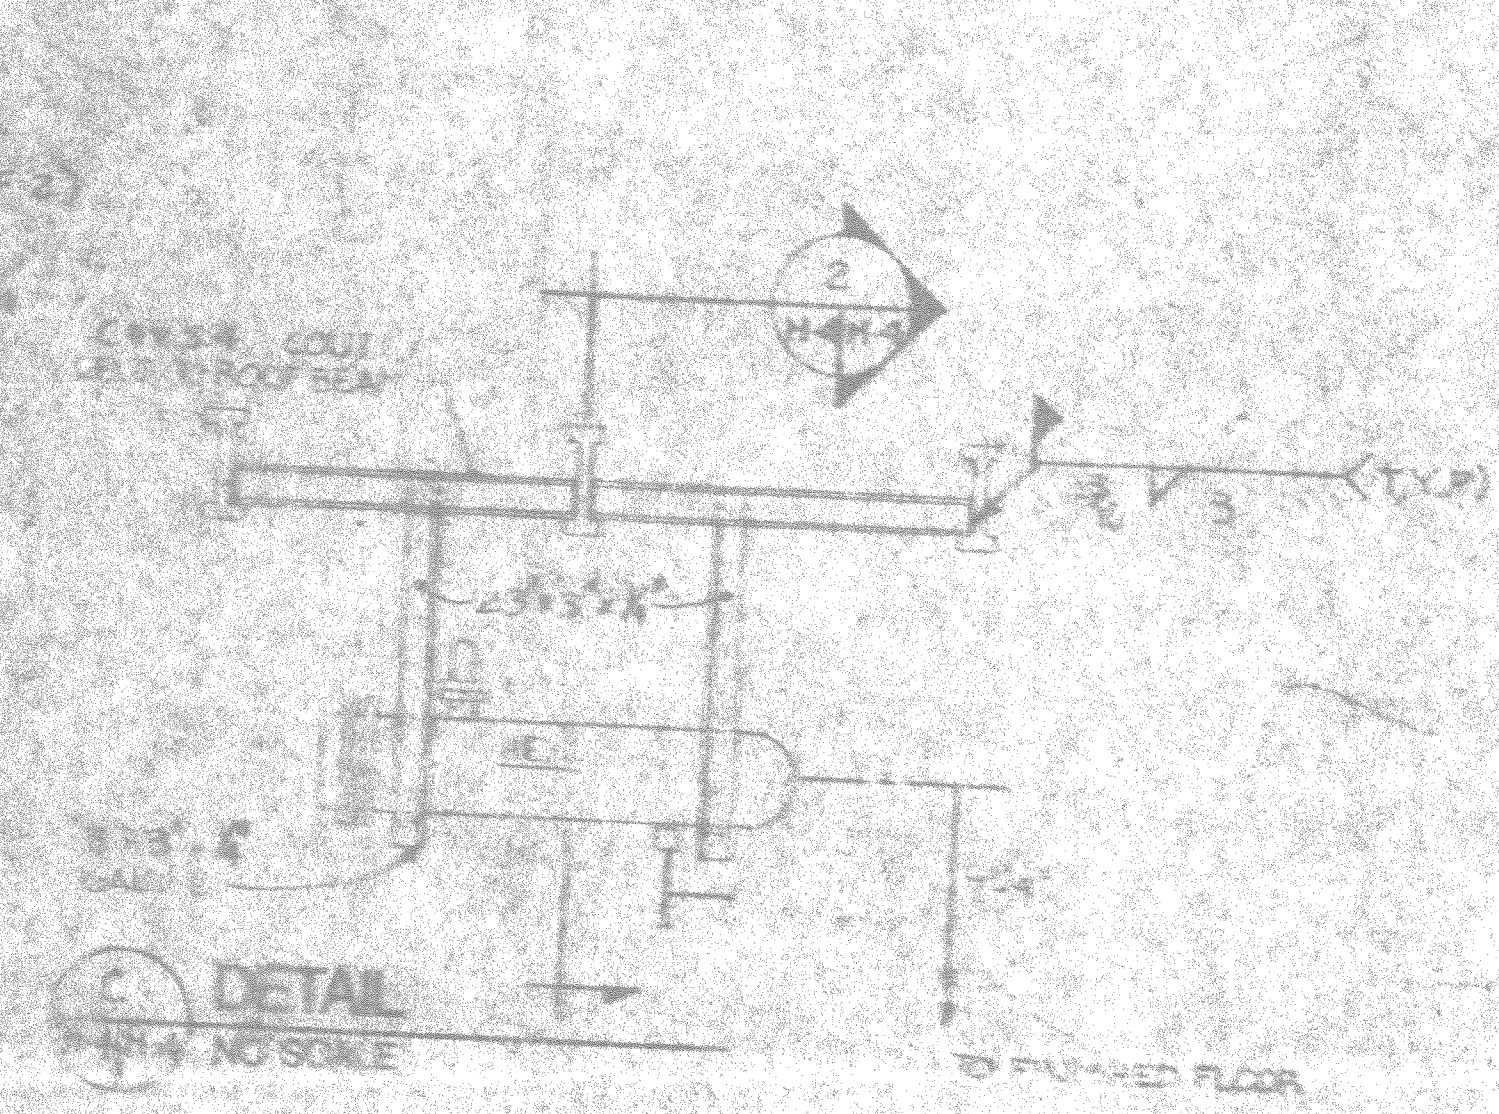

C DETAIL  
NO SCALE

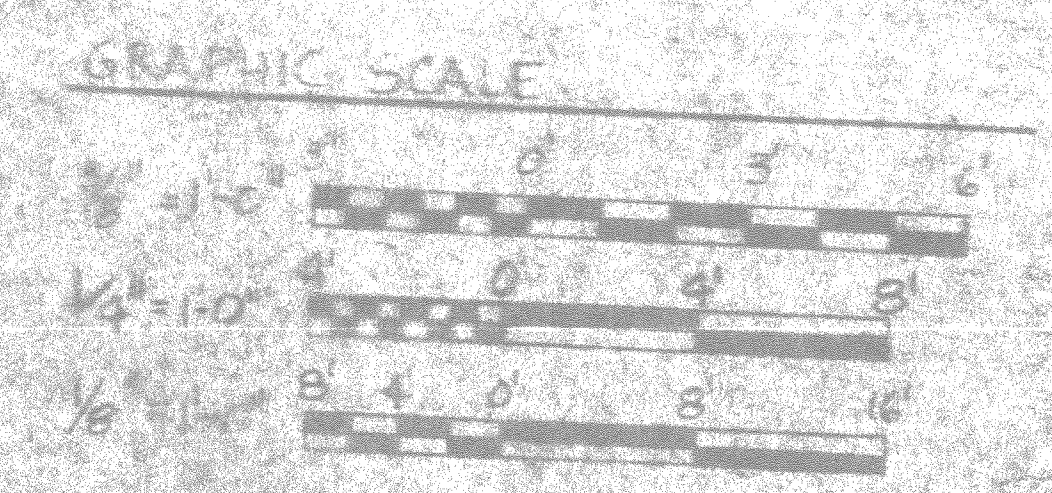

M-4

U.S. NAVAL ARCHITECTS ASSOCIATION

ARCHITECT: [Signature]

ENGINEER: [Signature]

DEPARTMENT OF THE NAVY

ATLANTIC DIVISION

NAVY FACILITIES ENGINEERING COMMAND

ROSTOCK, VIRGINIA

NAVAL STATION

MARINE CORPS BASE CAMP LEJEUNE, N.C.

BACHELOR ENLISTED QUARTERS

MECHANICAL BUILDING PLAN

DATE: 12-1956

SIZE: 11" x 17"


CODE IDENT. NO.: F 80091

NAVAC DRAWING NO.: 4155178












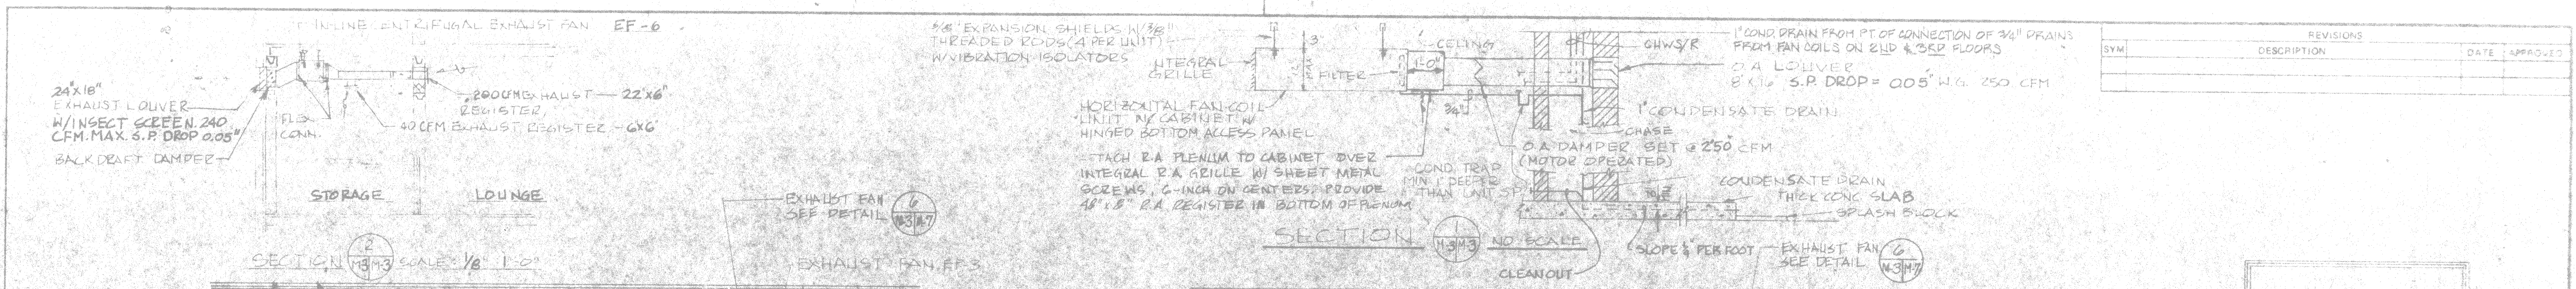

REVISIONS		
SYM	DESCRIPTION	DATE APPROVED

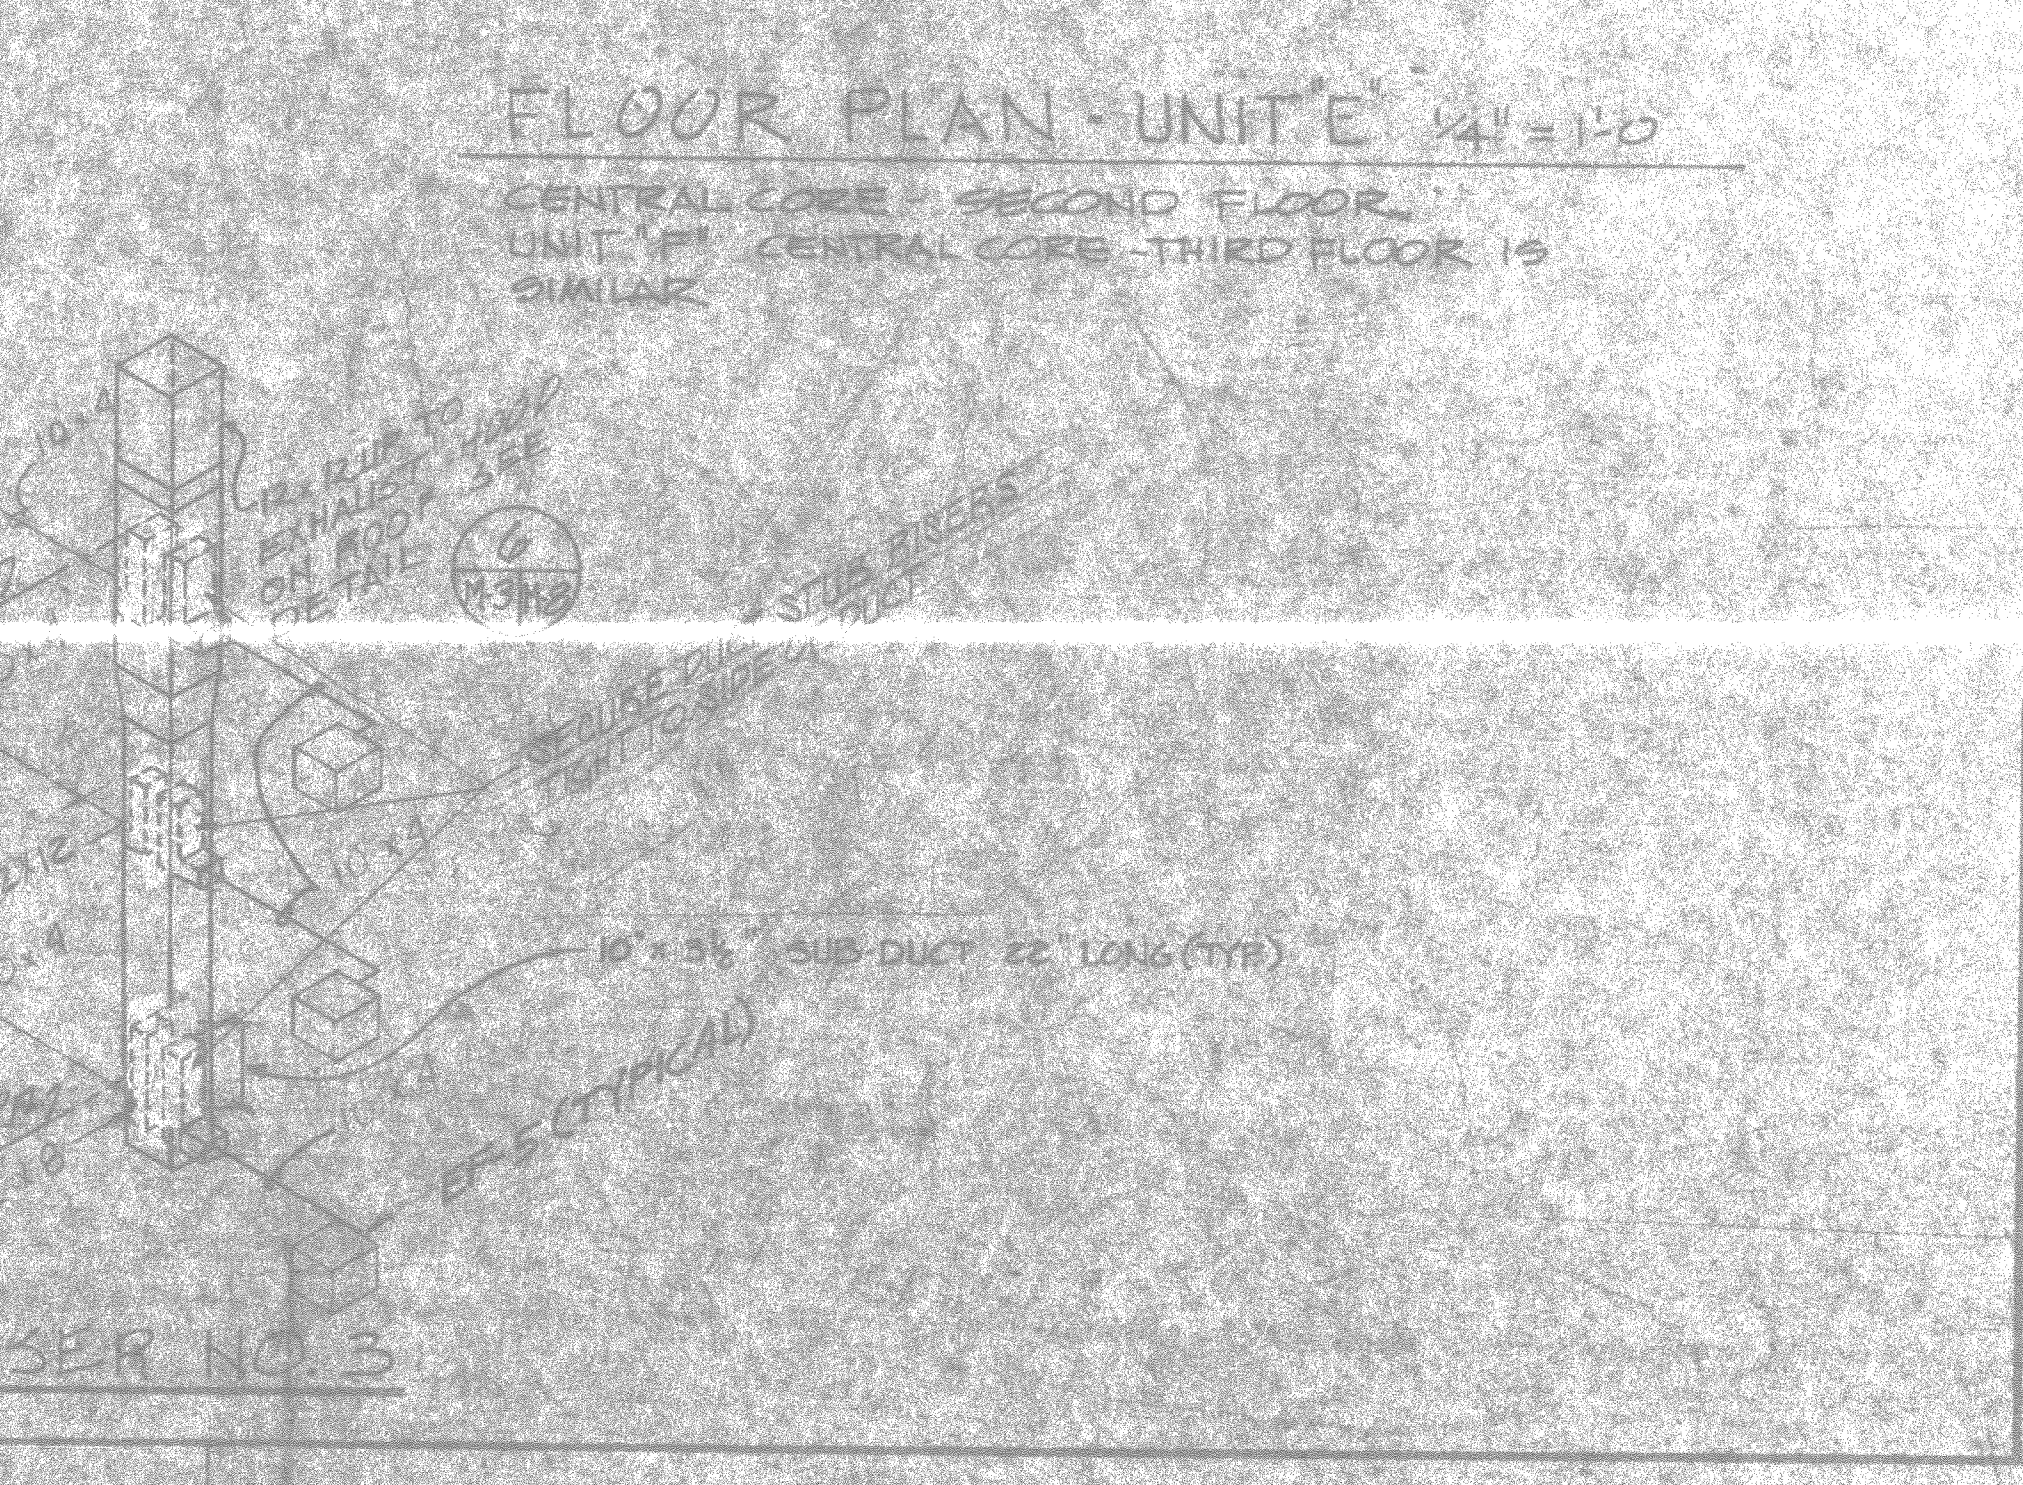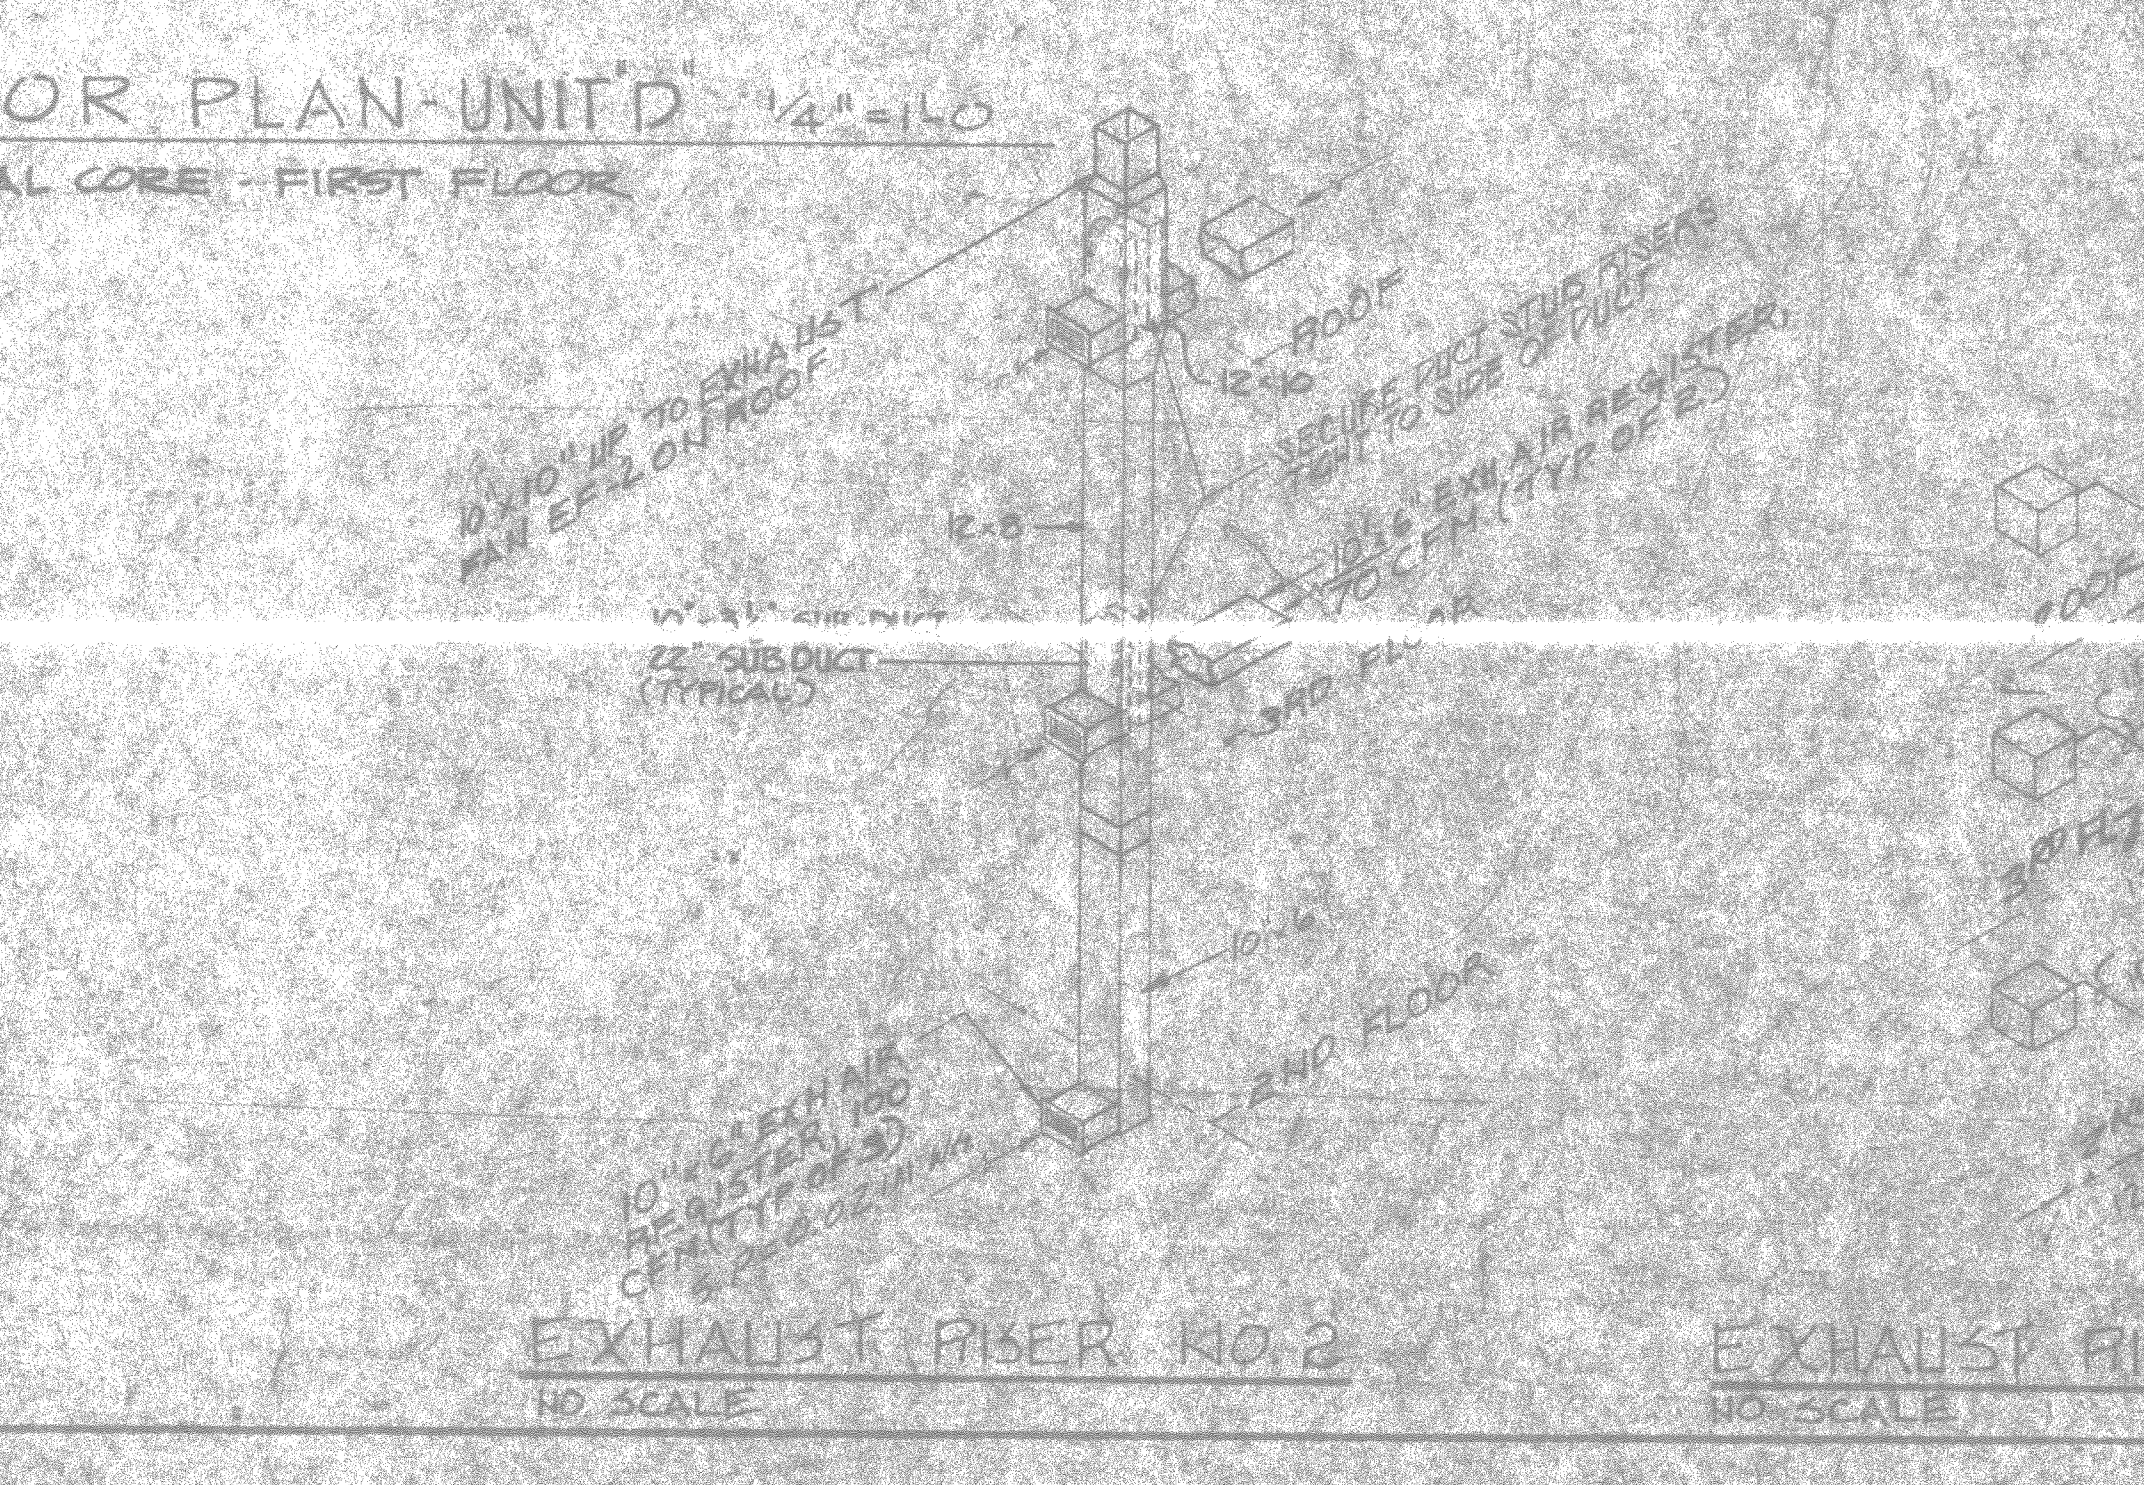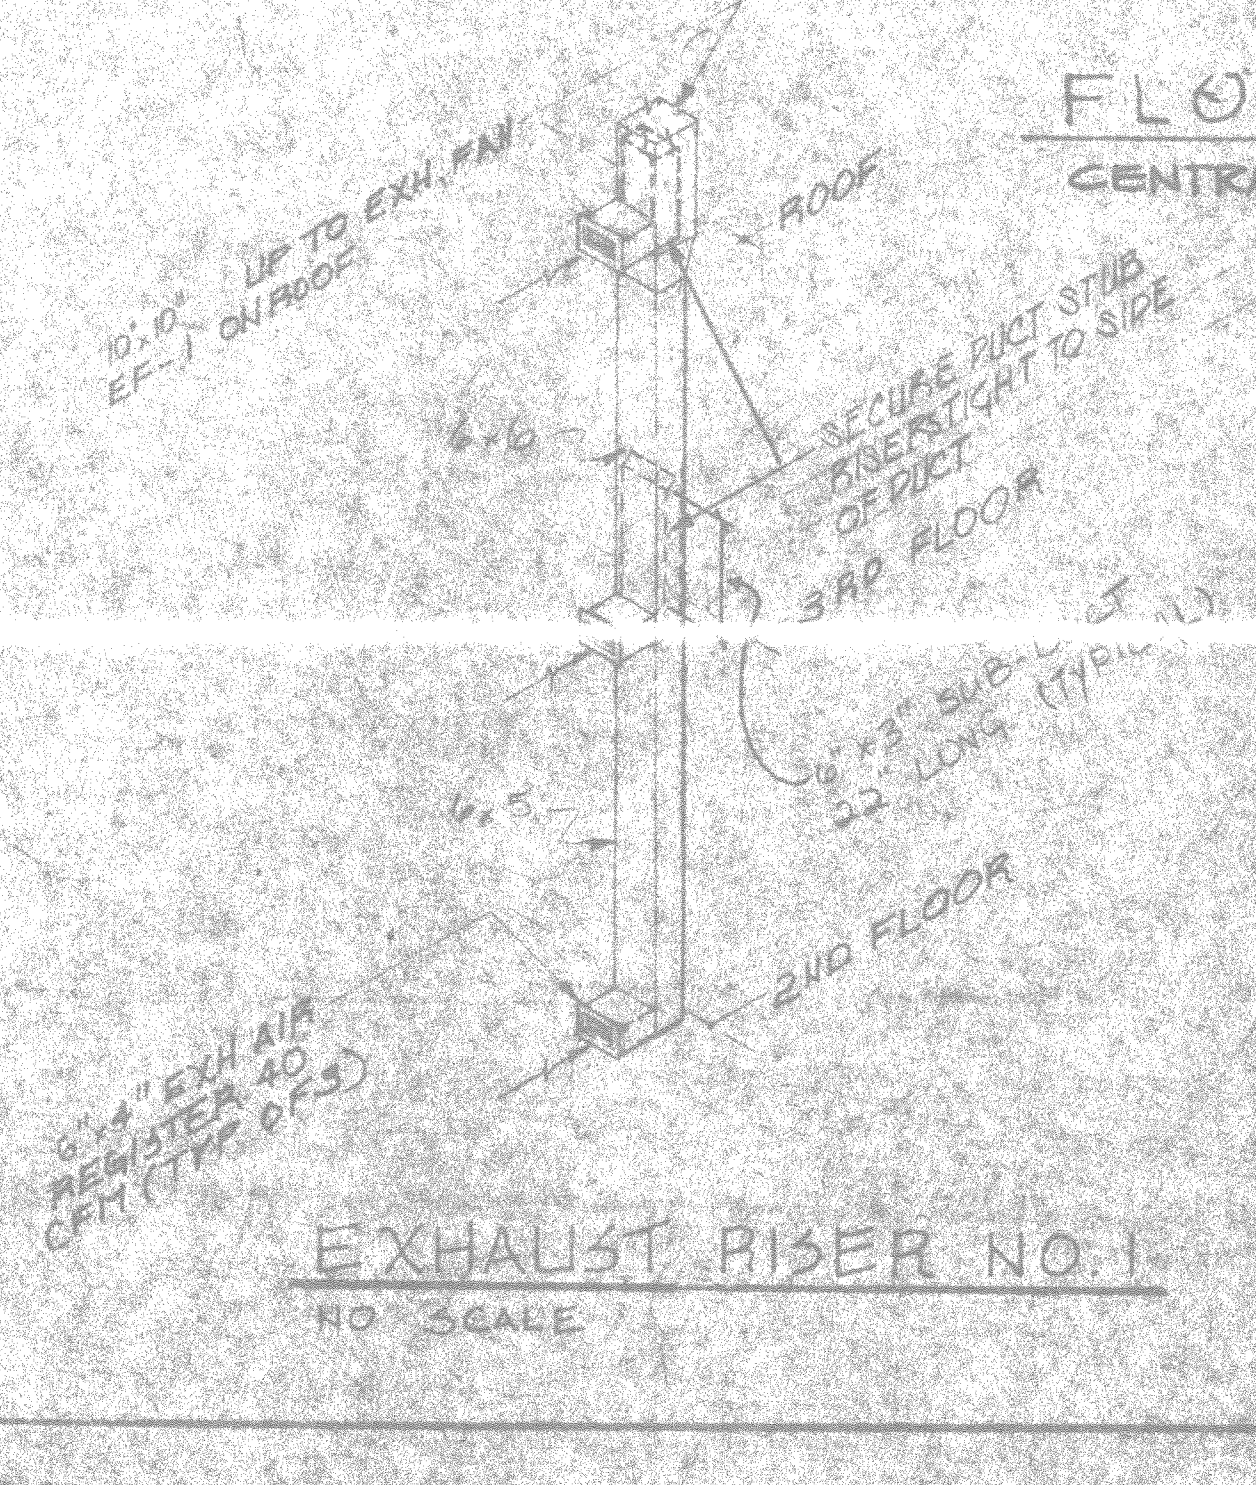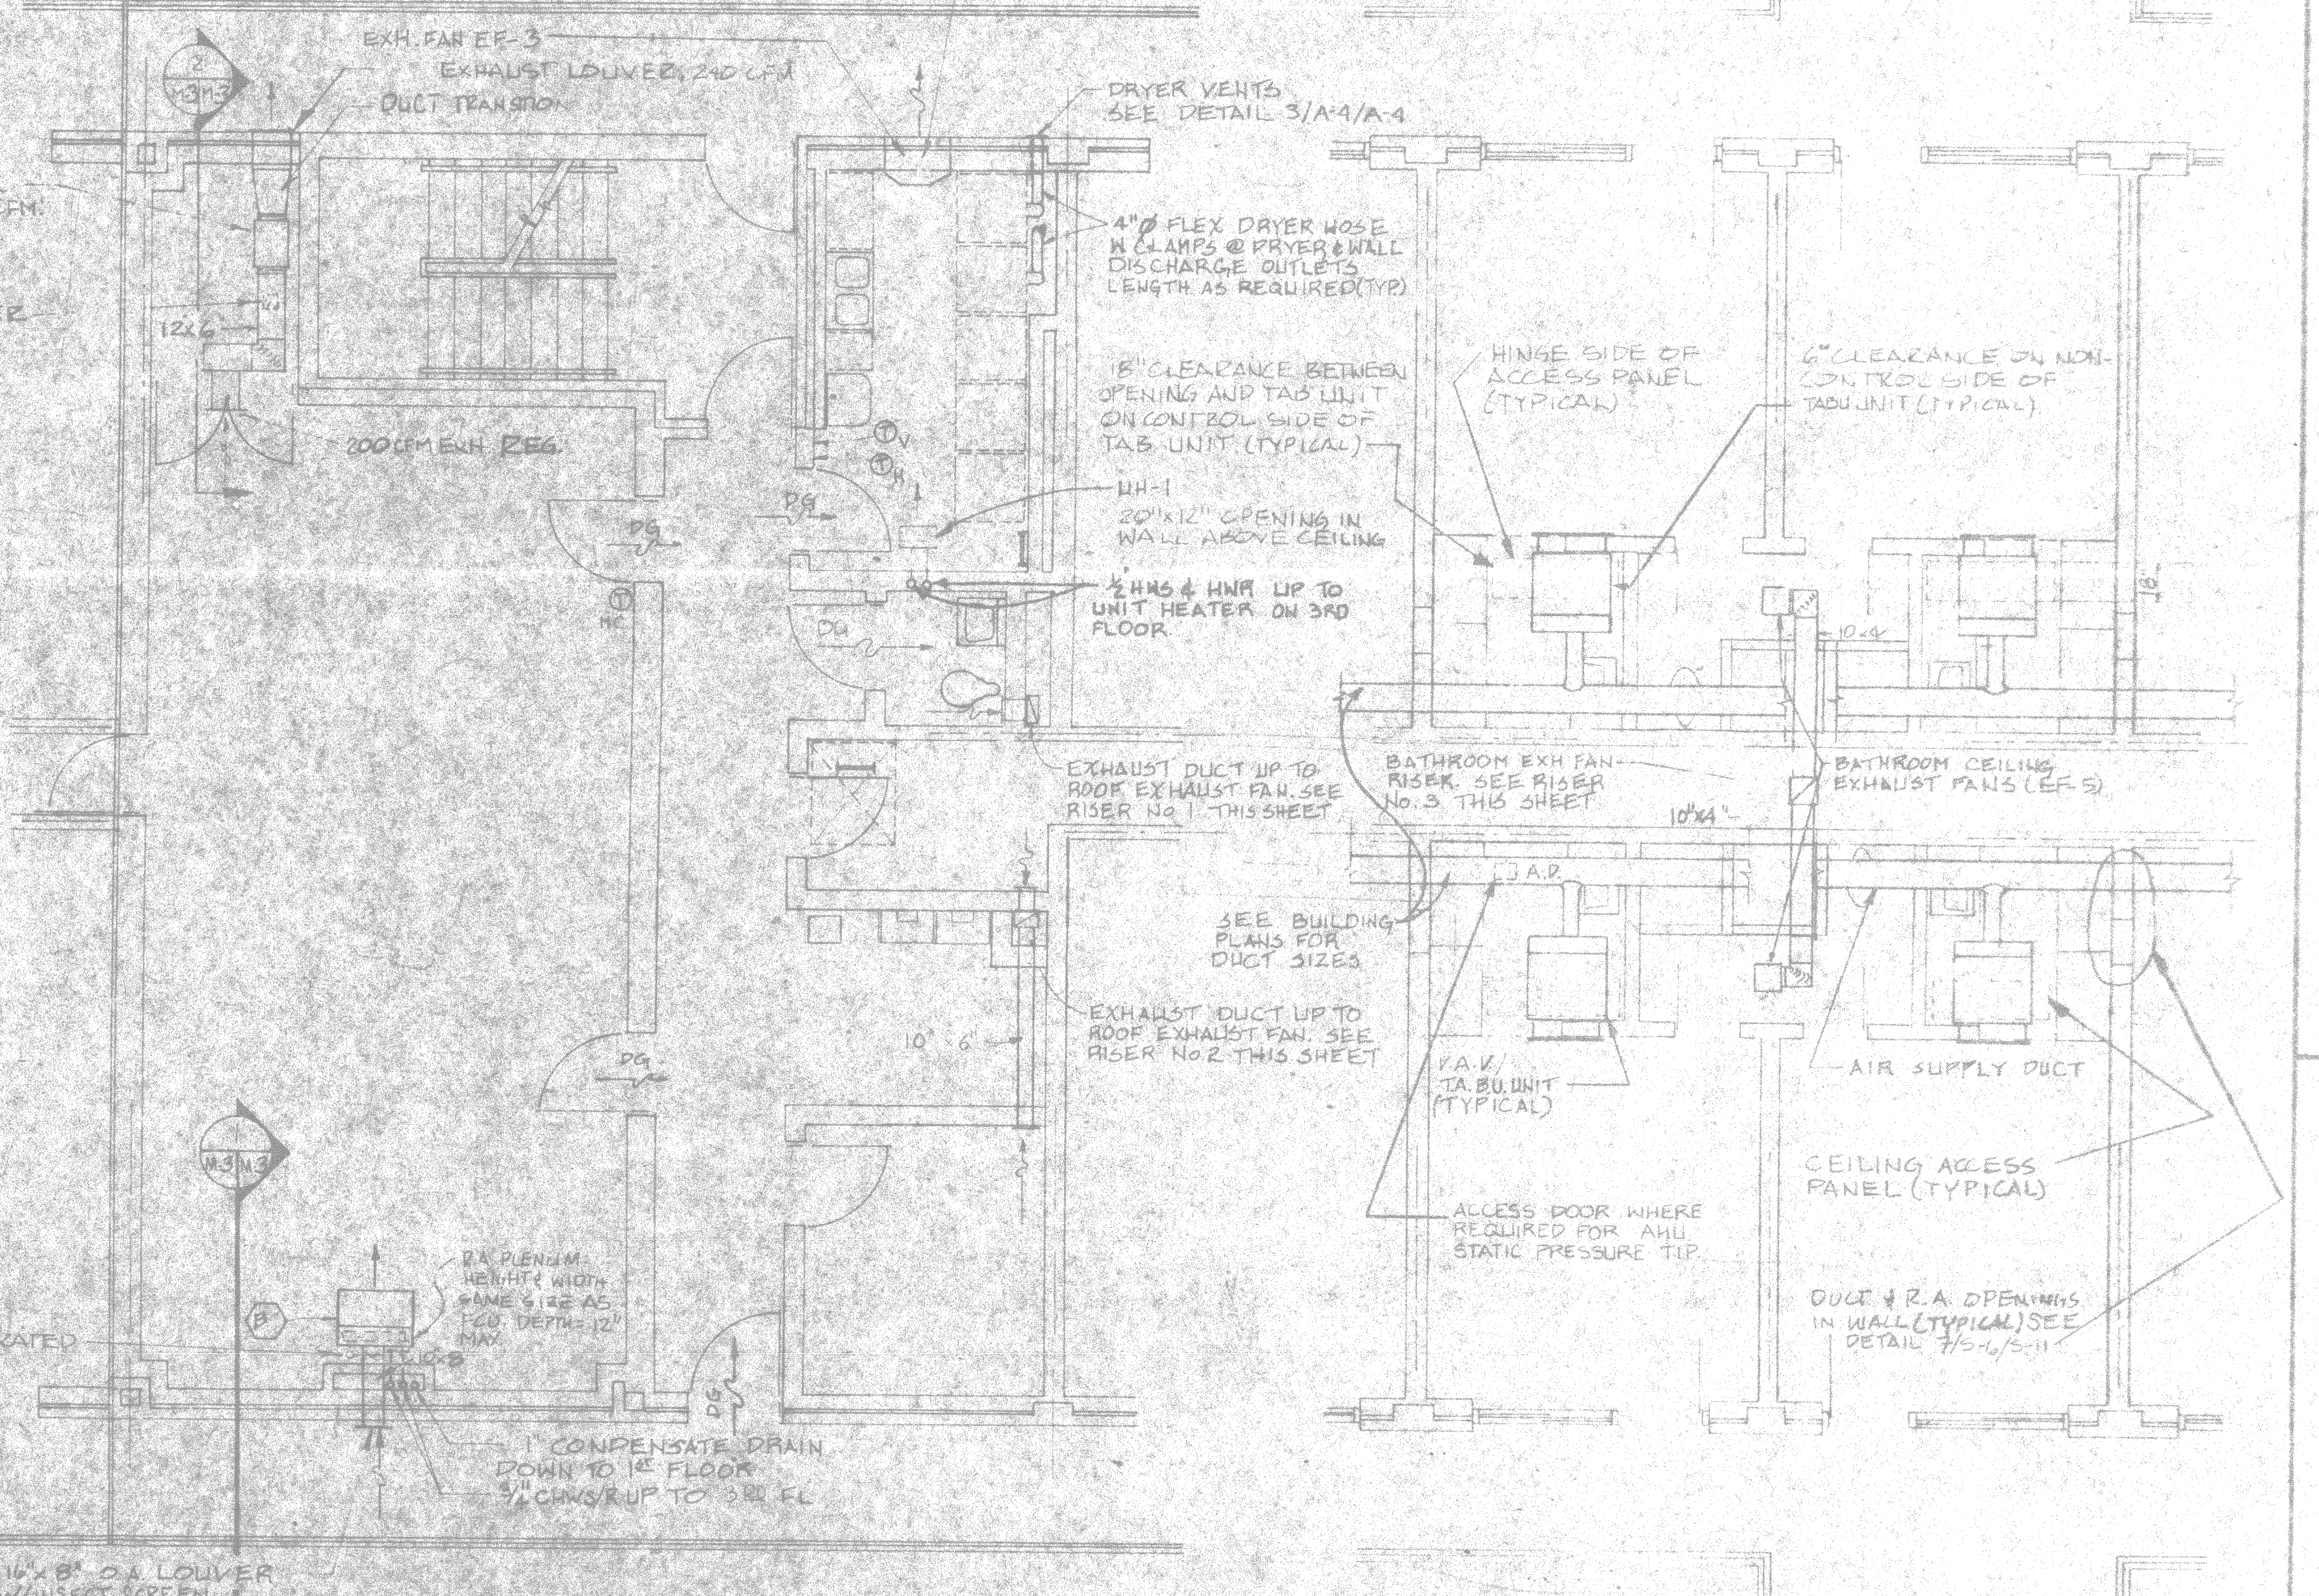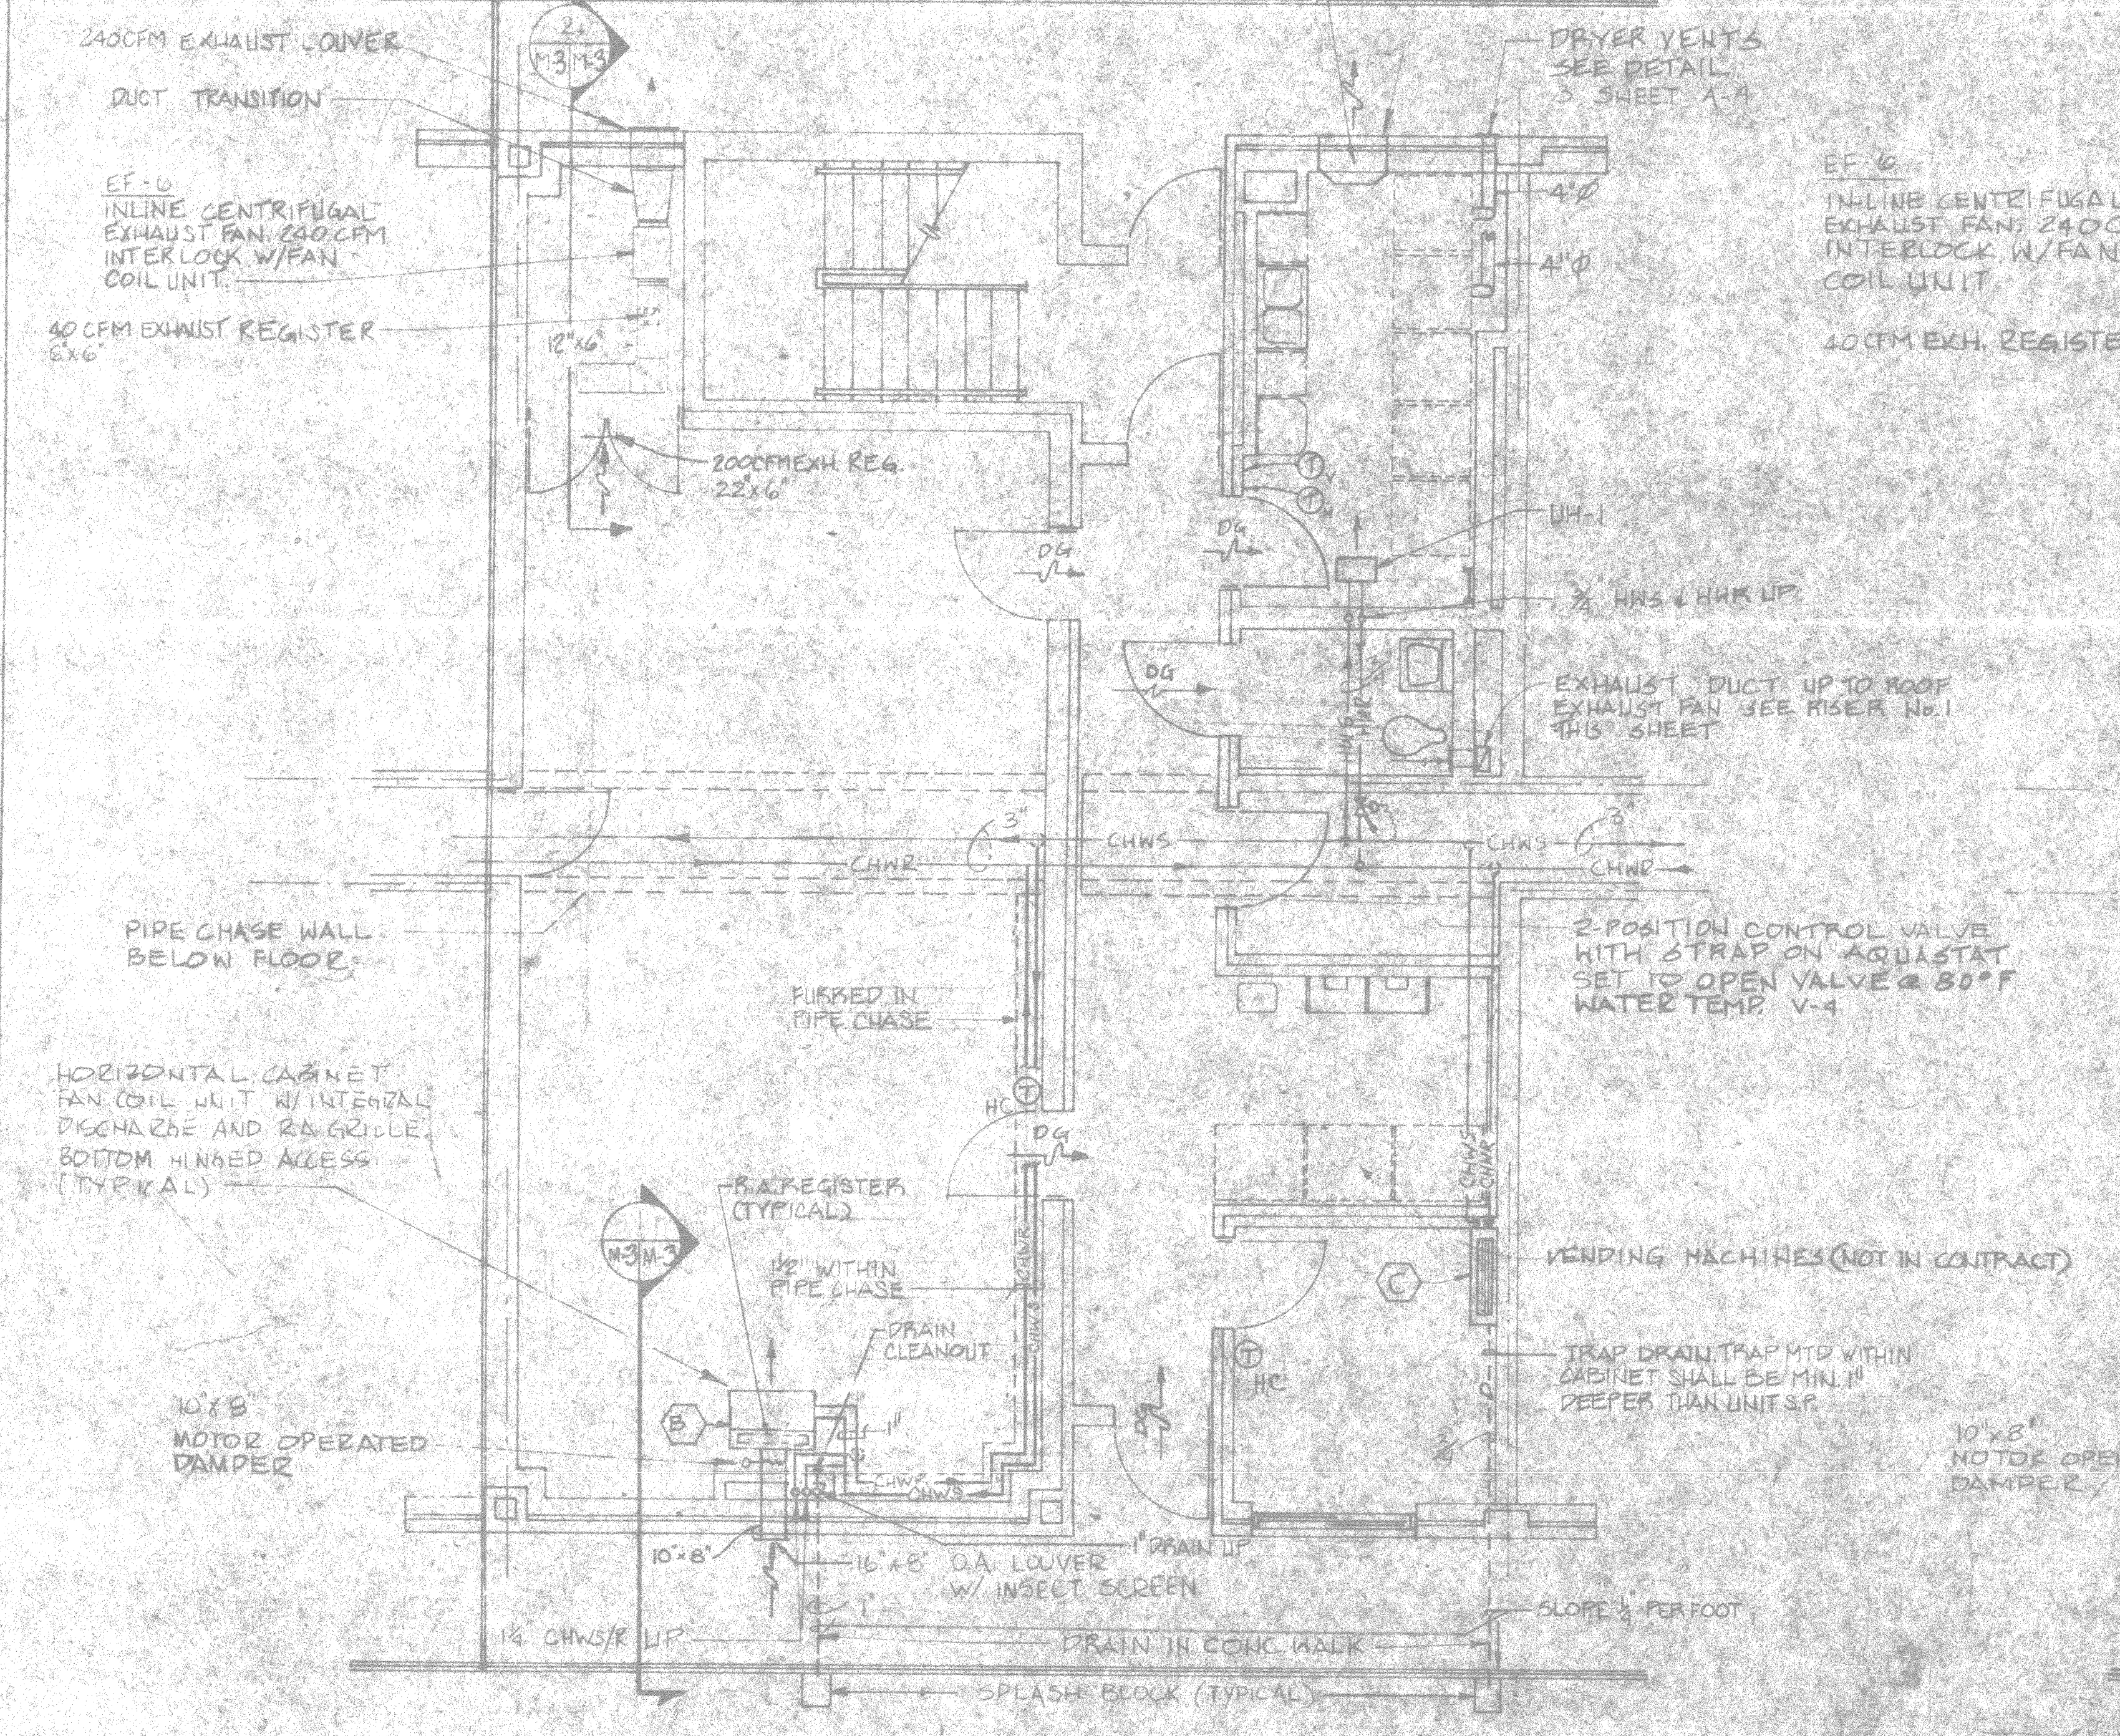

FLOOR PLAN UNIT "B" 1/4" = 1'-0"  
TYPICAL SLEEPING ROOM  
UNIT "A" AND UNIT "C" SIMILAR




		<b>M-3</b>	
		J. M. PEASE ASSOCIATES ARCHITECTS - ENGINEERS - PLANNERS CHARLOTTE NORTH CAROLINA	
DEPARTMENT OF THE NAVY NAVAL FACILITIES ENGINEERING COMMAND <b>ATLANTIC DIVISION</b>		NAVAL STATION NORFOLK VIRGINIA MARINE CORPS BASE CAMP LEJEUNE, N.C. BACHELOR ENLISTED QUARTERS	
PROJECT NO. 05-55-5142 DRAWING NO. 05-55-5142-118 SHEET 7B OF 118		TYPICAL HVAC PLANS - UNIT "B", "D", "E", & "F"	
DATE 10/1/55 DRAWN BY J. M. PEASE CHECKED BY J. M. PEASE IN CHARGE J. M. PEASE		NAVFAC DRAWING NO. 155177 CONSTR. CONTR. NO. N62470-85-B-5142 SCALE AS SHOWN SPEC. 05-55-5142	
FOR EPD FOR COMMANDER, NAVFAC		EPD DWG. NO. 265177	









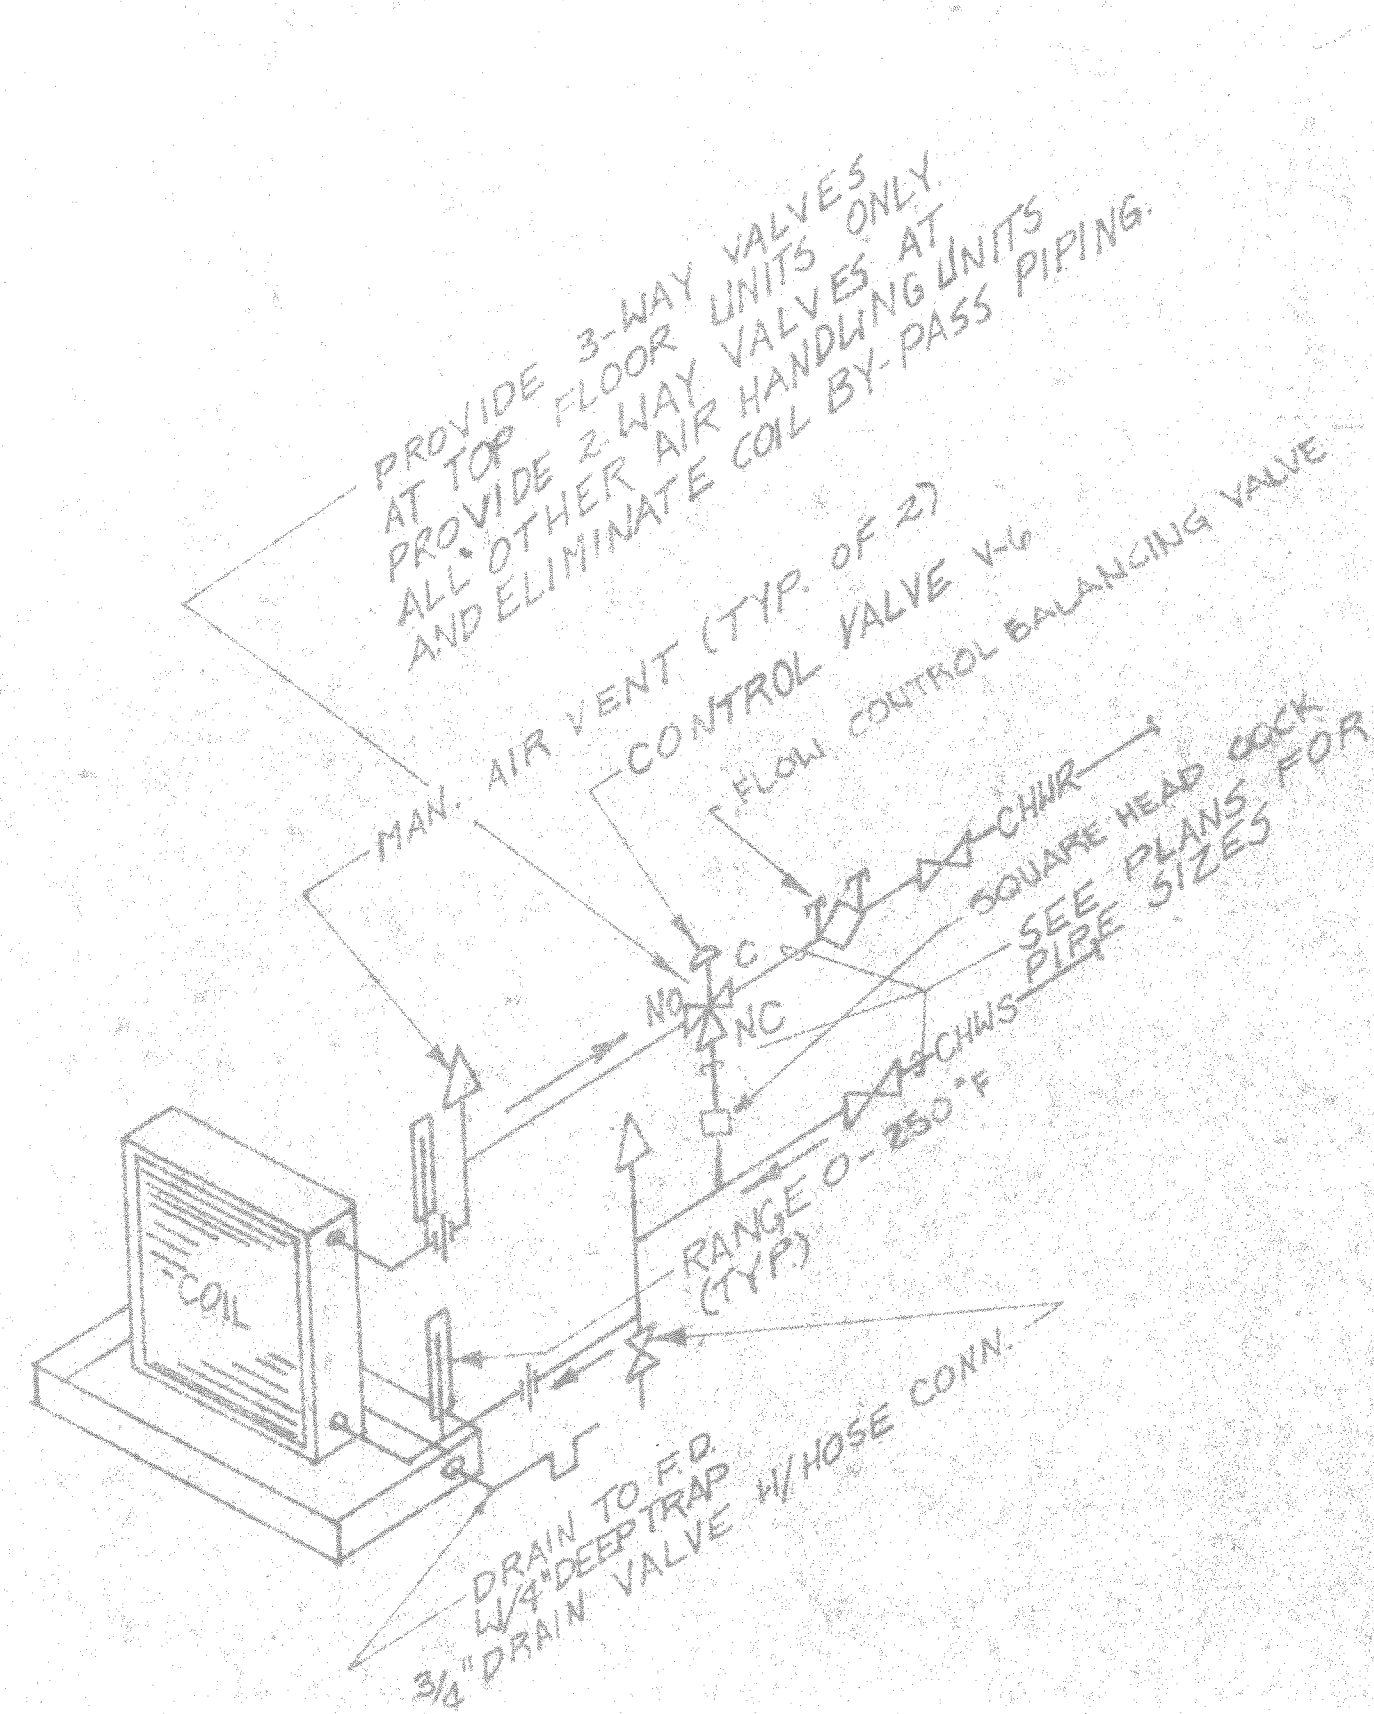


1 AHU COIL PIPING DIAGRAM  
NO SCALE

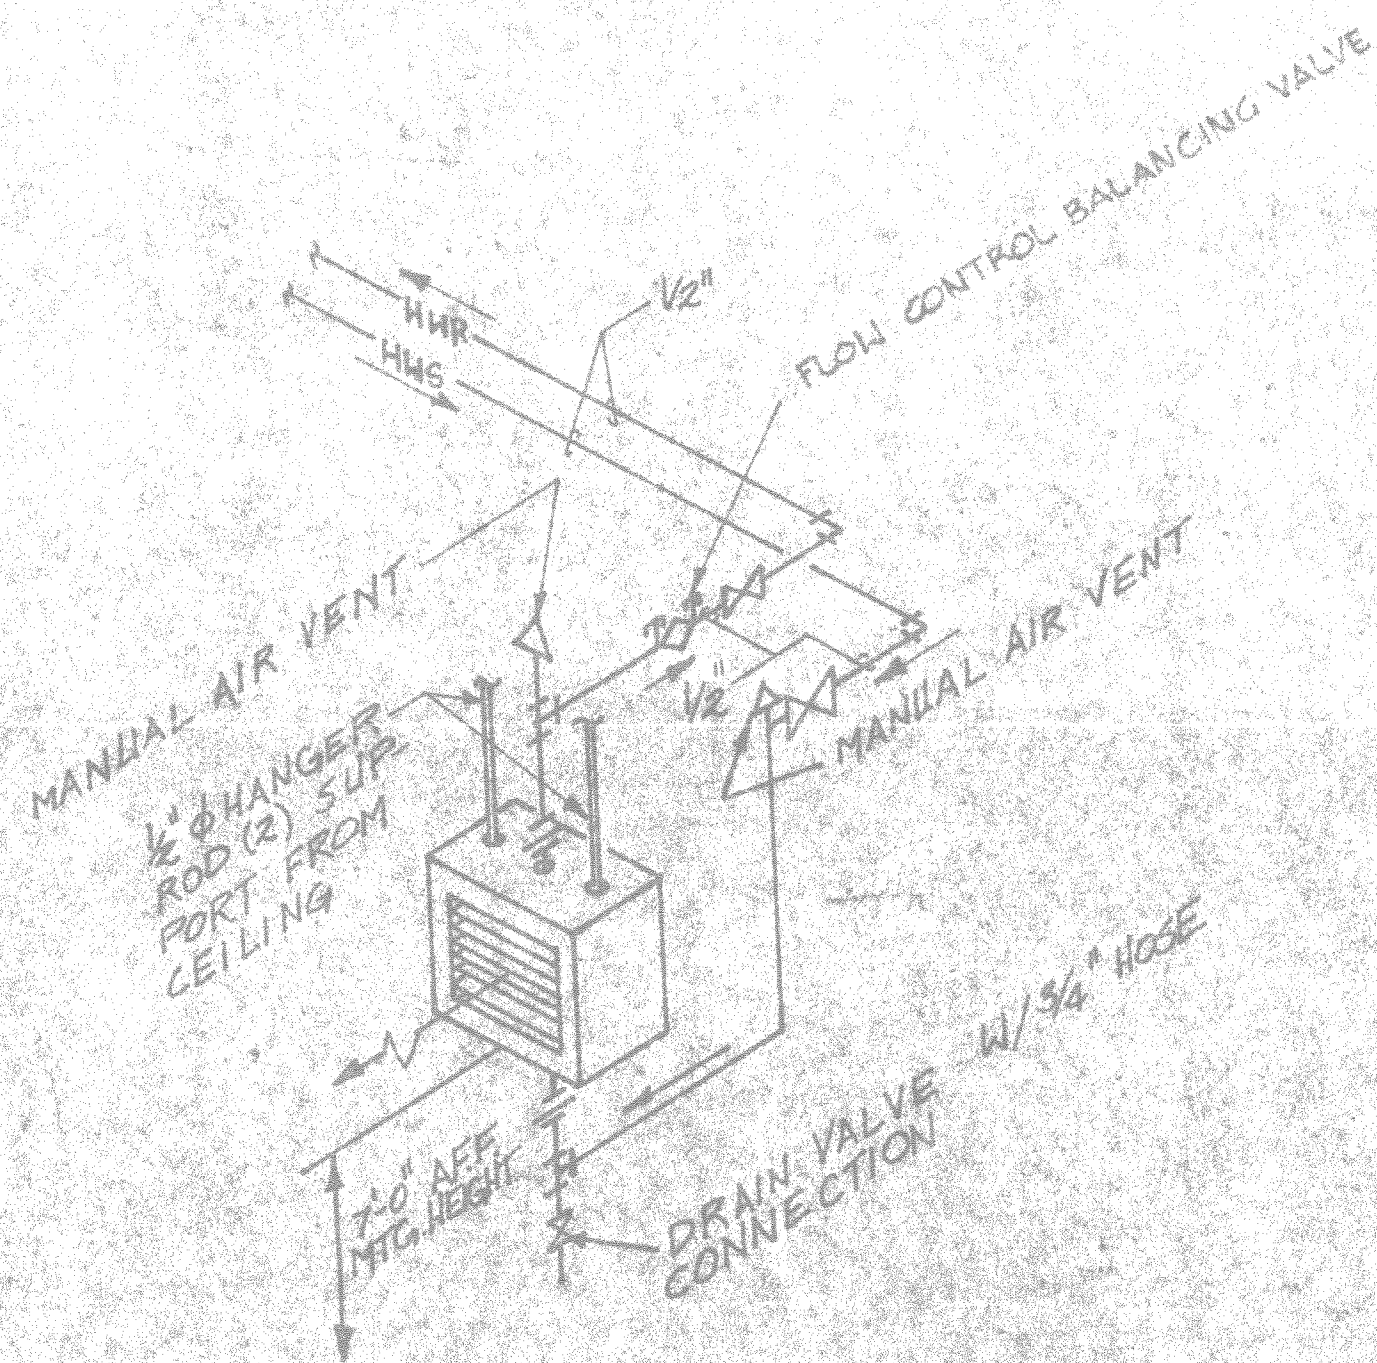


4 UNIT HEATER DETAIL  
NO SCALE

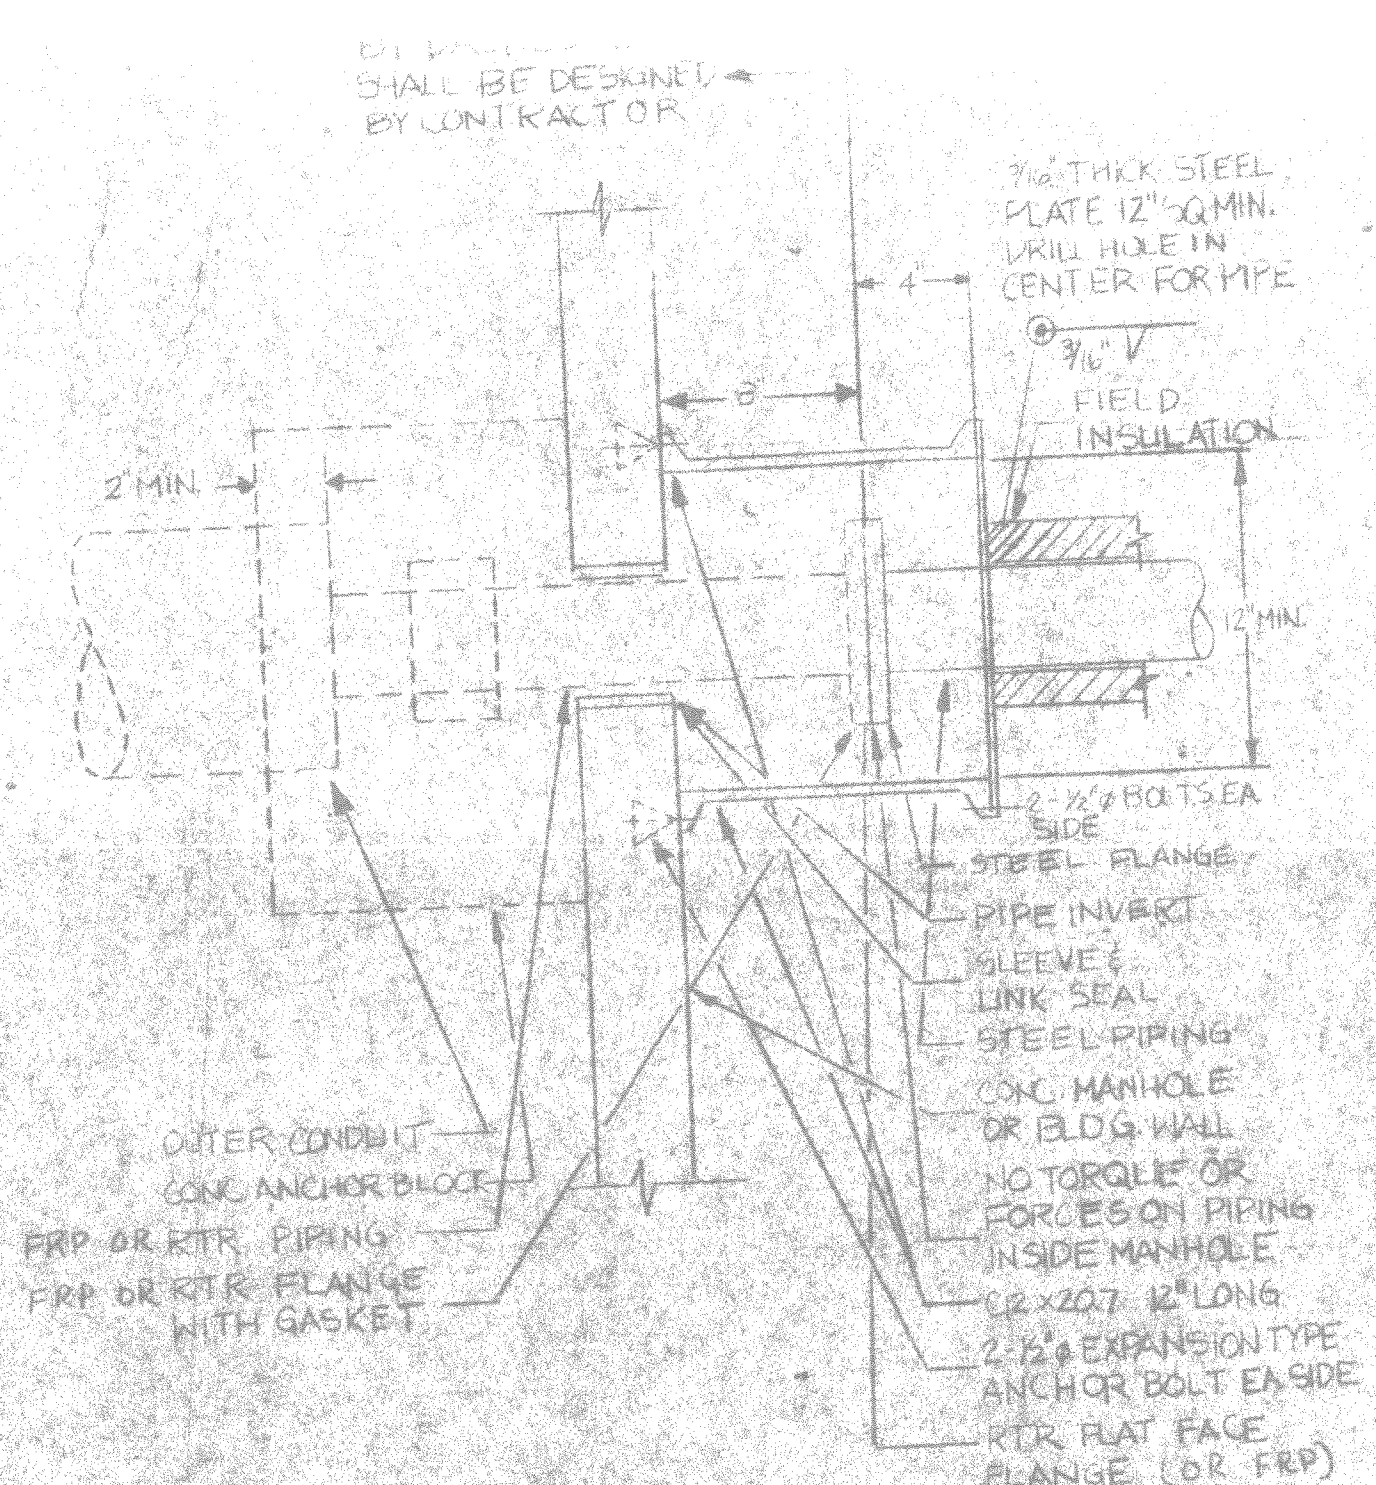


7 DETAIL CONDENSATE PIPE PENETRATION  
MANHOLE & STEAM FIT PENETRATION AT HP-SH  
NO SCALE

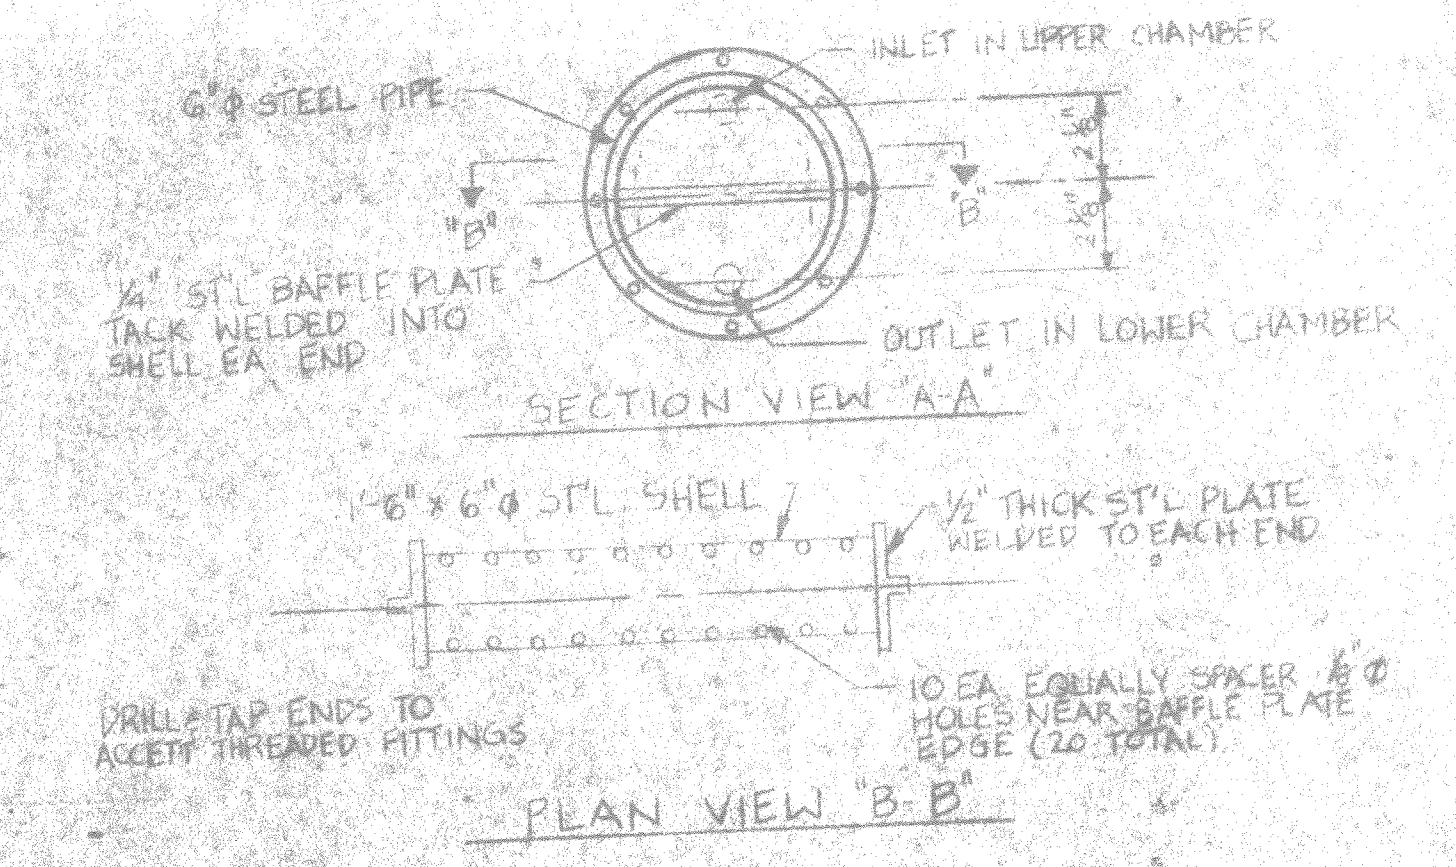


10 DETAIL BAFFLE CHAMBER CONSTRUCTION  
NO SCALE

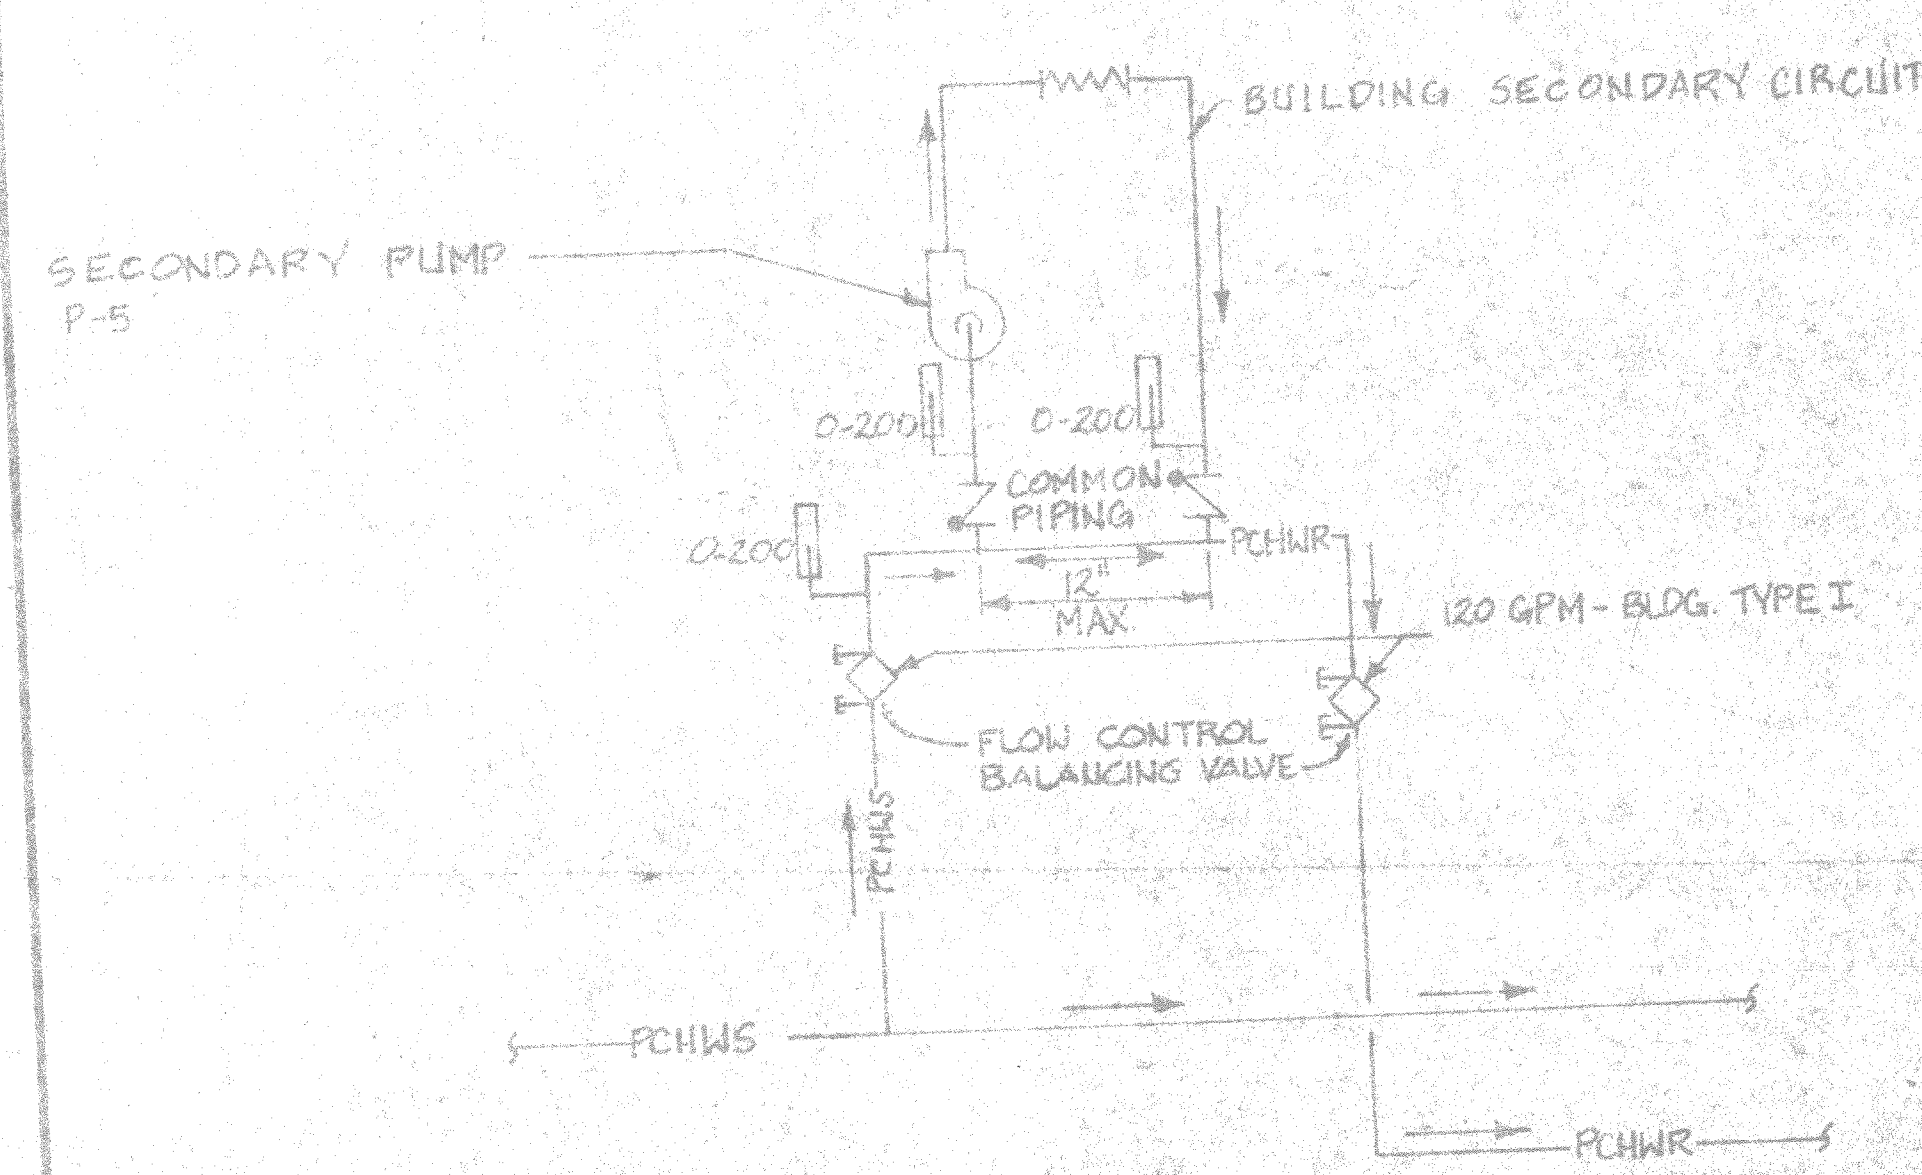


2 BUILDING PRIMARY/SECONDARY CHILLED/HOT WATER PIPING LOOP  
NO SCALE

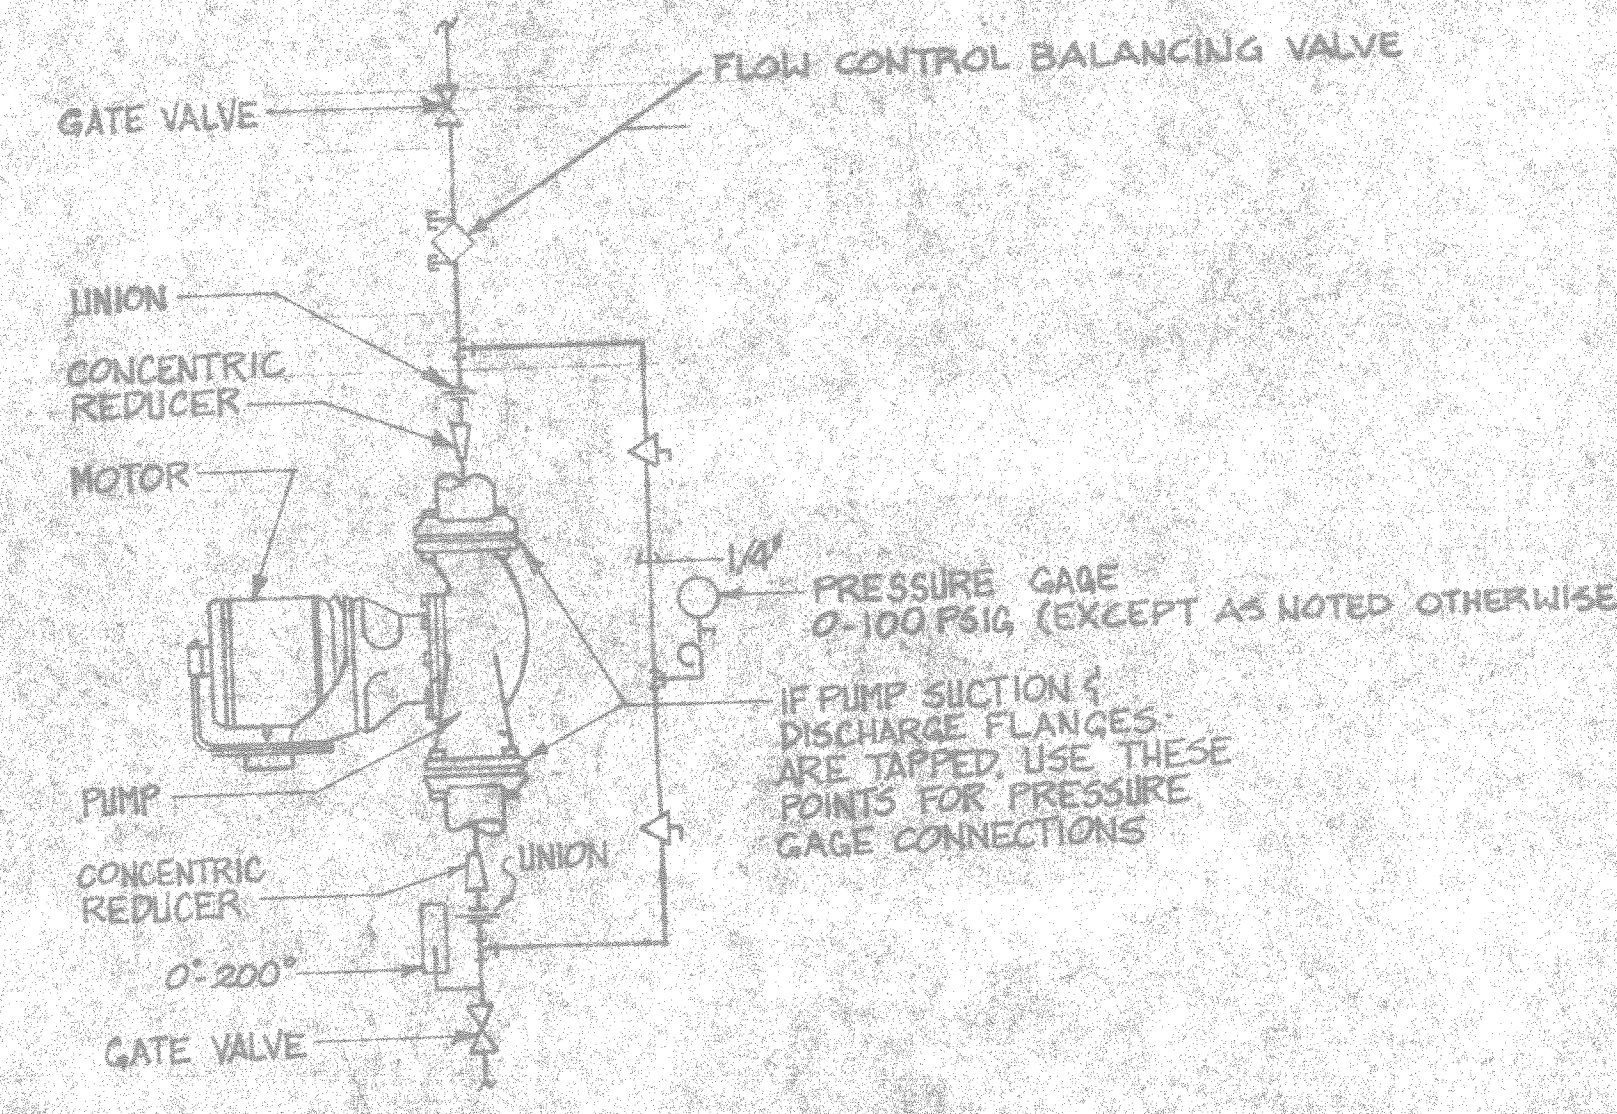


5 INLINE CENTRIFUGAL PUMP DETAIL  
NO SCALE

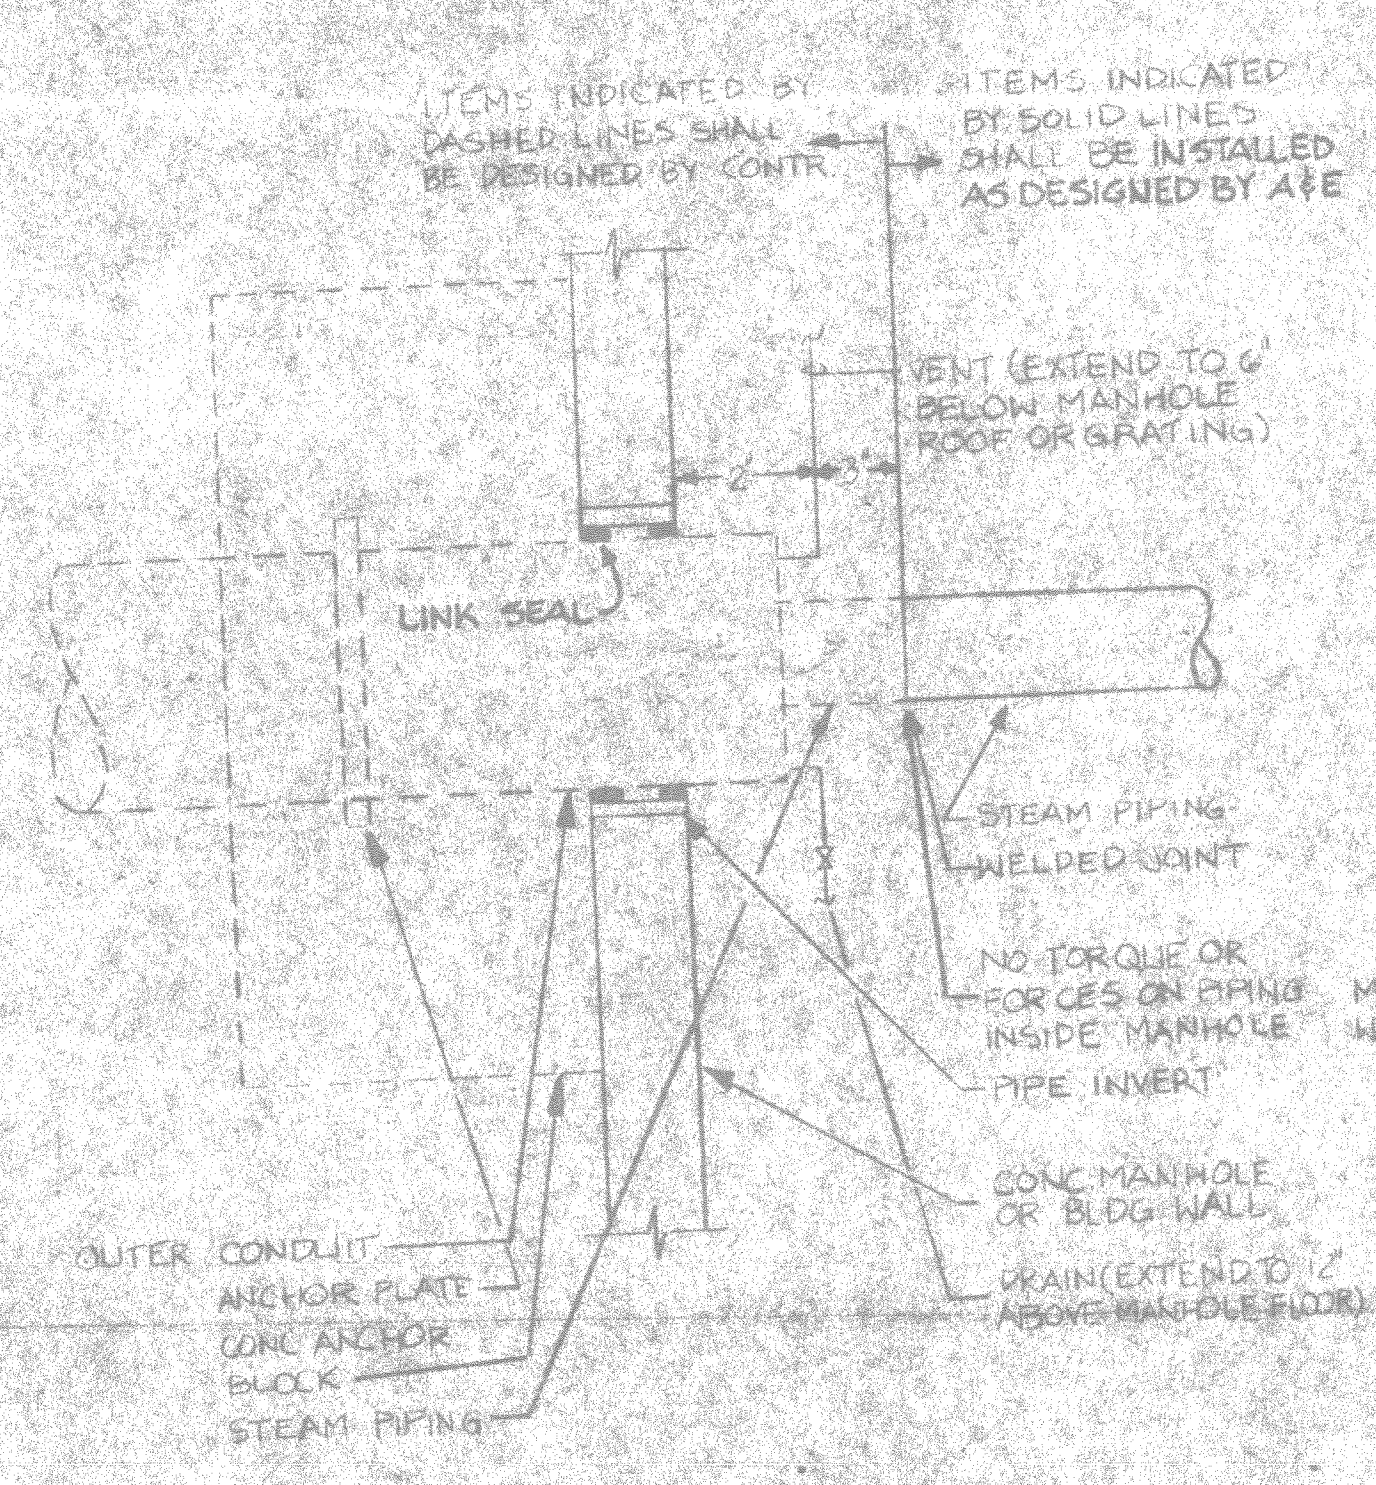

8 DETAIL STEAM PIPE PENETRATION  
MANHOLE & STEAM FIT PENETRATION AT HP-SH  
NO SCALE

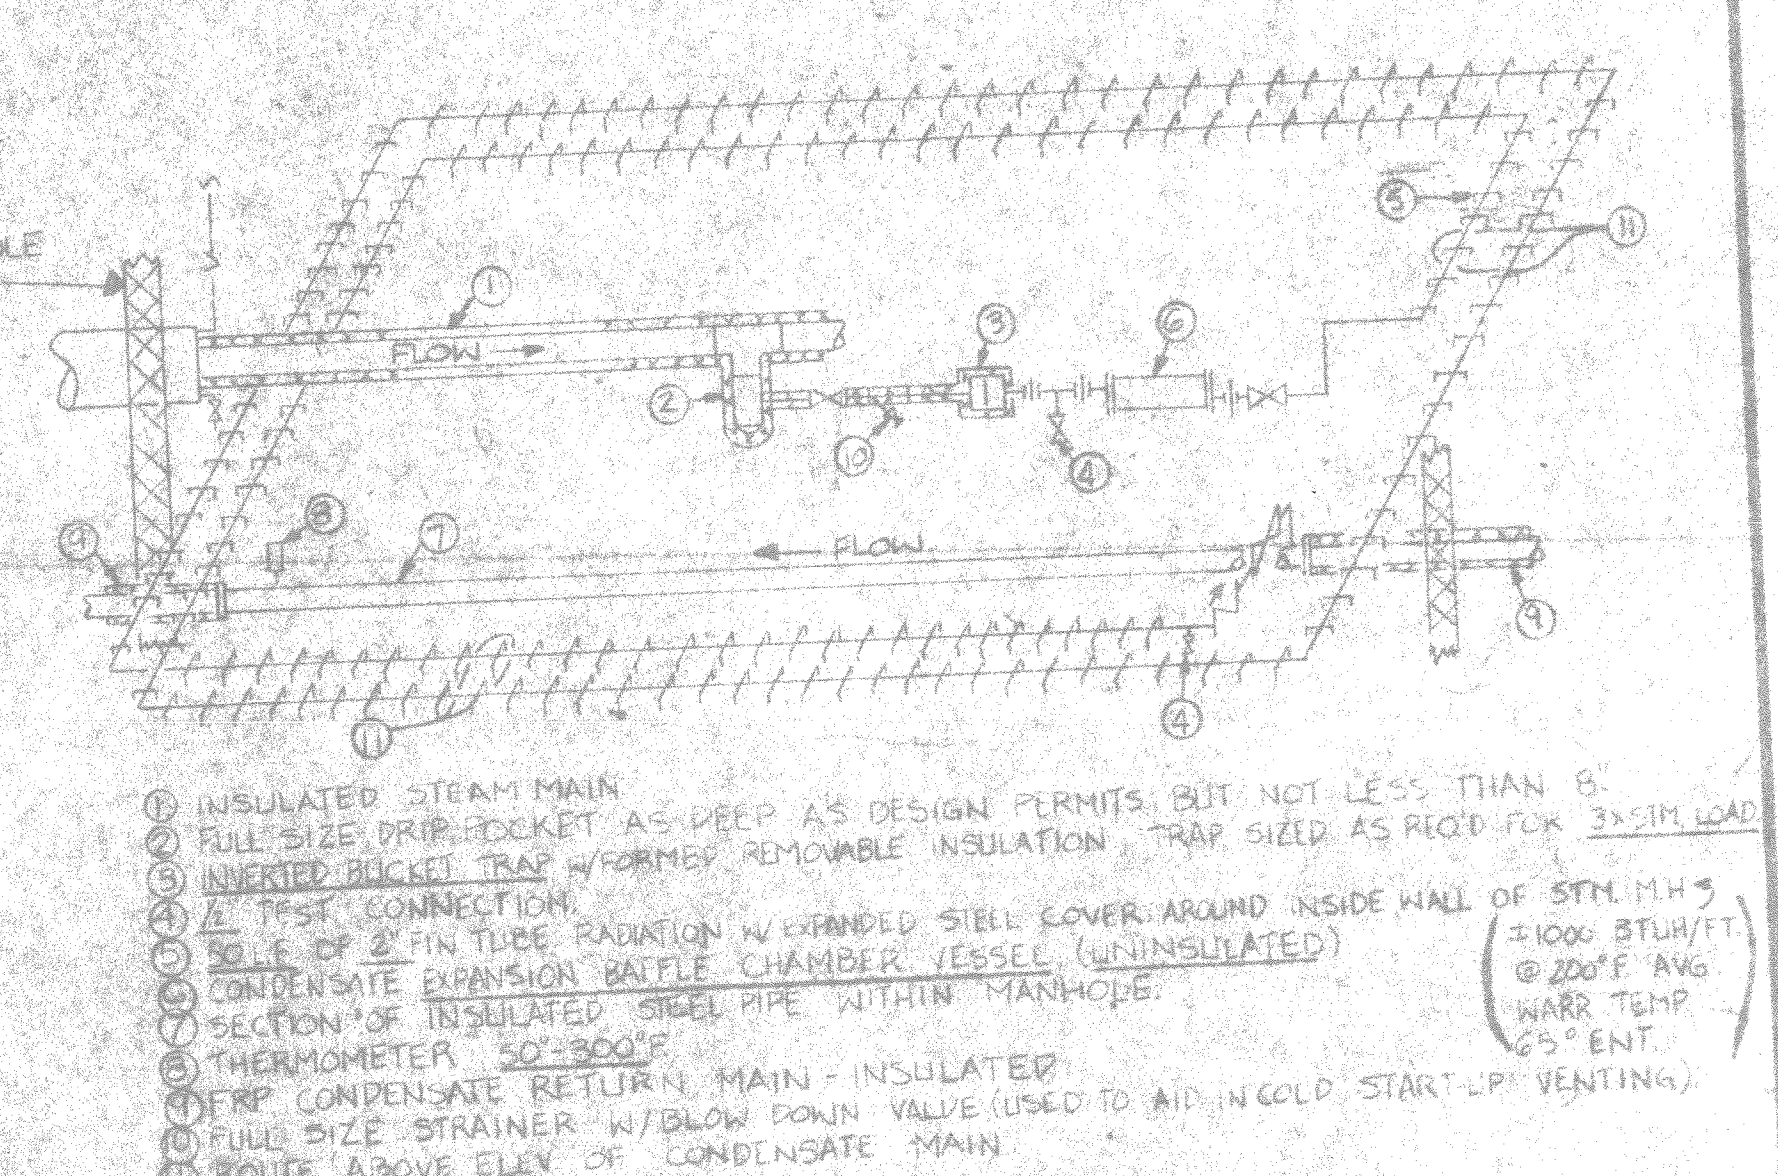


11 DETAIL U.G. HP CONDENSATE DRIP TO RTR OR FRP SYSTEMS  
NO SCALE

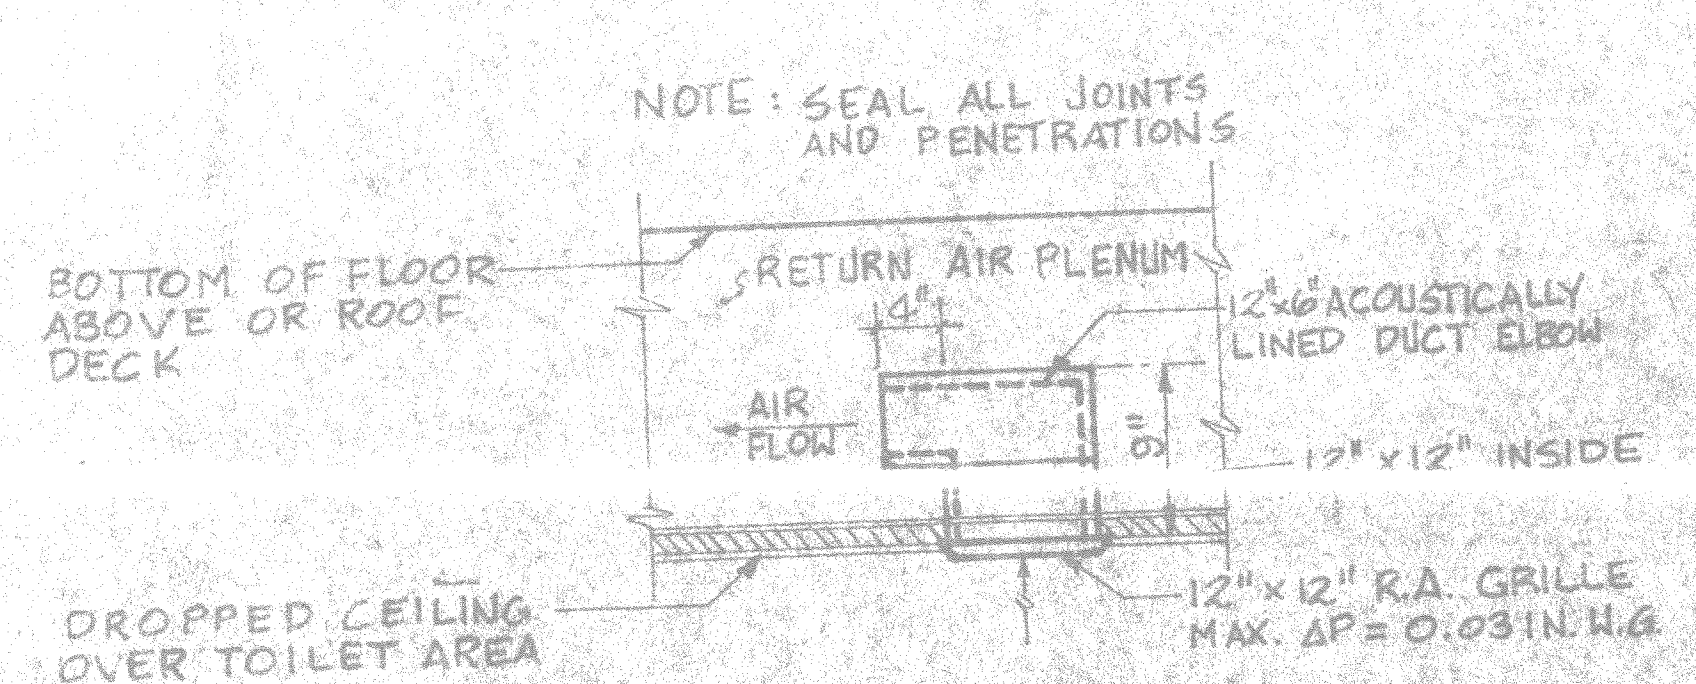

3 ELBOW DETAIL  
NO SCALE



6 SIDEWALL EXHAUST FAN DETAIL  
NO SCALE

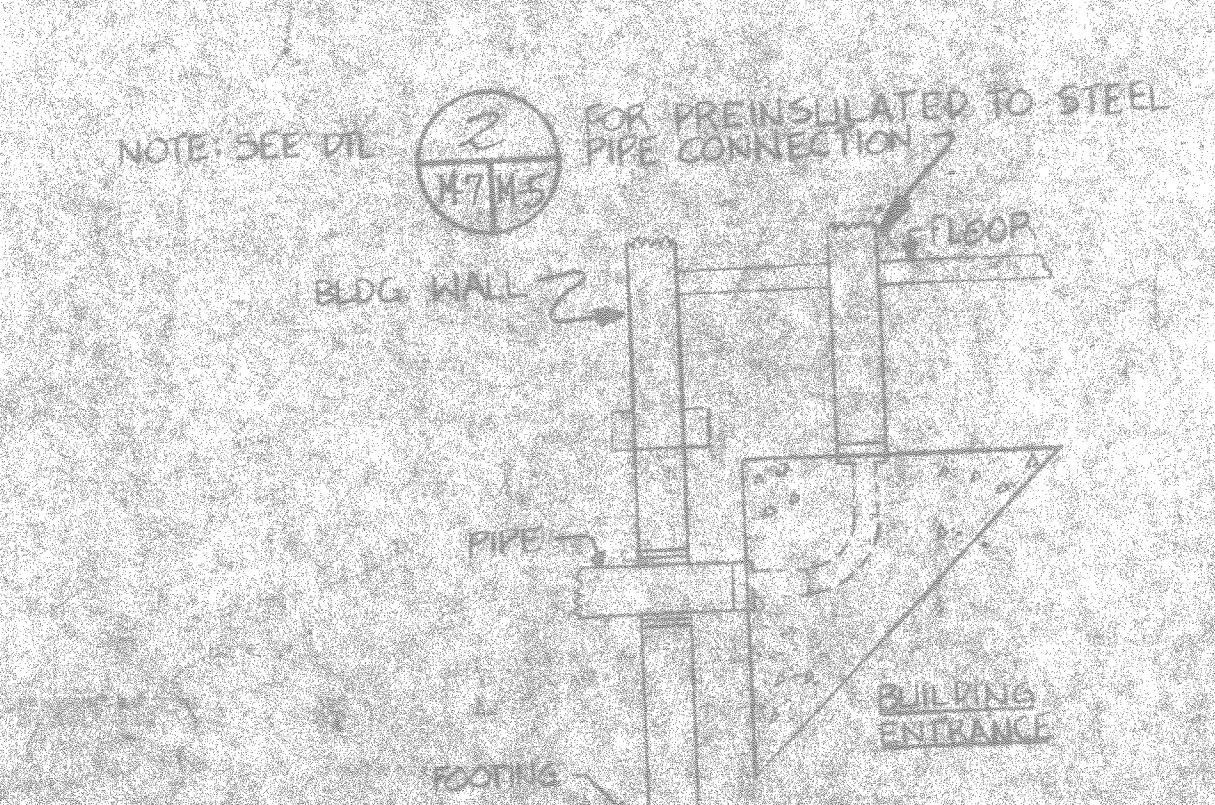

9 DETAIL THRUST BLOCKS FOR UNDERGROUND PIPING  
NO SCALE


NOTE: IF ADDITIVE OR ACCEPTED ALL REFERENCES TO M-11 WILL BECOME M-11-A

	J. N. MEASE ASSOCIATES ARCHITECTS, ENGINEERS, PLANNERS CHARLOTTE, NORTH CAROLINA 17-21-56	DEPARTMENT OF THE NAVY NAVAL FACILITIES ENGINEERING COMMAND DIVISION NORFOLK, VIRGINIA
	DR. S. C. BAW PROJECT ENGINEER DATE: APR 24 1968	MARINE CORPS BASE CAMP LEJEUNE, N.C. BACHELOR ENLISTED QUARTERS MECHANICAL DETAILS WATAC DRAWING NO. 4155181 CONST. CONTR. NO. N62470-85-B-5142 SHEET 22 OF 118 EFD: BWS, NC, 255181




Laurence




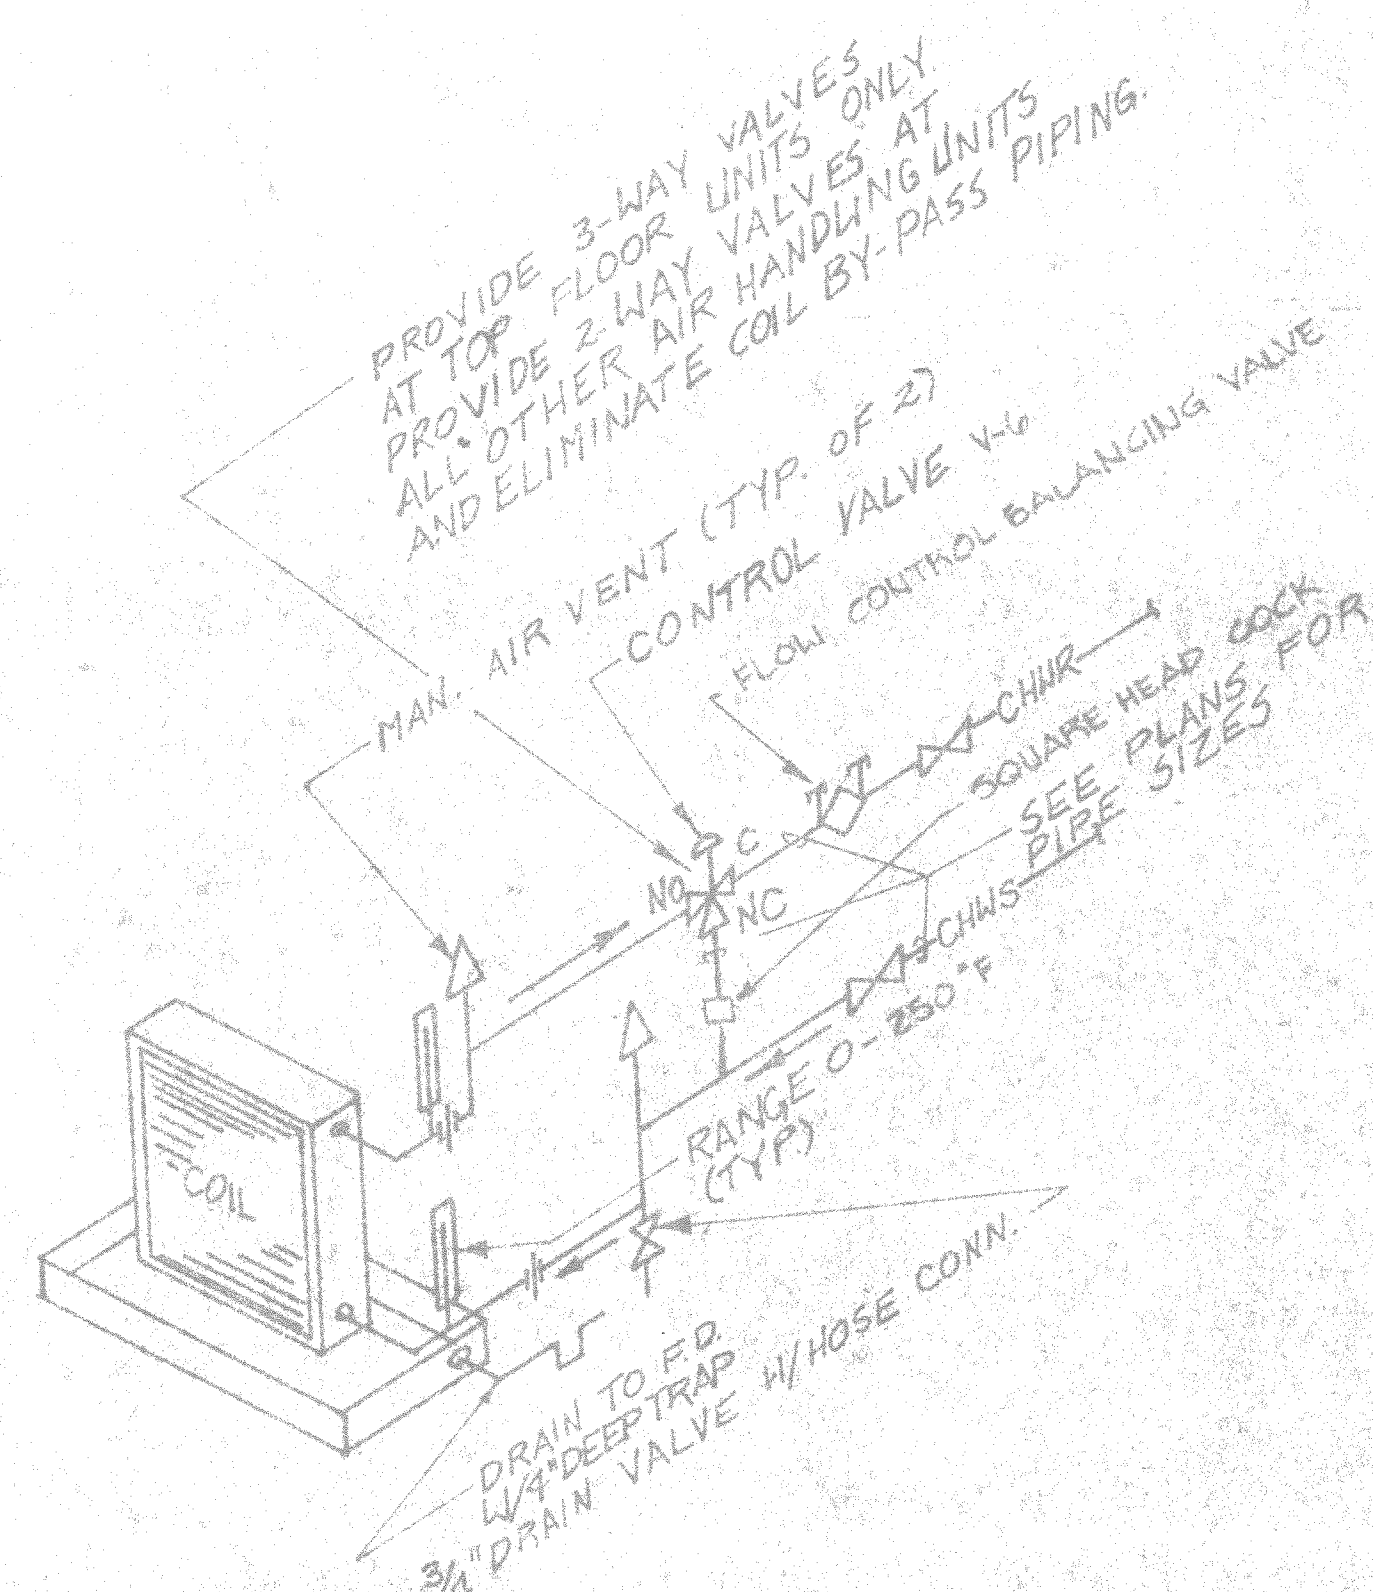


1 AHU COIL PIPING DIAGRAM  
M-7/M-7  
NO SCALE

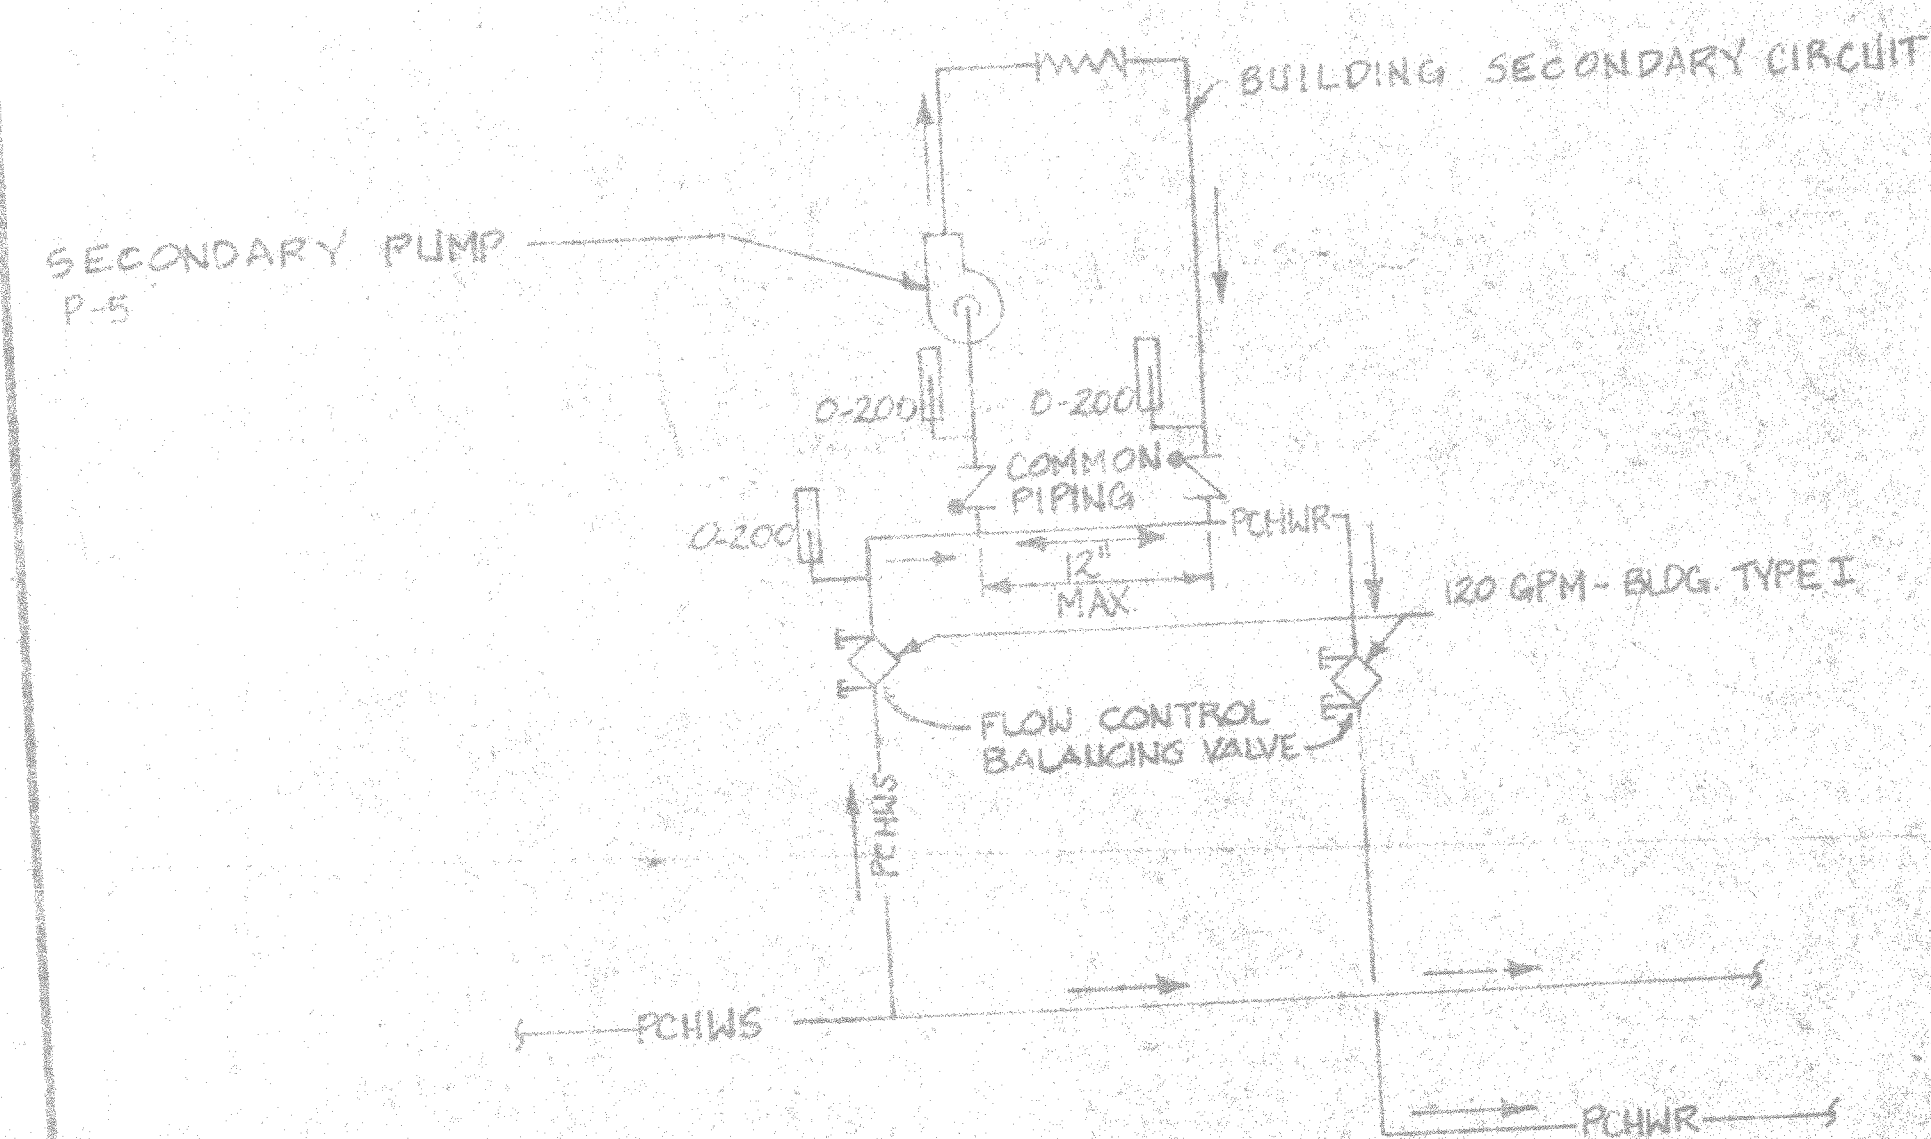


2 BUILDING PRIMARY/SECONDARY CHILLED/HOT WATER PIPING LOOP  
M-7/M-7  
NO SCALE

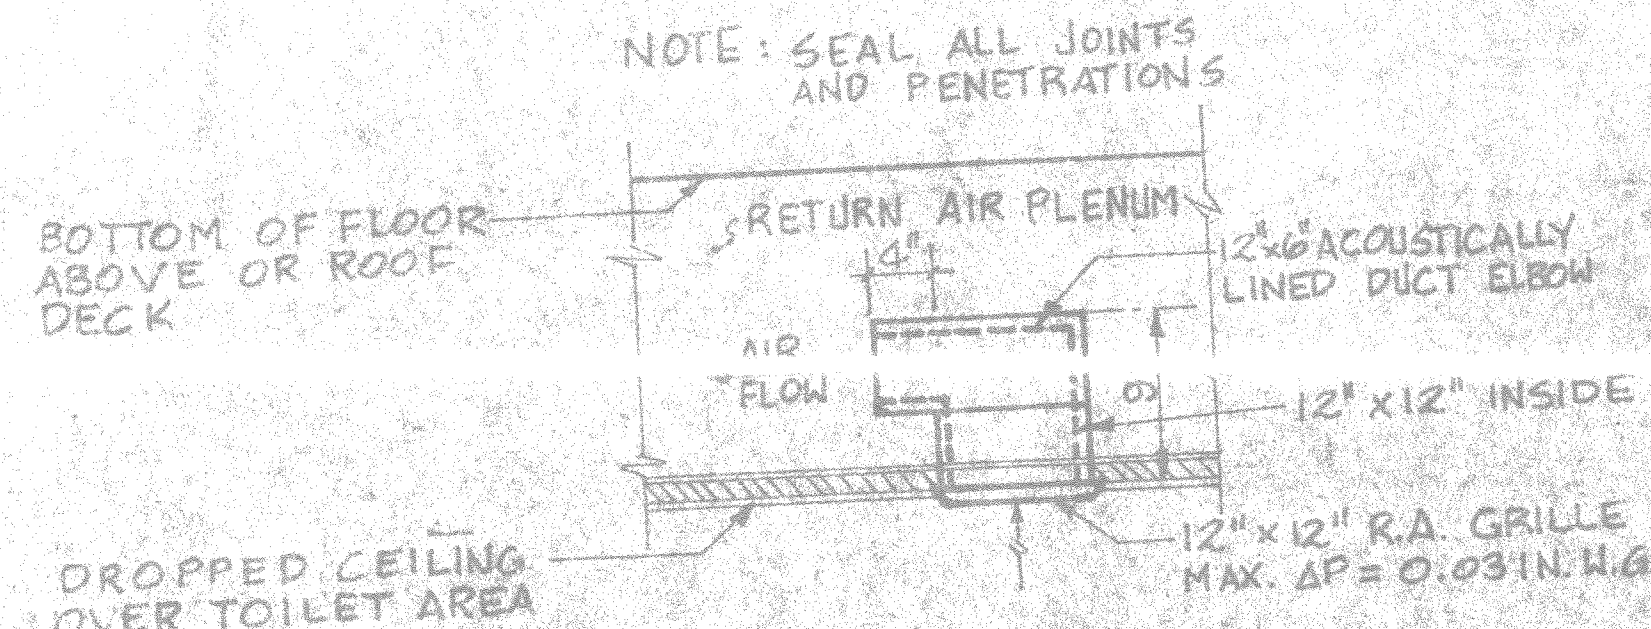


3 ELBOW DETAIL  
M-7/M-7  
NO SCALE

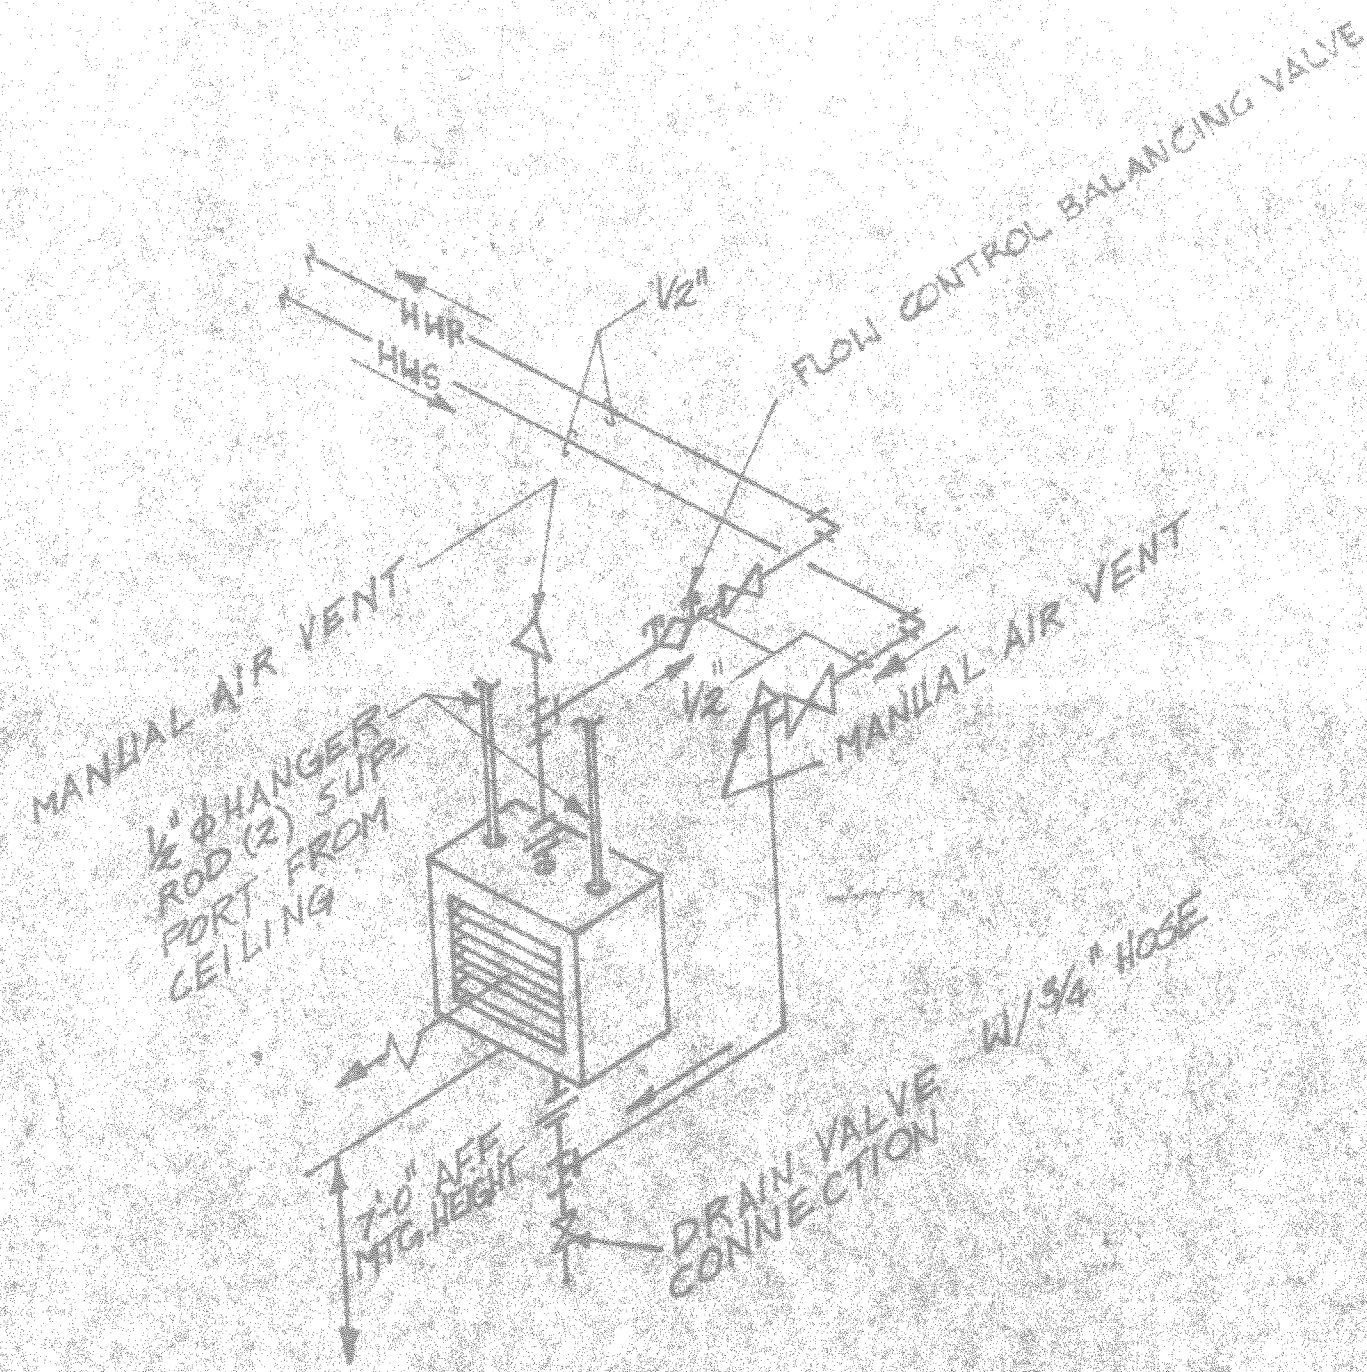


4 UNIT HEATER DETAIL  
M-7/M-7  
NO SCALE

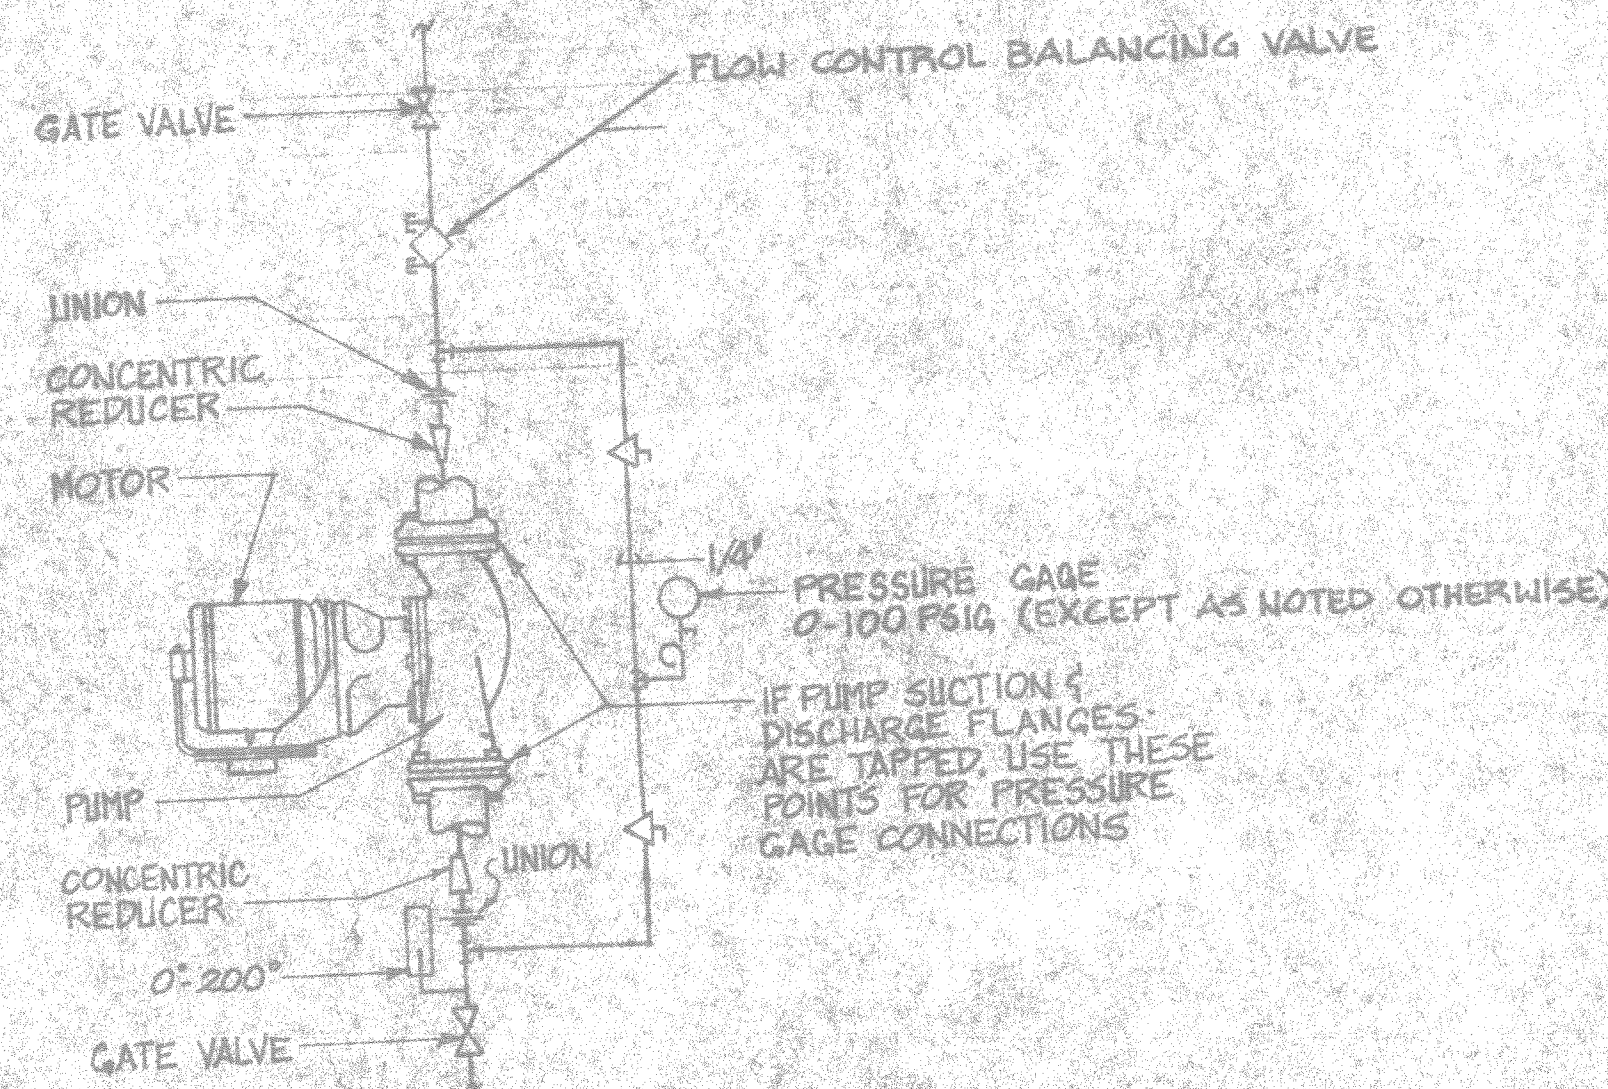


5 INLINE CENTRIFUGAL PUMP DETAIL  
M-3/M-7  
NO SCALE

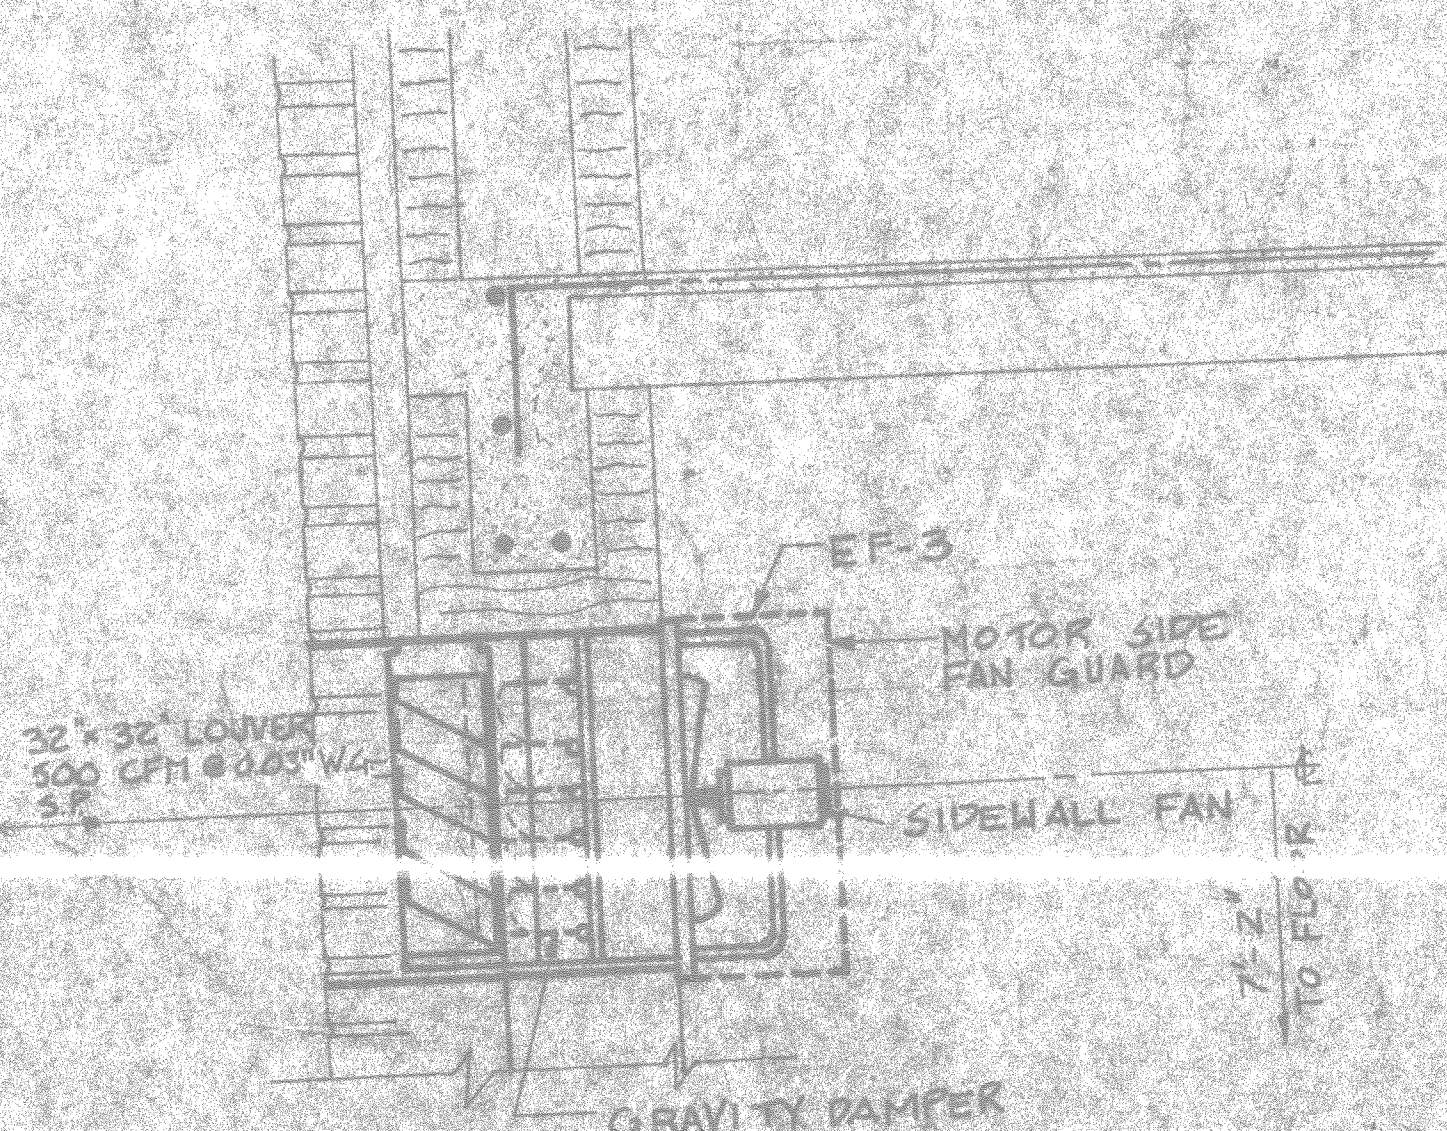


6 SIDEWALL EXHAUST FAN DETAIL  
M-3/M-7  
NO SCALE

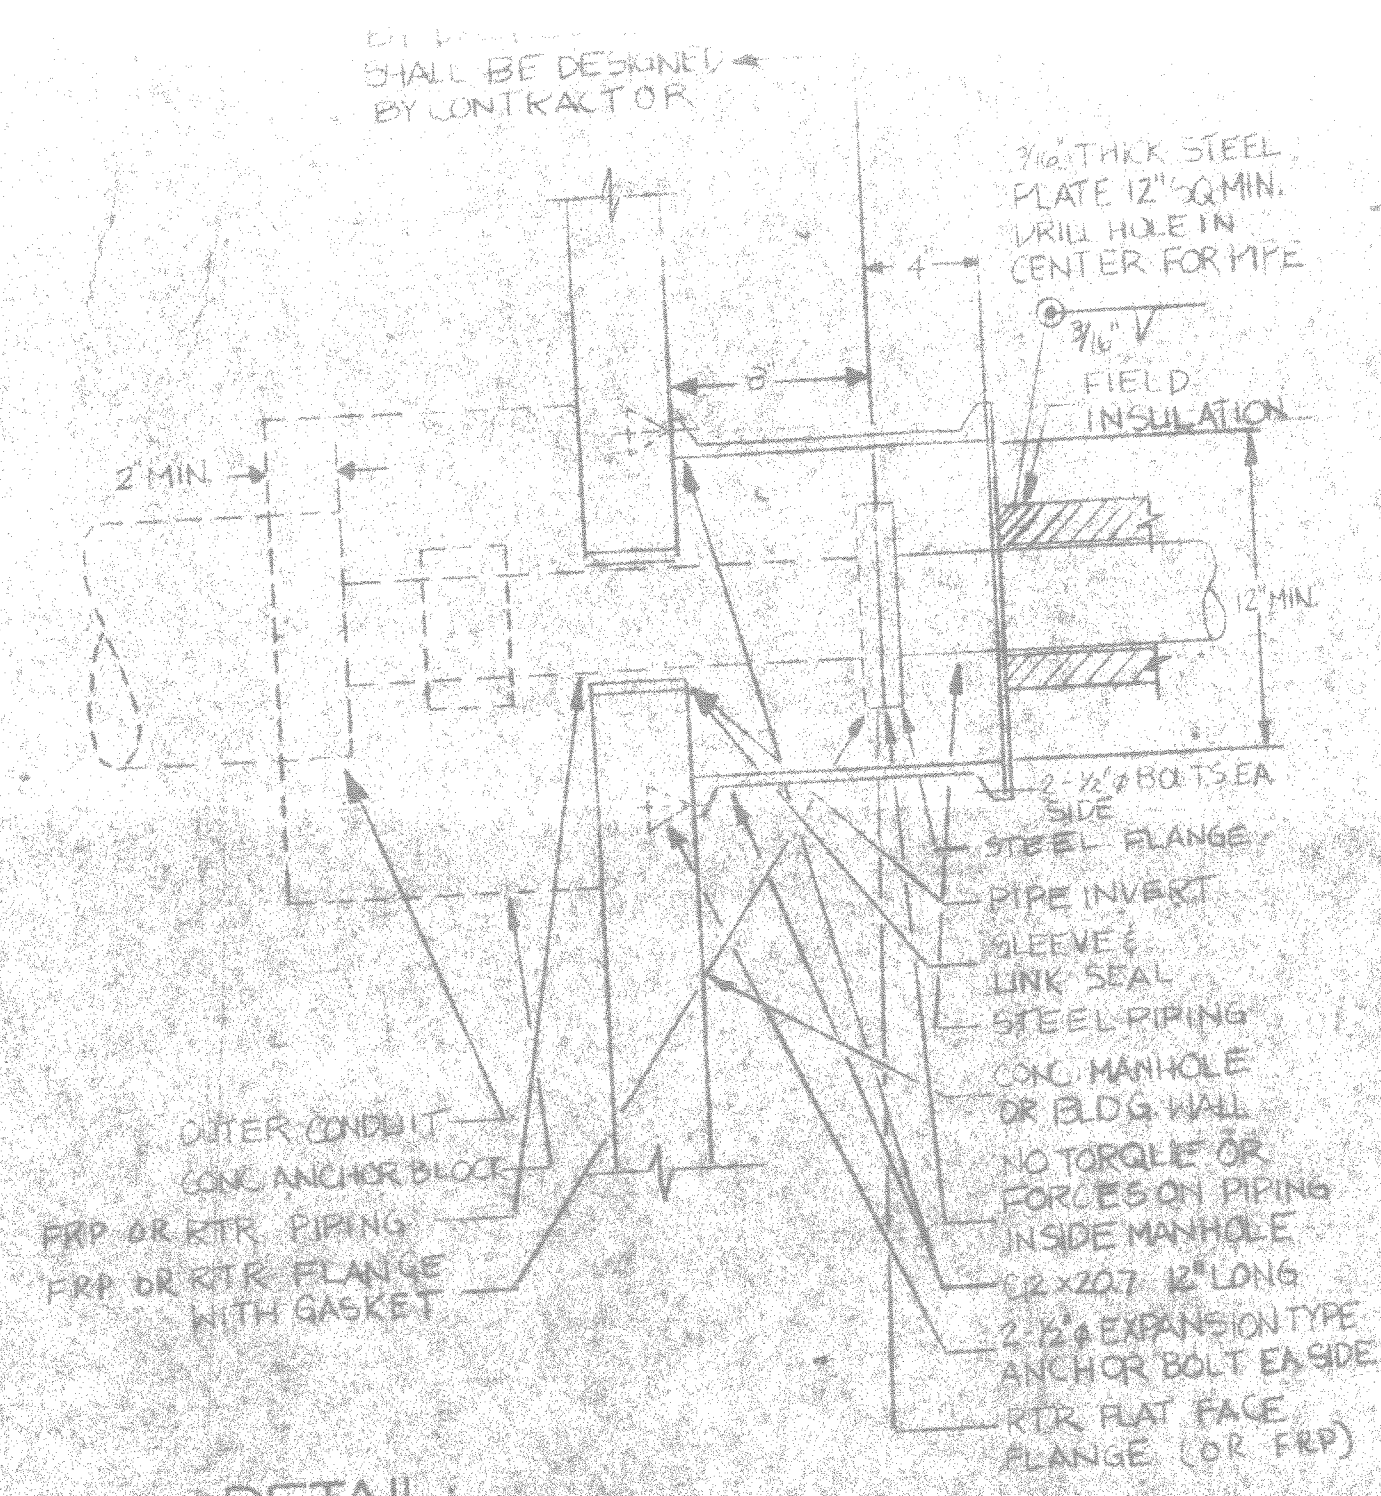


DETAIL CONDENSATE PIPE PENETRATION  
M-7/M-7  
NO SCALE

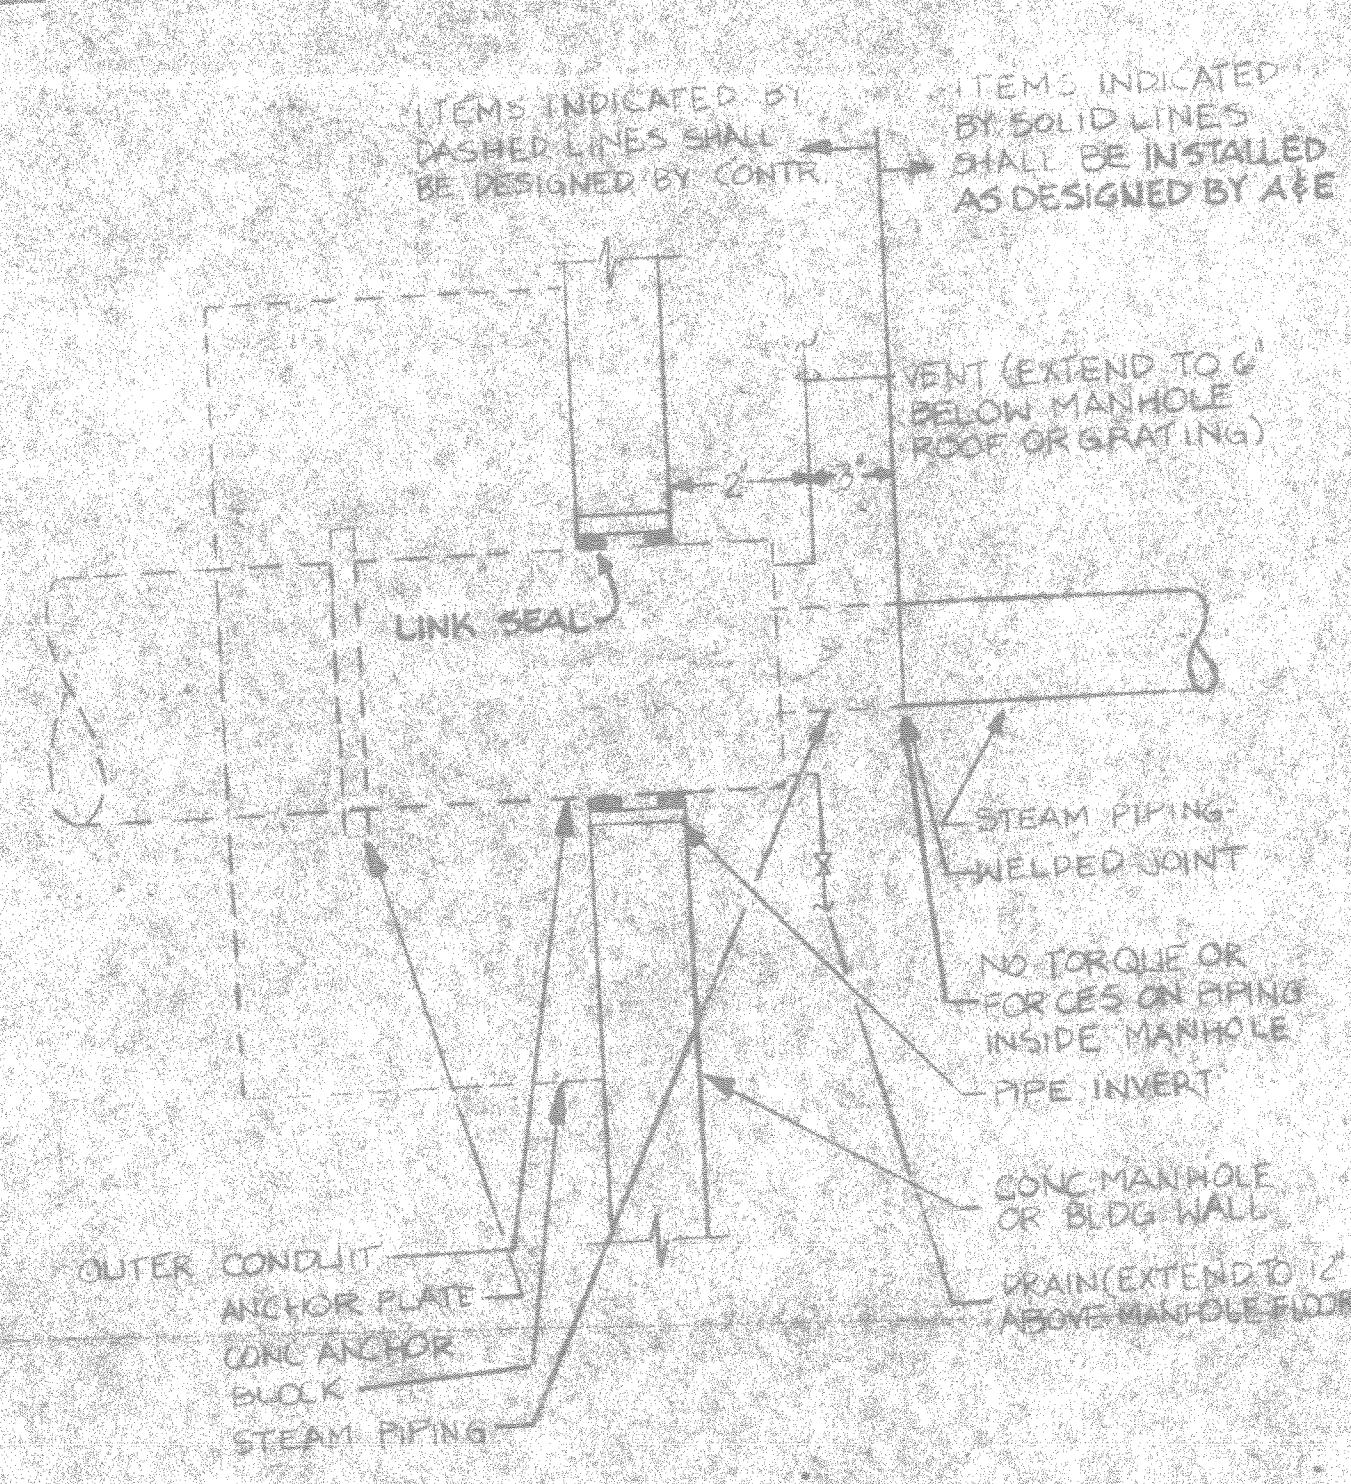


DETAIL STEAM PIPE PENETRATION  
M-7/M-7  
NO SCALE

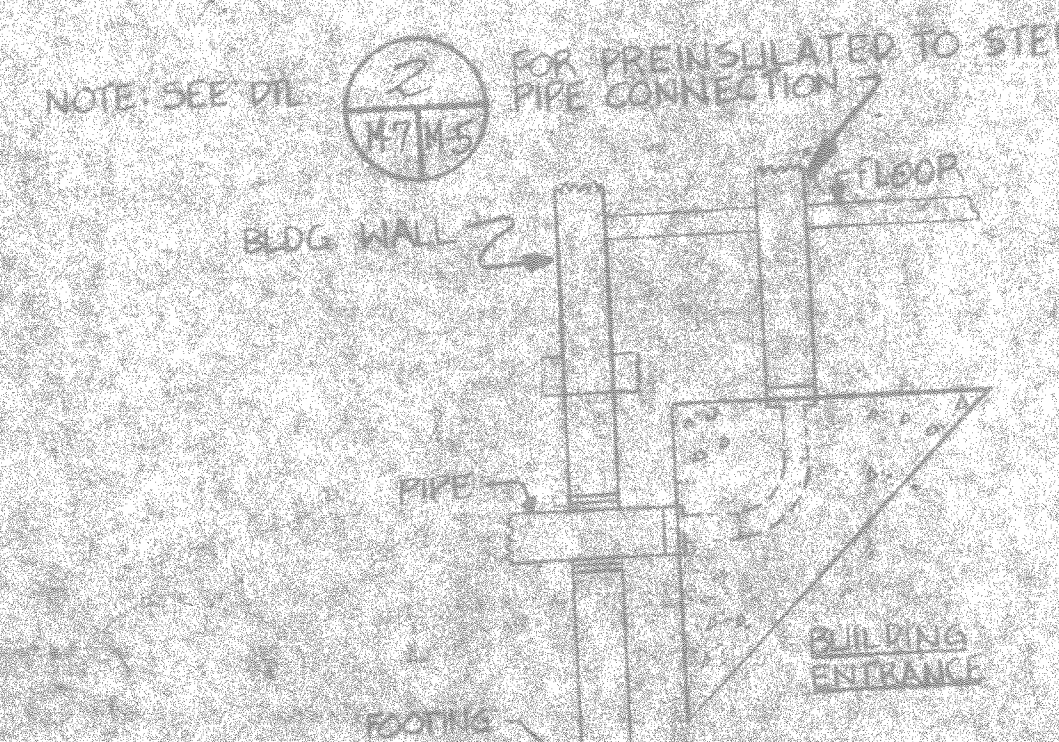

9 DETAIL THRUST BLOCKS FOR UNDERGROUND PIPING  
M-7/M-7  
NO SCALE

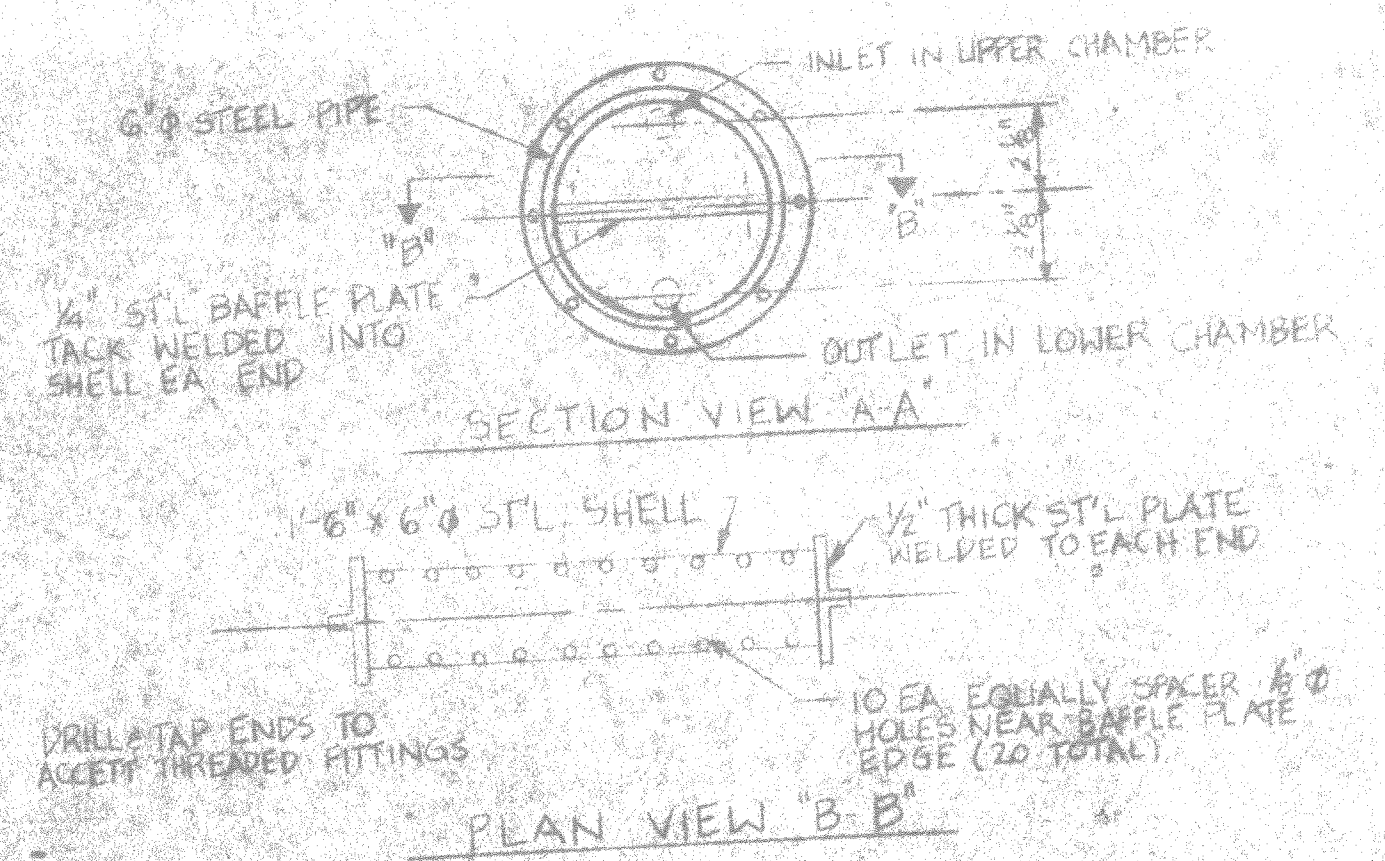

DETAIL BAFFLE CHAMBER CONSTRUCTION  
M-7/M-7  
NO SCALE

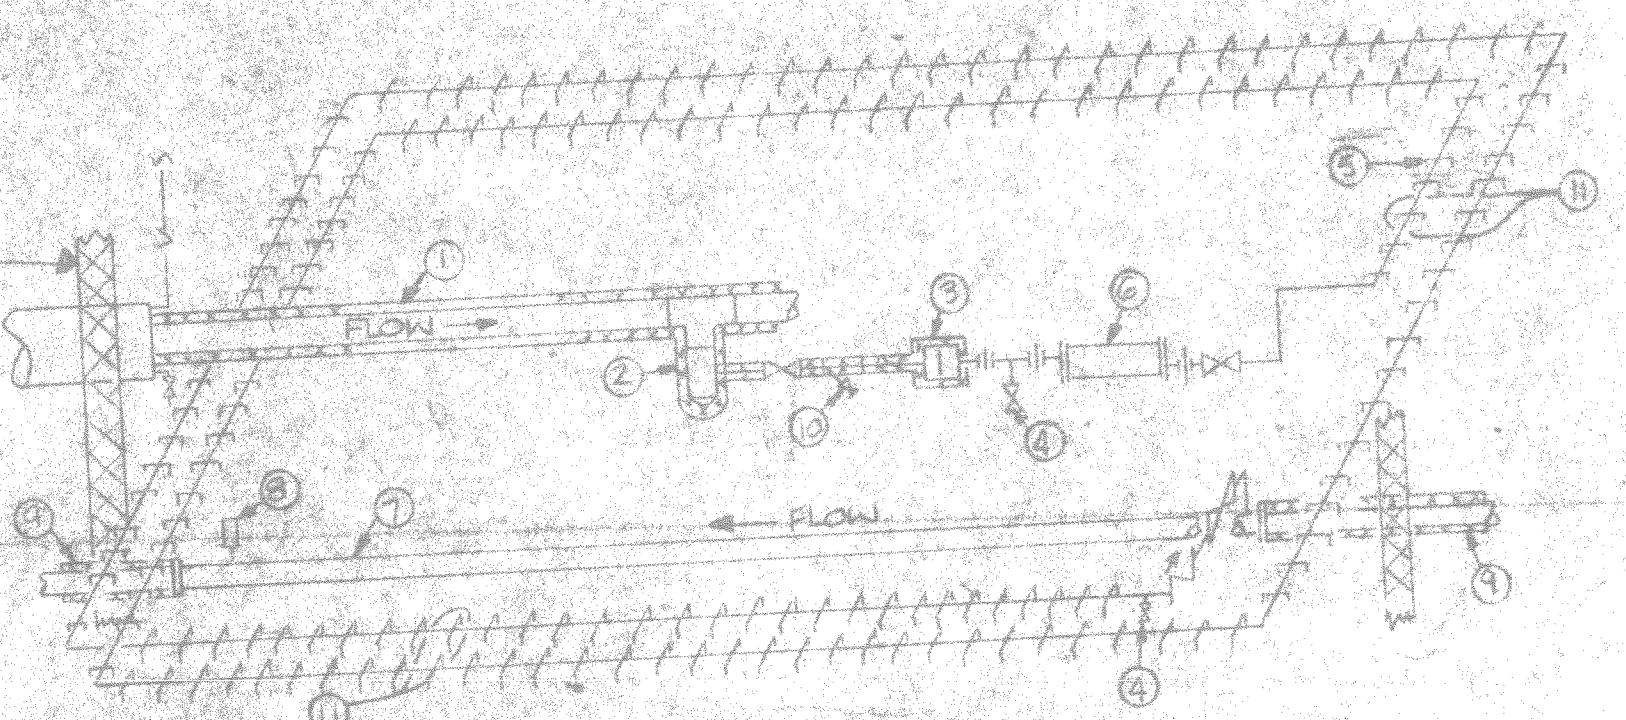

DETAIL U.G. HP CONDENSATE DRIP TO RTR OR FRP SYSTEMS  
M-7/M-7  
NO SCALE

NOTE: IF ADDITIVE IS ACCEPTED ALL REFERENCES TO P-11 WILL BECOME M-11A

<b>M-7</b>	
<b>3. N. BEASE ASSOCIATES</b> ARCHITECTS, ENGINEERS, PLANNERS CHARLOTTE, NORTH CAROLINA	
DEPARTMENT OF THE NAVY <b>ATLANTIC DIVISION</b> NAVAL STATION <b>MARINE CORPS BASE, CAMP LEJEUNE, N.C.</b> BACHELOR ENLISTED QUARTERS	
<b>MECHANICAL DETAILS</b>	
NAVFAC DRAWING NO. 4155181 CONST. CONTR. NO. N62470-85-B-5142 SHEET 82 OF 118 EFD, BWS, NC, 255181	







# AIR HANDLING UNIT SCHEDULE

\*NEMA STARTER SIZE 1, 208/3/60

UNIT NO.	LOCATION	FAN DATA					DUAL TEMPERATURE COIL															REMARKS						
		TOTAL CFM	MIN. O.A. CFM	MAX. O.A. CFM	T.E.S.P.	APPROX. T.S.P.	MAX. HP*	COOLING PERFORMANCE DATA																				
								COIL CFM	TOTAL LOAD B.T.U.H.	TOTAL SENS. B.T.U.H.	MAX. FACE VEL. FPM	E.A.T. °F	L.A.T. °F	COIL G.P.M.	E.W.T. °F	W.A.T. P.D. MAX	A.H.P. MAX	MIN. FLOW	COIL C.F.M.	TOTAL LOAD B.T.U.H.	MAX. FACE VEL. FPM		E.A.T. °F	L.A.T. °F	COIL G.P.M.	E.W.T. °F		
AHU-1	TYPE I BLDG.	4500	200	2100	1.22	3"	5	4500	136,688	104,004	500	78.2	65.4	57.1	55.9	22.8	45	8'	0.7"	4	4500	140,940	500	66.0	95.0	14.1	180	1 <sup>ST</sup> FLOOR, UNIT H
AHU-2		4500		2100	1.30			4500	136,688	104,004											4500	140,940						1 <sup>ST</sup> FLOOR, UNIT H
AHU-3		4800		2200	1.28			4800	141,696	109,901											4800	149,299						2 <sup>ND</sup> FLOOR, UNIT H
AHU-4		4800		2200	1.28			4800	141,696	109,901											4800	149,299						2 <sup>ND</sup> FLOOR, UNIT H
AHU-5	TYPE I BLDG.	4800	200	2200	1.59			4800	141,696	109,901											4800	149,299						3 <sup>RD</sup> FLOOR, UNIT H
AHU-6	TYPE II BLDG.	5300	240	2100	1.27			5300	162,896	123,066											5300	166,568	500	66.2	95.0	14.9		3 <sup>RD</sup> FLOOR, UNIT H
AHU-7		5300		2100	1.27			5300	162,896	123,066											5300	166,568						1 <sup>ST</sup> FLOOR, UNIT H
AHU-8		5300		2100	1.27			5300	162,896	123,066											5300	166,568						1 <sup>ST</sup> FLOOR, UNIT H
AHU-9		5600		2200	1.27			5600	165,312	128,822											5600	174,787						2 <sup>ND</sup> FLOOR, UNIT H
AHU-10		5600		2200	1.27			5600	165,312	128,822											5600	174,787						2 <sup>ND</sup> FLOOR, UNIT H
AHU-11	TYPE I BLDG.	5600	240	2200	1.30	3"	5	5600	165,312	128,822	500	78.2	65.4	57.3	56.2	27.6	45	8'	0.7"	4	5600	174,787	500	66.1	95.0	17.5	190	3 <sup>RD</sup> FLOOR, UNIT H
AHU-12	TYPE II BLDG.	5600		2200	1.30			5600	165,312	128,822											5600	174,787						3 <sup>RD</sup> FLOOR, UNIT H

REVISED AS-BUILT	REVISIONS	PREP BY	DATE	APPROVED

# HOT WATER STORAGE GENERATOR

UNIT NO.	SERVICE	LOCATION	STEAM PRESS.	#/HR STEAM	RECOV. GPH	ENT. WATER	LEAVE WATER	GAL	TANK SIZE	ELECT. VOLT	PHASE	REMARKS
DHWH-1	HP-512-513-514	HP-515	15 PSIG	1239	1959	40°F	120°F	2800	1150	120	1	

### SEQUENCE OF OPERATION:

- HEATING/COOLING CONTROL: SYSTEM SHALL BE ENERGIZED WHENEVER MANUAL "ON-OFF" SWITCH IS IN "ON" POSITION, AND SYSTEM MODE SHALL BE CONTROLLED BY "COOL-AUTO-HEAT" SELECTOR SWITCH. WITH THE SELECTOR SWITCH IN THE AUTO POSITION, A NORMALLY OPEN THERMOSTAT (T-1), LOCATED IN THE OUTSIDE AIR, SHALL CONTROL THE SYSTEM CHANGEOVER. ABOVE 65 DEGREES F OUTSIDE TEMPERATURE THE SYSTEM SHALL BE IN THE COOLING MODE, AND BELOW 65 DEGREES F THE SYSTEM SHALL BE IN THE HEATING MODE. WHEN SYSTEM IS IN THE HEATING MODE THE HEATING HOT WATER PUMP SHALL BE ENERGIZED AND THE SWITCHOVER 3-WAY VALVES (V-2 AND V-3) SHALL BE IN THE HEATING (NORMALLY OPEN) POSITIONS. WHEN SYSTEM IS IN THE COOLING MODE A REMOTE BULB THERMOSTAT (AQ-1), ACTING AS HIGH LIMIT SAFETY, WITH ELEMENT LOCATED IN THE RETURN WATER LINE SHALL PREVENT SYSTEM CHANGEOVER UNTIL WATER TEMPERATURE IS BELOW A PREDETERMINED SETTING (85 DEGREES F ADJ.). UNTIL CHANGEOVER TEMPERATURE IS MAINTAINED, HOT WATER PUMP SHALL CONTINUE TO OPERATE WITHOUT SHORT CYCLING, CIRCULATING WATER FOR COOL DOWN, AND THE CONVERTER STEAM VALVE V-1 SHALL BE MAINTAINED IN THE CLOSED POSITION DURING COOLING MODE. RELAY (CR) SHALL BE ENERGIZED WHEN (AQ-1) CLOSURE, TO START CHILLED WATER PUMP, STOP HOT WATER PUMP, AND POSITION 3-WAY VALVES (V-2 AND V-3), TO COOLING MODE.
- CHILLER CONTROL: THE AIR COOLED WATER CHILLER SHALL HAVE SELF-CONTAINED CONTROLS WHICH WILL START ON A DEMAND FOR COOLING, AND FLOW SWITCHES (FS-1 AND FS-2) SHALL BE INTERLOCKED TO PREVENT CHILLERS FROM STARTING UNLESS THERE IS PROOF OF FLOW IN THE CHILLED WATER LINE. AN ELECTRICAL INTERLOCK BETWEEN CHILLED WATER PUMP AND CHILLER SHALL PREVENT CHILLER FROM STARTING UNLESS PUMP IS ENERGIZED. THE TEMPERATURE CONTROLLER SHALL ARRANGE THE UNLOADING STAGES TO PREVENT SHORT CYCLING OF EITHER MACHINE AND MAINTAIN SYSTEM CHILLED WATER TEMPERATURE WITHIN PLUS OR MINUS 2 DEGREES F OF THE SYSTEM DESIGN. CHILLER CONTROL SEQUENCER SHALL ALLOW LEAD MACHINE TO OPERATE UP TO GREATER THAN 50 PERCENT (ADJUSTABLE) OF THE SYSTEM LOAD BEFORE ENERGIZING THE SECOND MACHINE. AS THE TOTAL LOAD DECREASES, THE LEAD MACHINE SHALL REMAIN IN OPERATION UNTIL LESS THAN 50 PERCENT (ADJUSTABLE) OF THE SYSTEM LOAD IS REACHED. MACHINE SHALL HAVE A LEAD-LAG SELECTOR SWITCH. THE LEAVING WATER TEMPERATURE FROM EITHER MACHINE SHALL NOT FALL BELOW 38 DEGREES F OR MANUFACTURER'S RECOMMENDATIONS, WHICHEVER IS HIGHER.
- HOT WATER CONTROL: AN ADJUSTABLE OUTDOOR RESET THERMOSTAT (TC-1) MODULATES, THROUGH A TEMPERATURE CONTROLLER, STEAM REGULATING VALVE (V-1) ON A PREDETERMINED RESET SCHEDULE TO MAINTAIN LEAVING WATER TEMPERATURE.
- FAN COIL UNITS: A LOW VOLTAGE CHANGEOVER THERMOSTAT (TS-1) FOR USE WITH COMBINATION HEATING-COOLING THERMOSTAT (RT-1) SHALL CONTROL THE WATER FLOW THROUGH EACH FAN COIL UNIT BY CONTROLLING THE POSITION OF A TWO-POSITION THREE-WAY VALVE (V-5). THE MODE OF THE CHANGEOVER THERMOSTAT SHALL BE CONTROLLED BY A STRAP-ON THERMOSTAT ELEMENT ON THE WATER SUPPLY TO THE TWO-POSITION THREE-WAY VALVE (V-5). WHEN WATER SUPPLY IS ABOVE 65 DEGREES F, THE CHANGEOVER THERMOSTAT (TS-1) SHALL BE POSITIONED TO THE HEATING MODE. WHEN WATER SUPPLY IS BELOW 65 DEGREES F, THE CHANGEOVER THERMOSTAT (TS-1) SHALL BE POSITIONED TO THE COOLING MODE. FAN OPERATION SHALL BE CONTROLLED BY OFF-HIGH-MEDIUM-LOW FAN SPEED SWITCH (MS-1). THERMOSTAT AND SWITCH SHALL BE MOUNTED FIVE FEET ABOVE THE FLOOR.
- LAUNDRY ROOM CONTROL: A TWO-STAGE HEATING/COOLING THERMOSTAT SHALL ENERGIZE THE EXHAUST FAN ANY TIME SPACE TEMPERATURE EXCEEDS 80 DEGREES F AND ENERGIZE THE UNIT HEATER FAN WHENEVER THE SPACE TEMPERATURE FALLS BELOW 65 DEGREES F. WHEN THE ROOM TEMPERATURE FALLS BELOW 80 DEGREES F THE EXHAUST FAN SHALL BE DE-ENERGIZED. A STRAP-ON AQUASTAT SHALL PREVENT THE UNIT HEATER FROM OPERATING IF THE WATER TEMPERATURE IS BELOW 80 DEGREES F AND CLOSE TWO-POSITION VALVE. V-4
- MECHANICAL EQUIPMENT BUILDING EXHAUST FAN EF-6: FAN SHALL BE CONTROLLED BY A THERMOSTAT. ON A RISE IN ROOM TEMPERATURE, THERMOSTAT SET FOR 85 DEGREES F, THE FAN SHALL ENERGIZE AND OPEN OUTSIDE AIR INTAKE DAMPER, AND ON A DROP IN TEMPERATURE THE REVERSE SHALL OCCUR.
- AIR HANDLER UNIT CONTROL (FOR EACH A.H. UNIT): UNITS SHALL BE STARTED AND STOPPED MANUALLY.
  - THE AH UNIT AND ROOM CONTROLS SHALL BE INDEXED FOR HEATING OR COOLING FROM A SENSOR (AQ-2) IN THE CW/HW SUPPLY PIPING FROM CENTRAL SYSTEM. WHEN 75 DEGREES F OR ABOVE WATER TEMPERATURE IS SENSED, THE SYSTEM SHALL BE INDEXED FOR HEATING. WHEN 65 DEGREES F OR BELOW WATER IS SENSED, THE SYSTEM SHALL BE INDEXED FOR COOLING.
  - WITH AH UNITS OPERATING AND SYSTEM INDEXED FOR HEATING, THE RETURN AIR SENSOR SHALL RESET THE DISCHARGE AIR TEMPERATURE OVER A PREDETERMINED SCHEDULE. ON A FALL IN DISCHARGE TEMPERATURE, CONTROLLER (RC) SHALL REPOSITION THREE-WAY VALVE (V-6) SUPPLYING HOT WATER TO THE UNIT COIL.
  - WITH THE AH UNIT OPERATING AND SYSTEM INDEXED FOR COOLING, THE DISCHARGE AIR CONTROLLER (TTD) SHALL BE AUTOMATICALLY SET TO MAINTAIN 59 DEGREE F CONSTANT DISCHARGE AIR TEMPERATURE. THE RETURN AIR SENSOR SHALL BE LOCKED OUT.
  - PROVIDE A TEMPERATURE LOW LIMIT THERMOSTAT (LLL) TO SHUT THE AH UNIT DOWN AT 38 DEGREES F.
  - PROVIDE A TEMPERATURE HIGH LIMIT THERMOSTAT (THL) TO SHUT THE AH UNIT DOWN AT 85 DEGREES F.
  - AH SHALL SHUT DOWN VIA ALARM-OPERATED CONTACTS IN FIRE ALARM CONTROL PANEL.
  - ROOM CONTROL: WITH THE ROOM THERMOSTAT INDEXED FOR HEATING, THE ROOM THERMOSTAT SHALL ON A FALL IN TEMPERATURE MODULATE THE TAB SUPPLY AIR DAMPER OPEN SIMULTANEOUSLY CLOSING THE ROOM RETURN AIR DAMPER. WITH THE THERMOSTAT INDEXED FOR COOLING THE THERMOSTAT SHALL ON A RISE IN TEMPERATURE MODULATE TO OPEN THE TAB SUPPLY AIR SIMULTANEOUSLY CLOSING THE ROOM RETURN. INDEXING FOR HEATING AND COOLING SHALL BE AUTOMATIC BY CENTRAL SOURCE.
  - AH UNIT STATIC PRESSURE CONTROL: A STATIC PRESSURE CONTROL (SPC) SHALL BE PROVIDED FOR EACH SUPPLY PLENUM (FOUR PER AH UNIT) WITH THE SENSING TIPS LOCATED IN THE SUPPLY PLENUM 3/4 DOWN TOTAL LENGTH OF SUPPLY AIR DUCT IN WHICH INSTALLED AND IN THE AH EQUIPMENT ROOM. ON A RISE IN STATIC ABOVE THE CONTROLLER SETPOINT (.75 INCH ADJ.) THE CONTROLLER SHALL MODULATE THE INLET VALVE ON THE AH UNIT FAN. THROUGH A HIGH-LOW PRESSURE SELECTOR (ONE PER AH UNIT), THE CONTROLLER SET POINT IS ADJUSTABLE.
  - HOT WATER STORAGE HEATERS: A SELF-CONTAINED CONTROL VALVE WITH A CAPILLARY BULB IN THE DOMESTIC HOT WATER TANK SHALL MODULATE THE NORMALLY CLOSED STEAM VALVE TO CONTROL THE WATER TEMPERATURE SET AT 110 DEGREES F. DOMESTIC WATER CIRCULATION PUMP P-3 SHALL BE CONTROLLED AUTOMATICALLY BY AQUASTAT LOCATED IN DOMESTIC HOT WATER RETURN SET AT 110 DEGREES F AND WHEN TEMPERATURE DROPS BELOW 110 DEGREES F WILL START PUMP P-3. A SELF-CONTAINED TEMPERING VALVE V-8 SET AT 110 DEGREES F WITH BULB LOCATION IN THE DOMESTIC HOT WATER SUPPLY LINE SHALL MAINTAIN THE DESIRED DOMESTIC HOT WATER TEMPERATURE TO THE BUILDINGS.
  - EXHAUST FAN CONTROL: WITH HIGH LIMIT THERMOSTAT AND DISCONNECT SWITCH CLOSED, EXHAUST FAN RUNS CONTINUOUSLY.
  - ENERGY MONITORING CONTROL SYSTEM (EMCS): A CENTRAL ENERGY MANAGEMENT AND CONTROL SYSTEM WILL BE INSTALLED IN THE FUTURE WHICH WILL CONNECT BUILDINGS HP-506, HP-507, HP-508, HP-509, & HP-510 AND THE MECHANICAL BUILDING HP-511. DATA TERMINAL CABINETS (DTC) SHALL BE FURNISHED THAT WILL INCORPORATE THE FOLLOWING POINTS INTO THE EMCS. ALL EQUIPMENT SHALL BE COMPATIBLE FOR CONNECTING TO THE FUTURE FIELD INTERFACE DEVICES AND TO THE CENTRAL SYSTEM.

### 12.1 MECHANICAL BUILDING:

- CHILLED/HOT WATER SUPPLY AND RETURN -- TEMPERATURE SENSOR (DEGREE F) AND FLOW (GPM)
- CHILLER PACC-1 -- START-STOP, ALARMS STATUS, CHILLED WATER RESET AND CHILLER PROFILE AND SELECT
- CHILLER PACC-2 -- START-STOP, ALARMS STATUS, CHILLED WATER RESET AND CHILLER PROFILE AND SELECT.
- STEAM LINE -- MEASURE STEAM FLOW LBS./HOUR (ORIFICE)
- STEAM LINE -- TOTALIZE STEAM FLOW
- ELECTRICAL ENERGY -- MEASURE AND TOTALIZE KWH, KWD, CHILLER PACC-1 AND 2, P1 AND P2.
- MONITOR HEAT OR COOL CONTROL POSITION
- PUMPS NO. 1 AND 2 -- MONITOR OPERATION, START-STOP (FOR DEMAND LIMITING)


### 12.2 DEPH BUILDINGS:

- POINTS LISTED ARE REQUIRED IN EACH BUILDING.
- MEASURE TEMPERATURE OF SUPPLY AND RETURN AIR TEMPERATURE OF EACH AIR HANDLER (6 PER BUILDING)
- BUILDING AIR HANDLERS (6 PER BUILDING) START-STOP FOR DEMAND LIMITING AND DUTY CYCLING, FAN STATUS
- HUMIDITY MONITORING, EACH BUILDING AIR HANDLERS, (6 PER BUILDING)
- TERMINAL AIR BLENDER CONTROL (ONE PER AIR HANDLING UNIT) -- HIGH AND LOW TEMPERATURE
- PUMP P-4 CONTROL (TYPICAL FOR FOUR PUMPS): PUMP P-4 SHALL BE ENERGIZED WHEN THE TEMPERATURE OF THE WATER IN THE DOMESTIC HOT WATER STORAGE GENERATOR FALLS BELOW 115 DEGREES F. HOWEVER, THE PUMP SHALL BE INTERLOCKED WITH THE RECIPROCATING LIQUID CHILLER SO THAT THE PUMP WILL NOT OPERATE UNLESS THE CHILLER IS IN OPERATION. ALSO, A SENSOR IN THE CHILLER'S LEAVING CHILLED WATER LINE SHALL DE-ENERGIZE THE PUMP IF THE LEAVING CHILLED WATER TEMPERATURE EXCEEDS 46 DEGREES F.


# CONTROL VALVE SCHEDULE

MARK	UNIT SERVED	SERVICE	TYPE	ACTION	CAPACITY LBS/HR	GPM	STEAM PRESS. INLET	STEAM PRESS. OUTLET	Cv	MAX WPD FT. H <sub>2</sub> O	INCHES	LOCATION
PRV-1		STEAM	2-WAY	MODULATING	2441		150	25	8.4		1"	MECHANICAL BUILDING
PRV-2		STEAM	2-WAY		1239		150	25	4.3		3/4"	MECHANICAL BUILDING
PRV-3	EJECTOR PUMPS	STEAM	2-WAY		800		150	75	3.4		1"	STEAM PITS
V-1	HE-1	STEAM	2-WAY	MODULATING	2441		25	15	48.7		2 1/2"	MECHANICAL BUILDING
V-2	CHANGEOVER	CHWIR	3-WAY	2-POSITION					188	7	6"	MECHANICAL BUILDING
V-3	CHANGE OVER	CHWIR	3-WAY						188	7	6"	MECHANICAL BUILDING
V-4	UNIT HEATER	HWIR	2-WAY						188	7	6"	MECHANICAL BUILDING
V-5	FCU (C)	CHWIR	3-WAY						2.2	5	1/2"	BEO LOUNGES
V-5A	FCU (C)	CHWIR	3-WAY						1.7	7	1/2"	BEO LOUNGES
V-6	AHU 5 & 6	CHWIR	3-WAY	2-POSITION					0.6	7	1/2"	BEO OFFICES
V-6A	AHU 1-4	CHWIR	3-WAY	MODULATING	23.6*				13.4	7	1 1/2"	BEO TOP FLOOR
V-7	DHW-1	STEAM	2-WAY		1239		25	15	22.2		1 1/2"	BEO 1 <sup>ST</sup> & 2 <sup>ND</sup> FLOOR
V-8	DHW-1	DHWIS	3-WAY	MODULATING	254		15	20.2	7	6"	MECHANICAL BUILDING	


\* 27.2 GPM PER AHU-7 THRU 10  
\* 27.6 GPM PER AHU-11 AND 12

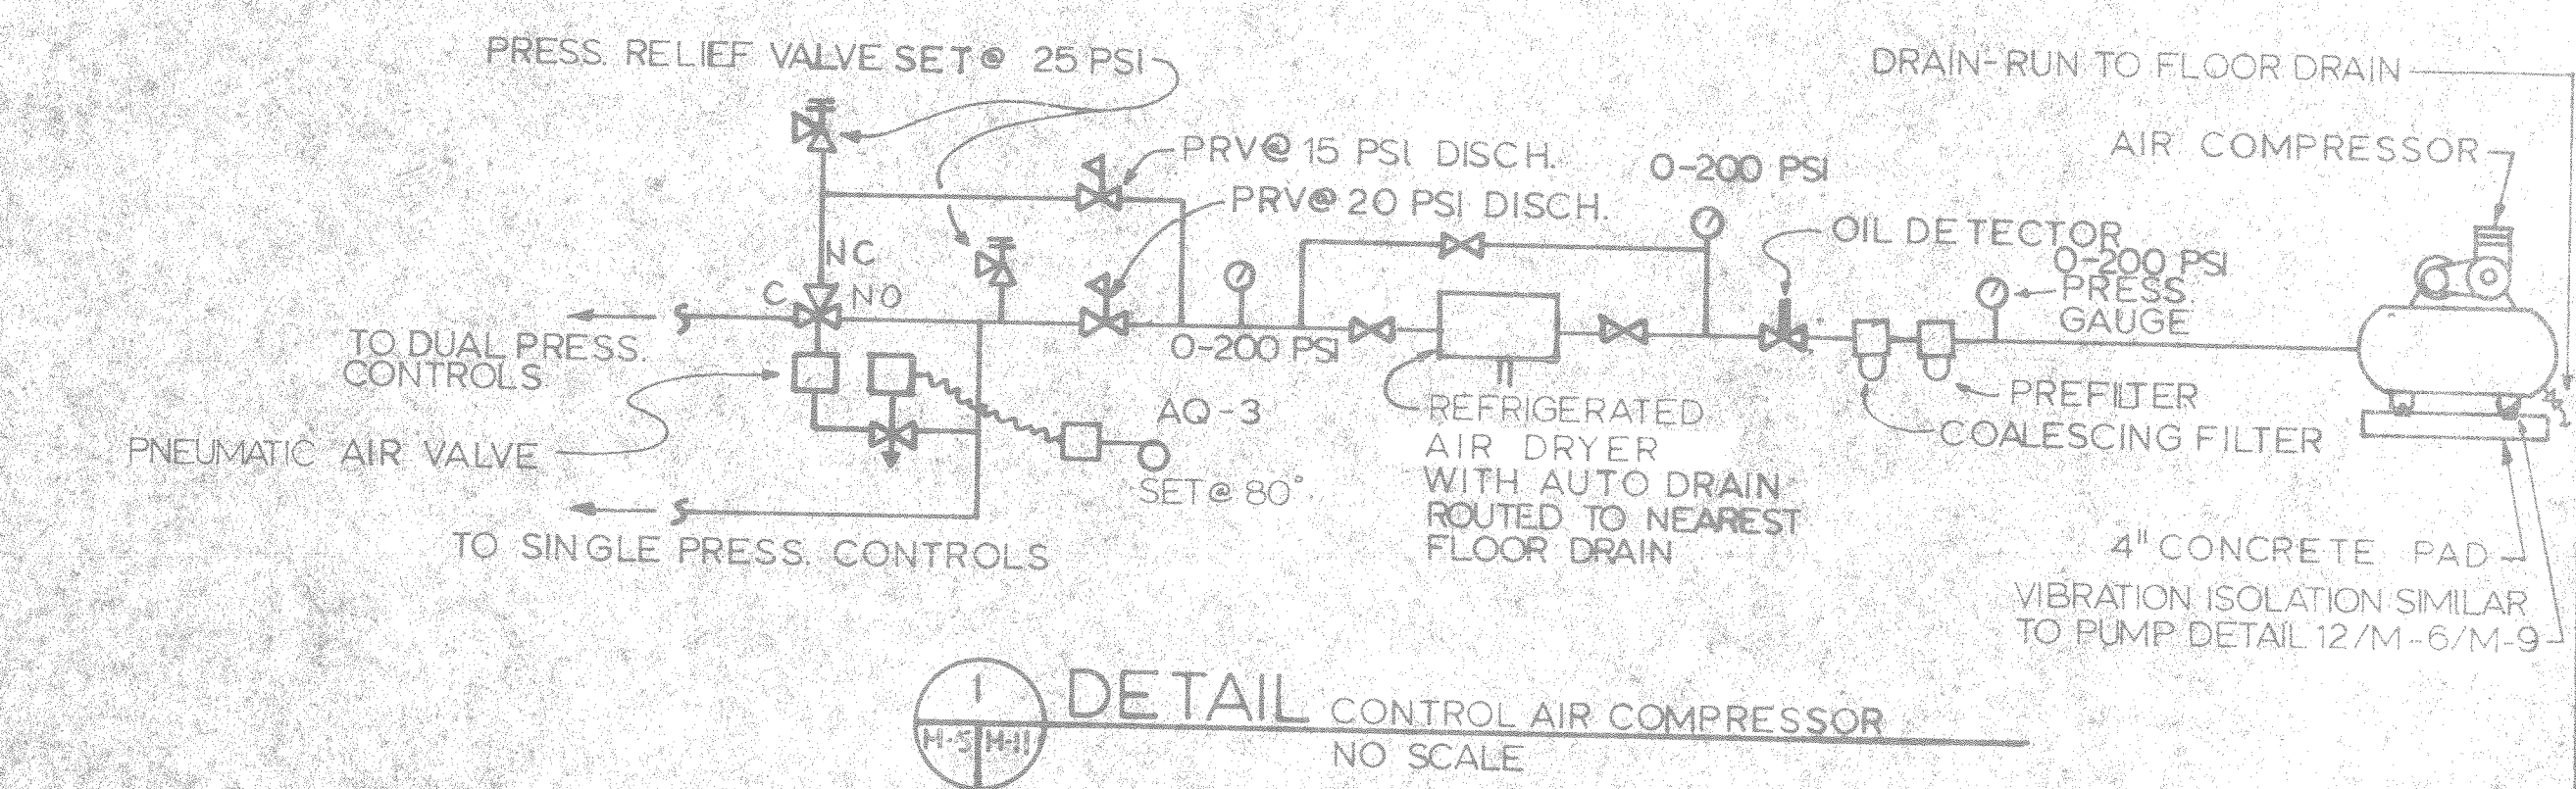


1-3/4" DETAIL CONTROL AIR COMPRESSOR  
NO SCALE

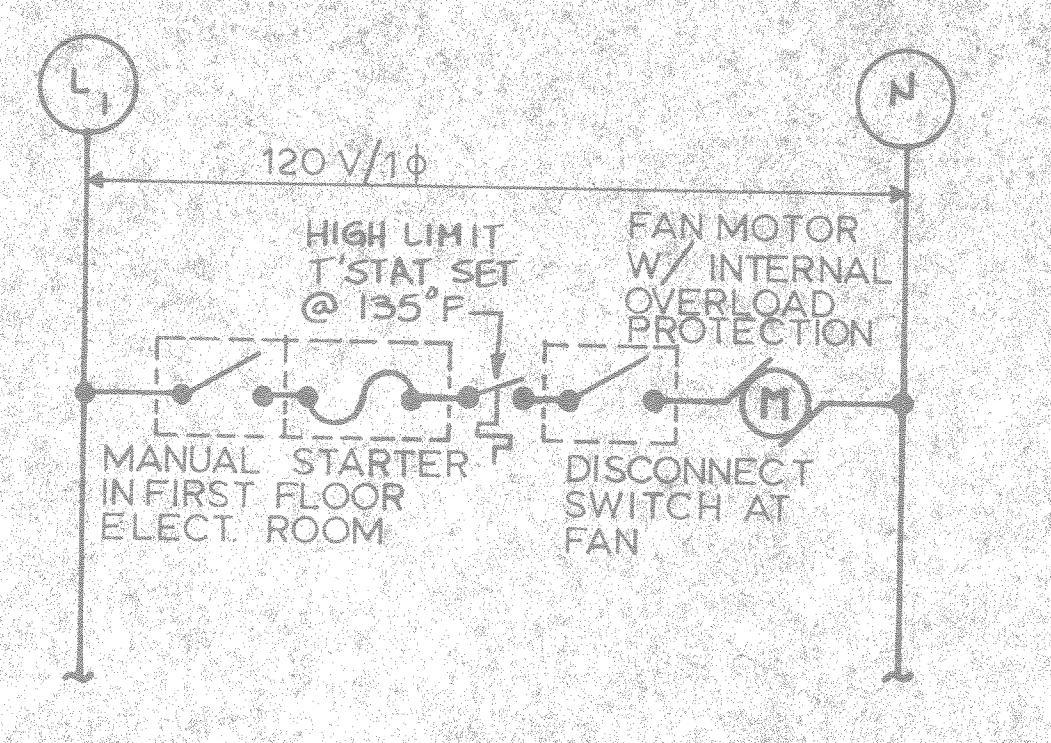

FAN EF-1 CONTROL (TYP FOR EF-2)  
NO SCALE

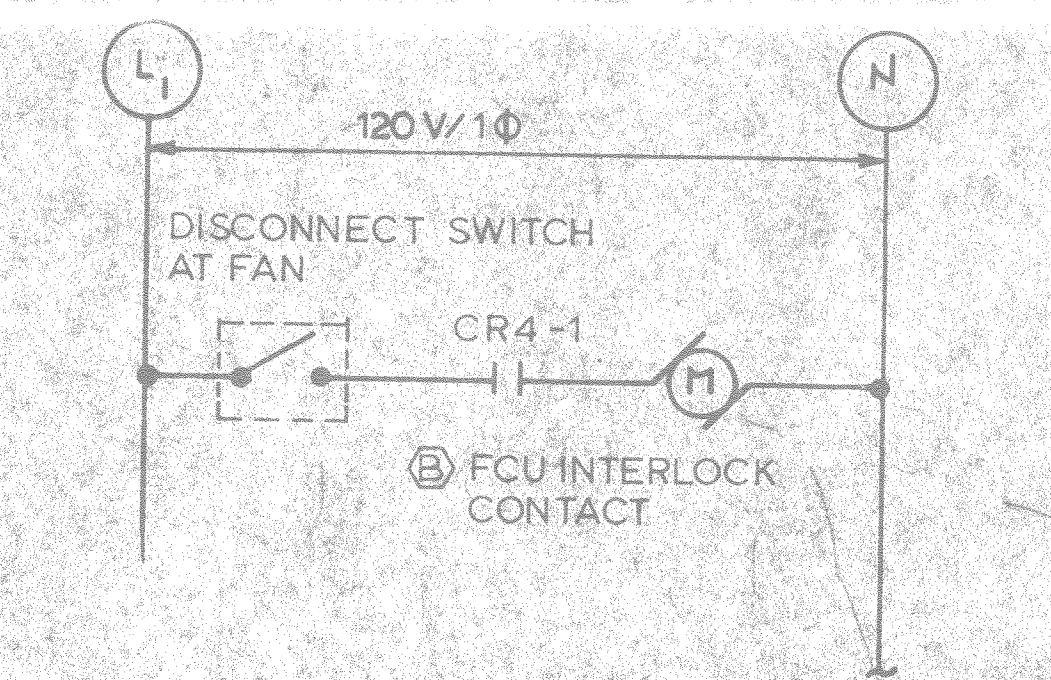

FAN EF-6 CONTROL  
NO SCALE

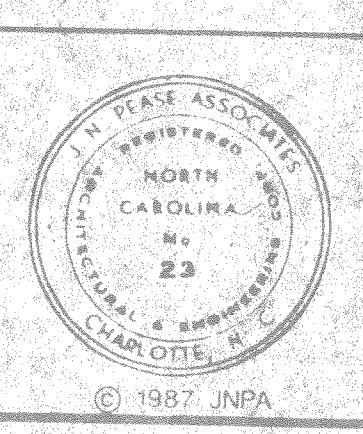

## RECORD DRAWING

### LETTER DATED 14 FEB 1991

M - 11

J. N. PEASE ASSOCIATES, ARCHITECTS - ENGINEERS - PLANNERS - CHARLOTTE - NORTH CAROLINA		DEPARTMENT OF THE NAVY, NAVAL FACILITIES ENGINEERING COMMAND, NAVAL STATION ATLANTIC DIVISION, NORFOLK, VIRGINIA	
DESIGNED BY: J. N. PEASE		DRAWN BY: J. N. PEASE	
CHECKED BY: J. N. PEASE		DATE: 10/19/87	
APPROVED BY: J. N. PEASE		PRINCIPAL	

MARINE CORPS BASE CAMP LEJEUNE, N.C. BACHELOR ENLISTED QUARTERS

### CONTROLS AND SCHEDULES

SIZE	CODE IDENT NO	NAVFAC DRAWING NO
F	80091	4168711
CONSTR CONTR NO	N62470-85-B-5428	
SCALE	1/8" = 1'-0"	SPEC 05-85-5428


DRAWING NO. 96-0110














REVISIONS			
SYM	DESCRIPTION	PREP BY	DATE
①	REVISED AS-BUILT	CB	CB

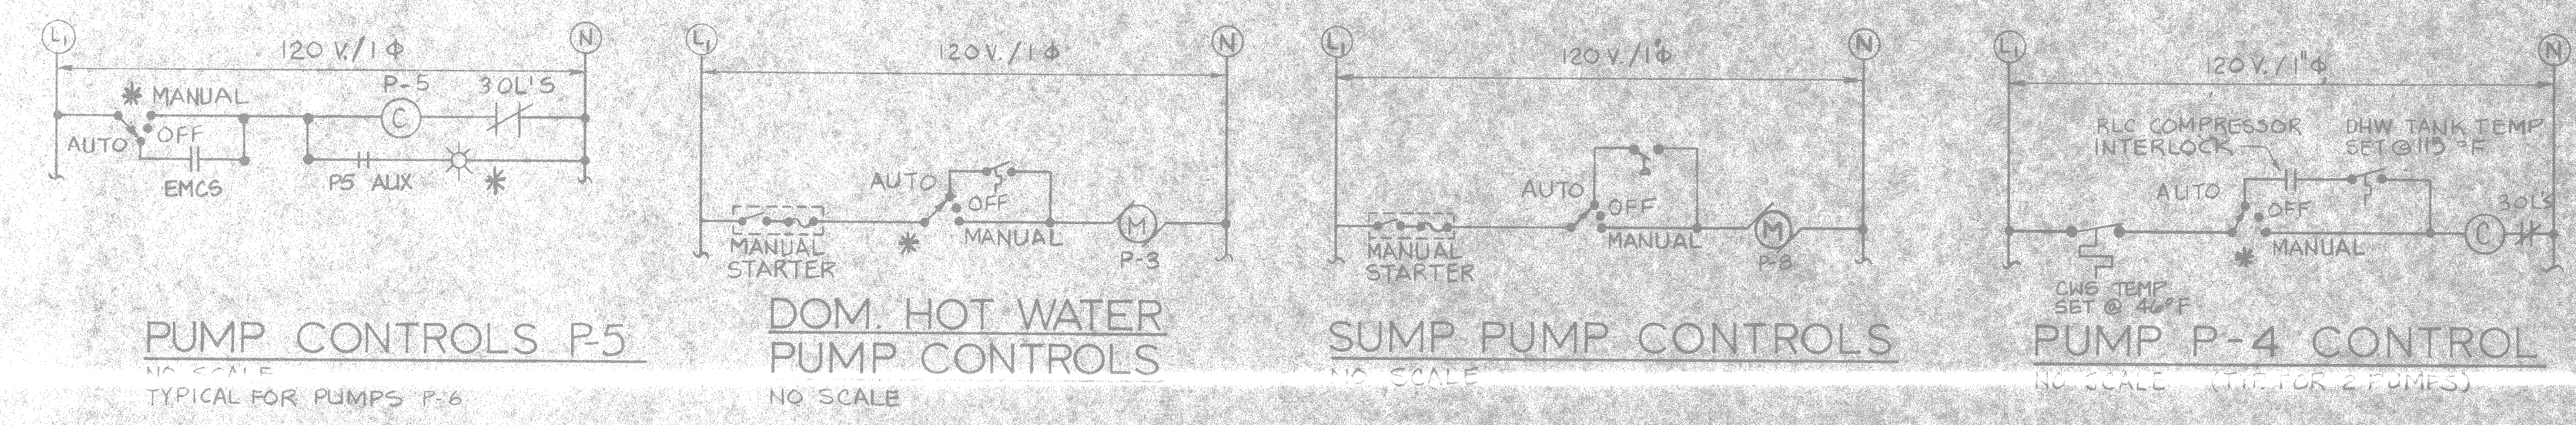

**CONTROL LEGEND**



- AO AQUASTAT
- CR CONTROL RELAY
- TS TEMPERATURE SENSOR
- MS MANUAL SWITCH
- DTC DATA TERMINAL CABINET
- S SENSOR
- N/C NORMALLY CLOSED
- N/O NORMALLY OPEN
- C COMMON
- PS STATIC PRESSURE SWITCH
- FS FLOW SWITCH
- TLL LOW LIMIT THERMOSTAT
- THL HIGH LIMIT THERMOSTAT
- TTR RETURN AIR TEMP TRANSMITTER
- TTD DISCHARGE AIR TEMP TRANSMITTER
- TI TEMP INDICATOR
- RC RESET CONTROLLER
- DLS THERMAL OVERLOADS
- DM DAMPER MOTOR
- EP ELECTRIC-PNEUMATIC SWITCH
- NO NORMALLY OPEN CONTACT
- NC NORMALLY CLOSED CONTACT
- PLT PILOT LIGHT
- FUSE FUSE
- TEMP. TEMP. SENSING SWITCH
- FLT FLOAT SWITCH

DESIGN CONDITIONS		
MODE	OUTSIDE	INSIDE
SUMMER	90°F DB / 74°F WB	78°F DB / 50% RH
WINTER	23°F DB	68°F DB

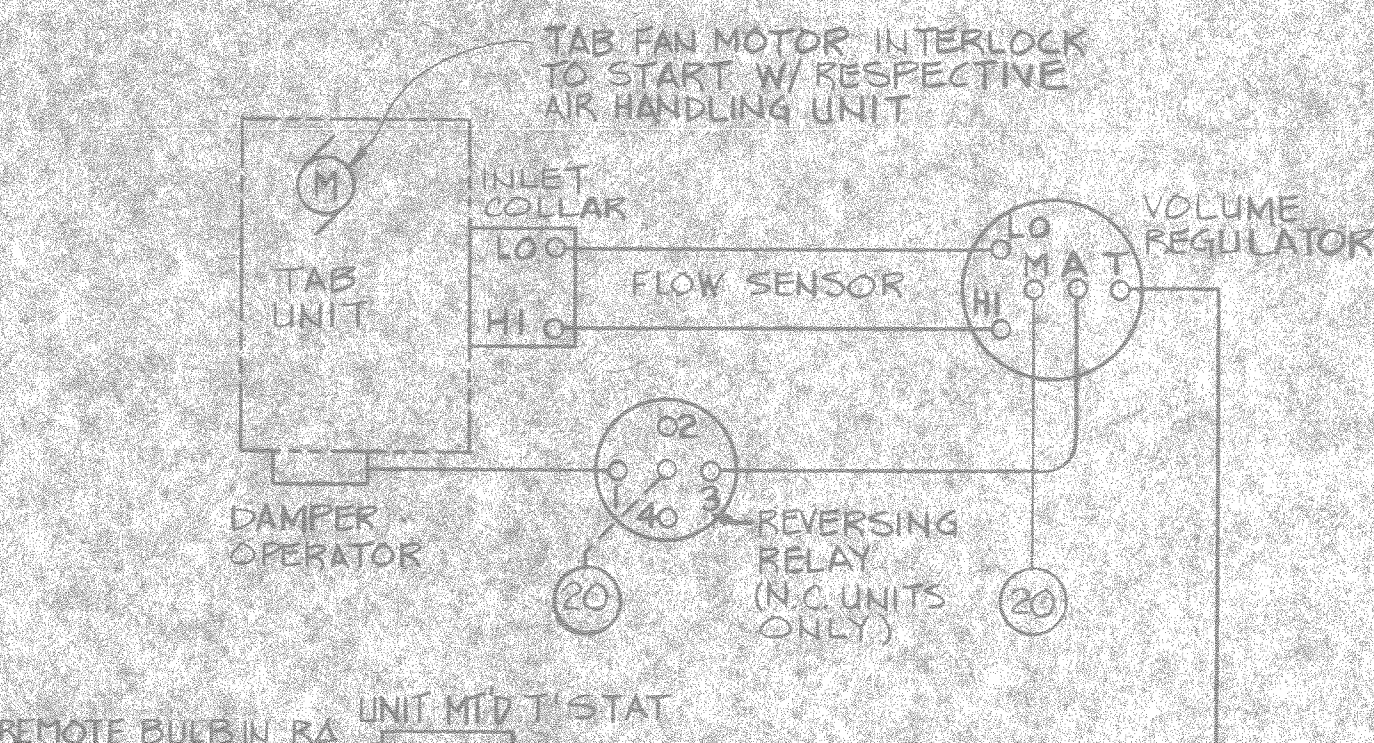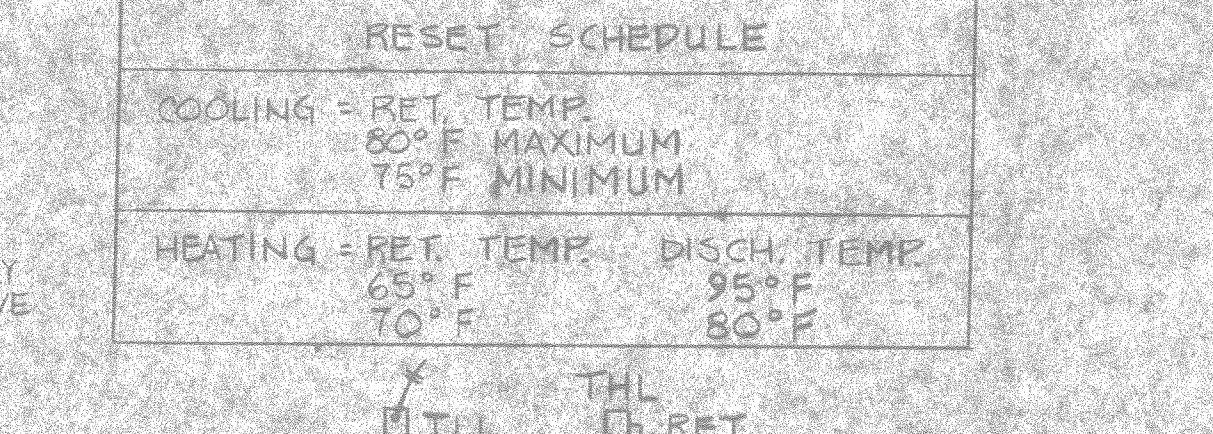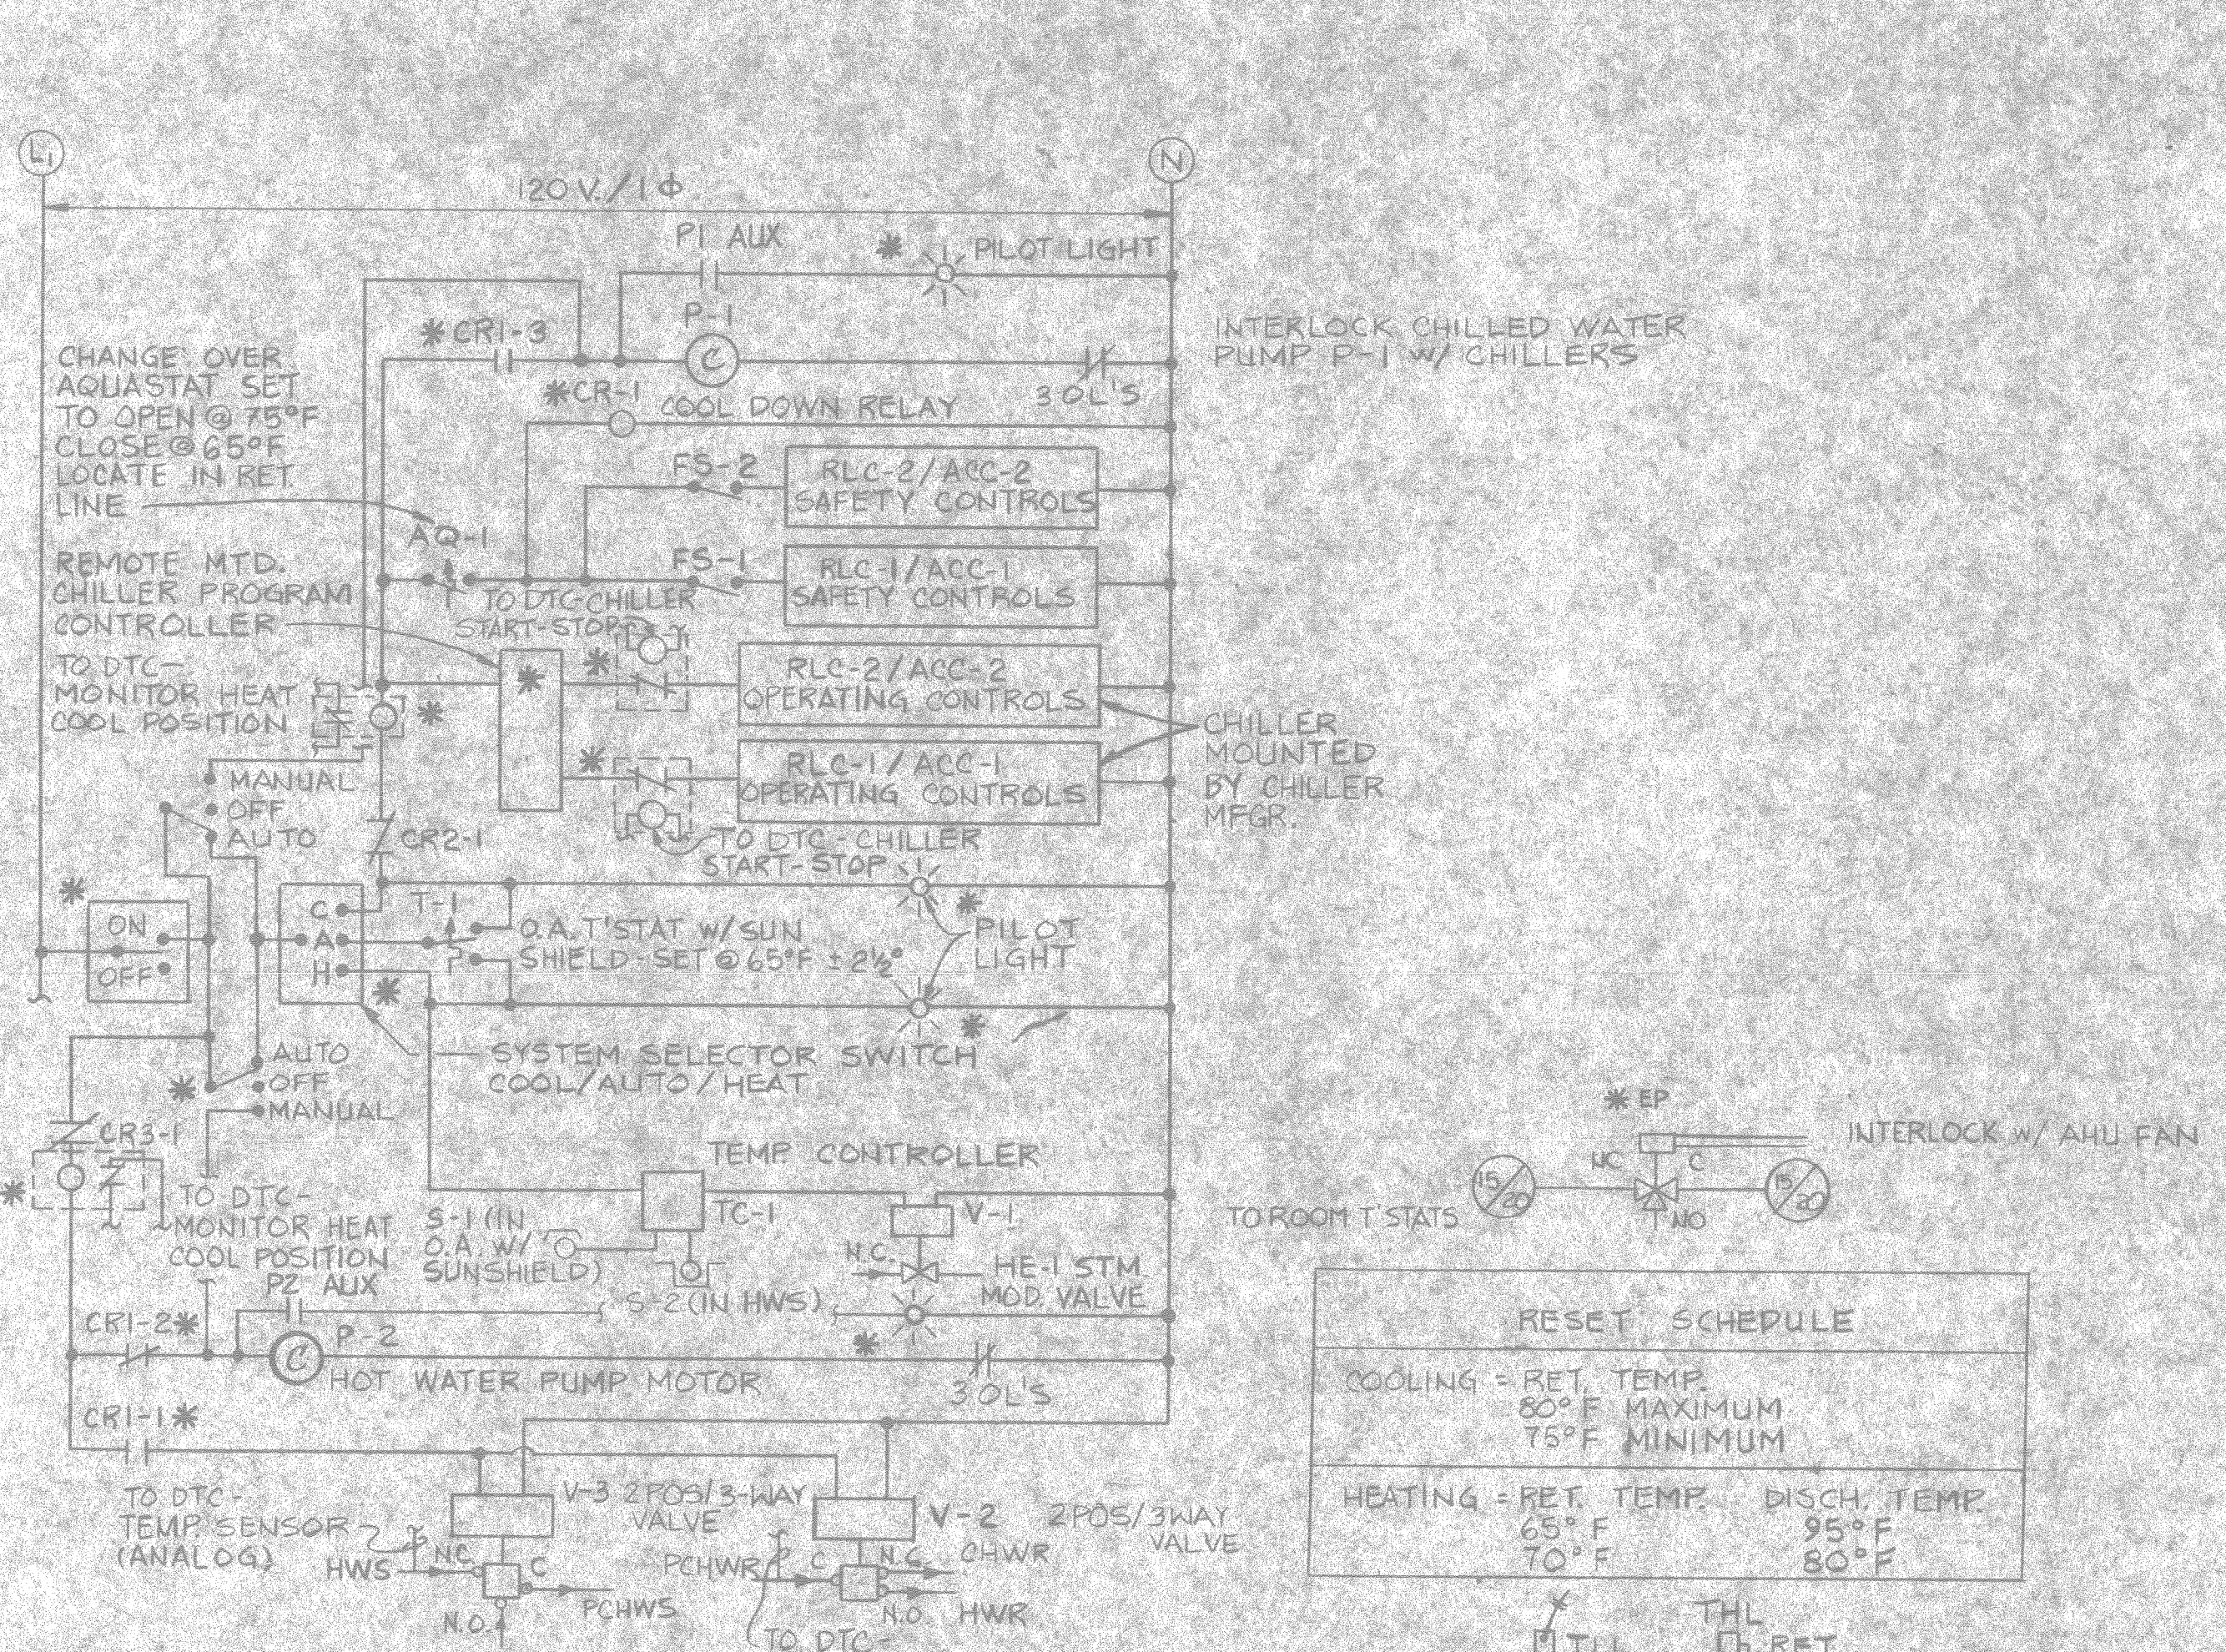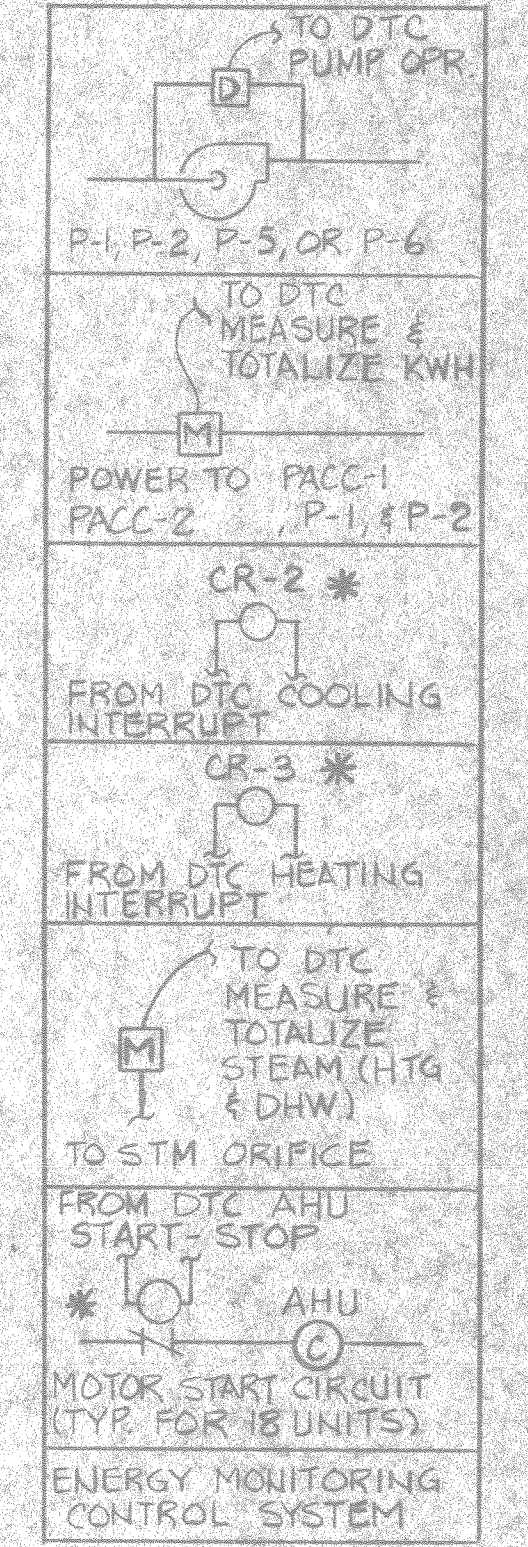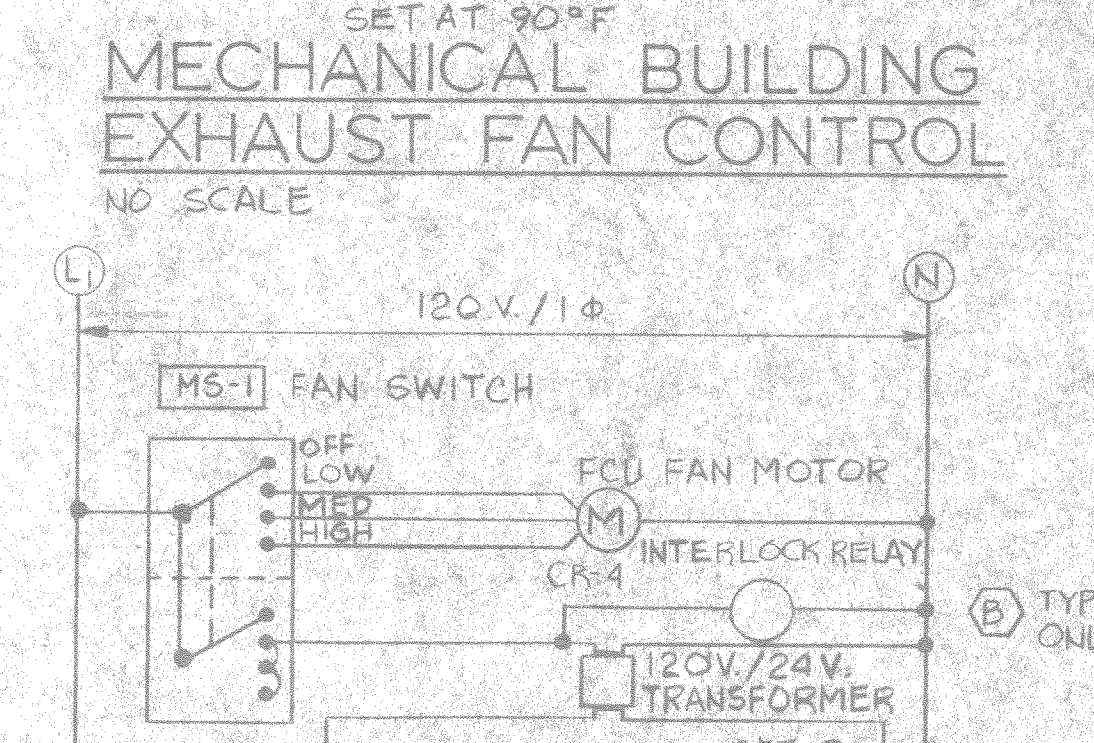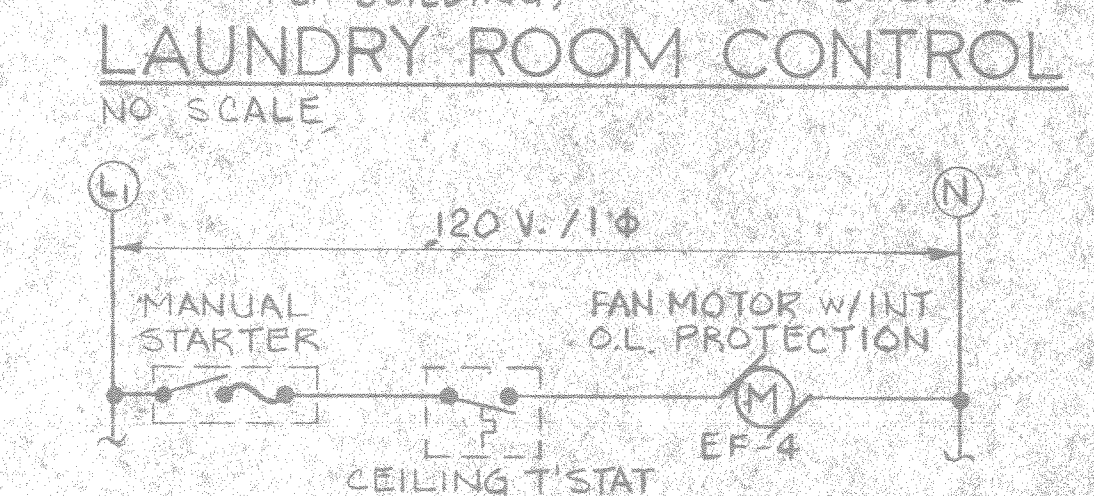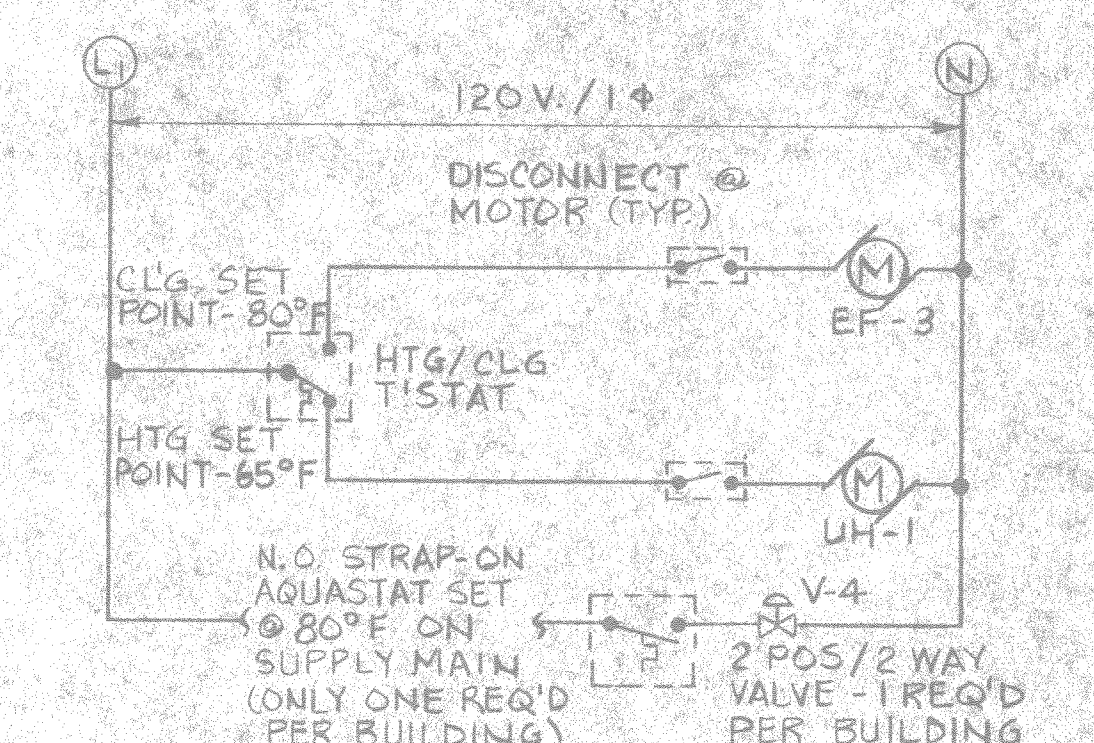

STEAM/HOT WATER HEAT EXCHANGER	
UNIT DESIGNATION	HE-1
TYPE SERVICE	HEATING
BLOG SERVED	HP 512-513-514
TEMP. IN °F	160°
TEMP. OUT °F	180°
STEAM PRESS. PSIG	15'
STEAM FLOW, GPH	294
WATER FLOW, GPM	25
EXCHANGE TYPE	SHELL/TUBE
NOTES	1. 2" @ 3" @ 4"

1. MAX. TUBE VEL. = 7 FEET PER SECOND  
2. MAX. PRESS. DROP = 5 FT WATER GAUGE  
3. SCALE FACTOR = 0.0005  
4. 14'4" x 24" LONG

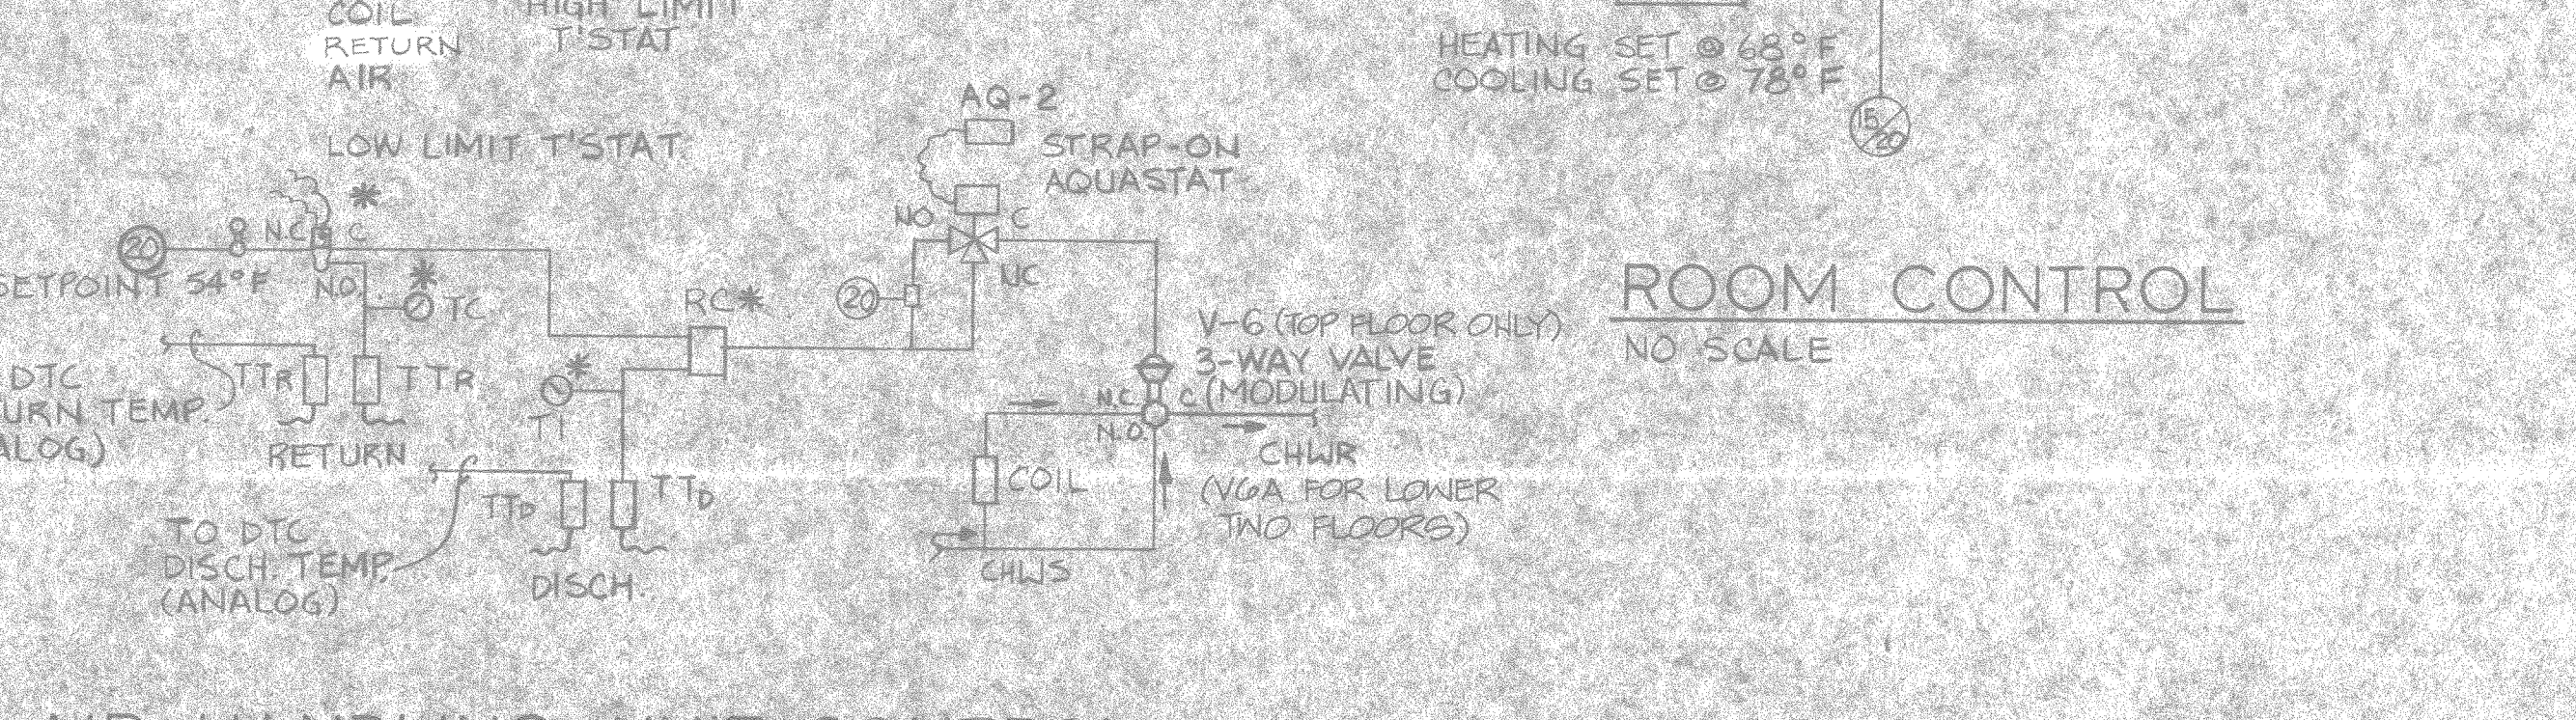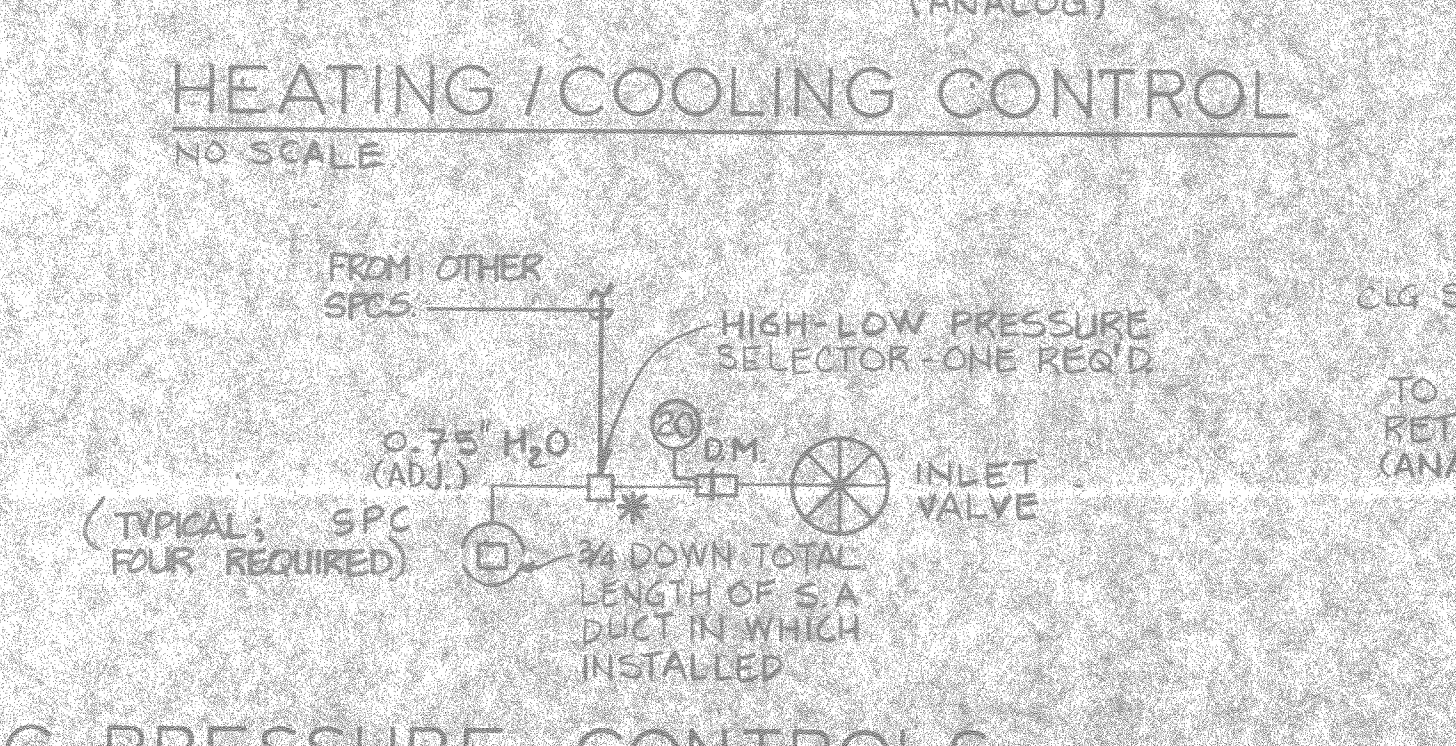

UNIT HEATER SCHEDULE	
UNIT DESIGNATION	UH-1
AREA SERVED	LAUNDRY
MIN. CAP. BTUH	12,500
ENT. AIR TEMP. °F	60
WATER TEMP. °F	180°
WATER TEMP. DROP	20°
MAX. MOTOR H.P.	1/2
VOLTS / PHASE / HERTZ	120/1/60
HEATER TYPE	HORIZONTAL
G.P.M.	0.5
NOTES	1. DIRECTIONAL DISCHARGE LOUVER 2. 300 CFM NOMINAL 3. FOULING FACTOR = 0.0005

FAN COIL UNIT SCHEDULE		
UNIT DESIGNATION	①	②
NOTES	①	②
NOMINAL CFM	600	200
COIL SELECTION, CFM	600	200
MAXIMUM CHILLED WATER FLOW GPM	3	1
MINIMUM COIL CAPACITY SENSIBLE BTUH	10,822	3,876
MINIMUM COIL CAPACITY TOTAL BTUH	16,740	5,400
ENTERING AIR TEMP. DB °F	83.0	78
ENTERING AIR TEMP. WB °F	70.8	65
ENTERING WATER TEMP. °F	44.0	44.0
MINIMUM COIL CAPACITY TOTAL BTUH	19,894	5,832
ENTERING AIR TEMP. DB °F	43.3	68
ENTERING WATER TEMP. °F	190.0	190.0
CFM OUTSIDE AIR	250	0
PIPING RUNOUT SIZE, SUPPLY & RETURN	1"	1/2"
MAXIMUM MOTOR WATTAGE	135	95
MAXIMUM HOT WATER FLOW GPM	3	1.2

PACKAGED AIR COOLED CHILLER			
UNIT DESIGNATION	P-1	P-2	P-3
BUILDING SERVED	HP 512-513-514	HP 512-513-514	HP 512-513-514
MINIMUM TOTAL CAPACITY TONS	82.9	80.9	82.9
ENTERING WATER TEMP. °F	56°	56°	56°
LEAVING WATER TEMP. °F	44°	44°	44°
WATER FLOW GPM	183	182	183
AMBIENT AIR TEMP. DB °F	92°	92°	92°
MAXIMUM WATER PRESSURE DROP FT WG	12	12	12
MAXIMUM UNIT KW	130	130	130
VOLTS / PHASE / HERTZ	480/3/60	480/3/60	480/3/60
CHILLER SHALL HAVE MINIMUM OF 4 STEPS OF CAPACITY REDUCTION			
FOULING FACTOR	0.0005		

PUMP SCHEDULE							
UNIT DESIGNATION	P-1	P-2	P-3	P-4	P-5	P-6	P-7
TYPE SERVICE	CHILLED WATER	HOT WATER	DOMAN HW	HEAT RECLAIM	SECONDARY	SECONDARY	STEAM COND.
BLOG SERVED	HP 512-513-514	HP 512-513-514	HP 515	HP 515	HP 512-513-514	HP 512-513-514	HP 515
WATER FLOW GPM	375	230	60	16	1120	135	39
TOTAL HEAD FT W.G.	90	40	2.6	2.5	55	50	30
R.P.M. / VEMA STR.	1750/2	1750/0	1750/0	1750/1	1750/1	3500/0	1750/0
MAX MOTOR H.P.	15	5	1/2	5	5	3	1/2
VOLTS / PHASE / HERTZ	480/3/60	480/3/60	480/3/60	120/1/60	208/3/60	208/3/60	480/3/60
PUMP TYPE	BASE MTD	BASE MTD	IN-LINE	IN-LINE	IN-LINE	IN-LINE	CENTRIFUGAL

EXHAUST FAN SCHEDULE						
UNIT DESIGNATION	EF-1	EF-2	EF-3	EF-4	EF-5	EF-6
NOTES	①	②	③	④	⑤	⑥
AIR FLOW, CFM	120	440	500	2160	109	240
TOTAL STATIC PRESSURE IN WG	125	125	125	25	125	0.25
LOCATION	ROOF	ROOF	WALL	CEILING	LOUNGE	LOUNGE
AREA SERVED	LANCIBET	ELECT. ROOM	LAUNDRY	HP-502	TOILETS	LOUNGE
MAX MOTOR H.P.	3/8 MHP	1/2	1/2	0.7 AMPS	1/4	1/4
VOLTS / PHASE / HERTZ	120/1/60	120/1/60	120/1/60	120/1/60	120/1/60	120/1/60
FAN TYPE	CENTRIFUGAL	CENTRIFUGAL	PROP.	CENTRIFUGAL	CENTRIFUGAL	W-LINEBOLT

- ① HORIZONTAL TYPE W/ OUTSIDE AIR INTAKE
- ② VERTICAL TYPE W/ OUTSIDE AIR
- ③ SELECT UNITS TO MEET SENSIBLE CAPACITY @ HIGH FAN SPEED
- ④ 0.0005 FOULING FACTOR
- ⑤ UNITS ARE 120 V / 1 φ
- ⑥ MAXIMUM COIL WATER PRESSURE DROP = 150 FT
- ⑦ MAXIMUM COIL WATER PRESSURE DROP = 50 FT

- ① PROVIDE MOTOR OPERATED 1/2" MPEE DISCONNECT SWITCH & BIRD SCREEN
  - ② PROVIDE ALUMINUM WALL GRIDDLE, FAN GUARD & GRAVITY BACKDRAFT DAMPER & DISCONNECT SWITCH
  - ③ PROVIDE ALUMINUM SELF-FLASHING CURB SEE DETAIL 4-14/4-19
  - ④ MAX SOUND LEVEL TO BE 4 SONES
  - ⑤ 1" TELECOP W/ LIGHT SWITCH
  - ⑥ BIRD SCREEN NOT REQUIRED ON EF-5
- PUMP SCHEDULE NOTES:**
- ① MOTOR CAPACITY SQUARE FEET
  - ② ORIGINAL RECEIVER CAPACITY
  - ③ DUPLEX W/ CAST IRON RECEIVER
  - ④ HIGH ALTERNATOR
  - \*\*\* NO REQ'D \*\* FOUR REQ'D

**RECORD DRAWING**  
LETTER DATED 14 FEB 1991

**M - 10**

J. N. PRASE ASSOCIATES ARCHITECTS - ENGINEERS - PLANNERS  
CHARLOTTE NORTH CAROLINA

DEPARTMENT OF THE NAVY NAVAL FACILITIES ENGINEERING COMMAND  
ATLANTIC DIVISION

MARINE CORPS BASE CAMP LEJEUNE, NC  
BACHELOR ENLISTED QUARTERS

**CONTROLS & SCHEDULES**

APPROVED: [Signature] DATE: [Date]

OFFICER IN CHARGE: [Signature] DATE: [Date]

SCALE: AS SHOWN SPEC 05-85-5428 SHEET 06 OF 10

FOR EED FOR COMMANDER, NAFAC






















NO.	REVISION	DATE	APPROVED
1	REVISED AS BUILT		

SYMBOL LEGEND	
(T) THERMOSTAT (VENTILATION)	DMSD DUCT MOUNTED SMOKE DETECTOR
(T) THERMOSTAT (HEATING & COOLING)	O.V. OUTLET VELOCITY
(T) THERMOSTAT (HEATING)	CHWS CHILLED HOT WATER SUPPLY
(T) THERMOSTAT (HEATING)	CHWR CHILLED HOT WATER RETURN
(T) THERMOSTAT (HEATING)	CHWS CHILLED WATER SUPPLY
(T) THERMOSTAT (HEATING)	CHWR CHILLED WATER RETURN
(C) CONNECT NEW TO EXISTING	GV GATE VALVE
(R) PIPE REDUCER ECCENTRIC	HGEV HOSE END GATE VALVE
(C) GAGE COCK	BV BUTTERFLY VALVE
(C) CAST IRON	GV GLOBE VALVE
(C) AFF. ABOVE FINISHED FLOOR	STR STRAINER
(C) EXTERNAL STATIC PRESSURE	2WV 2 WAY CONTROL VALVE
(C) FLOW CONTROL BALANCING VALVE	3WV 3 WAY CONTROL VALVE
(C) UNION	UNION
(C) PIPE REDUCER CONCENTRIC	PRV PRESS. RED. VALVE
(C) PRESS. GAGE	MANV MANUAL AIR VENT
(C) PRESS. GAGE	MVD MANUAL VOLUME DAMPER
(C) PRESS. GAGE	PRV PRESS. RED. VALVE
(C) PRESS. GAGE	FCU FAN COIL UNIT
(C) PRESS. GAGE	UH UNIT HEATER
(C) PRESS. GAGE	TABU TERMINAL AIR BLENDER
(C) PRESS. GAGE	DS DEFLUVER HEATER
(C) PRESS. GAGE	FLDR FLOORS DRAIN
(C) PRESS. GAGE	OCB OPPOSED BLADE DAMPER
(C) PRESS. GAGE	EMCS ENERGY MONITORING CONTROL SYSTEM
(C) PRESS. GAGE	MOD MOTOR OPERATED DAMPER
(C) PRESS. GAGE	AD ACCESS DOORS
(C) PRESS. GAGE	FP FIRE DAMPER
(C) PRESS. GAGE	BFF BELOW FINISHED FLOOR
(C) PRESS. GAGE	THERM THERMOSTAT
(C) PRESS. GAGE	HS HUMIDITY SENSOR
(C) PRESS. GAGE	HWS HOT WATER SUPPLY
(C) PRESS. GAGE	HWR HOT WATER RETURN
(C) PRESS. GAGE	MPS MEDIUM PRESSURE STEAM
(C) PRESS. GAGE	FLD FLOW DIRECTION
(C) PRESS. GAGE	HPS HIGH PRESSURE STEAM
(C) PRESS. GAGE	DG DOOR GRILLE
(C) PRESS. GAGE	PA PIPE ANCHORS
(C) PRESS. GAGE	PCHWS PRIMARY CHILLED HOT WATER SUPPLY
(C) PRESS. GAGE	PCHWR PRIMARY CHILLED HOT WATER RETURN
(C) PRESS. GAGE	DHWS DOMESTIC HWS
(C) PRESS. GAGE	DHWR DOMESTIC HWR
(C) PRESS. GAGE	RHW RECLAIM HOT WATER
(C) PRESS. GAGE	PD PUMP DISCHARGE
(C) PRESS. GAGE	VTR VENT TO ROOF
(C) PRESS. GAGE	MPD MED. PRESS. DRIP ASSEMBLY
(C) PRESS. GAGE	HPD HIGH PRESS. DRIP ASSEMBLY
(C) PRESS. GAGE	HG HOT GAS LINE
(C) PRESS. GAGE	L LIQUID LINE
(C) PRESS. GAGE	CVA CONTROL VALVE ASSEMBLY
(C) PRESS. GAGE	PACC PACKAGE AIR COOLED CHILLER
(C) PRESS. GAGE	E EXPANSION LINE
(C) PRESS. GAGE	CTE CONNECT TO EXISTING

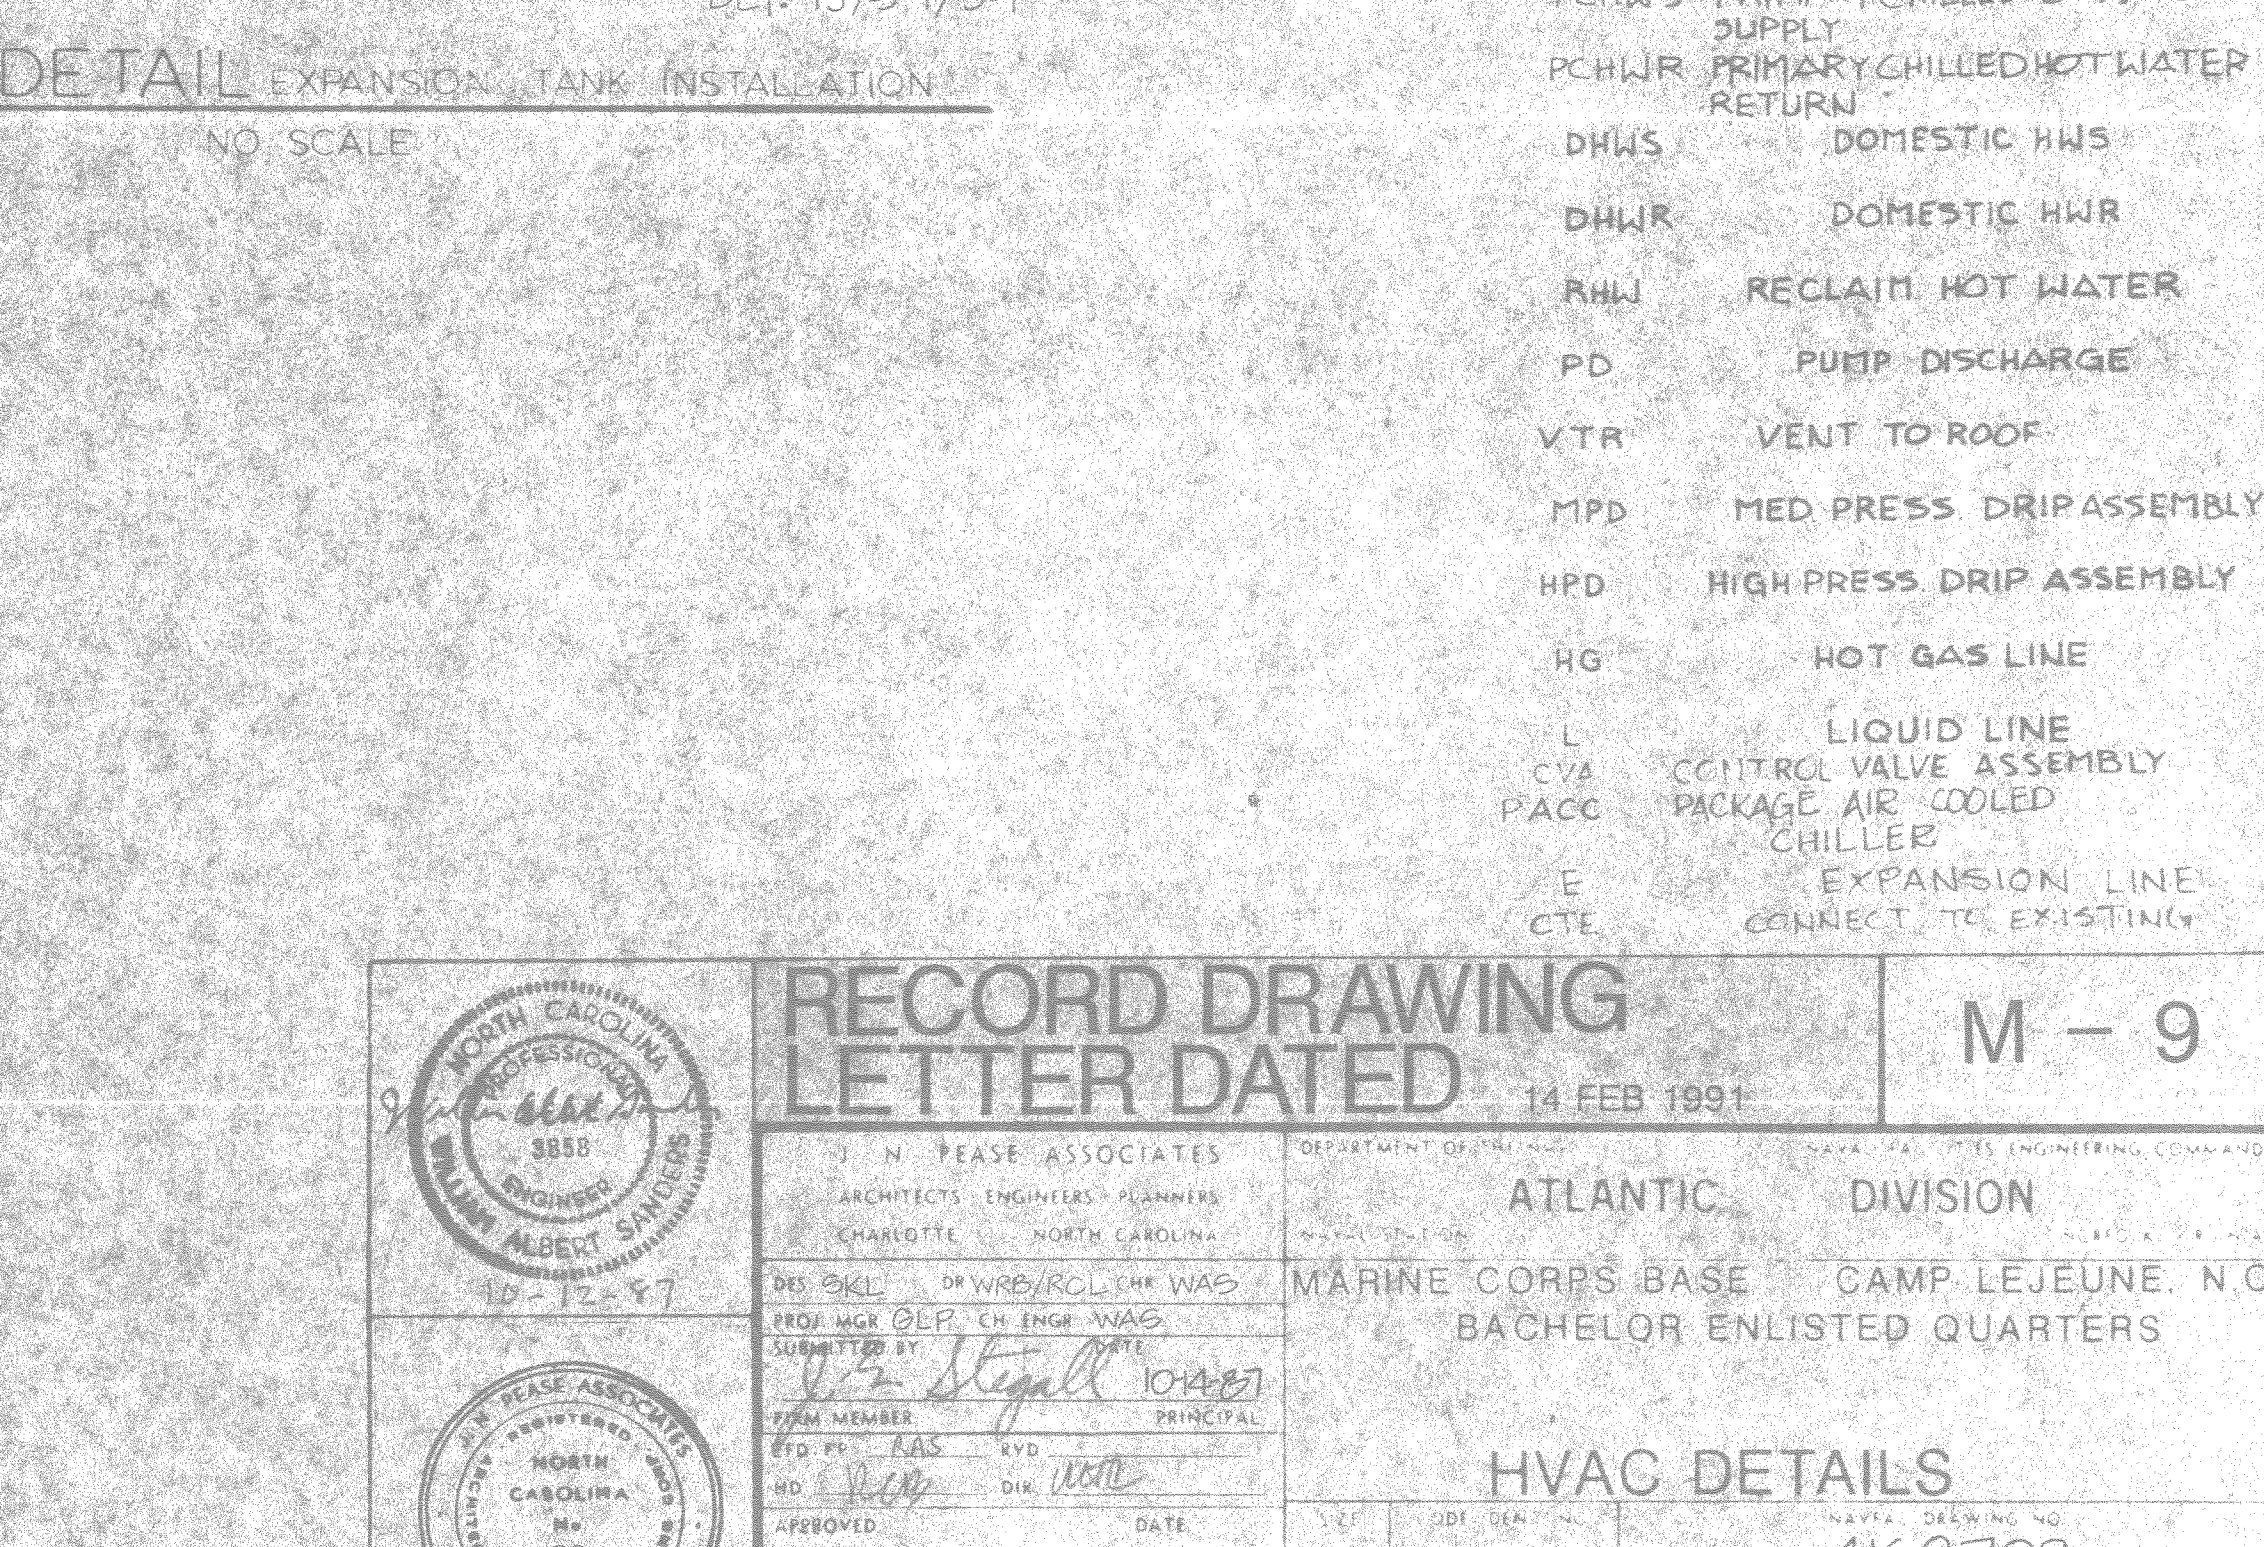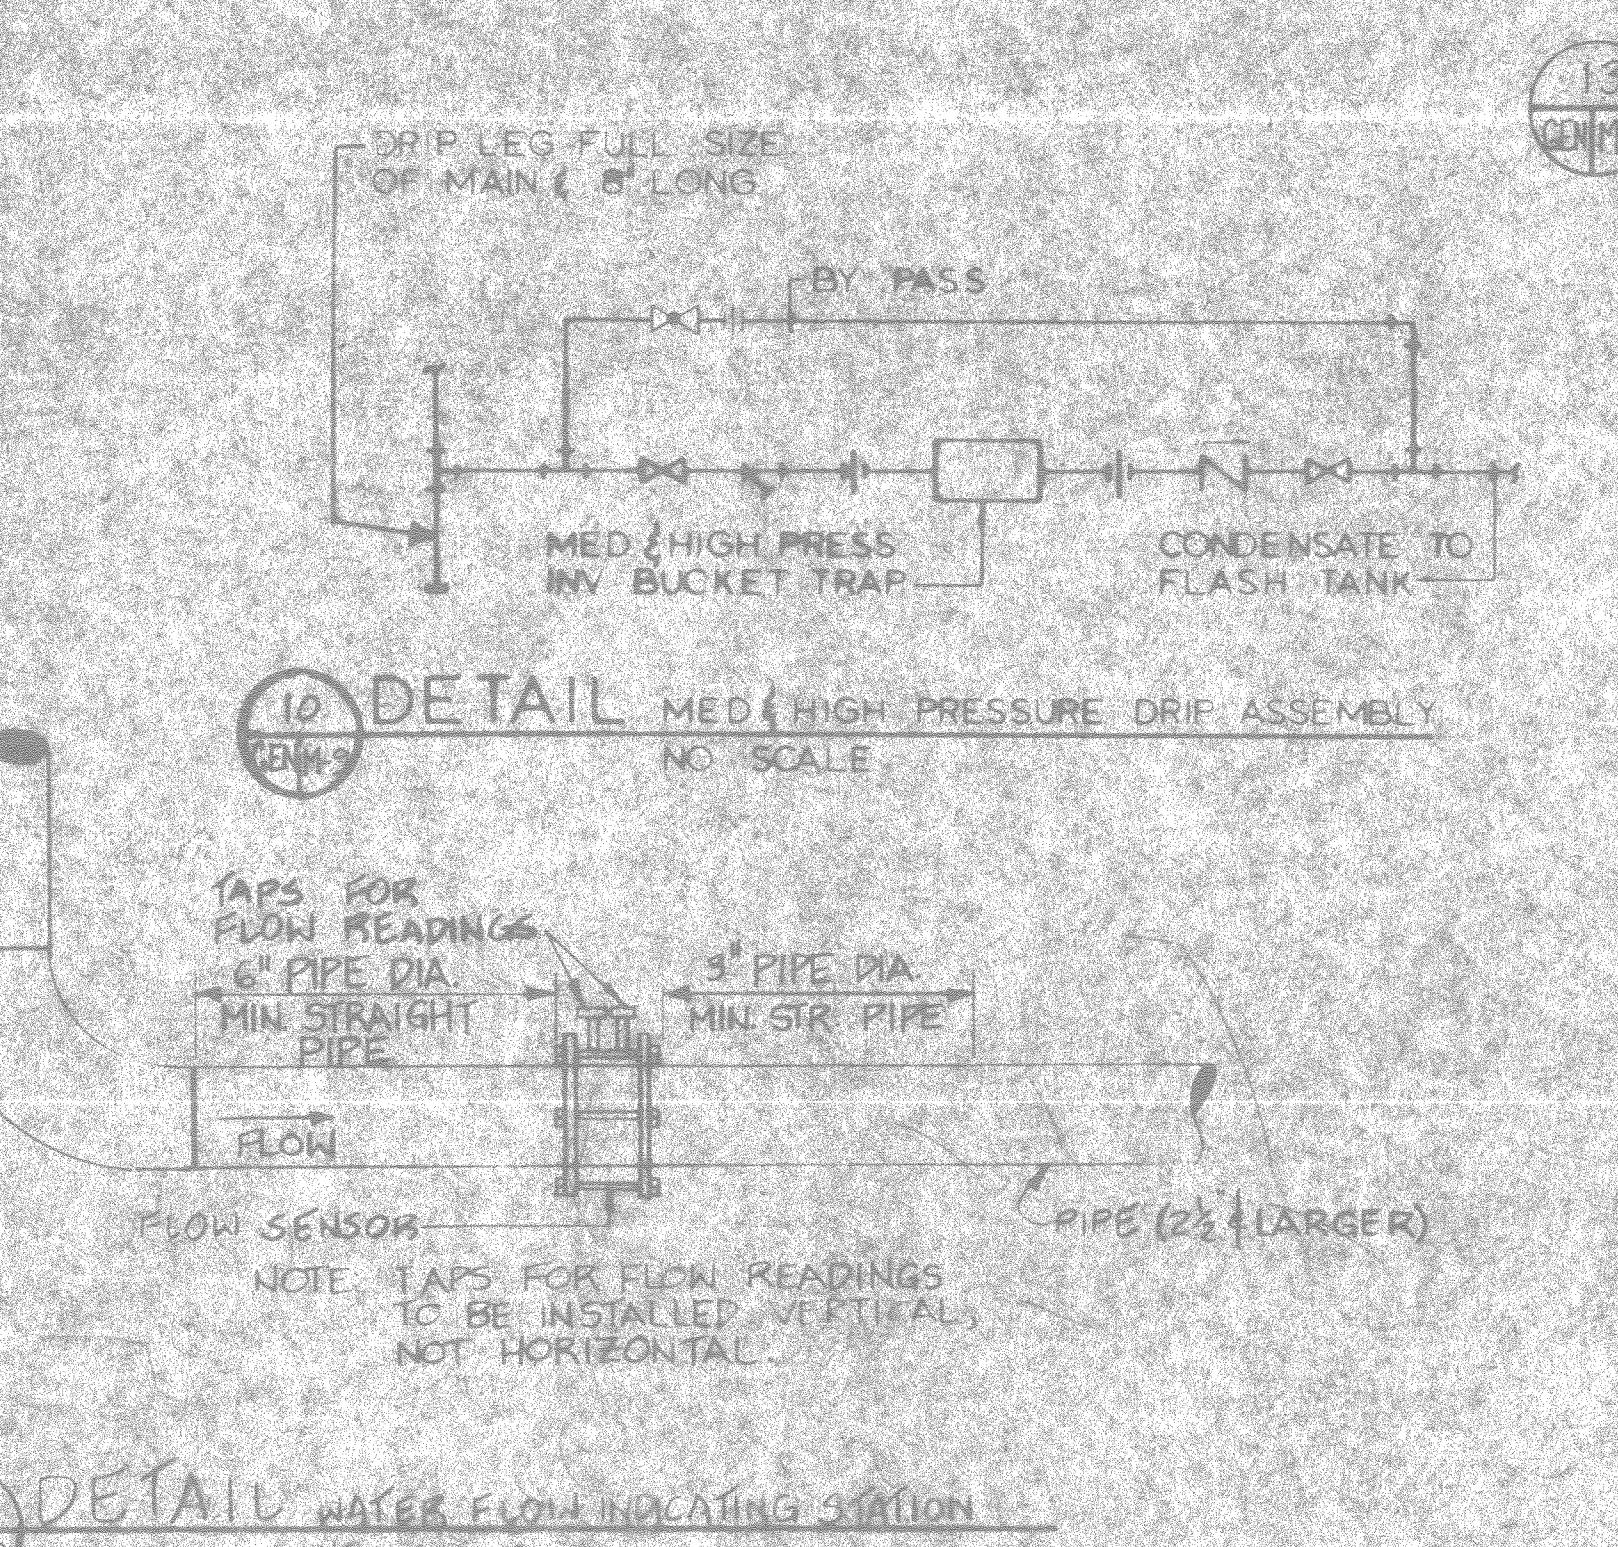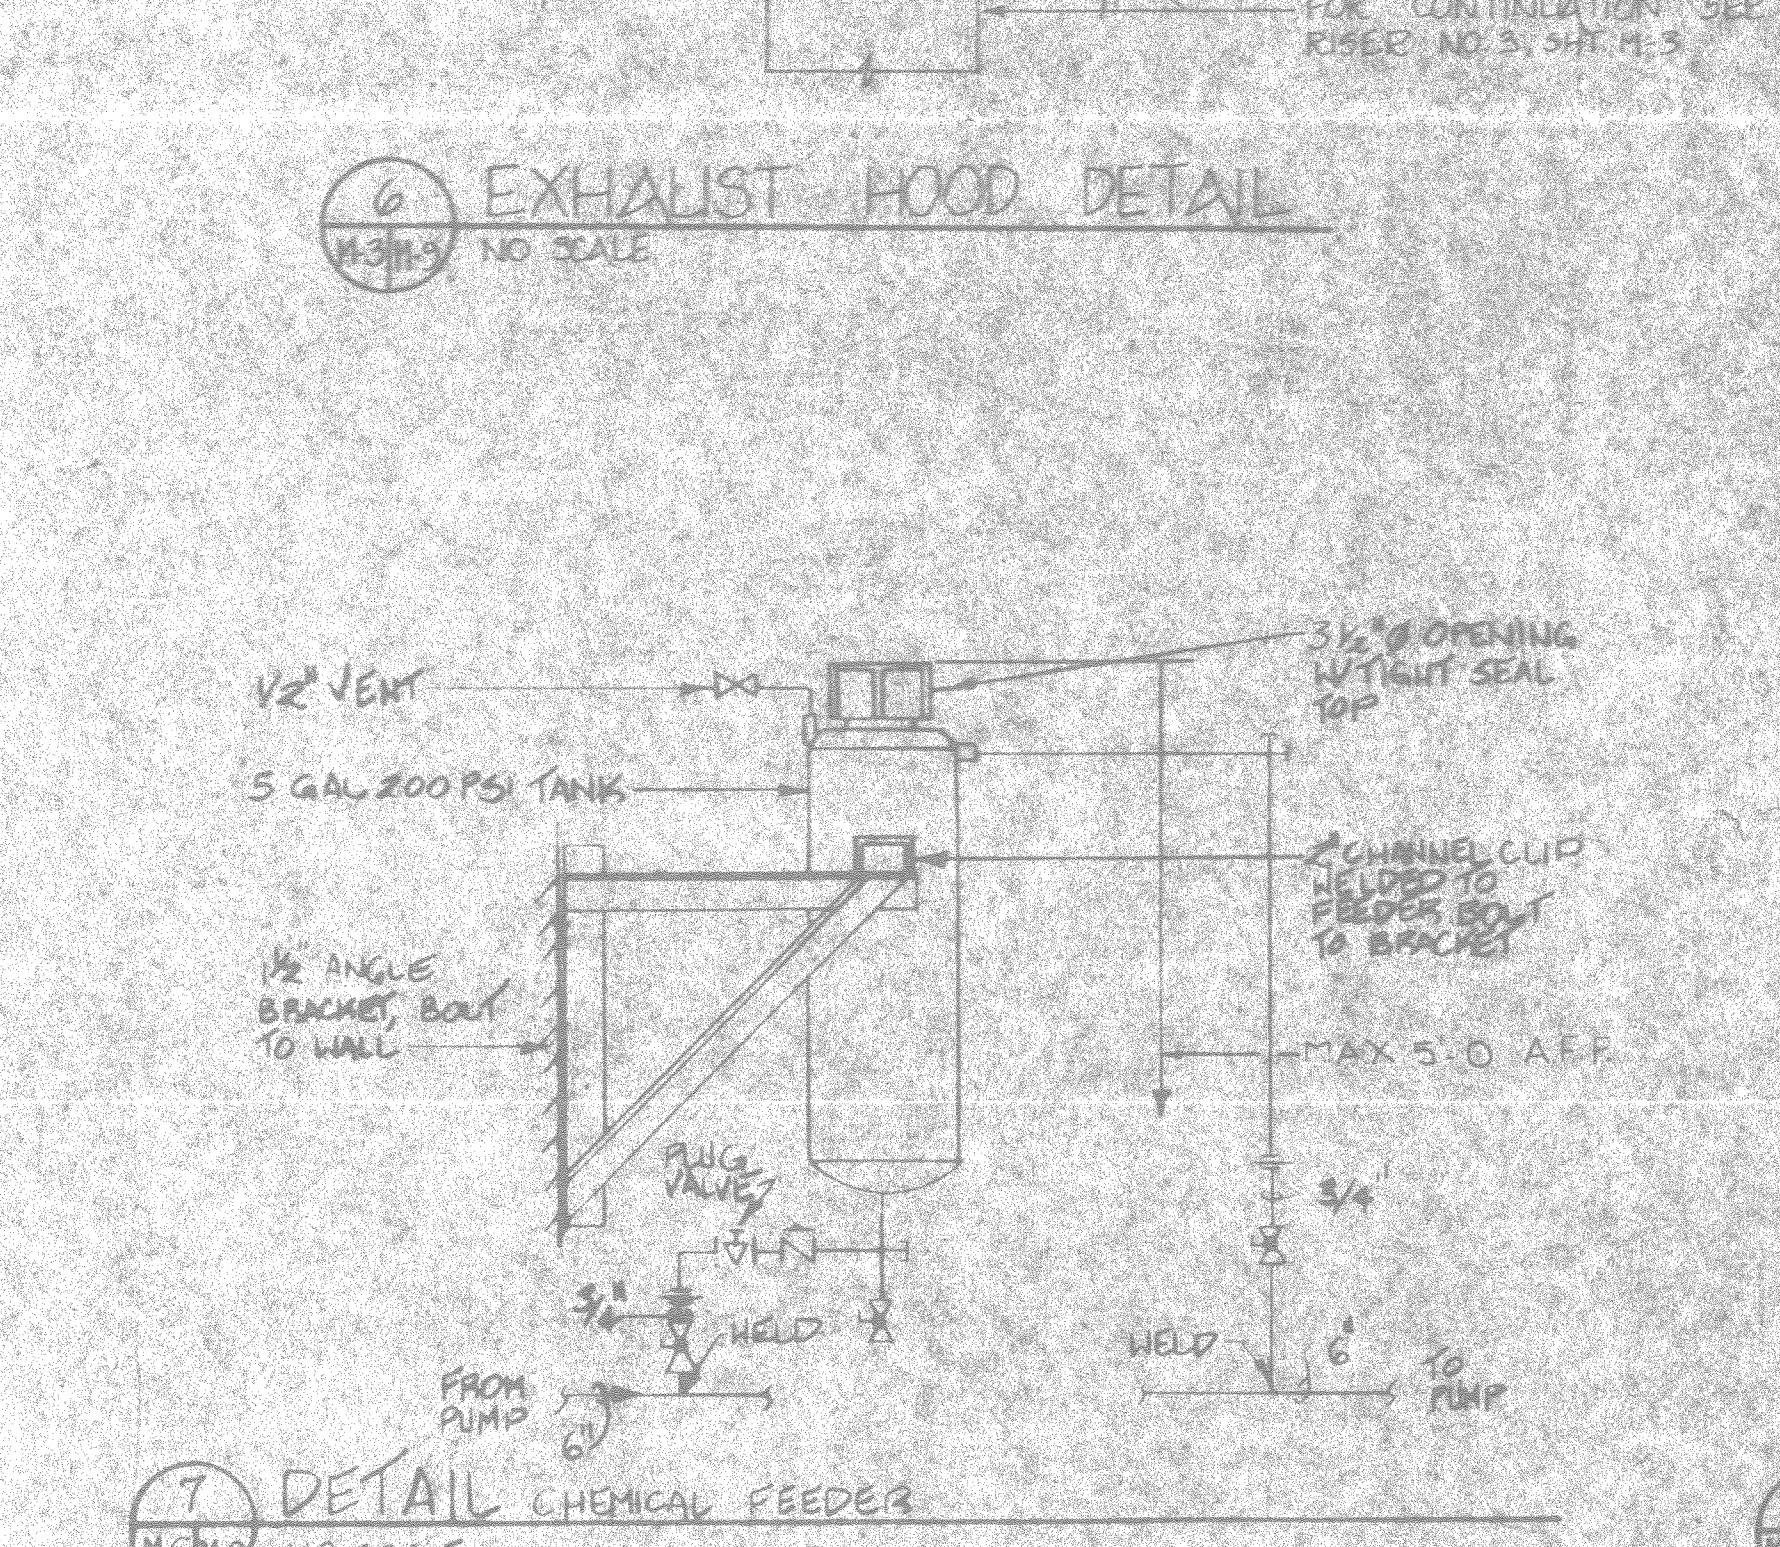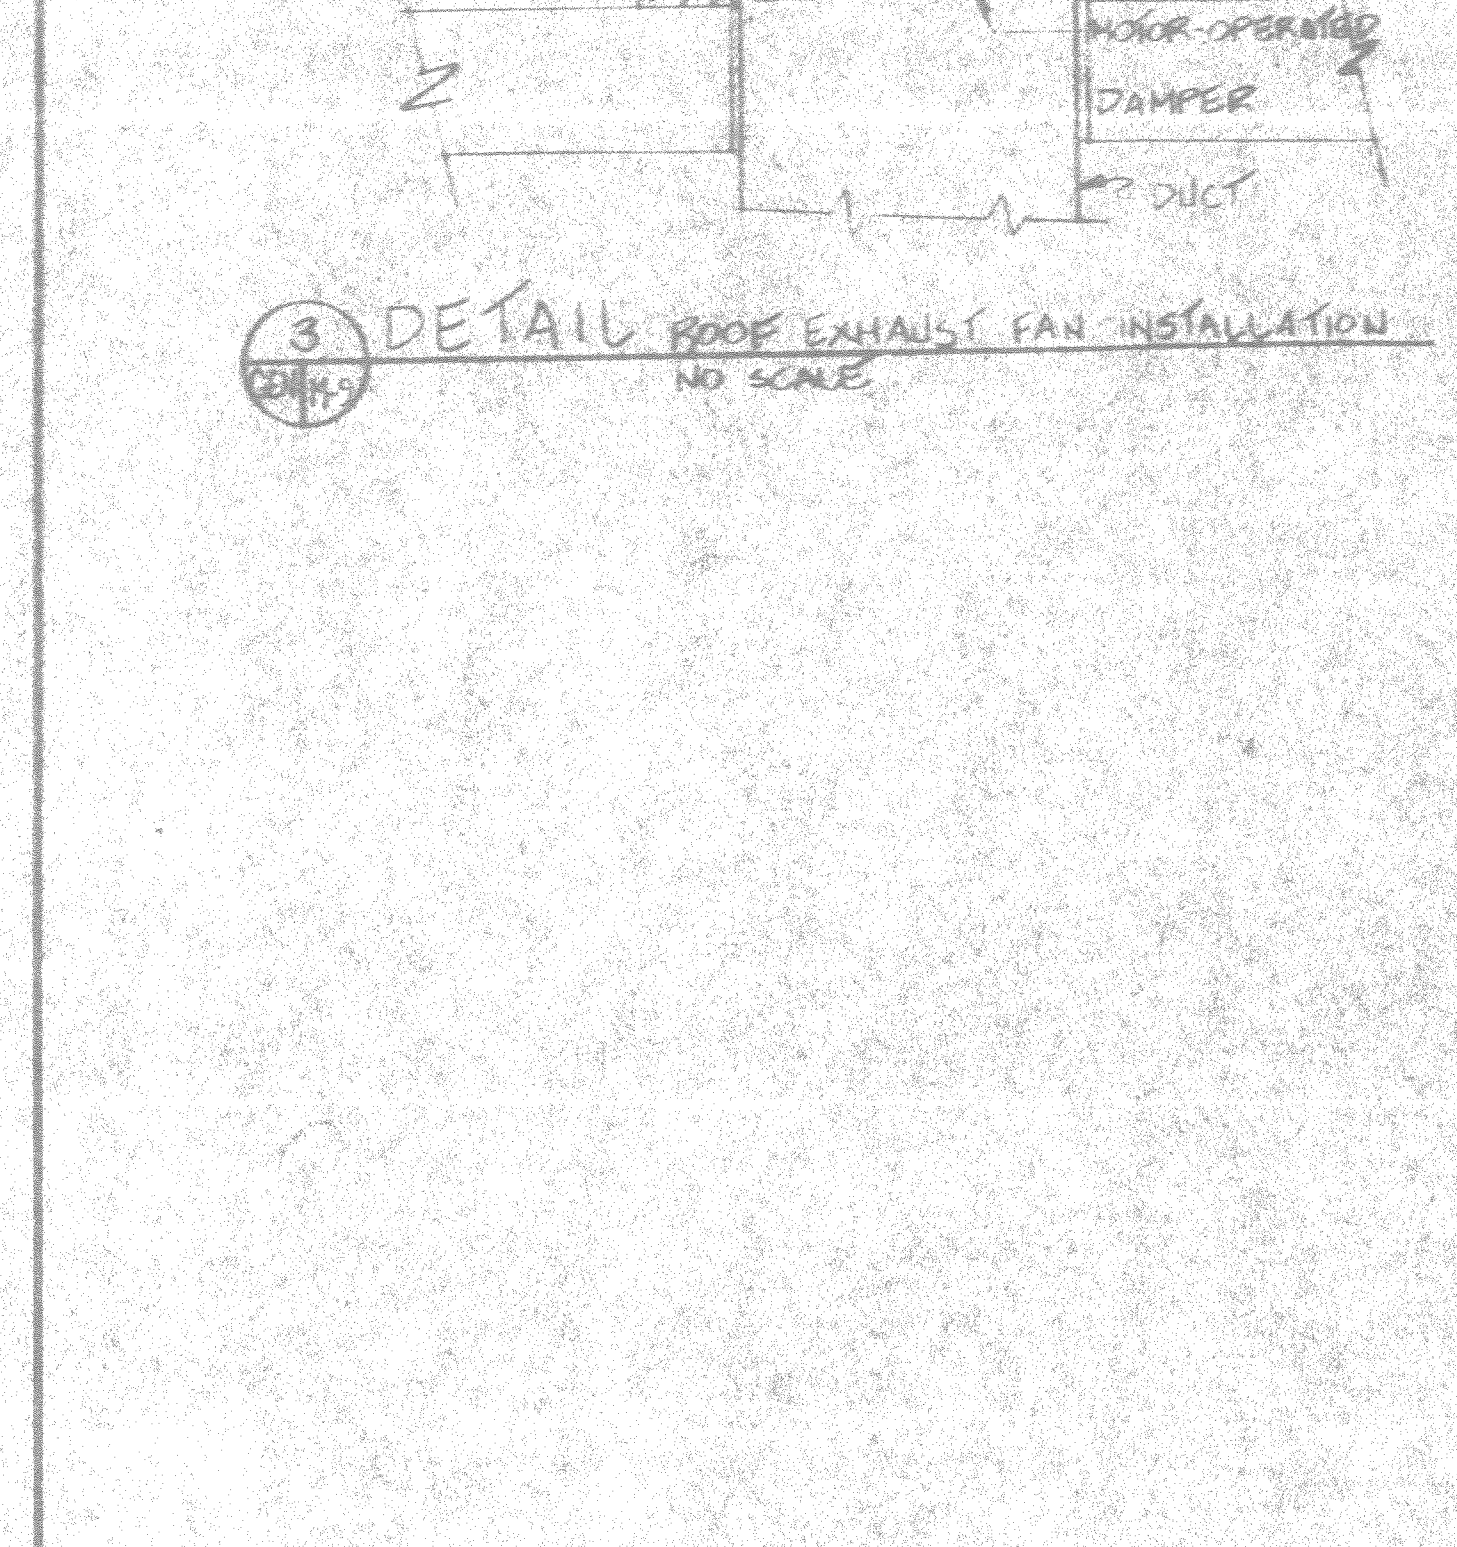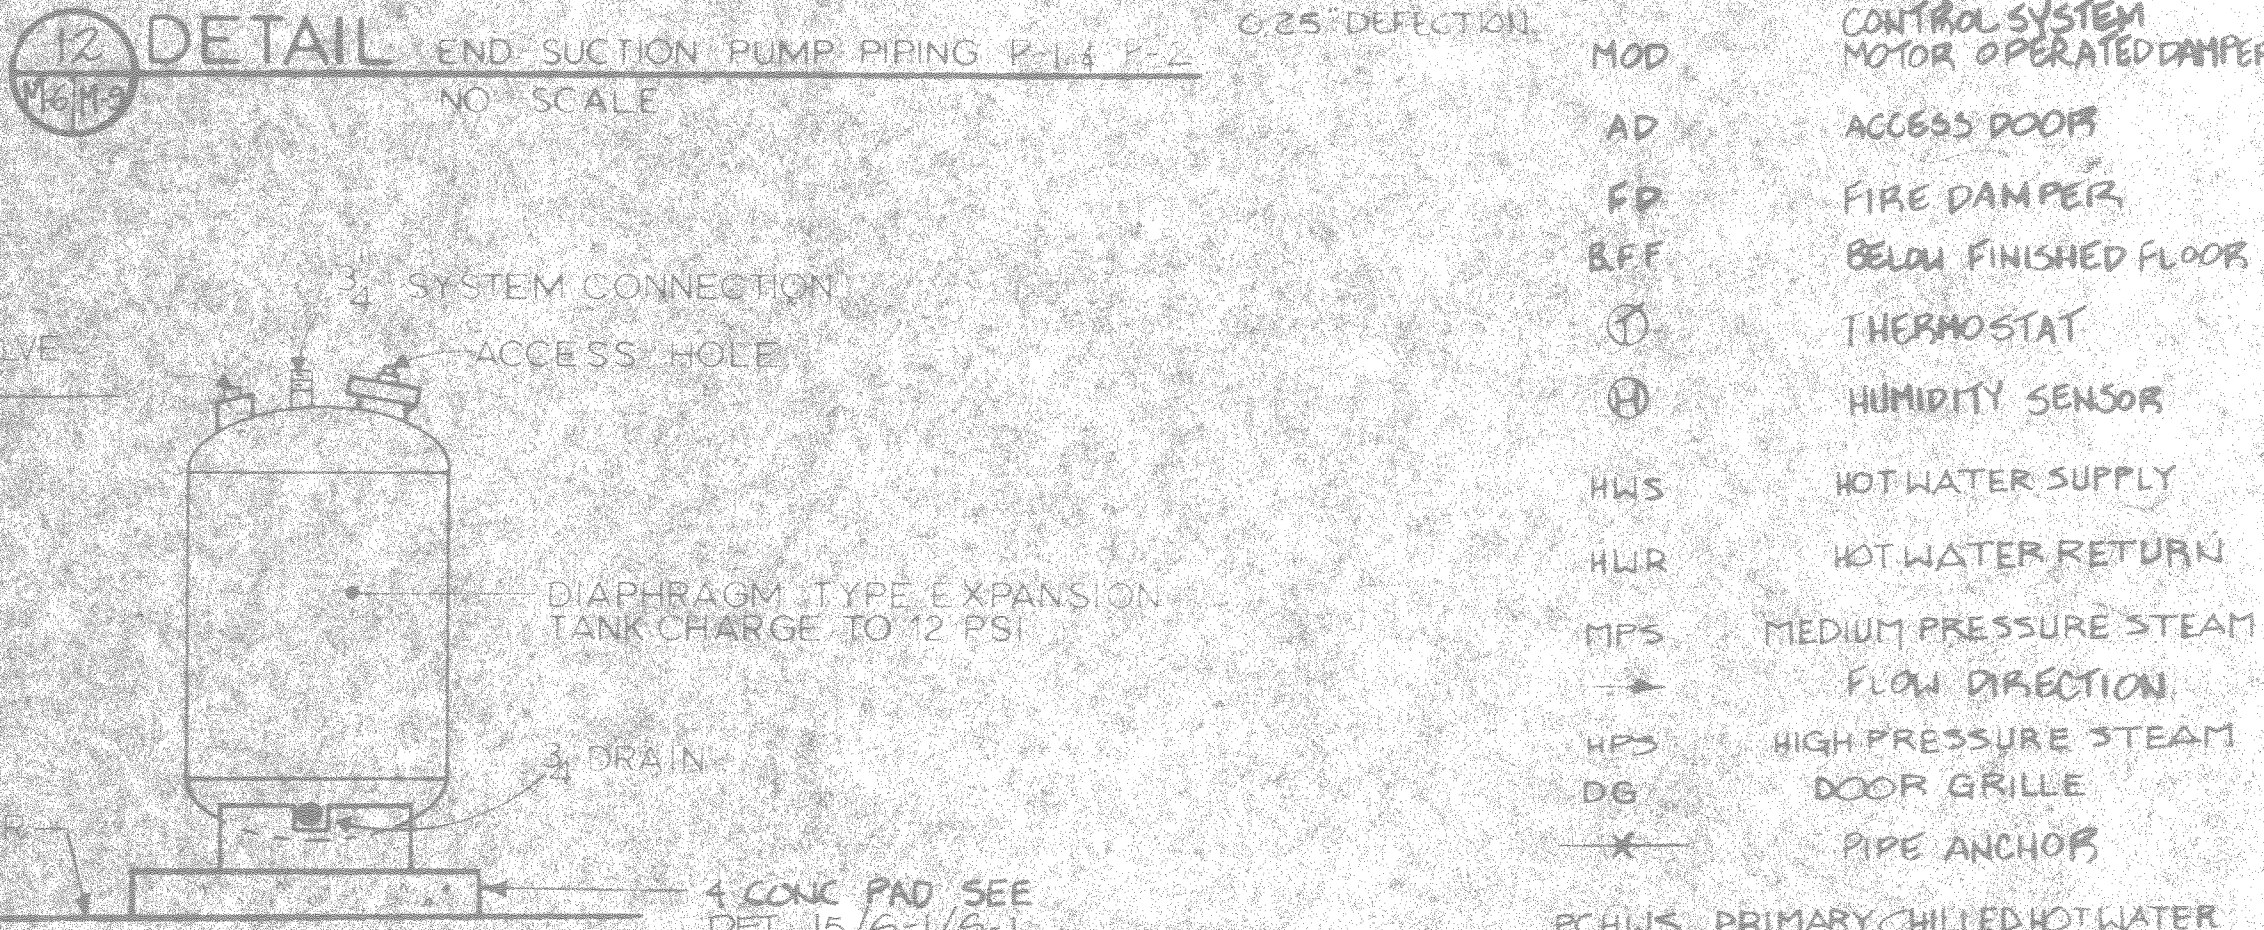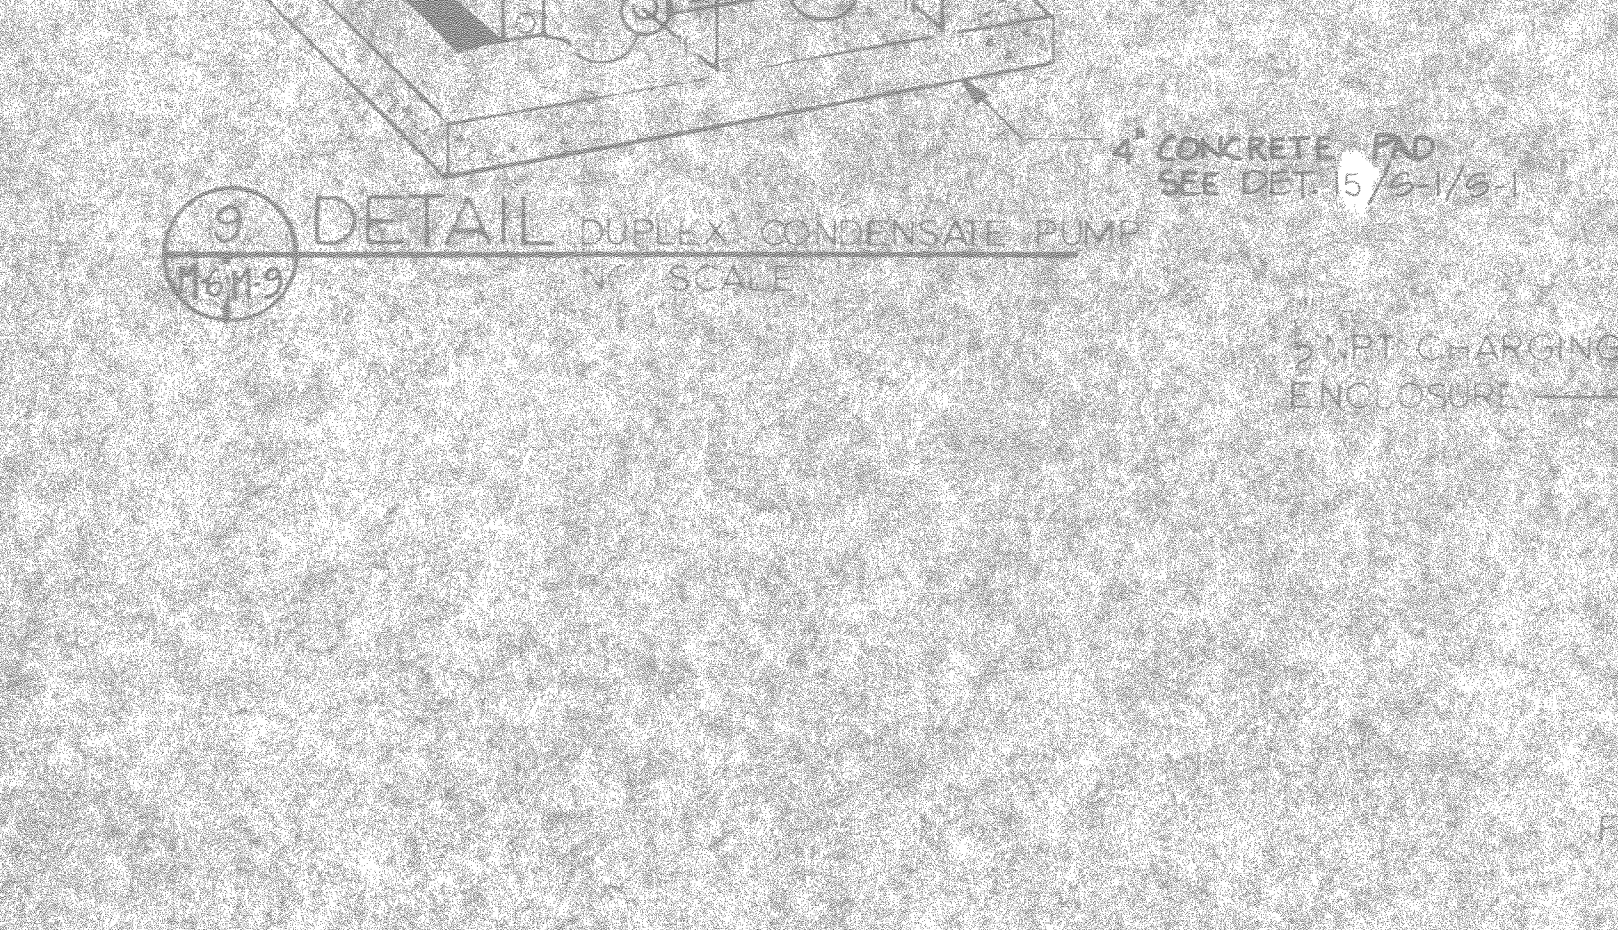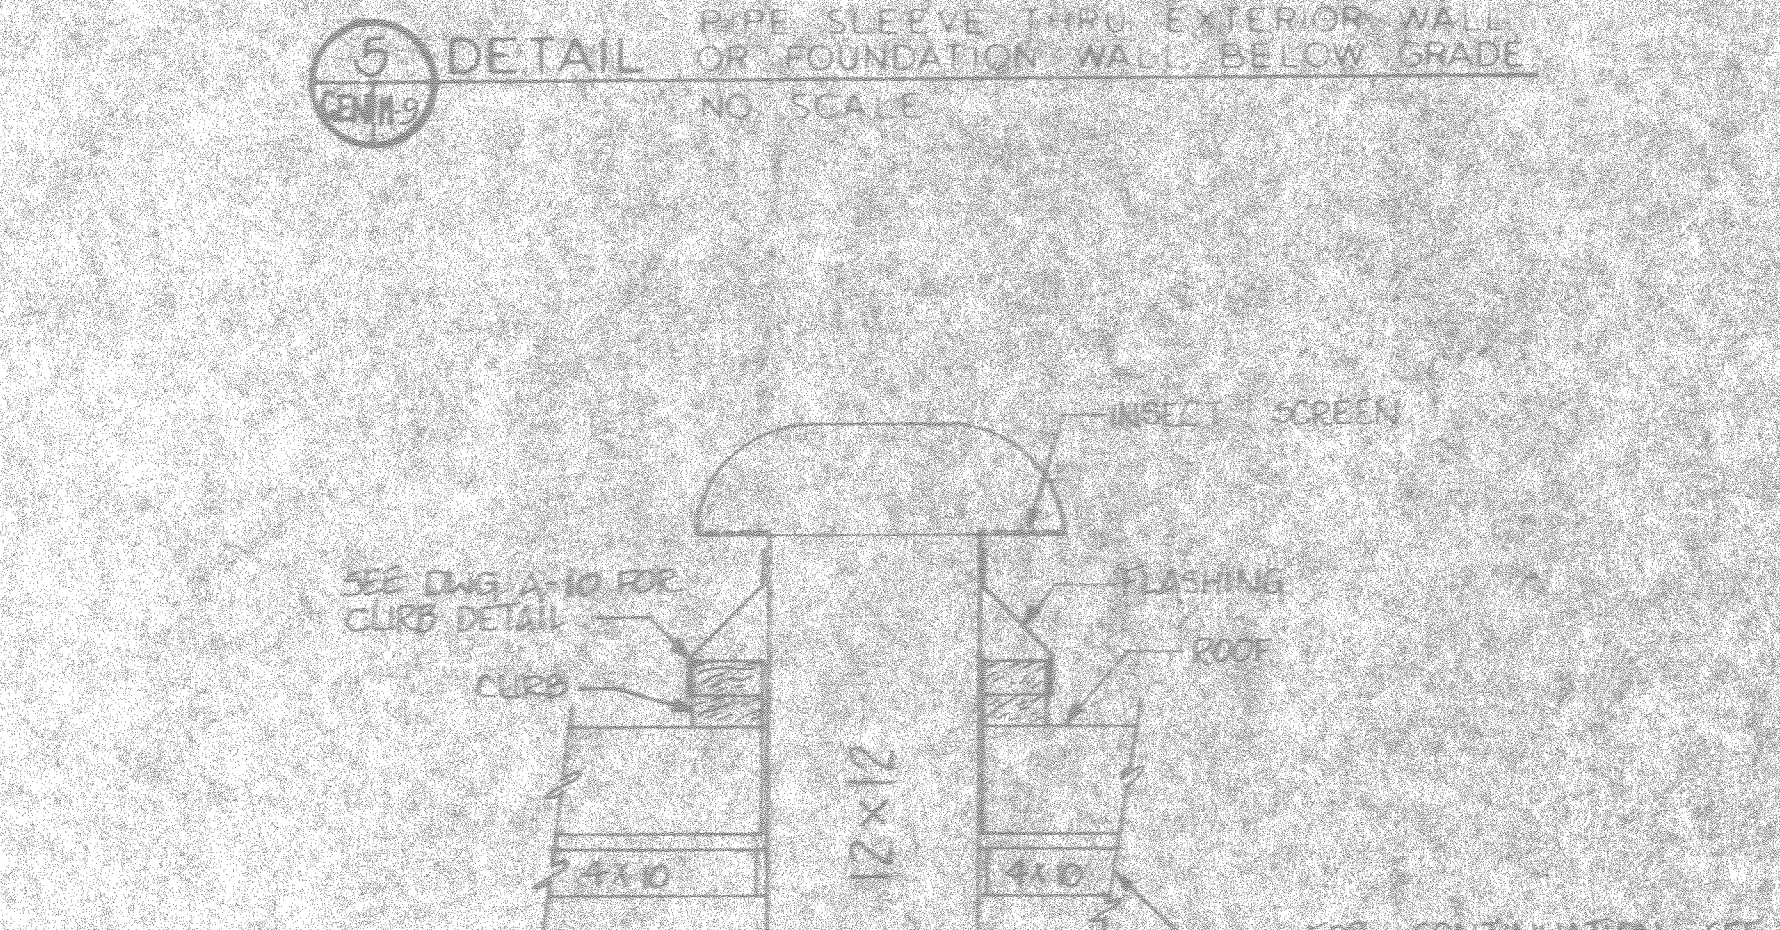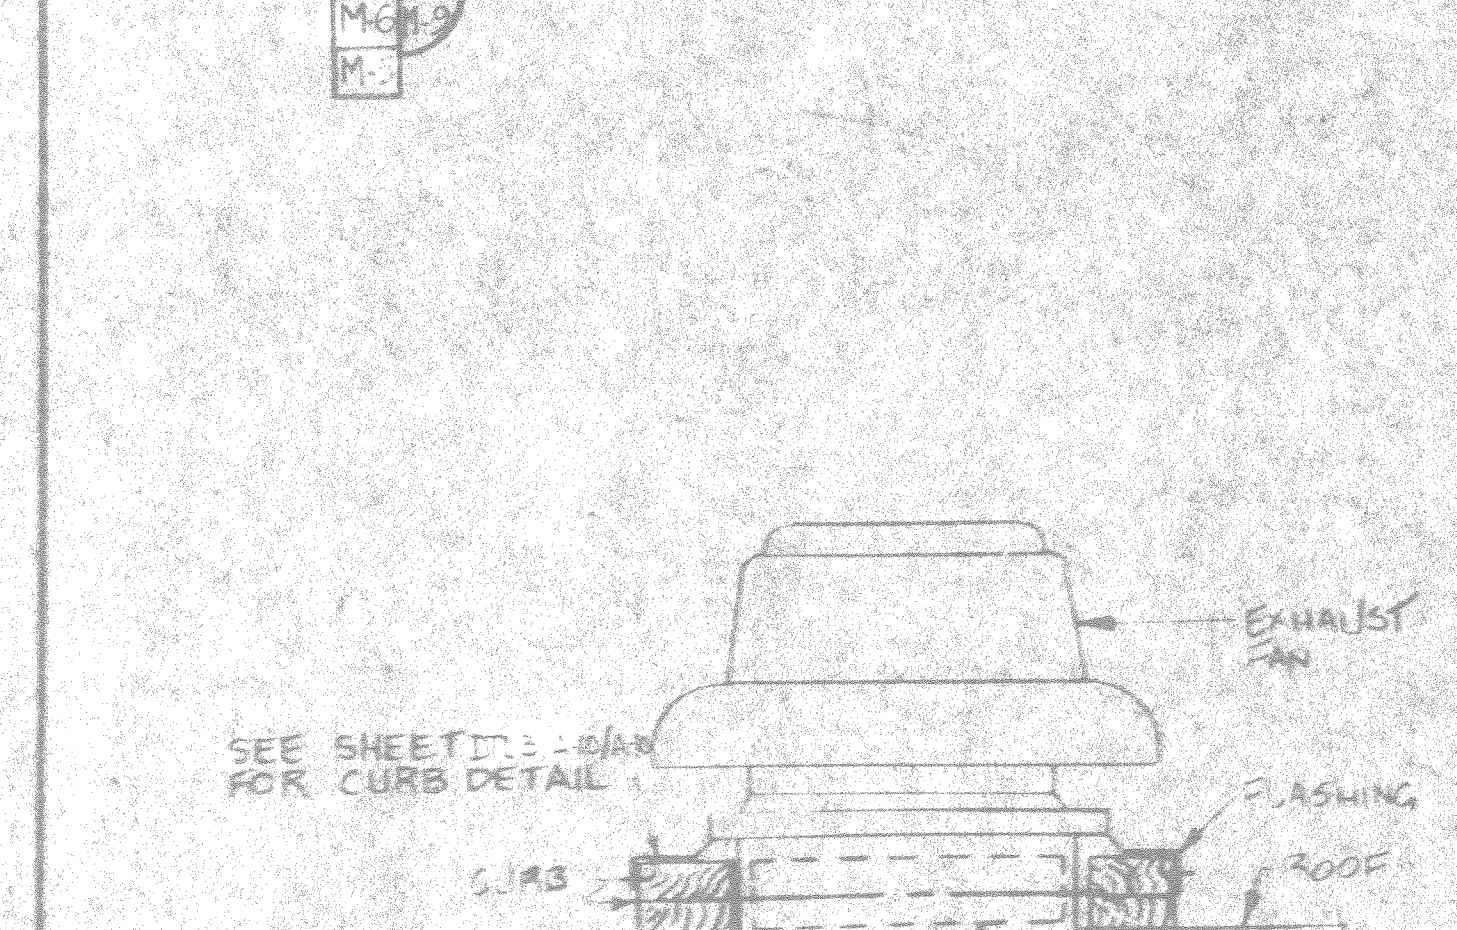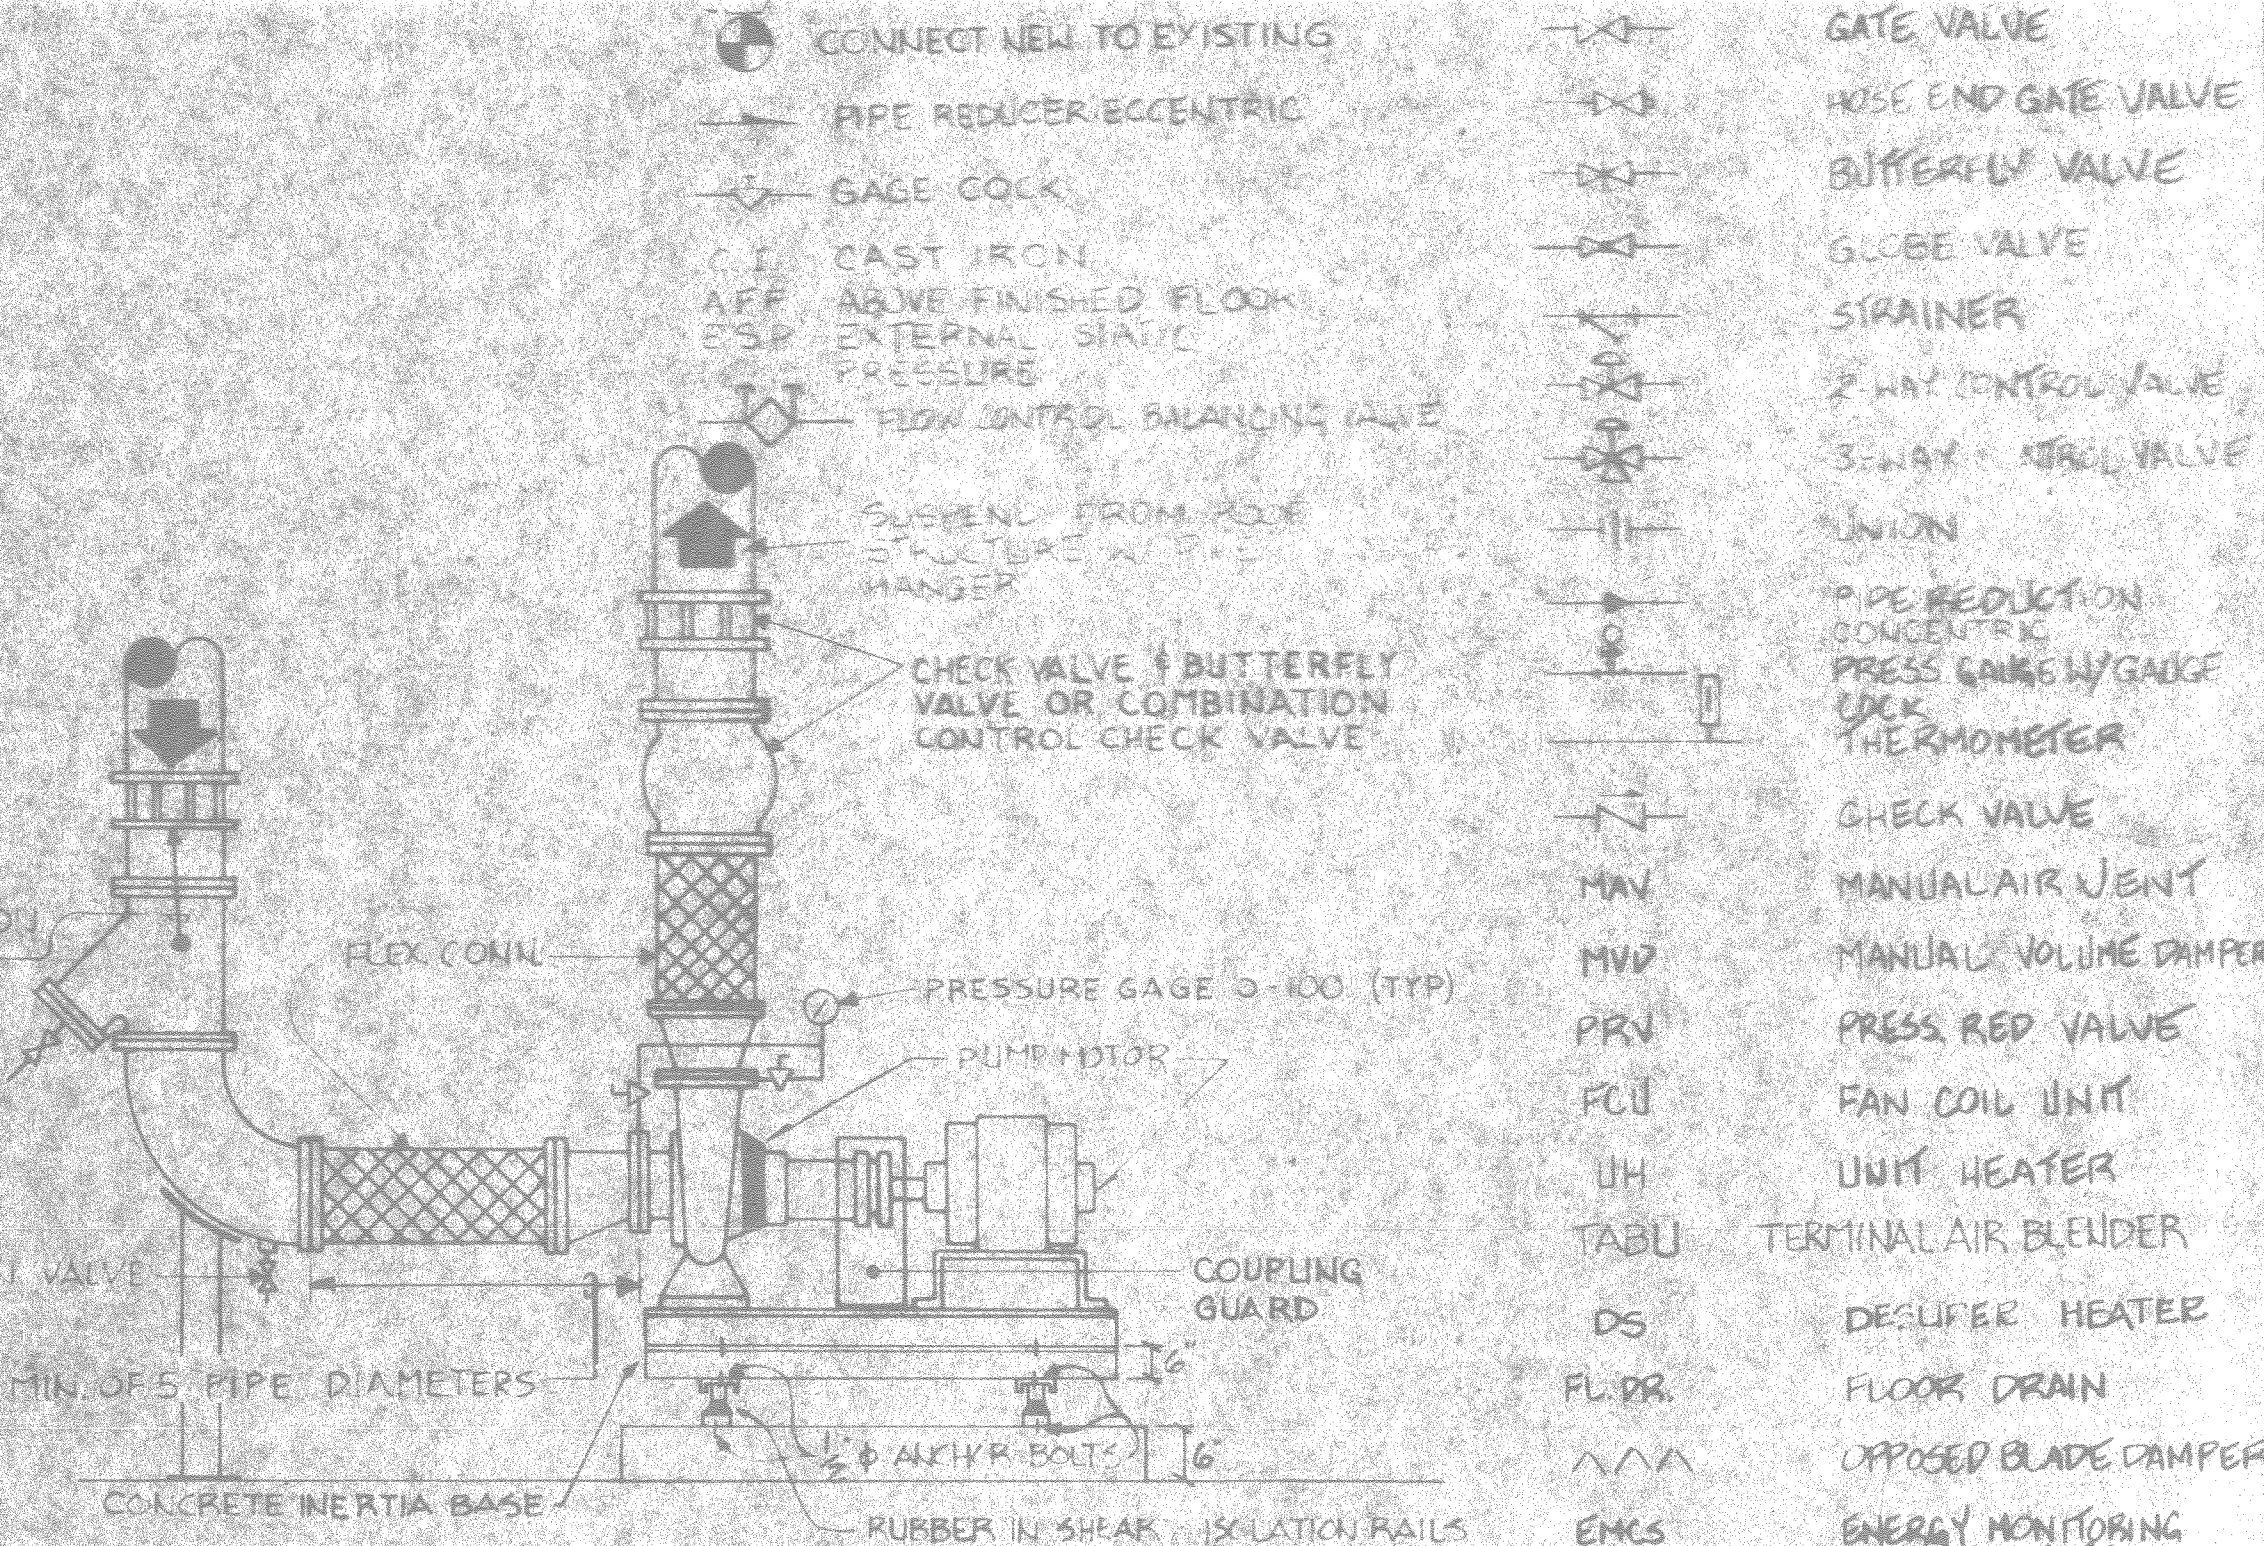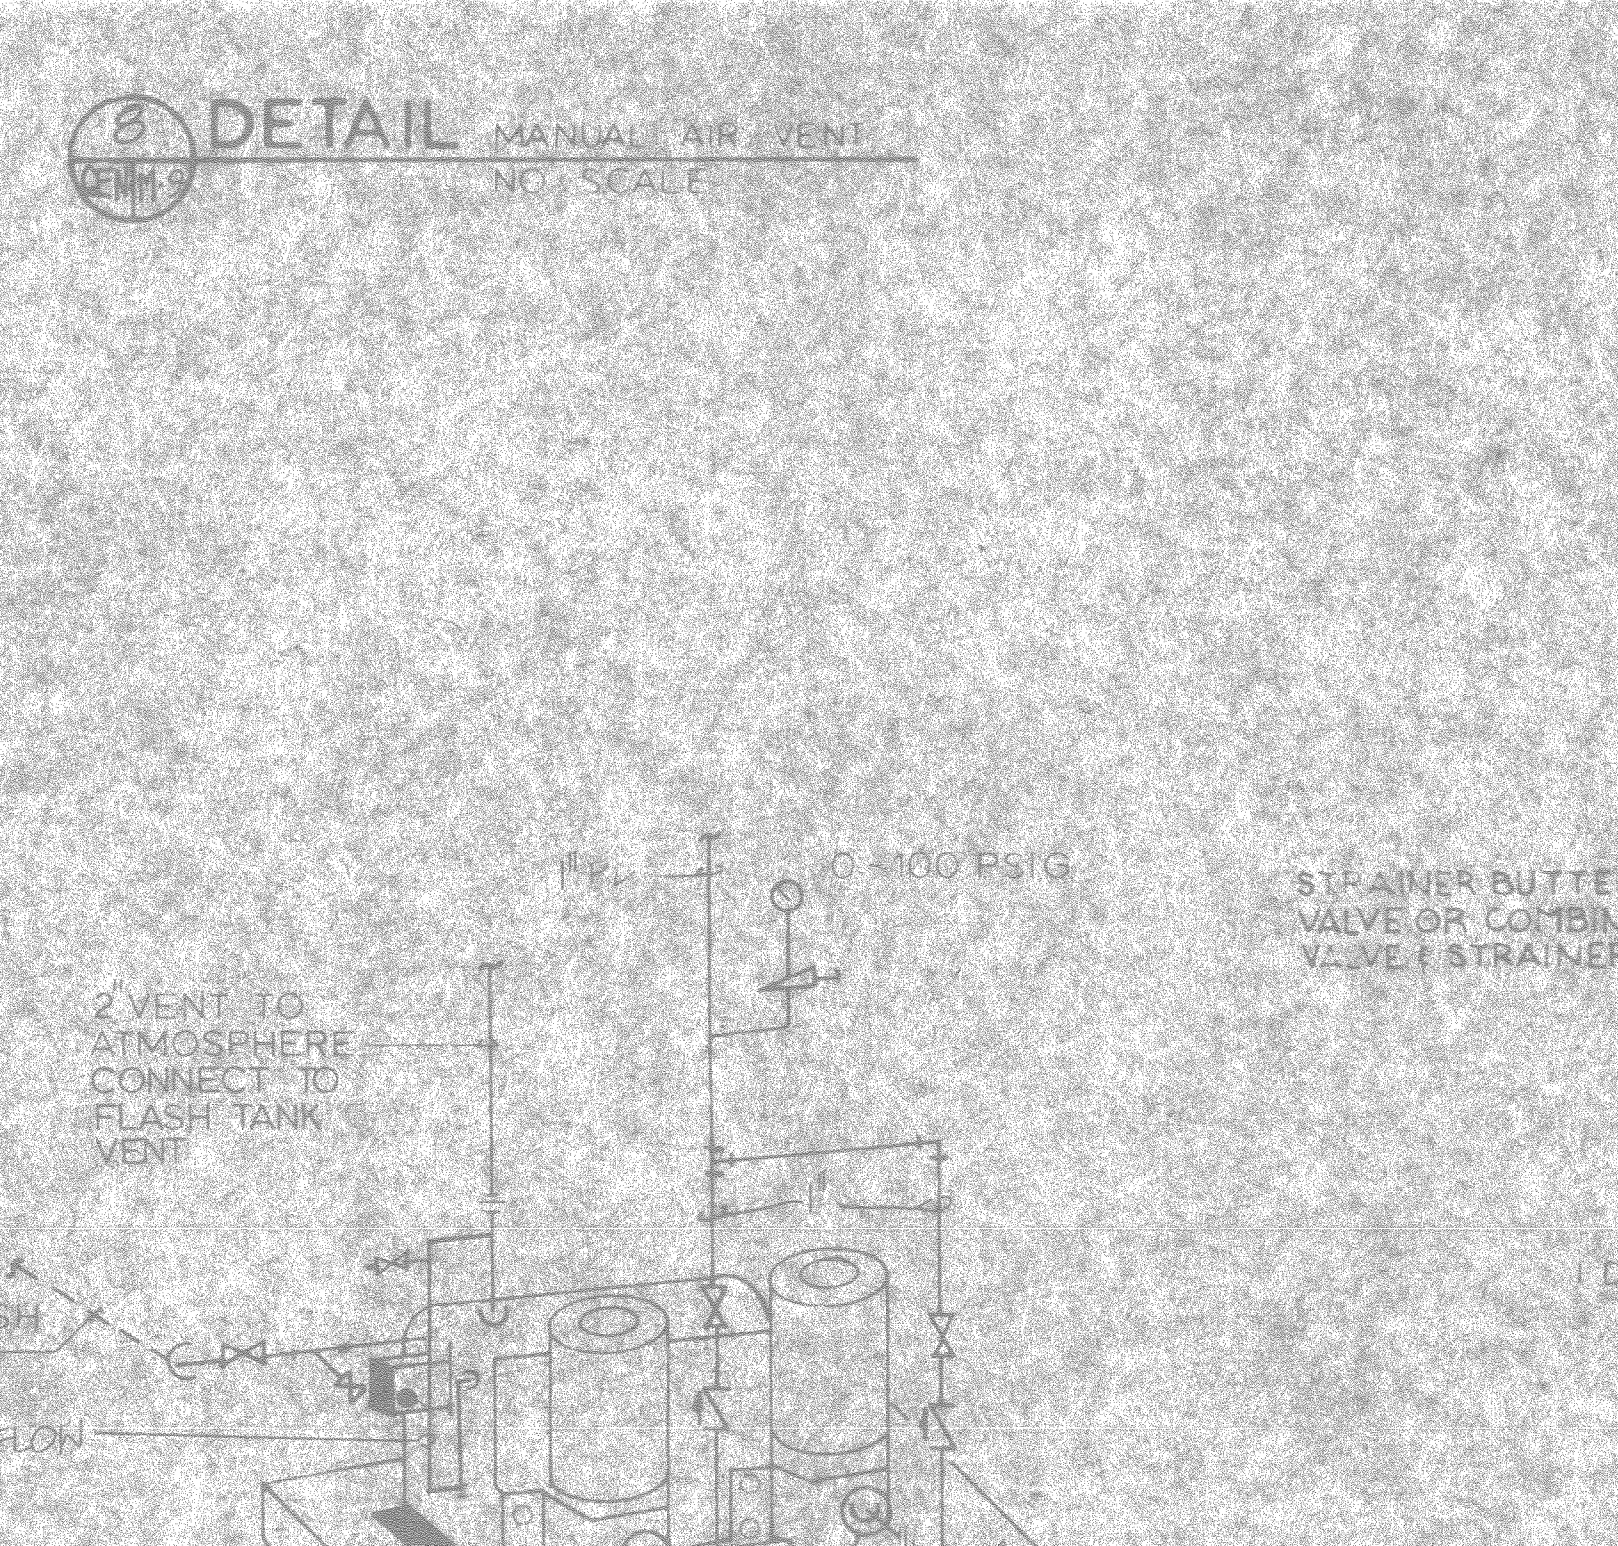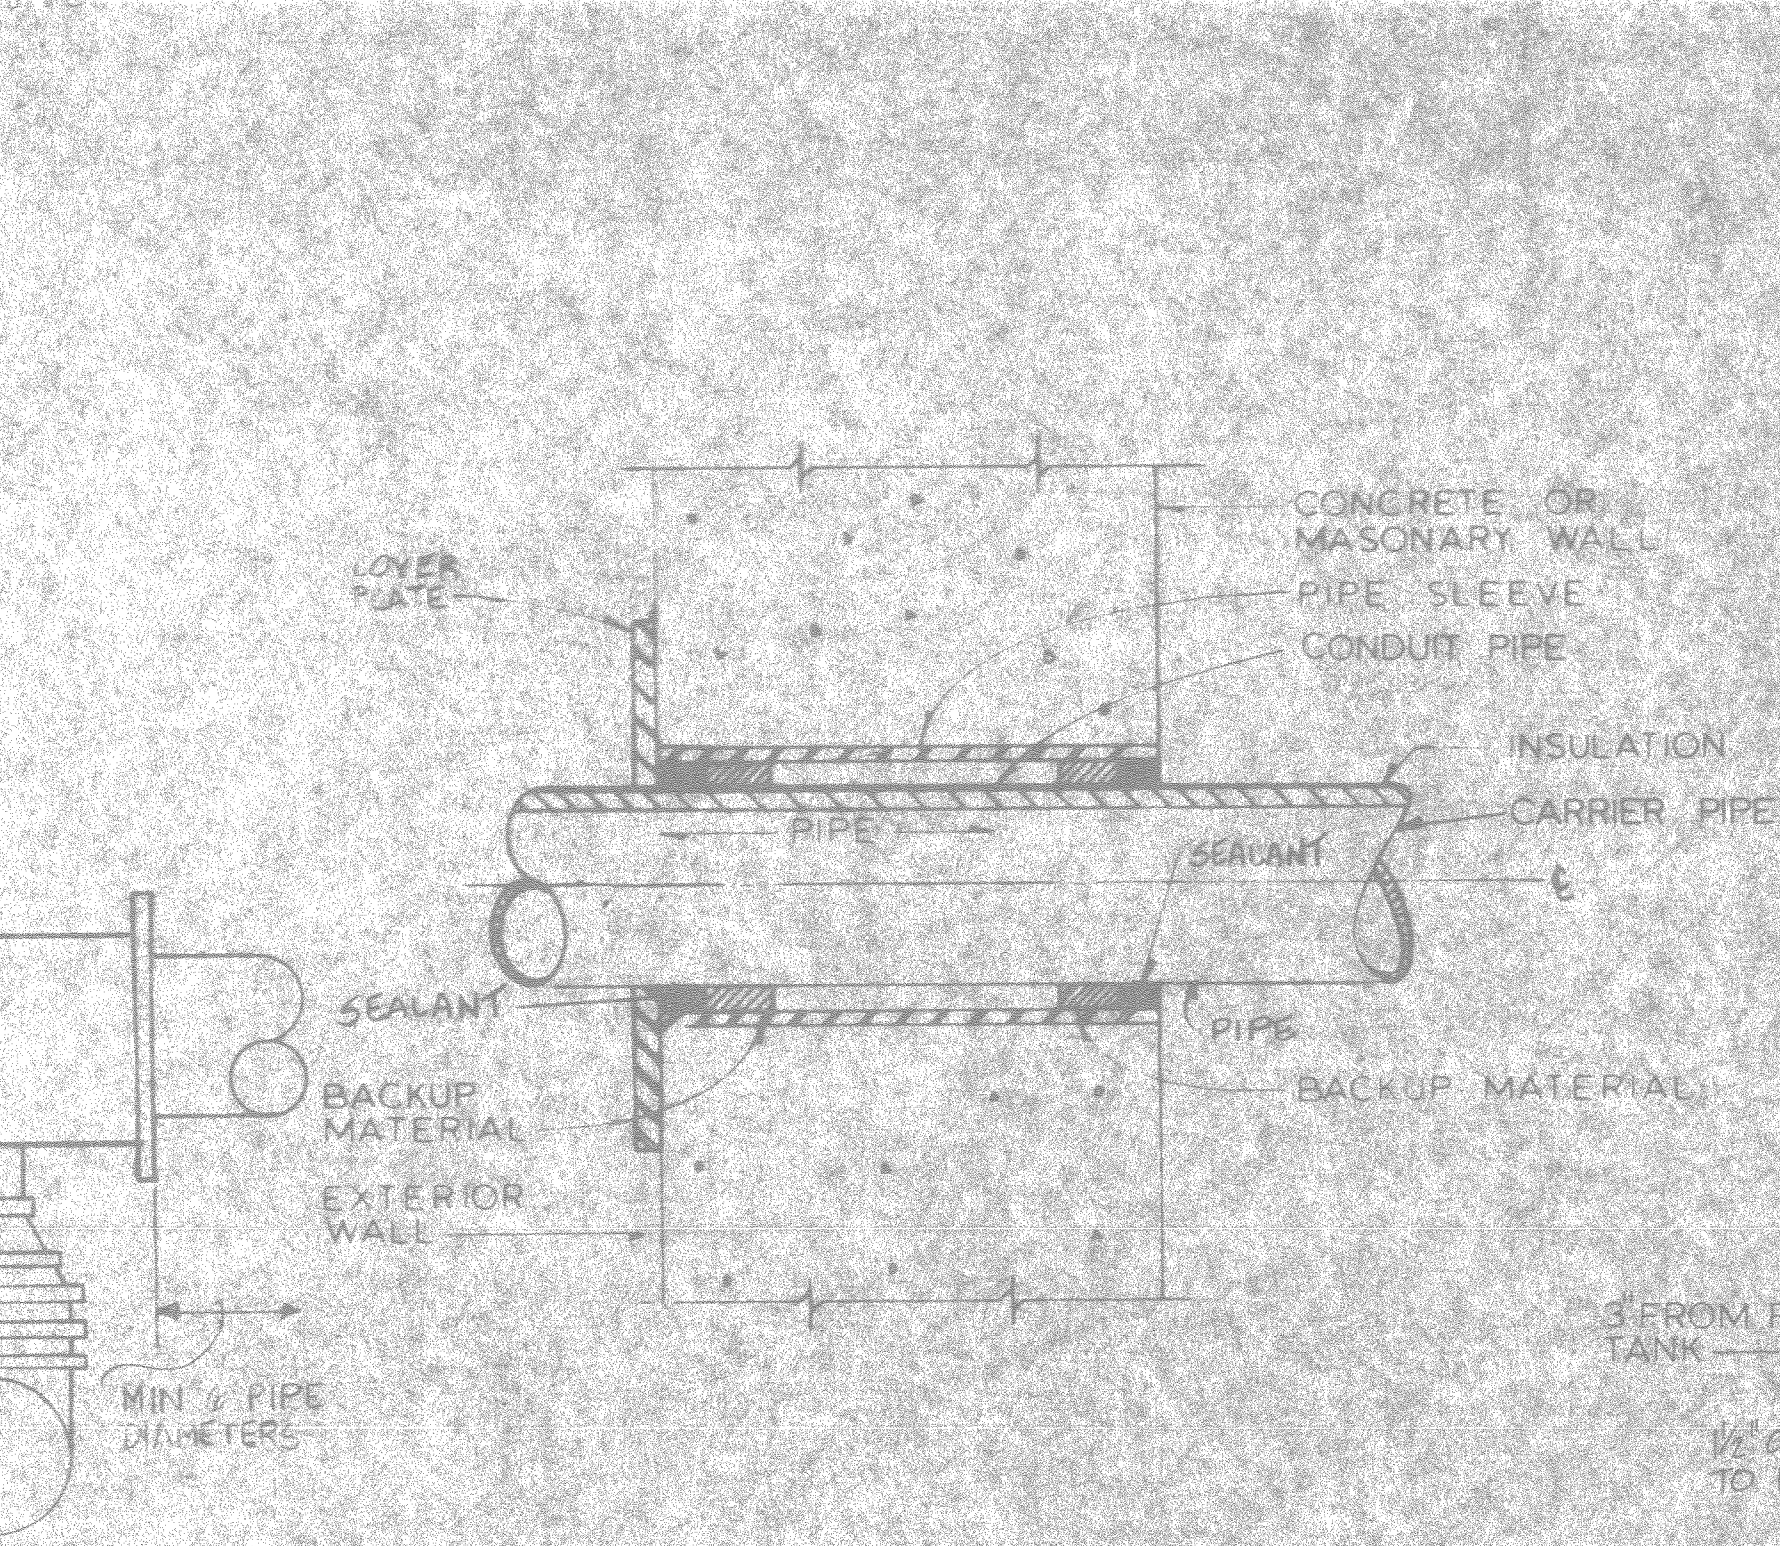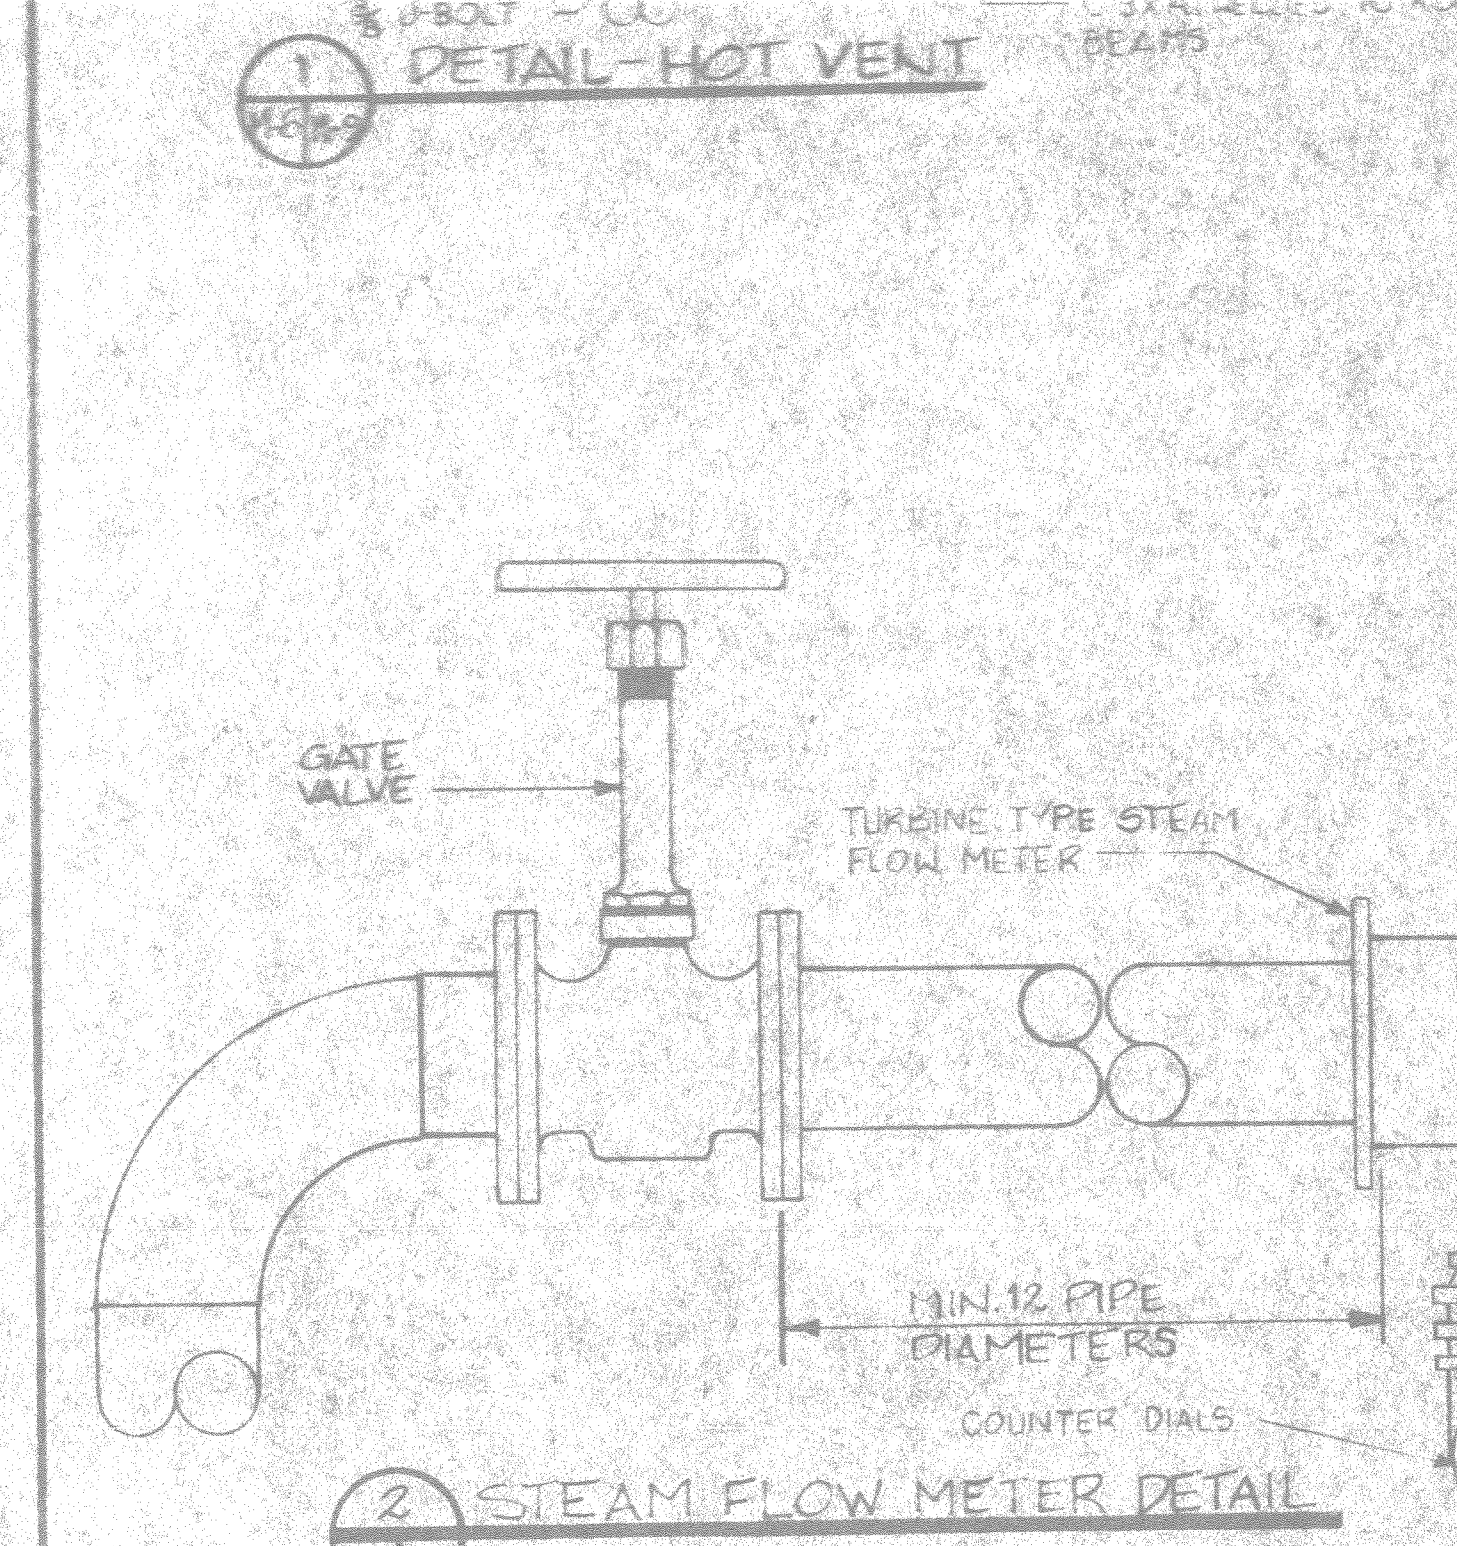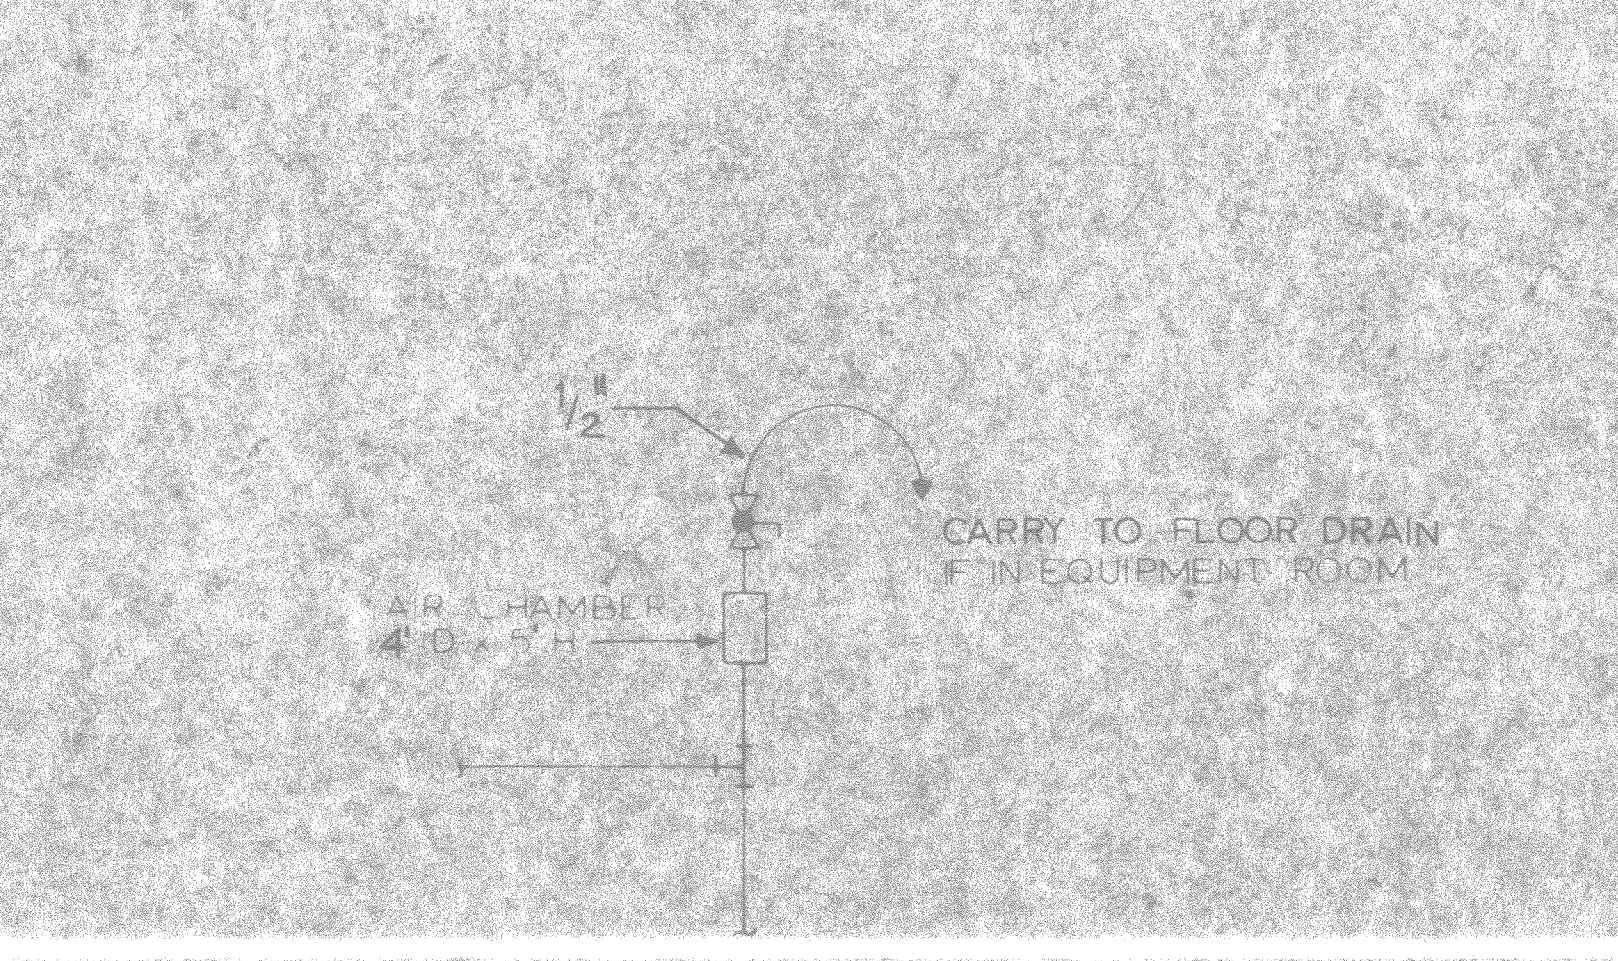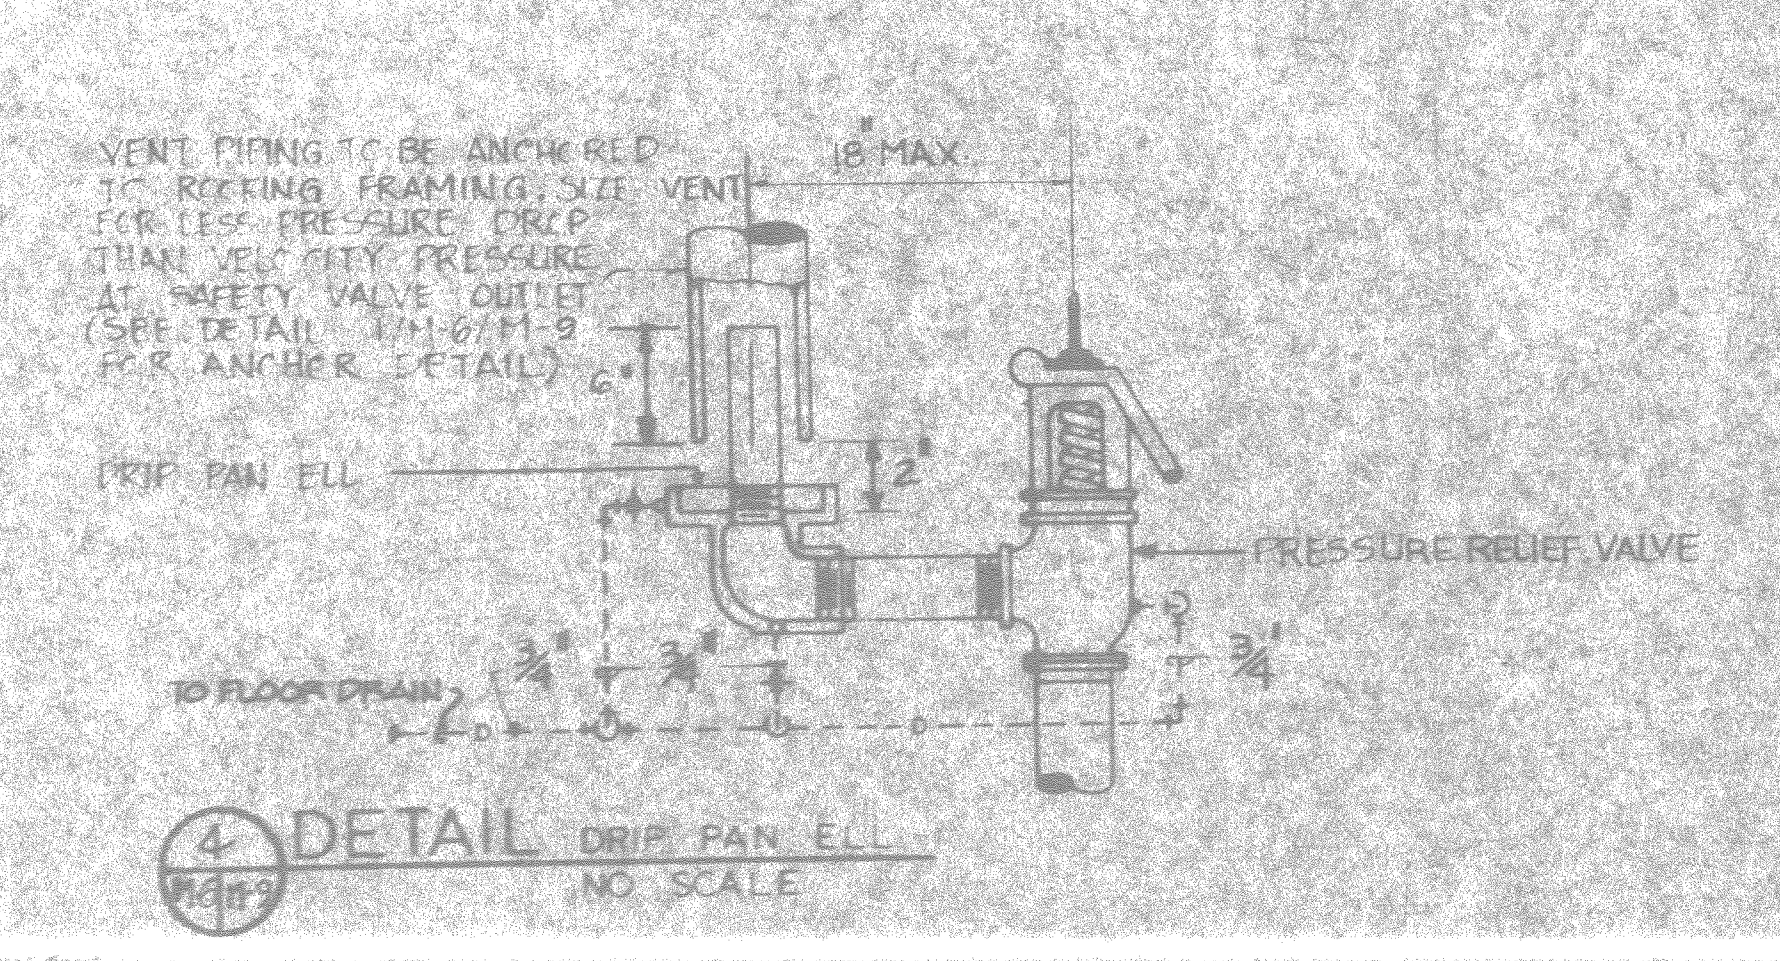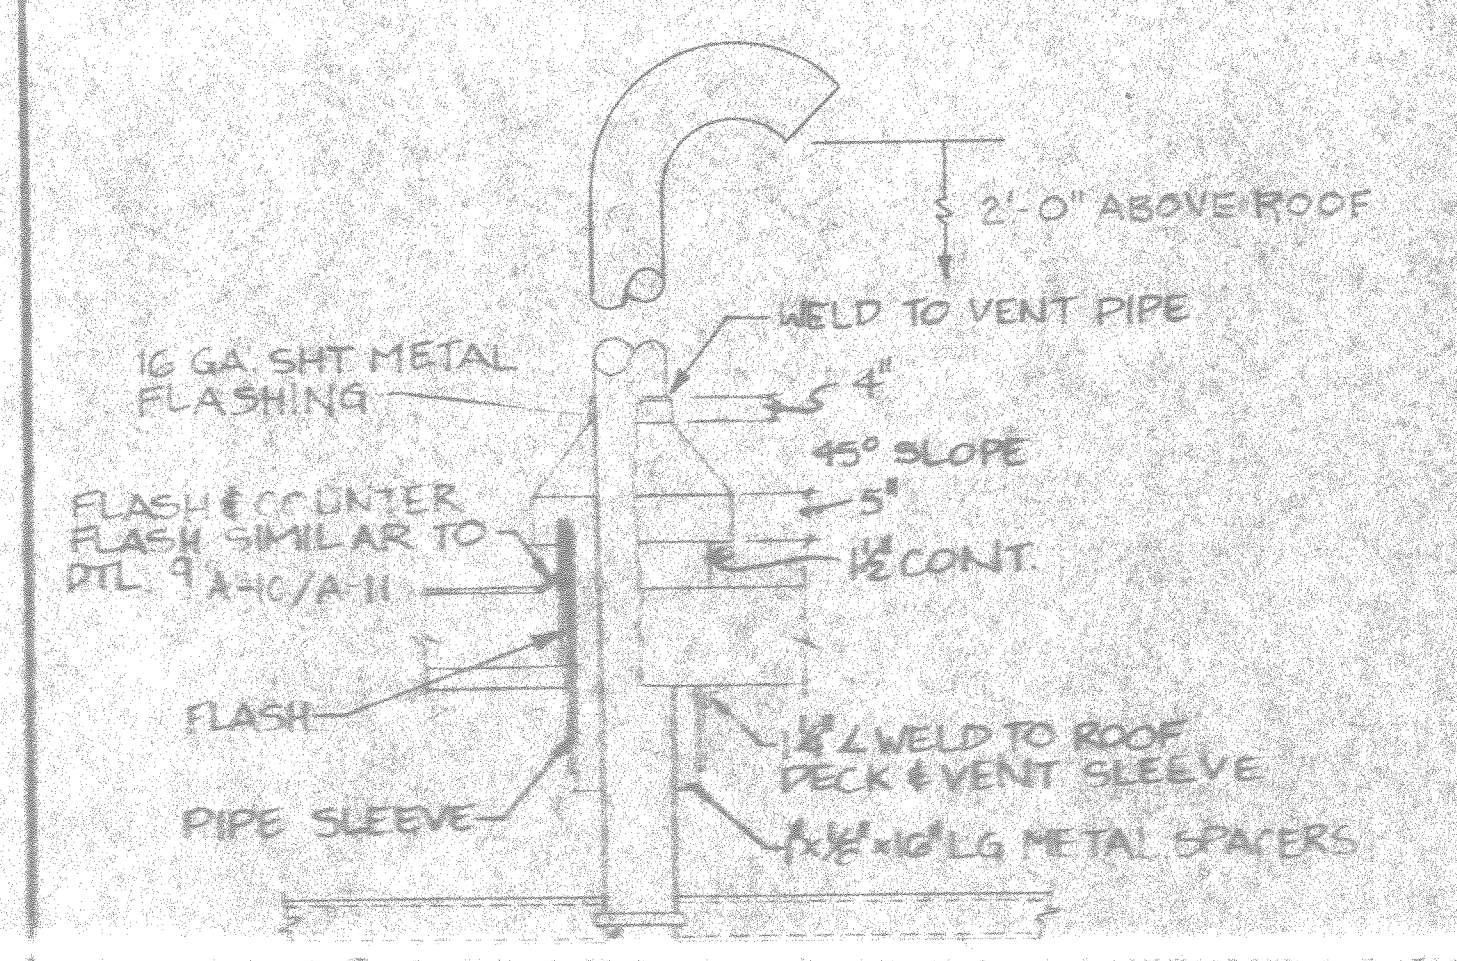

**RECORD DRAWING**  
**LETTER DATED** 14 FEB 1991  
**M - 9**

IN PEASE ASSOCIATES  
 ARCHITECTS ENGINEERS PLANNERS  
 CHARLOTTE NORTH CAROLINA  
 10-12-97

DEPARTMENT OF THE ARMY  
 MARINE CORPS BASE CAMP LEJEUNE N.C.  
 BACHELOR ENLISTED QUARTERS

ATLANTIC DIVISION

HVAC DETAILS


80091  
 4168709  
 05-85-5428









SYN	DESCRIPTION	PREP BY	DATE	APPROVED
①	REVISED AS-BUILT	GB	68	

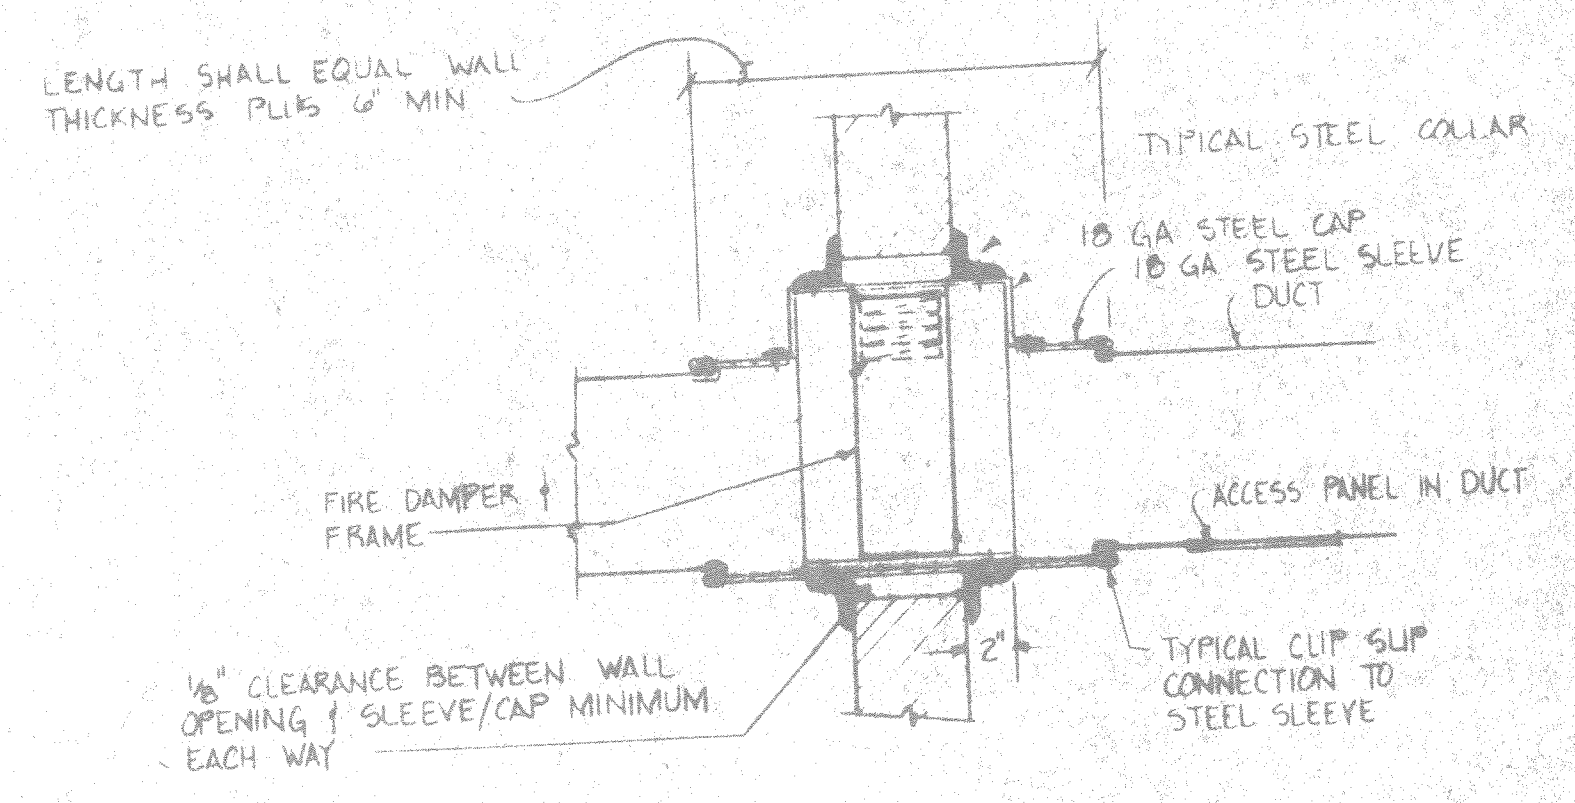


① DETAIL FIRE DAMPER  
NO SCALE

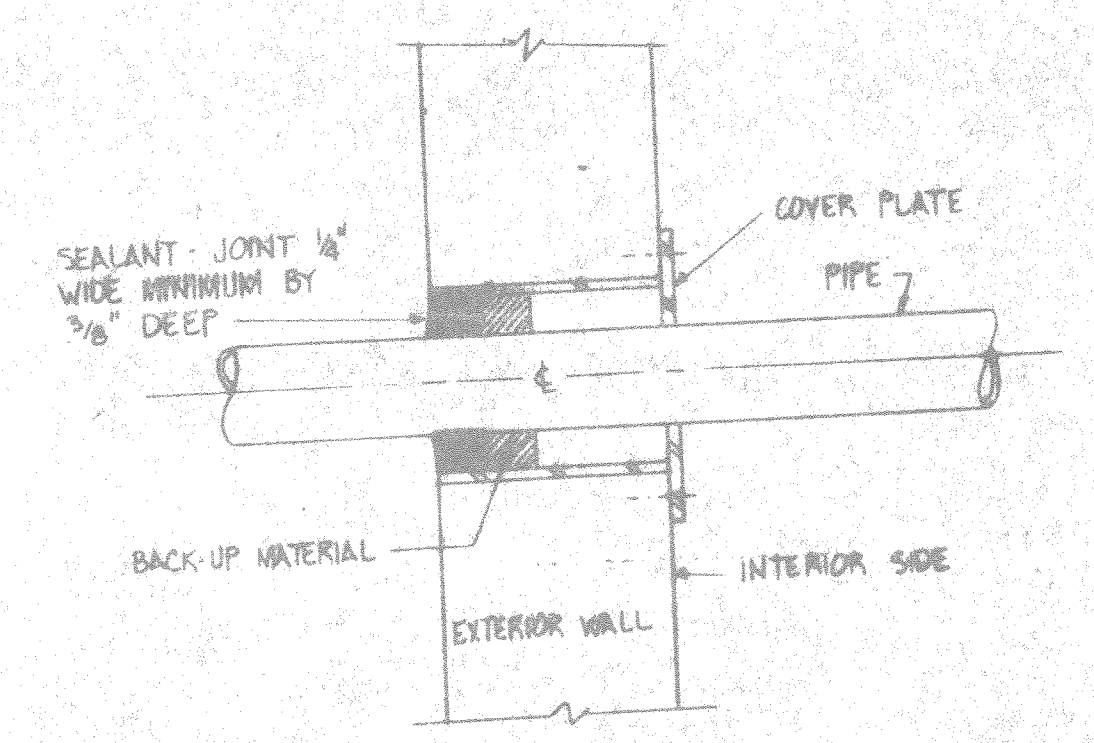


② DETAIL PIPE SLEEVE FOR BARE PIPE THRU WALL - ABOVE GRADE  
NO SCALE

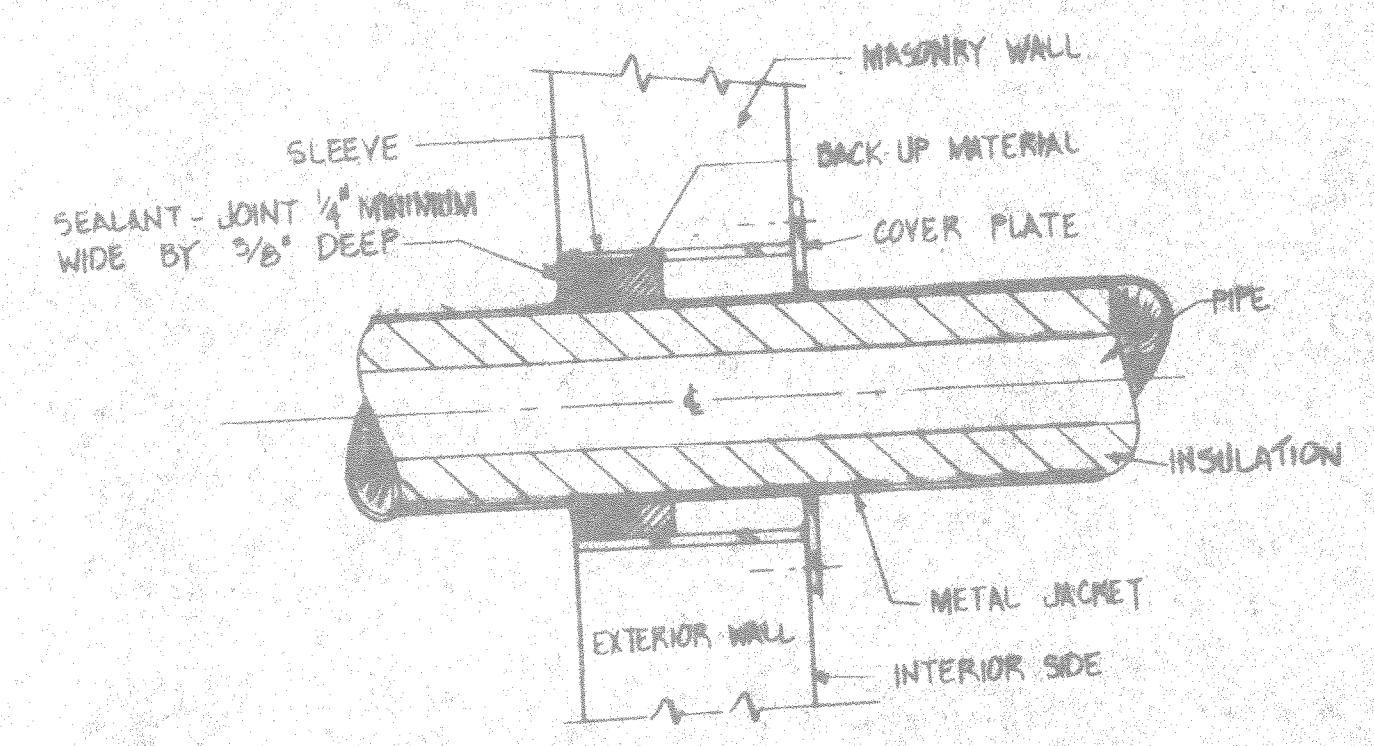


③ DETAIL PIPE SLEEVE FOR INSULATED PIPE THRU WALL - ABOVE GRADE  
NO SCALE

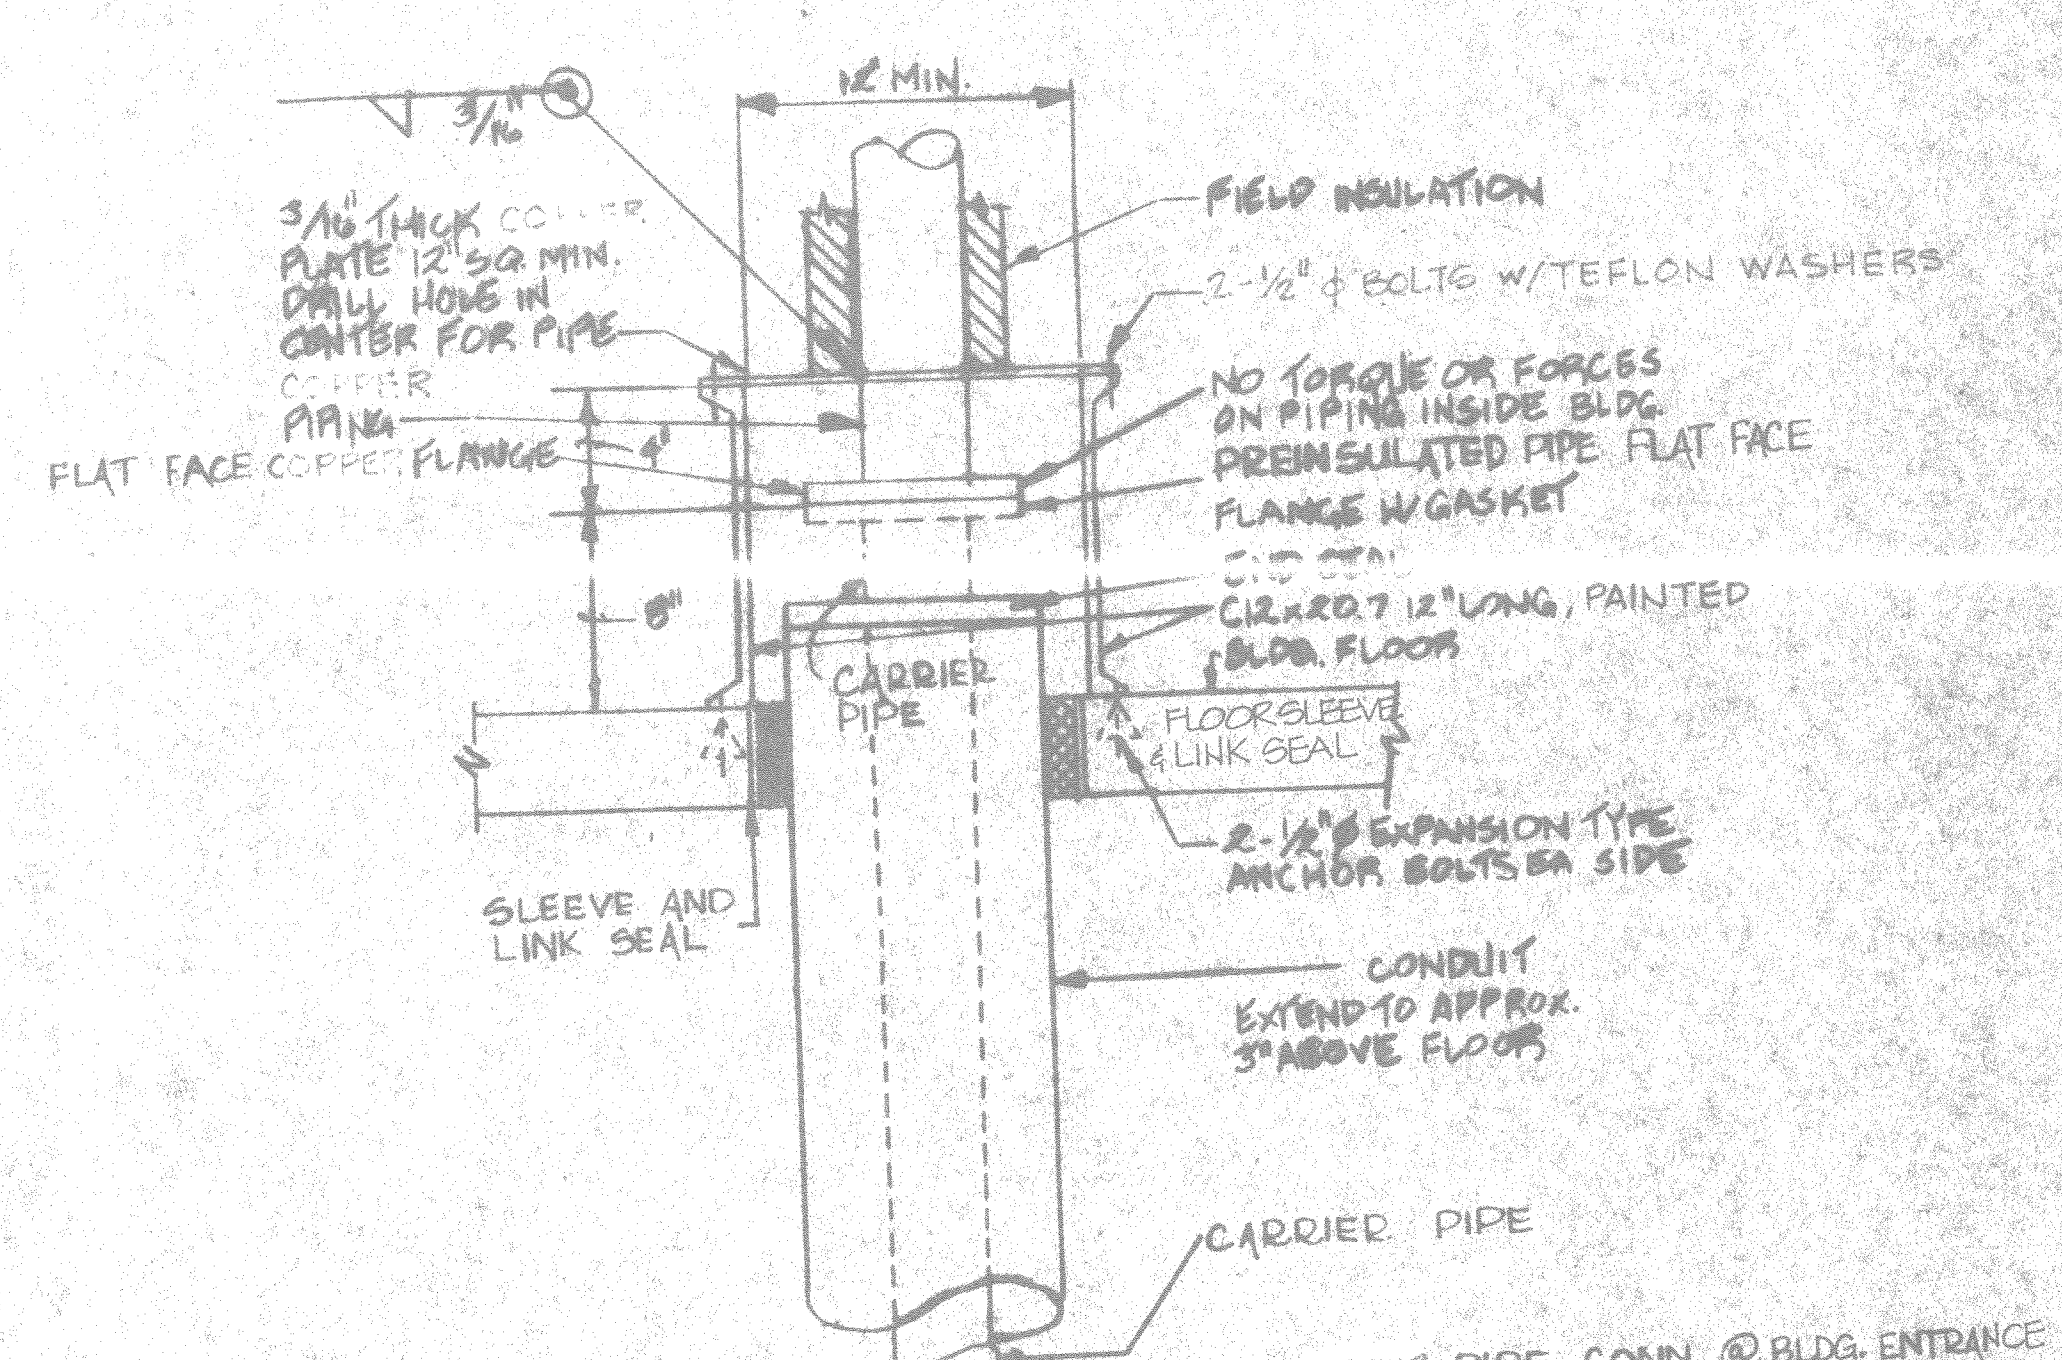


④ DETAIL PREINSULATED PIPE TO COPPER PIPE CONN. @ BLDG. ENTRANCE  
NO SCALE

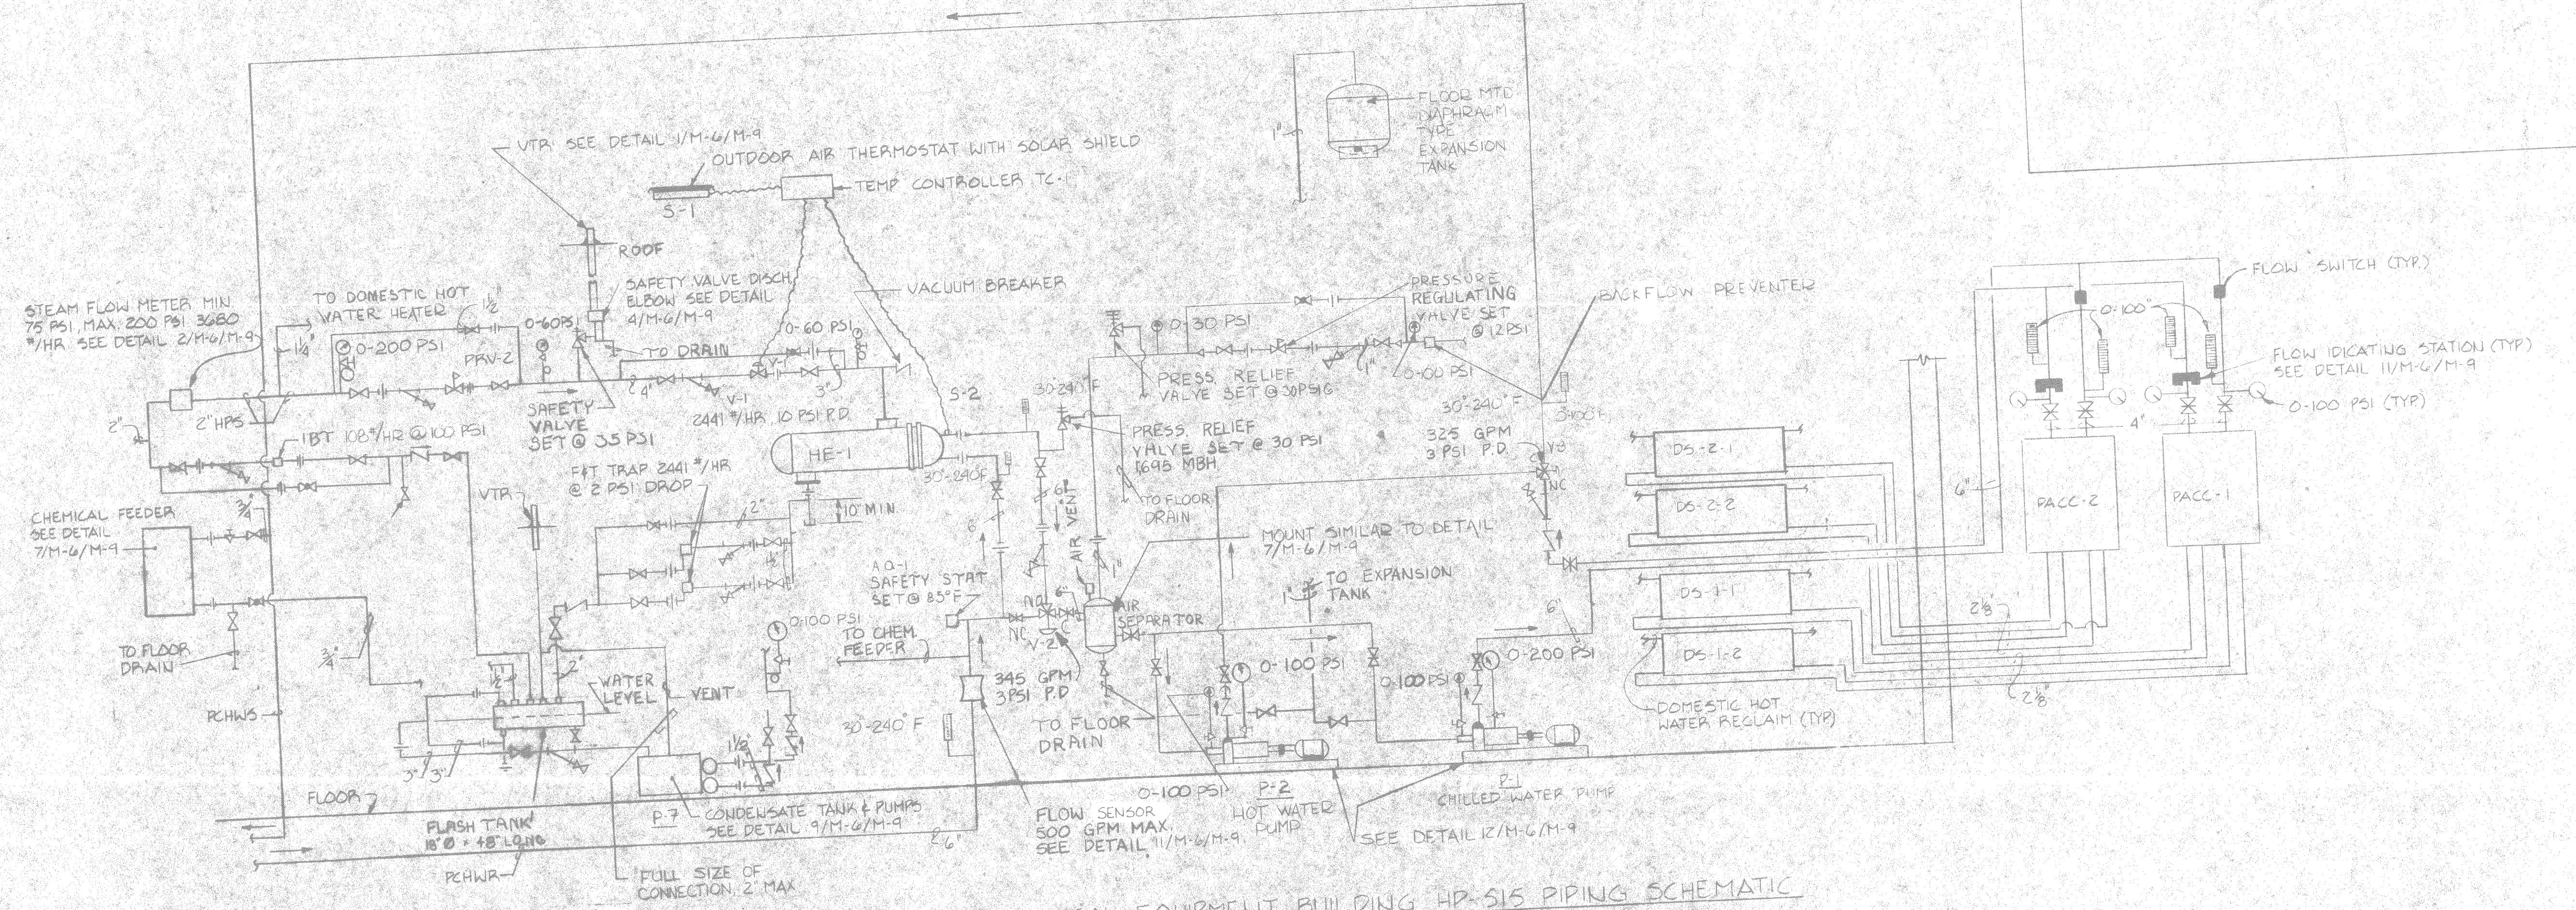



MECHANICAL EQUIPMENT BUILDING HP-515 PIPING SCHEMATIC  
NO SCALE

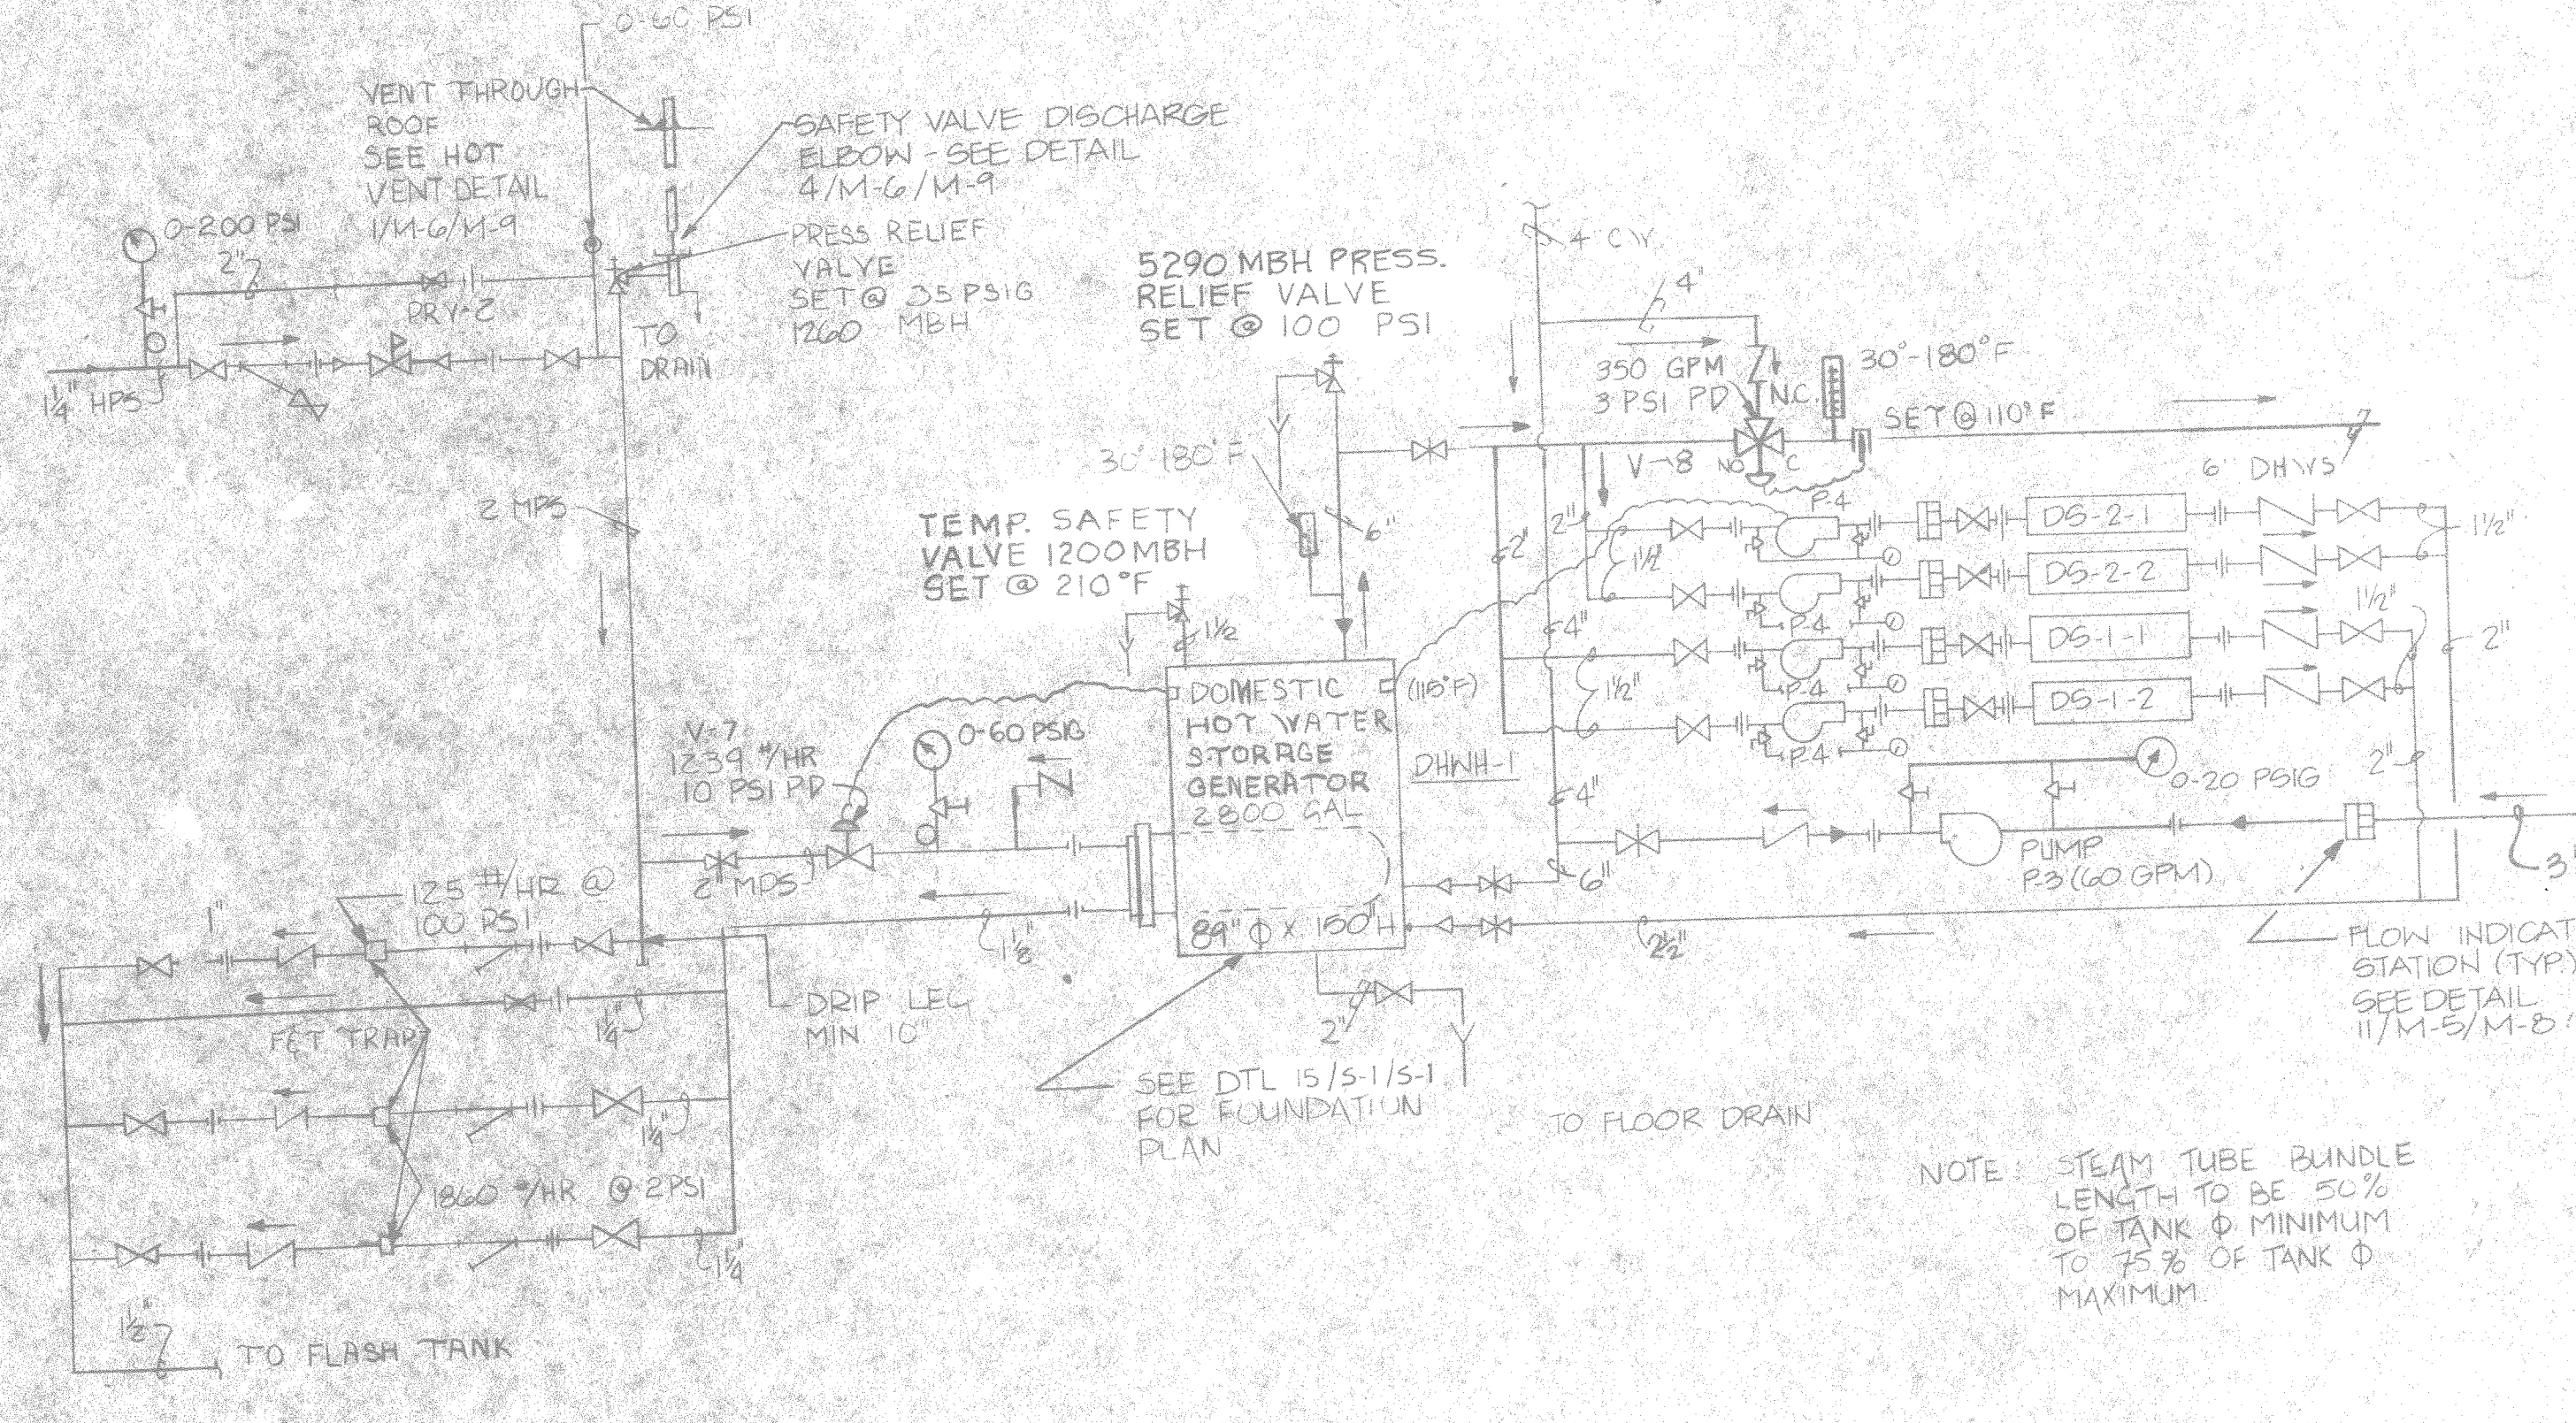

DOMESTIC HOT WATER STORAGE HEATER SCHEMATIC PIPING  
NO SCALE

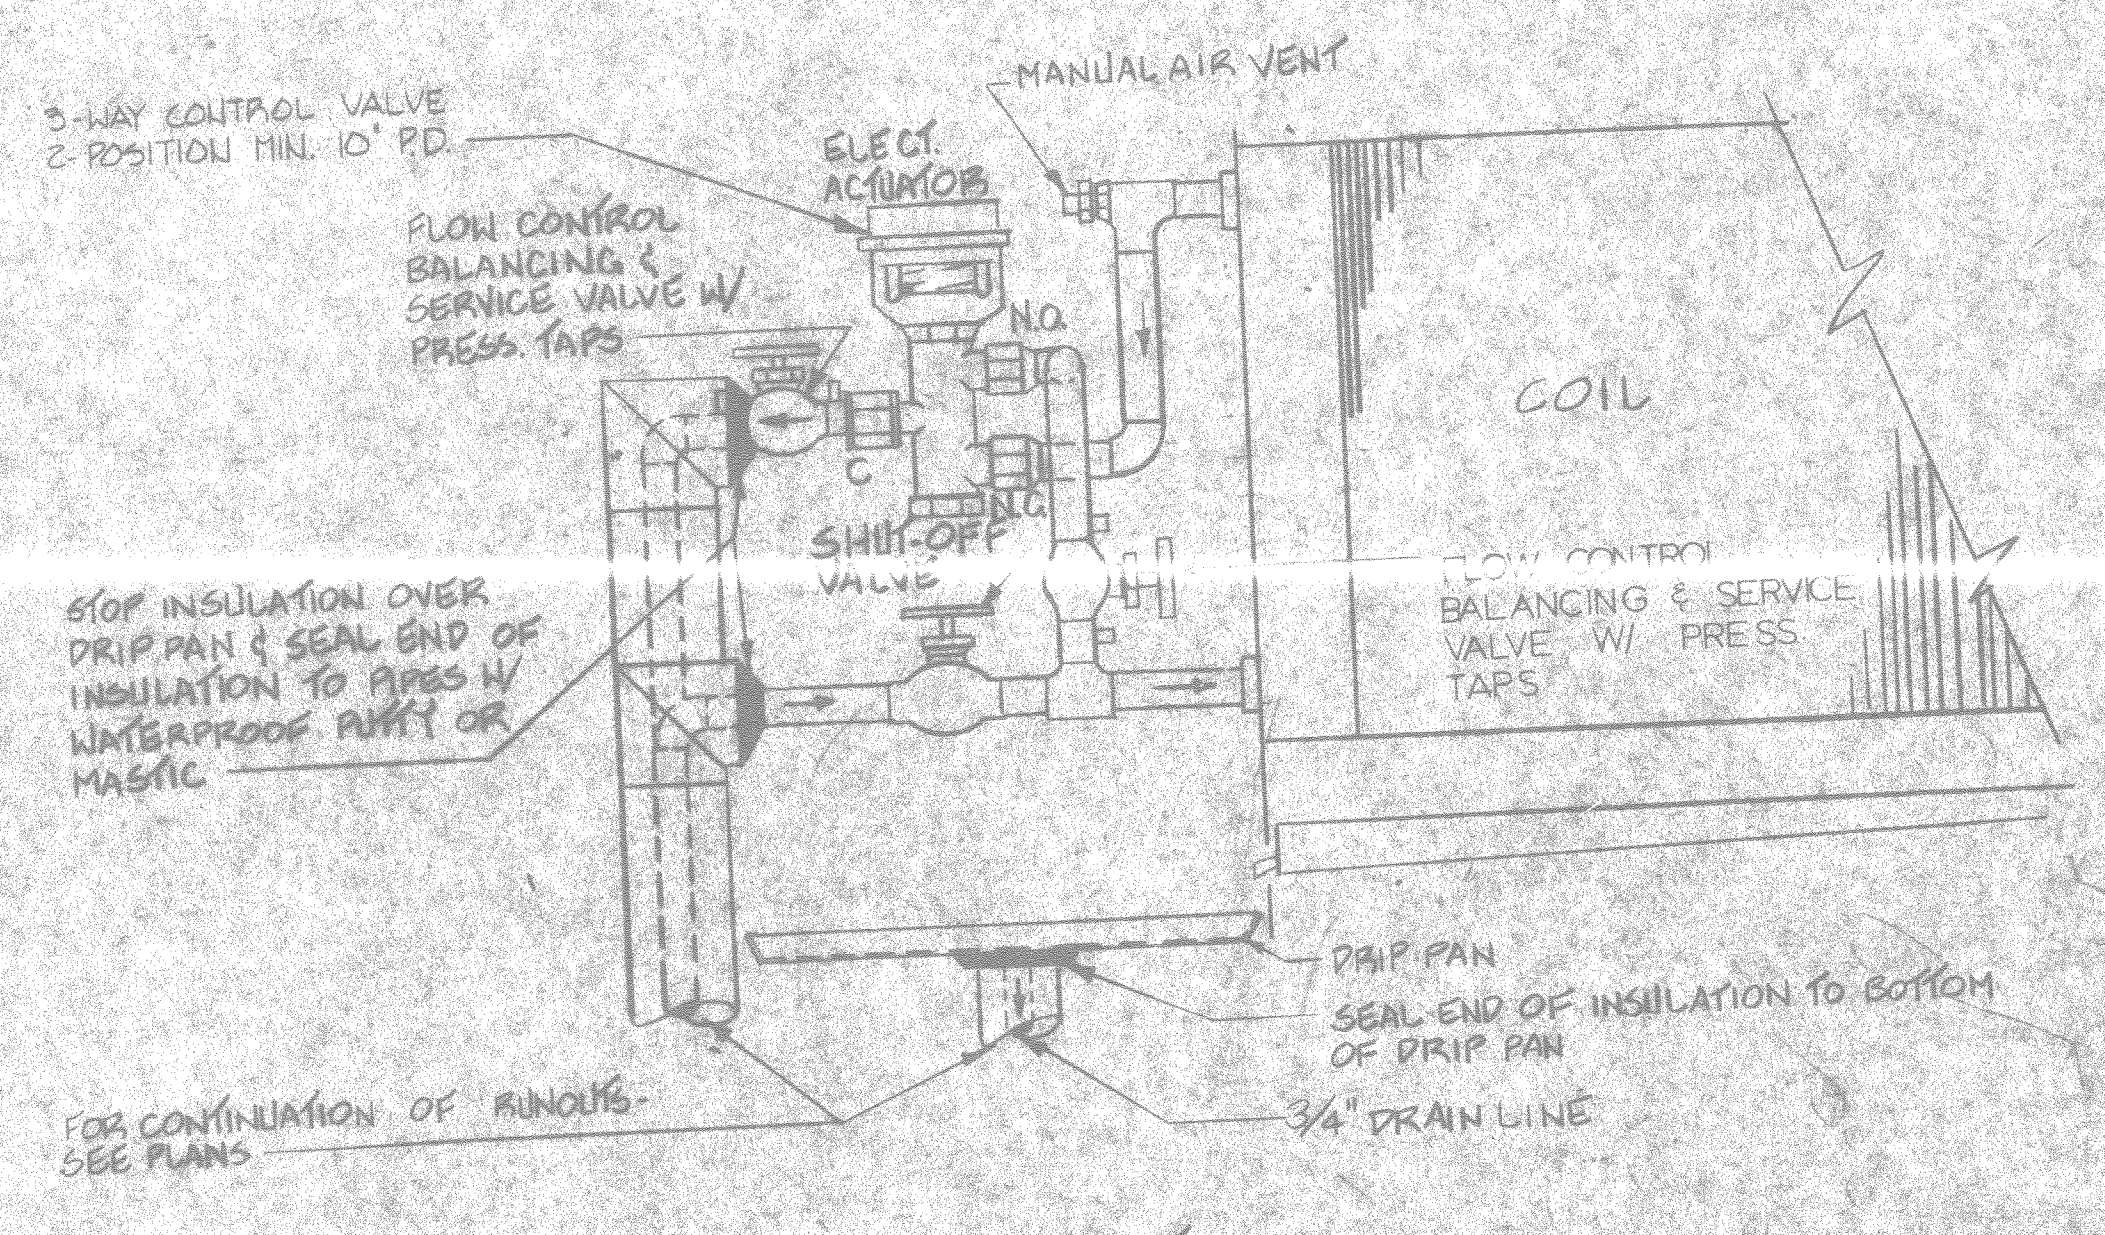

⑤ FAN COIL UNIT PIPING DETAIL  
NOT TO SCALE

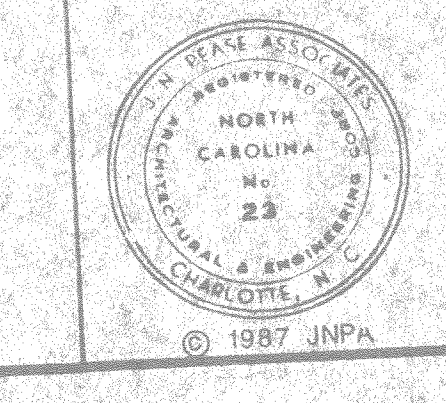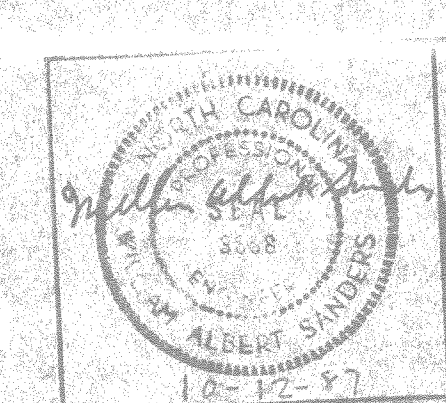

**RECORD DRAWING LETTER DATED** 14 FEB 1991

J. N. PEASE ASSOCIATES ARCHITECTS-ENGINEERS-PLANNERS CHARLOTTE, NORTH CAROLINA

DEPARTMENT OF THE NAVY ATLANTIC DIVISION

NAVAL STATION MARINE CORPS BASE CAMP LEJEUNE BACHELOR ENLISTED QUARTERS

**DETAILS & PIPING SCHEMATICS**

NAVY DRAWING NO 468706

CONSTR CONTR NO N62470-85-E


SCALE: NONE SPEC: 05-85-5428 SHEET NO: 102 OF 102









REVISIONS			
SYM	DESCRIPTION	DATE	APPROVED
(A)	REVISED AS-BUILT		

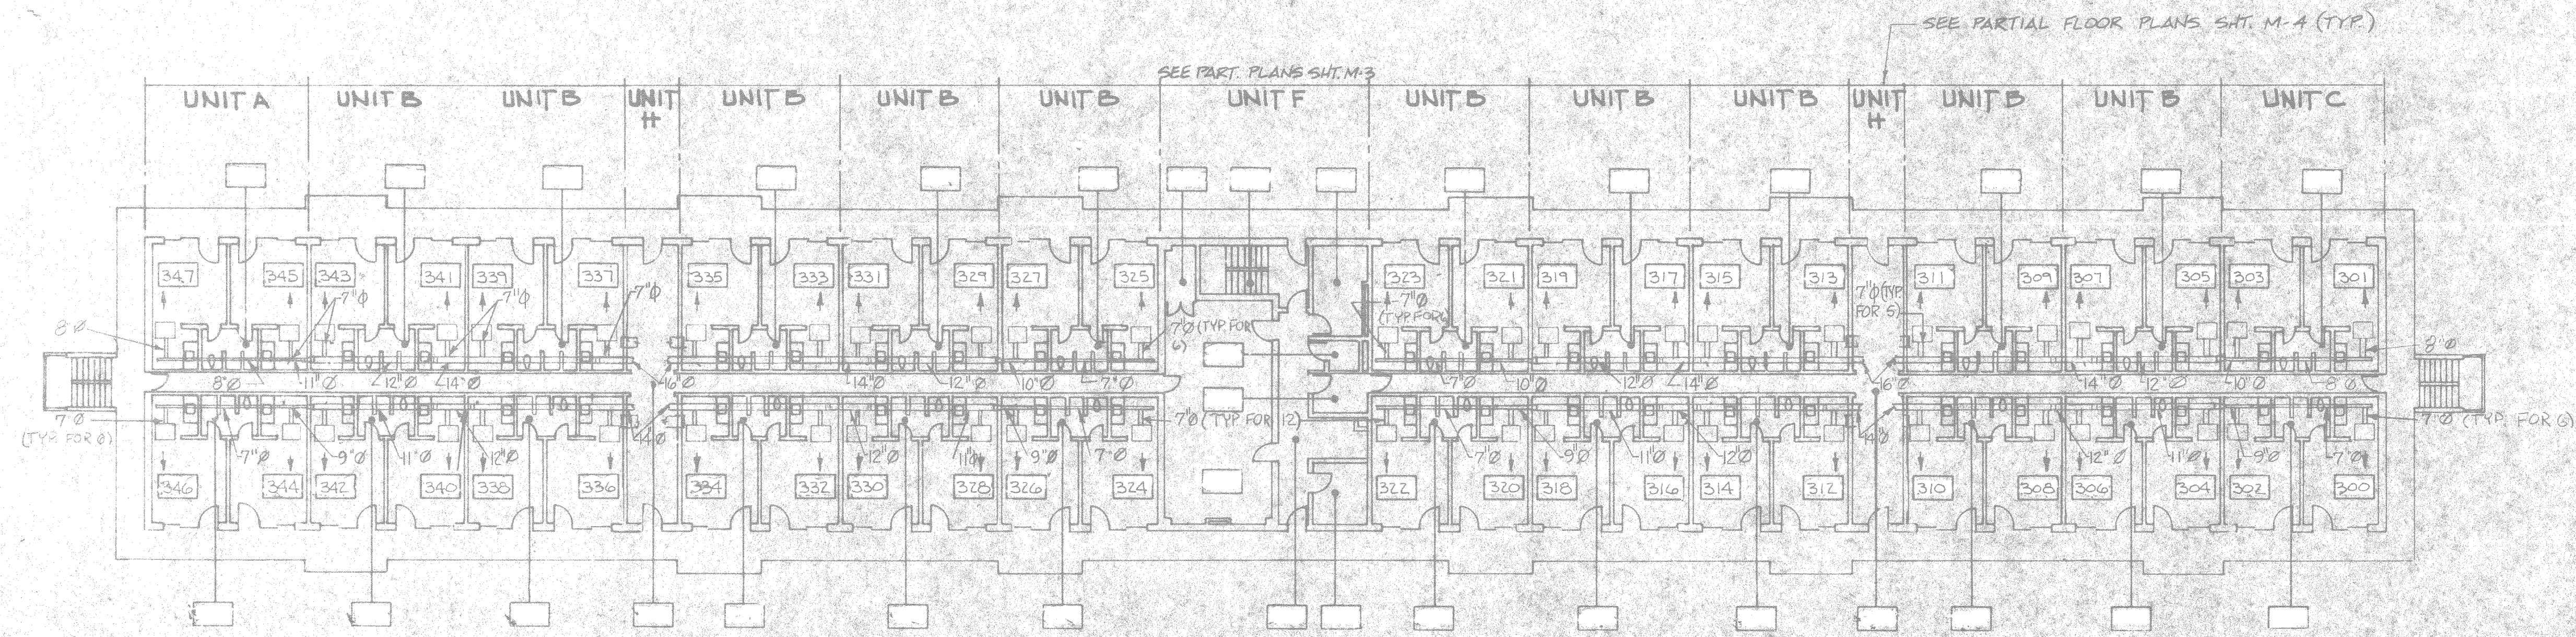


THIRD FLOOR PLAN - TYPE II 1/16" = 1'-0"  
TYPICAL FOR BUILDING HP-512 & HP-513

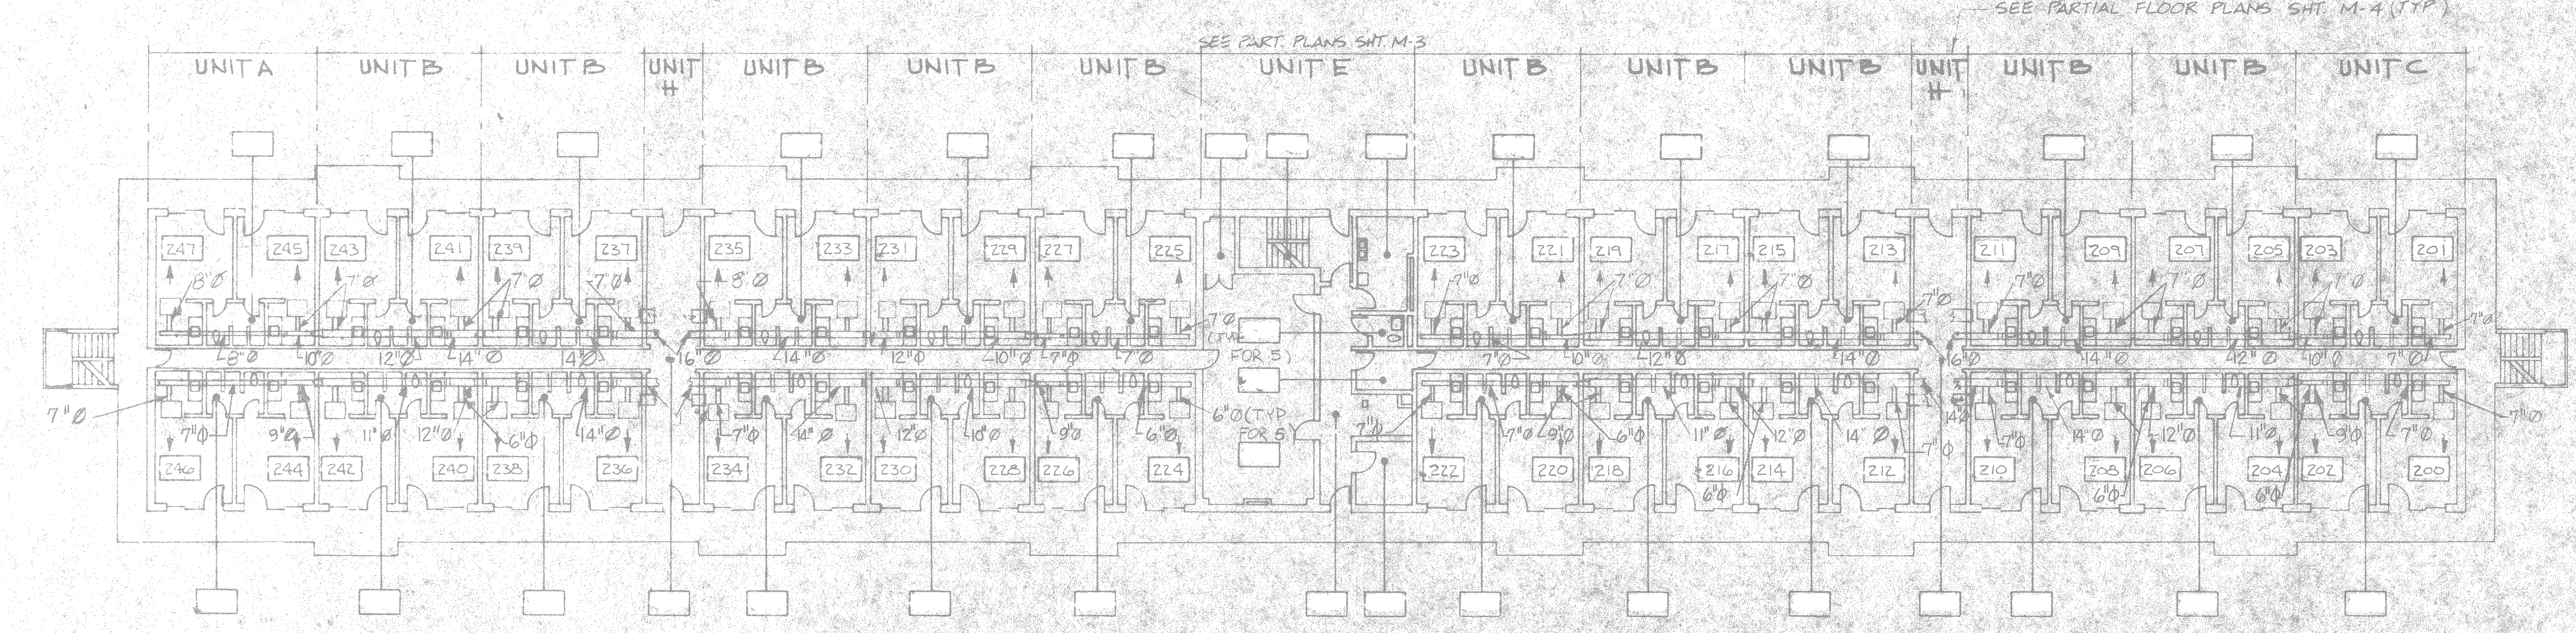

SECOND FLOOR PLAN - TYPE II 1/16" = 1'-0"  
TYPICAL FOR BUILDING HP-512 & HP-513

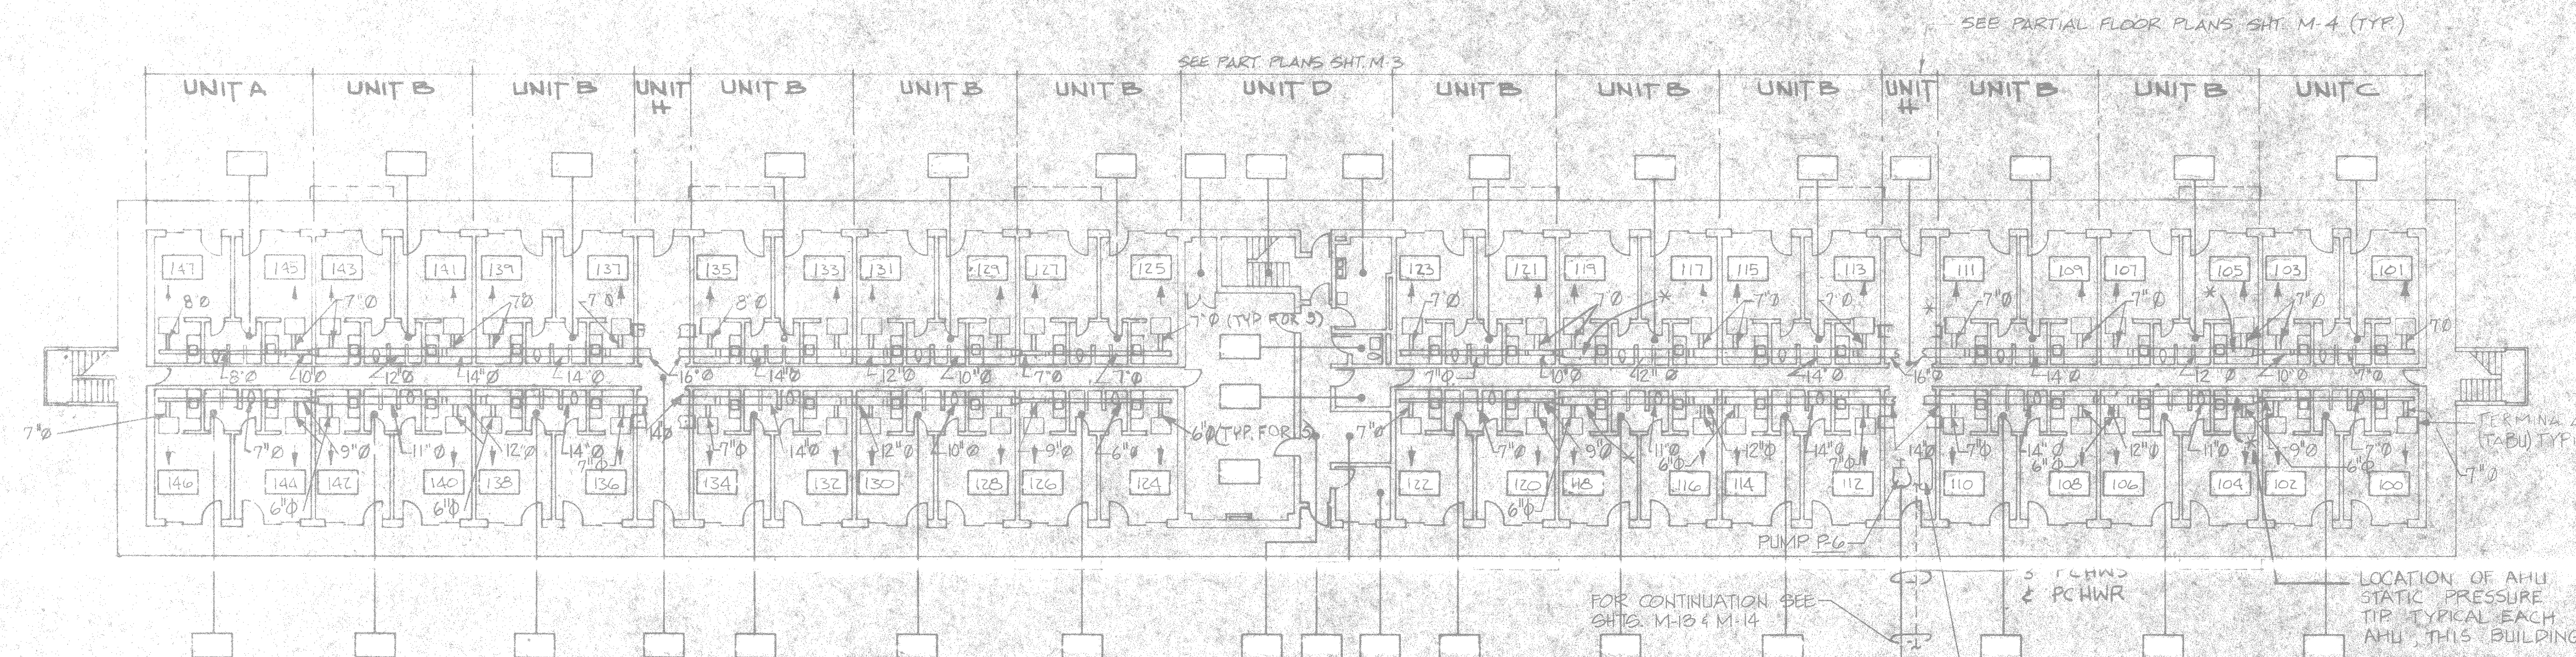

FIRST FLOOR PLAN - TYPE II 1/16" = 1'-0"  
TYPICAL FOR BUILDINGS HP-512 AND HP-513

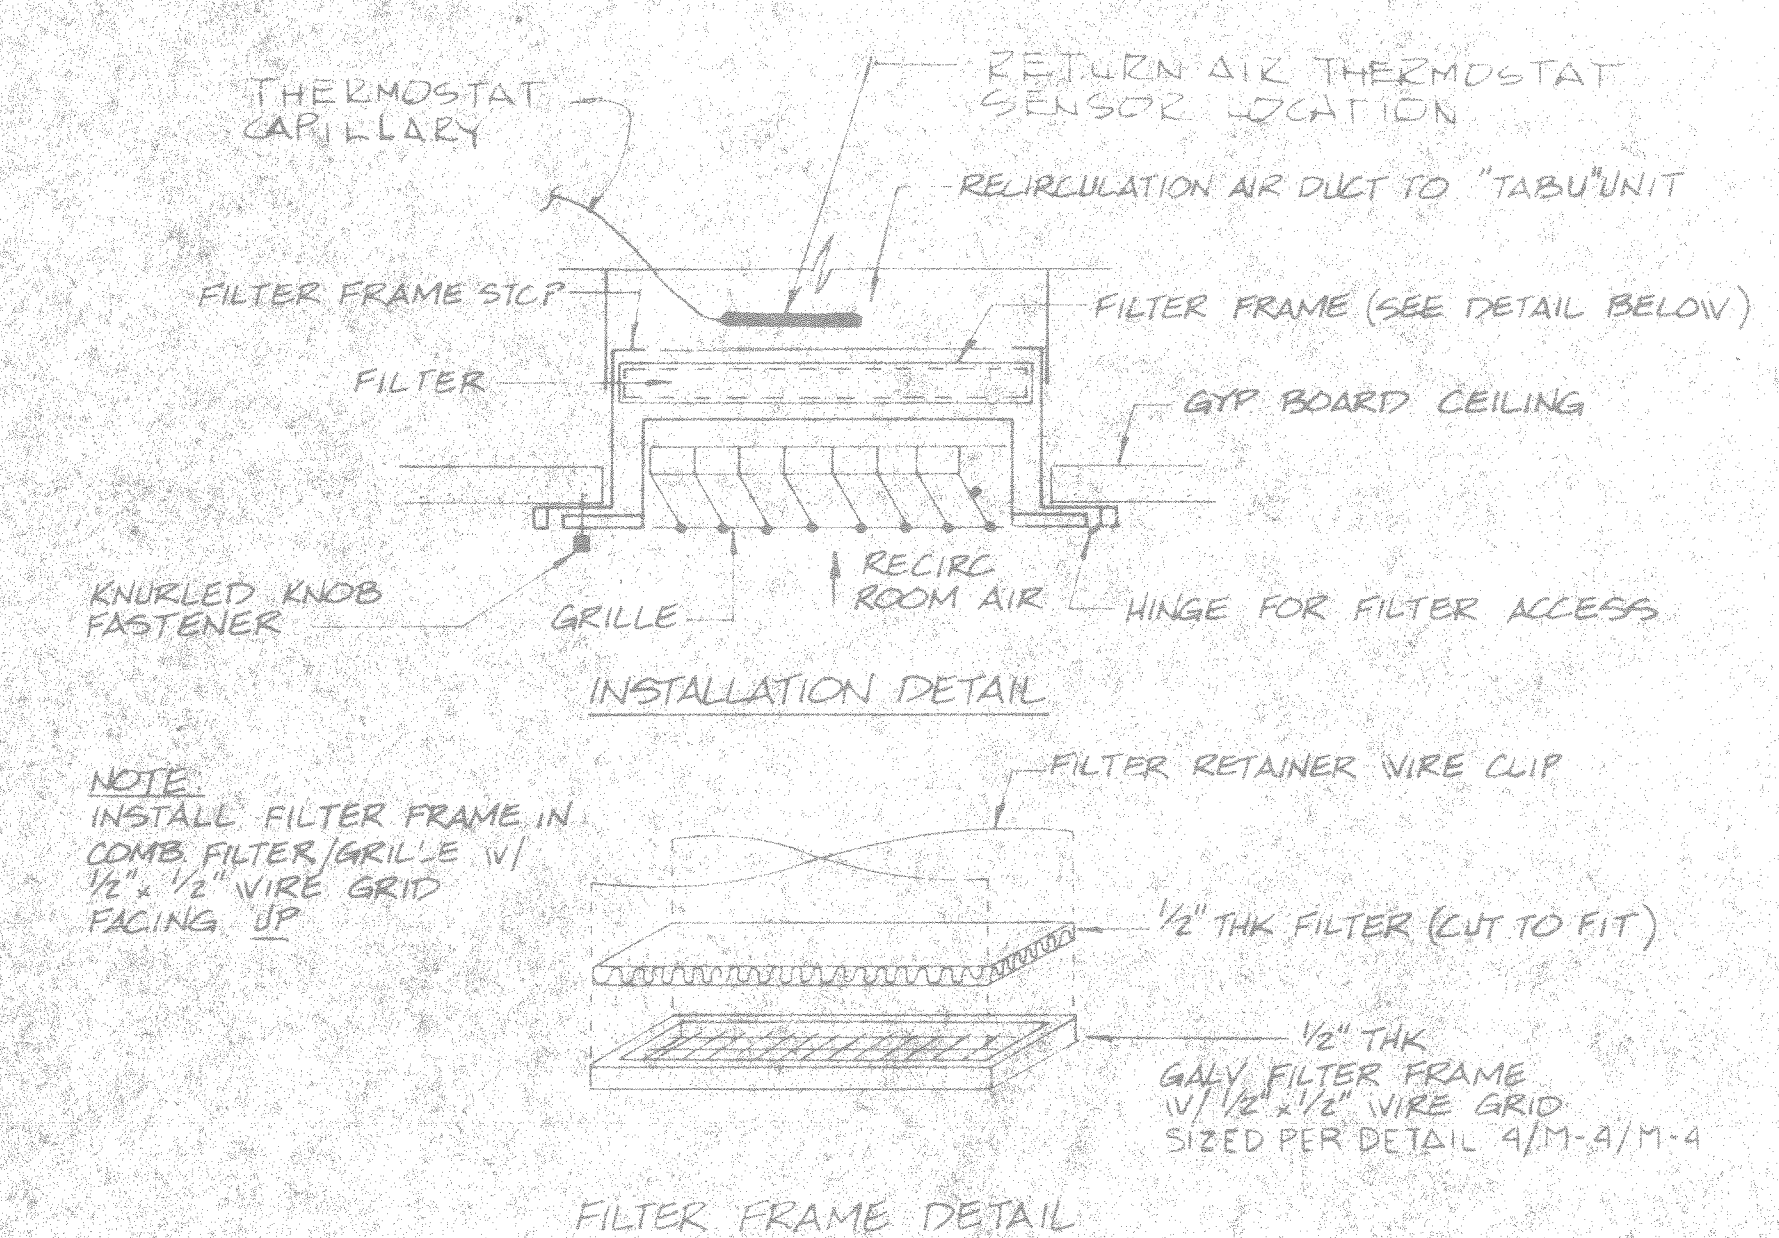

TYPICAL COMBINATION FILTER/GRILLE DETAIL @ TAB  
NOT TO SCALE

- GENERAL NOTES
1. PROVIDE MANUAL AIR VENTS AT ALL HIGH POINTS OF PIPING SYSTEM & WHERE INDICATED.
  2. PROVIDE PIPING SYSTEM DRAINS WITH HOSE CONNECTIONS AT ALL LOW POINTS & WHERE INDICATED.
  3. ALL BALANCING VALVES, THE PROMETOP WELLS, STRAINERS AIR VENTS SHALL BE PROVIDED WITH REMOVABLE INSULATION CAPS.
  4. ALL CONTROL VALVES SHALL BE CAPABLE OF SHUTTING TIGHT AGAINST PUMP SHUT-OFF HEAD.
  5. DUCT STATIC PRESSURE CLASSIFICATIONS ARE: SUPPLY AIR = 2.0" S.P. AND RETURN / OUTSIDE / EXHAUST AIR = 0.5" S.P.



NOTE:  
TOILETS WERE BUILT WITH THE SHOWERS & WATER CLOSETS BACK TO BACK. THE WATER CLOSET IS ON SIDE TOWARD THE LOUNGE.

NOTE: ROOM NUMBERS 344 AND 244 ARE NOT USED FOR THIRD FLOOR AND SECOND FLOOR PLANS RESPECTIVELY FOR CONTINUANCE OF SLEEPING ROOM NUMBERS ON ALL FLOORS.


	<b>RECORD DRAWING</b> <b>LETTER DATED</b> 14 FEB 1991		<b>M-2</b>
	J. N. PEASE ASSOCIATES ARCHITECTS - ENGINEERS - PLANNERS CHARLOTTE NORTH CAROLINA		
DEPARTMENT OF THE NAVY <b>ATLANTIC DIVISION</b>		NAVAL FACILITIES ENGINEERING COMMAND NORFOLK VIRGINIA	
DET. ENCL. DR. WRS/PL. CH. WAS PROJ. MGR. G.L.P. CH. ENGR. WAS DRAWING BY: DEWY I. C. K. Regan 1/14/87 FIRM MEMBER: 11 PRINCIPAL EPD. PP. 845 RVD. NORT. CAROLINA APPROVED: DATE: 1/28/91		MARINE CORPS BASE CAMP LEJEUNE, N.C. UNACCOMPANIED ENLISTED PERSONNEL HOUSING	
OFFICER IN CHARGE APPROVED: DATE: 1/28/91		<b>HVAC FLOOR PLANS - TYPE 2</b> NAVFAC DRAWING NO. 408102 CONSTR. CONTR. NO. N62470-85-B-5428	
FOR EPD FOR COMMANDER, NAVFAC		SCALE: AS SHOWN SPEC. 05-85-5428 SHEET 93 OF 106 EPD. DWG. NO. 208102	









SYM	REVISIONS	DATE	APPROVE
①	REVISED AS-BUILT		C.B.

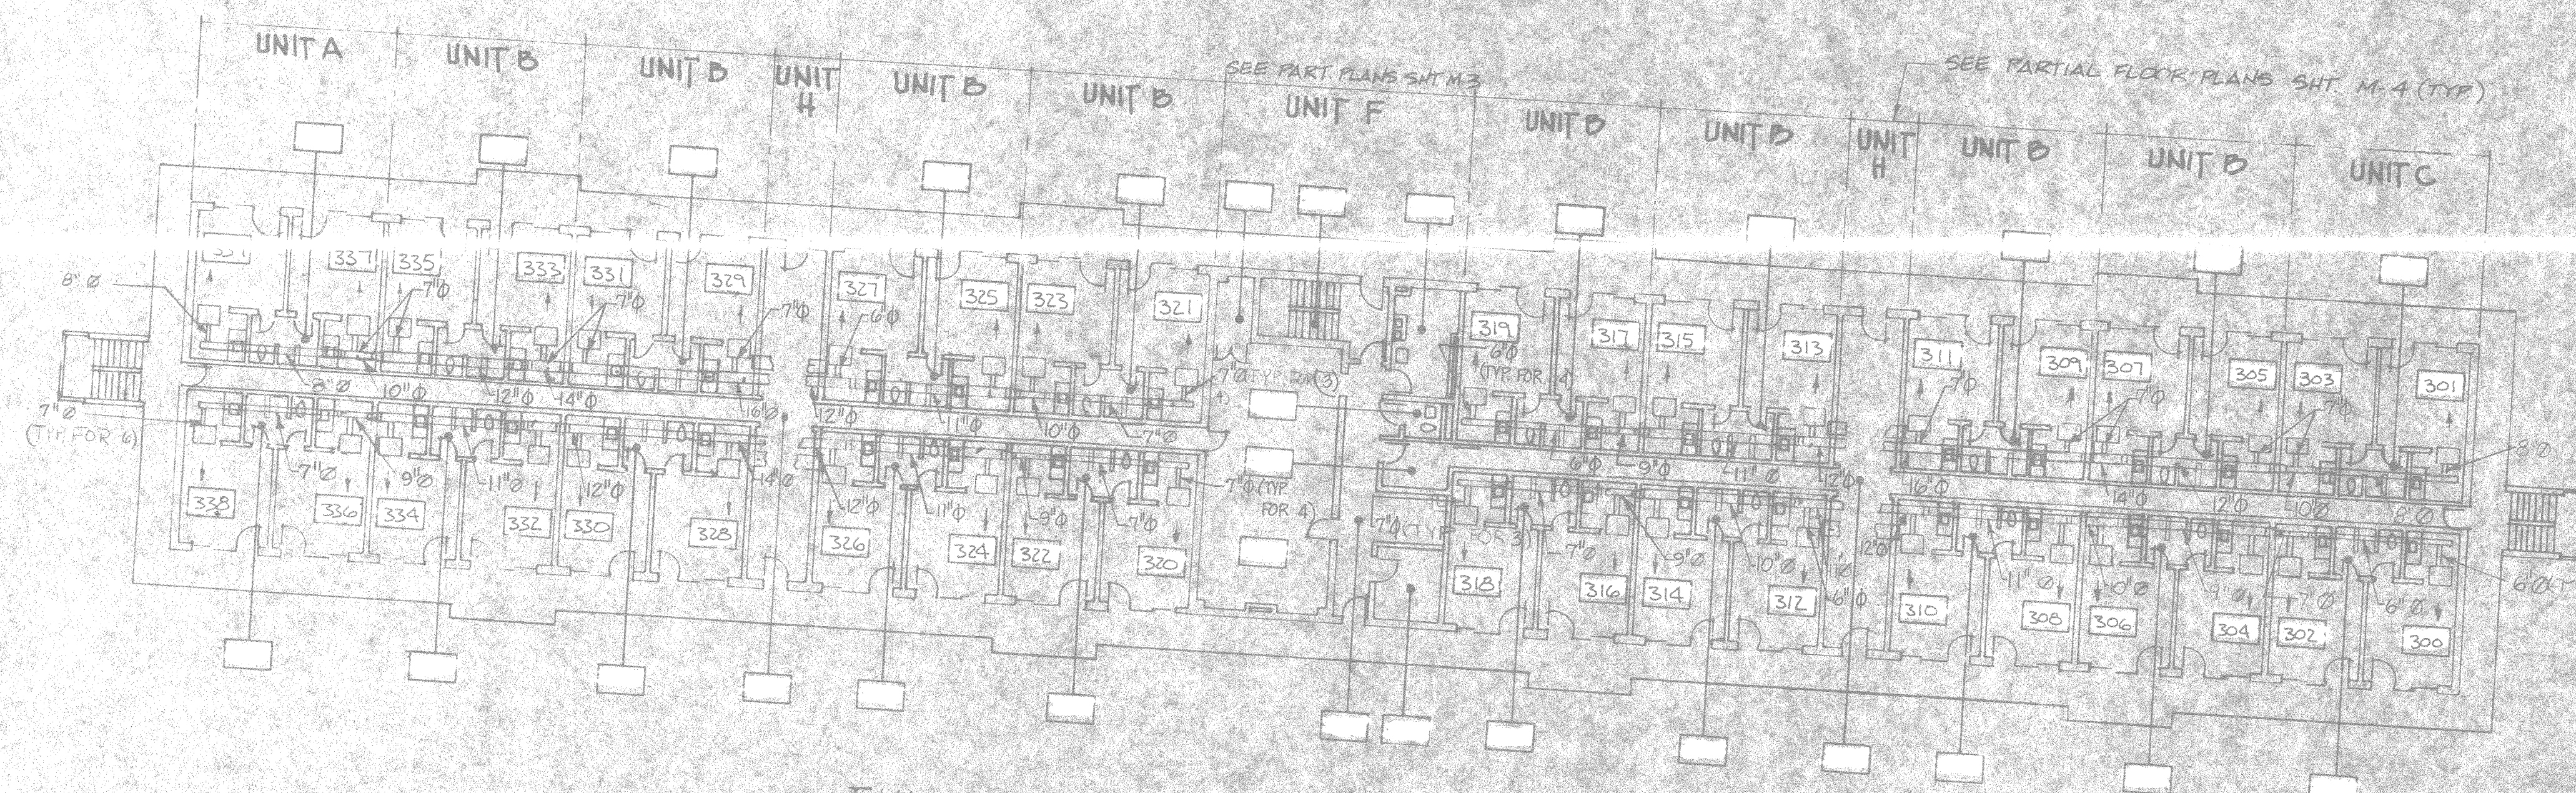

THIRD FLOOR PLAN - TYPE I 1/16" = 1'-0"  
TYPICAL FOR BUILDING HP 514 AND ADDITIVE NO. 1 - BUILDING HP 506

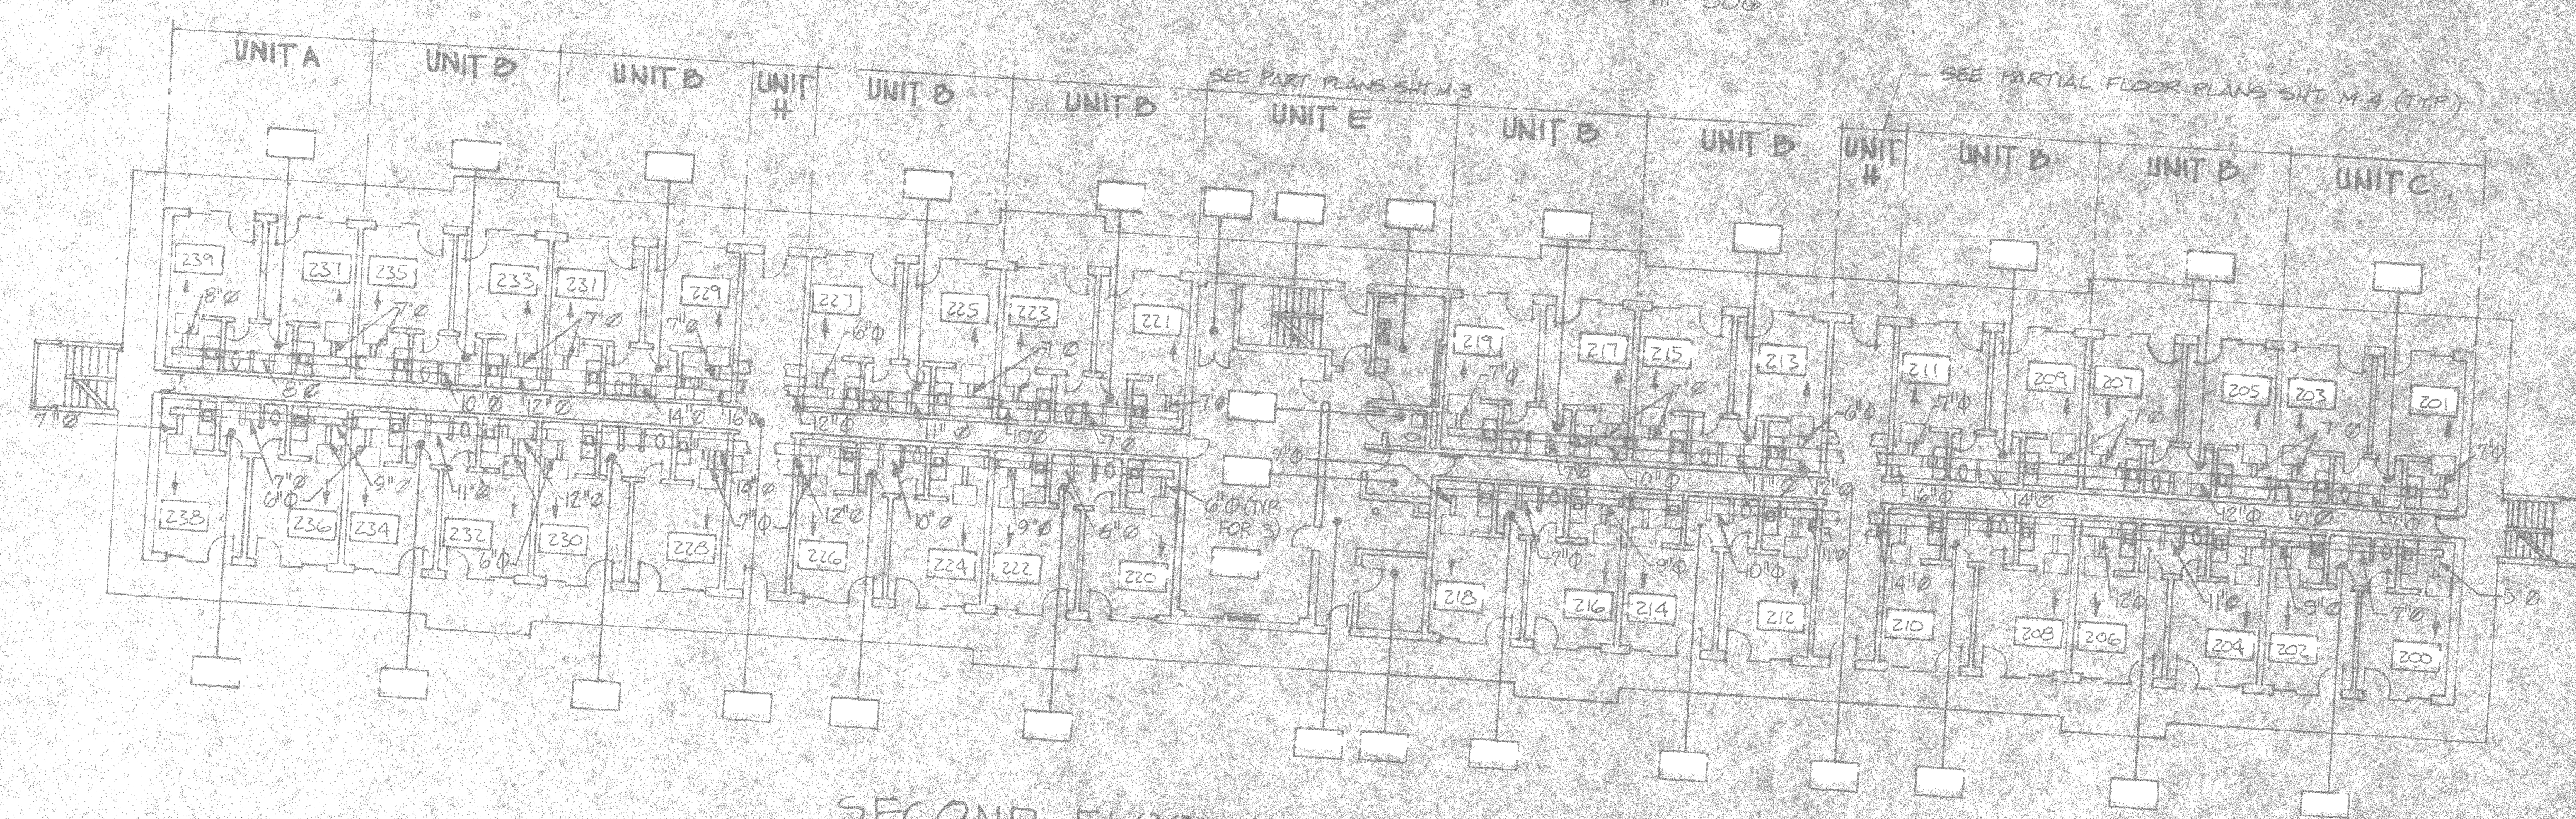

SECOND FLOOR PLAN - TYPE I 1/16" = 1'-0"  
TYPICAL FOR BUILDING HP 514 AND ADDITIVE NO. 1 - BUILDING HP 506

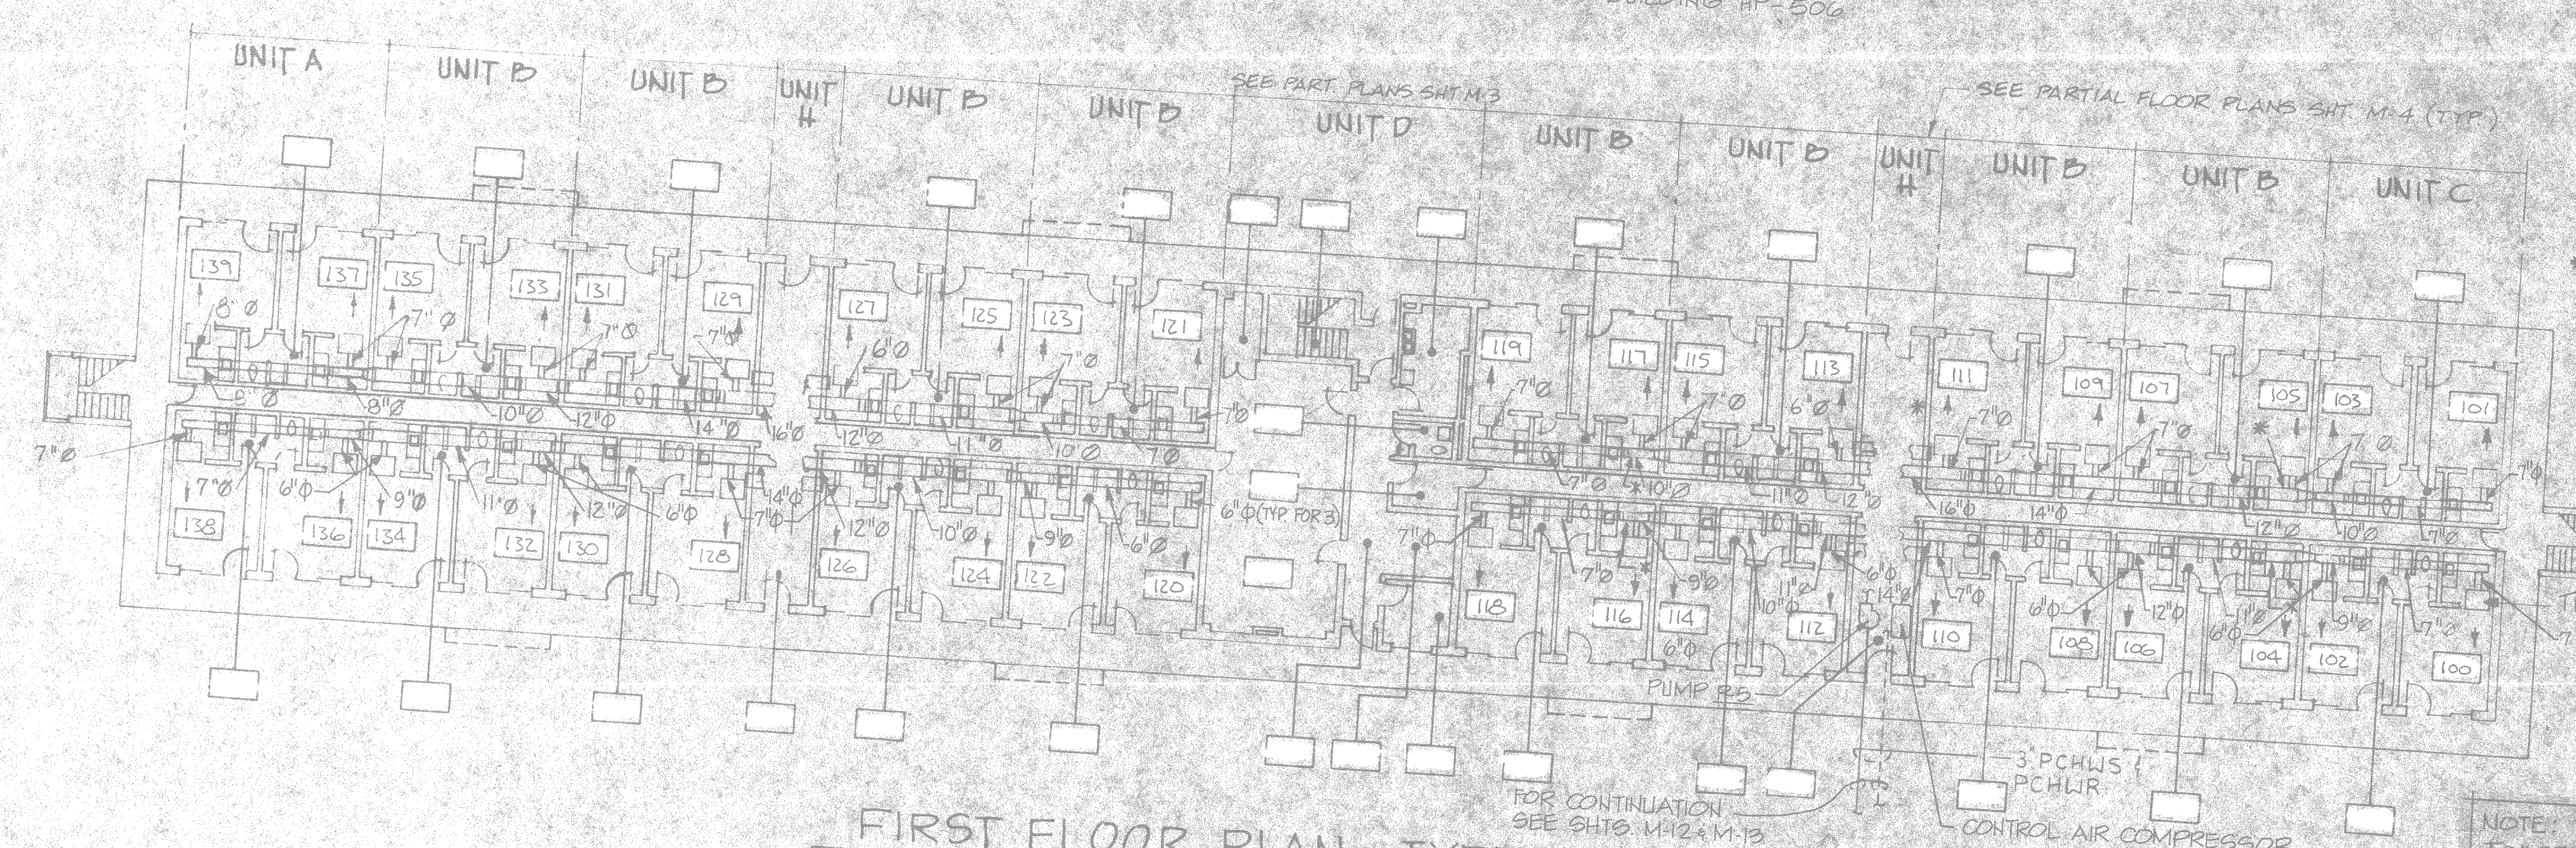

FIRST FLOOR PLAN TYPE I 1/16" = 1'-0"  
TYPICAL FOR BUILDING HP 514 AND ADDITIVE NO. 1 - BUILDING HP 506


② MAXIMUM SUPPLY CFM TO TERMINAL AIR BLENDER UNITS

ROOM NO.	TYPE I BLD'G FLOOR			ROOM NO.	TYPE II BLD'G FLOOR		
	1ST	2ND	3RD		1ST	2ND	3RD
*39	330	250	365	*47	350	350	365
*37	310	310	325	*45	310	310	325
*36	270	270	285	*42	270	270	285
*35	245	245	255	*44	245	245	255
*35	310	310	325	*43	310	310	325
*34	245	245	255	*41	310	310	325
*32	245	245	255	*42	245	245	255
*31	310	310	325	*40	245	245	255
*29	325	325	345	*39	310	310	325
*30	245	245	255	*37	425	325	345
*28	245	245	255	*38	245	245	255
*27	325	325	345	*36	245	245	255
*25	310	310	325	*35	325	325	345
*26	245	245	255	*35	310	310	325
*24	245	245	255	*34	245	245	255
*23	310	310	325	*32	245	245	255
*21	300	300	320	*31	310	310	325
*22	245	245	255	*29	310	310	325
*20	245	245	255	*30	245	245	255
*19	325	325	345	*28	245	245	255
*18	310	310	325	*27	310	310	325
*16	270	265	275	*25	300	300	320
*15	245	245	255	*26	245	245	255
*13	310	310	325	*24	245	245	255
*14	245	245	255	*23	325	325	345
*12	245	245	255	*21	310	310	325
*11	325	325	345	*22	270	265	275
*09	310	310	325	*20	245	245	255
*10	245	245	255	*19	310	310	325
*05	245	245	255	*18	245	245	255
*07	310	310	325	*16	245	245	255
*05	310	310	325	*15	310	310	325
*06	245	245	255	*13	325	325	345
*04	245	245	255	*14	245	245	255
*03	310	310	325	*12	245	245	255
*01	325	305	360	*11	325	325	345
*02	245	245	255	*09	310	310	325
*00	280	280	275	*10	245	245	255
				*08	245	245	255
				*07	310	310	325
				*05	310	310	325
				*06	245	245	255
				*04	245	245	255
				*03	310	310	325
				*01	325	325	345
				*02	245	245	255
				*00	280	280	275

- ① TABULATED ROOM NUMBERS ARE INDICATED BY THE LAST TWO DIGITS OF ACTUAL ASSIGNED ROOM NUMBERS.
- ② MAXIMUM CFM TO TABU UNITS BASED ON INDIVIDUAL ROOM PEAK COOLING LOADS.
- ③ ROOMS WITH AN ASTERISK (\*) ADJACENT TO THE ROOM NO. REQUIRE A TABU IN 100 CFM CAPACITY, 2" P.H.P. 180" W. AND 0.13" E.S.P. ALL OTHERS REQUIRE A TABU IN 300 CFM CAPACITY, 2" P.H.P. 120" W. AND 0.13" E.S.P. MINIMUM PRIMARY AIR INLET STATIC PRESSURE = 0.75" W.G.

\* LOCATION OF AHD STATIC PRESSURE TAP AT EACH AHD THIS BUILDING.

NOTE: SEE SHIT. M. 2 FOR GENERAL NOTES  
TERMINAL AIR BLENDER (TABU) TYP

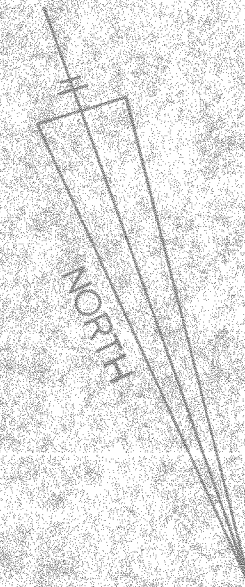

NOTE: ROOM NUMBERS 330 AND 236 ARE NOT USED FOR THIRD FLOOR AND SECOND FLOOR PLANS RESPECTIVELY FOR CONTINUANCE OF SLEEPING ROOM NUMBERS ON ALL FLOORS.

NOTE: WHERE ROUND DUCT WILL NOT FIT DUE TO SPACE LIMITATIONS OR INTERFERENCES, OVAL DUCT OF EQUIVALENT DIAMETER MAY BE SUBSTITUTED.

**RECORD DRAWING**  
**LETTER DATED** 14 FEB 1991  
**M-1**

ARCHITECTS: ENGINEERS - PLANNERS  
CHARLOTTE NORTH CAROLINA

DEPARTMENT OF THE NAVY  
NAVAL FACILITIES ENGINEERING COMMAND  
ATLANTIC DIVISION

NAVAL STATION  
MARINE CORPS BASE CAMP LEJEUNE, N.C.  
BACHELOR ENLISTED QUARTERS

PROJECT NO. 62-100-100-100-100  
SUBMITTED BY: [Signature]  
DATE: 01/19/91

MEMBER: [Signature] PRINCIPAL  
APPROVED: [Signature] DATE: [ ]


OFFICER IN CHARGE

**HVAC FLOOR PLANS - TYPE I**








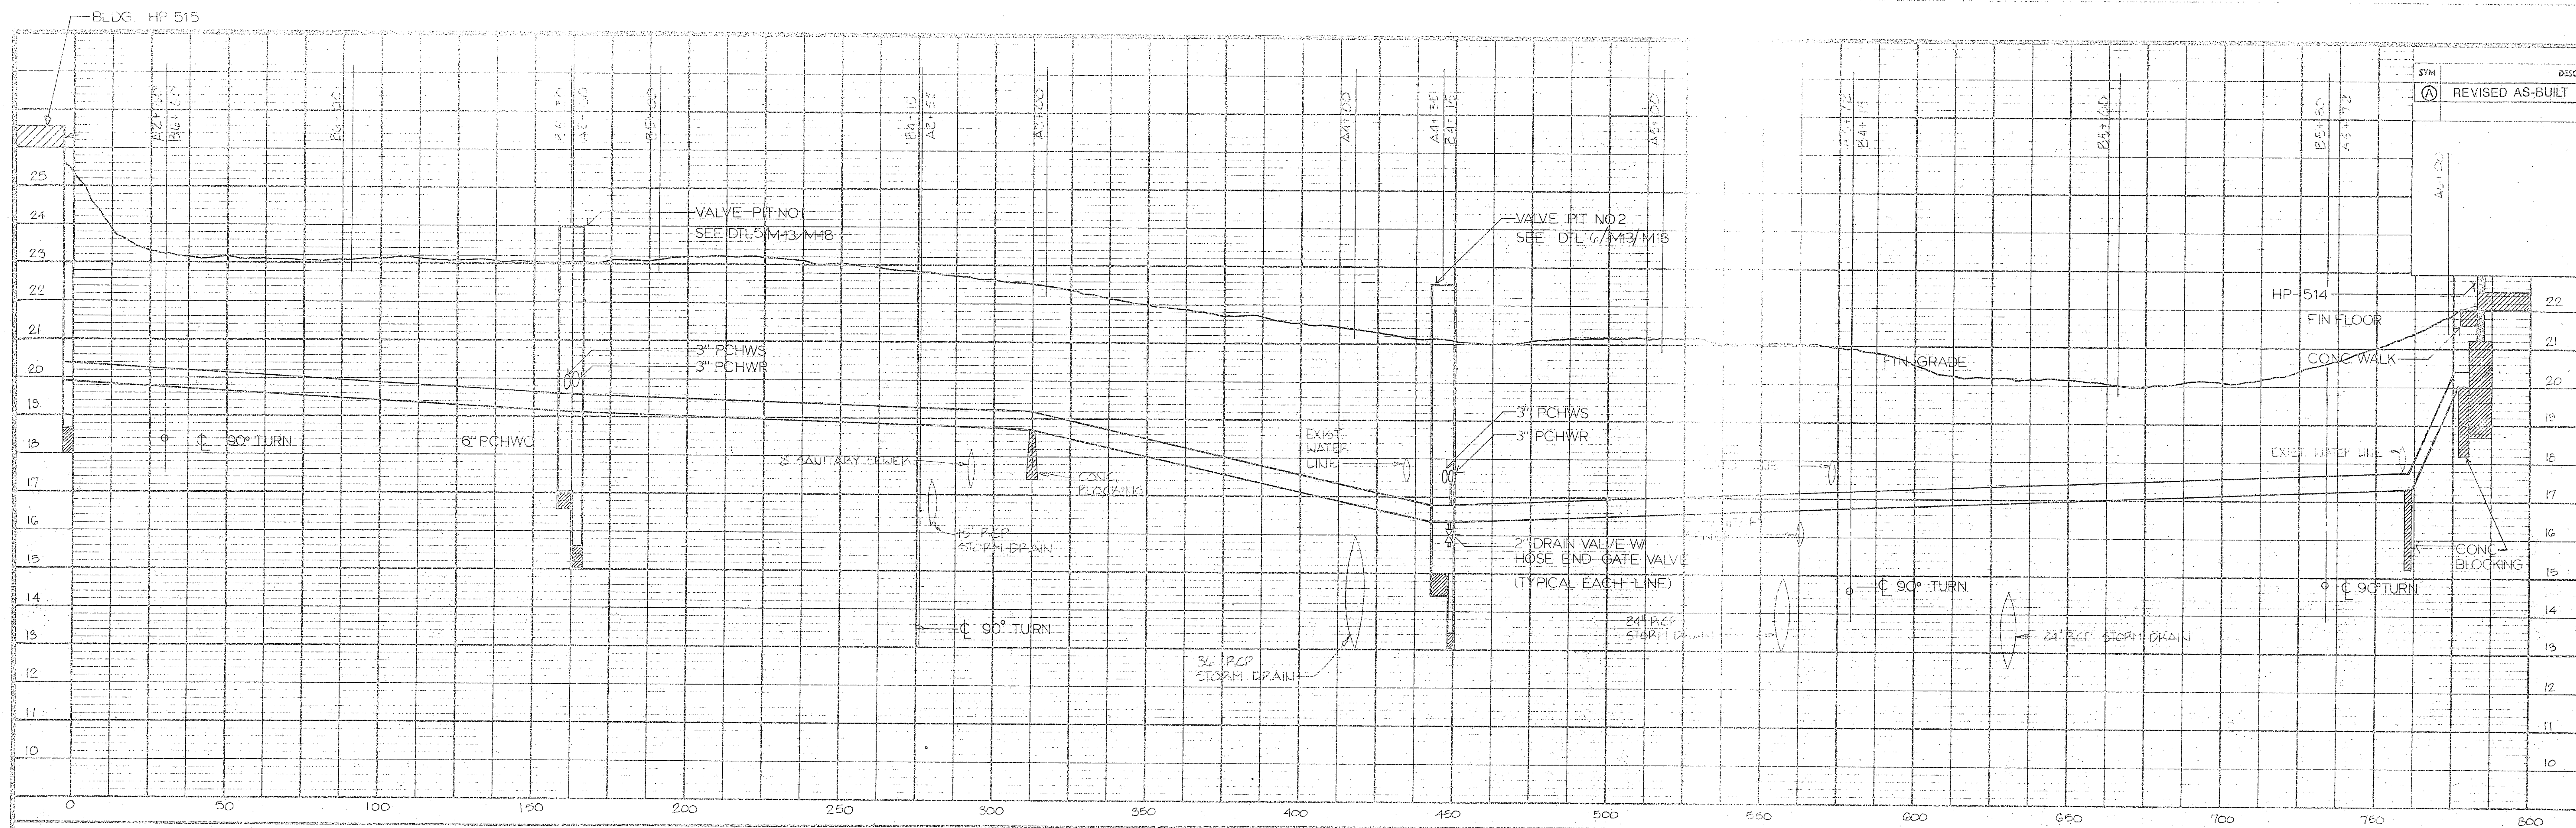

REVISIONS				
NO.	DESCRIPTION	PREP BY	DATE	APPROVED
1	REVISED AS-BUILT	CS		

**1** PROFILE NO. 1 PRIMARY CHILLED WATER RETURN  
 HORIZ. SCALE: 1" = 25'-0" VERTICAL SCALE: 1" = 2'-0"


NOTE: PCHWS, DHWS, AND DHWR PIPING SHALL BE RUN AT SAME ELEVATION AS PCHWR PIPING.

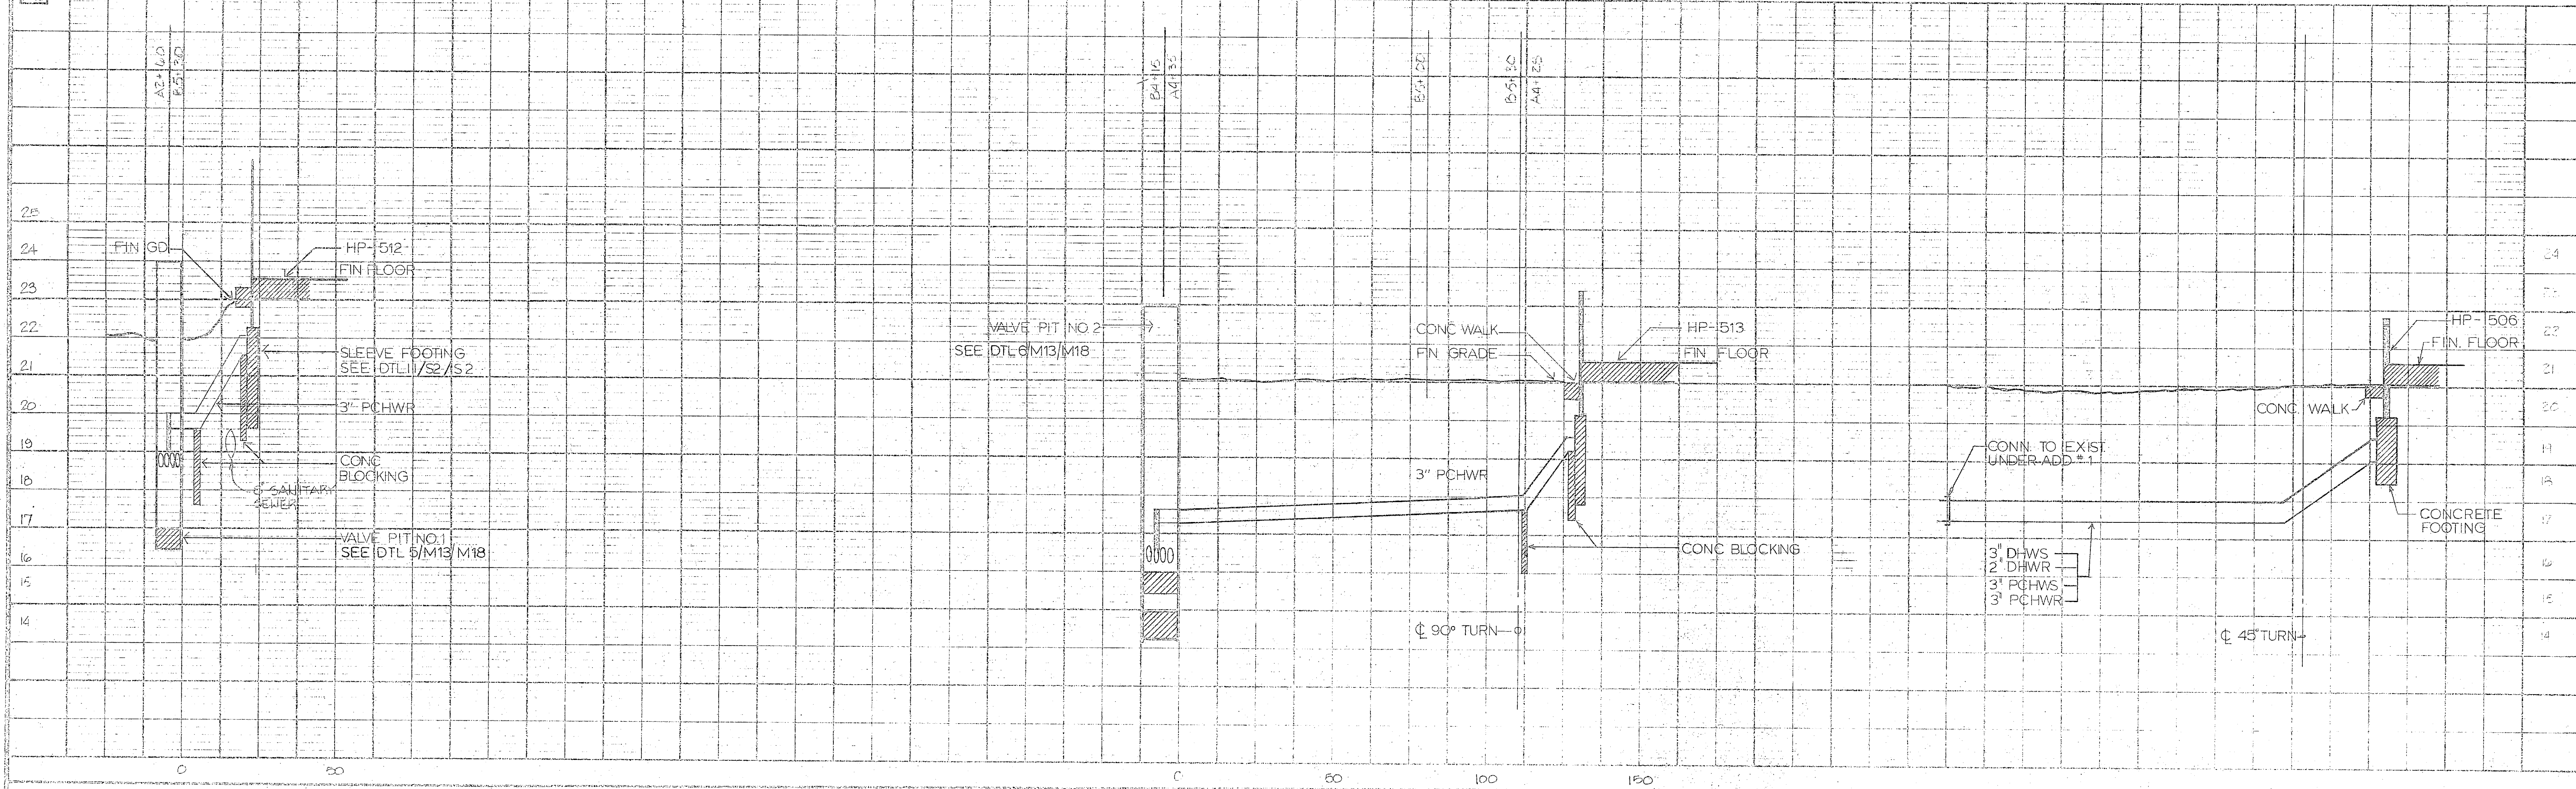

**2** PROFILE NO. 2 PRIMARY CHILLED WATER RETURN  
 HORIZ. SCALE: 1" = 25'-0" VERTICAL SCALE: 1" = 2'-0"

**3** PROFILE NO. 3 PRIMARY CHILLED WATER RETURN  
 HORIZ. SCALE: 1" = 25'-0" VERTICAL SCALE: 1" = 2'-0"

**4** PROFILE NO. 4  
 HORIZ. SCALE: 1" = 25'-0" VERT. SCALE: 1" = 1'-0"

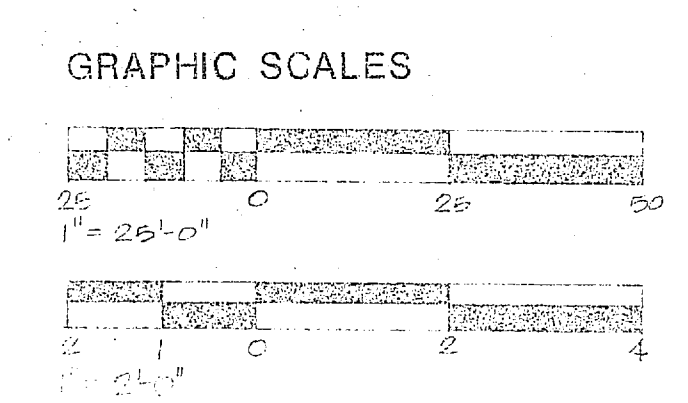

**RECORD DRAWING LETTER DATED** 14 FEB 1991

**M-17**

DEPARTMENT OF THE NAVY  
 ATLANTIC DIVISION  
 MARINE CORPS BASE CAMP LEJEUNE  
 BACHELOR ENLISTED QUARTERS  
**PROFILES- PCHWS/R & DHWS/R DISTRIBUTION**

460711  
 05-35-5428

© 1987 JNPA



