

ITEM #	QTY.	DESCRIPTION	LOCATION	NOTES
1	16	RP908100 Room #1 stat	See Plans	R.A., set=70°, blank cover
2	3	VP514D Valve assembly - see schedule	At Unit	N.C., 4-11#
3	3	RP404100 Relay	Unit Panel	120/60
4A	1	RP908100 Summer Operator	O.A. Damper	3-13#
4B	1	RP908100 Winter Operator	O.A. Damper	3-13#
5	4	LP915A100 Sensor	Coil Discharge	0-200°
6	4	RP908100 Comp. Gauge	Unit Panel	0-2000, 2 1/2" dia.
7	3	AMP214700 Stop-start push buttons	Unit Panel Face	Non. contact
8	3	AMP214700 Freezestat	Coil Discharge	Set=40°
9	1	RP908100 Controller	Unit Panel	R.A., set=70°, P.B.=3%
10	1	RP908100 Summer Operator	O.A. Damper	3-13#
11	2	LP914A100 Sensor	H.W. Supply	40 to 240°
12	2	RP908100 Comp. Gauge	At Controller	40 to 2400, 3 1/2" dia.
13	2	RP908100 Controller	On wall near converter	R.A., P.B.=10%, auth=100% (Conv.#1) auth=100% (Conv.#2)
14	2	RP908100 Comp. Gauge	At Controller	-Item #13
15	2	VP514D Valve assembly - see schedule	Near Converter	N.O., 4-11#
16	1	LP914A100 Sensor	O.A. at ext. wall	-40 to 160°
17	2	VP514D Valve Assembly - see schedule	At duct coils	N.C., 4-11#
18	1	RP908100 Room #1 stat	See Plans	D.A., set=70°, blank cover
19	6	LP914A100 Sensor	Thru Wall into washing area	-40 to 160°
20	6	RP908100 Controller	In Chase behind D.A., P.B.=2 1/2%, set=70°	
21	7	VP516C Valve assembly - see schedule	In Equip. Room	4-11#
22	1	RP908100 Controller	H&V #3 Panel	R.A., P.B.=3%, Set=75°
23	1	VP516C Valve Assembly - see schedule	Wall of Equip. Room #1, as required	
24	1	RP404100 Summer-Winter Switch	Room #1, as required	
25	1	LP914A100 Sensor #3150460 #911	Hot-Chilled Water return line	40 to 240°
26	1	RP908100 Controller	On wall near switch-item#24	R.A., P.B.=2 1/2%, set=90°
27	1	RP404100 Relay	On wall near switch-item#24	
28	1	VP516C Valve assembly - see schedule	Equip. Room	4-11#
29	1	RP404100 PE switch	Near Panel "WLD"	Set=8-10#
30	1	RP4210100 Contactor	Near Panel "WLD"	120/60, 4P#
31	1	RP4210100 Contactor #29703A enclosure	Near Panel "WLD"	120/60, 3 P#
32	1	RP404100 PE Switch	At chiller in panel	Set=10-12#
33	1	RP908100 Freezestat #3150460 #911	See Plans	R.A. - Summer O.A. - Winter Marked: "warmer-cooler"
34	28	VP516C Valve Assembly - see schedule	At Fan coil Unit	Set=10#
35	12	VP516C Valve assembly - see schedule	At Convertors	R.C., 3-10#
36	14	LP908100 Freezestat	Locate at inlet to fans	Set=125°
37	1	RP404100 Room #1 stat	In Equip. Room #1	Set=60°
38	1	W220B1000 1/2" Compressor and Air Dryer w/ 1/2" 4" coil guard	In Equip. Room #1	1 1/2" H.P., 20 gal. tank 120/60/10
39	1	RP908100 Two-Pressure P.R.V.	At Compressor	Set=1 1/2" & 20#
40	1	RP908100 P.R.V. & Filter	At Compressor	Set=20#
41	1	MC110100 20 Pall Trinity Micro Filter	At Compressor	Reverse Utilizer Element

LOCATION	Q (#/HR.)	Cv	SIZE	VALVE NUMBER	OPERATOR NO.
H&V-1	360	10	1"	V501101201	MP953D1131
H&V-2	322	10	1"	V501101201	MP953D1131
H&V-3	526	16	1 1/2"	V501101268	MP953D1131
Converter #1	205	6.3	3/4"	V501101144	MP953D1131
Converter #2	500	16	1 1/2"	V501101268	MP953D1131
Duct Htg. Coil #1	7.1	.4	1/2"	V501101698	MP953D1131
Coil #2	28.4	.63	1/2"	V501101603	MP953D1131
Convertors:					
1" M	4.5	1.0	1/2"	VP513B1004	
1" N	5.5	1.6	1/2"	VP513B1020	
1" Q	6.5	1.6	1/2"	VP513B1026	
1" R (2 Req.)	4.9	1.0	1/2"	VP513B1004	
1" S	3.0	1.0	1/2"	VP513B1004	
1" T	1.0	1.0	1/2"	VP513B1004	
1" U	6.5	1.6	1/2"	VP513B1020	
1" V (4 Req.)	4.0	1.0	1/2"	VP513B1004	

LEGEND

LOW VOLTAGE
 N.O. - NORMALLY OPEN
 N.C. - NORMALLY CLOSED
 D.A. - DIRECT ACTING
 R.A. - REVERSE ACTING
 T.R. - THROTTLING RANGE
 P.B. - PROPORTIONAL BAND


ARCHITECT: ENGINEER: CONTRACTOR:


DEVICES TO BE MOUNTED IN H&V UNIT CONTROL PANEL (3-REQUIRED - 1 EACH UNIT)

NOTES: PLASTIC TUBING TO BE RUN THROUGH-OUT PER G.S.A. STANDARDS. TUBING TO BE RUN IN NEAT MANNER-LIKE MANNER AND PROTECTED WHERE SUBJECT TO MECHANICAL DAMAGE.

Revisions	Date	Appd.
Supersedes	Drawn By: KCU	Date: 1-6-67
Superseded by	Approved By: RBU	Sheet 1 Of 2

2410 BUNAVANT ST, CHARLOTTE, N.C.
 B215 - CAMP LEJEUNE
 JACKSONVILLE, N.C.
 339-67074-1XIV

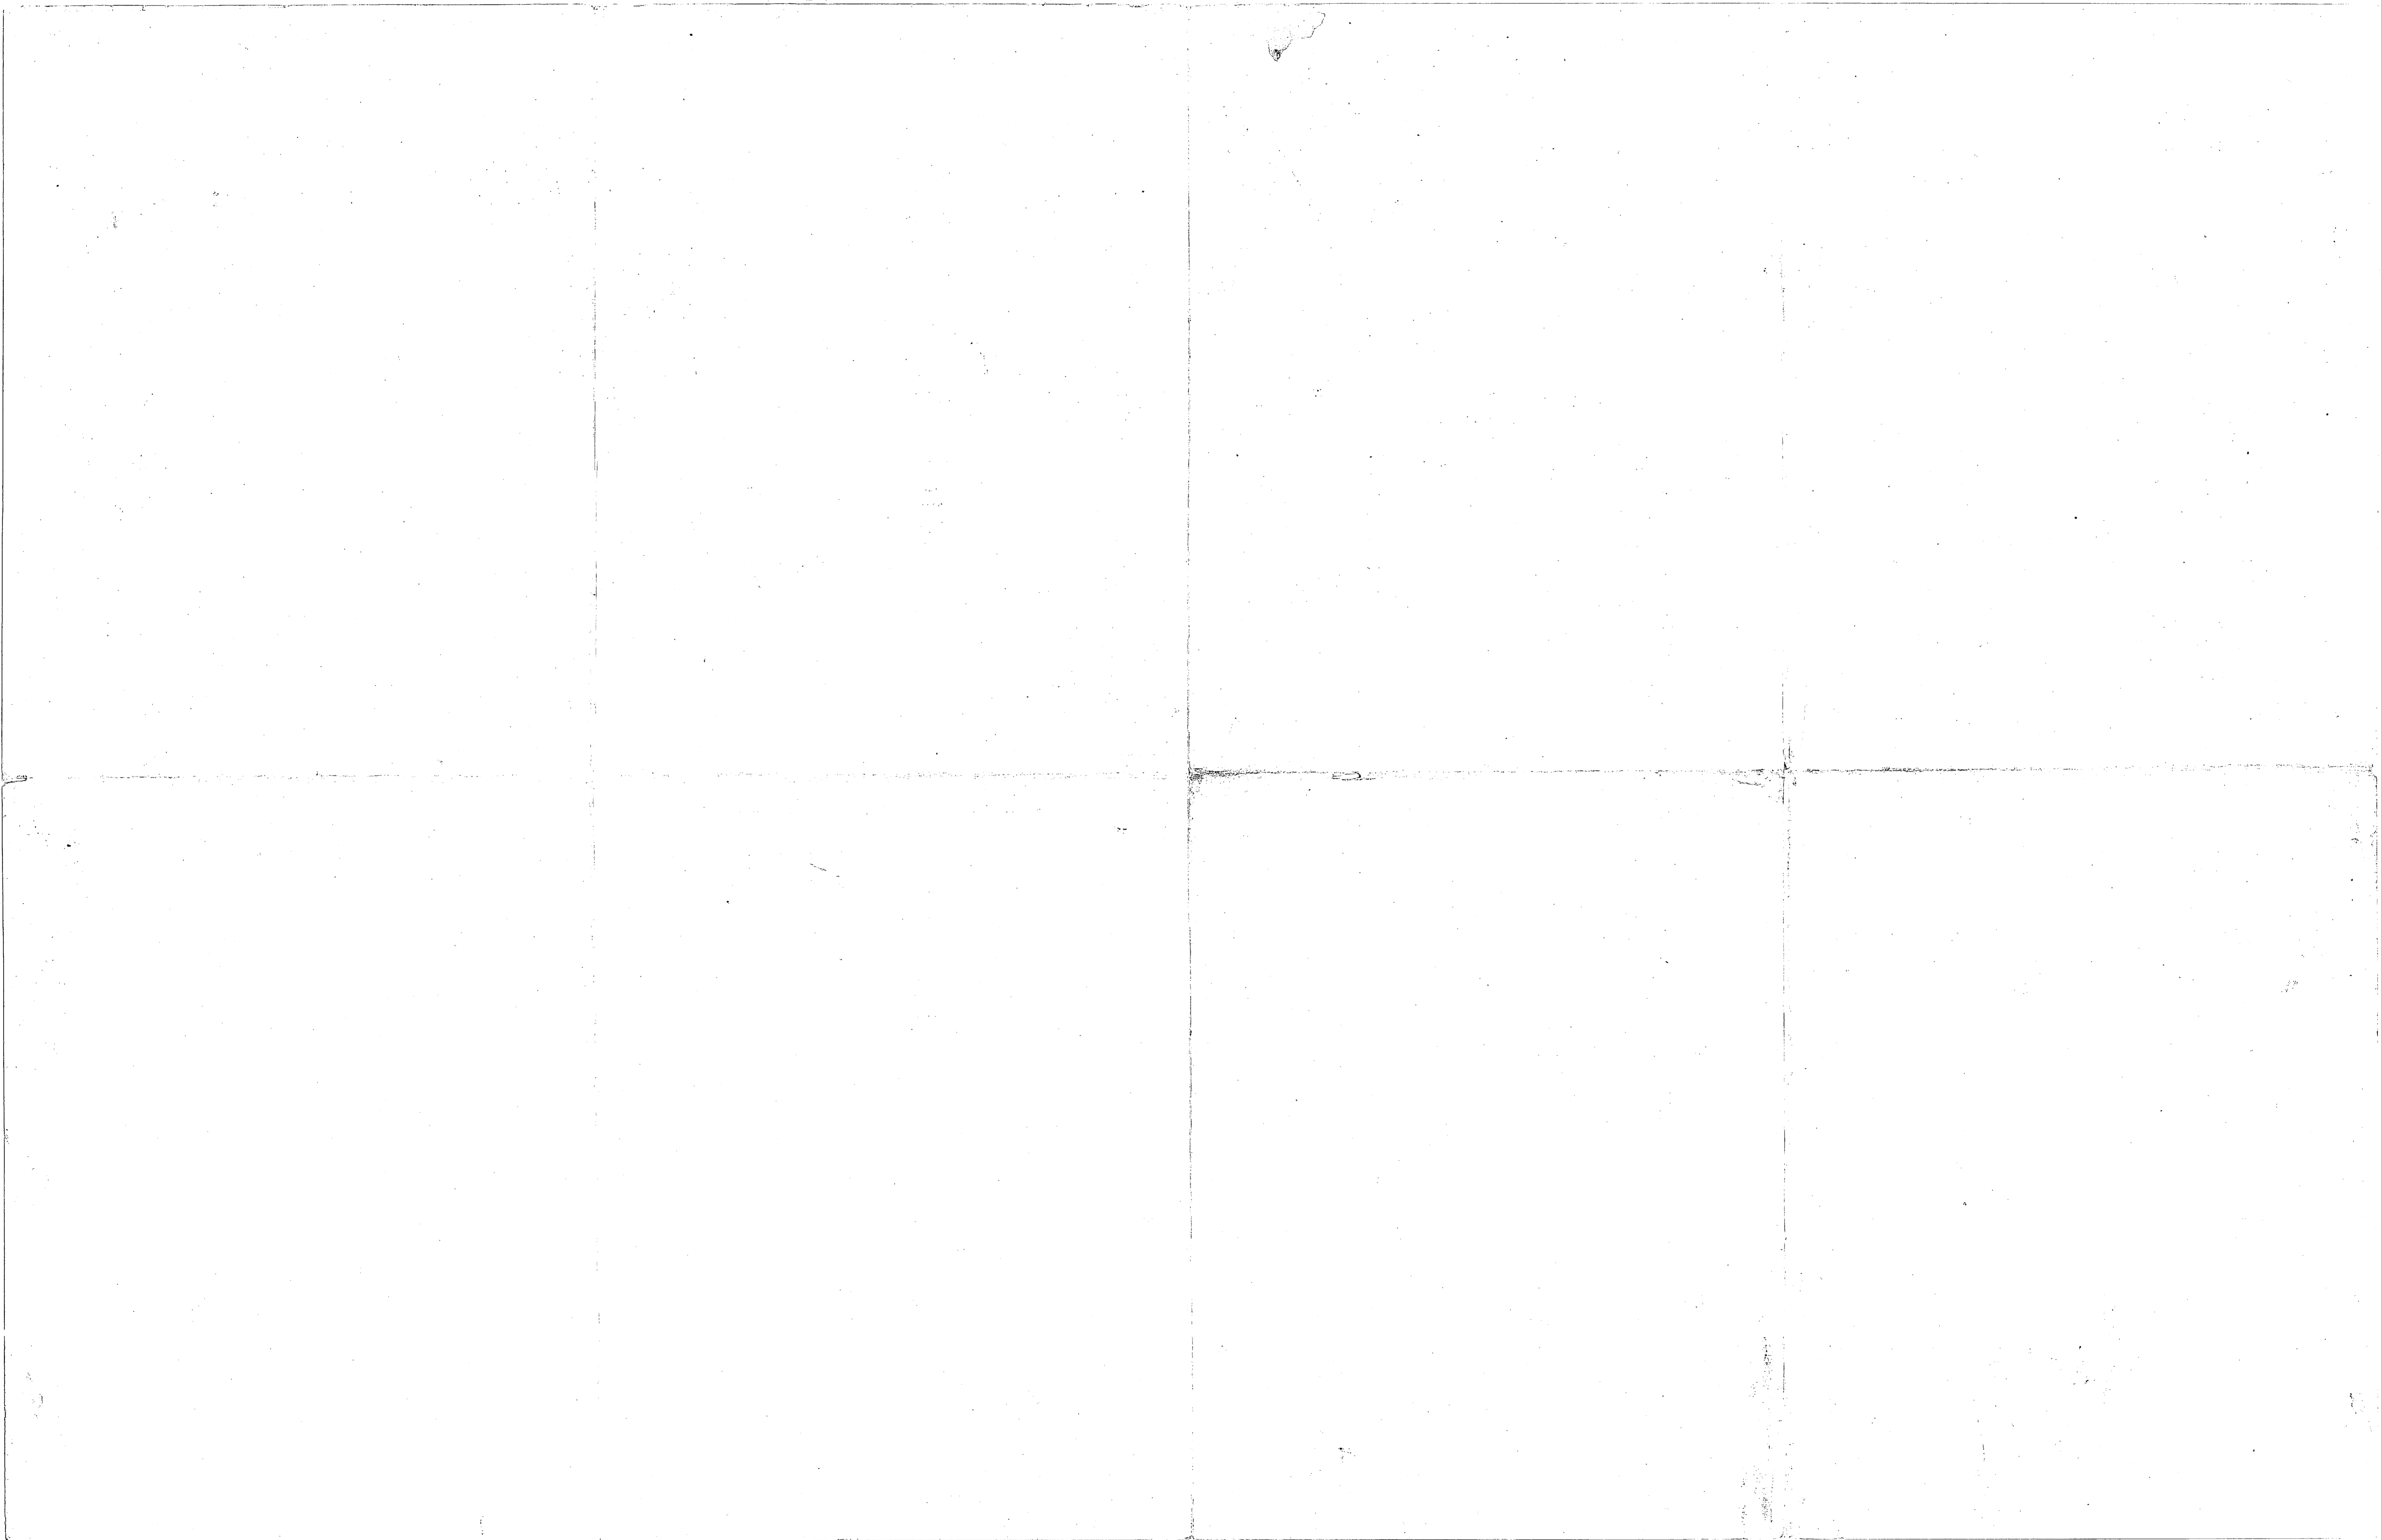

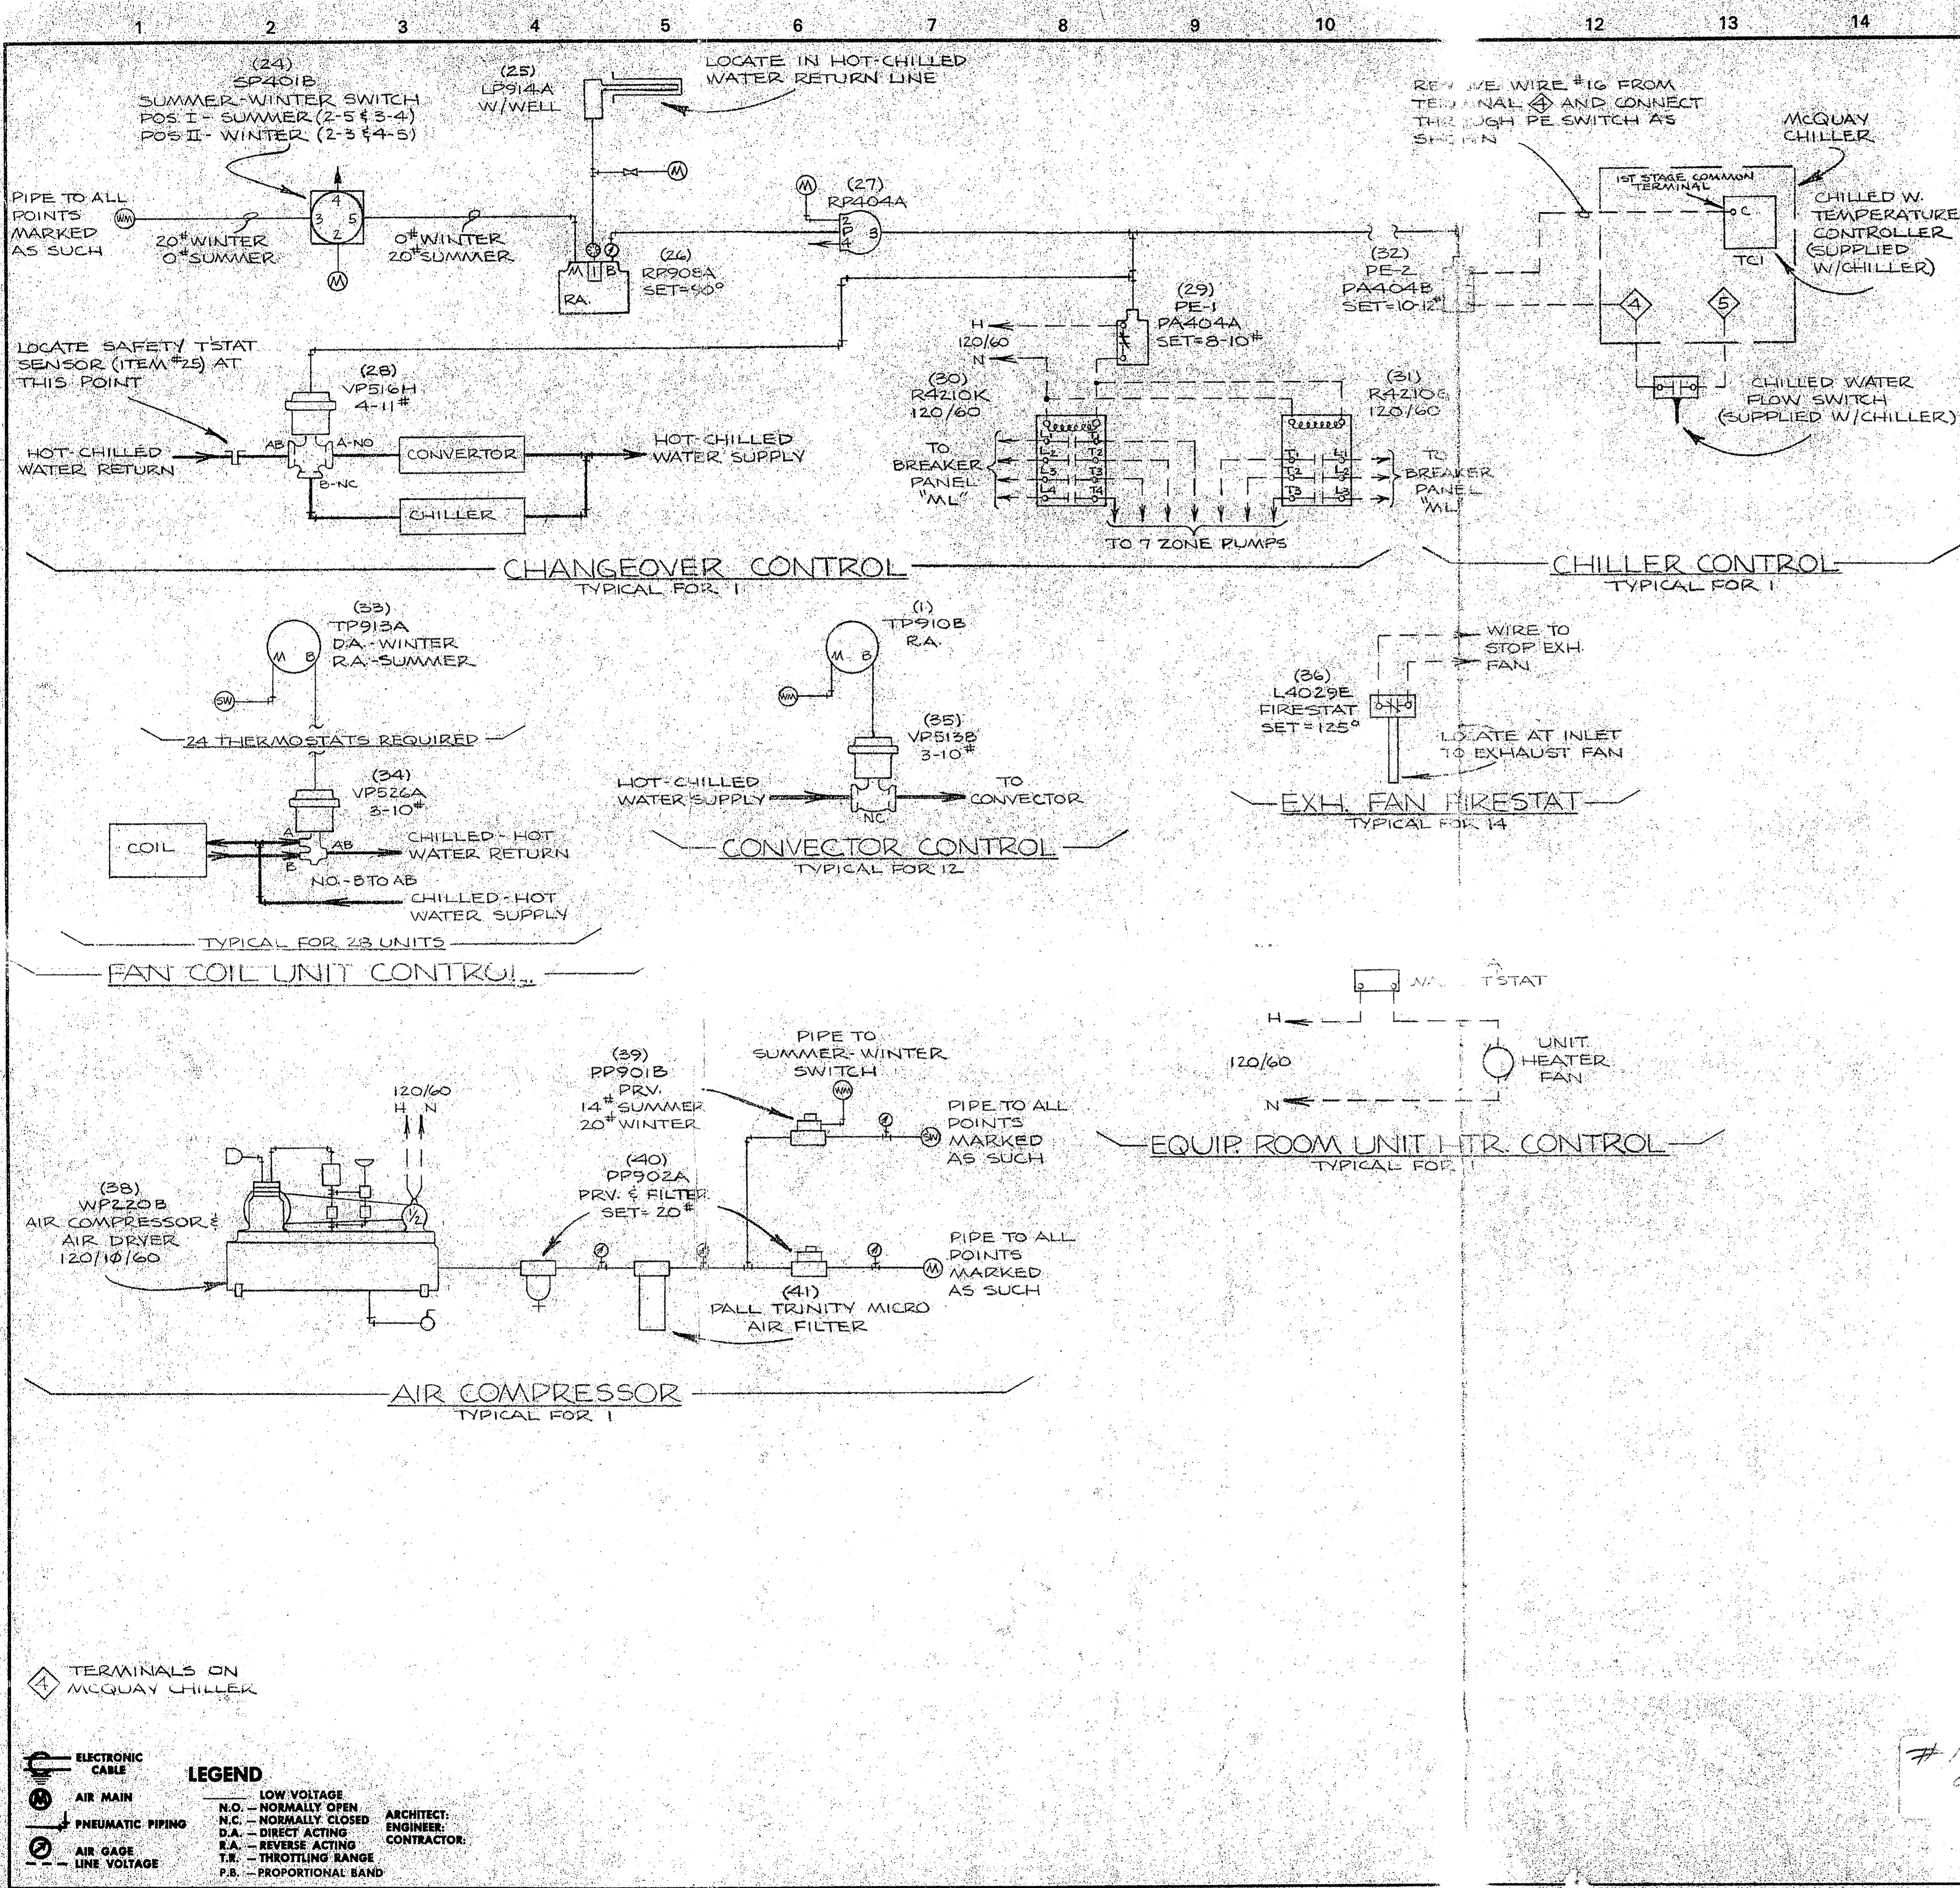

SEQUENCE OF OPERATIONS

H & V-1:
The unit fan is stopped and started manually from push button station (7). When the unit fan is running, RP-1 (3) is energized opening the outside air damper (4 & 4B). On unit fan shutdown RP-1 (3) is deenergized and the damper closes. A manually reset freeze stat (6) stops the unit fan if discharge air temperature from the coil becomes too low.

H & V-2:
When the system is indexed to "winter" operation, main air is supplied to room thermostat (1), allowing it to modulate valve (2) as required to maintain constant room temperature. When the system is indexed to "summer" operation, no air is supplied to room thermostat (1) and valve (2) remains closed. Sensor (5) transmits discharge air temperature to pneumatic temperature gage (6).

H & V-3:
The unit fan is stopped and started manually from push button station (7). When the unit fan is running, RP-1 (3) is energized opening the outside air damper (10). On unit fan shutdown, RP-1 (3) deenergizes closing the outside air damper. A manually reset freeze stat (8) stops the unit fan if discharge air temperature becomes too low.

CONVECTOR CONTROL:
When the system is indexed to "winter" operation, sensor (11) and controller (13) modulate steam valve (15) as required to maintain constant hot water supply temperature. Outside air sensor (16) resets the control point of controller (13) according to the schedule shown on the drawings.

DUCT COOLING COIL CONTROL:
When the system is indexed to "summer" operation and chilled water is available, sensor (5) and controller (22) modulate chilled water valve (23) as required to maintain constant discharge air temperature. On a rise in discharge air temperature, valve (23) opens to the coil. Pneumatic temperature gage (6) displays the coil discharge air temperature.

RADIANT HEAT ZONE CONTROL:
In each of the six dormitory heating zones, remote bulb sensor (19) and controller (20) modulate the zone heating valve (21) as required to maintain constant room temperature. In the Chapel heating zone, room t'stat (18) modulates the zone heating valve (21) as required to maintain constant room temperature. The zone pumps are stopped & started automatically, as described below in "Changeover Control."

FAN COIL UNIT CONTROL:
When the system is indexed to "winter" operation, room t'stat (33) is direct-acting. On a fall in room temperature (33) modulates the fan coil unit valve (34) opened to the coil.

CONVECTOR CONTROL:
When the system is indexed to "summer" operation, room t'stat (33) is reverse-acting. On a fall in room temperature t'stat (33) modulates the valve (34) closed to the coil.

CHANGEOVER CONTROL:
When summer-winter switch (24) is indexed to the "winter" position, main air is placed on the winter main "WM" allowing heating only portion of the control system to operate. At the same time, no air pressure is placed on the pilot port of relay (27) causing it to position so that the changeover valve (28) opens to the convector, PE-1 (29) closes to activate zone heating pumps (30 & 31), and PE-2 (32) opens to prevent the chiller from operating. When main air pressure is placed on the winter main "WM", dual pressure P.R.V. (39) supplies 20" main air pressure to the fan coil room t'stats (33) causing them to be direct-acting.

CHILLER CONTROL:
When the summer-winter switch (24) is placed in the "summer" position, air is exhausted from the winter main "WM", causing the heating only portion of the system to become inoperative. At the same time, main air pressure is placed on the pilot port of relay (27), causing it to position so that changeover valve (28) opens to the chiller, PE-1 (29) opens deenergizing the zone heating pumps, and PE-2 (32) closes to activate the chiller. When main air is exhausted from the winter main "WM", dual pressure P.R.V. (39) is positioned so that 14" main air is supplied to the fan coil room t'stats (33) causing them to be reverse-acting.

EXHAUST FAN FIRESTAT:
A manually reset firestat (36) stops the exhaust fan if inlet air temperature becomes too high.

EQUIPMENT ROOM UNIT HEATER CONTROL:
A room thermostat (37) cycles the unit heater fan as required to maintain constant space temperature.

WATER VALVE SCHEDULE

LOCATION	GPM	Cv	SIZE	VALVE NUMBER	OPERATOR NO.
Duct Cooling Coil 15		16	1 1/2"	V5013A1047	MP95301026
Radiant Heat:					
Zone #1	6.6	6.3	3/4"	V5013A1021	MP95301026
Zone #2	8.6	6.3	3/4"	V5013A1021	MP95301026
Zone #3	3.8	6.3	3/4"	V5013A1021	MP95301026
Zone #4	6.6	10.0	1"	V5013A1039	MP95301026
Zone #5	6.6	10.0	1"	V5013A1039	MP95301026
Zone #6	10.6	16.0	1 1/2"	V5013A1047	MP95301026
Zone #7	8.9	16.0	1 1/2"	V5013A1047	MP95301026
Fan Coil Units:					
"A" (14 Req.)	1.0	1.0	1/2"	VP526A1068	
"B"	1.5	1.0	1/2"	VP526A1068	
"C"	2.5	1.0	1/2"	VP526A1068	
"D" (2 Req.)	1.5	1.0	1/2"	VP526A1068	
"E"	1.5	1.0	1/2"	VP526A1068	
"F"	4.0	1.6	1/2"	VP526A1076	
"H" (4 Req.)	2.0	1.0	1/2"	VP526A1068	
"I"	2.0	1.0	1/2"	VP526A1068	
"J"	2.0	1.0	1/2"	VP526A1068	
"K"	2.0	1.0	1/2"	VP526A1068	
Changeover	54	63	2 1/2"	V5013C1001	MP95301083

LEGEND

ELECTRONIC CABLE

AIR MAIN

PNEUMATIC PIPING

AIR GAGE

LINE VOLTAGE

LOW VOLTAGE

N.O. - NORMALLY OPEN
N.C. - NORMALLY CLOSED
D.A. - DIRECT ACTING
R.A. - REVERSE ACTING
T.R. - THROTTLING RANGE
P.B. - PROPORTIONAL BAND

ARCHITECT:
ENGINEER:
CONTRACTOR:

#1041
OLD PART

2410 DUNAVANT ST, CHARLOTTE, NC.

BRIG CAMP LEJEUNE
JACKSONVILLE, NC.

Revisions: _____ Date: _____ Appd: _____

Supersedes: _____ Drawn By: K.T.J. Date: 11-26-67

Superseded by: _____ Approved By: R.W. SHEET: 2 OF 2 DRAWING NUMBER: 939-67074-2XI

HONEYWELL, INC.

AIR DIAGRAM


1041
066

1041
67
1041


AIR CONTROL
010 part

1041
PTO


REV	DESCRIPTION
△ REV AS-BUILT	

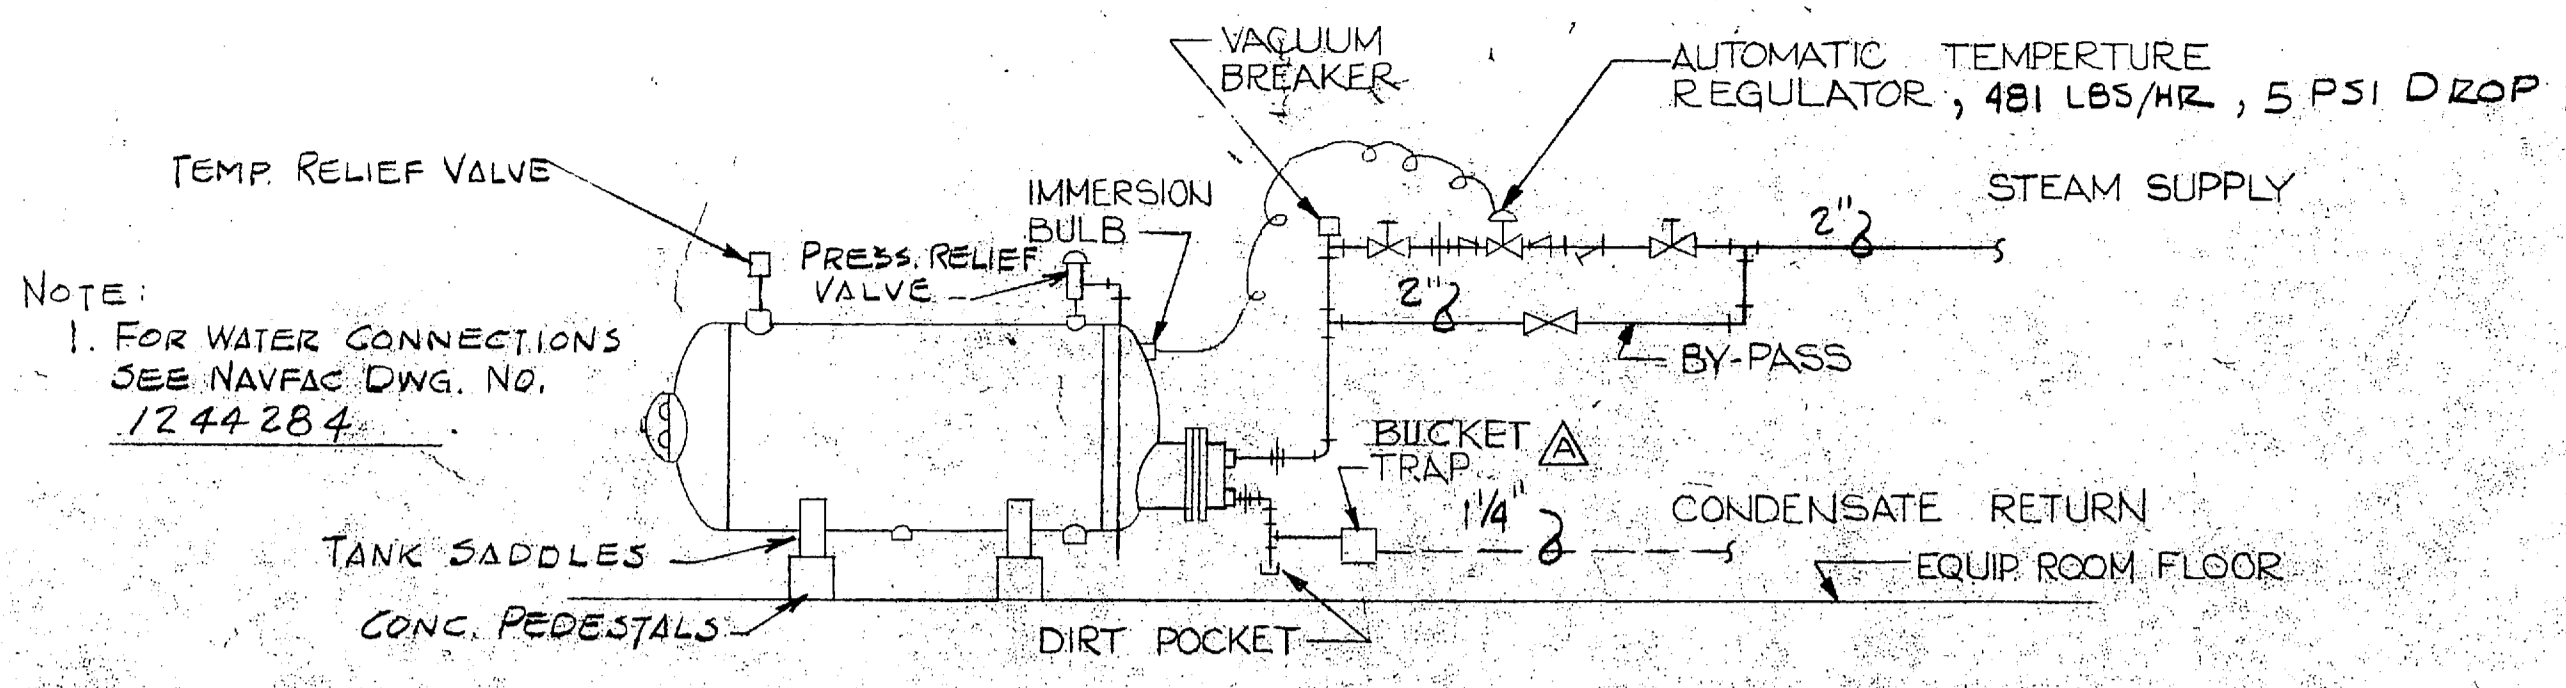

WATER HEATER STEAM CONNECTION DETAIL
NO SCALE

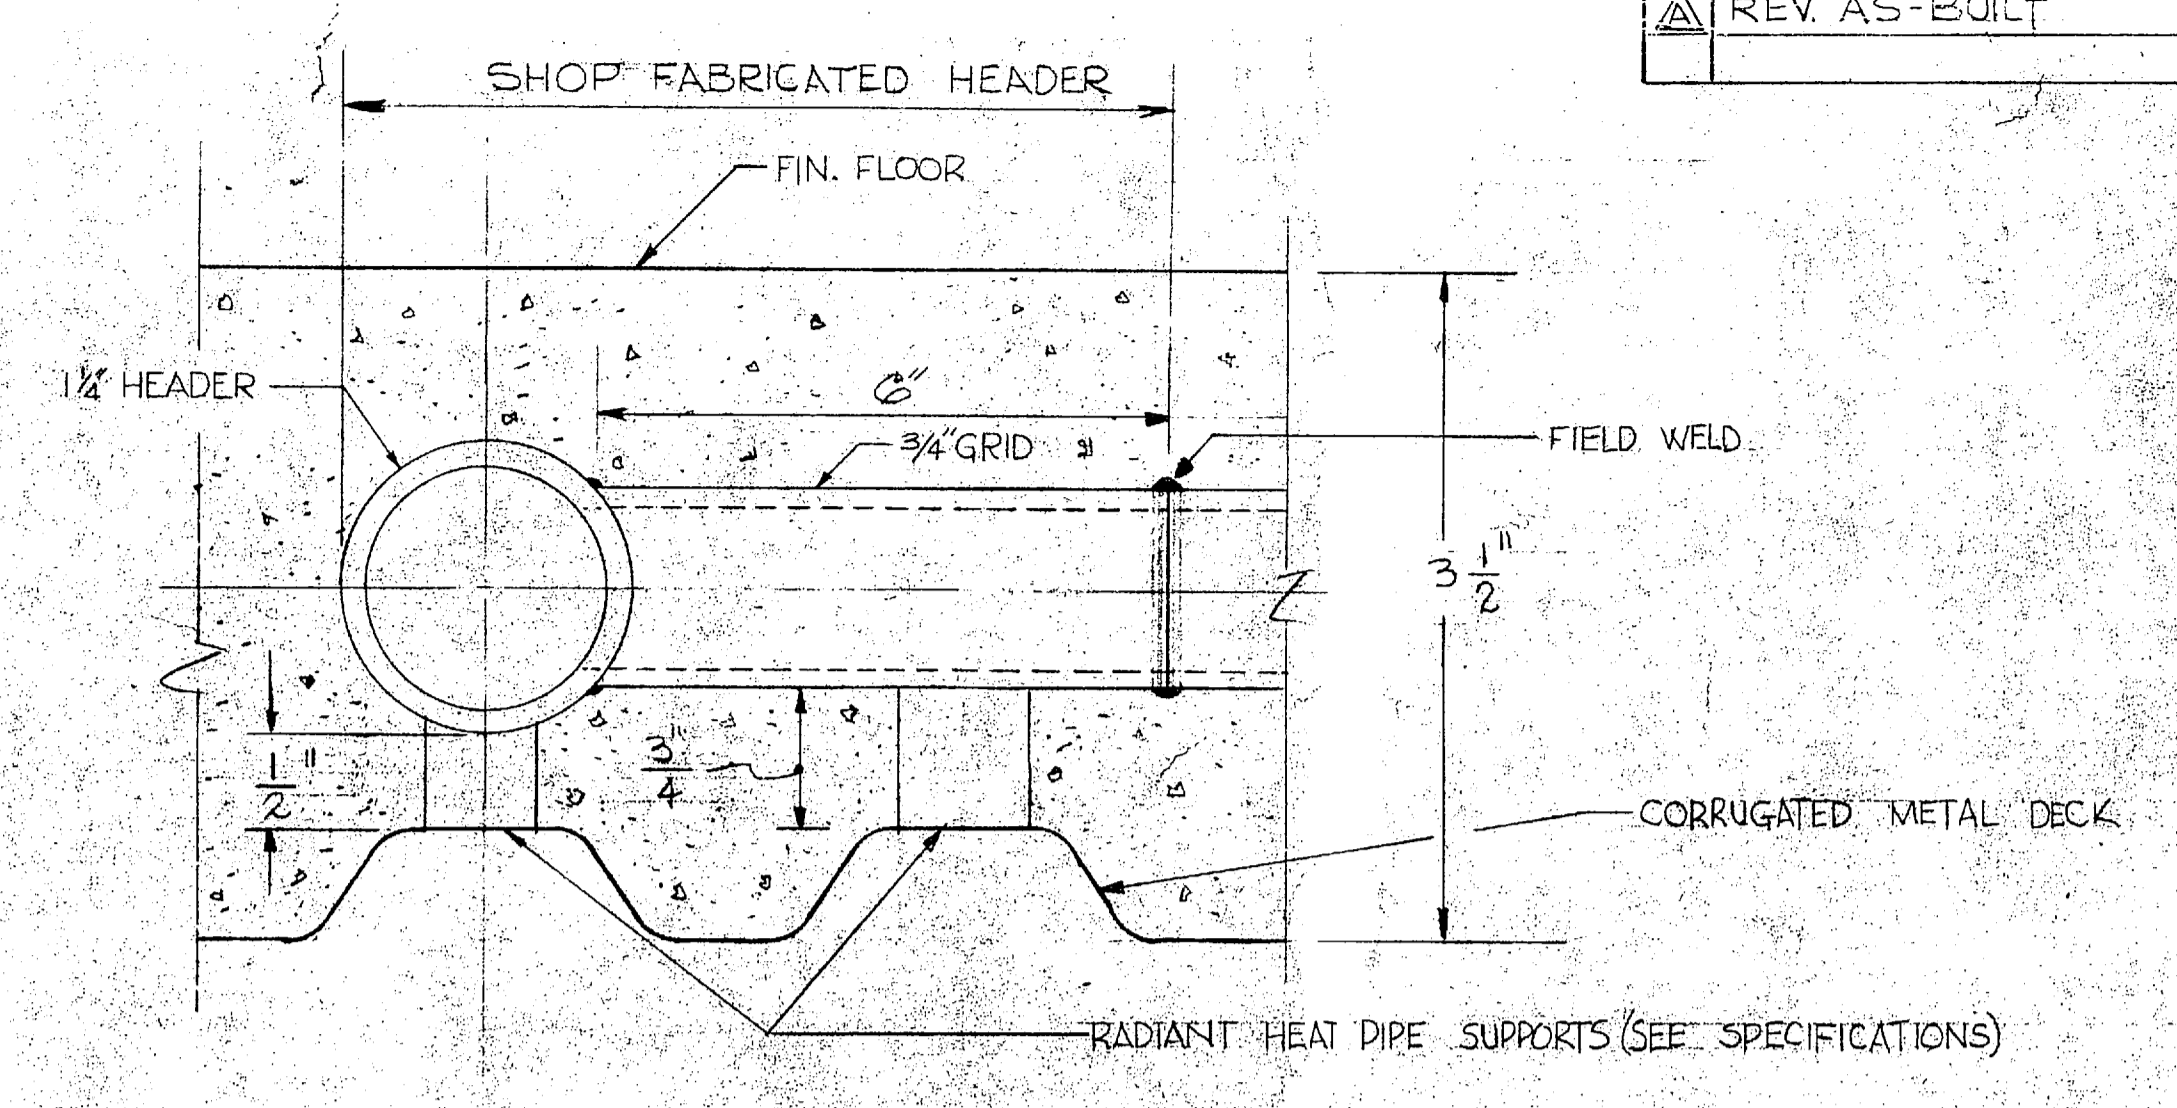


DETAIL OF RADIANT HEAT PIPE IN FLOOR SLAB
SCALE: 1" = 0'-1"

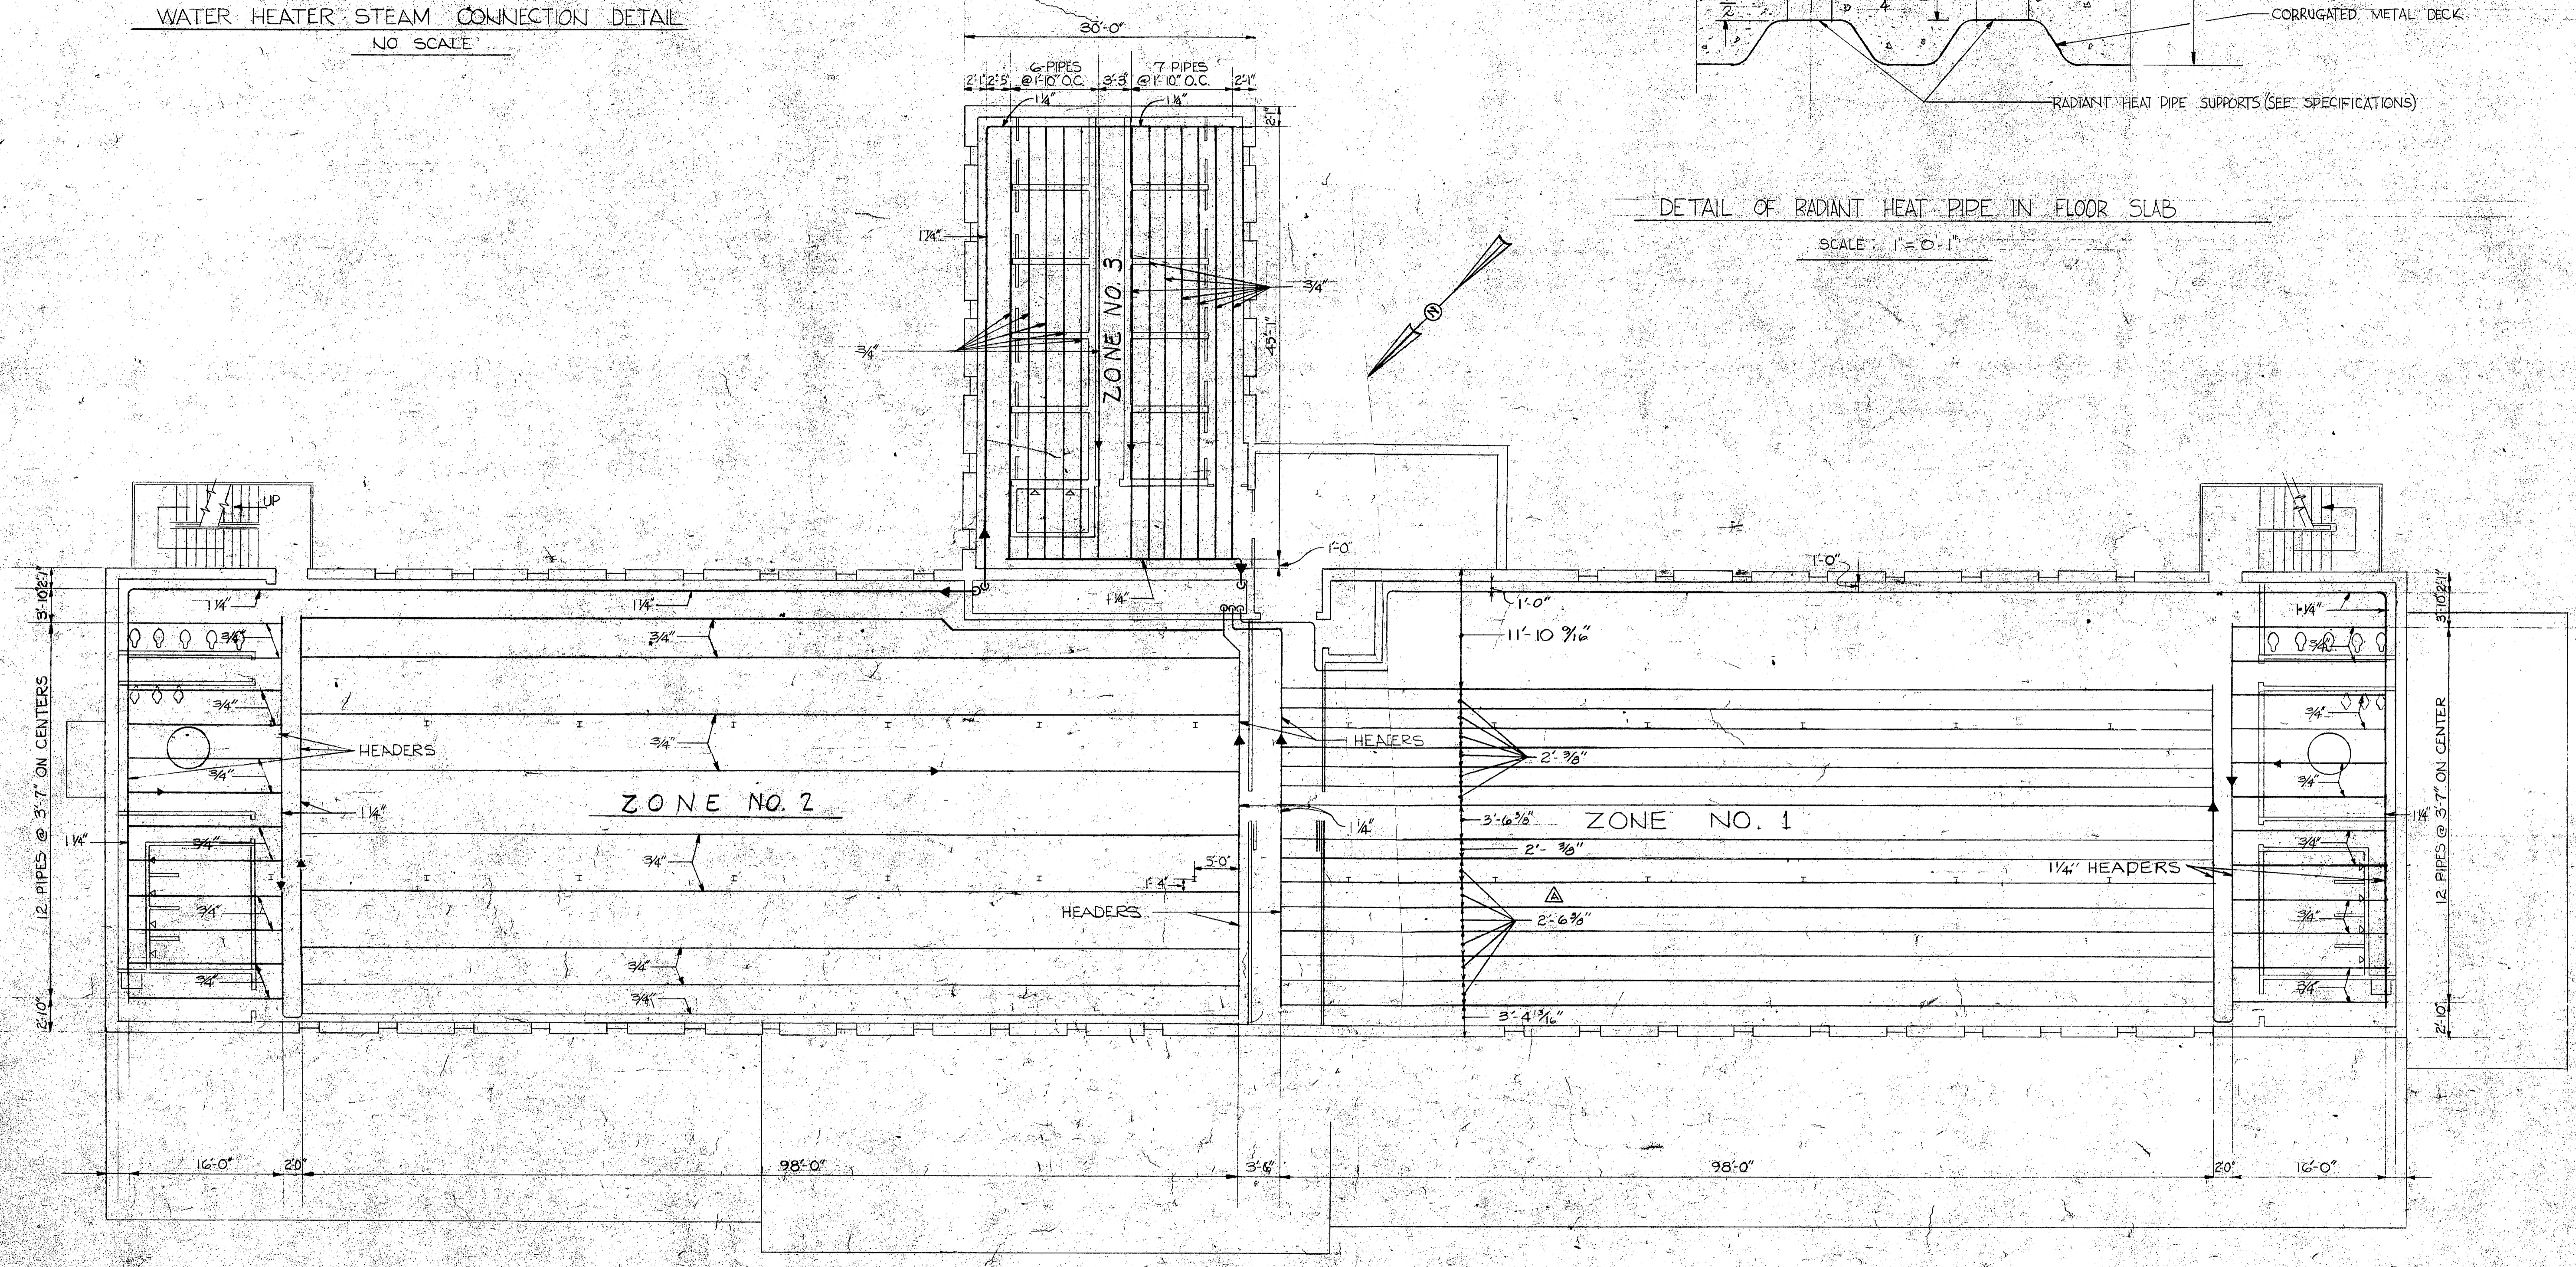

SECOND FLOOR PLAN RADIANT HEATING
SCALE 1/8" = 1'-0"

Blot 1041 SHH

RECORD DRAWING
LETTERHEAD 24 JUN 1960

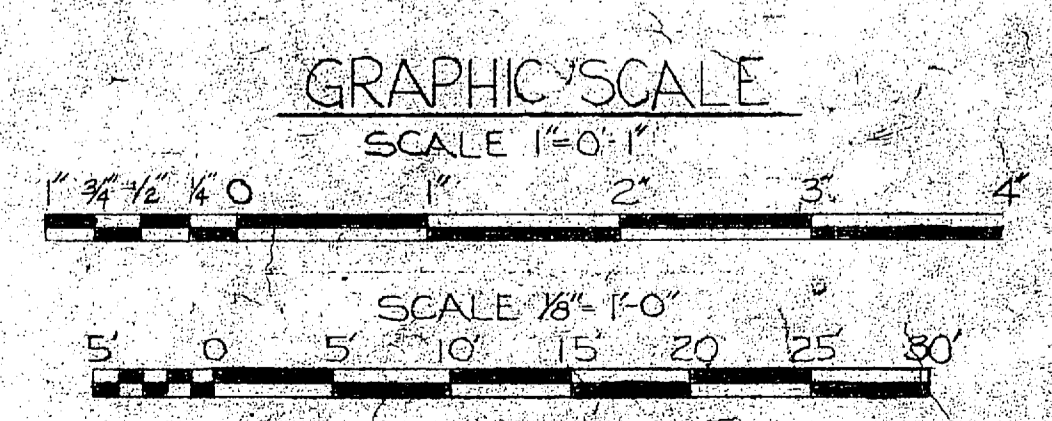

- NOTE:
1. FOR LEGEND SEE NAVFAC DWG. NO. 1244 296
2. FOR THERMOSTAT LOCATION SEE NAVFAC DWG. NO. 1244 292


EFD DWG. NO. 77289	DEPARTMENT OF THE NAVY - NAVAL FACILITIES ENGINEERING COMMAND
WORK REQ. NO. 60-322	ATLANTIC DIVISION
DES. BROWN	NAVAL STATION NORFOLK, VA.
DRWN. KERN	MARINE CORPS BASE CAMP LEJEUNE, N.C.
TR.	BRIG
CHK. <i>Venkus</i>	MECHANICAL
BR. MGR. <i>Brink</i>	2ND FLOOR HEATING PLAN & DETS.
DES. DIR. <i>J. Davis</i>	
SATISFACTORY TO DATE	
APPROVED DATE <i>J. Davis</i>	NAVFAC DRAWING NO. 1244289
FOR EFC FOR COMMANDER USE	CONST. CONTR. NO. N62470-B-67-0741
	SCALE GRAPHIC: 5/8" = 1'-0" 1/4" = 1'-0" 1/8" = 1'-0" SHEET 41 OF 61

Four Piping
Bids 1041


1041
MECHANICAL

FLOAT TYPE AUTOMATIC AIR VENT FOR LOCATION OF AUTOMATIC AIR VENTS SEE NAVFAC DWG. NO. 1244291.


1/8" PETCOCK

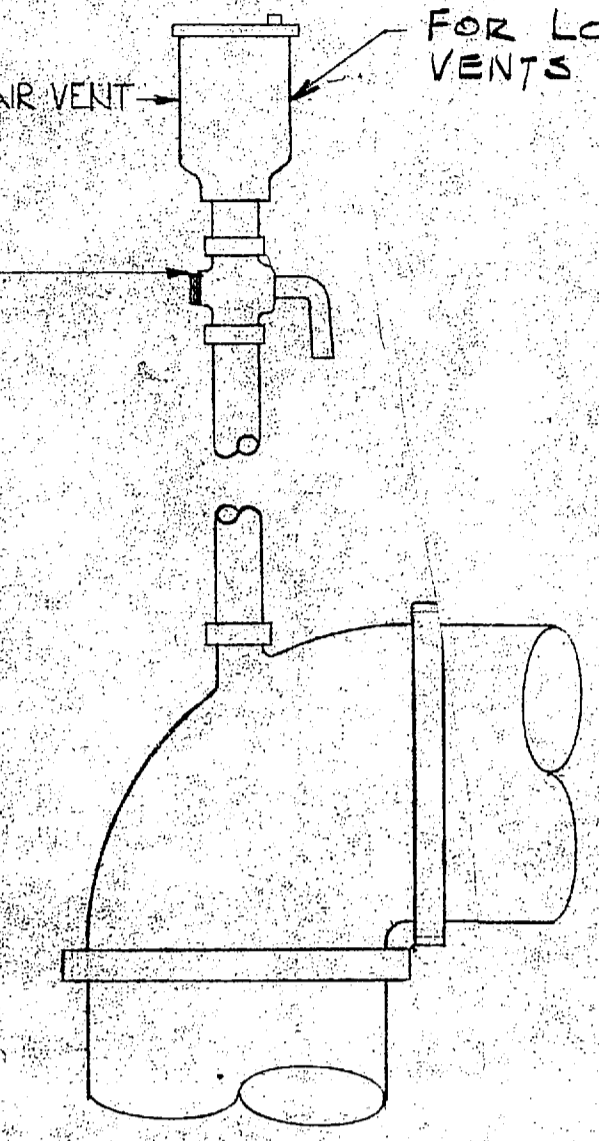

RADIANT HEAT AIR VENT DETAIL NO SCALE

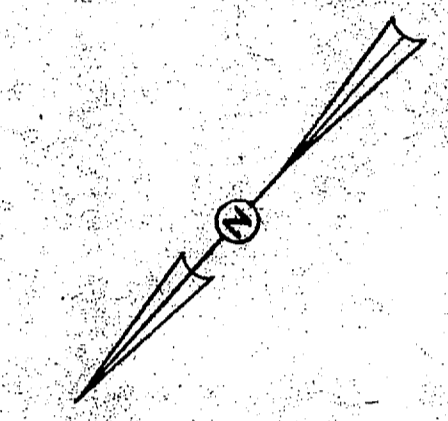

RUN ABOVE 2ND FLOOR SUSPENDED CEILING

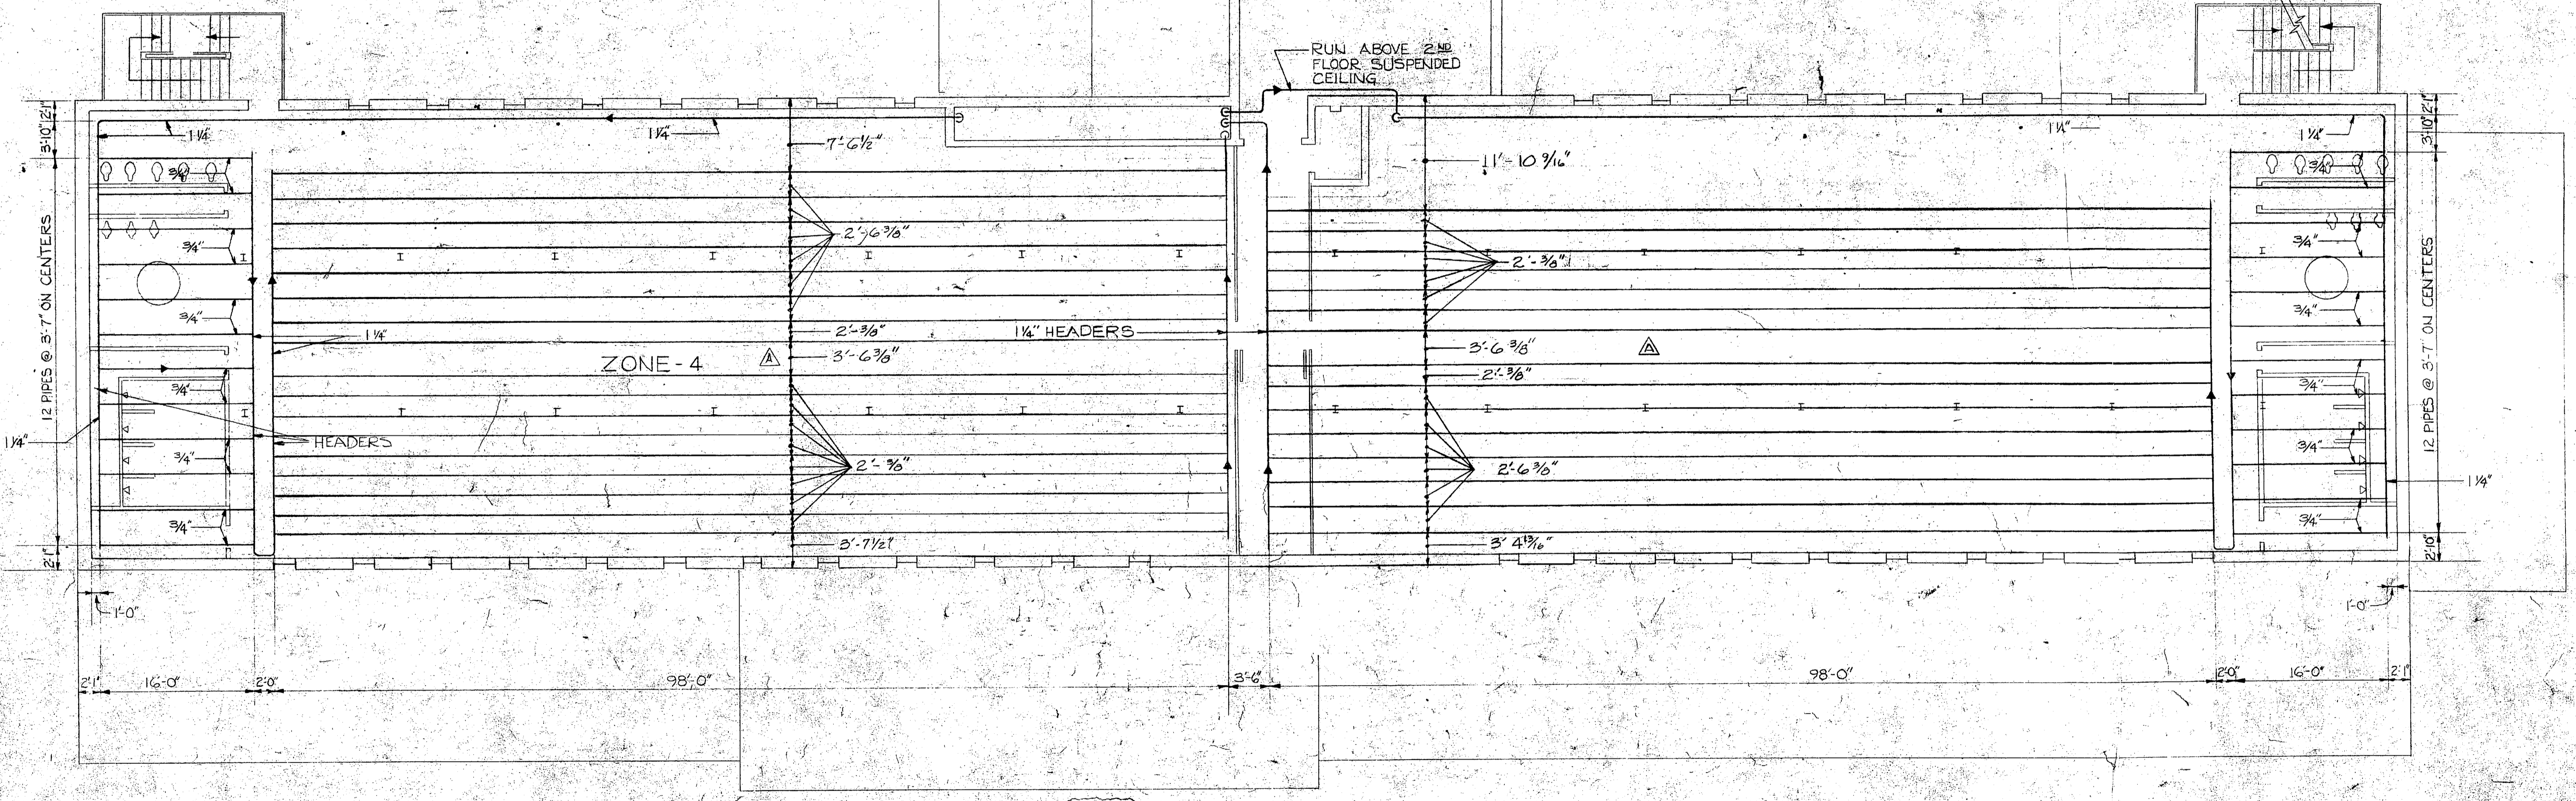


THIRD FLOOR PLAN - RADIANT HEATING SCALE 1/8" = 1'-0"

Block 11.41 5448


- NOTE:
1. FOR LEGEND SEE NAVFAC DWG. NO. 1244290.
 2. FOR THERMOSTAT LOCATION SEE NAVFAC DWG. NO. 1244292.

RECORD DRAWING LETTER DATED 24 JUN 1969

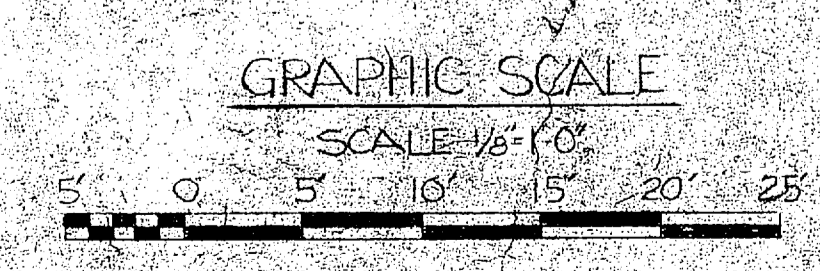


EPD DWG. NO. 77290	DEPARTMENT OF THE NAVY NAVAL FACILITIES ENGINEERING COMMAND
WORK REQ. NO. 66-322	ATLANTIC DIVISION
DES. BROWN	NAVAL STATION NORFOLK, VA
DRWN. KERN	MARINE CORPS BASE CAMP LEJEUNE, N.C.
TR.	BRIG
CHK. <i>[Signature]</i>	MECHANICAL
BR. MOR. <i>[Signature]</i>	3RD FLOOR HEATING - PLAN & DET'S
DES. DIR. <i>[Signature]</i>	
SATISFACTORY TO DATE	
APPROVED <i>[Signature]</i> DATE 18/15/67	SITE CODE IDENT. NO. 80091
FOR SIGNED FOR COMMANDER USE	ENGINE CONTR. NO. N62470-67-B-074
	NAVFAC DRAWING NO. 1244290
	SHEET GRAPHIC SPEC. 5/22/67 REV. 31927 SHEET 42 OF 61

Bldg # 1041
Heat in floor

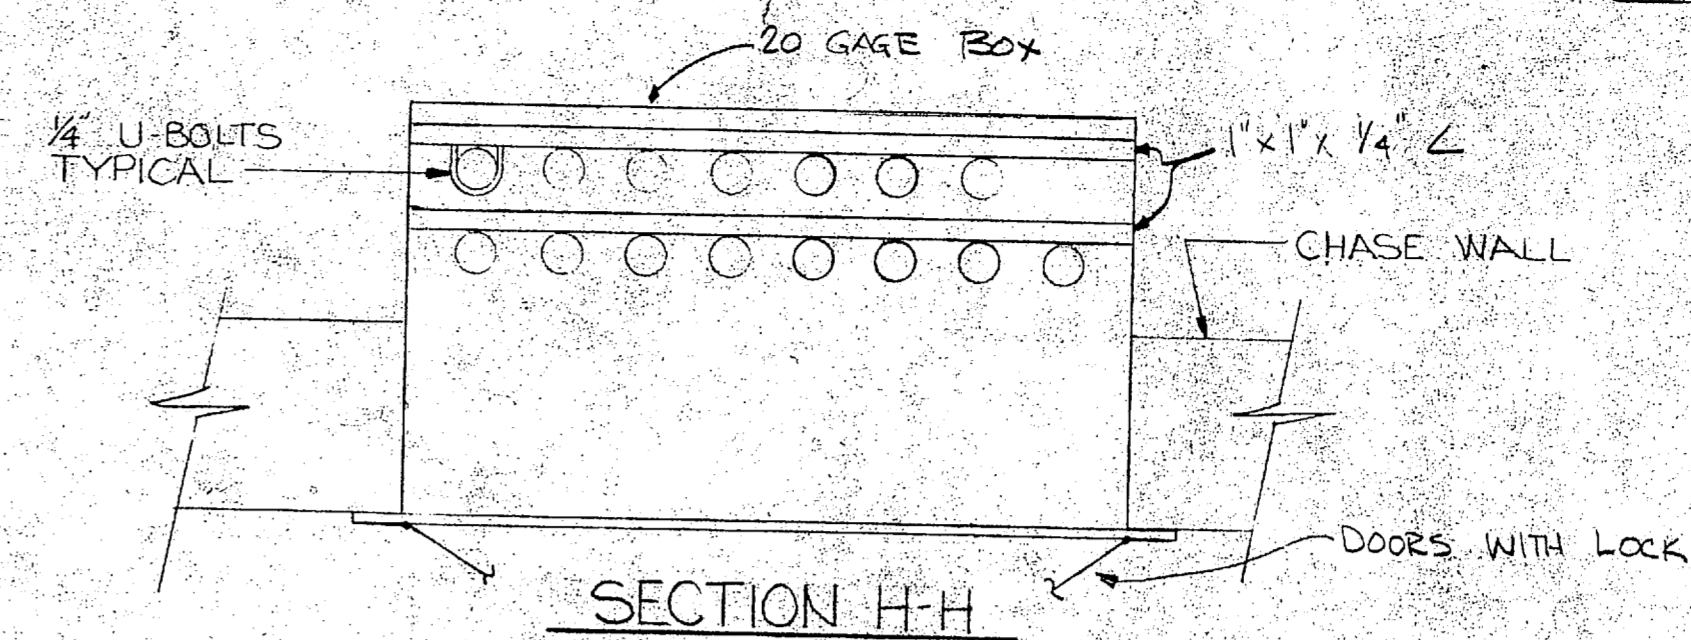

1/8\"/>

DETAIL - AUTOMATIC AIR VENT ACCESS BOX
SCALE 1/2\"/>

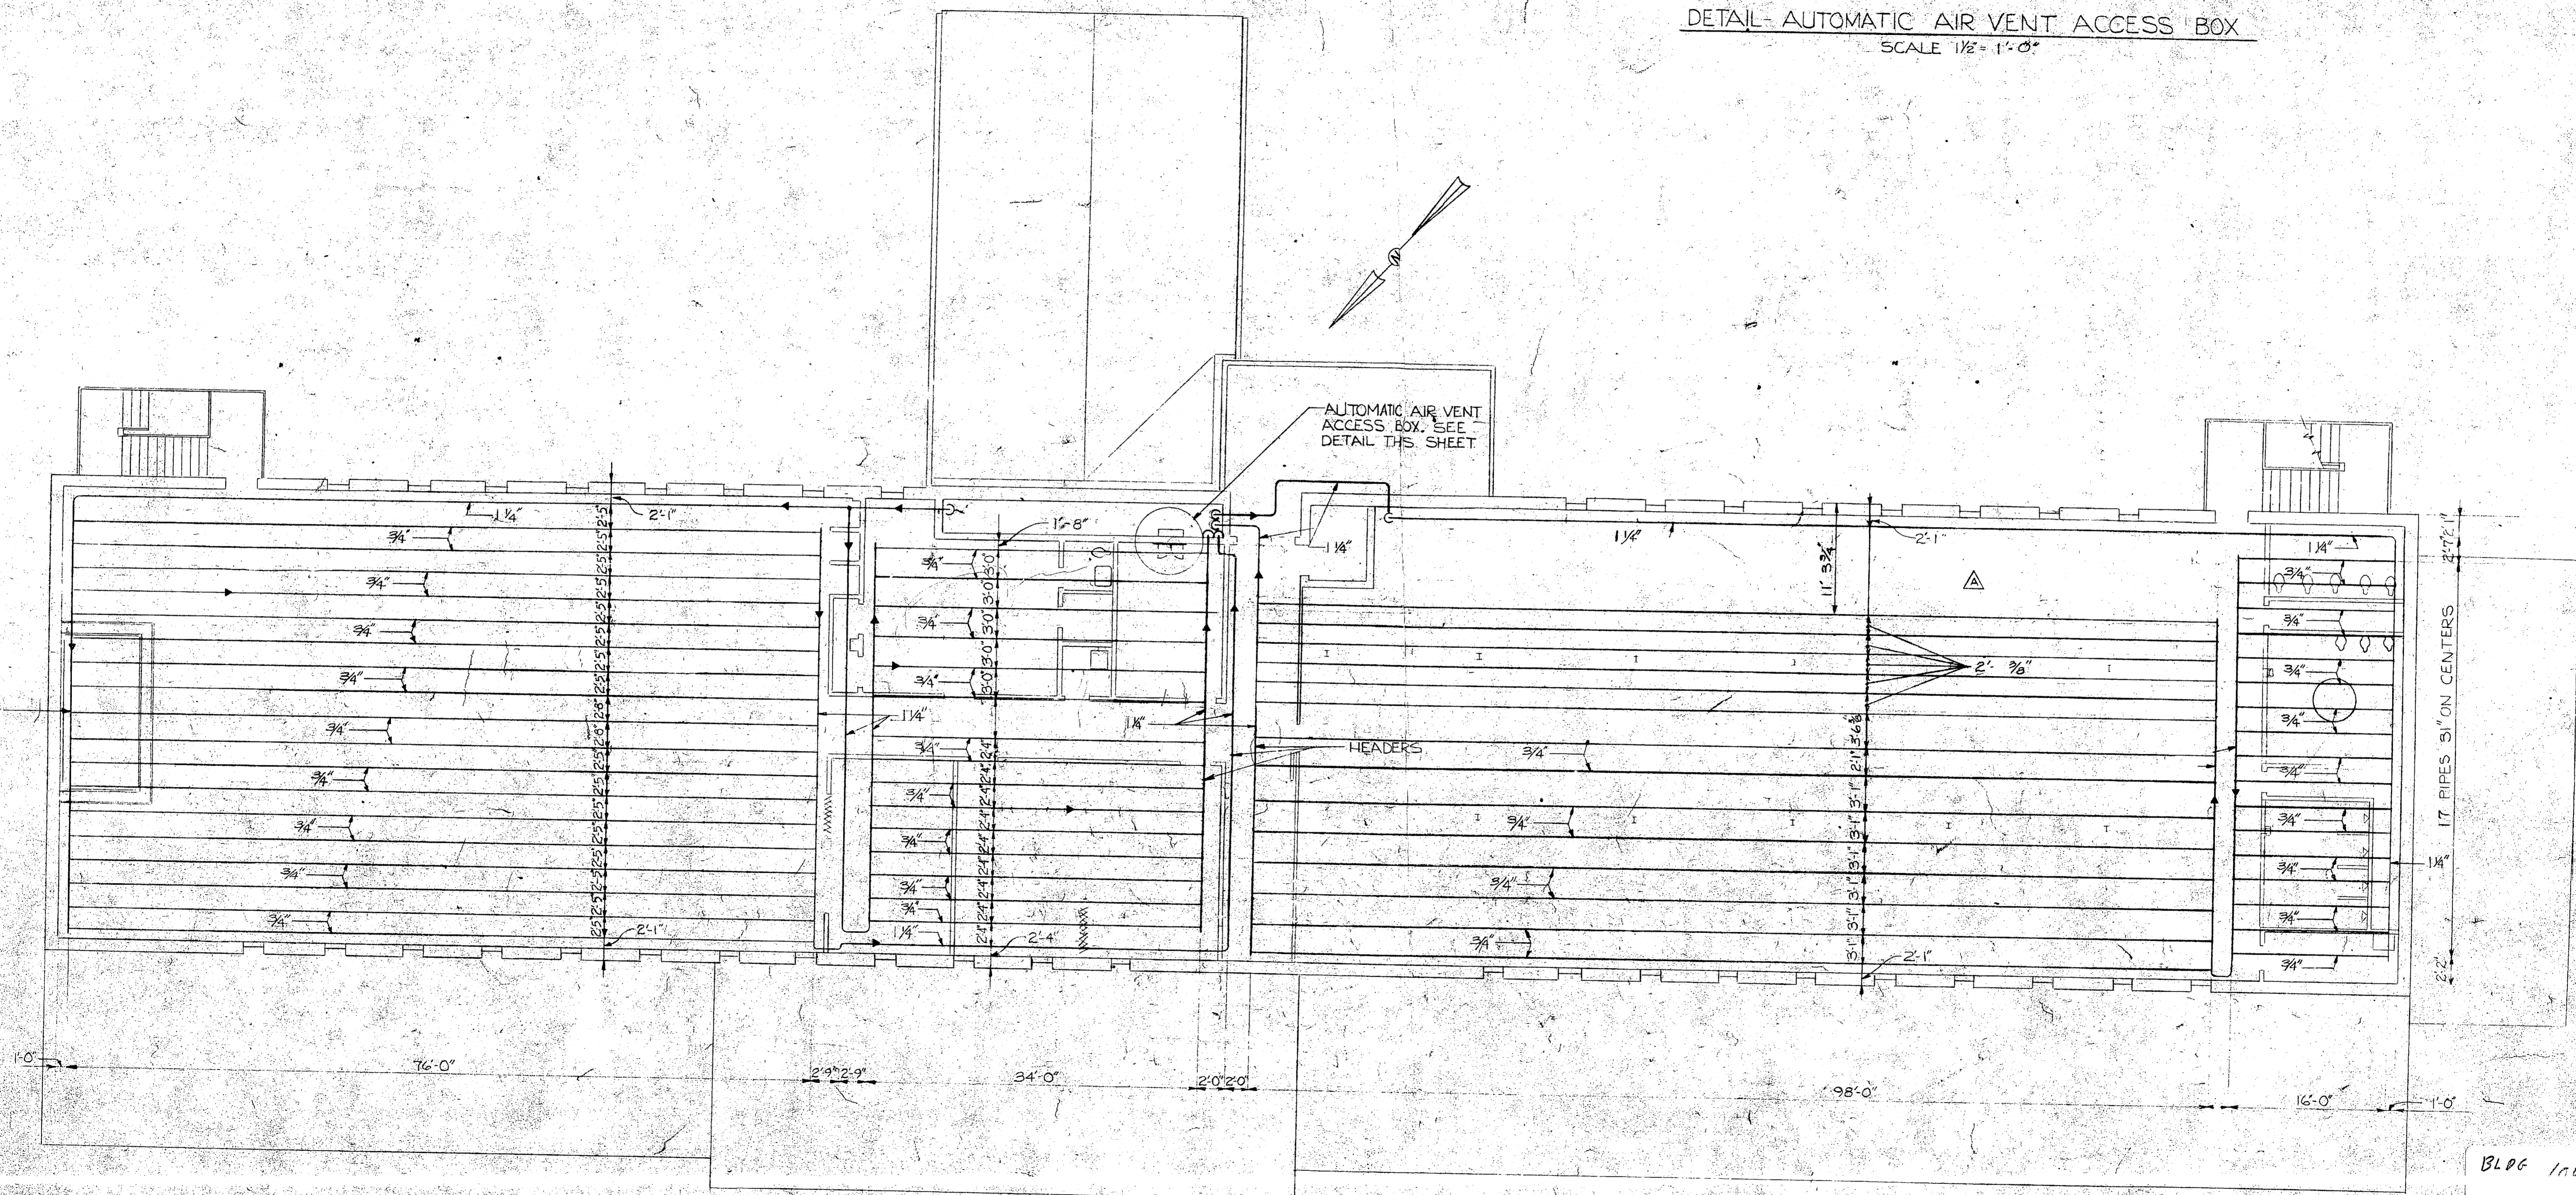


BLDG 1001 5110

RECORD DRAWING
LETTER DATED 24 JUN 1989

- NOTE
- FOR LEGEND SEE NAVFAC DWG. NO. 1244-293
 - FOR THERMOSTAT LOCATION SEE NAVFAC DWG. NO. 1244-292

FOURTH FLOOR PLAN RADIANT HEATING
SCALE 1/8\"/>

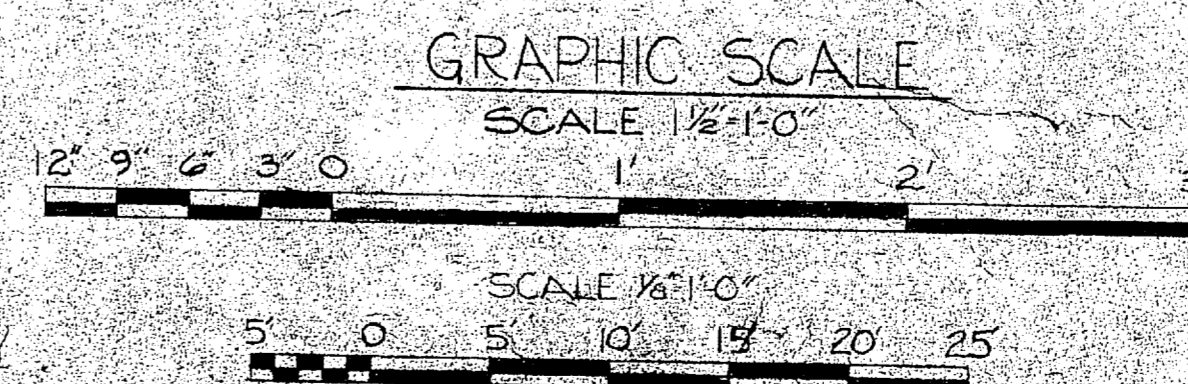

EPD DWG. NO. 11291	DEPARTMENT OF THE NAVY - NAVAL FACILITIES ENGINEERING COMMAND
WORK REQ. NO. 66-322	ATLANTIC DIVISION
DES. BROWN	NAVAL STATION NORFOLK VA.
DRWN KERN	MARINE CORPS BASE CAMP LEJEUNE, NC
TR.	BRIG
CHK. <i>[Signature]</i>	MECHANICAL
BR. MGR. <i>[Signature]</i>	4TH FLOOR HEATING - PLAN & DETS
DES. DIR. <i>[Signature]</i>	DATE
SATISFACTORY TO	DATE
APPROVED	DATE
FOR COMMANDER	DATE
SIZE	CODE IDENT. NO.
F	80091
NAVFAC DRAWING NO.	1244-291
QUANTITY	162410-67-1B-074
SCALE GRAPHIC	SPR81927/1709 81927
SHEET	43 OF 61



