




REVISIONS		
SYM	DESCRIPTION	DATE APPROVED
	REVISED AS-BUILT	1/24/82 C.S.

PAVEMENT MILLING REQUIRED *(COMPLETED)

STREET NAME	LINEAR FEET
AGANA PL.	935
BOUGAINVILLE BLVD.	15,673
CHOSIN CIR.	2,555
GARAPAN PL.	850
GUAM DR.	4,030
HAGARU DR.	6,845
HUNGNAM PL.	865
INCHON ST.	1,000
IWO JIMA BLVD.	7,500
MUNDA PL.	855
RENDOVA PL.	995
SAIPAN DR.	5,255
TARAWA BLVD.	13,670
TULAGI PL.	715

NOTE: PAVEMENT MILLING IS CONTINUOUS THE ENTIRE LENGTH AND INCLUDES BOTH EDGES OF ROADS LISTED ON THIS SHEET. FOR DETAILS SEE SHEET C-27.

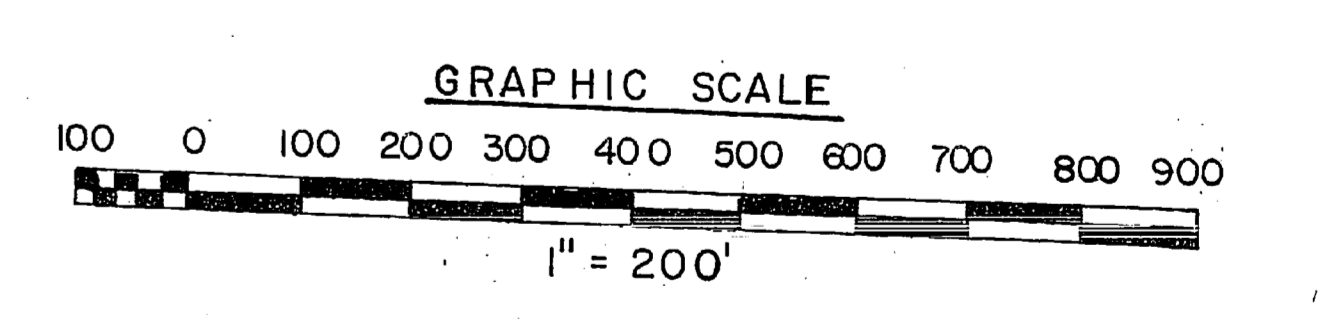

TARAWA TERRACE II
GENERAL SITE PLAN
SCALE: 1" = 200'


RECORD DRAWING
LETTER DATED JAN 24 1982


MCKIM & CREED ENGINEERS
WILMINGTON, N.C. AT

DES: SNEED DR. GULLY CHR. MCKIM
PROJ. MGR. CH. ENG.
SUBMITTED BY: T.M. MCKIM DATE: 9/26/82
FIELD ENGINEER RVD. PRINCIPAL
EFD: FP. JOR RVD. CHIEF
APPROVED: [Signature] DATE: 1/24/82
BY: [Signature] DATE: 1/24/82

DEPARTMENT OF THE NAVAL STA



F 8

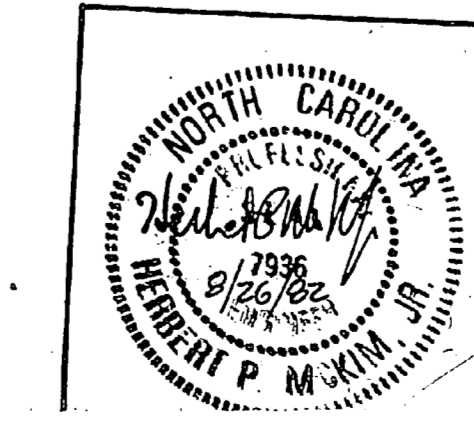

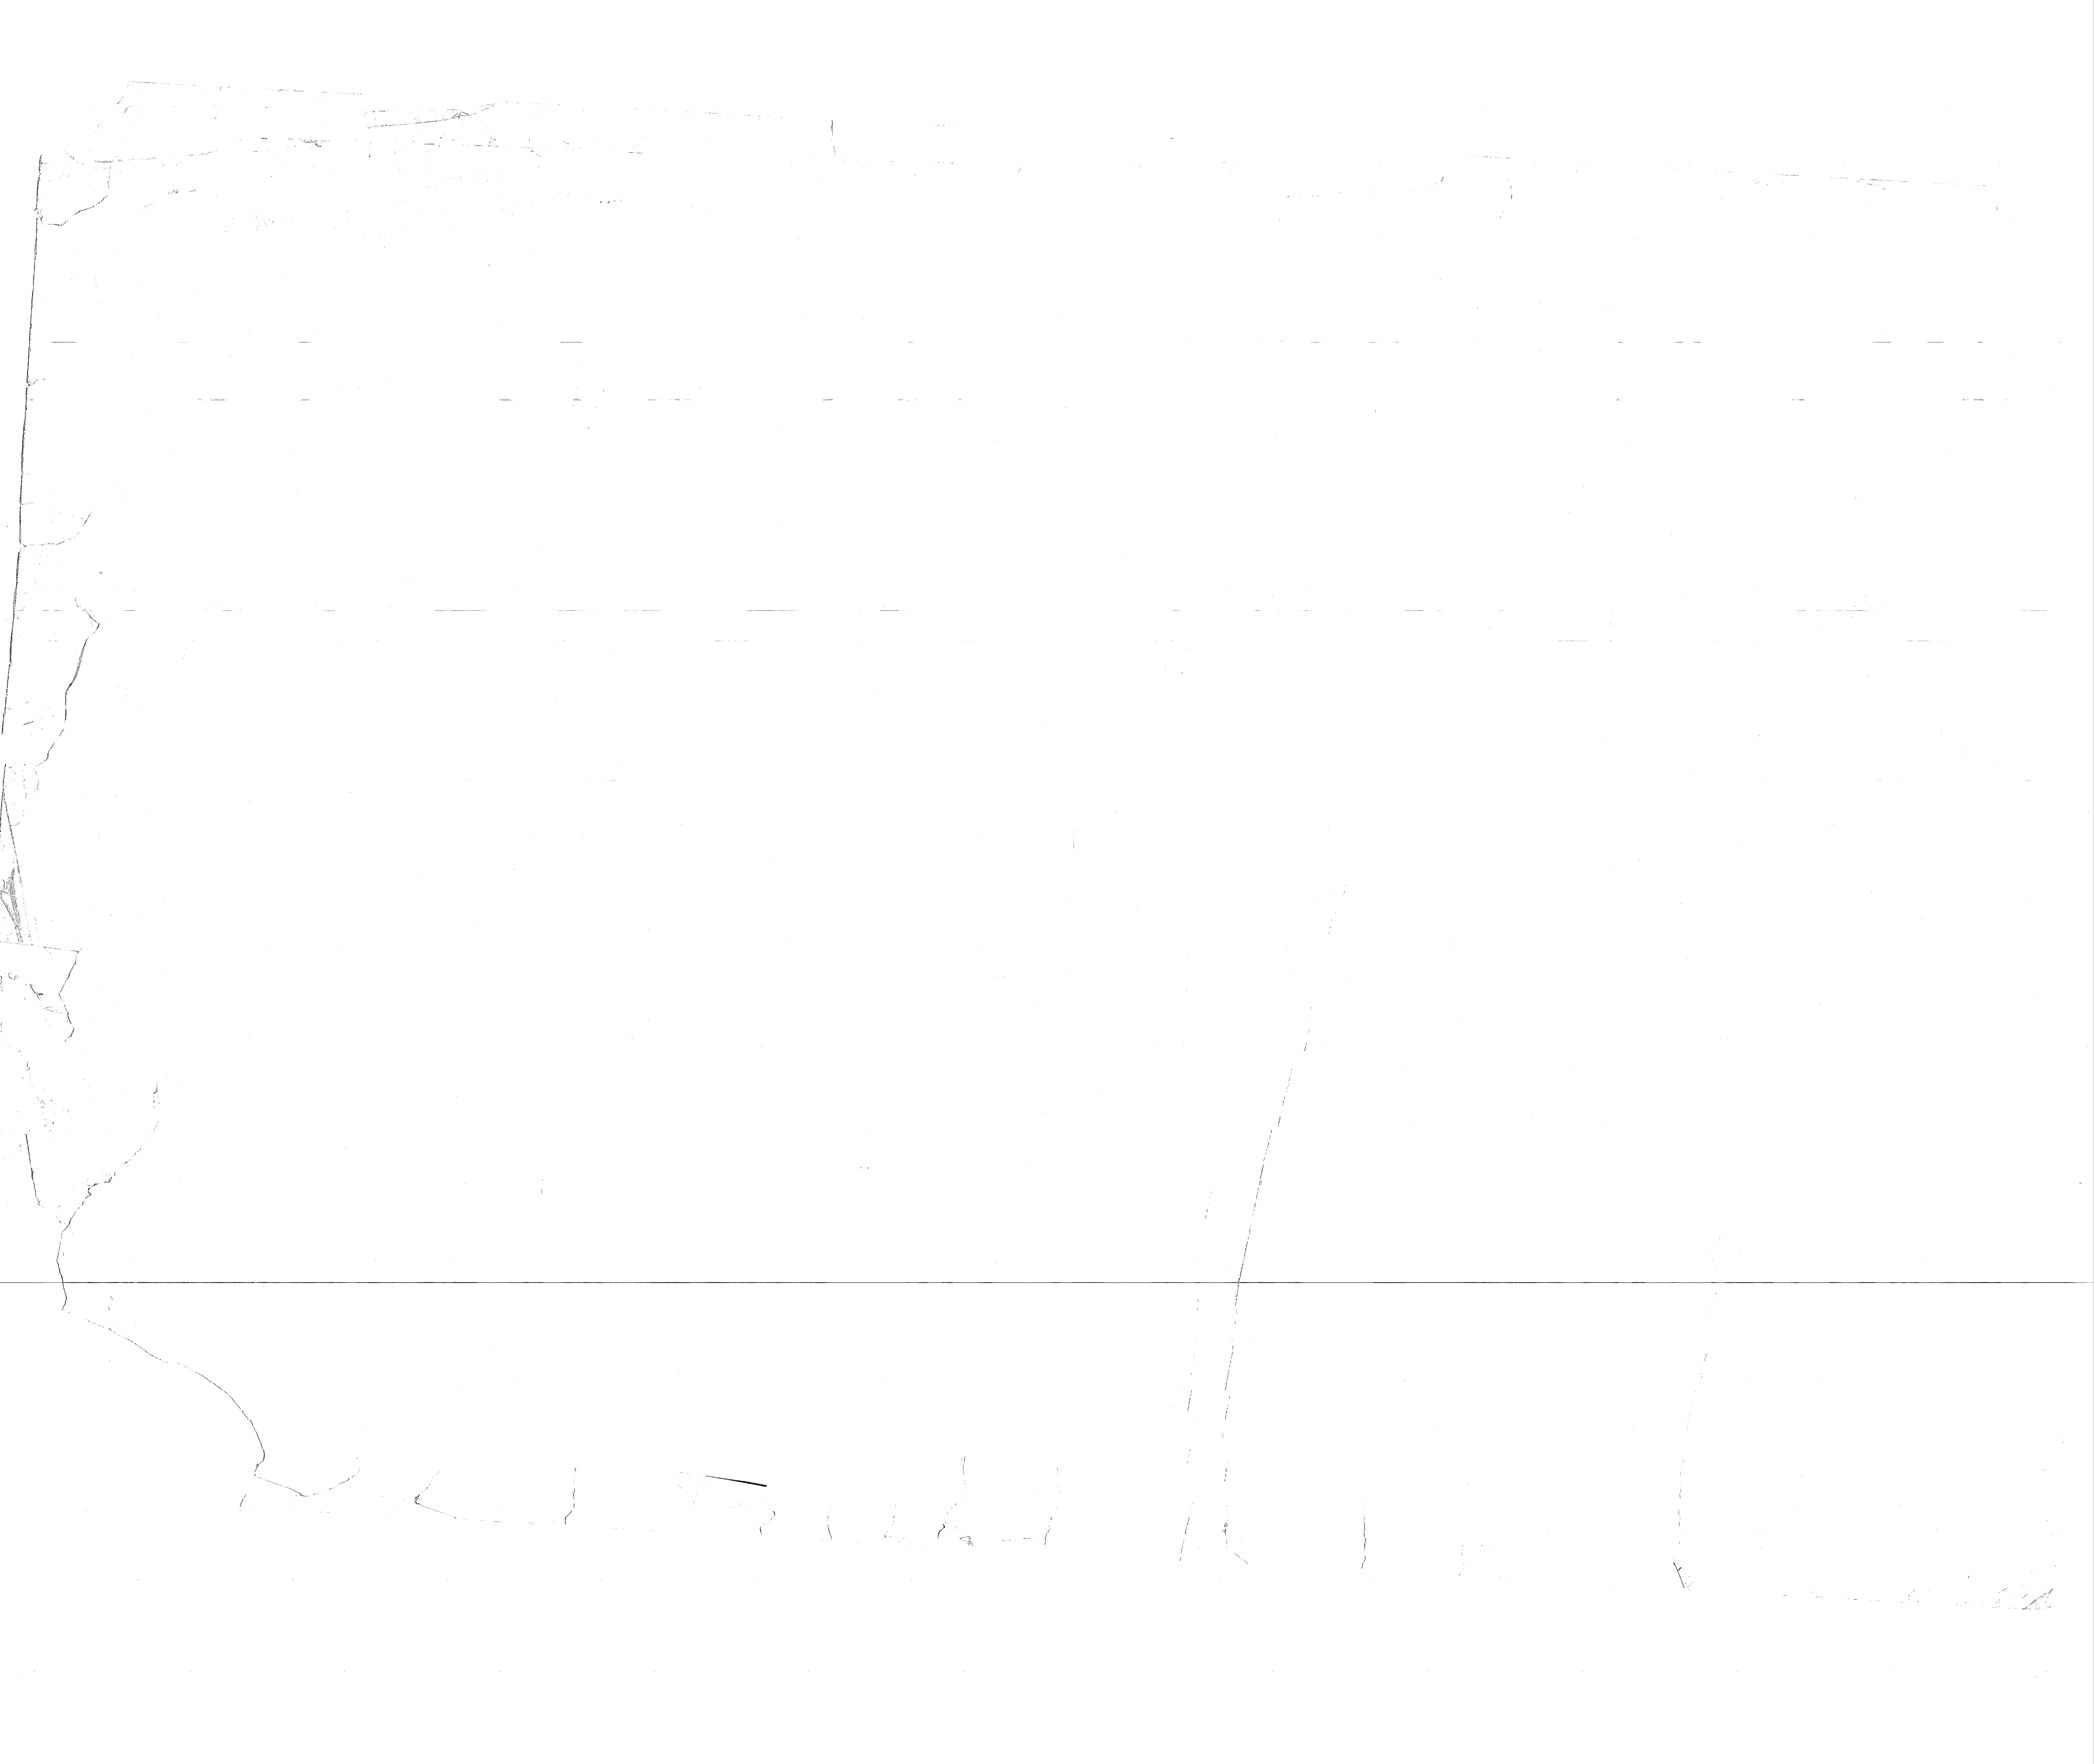



REVISIONS		
SYM	DESCRIPTION	DATE APPROVED
	REVISED A9-BUILT	1/3/62 C.C.

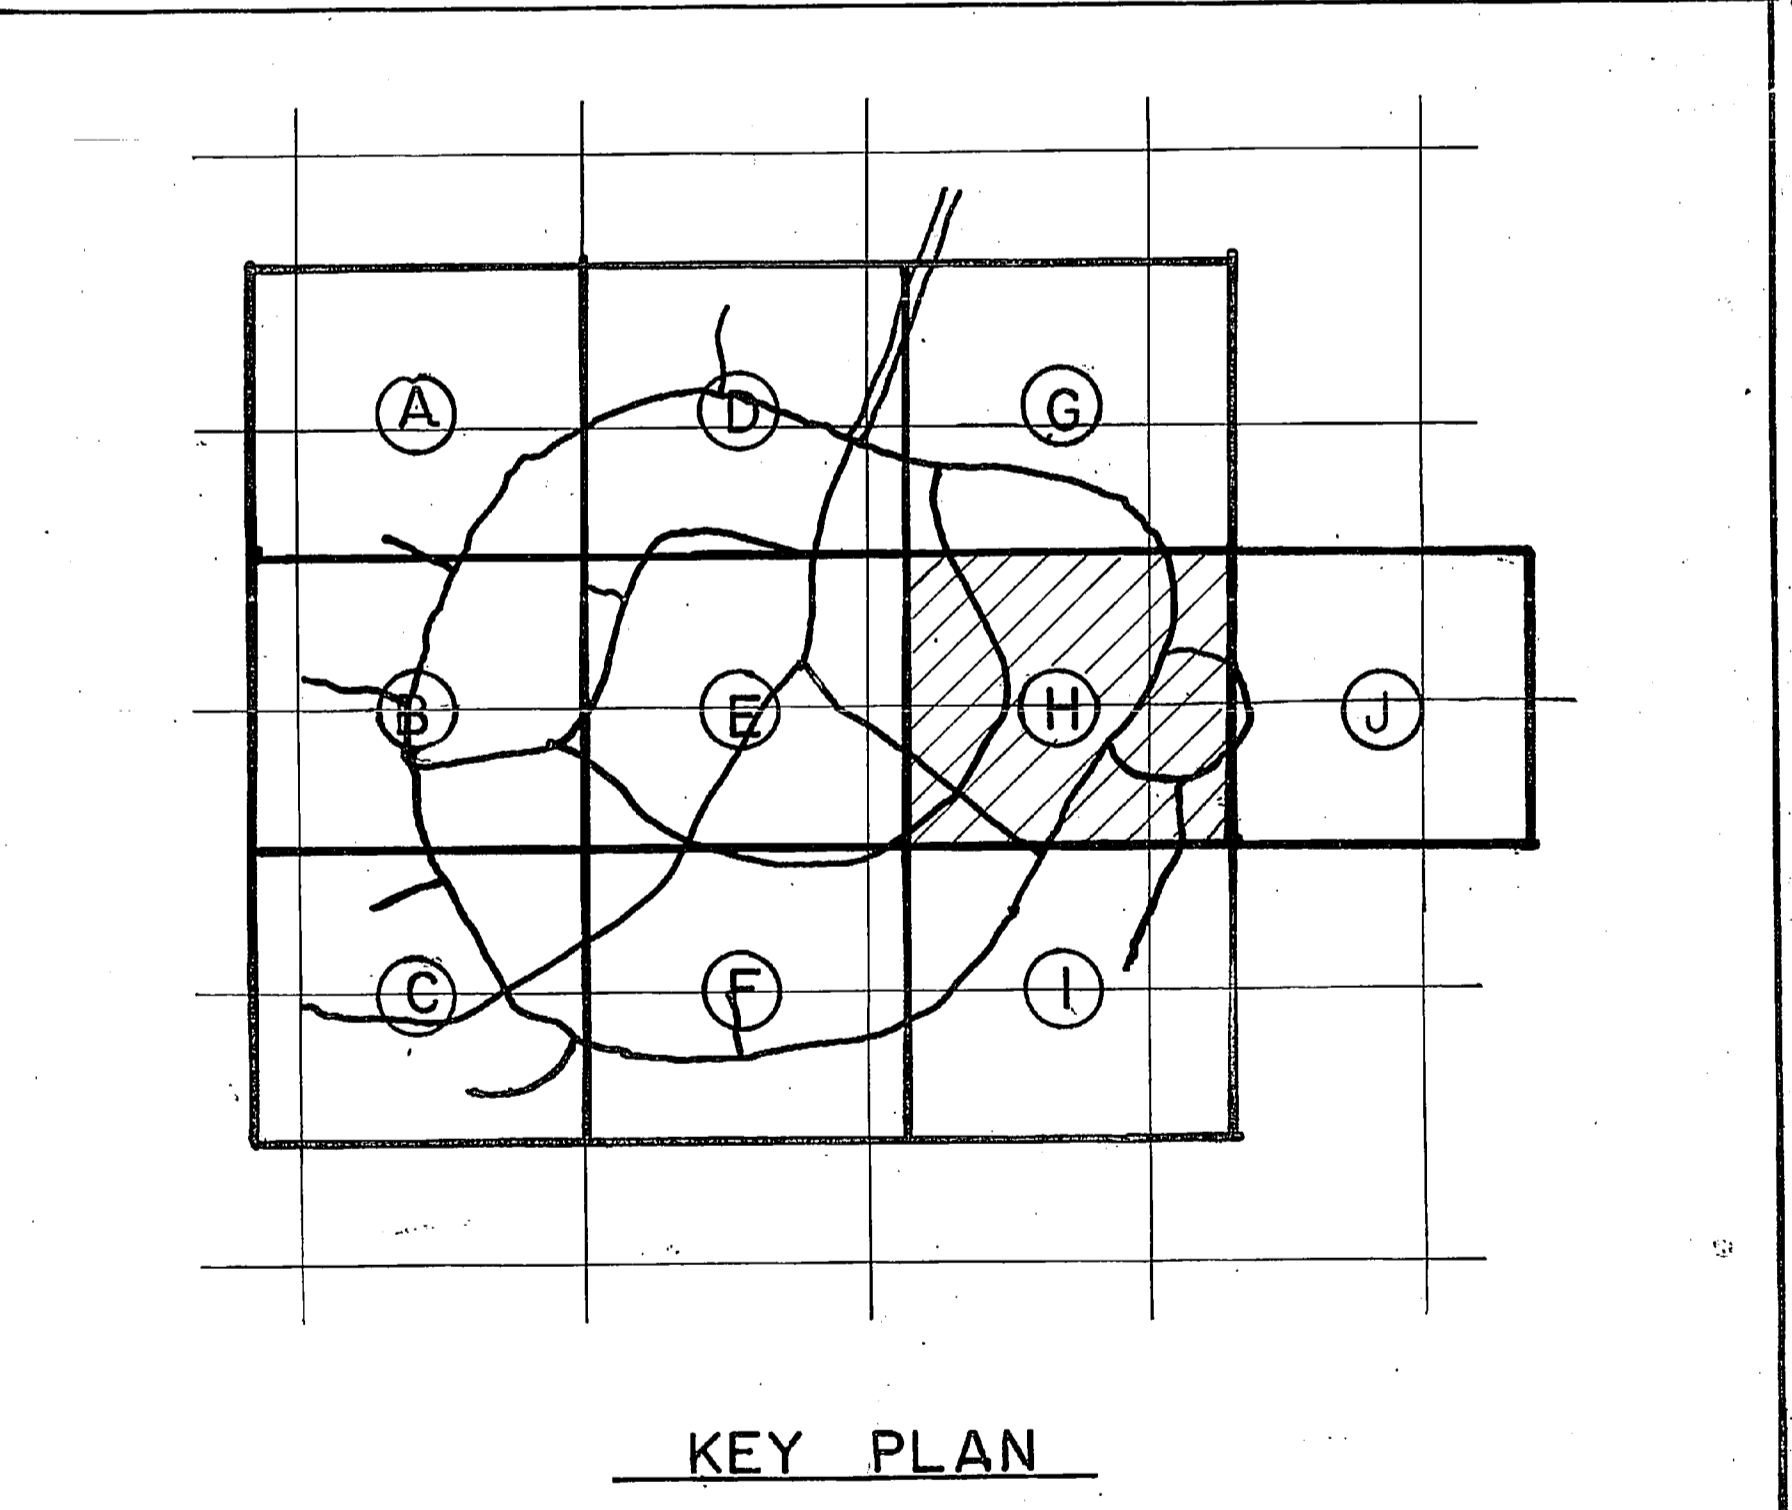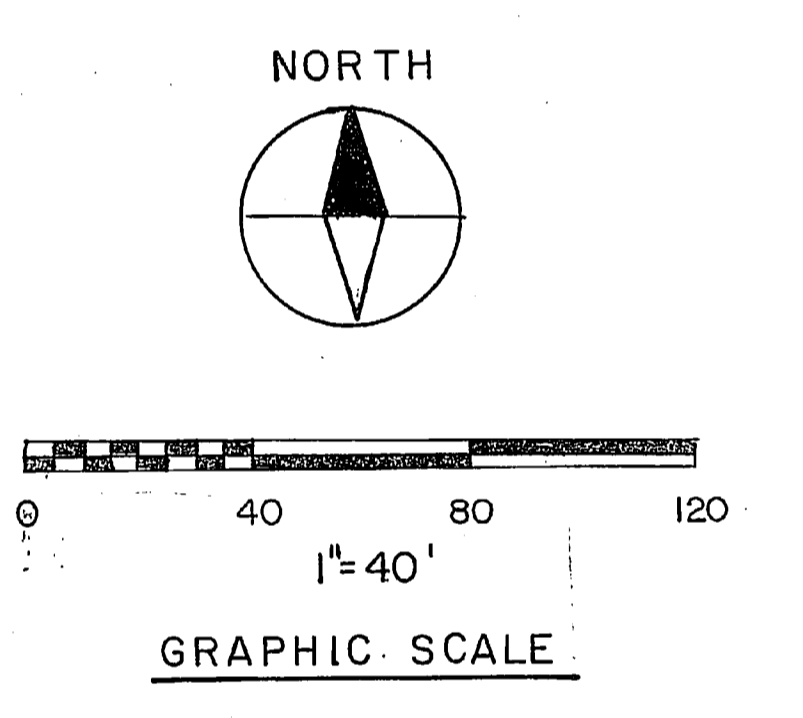

RECORD DRAWING		C-10	
LETTER DATED JAN 24 1962			
MCKIM & CREED ENGINEERS WILMINGTON, N.C.		DEPARTMENT OF THE NAVY NAVAL FACILITIES ENGINEERING COMMAND ATLANTIC DIVISION NAVAL STATION NORFOLK, VIRGINIA	
DESIGNED BY DR. WHITE		CHK. MCKIM	
PROJ. MGR.		CH. ENG.	
SUBMITTED BY		DATE	
FILED BY		RVD	
APPROVED		DATE	
ACTIVITY - SATISFACTORY		DATE	
APPROVED		DATE	
FOR E.O. FOR. COMMANDER NAVFAC		DATE	
SIZE	CODE IDENT NO.	CONSTR. CONTR. NO.	NAVAC DRAWING NO.
F	80091	NS2470-82-B-2305	4088792
SCALE	SPEC.	SHEET 11 OF 28	
1" = 40'	05-82-2305		



