


RAW WATER WELL CONTROL GROUPS - 16

GROUP NUMBER	WELLS	GROUP NUMBER	WELLS
1	1, 17, FUTURES	9	10, 27, FUTURES
2	2, 10, FUTURES	10	11, 28, FUTURES
3	3, 19, FUTURES	11	12, 29, FUTURES
4	4, 20, FUTURES	12	13, 30, FUTURES
5	5, 21, FUTURES	13	14, 31, FUTURES
6	6, 24, FUTURES	14	15, LCH-1, FUTURES
7	8, 25, FUTURES	15	16, 26, FUTURES
8	9, FUTURES	16	LCH-2, FUTURES

RAW WATER WELL CONTROL GROUPS - 8

GROUP NUMBER	WELLS
1	1, 10, 17, 26, FUTURE
2	2, 11, 18, 27, FUTURE
3	3, 12, 19, 28, FUTURE
4	4, 13, 20, 29, FUTURE
5	5, 14, 21, 30, FUTURE
6	6, 15, 24, 31, FUTURE
7	8, 16, 25, LCH-1, FUTURE
8	9, LCH-2, FUTURE, FUTURE, FUTURE

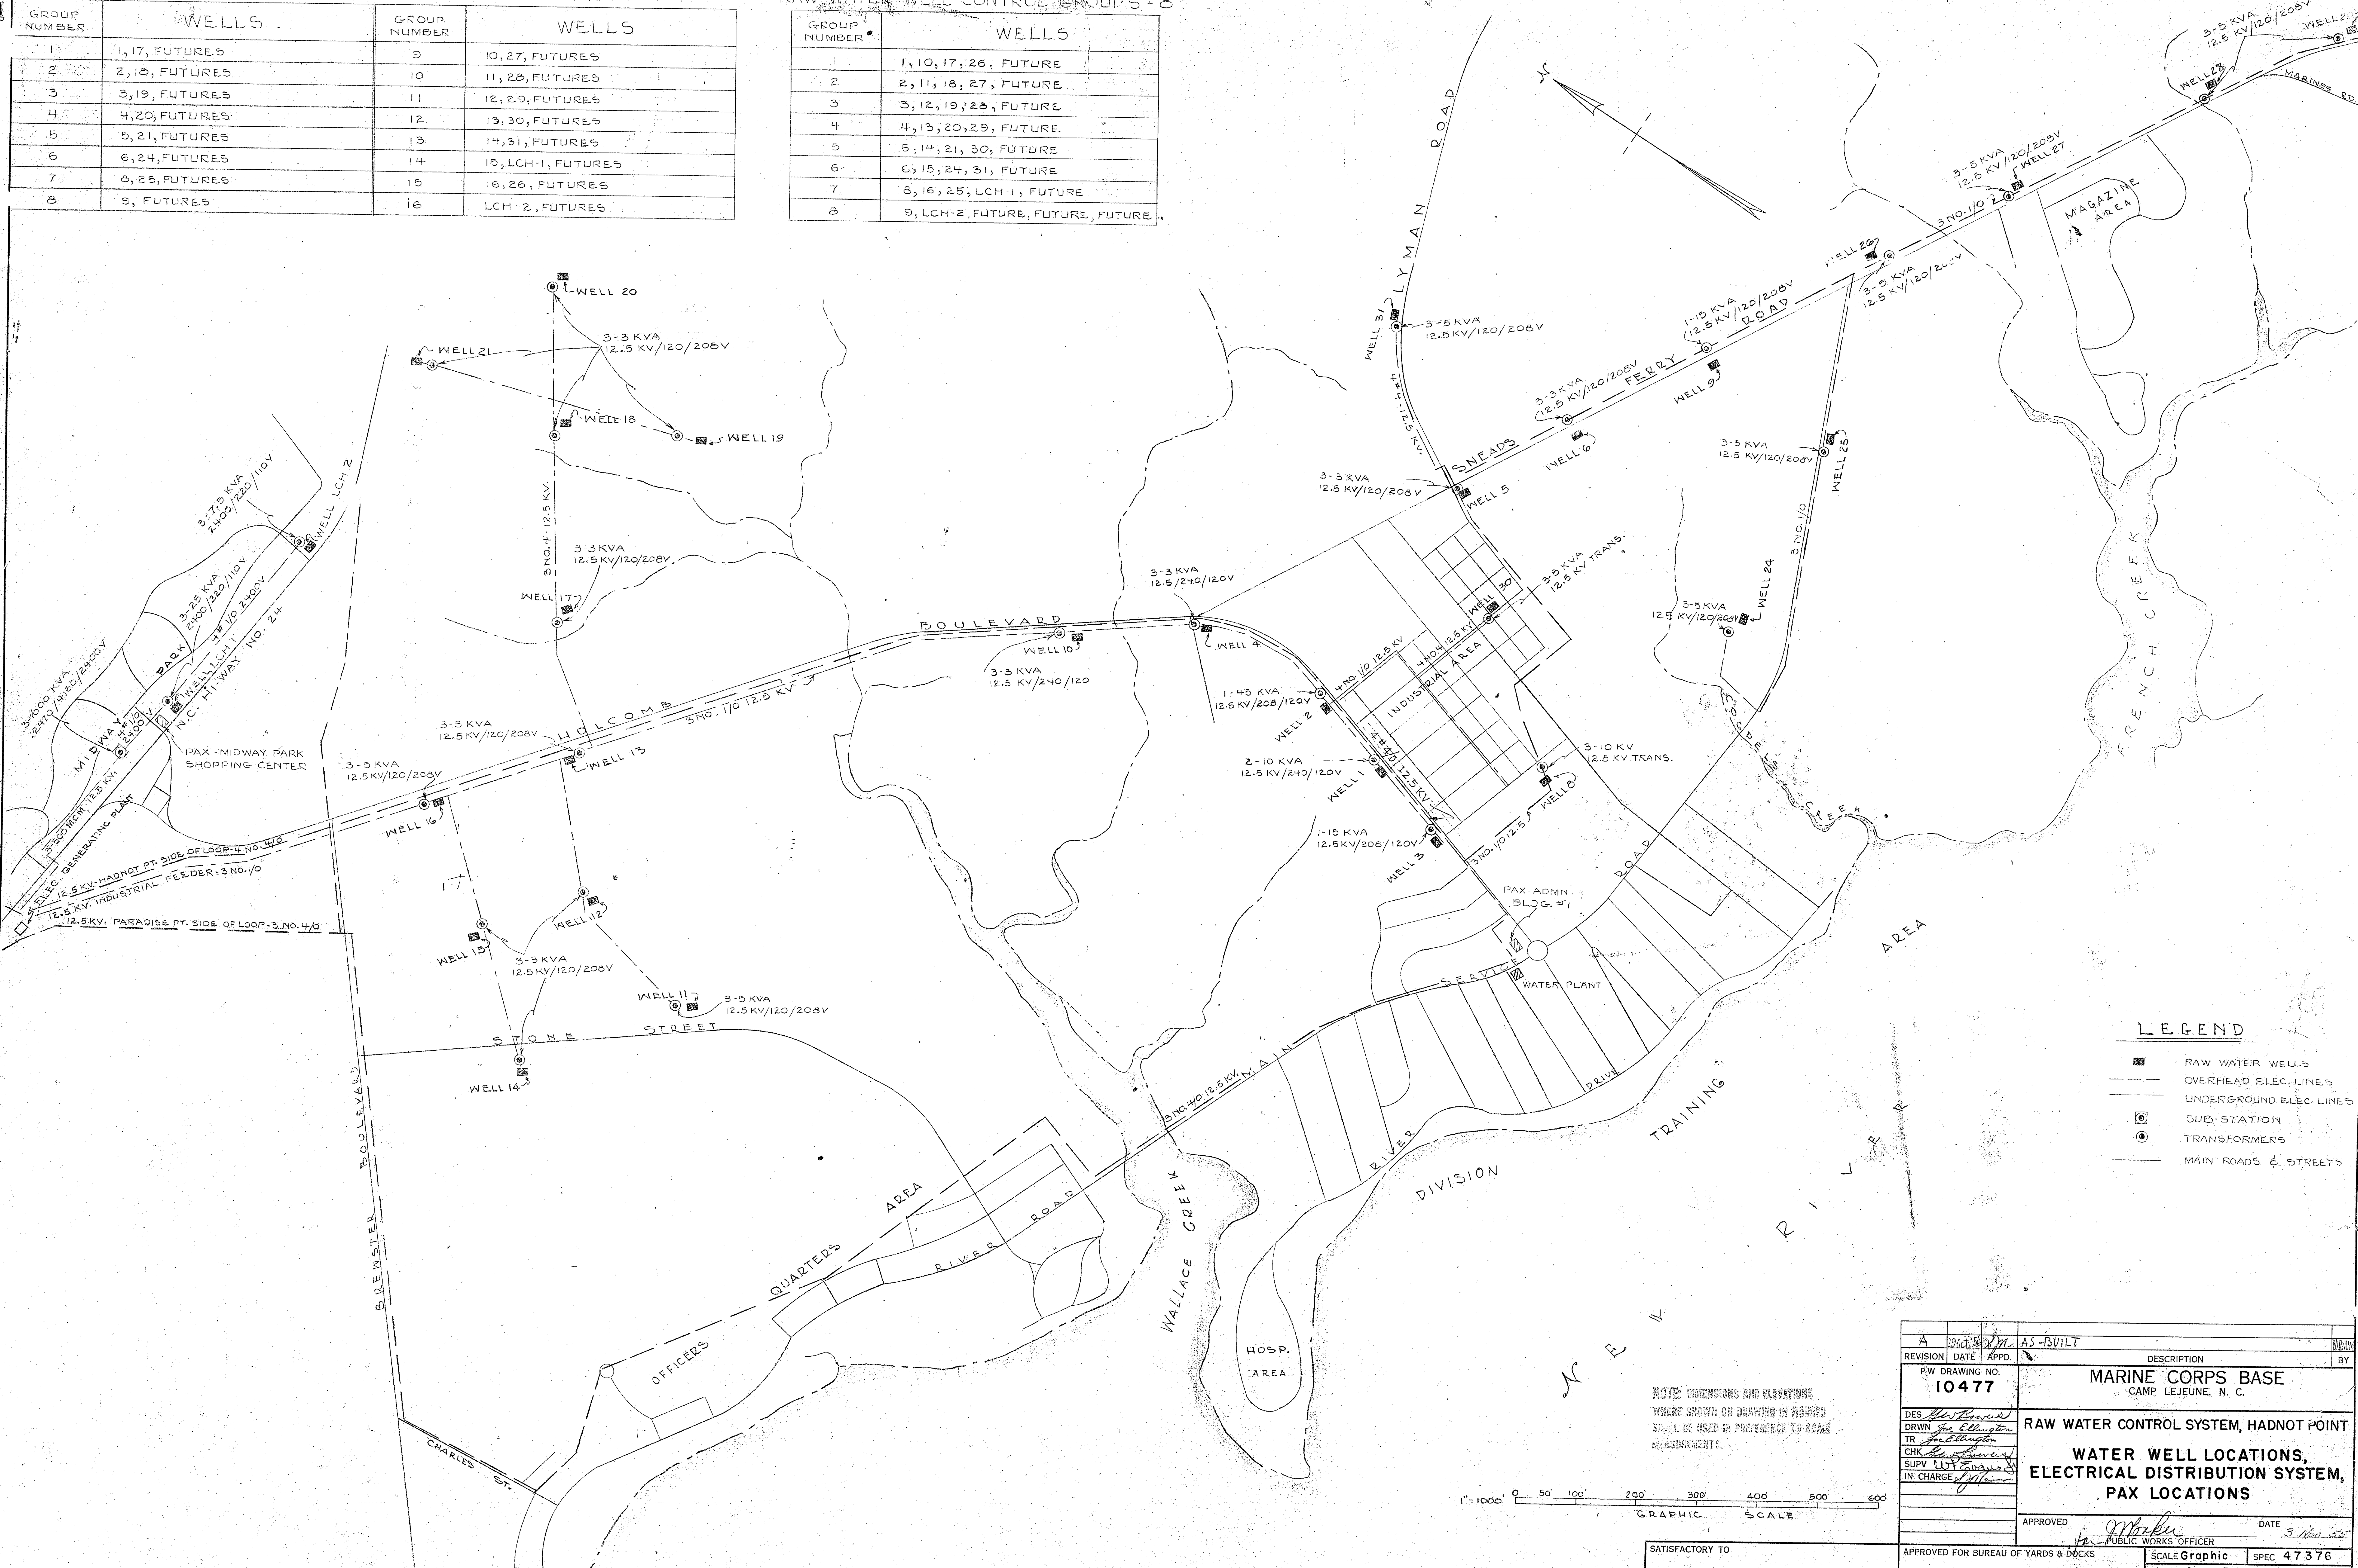




LEGEND

- RAW WATER WELLS
- OVERHEAD ELEC. LINES
- - - UNDERGROUND ELEC. LINES
- ⊙ SUB. STATION
- ⊕ TRANSFORMERS
- MAIN ROADS & STREETS

REVISION	DATE	APPD.	DESCRIPTION
A	3/10/55	AS-BUILT	
P.W. DRAWING NO.		MARINE CORPS BASE	
10477		CAMP LEJEUNE, N. C.	
RAW WATER CONTROL SYSTEM, HADNOT POINT			
WATER WELL LOCATIONS, ELECTRICAL DISTRIBUTION SYSTEM, PAX LOCATIONS			
DESIGNED BY	DRWN BY	TR BY	CHK BY
Supv. Lt. Col. J. H.
APPROVED		DATE	
Public Works Officer		3 Nov 55	
APPROVED FOR BUREAU OF YARDS & DOCKS		SCALE	SPEC
Graphic		47376	
DATE		SHEET	NOV
		2 OF 5	91286
DATE		Y & P	646677

 SATISFACTORY TO
THE QUARTERMASTER GENERAL OF
THE MARINE CORPS




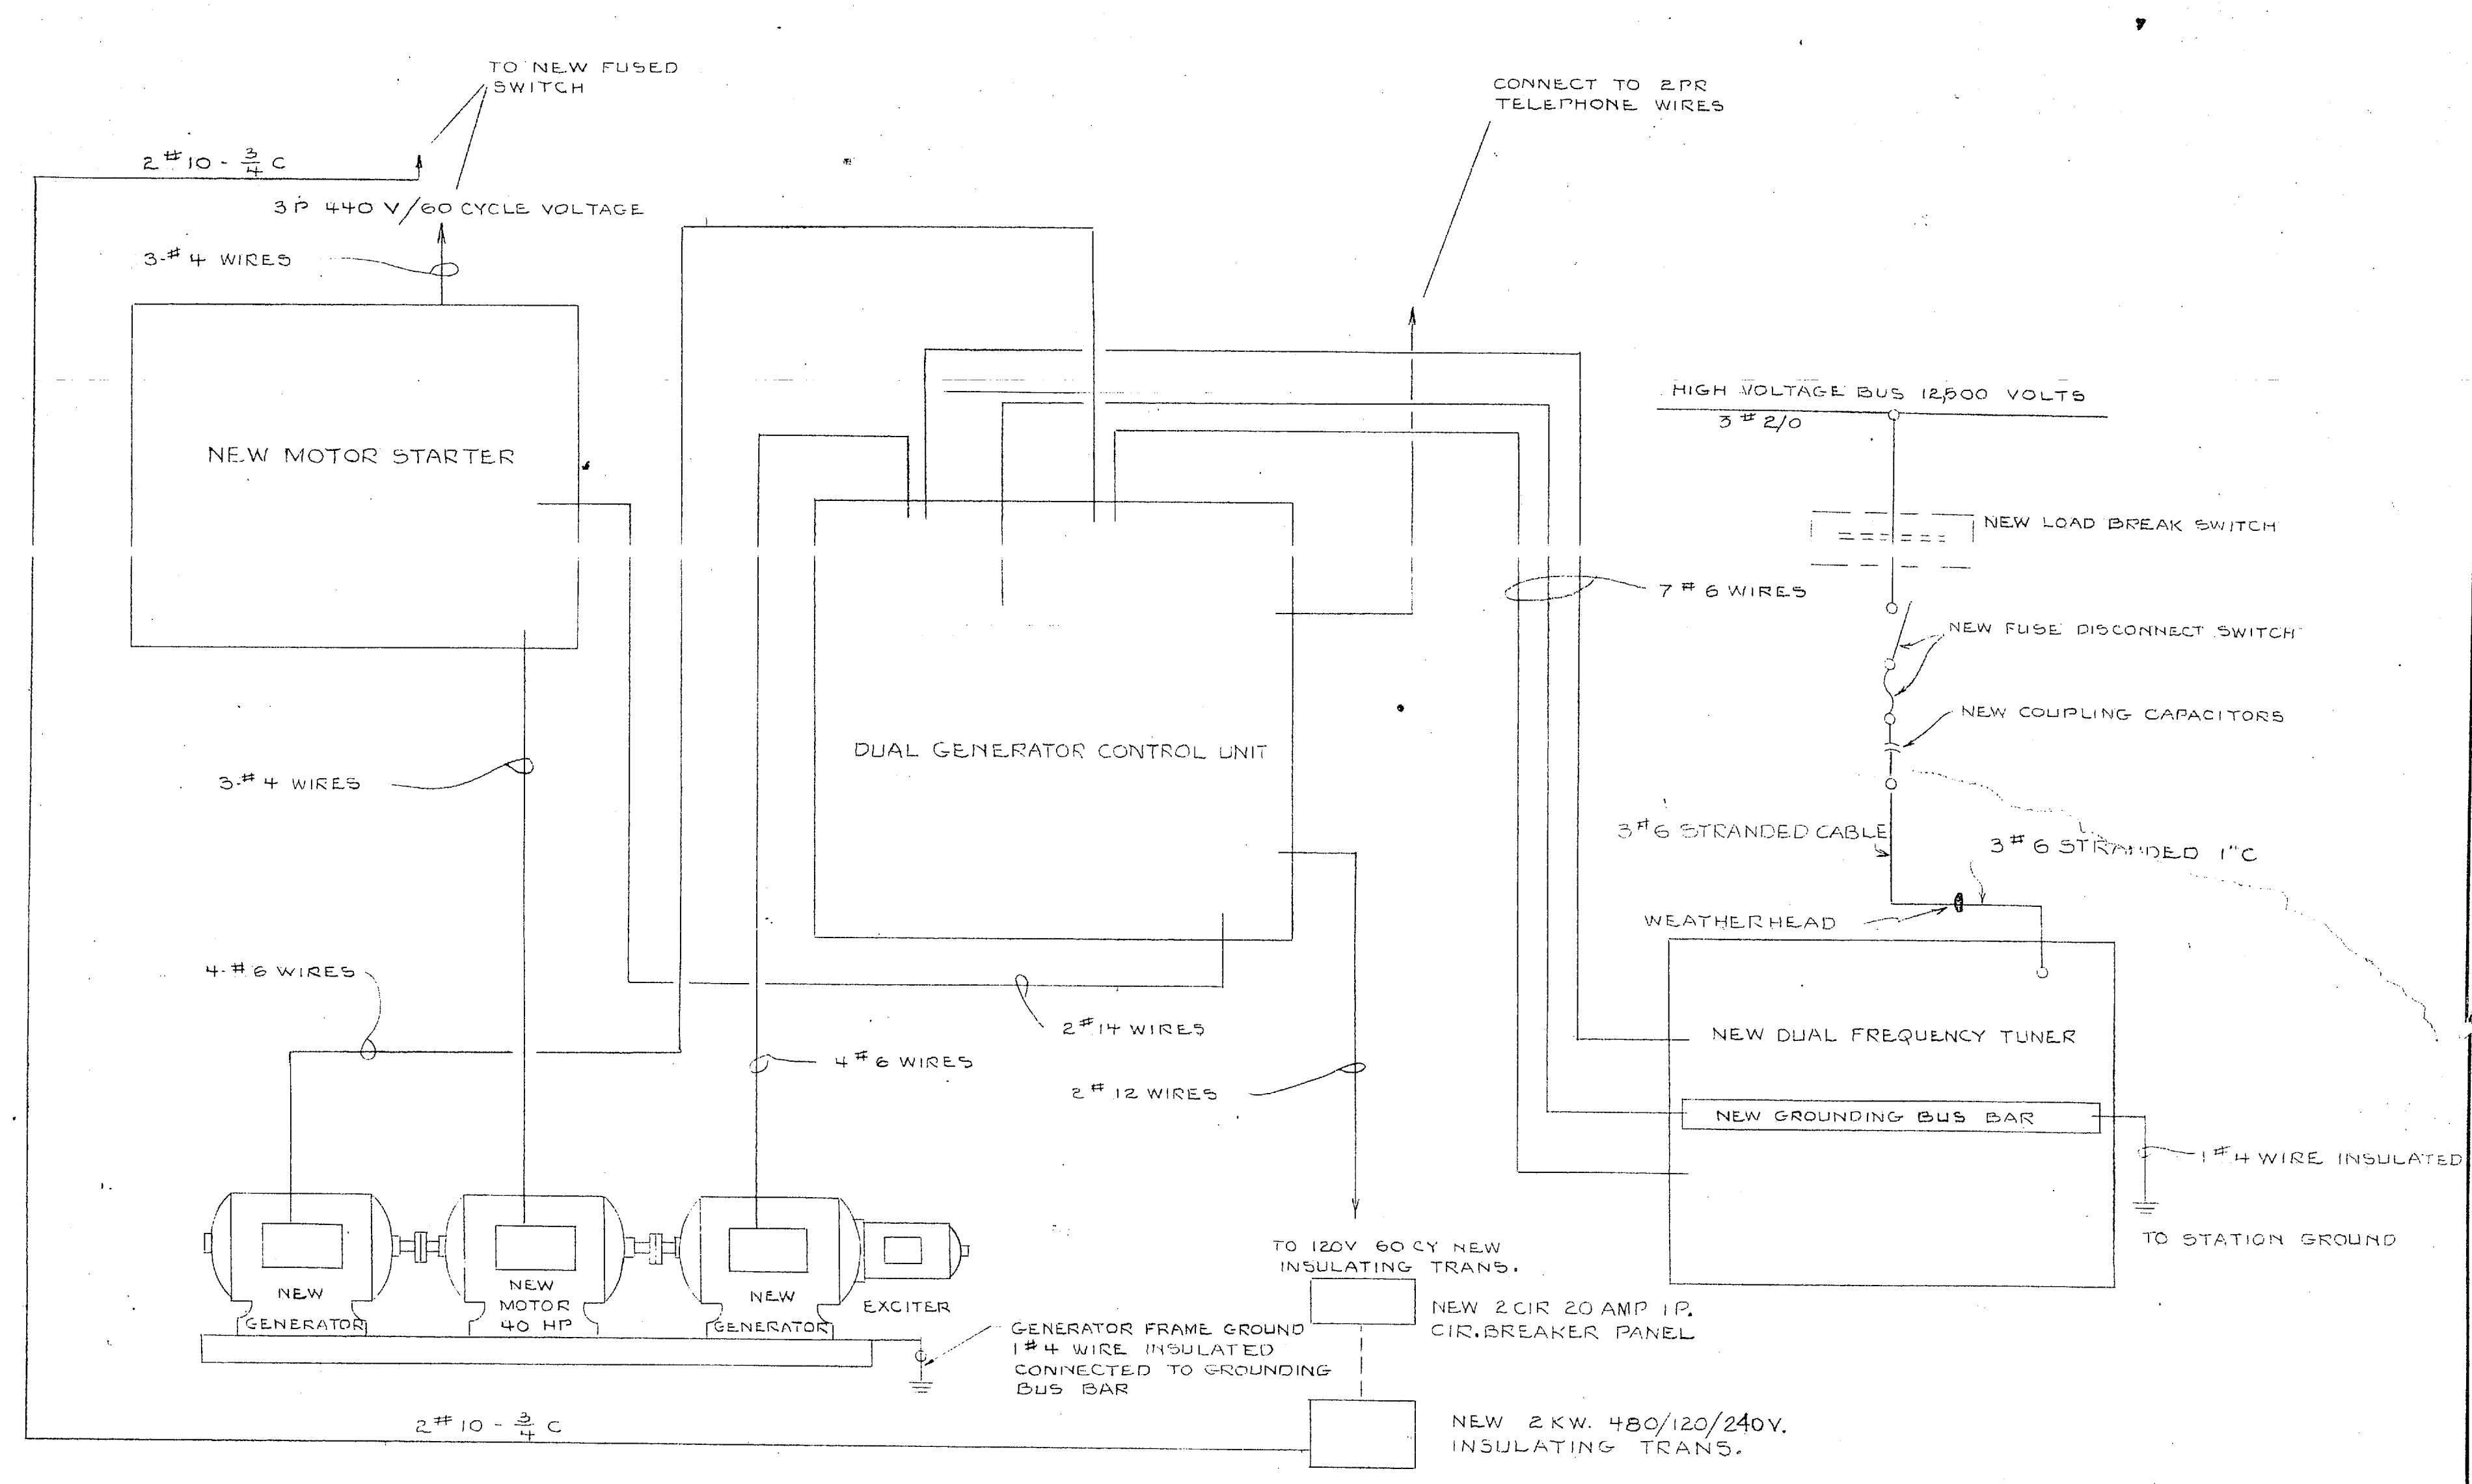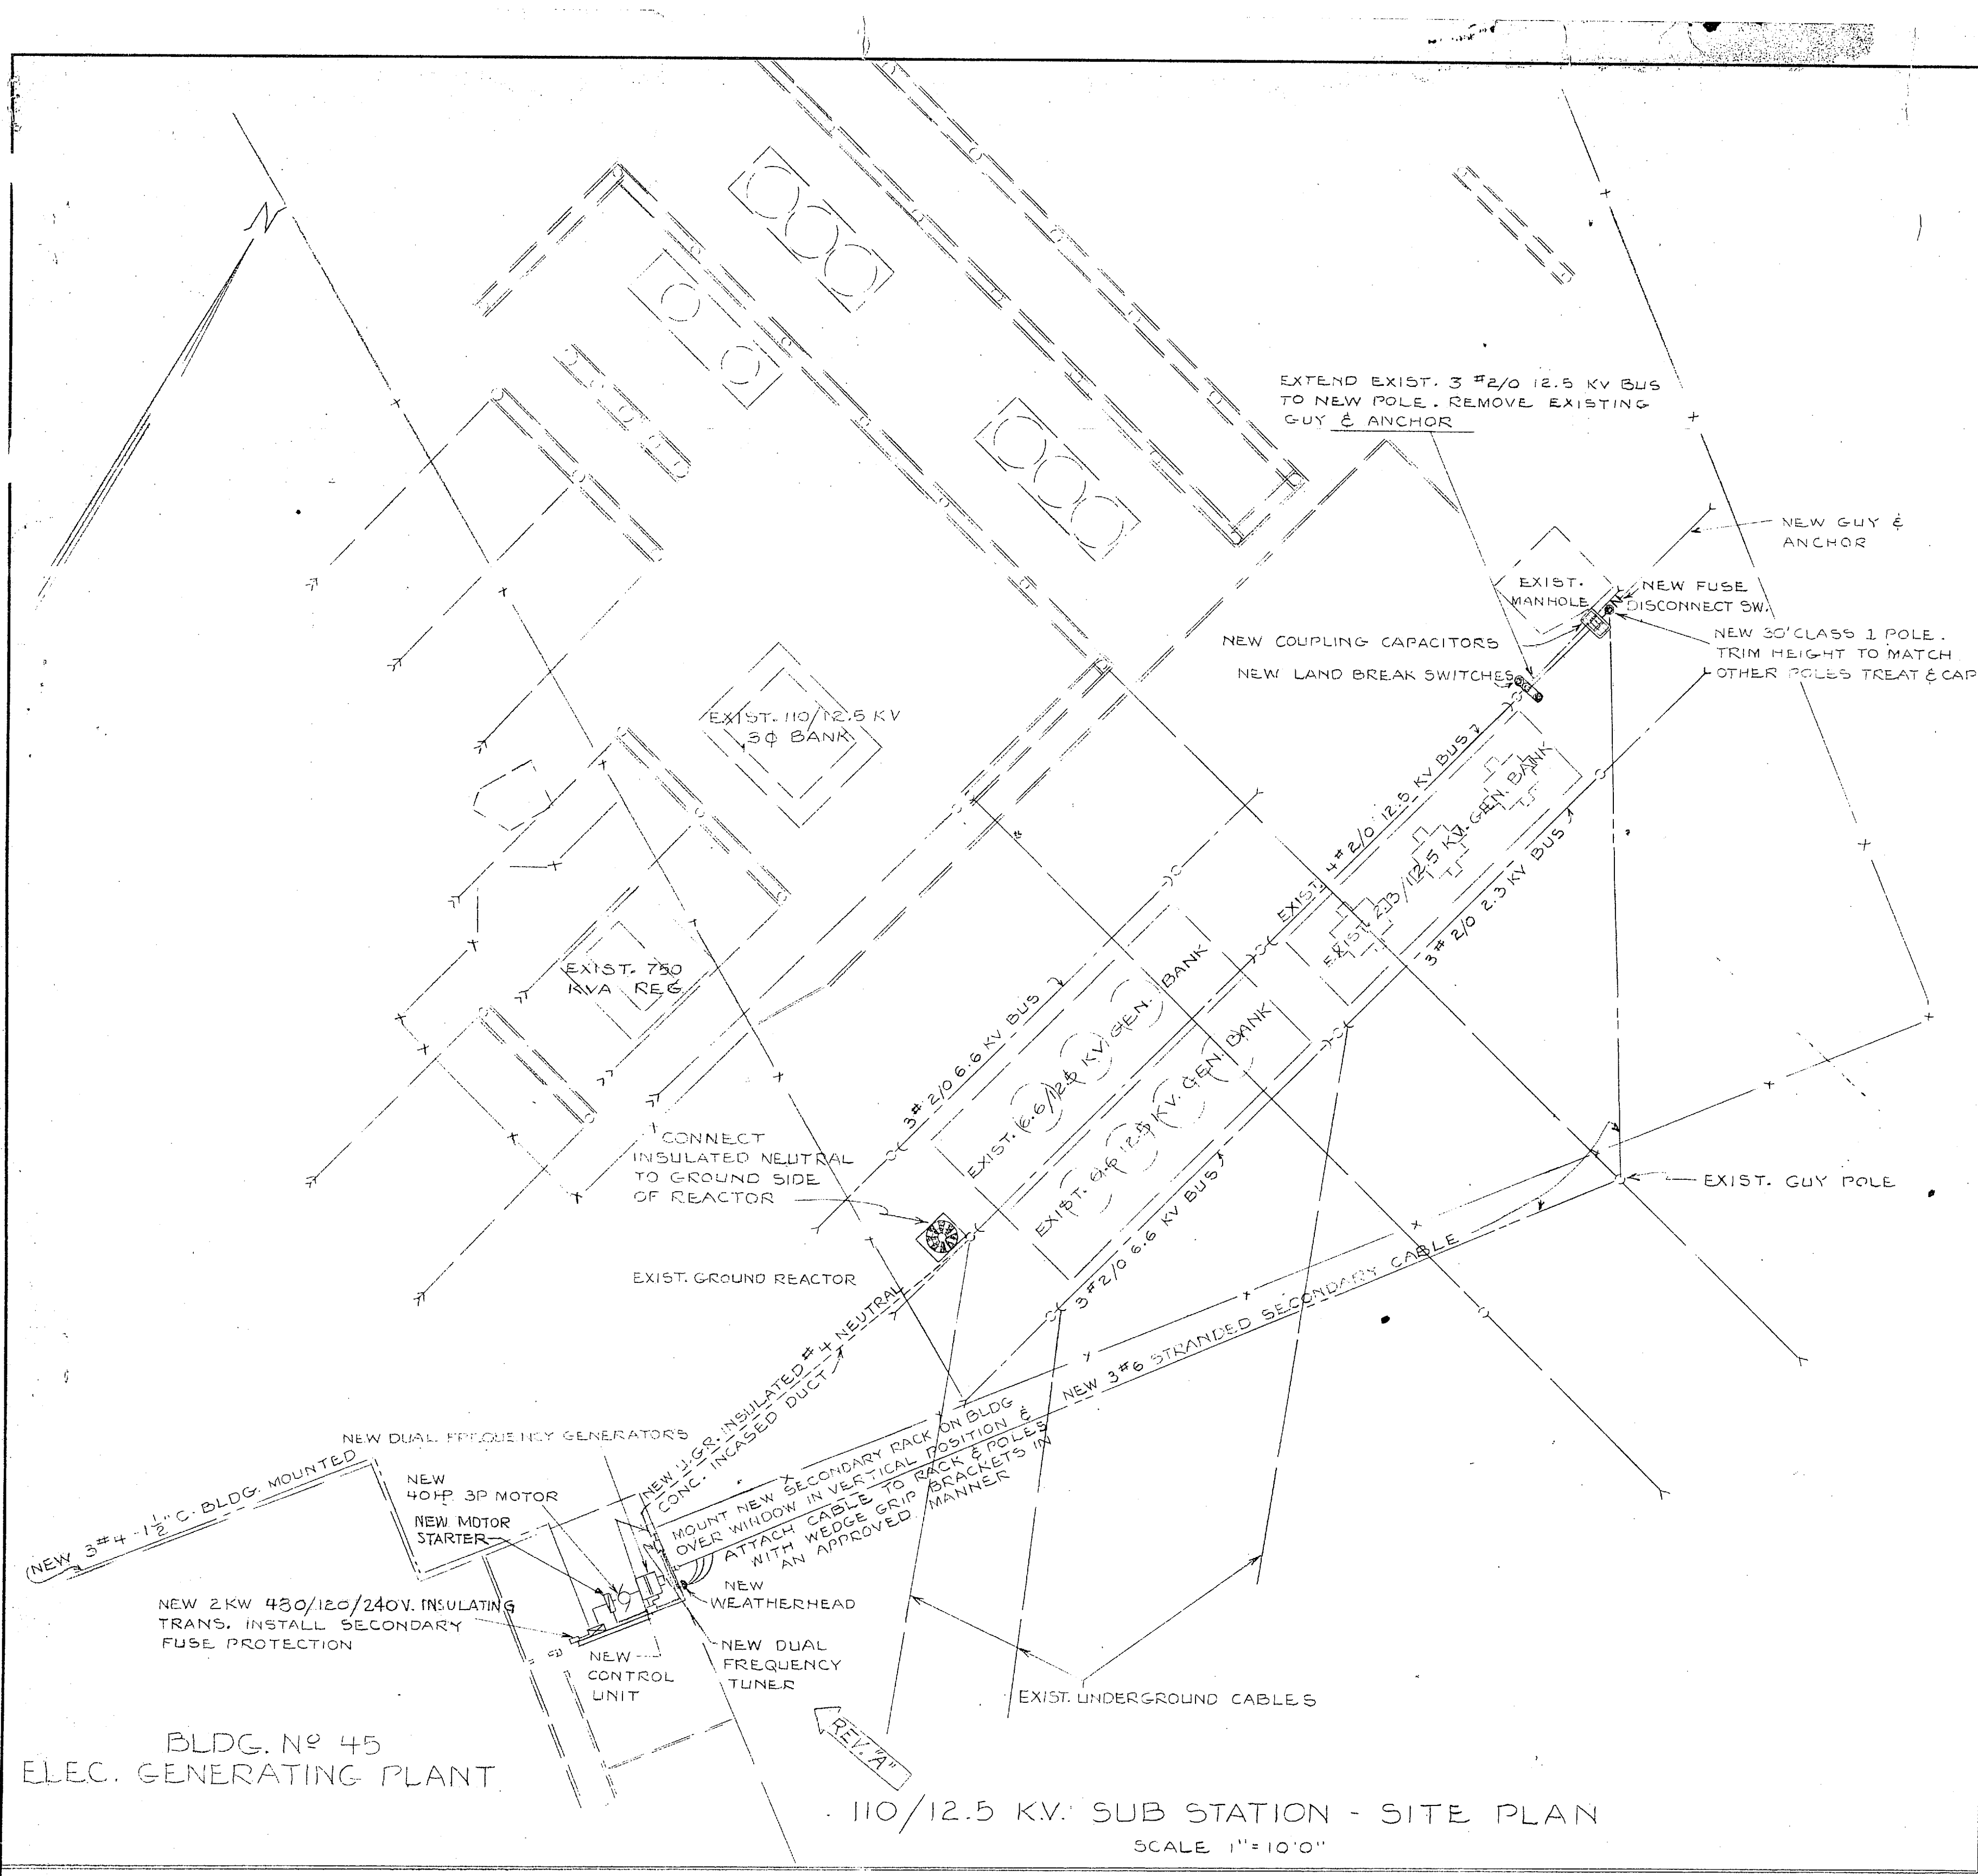

TYPICAL SCHEMATIC DIAGRAM OF NEW DUAL CARRIER FREQUENCY GENERATION

NO SCALE



BLDG. NO 45
ELEC. GENERATING PLANT
110/12.5 KV. SUB STATION - SITE PLAN
SCALE 1"=10'0"

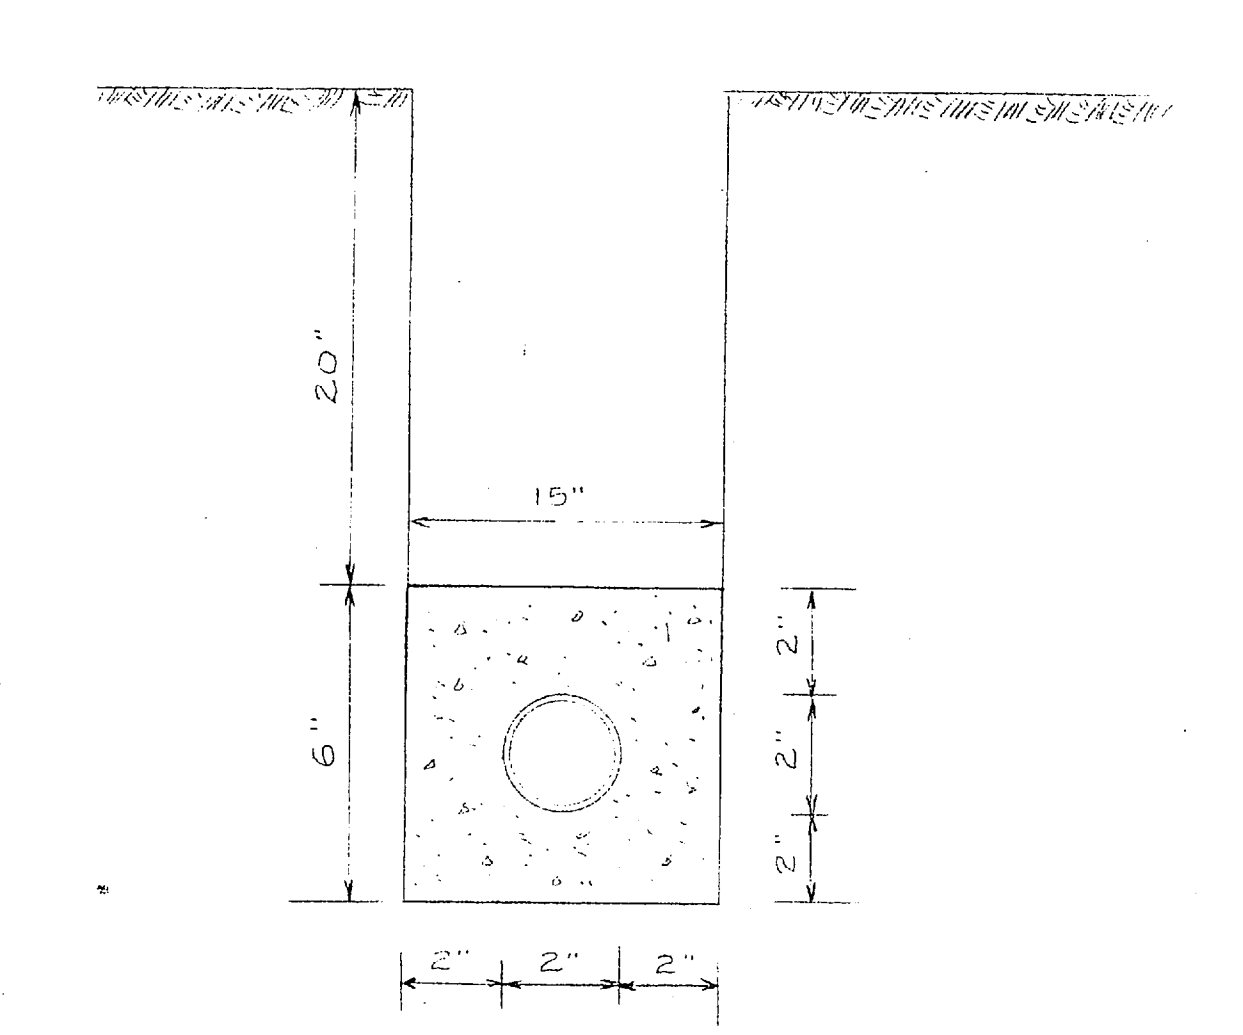

TYPICAL SECTION - CONC. INCASED DUCT

NO SCALE


NOTE: DIMENSIONS AND RELAYING
WIRING SHOULD BE DRAWING OR FIGURE
SCALE ARE USED IN PREFERENCE TO SCALE
DIMENSIONS.

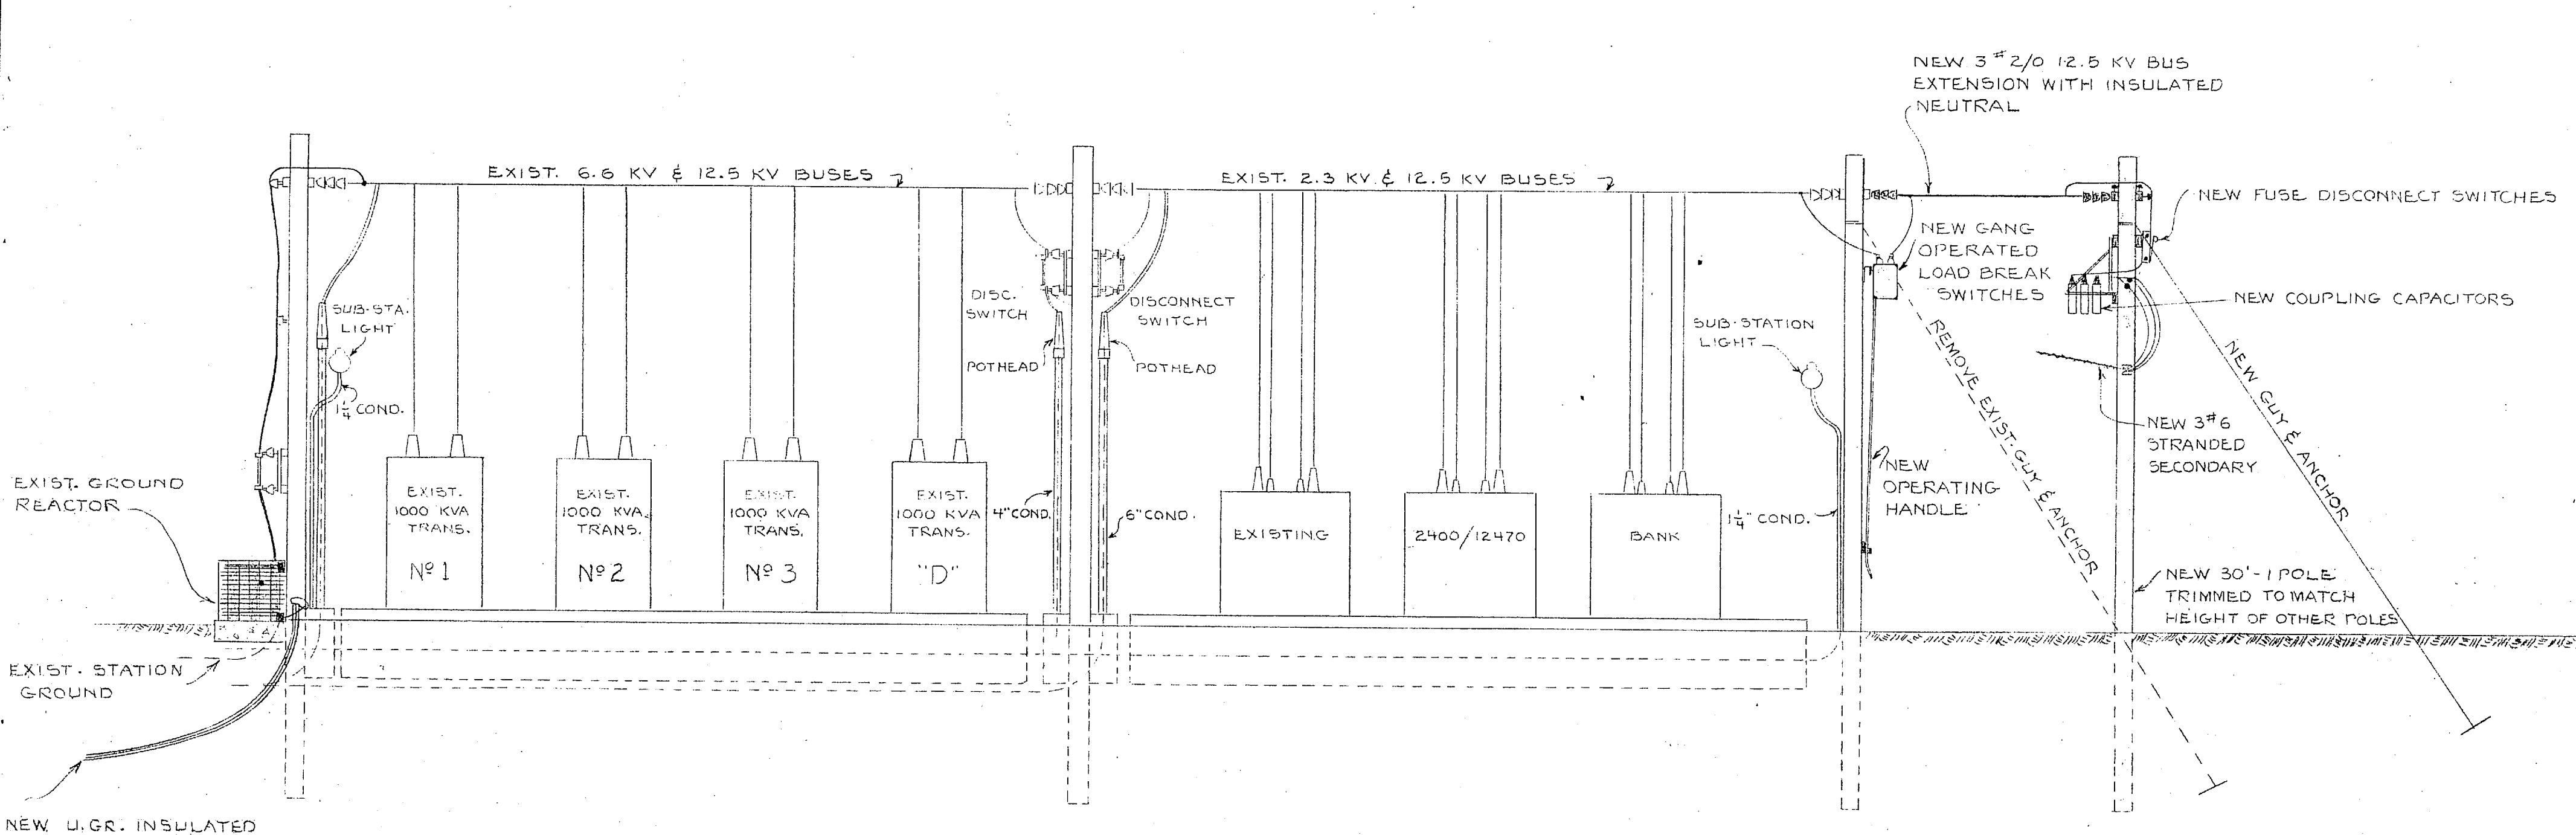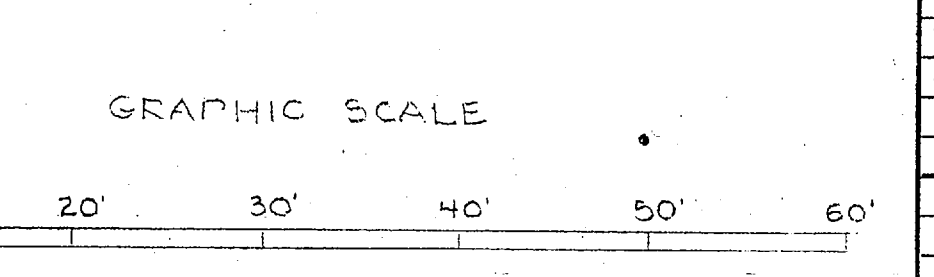


TYPICAL CONSTRUCTION DETAILS OF 12.5 BUS EXTENSION & COUPLING EQUIPMENT ARRANGEMENT


NO SCALE

REVISION	DATE	APPD.	AS-BUILT REVISION	BY
PW DRAWING NO. 10478			MARINE CORPS BASE CAMP LEJUNE, N. C.	
DES. <i>[Signature]</i>			RAW WATER CONTROL SYSTEM, HADNOT POINT	
DRWN. <i>[Signature]</i>			LEJUNE GENERATING PLANT, SCHEMATIC DUAL CARRIER FREQUENCY COUPLING DETAILS	
TR. <i>[Signature]</i>			APPROVED <i>[Signature]</i> DATE 3 Nov 58	
CHK. <i>[Signature]</i>			PUBLIC WORKS OFFICER	
SUPV. <i>[Signature]</i>			SCALE Graphic SPEC 4737	
IN CHARGE <i>[Signature]</i>			SHEET 3 OF 5 NOV 9 1958	
SATISFACTORY TO			APPROVED FOR BUREAU OF YARDS & DOCKS	
THE QUARTERMASTER GENERAL OF THE MARINE CORPS			DPWO FOR CHIEF OF BUREAU	
DATE			Y & D DRAWING NO. 64667e	

 


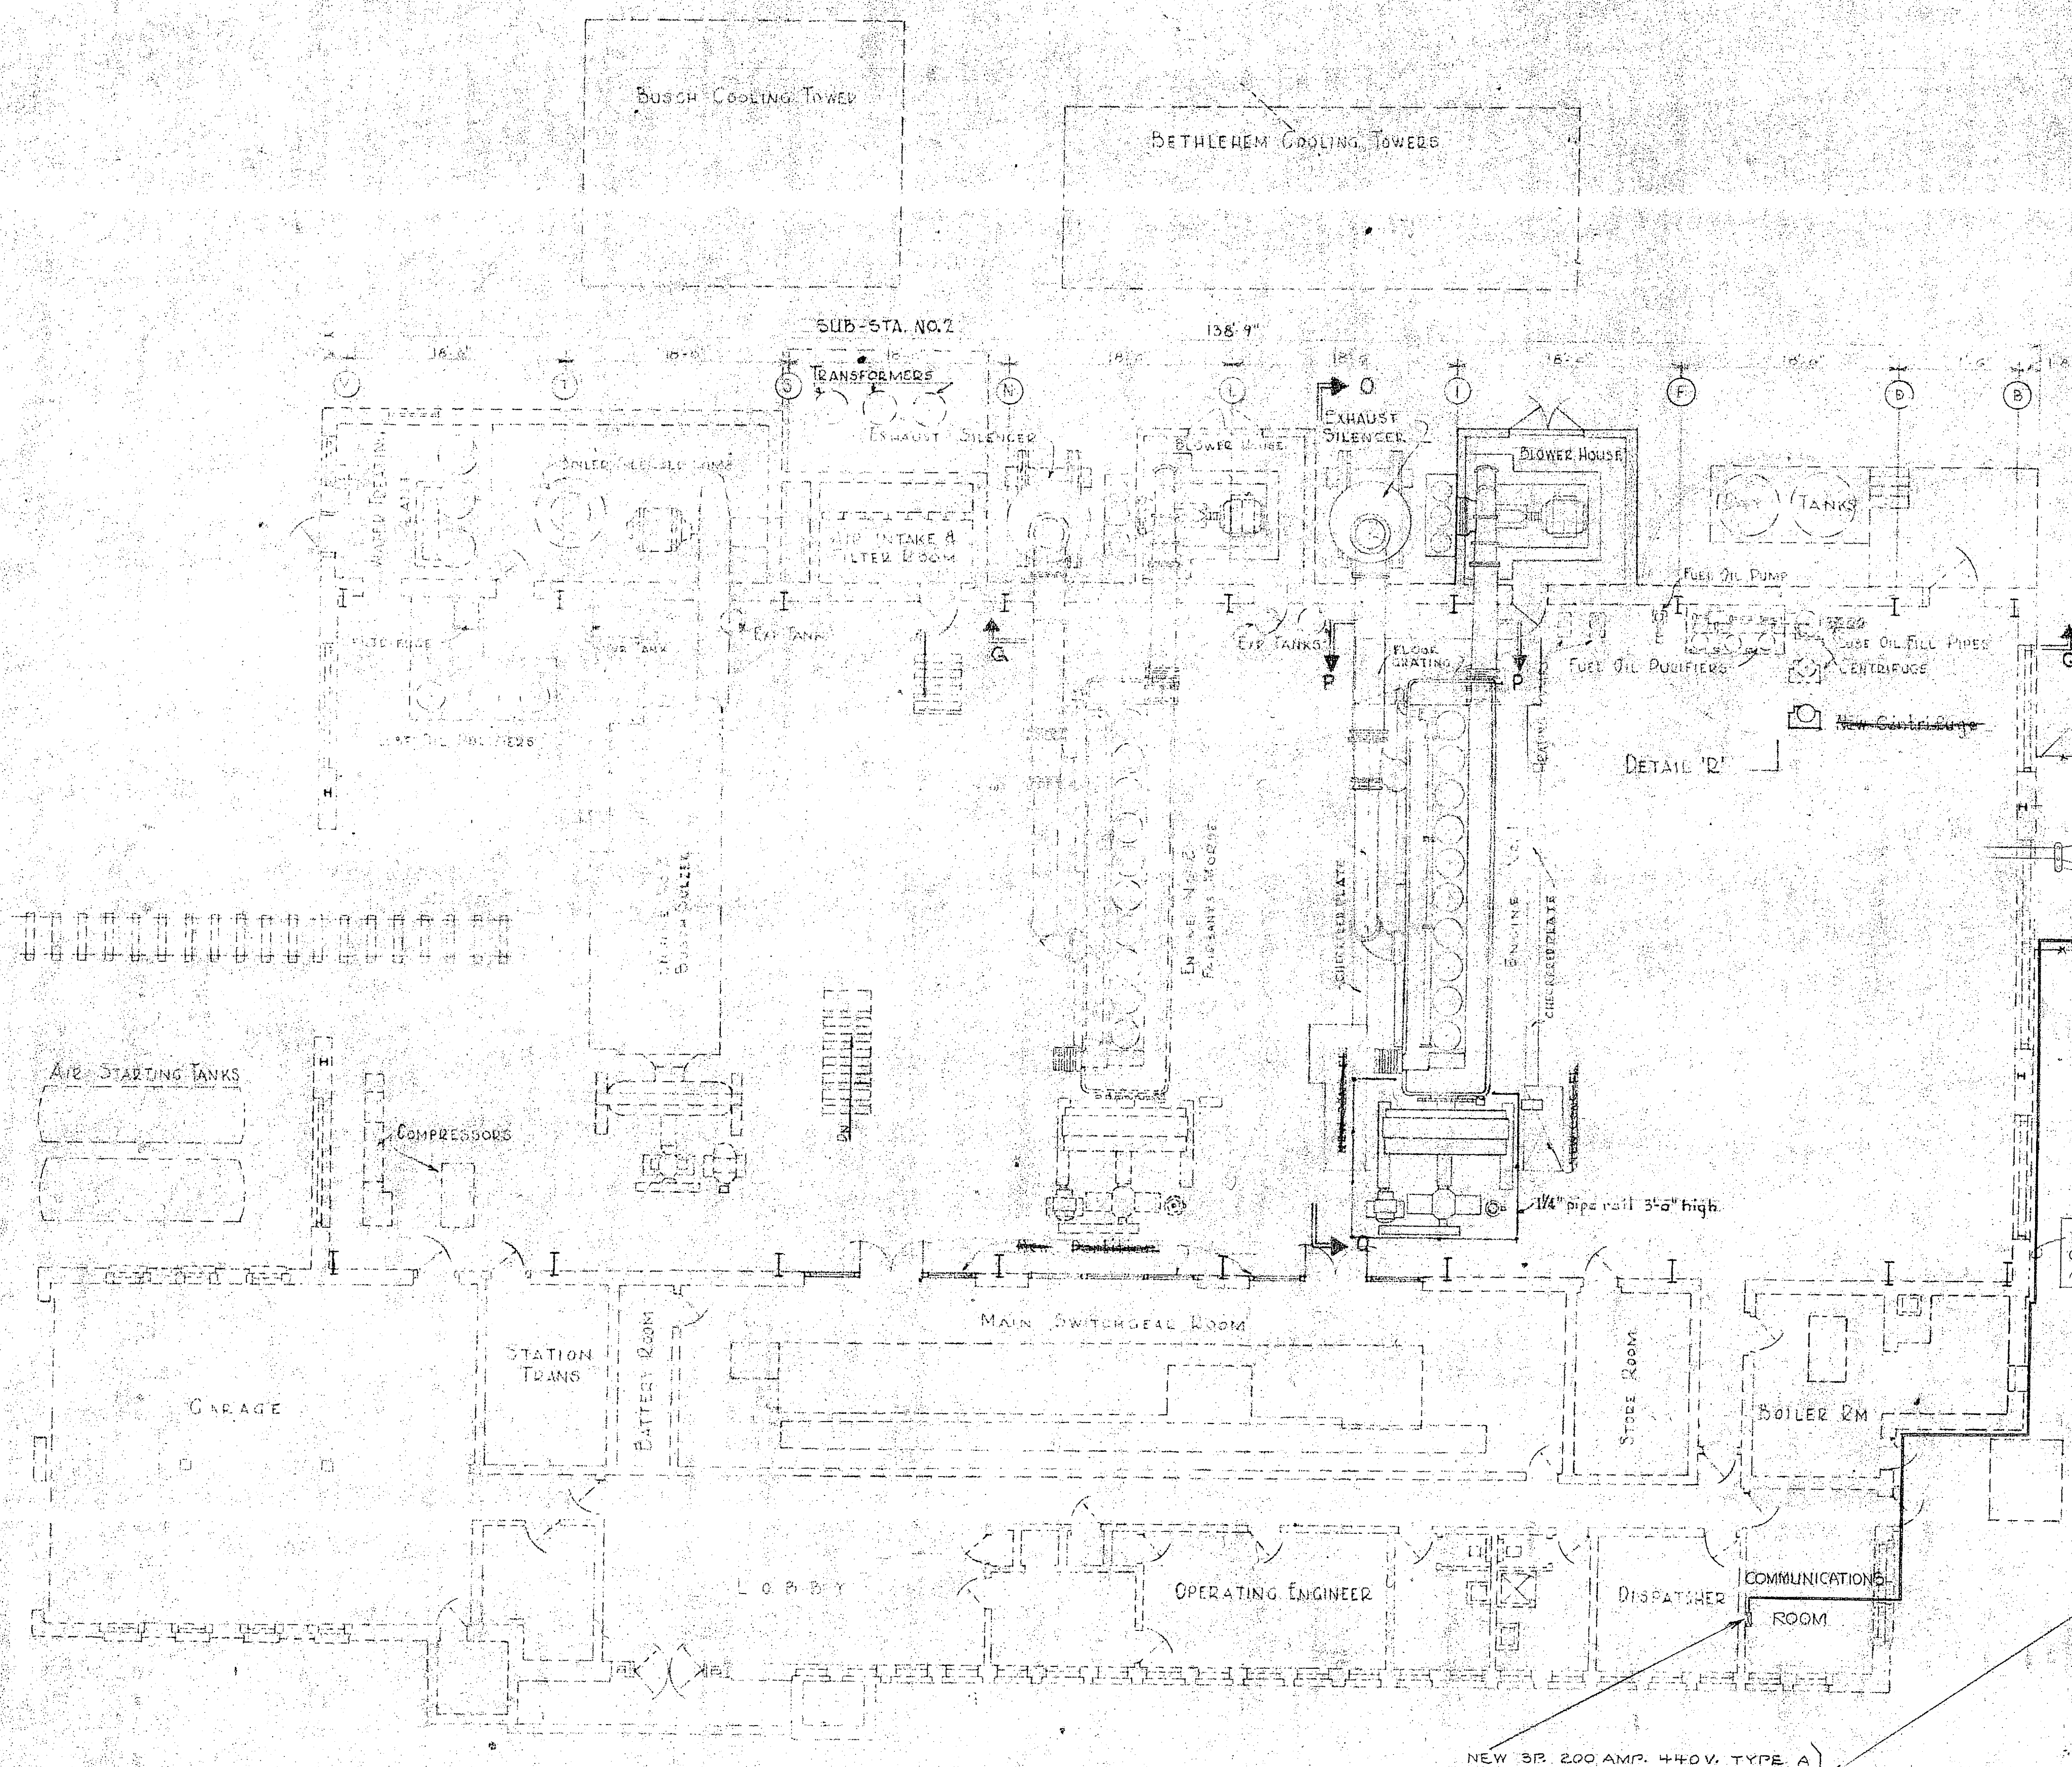


OPERATING FLOOR PLAN
Scale 1/8" = 1'-0"

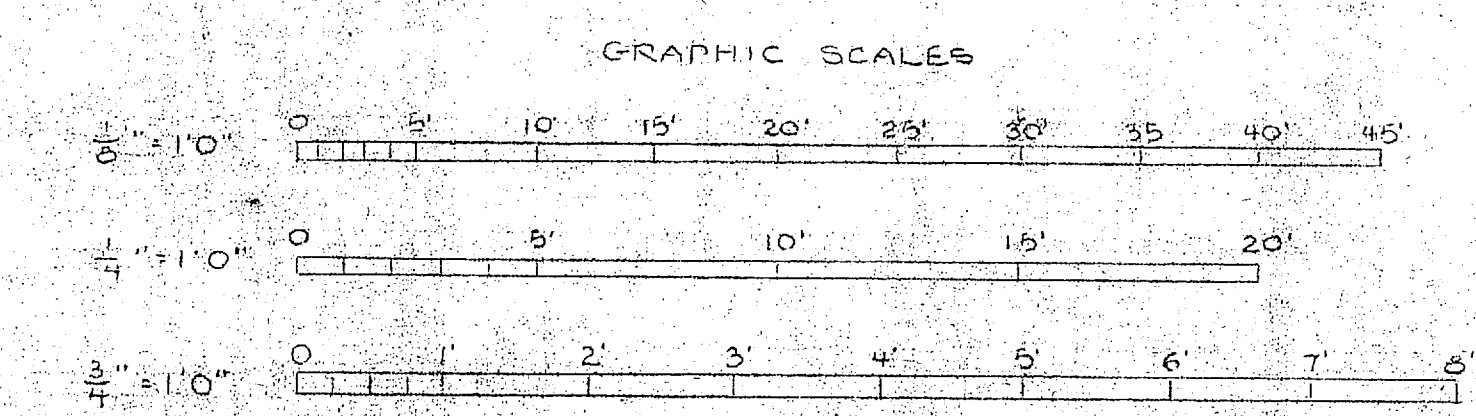

NOTE: DIMENSIONS AND ELEVATIONS
WERE SHOWN ON DRAWING IN FIGURES
SHALL BE USED IN PREFERENCE TO SCALY
MEASUREMENTS.

SATISFACTORY TO
THE QUARTERMASTER GENERAL OF
THE MARINE CORPS
DATE

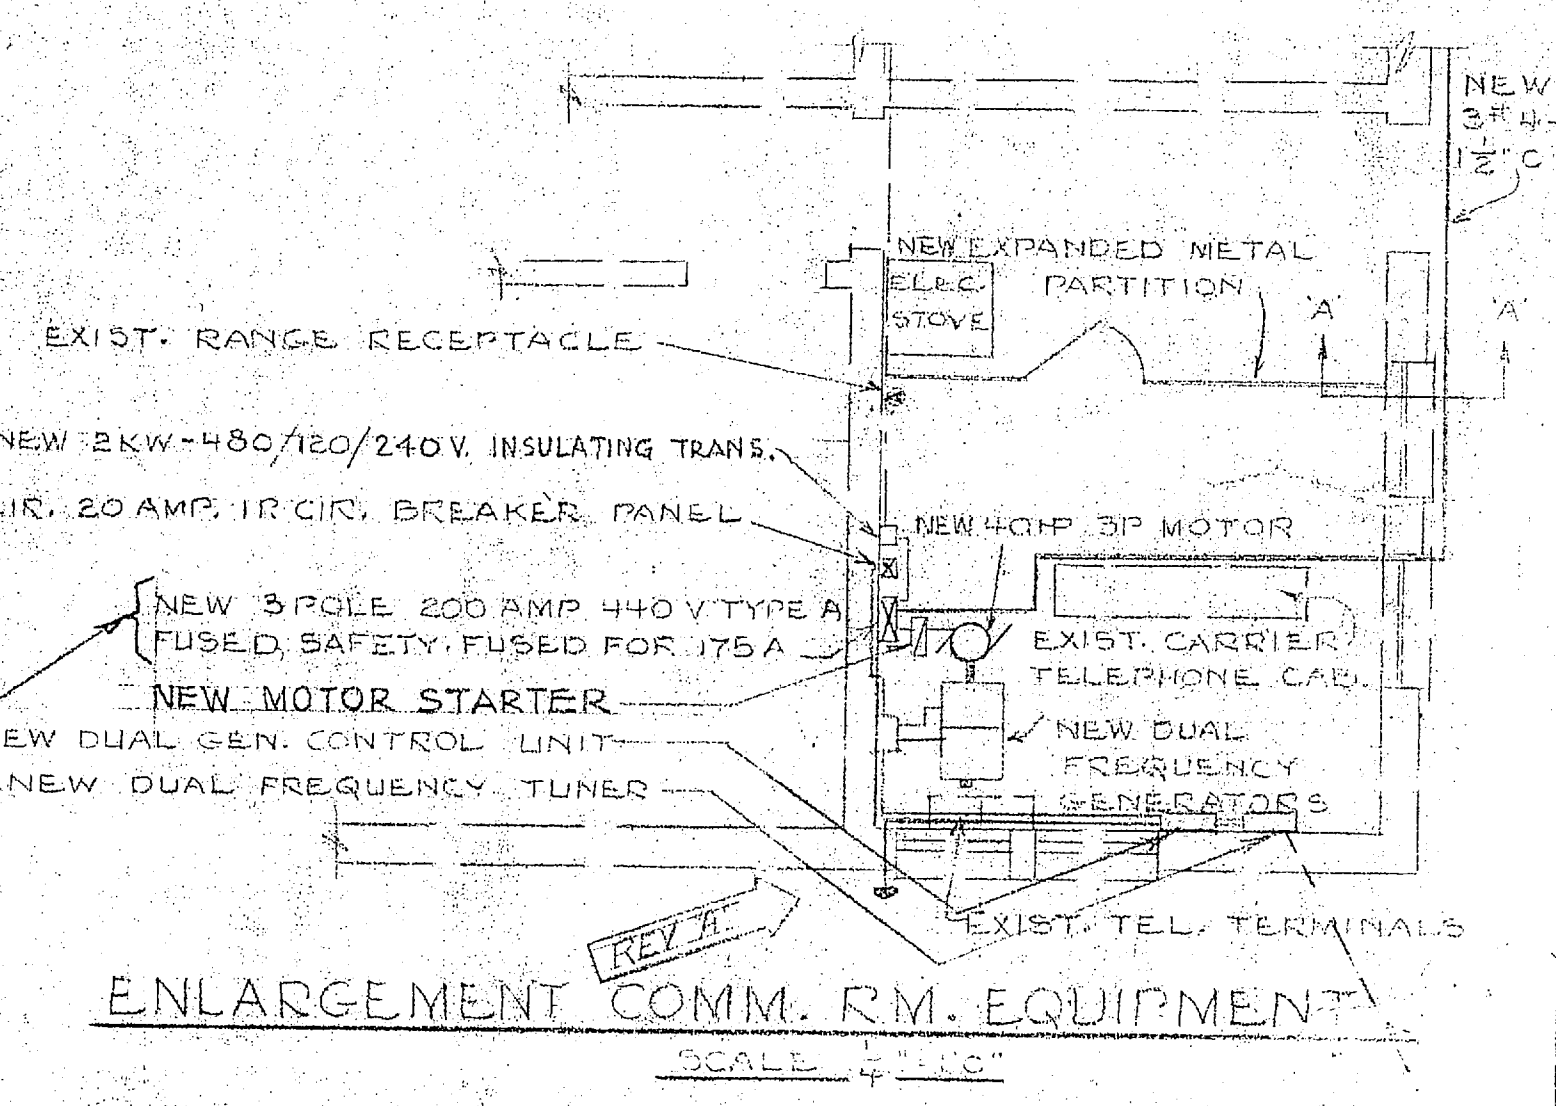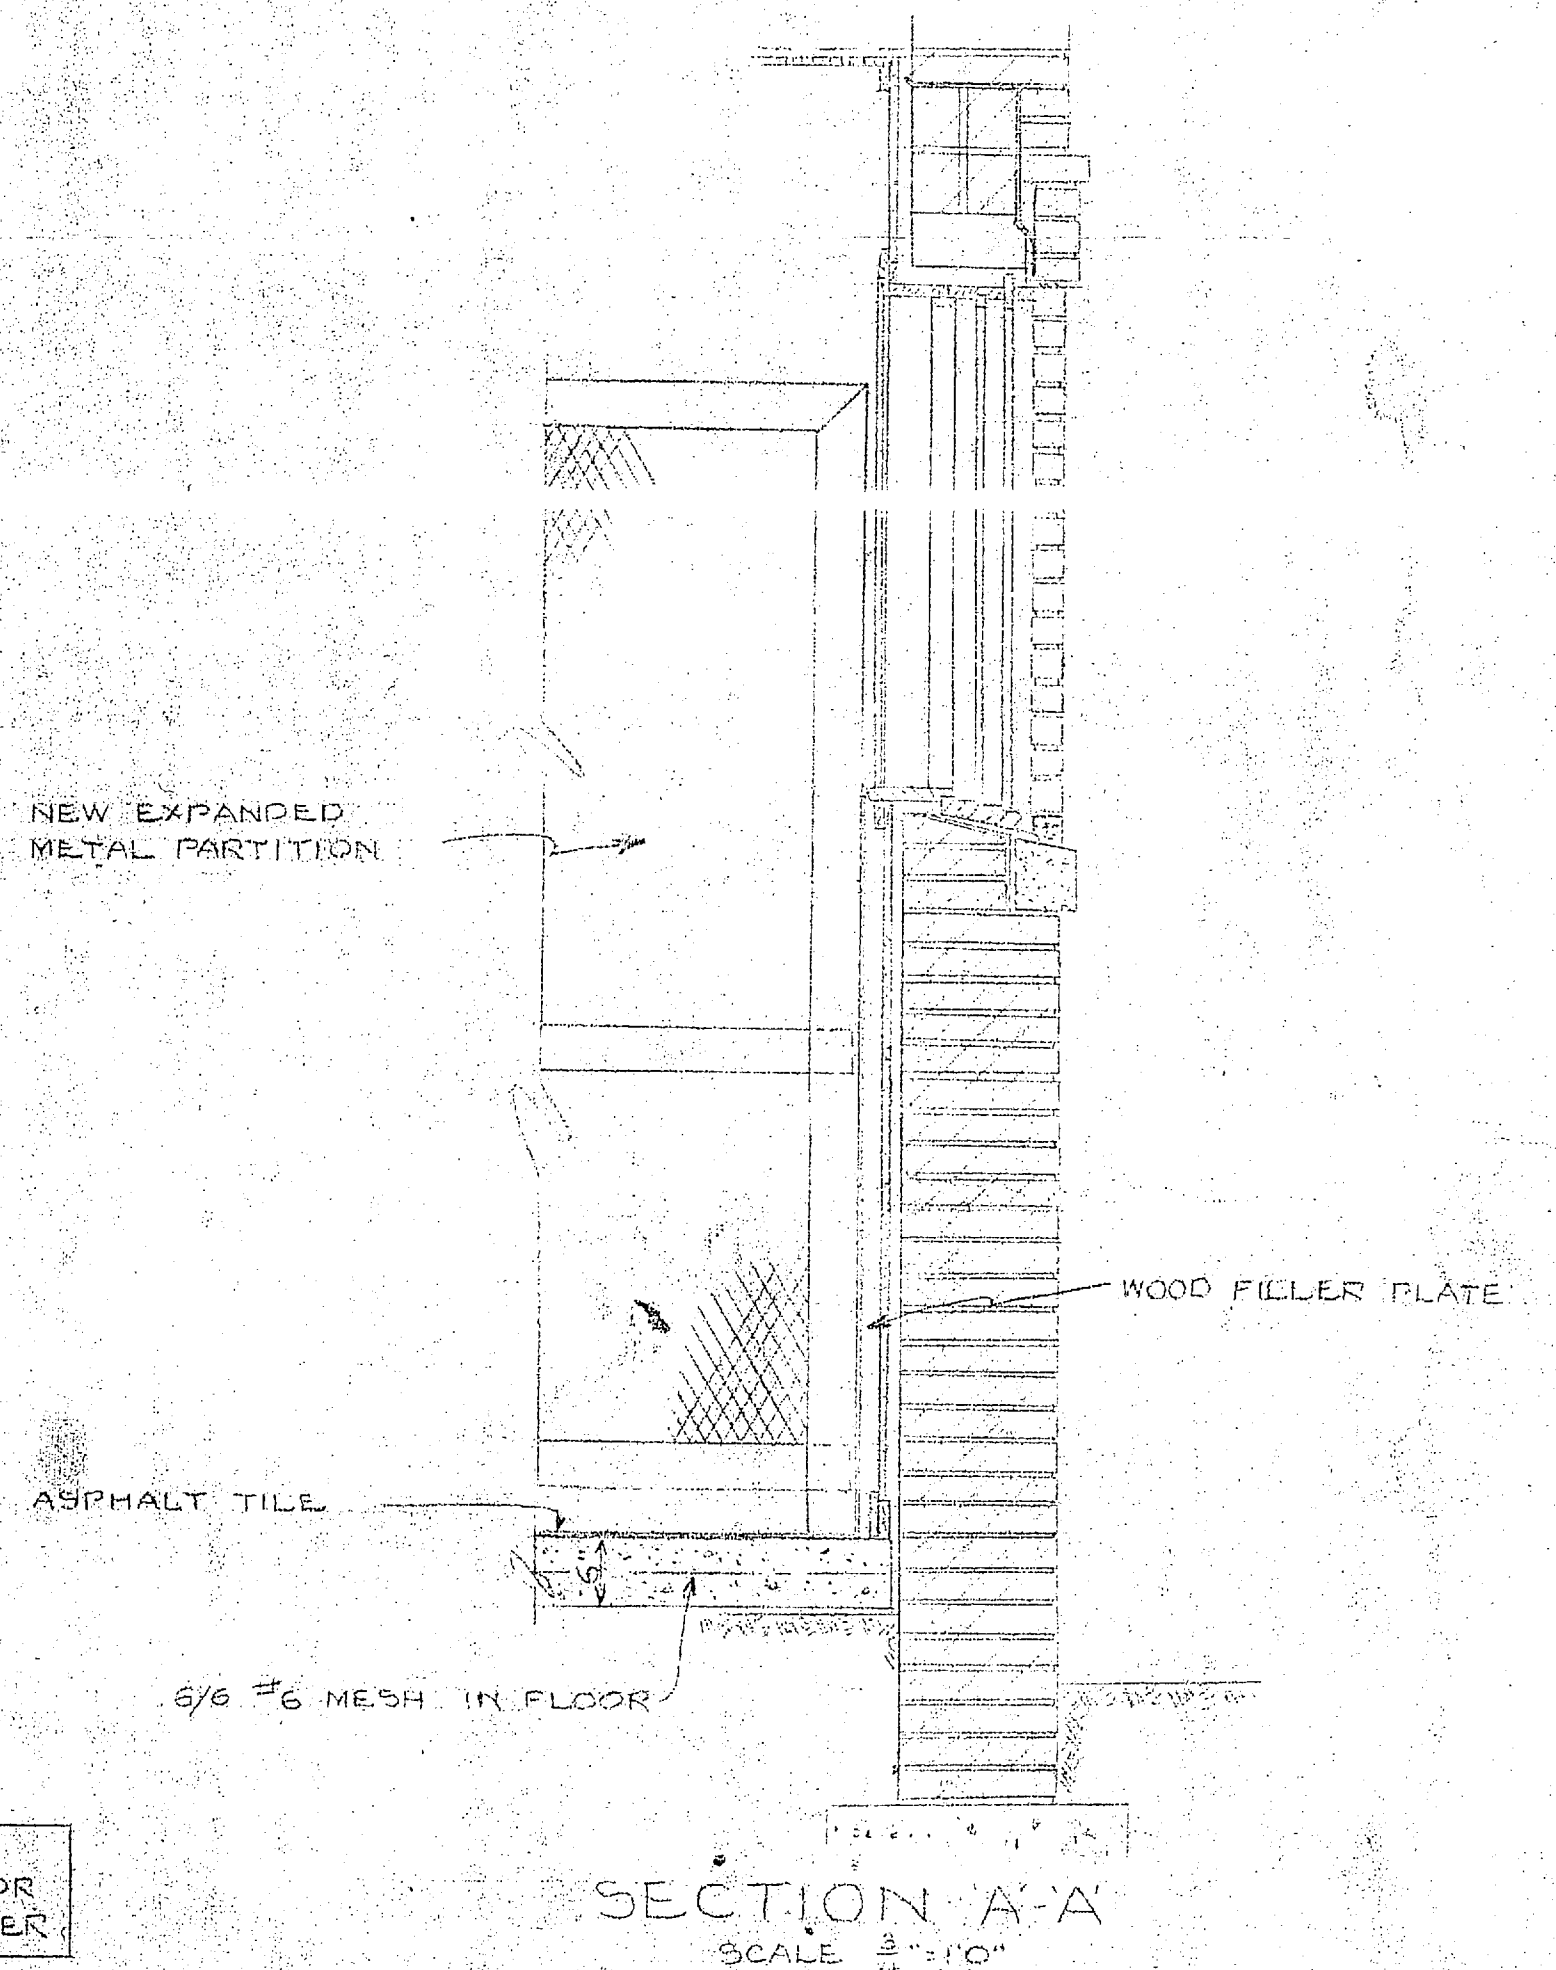

REVISION	DATE	APPD	DESCRIPTION	BY
A	3/16/51	WVC	AS-BUILT REVISION	
P.W. DRAWING NO.		MARINE CORPS BASE CAMP LEJUNE, N.C.		
10479		RAW WATER CONTROL SYSTEM, HADNOT POINT LEJUNE GENERATING PLANT, WIRING - PARTITION - EQUIPMENT LAYOUTS		
DES	WVC	DATE 3/16/51		
DRWN		APPROVED		
TR		PUBLIC WORKS OFFICER		
CHK		DATE		
SUPV		DATE		
IN CHARGE		DATE		
APPROVED FOR BUREAU OF YARDS & DOCKS		SCALE	GRAPHIC	SPEC 47376
DATE		SHEET 4 OF 5	NO 91286	
DATE		Y & D DRAWING NO.	646679	

