

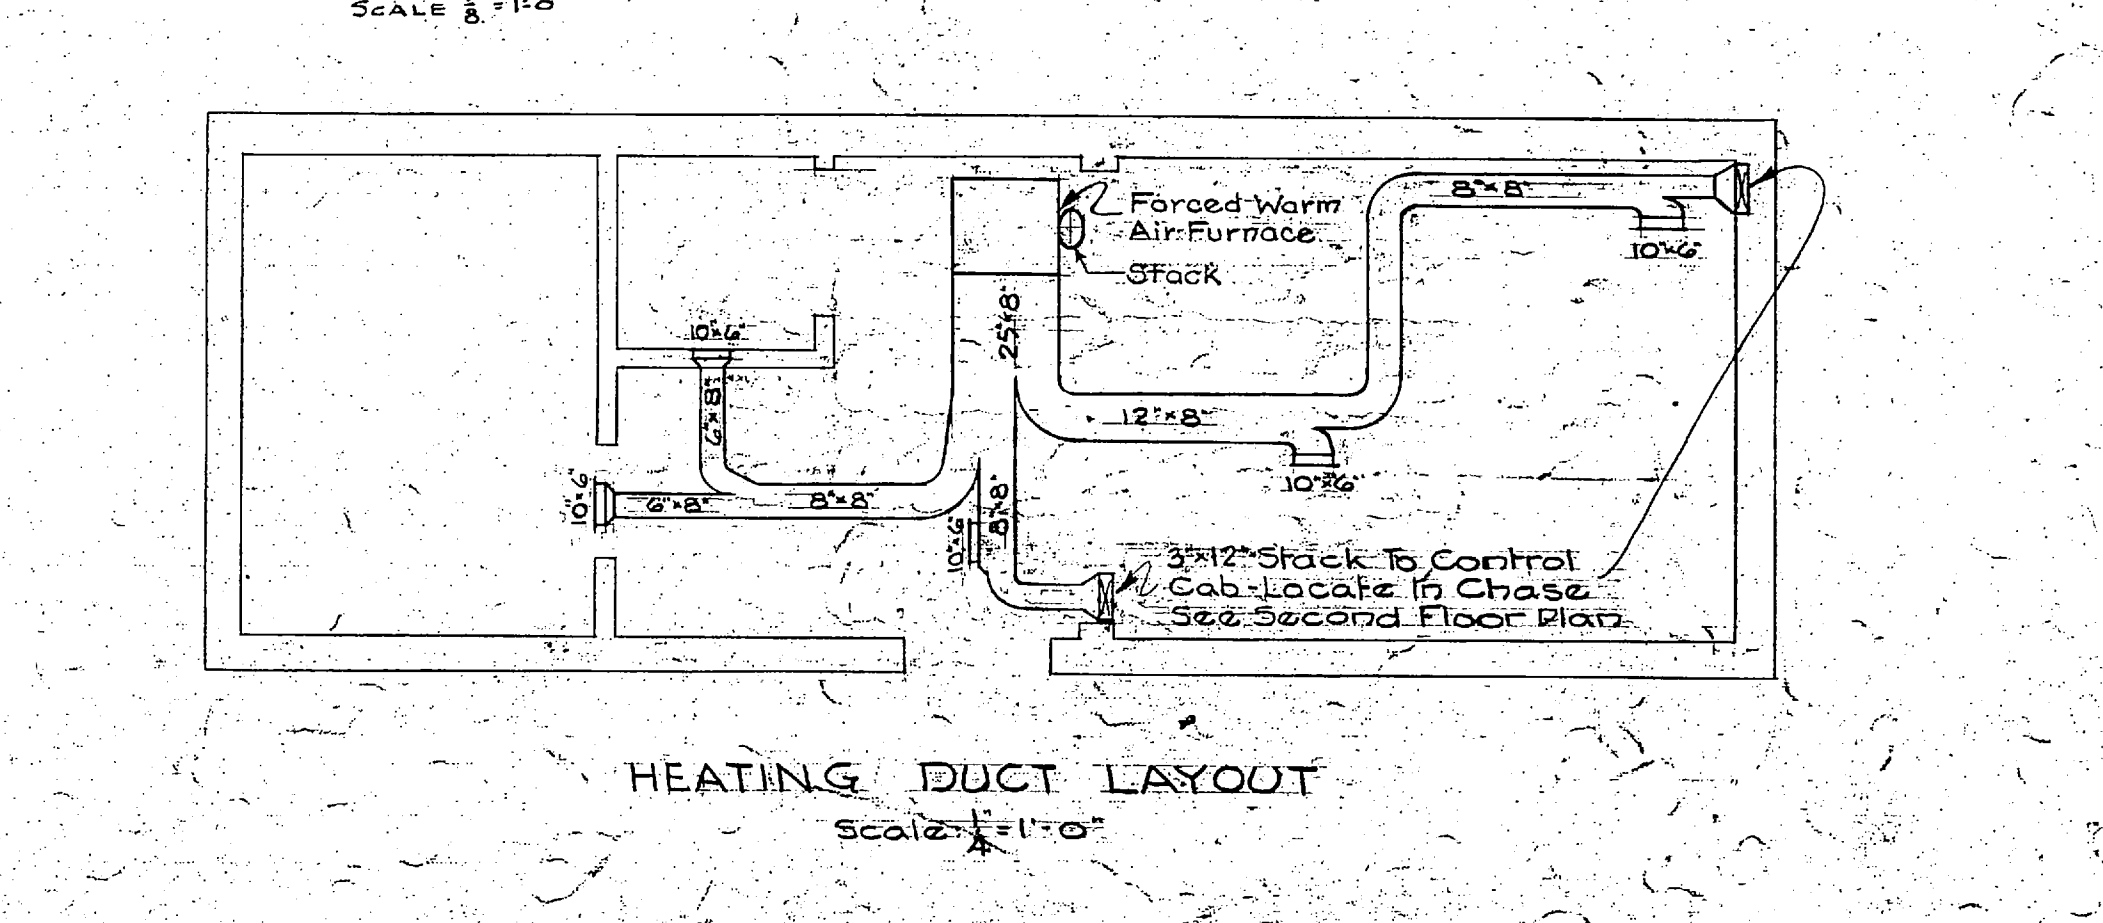
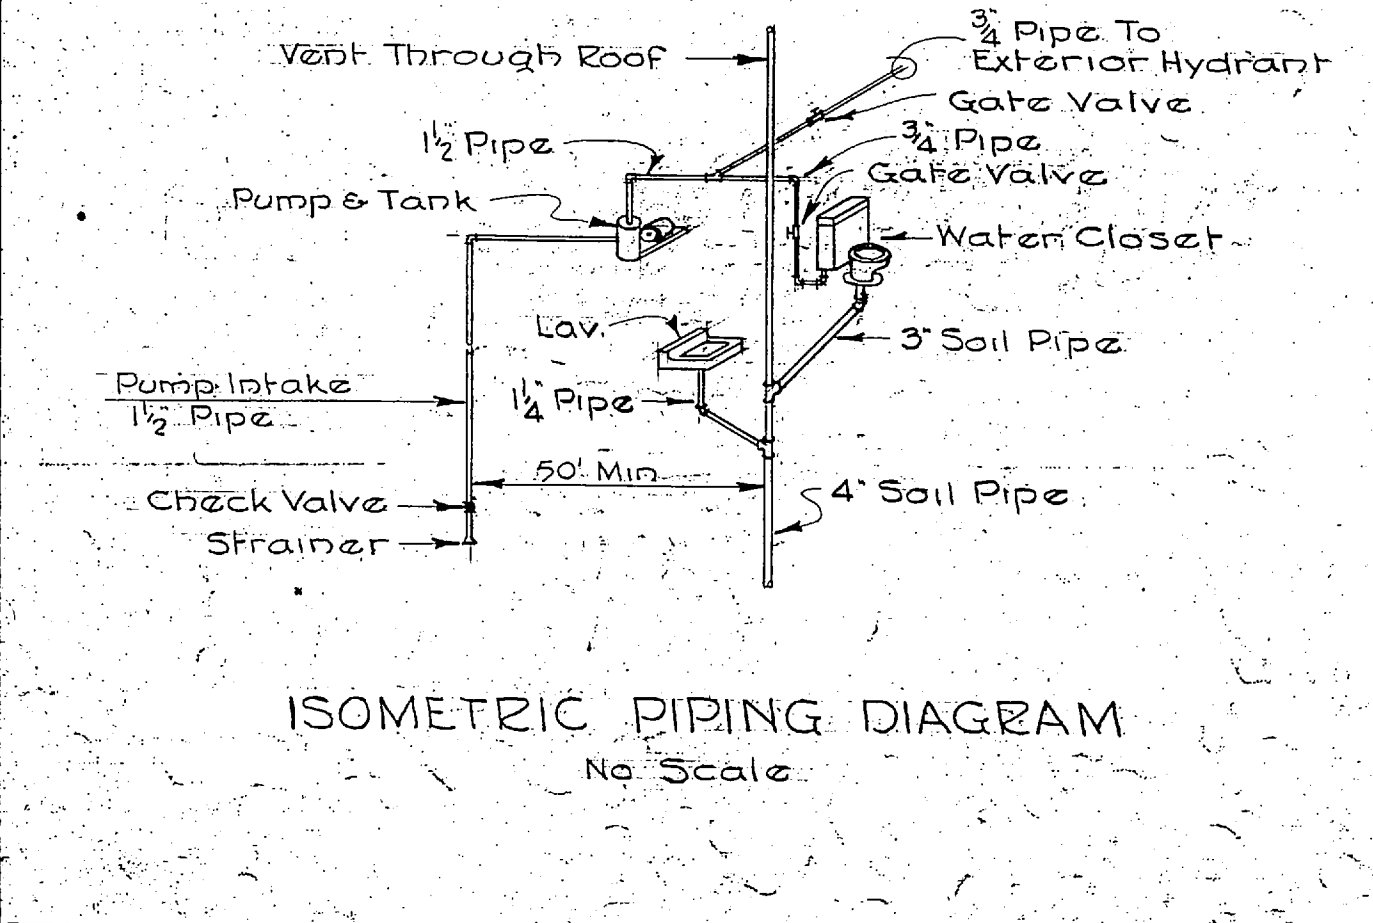
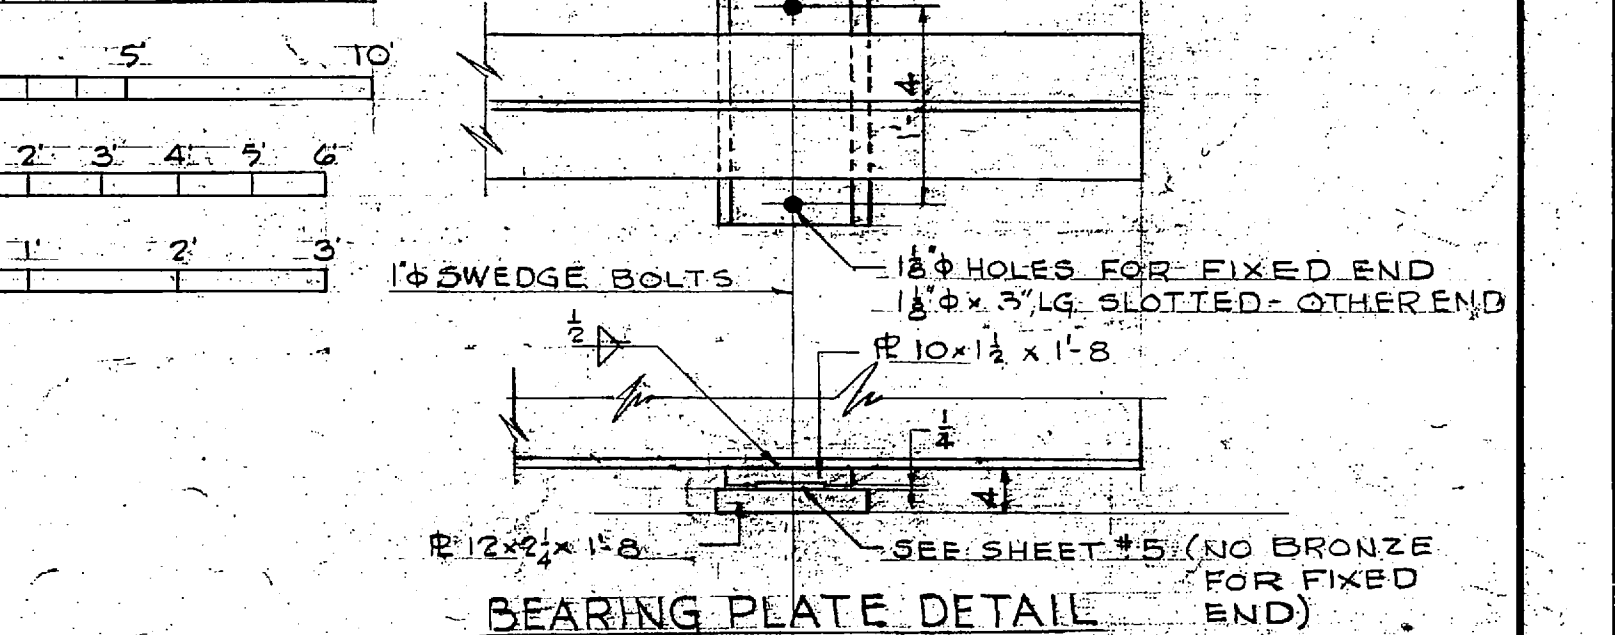
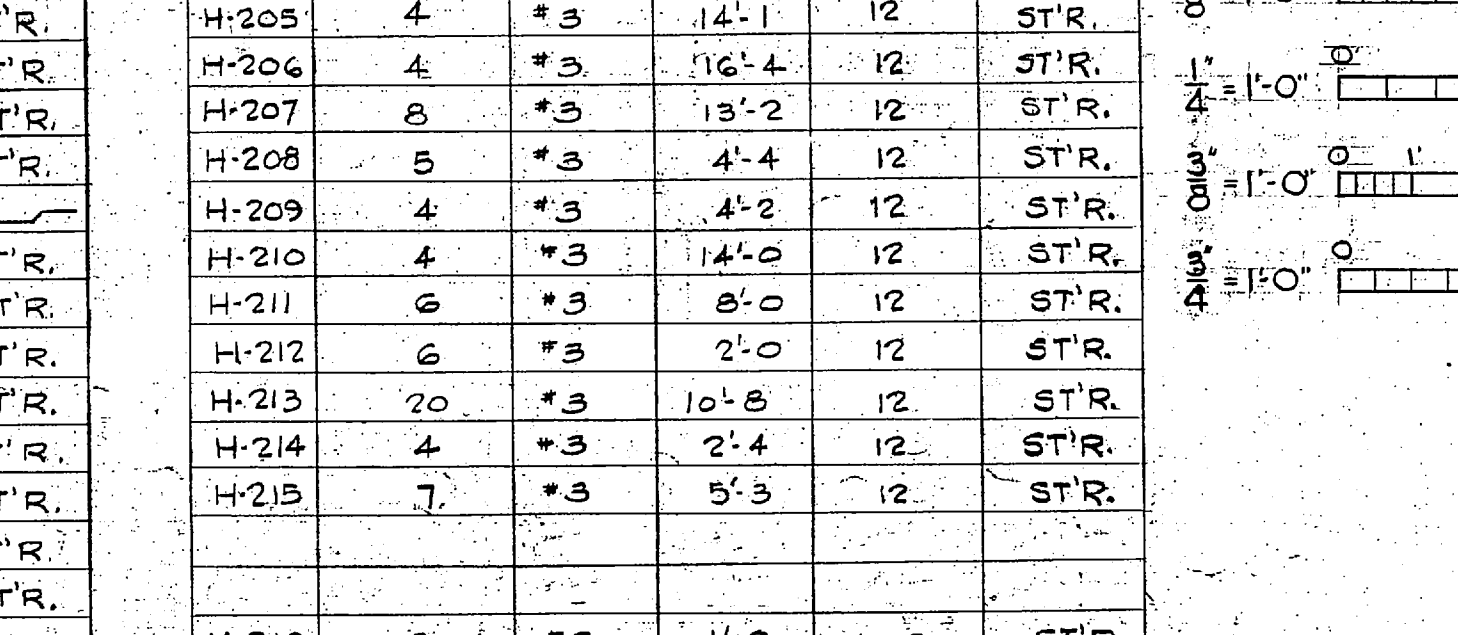
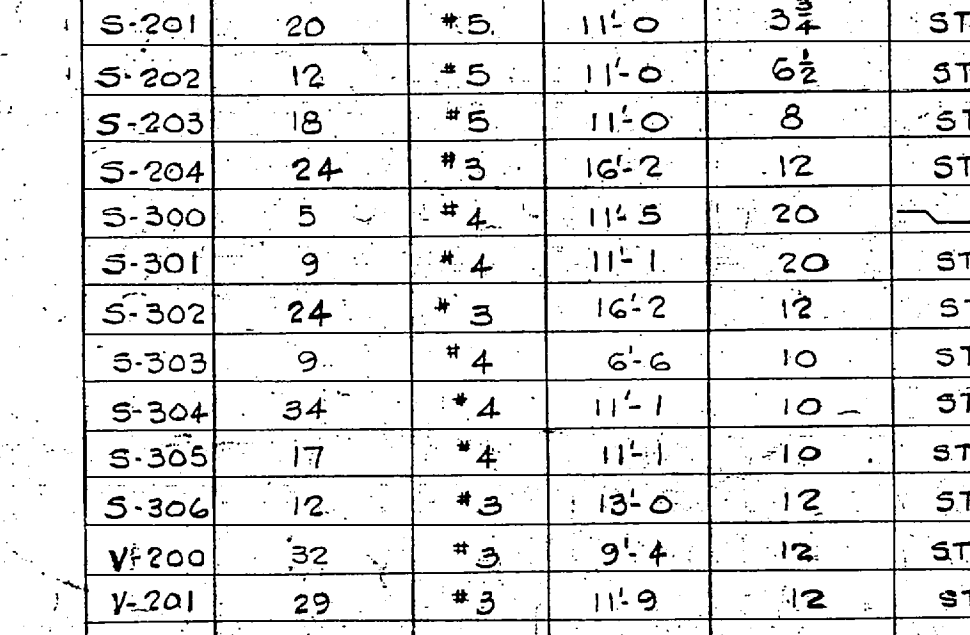
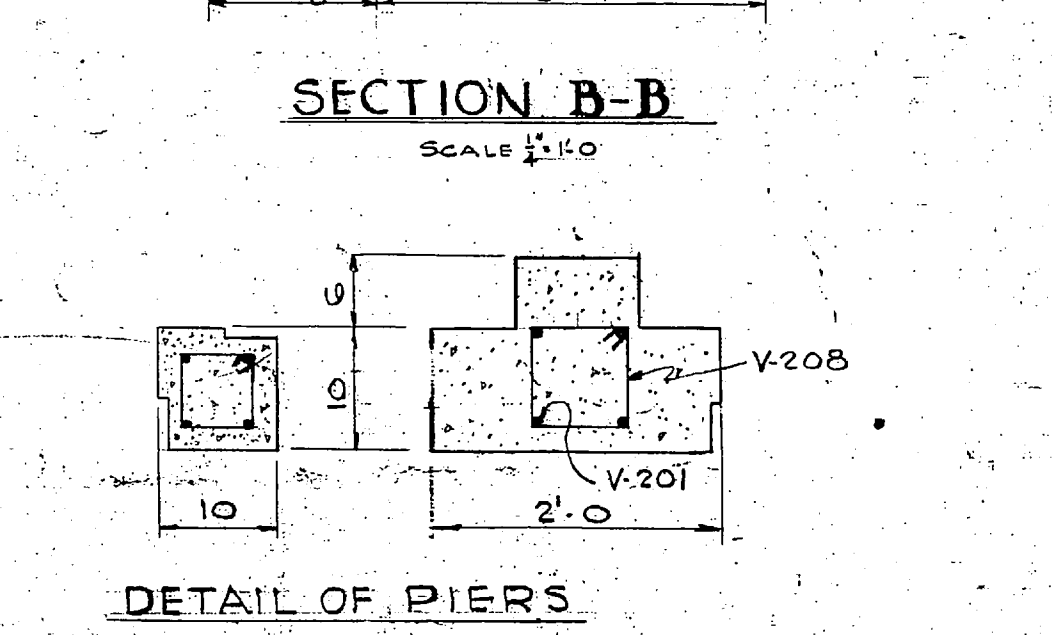
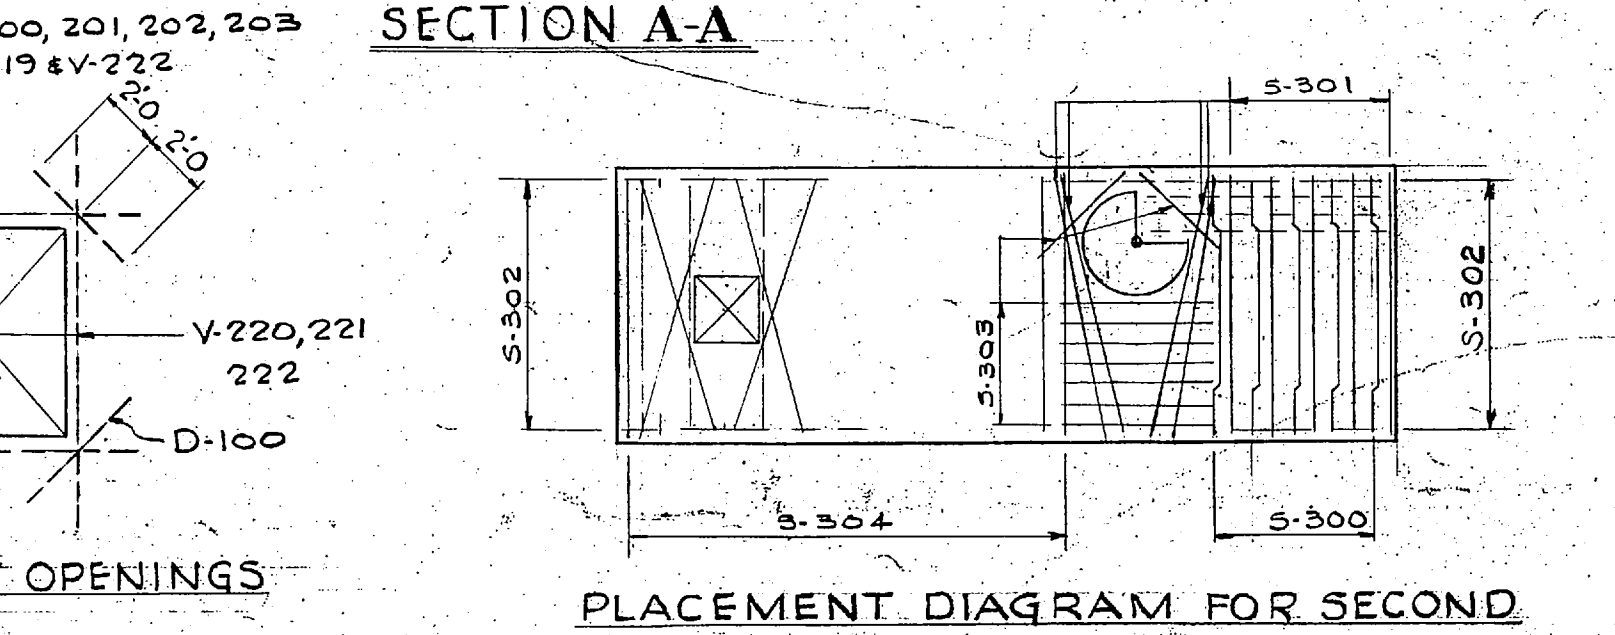
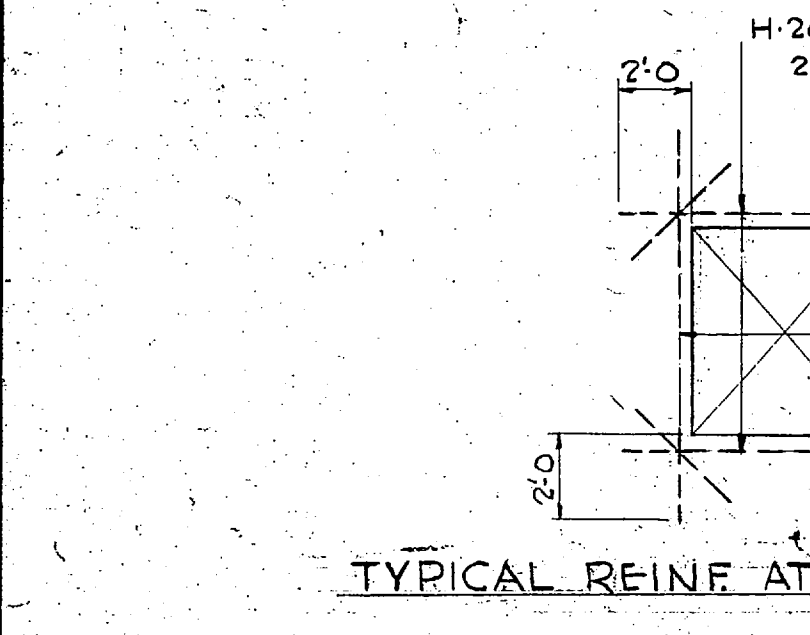
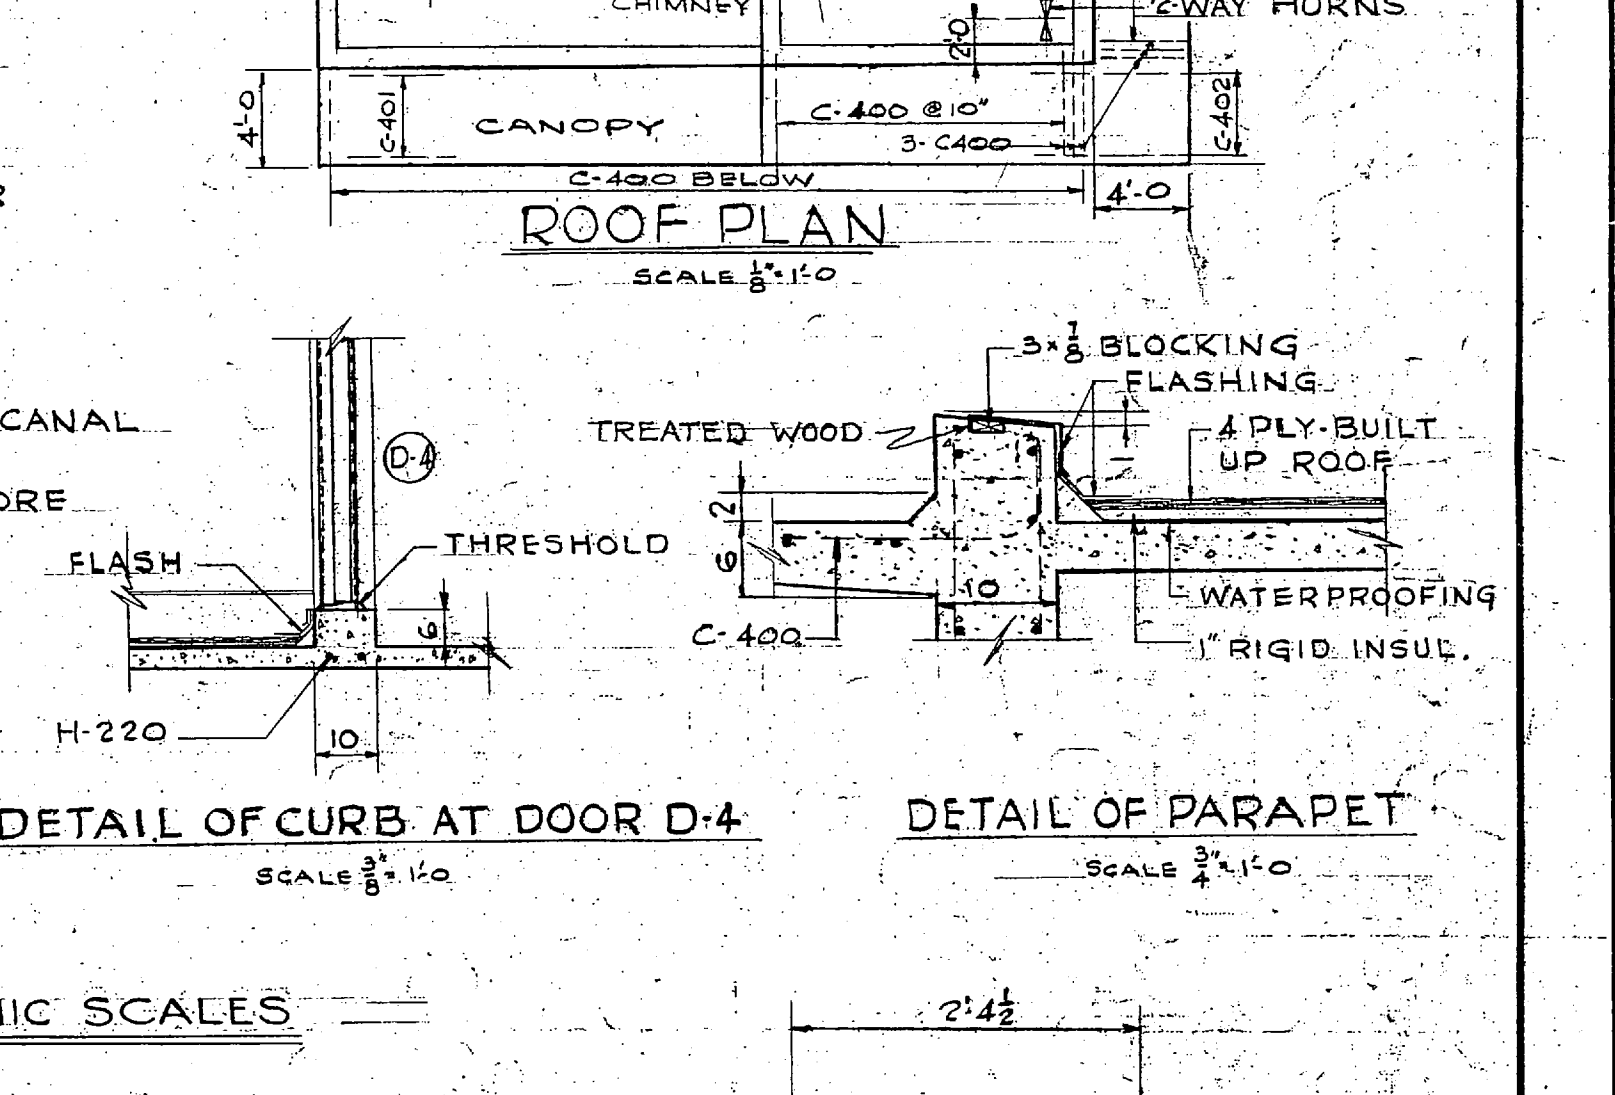
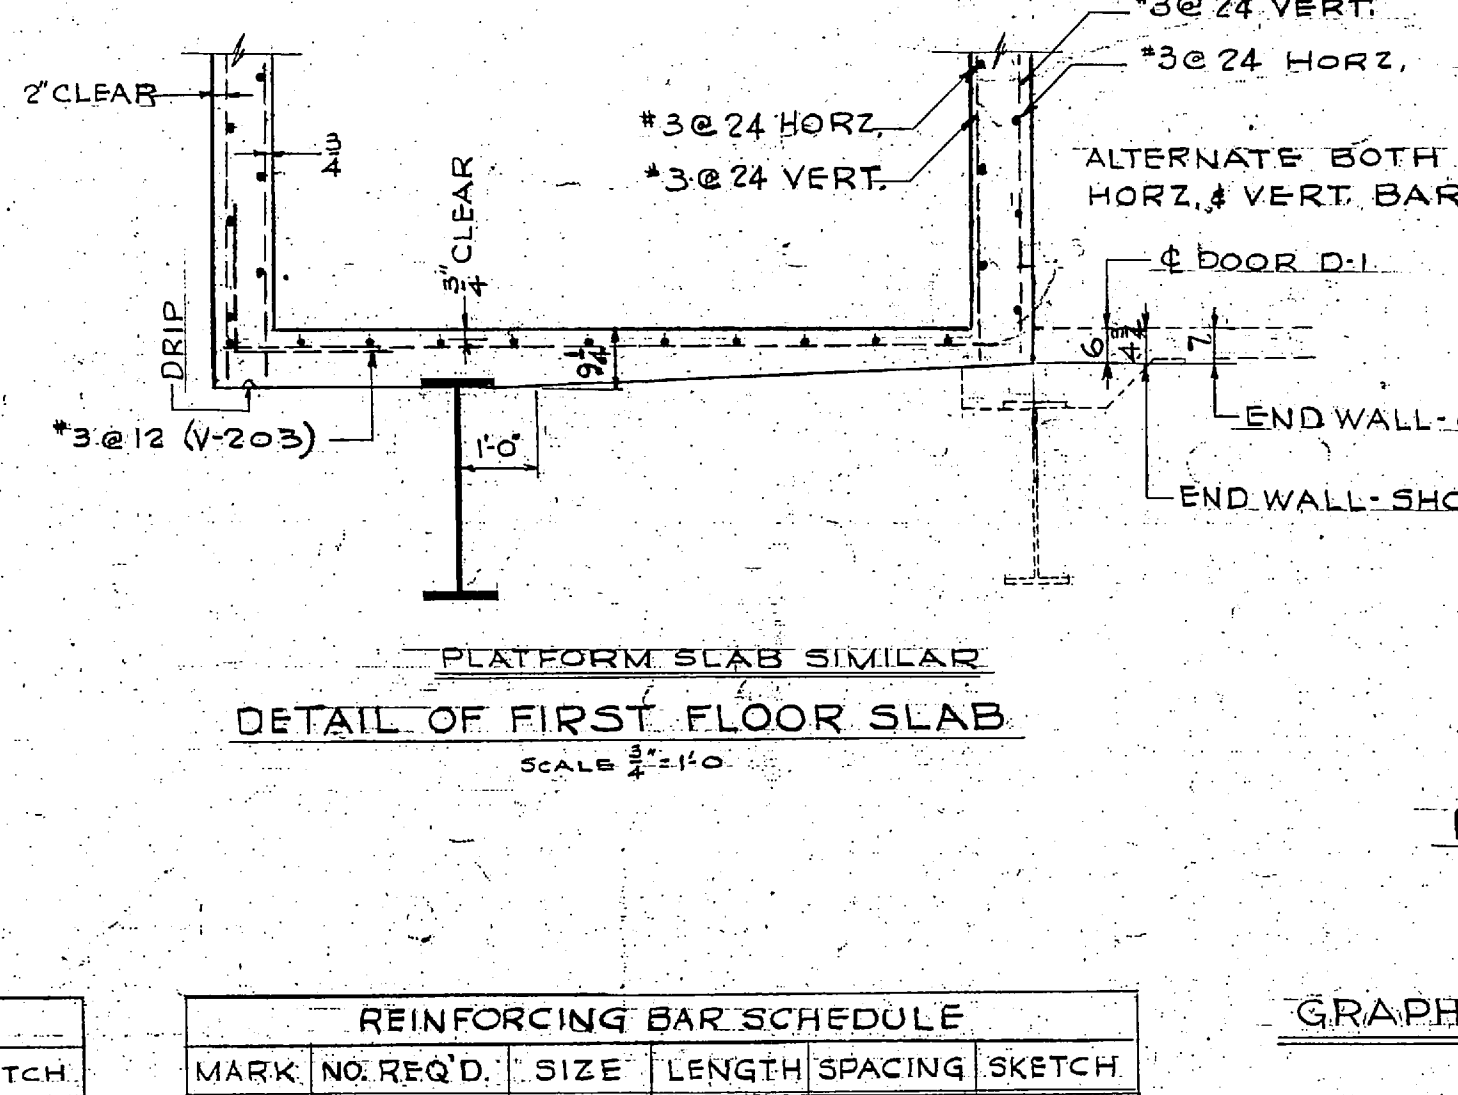
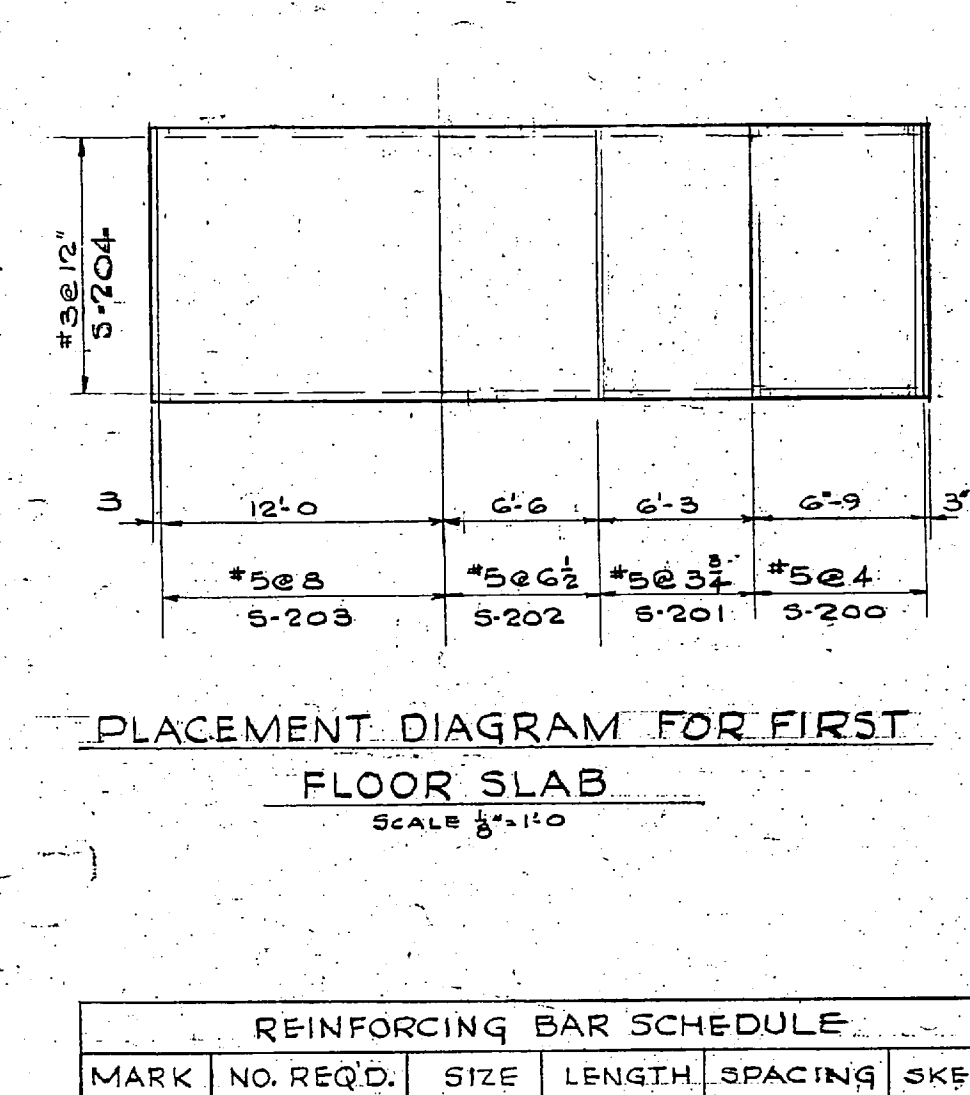
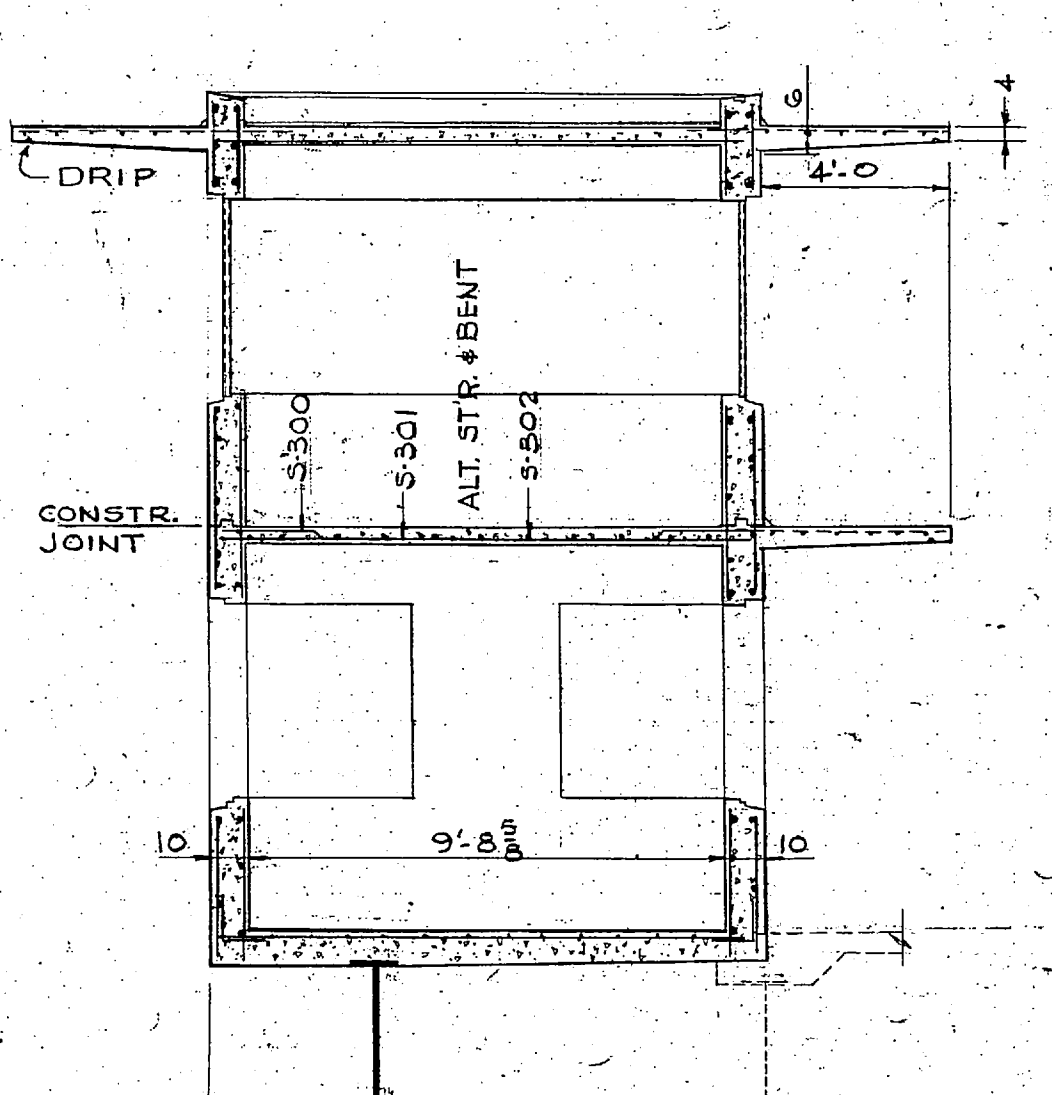
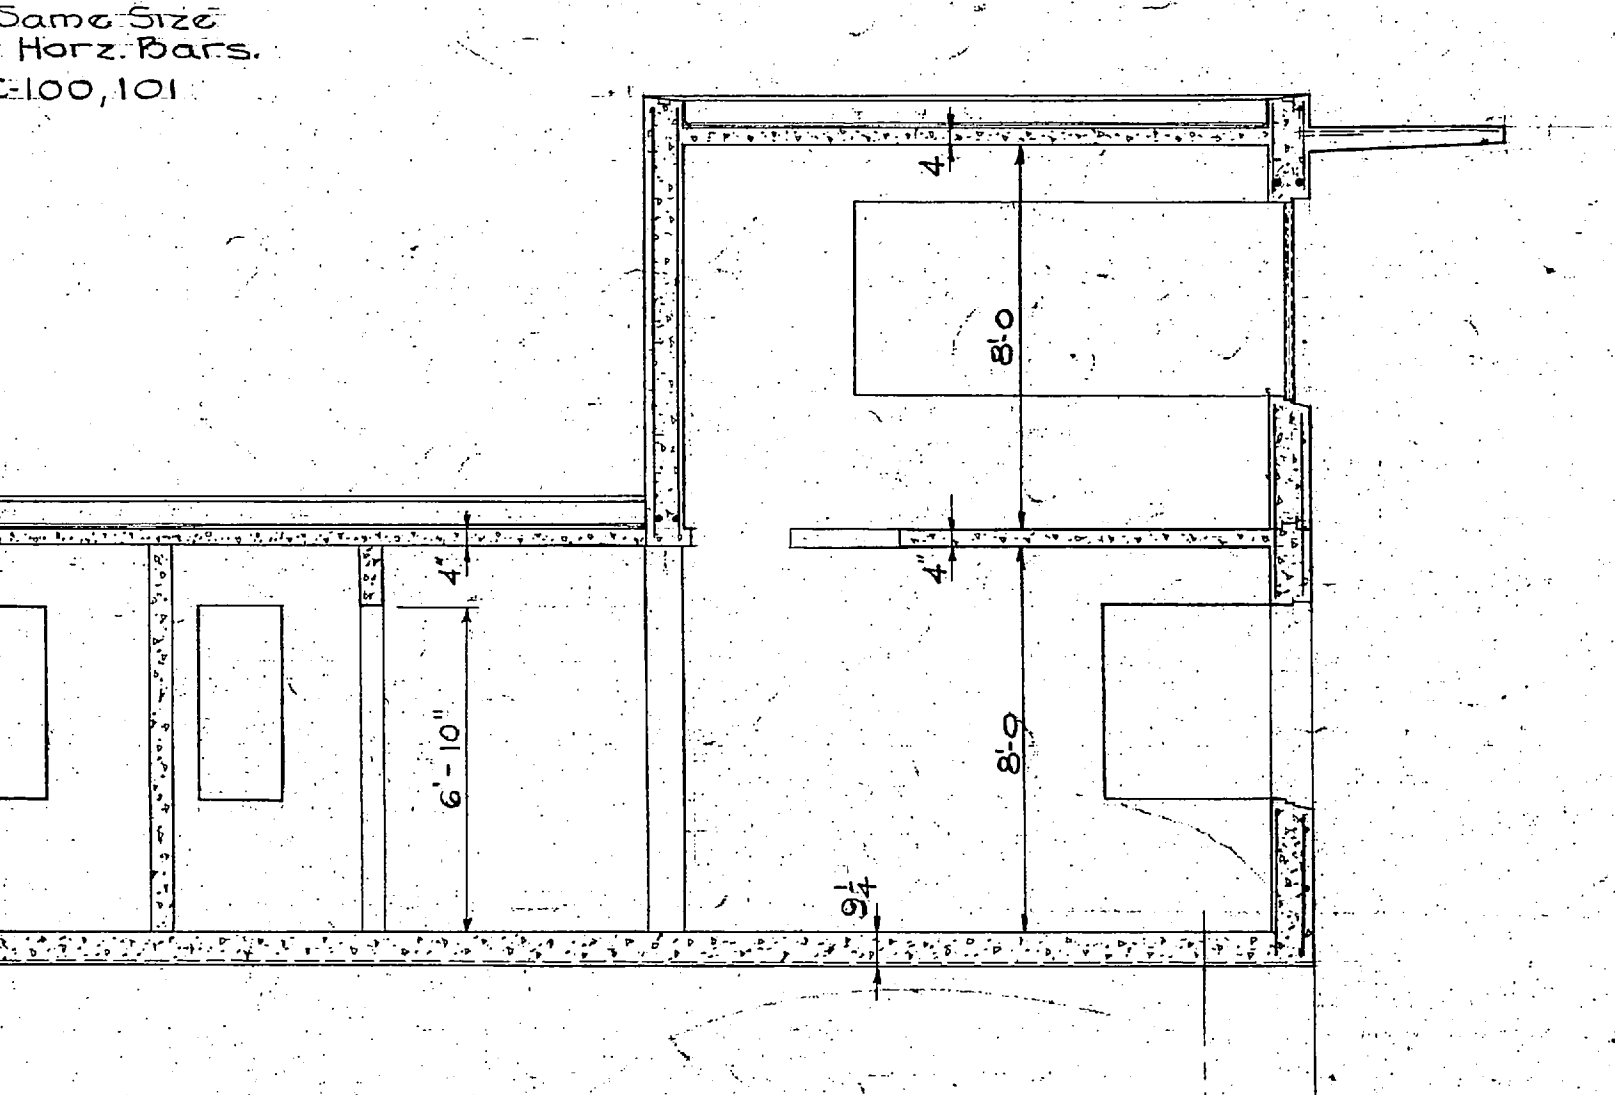
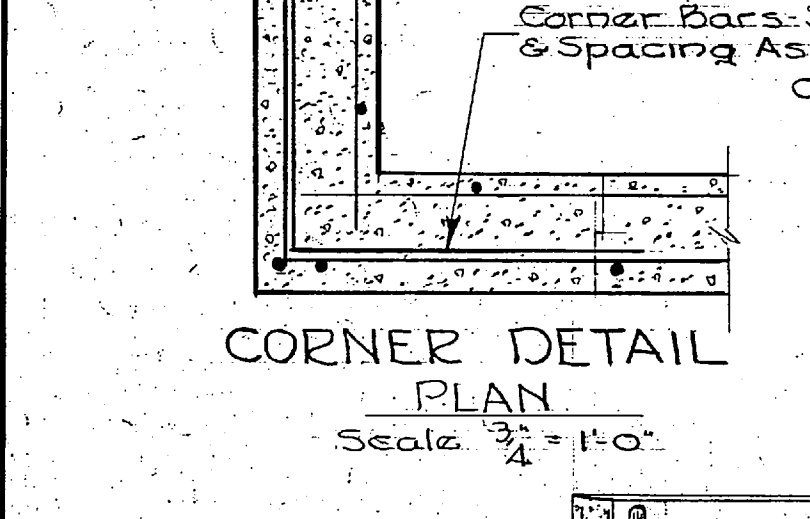
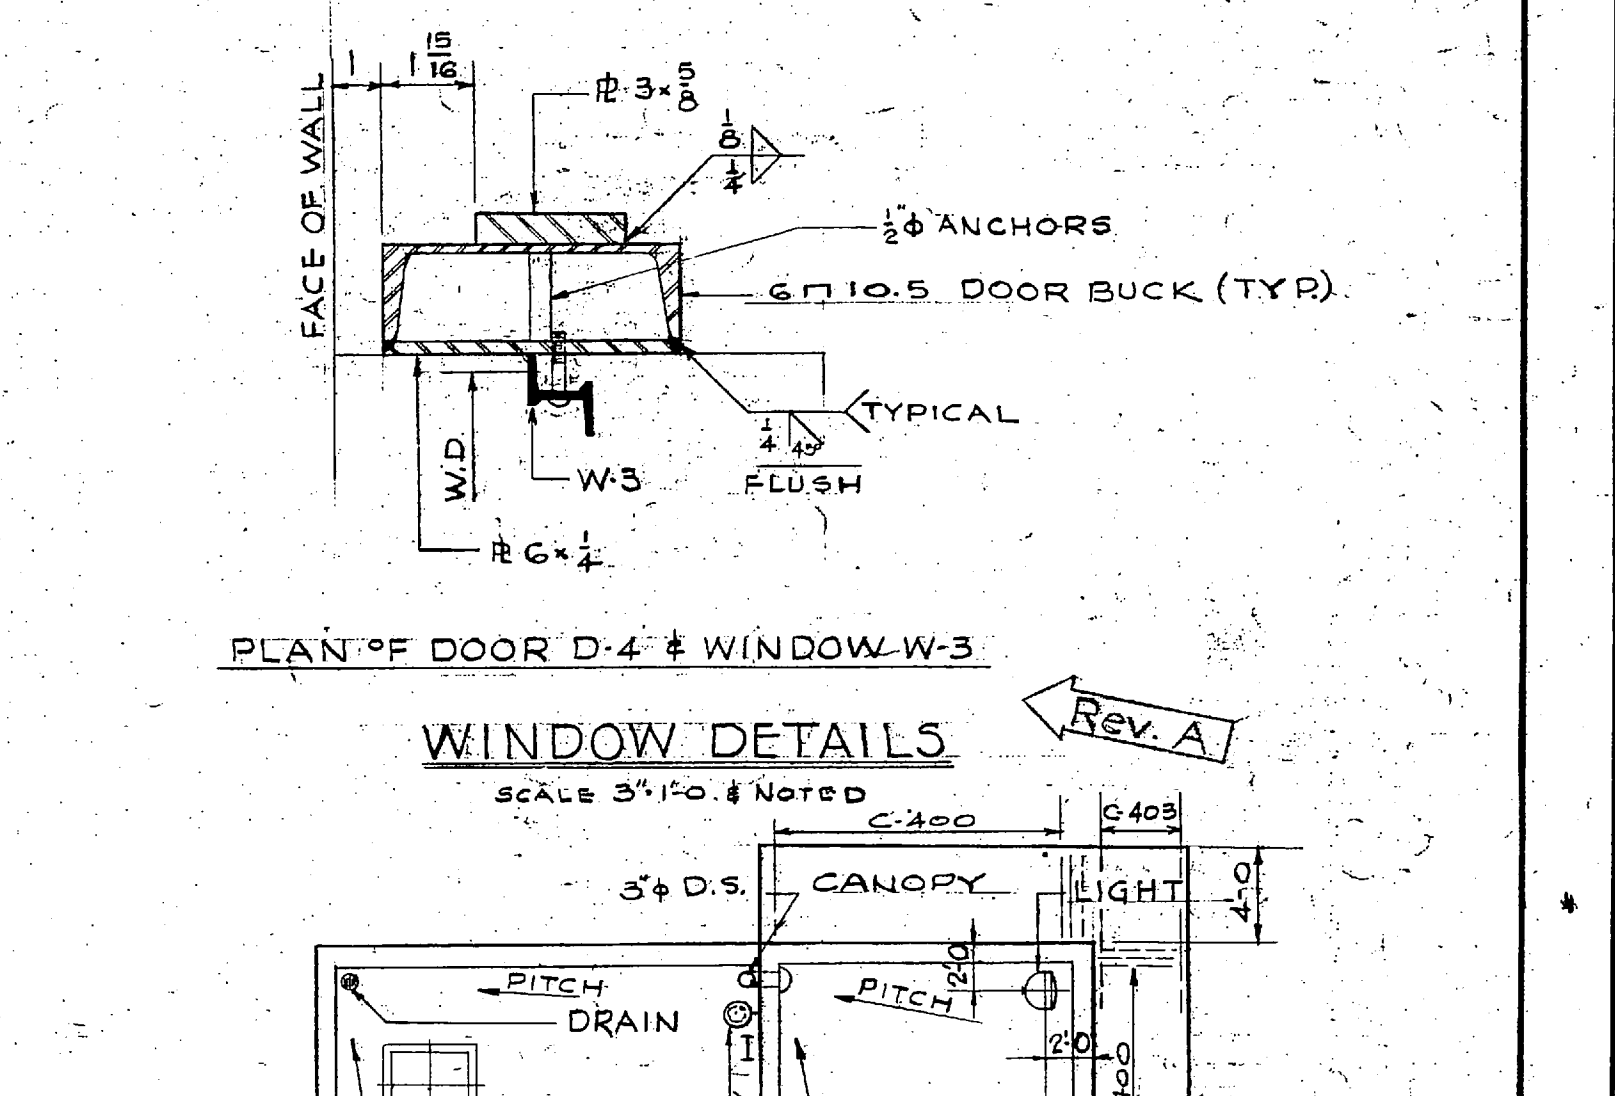
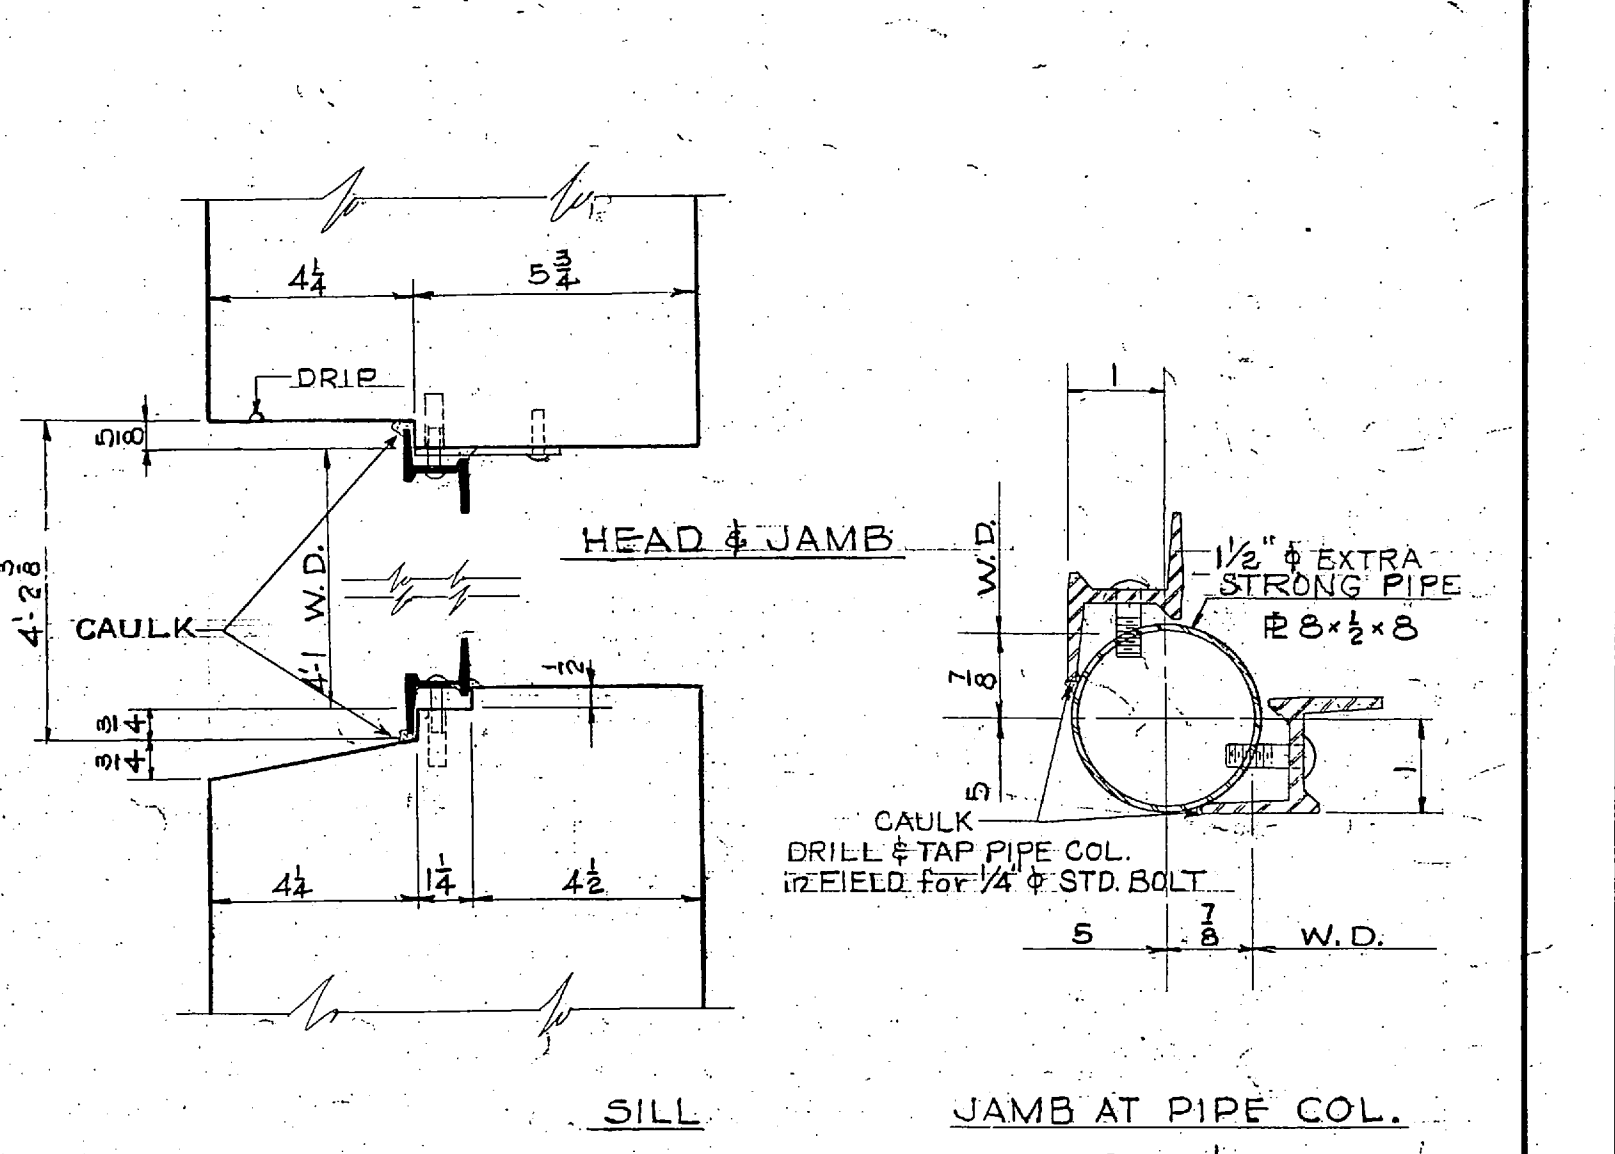
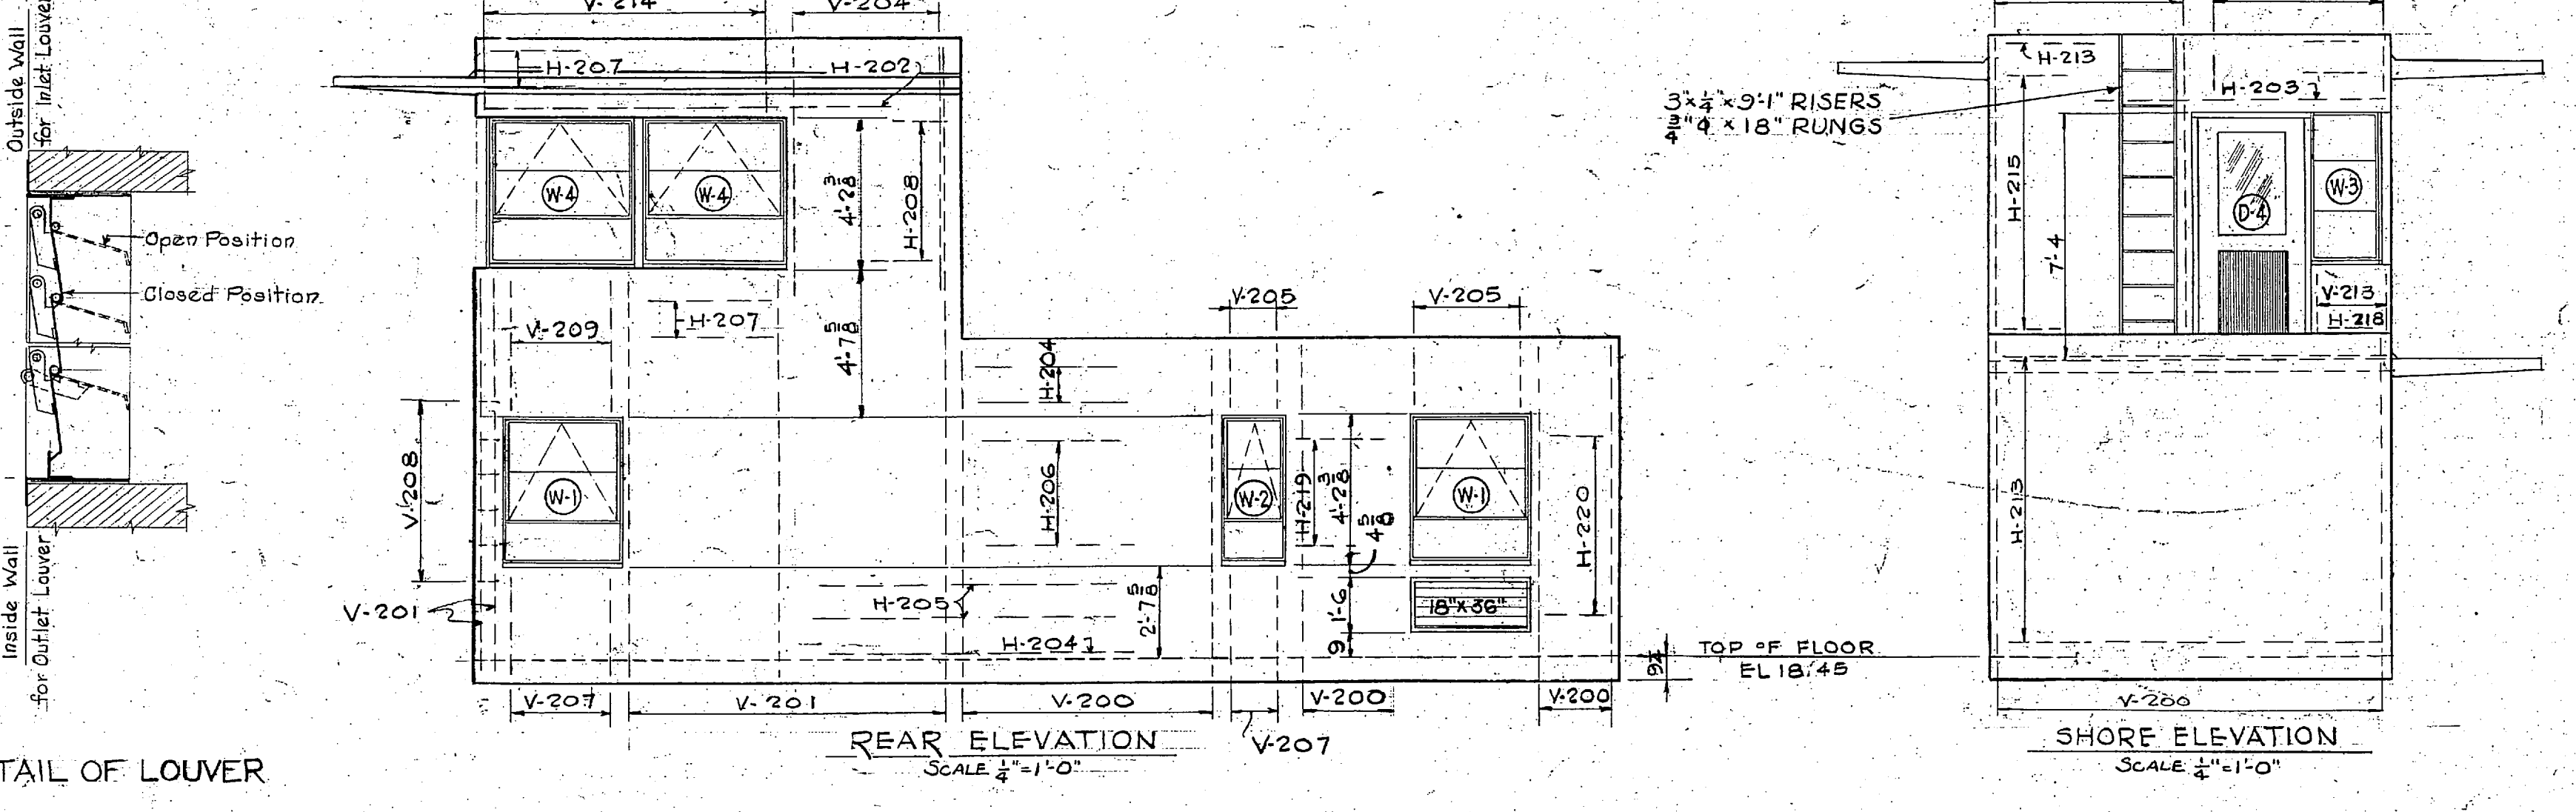
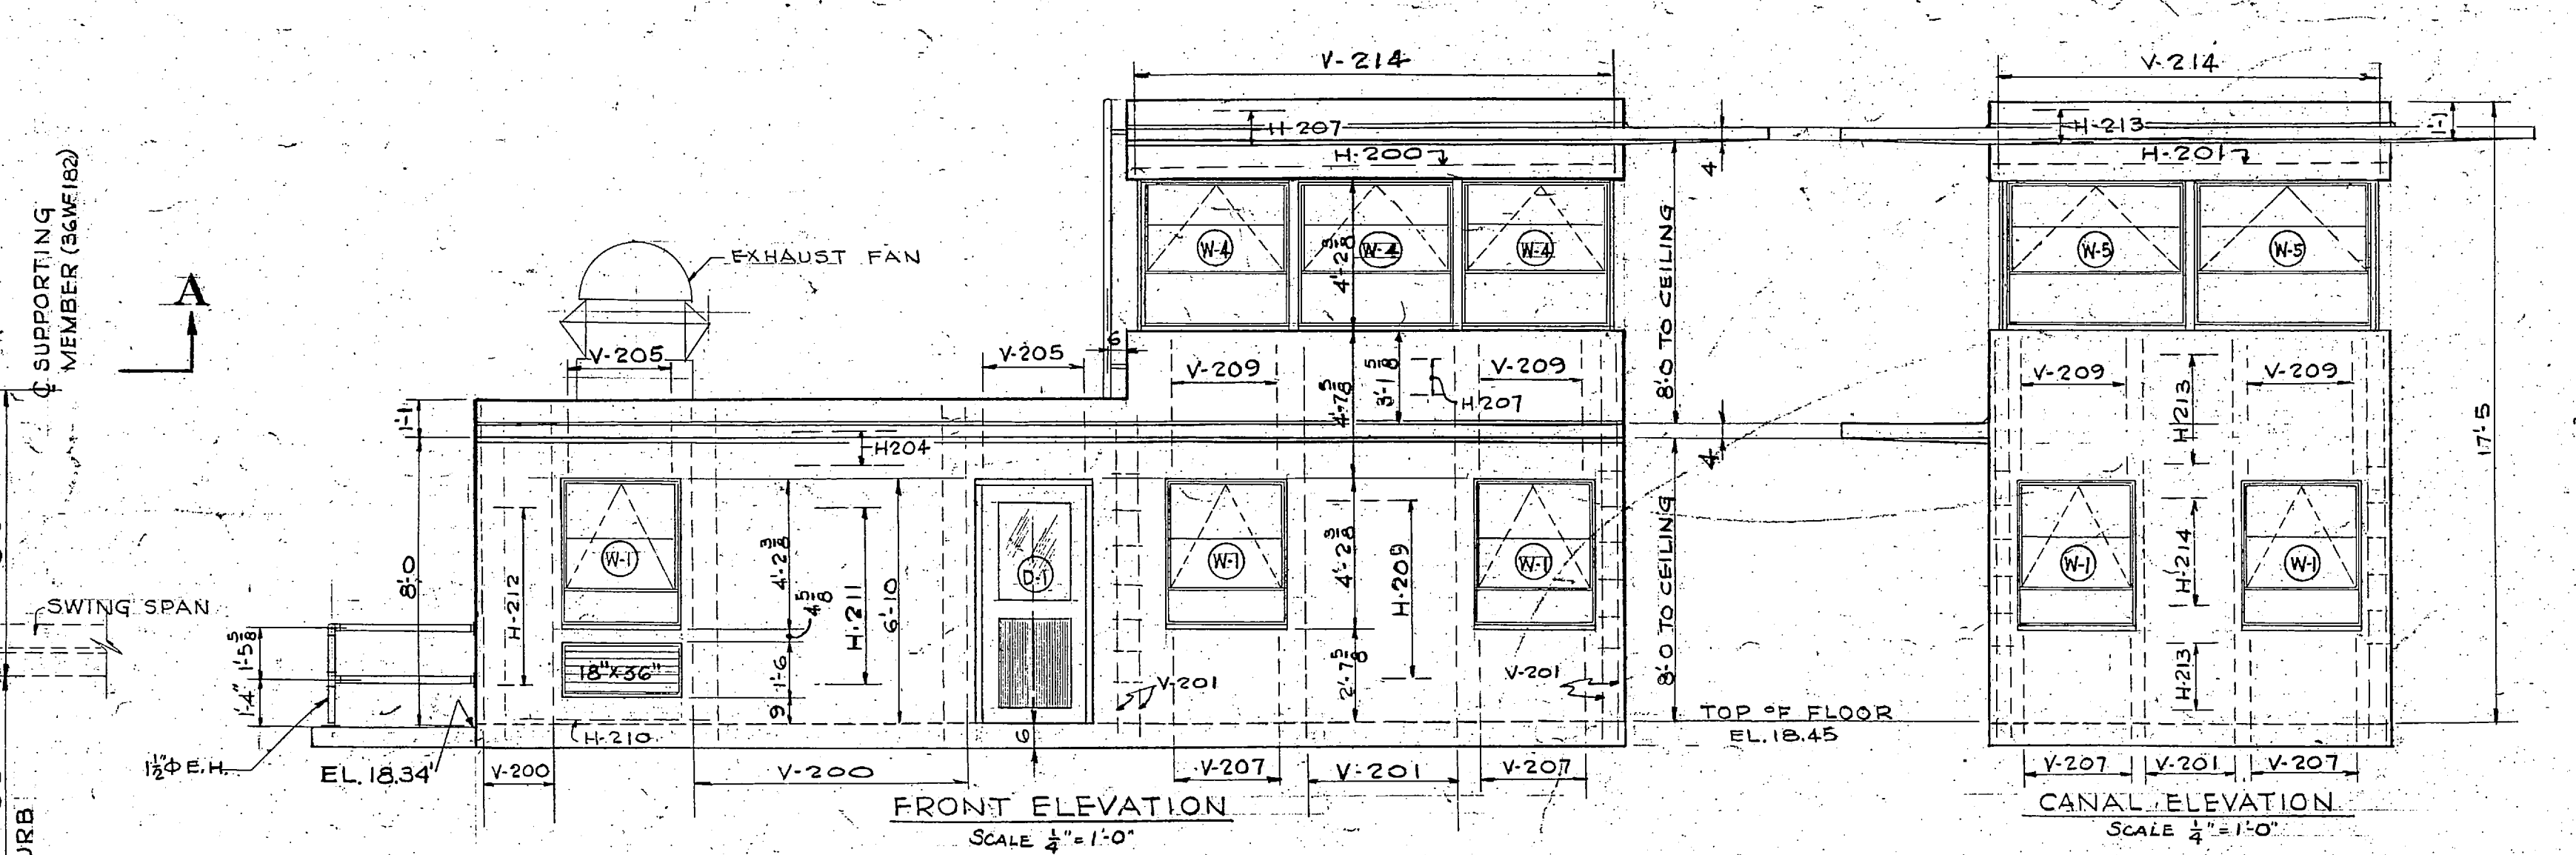
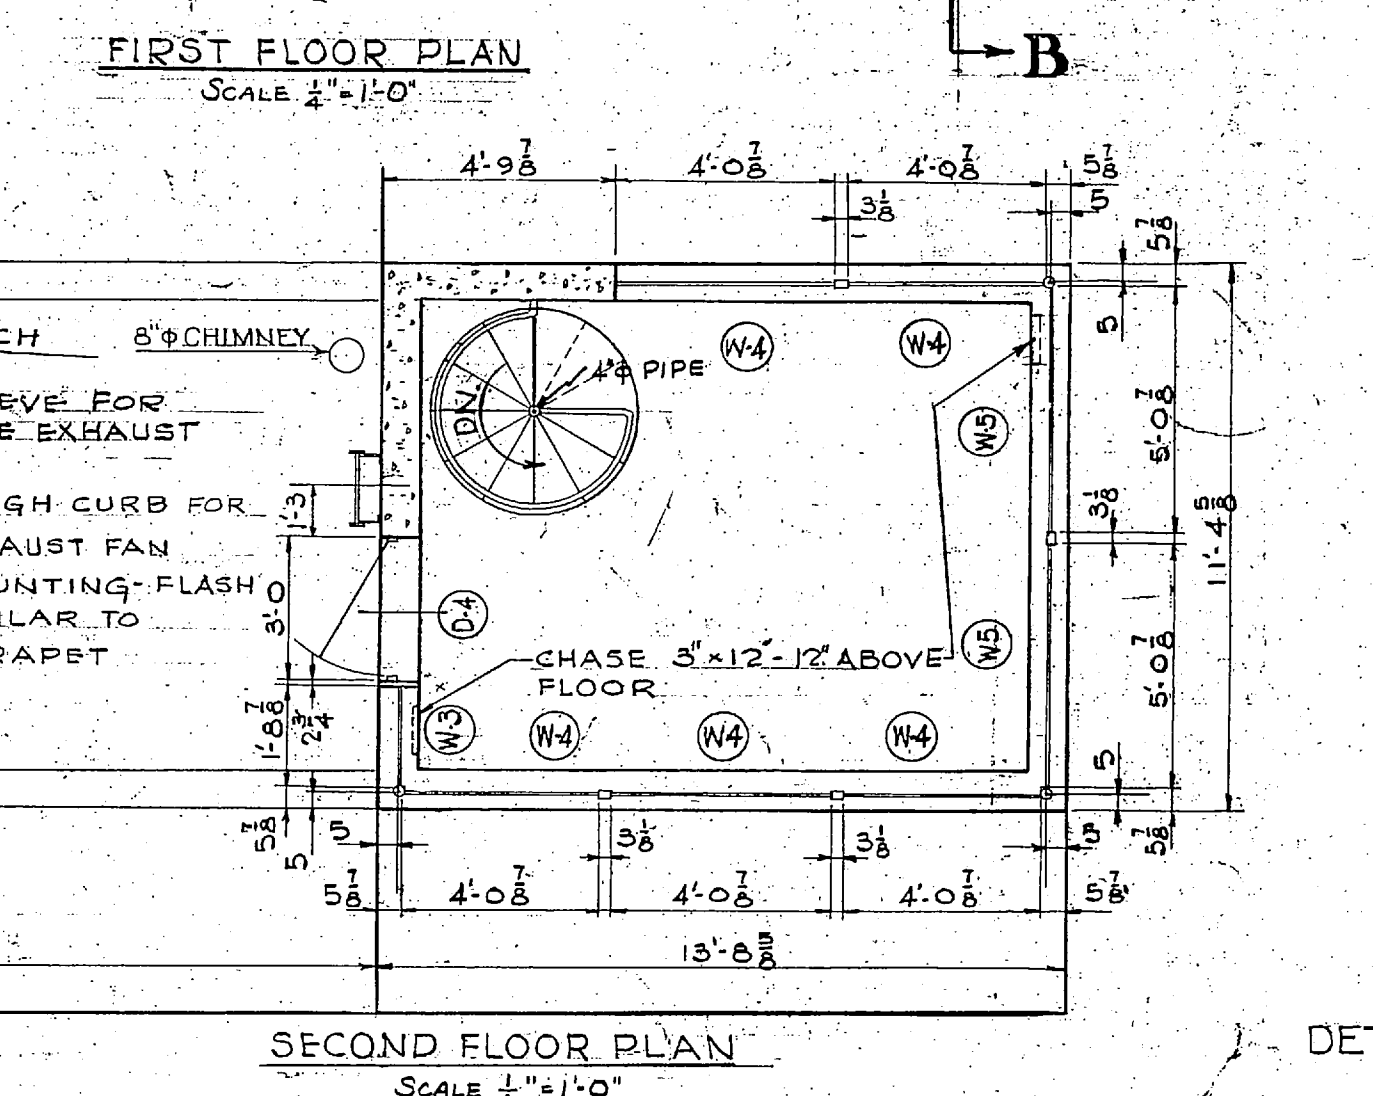


SYMBOL	DESCRIPTION	DATE	APPROVAL
B	AS BUILT (REV. SEE BUMPER DETAIL)	2-22-75	<i>[Signature]</i>
A	DIMENSIONS CORRECTED IN "PLAN" AND "SECTION B-B"	7-23-63	<i>[Signature]</i>
REVISIONS			
DEPARTMENT OF THE NAVY DISTRICT PUBLIC WORKS OFFICE 6TH ND CHARLESTON, S.C.			
DURHAM, NORTH CAROLINA CARR & J.E. GREINER COMPANY ARCHITECT & ENGINEERS BALTIMORE, MARYLAND			
MARINE BARRACKS CAMP LEJEUNE, NORTH CAROLINA			
BRIDGE OVER INTRACOASTAL WATERWAY FENDER SYSTEM			
APPROVED	<i>[Signature]</i>	DATE	17 Nov. 1952
RESIDENT OFFICER IN CHARGE			
APPROVED FOR BUREAU OF YARDS & DOCKS	SCALE AS SHOWN	SPEC.	3412C
DATE	DPWO FOR CHIEF OF BUREAU	SHEET 13 OF 18	NO. Y 74153
U.S. NAVY DRAWING NO. 505677			

APPROVED _____
DATE _____
THE QUARTERMASTER GENERAL OF THE MARINE CORPS

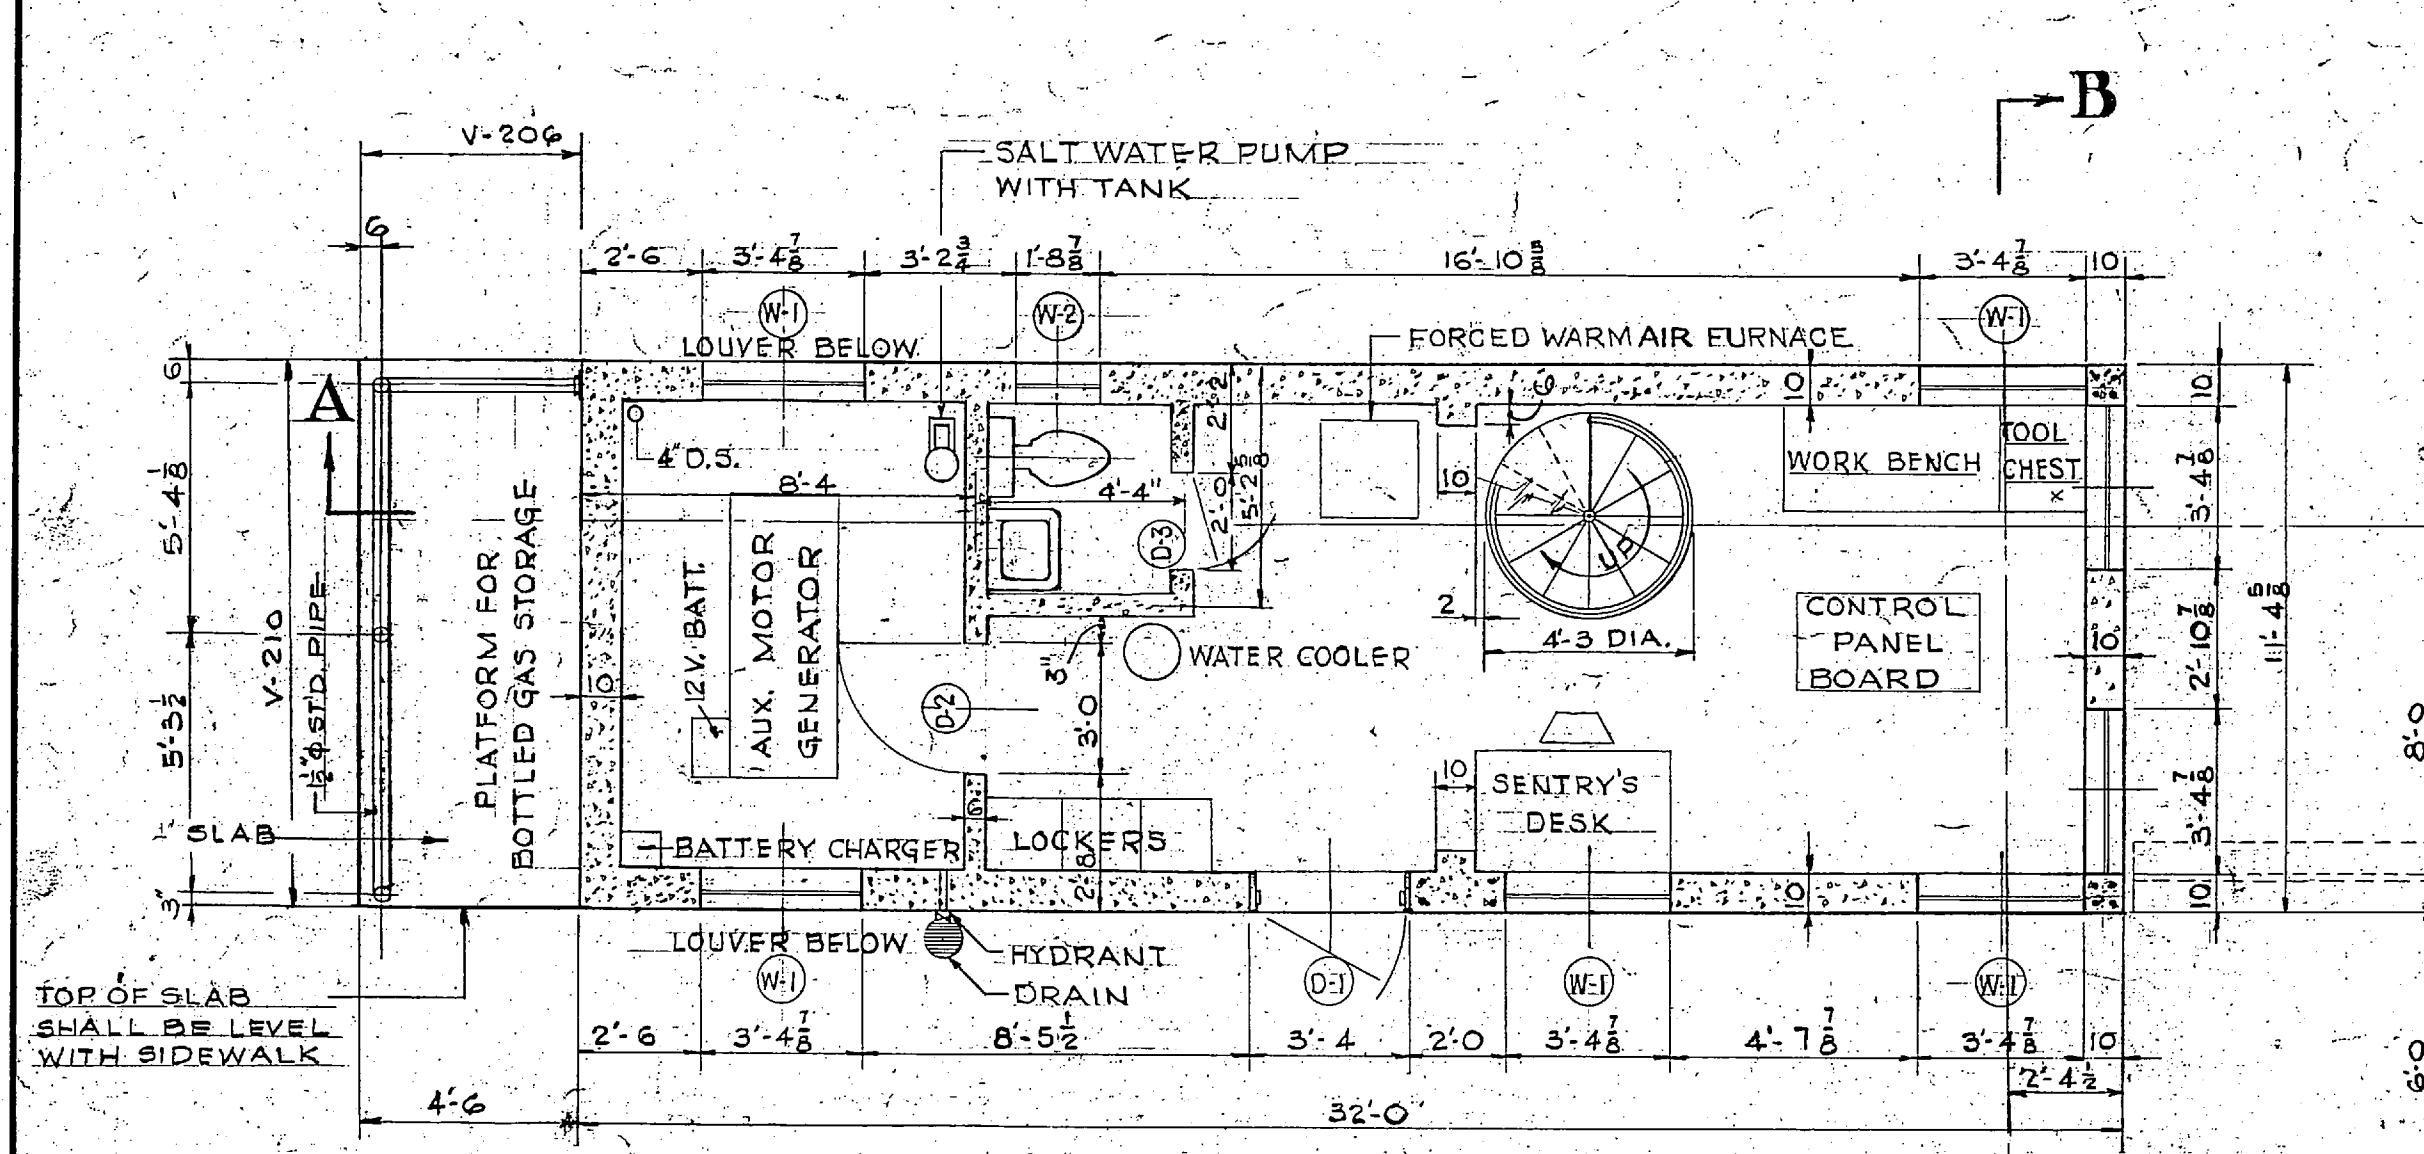

MARK	NO. REQD.	SIZE	LENGTH	SPACING	SKETCH
S-200	21	#5	11'-0"	4"	STR.
S-201	20	#5	11'-0"	3 1/2"	STR.
S-202	12	#5	11'-0"	6 1/2"	STR.
S-203	18	#5	11'-0"	8"	STR.
S-204	24	#5	16'-2"	12"	STR.
S-300	5	#4	11'-5"	20"	STR.
S-301	9	#4	11'-1"	20"	STR.
S-302	24	#3	16'-2"	12"	STR.
S-303	9	#4	6'-6"	10"	STR.
S-304	34	#4	11'-1"	10"	STR.
S-305	17	#4	11'-1"	10"	STR.
S-306	12	#3	13'-0"	12"	STR.
V-200	32	#3	9'-4"	12"	STR.
V-201	29	#3	11'-9"	12"	STR.
V-203	60	#3	4'-0"	12"	STR.
V-204	5	#3	7'-3"	12"	STR.
V-205	10	#3	1'-9"	12"	STR.
V-206	7	#4	11'-1"	8"	STR.
V-207	19	#3	2'-11"	12"	STR.
V-208	18	#2	3'-0"	12"	STR.
V-209	17	#3	4'-1"	12"	STR.
V-210	11	#3	2'-0"	12"	STR.
V-211	2	#3	2'-6"	12"	STR.
V-212	6	#3	8'-7"	12"	STR.
V-213	2	#3	2'-7"	12"	STR.
H-200	2	#5	13'-2"	STR.	
H-201	2	#5	11'-0"	STR.	
H-202	2	#5	11'-4"	STR.	
H-203	2	#5	8'-0"	STR.	
C-400	37	#4	5'-10 1/2"	10"	STR.
C-401	3	#3	16'-2"	12"	STR.
C-402	8	#3	17'-0"	12"	STR.
C-403	4	#3	19'-0"	12"	STR.

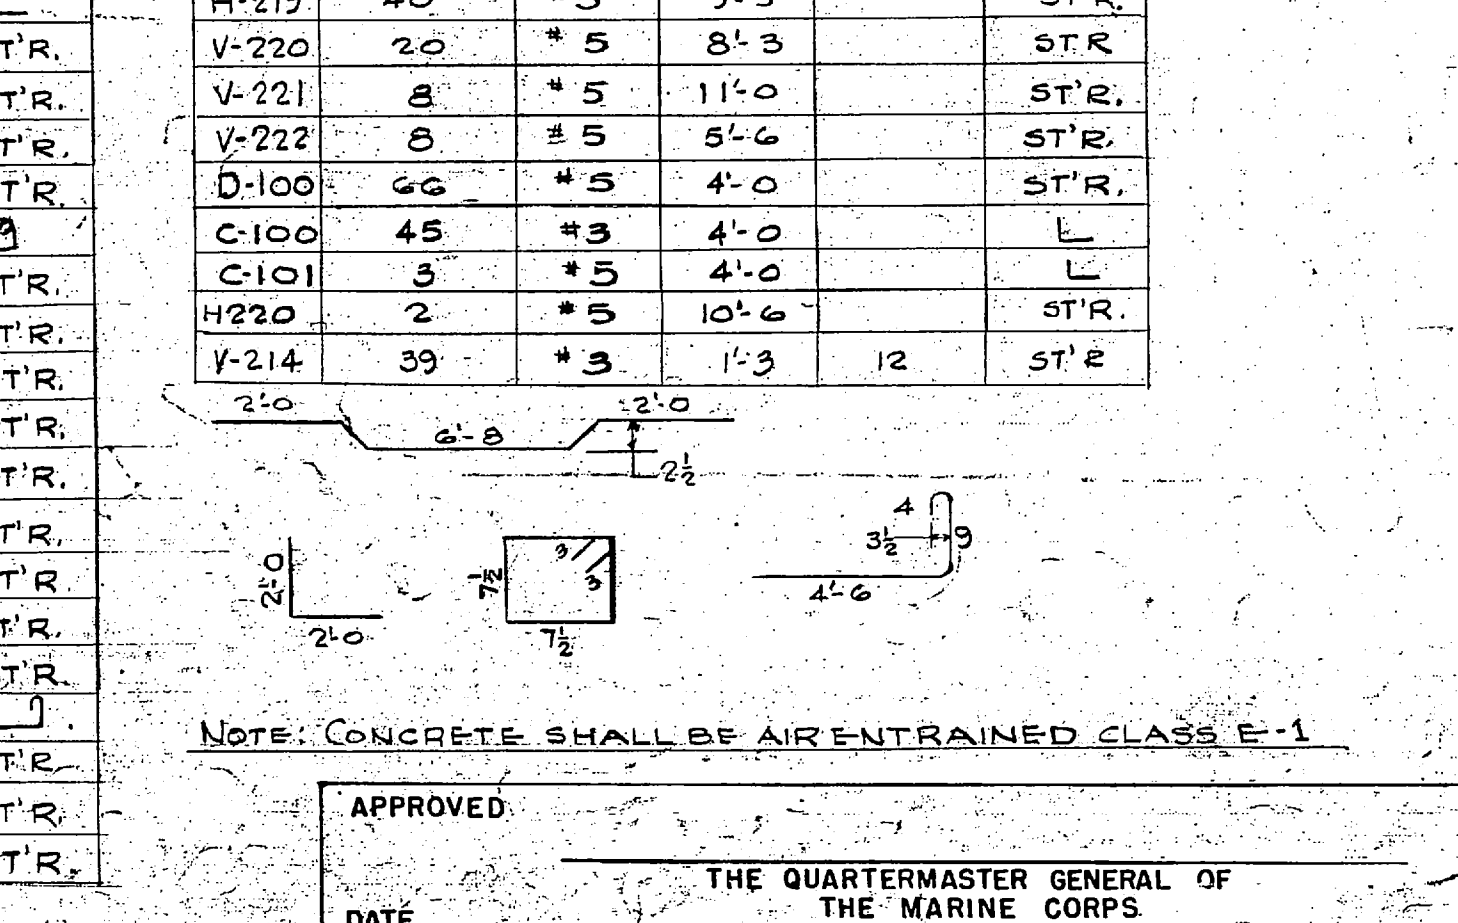


DEPARTMENT OF THE NAVY
DISTRICT PUBLIC WORKS OFFICE 6TH ND CHARLESTON, S.C.
DURHAM, NORTH CAROLINA
CARR & J.E. GREINER COMPANY
ARCHITECT & ENGINEERS
BALTIMORE, MARYLAND

**MARINE BARRACKS
CAMP LEJEUNE, NORTH CAROLINA
BRIDGE OVER INTRACOASTAL WATERWAY
OPERATOR'S HOUSE**


APPROVED: *Stephen Pappas* DATE 17 Nov 1952
RESIDENT OFFICER IN CHARGE

APPROVED FOR BUREAU OF YARDS & DOCKS
DPWO FOR CHIEF OF BUREAU

SCALE AS NOTED, SPEC 34123
SHEET 12 OF 18 NOV 74153
Y. & D. DRAWING NO. 505676

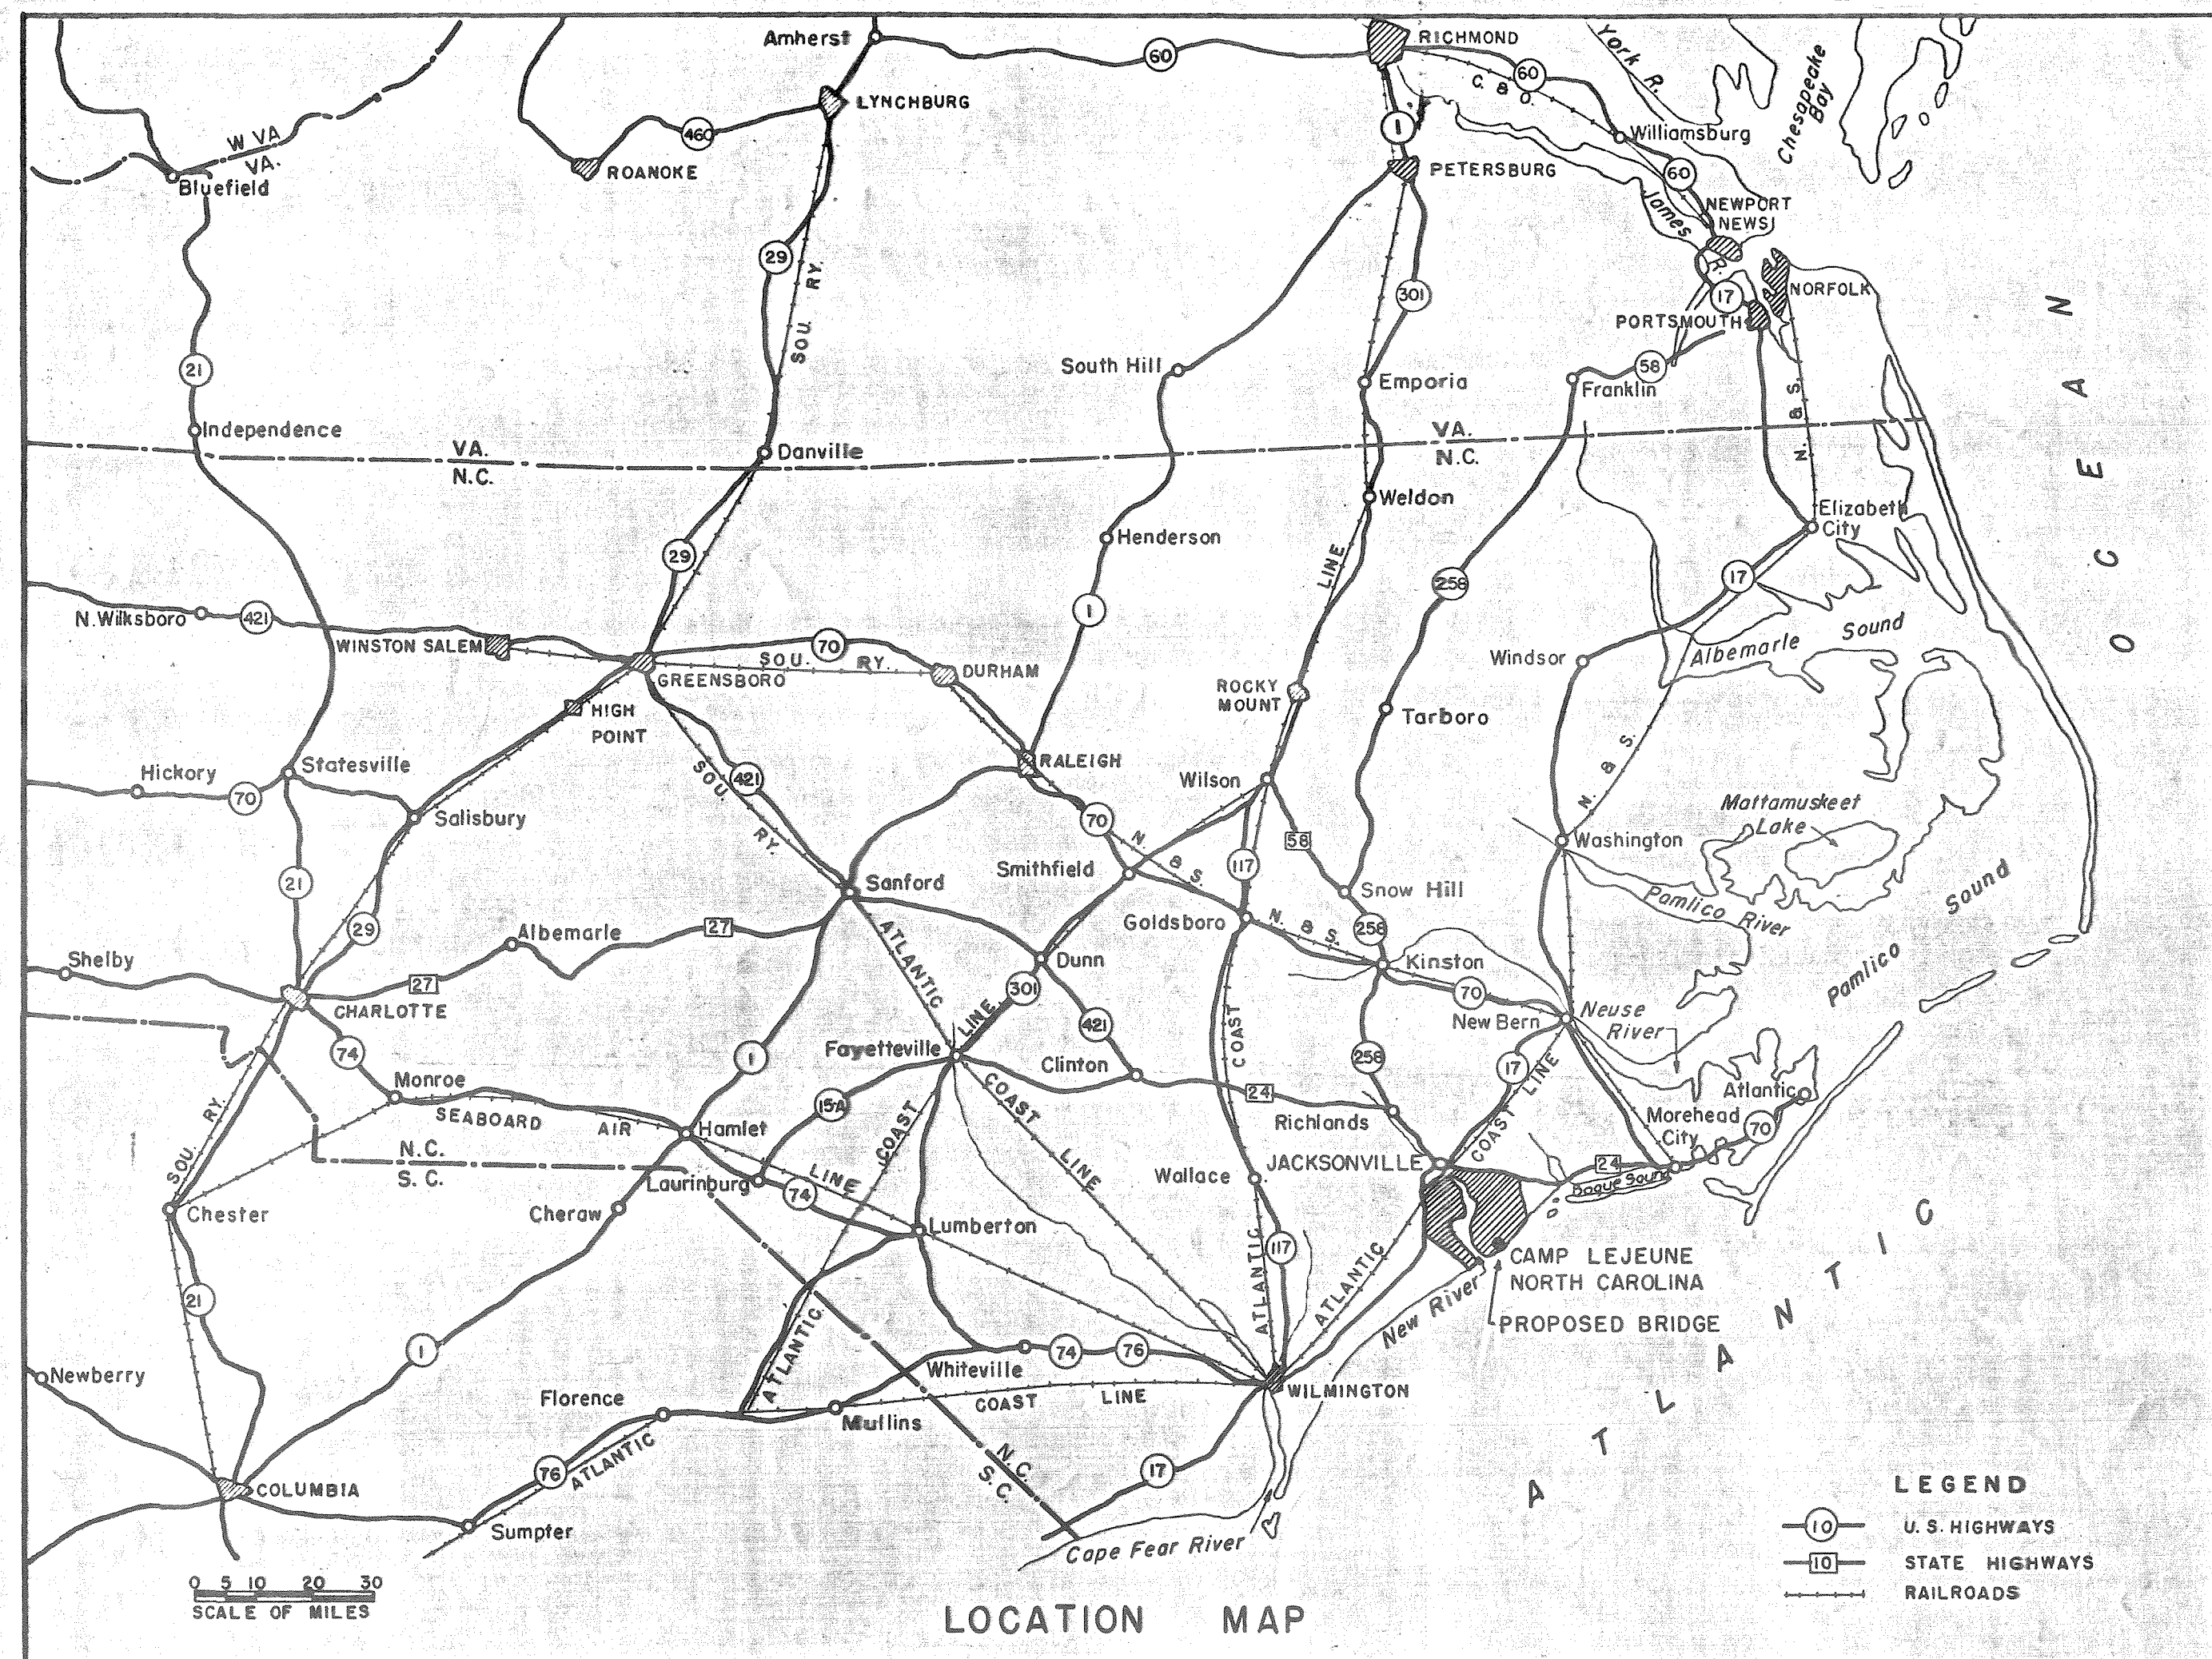

INDEX OF DRAWINGS	
TITLE	Y & D DRAWING NUMBER
COVER SHEET	505665
LOCATION PLAN	505665
ROADWAY PLAN, ELEVATION & DETAILS	505666
BRIDGE PLAN, ELEVATION & DETAILS	505667
ABUTMENTS & PIERS BEAM SPANS	505668
PIERS SWING SPAN	505669
BEAM SPANS STRESS SHEET & DETAILS	505670
SWING SPAN STRESS SHEET & DETAILS	505671
SWING SPAN DETAILS	505672
MACHINERY TURNING	505673
MACHINERY END LIFTS	505674
ELECTRICAL	505675
OPERATOR'S HOUSE	505676
FENDER SYSTEM	505677
CROSS SECTIONS STA. 48+34.42 TO STA. 55+00.	505678
CROSS SECTIONS STA. 55+05. TO STA. 62+00.	505679
CROSS SECTIONS STA. 63+00. TO STA. 74+00.	505680
CROSS SECTIONS STA. 74+50. TO STA. 82+00.	505681
CROSS SECTIONS STA. 83+00. TO STA. 86+54.27	505682

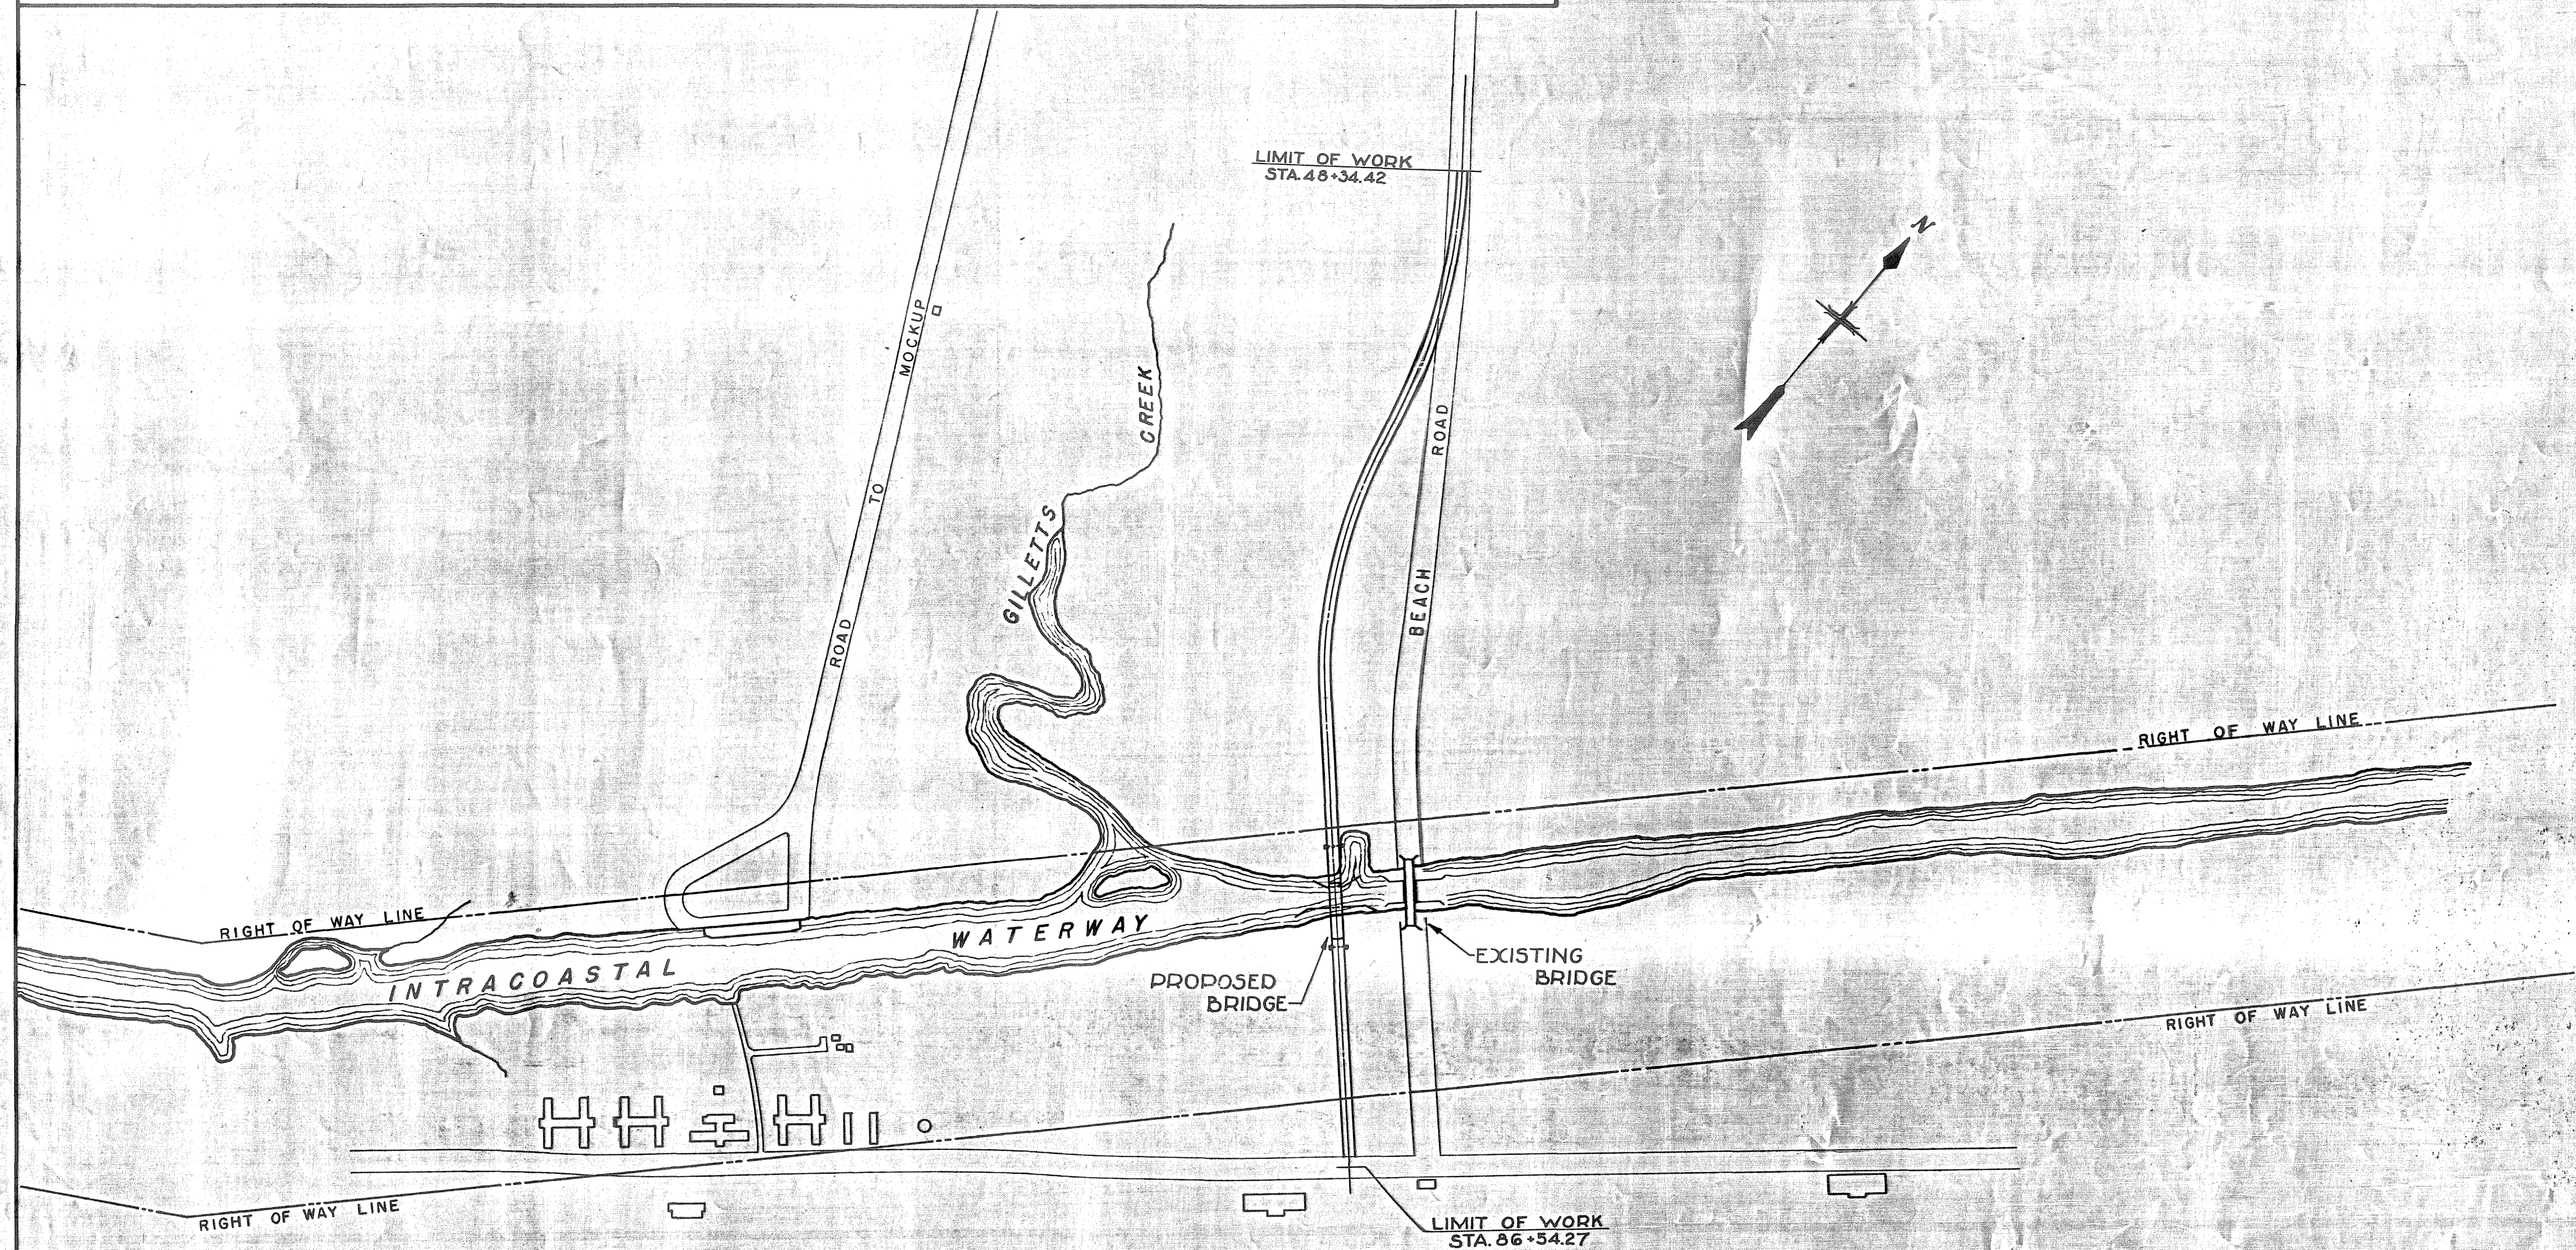

A T L A N T I C O C E A N

APPROVED
 DATE _____
 THE QUARTERMASTER GENERAL OF THE MARINE CORPS

SYMBOL	DESCRIPTION	DATE	APPROVAL
REVISIONS			
DEPARTMENT OF THE NAVY		BUREAU OF YARDS & DOCKS	
DISTRICT PUBLIC WORKS OFFICE 6TH ND CHARLESTON, S.C.		CARR & J.E. GREINER COMPANY	
DURHAM, NORTH CAROLINA		ARCHITECT & ENGINEERS BALTIMORE, MARYLAND	
DES	MARINE BARRACKS		
DRWN	CAMP LEJEUNE, NORTH CAROLINA		
TR	BRIDGE OVER INTRACOASTAL WATERWAY		
CHK	COVER SHEET		
SUPV	LOCATION PLAN		
DPWO & RQ IN CC	APPROVED <i>Stephen P. Jones</i> DATE 17/Nov/1962		
REV	RESIDENT OFFICER IN CHARGE		
SUPV	APPROVED FOR BUREAU OF YARDS & DOCKS		
IN CH	SCALE AS SHOWN SPEC 34123		
	SHEET 1 OF 18 NO. 74153		
	DATE _____ DPWO FOR CHIEF OF BUREAU Y&D DRAWING NO. 505665		

