




PLAN - EQUIPMENT ROOM

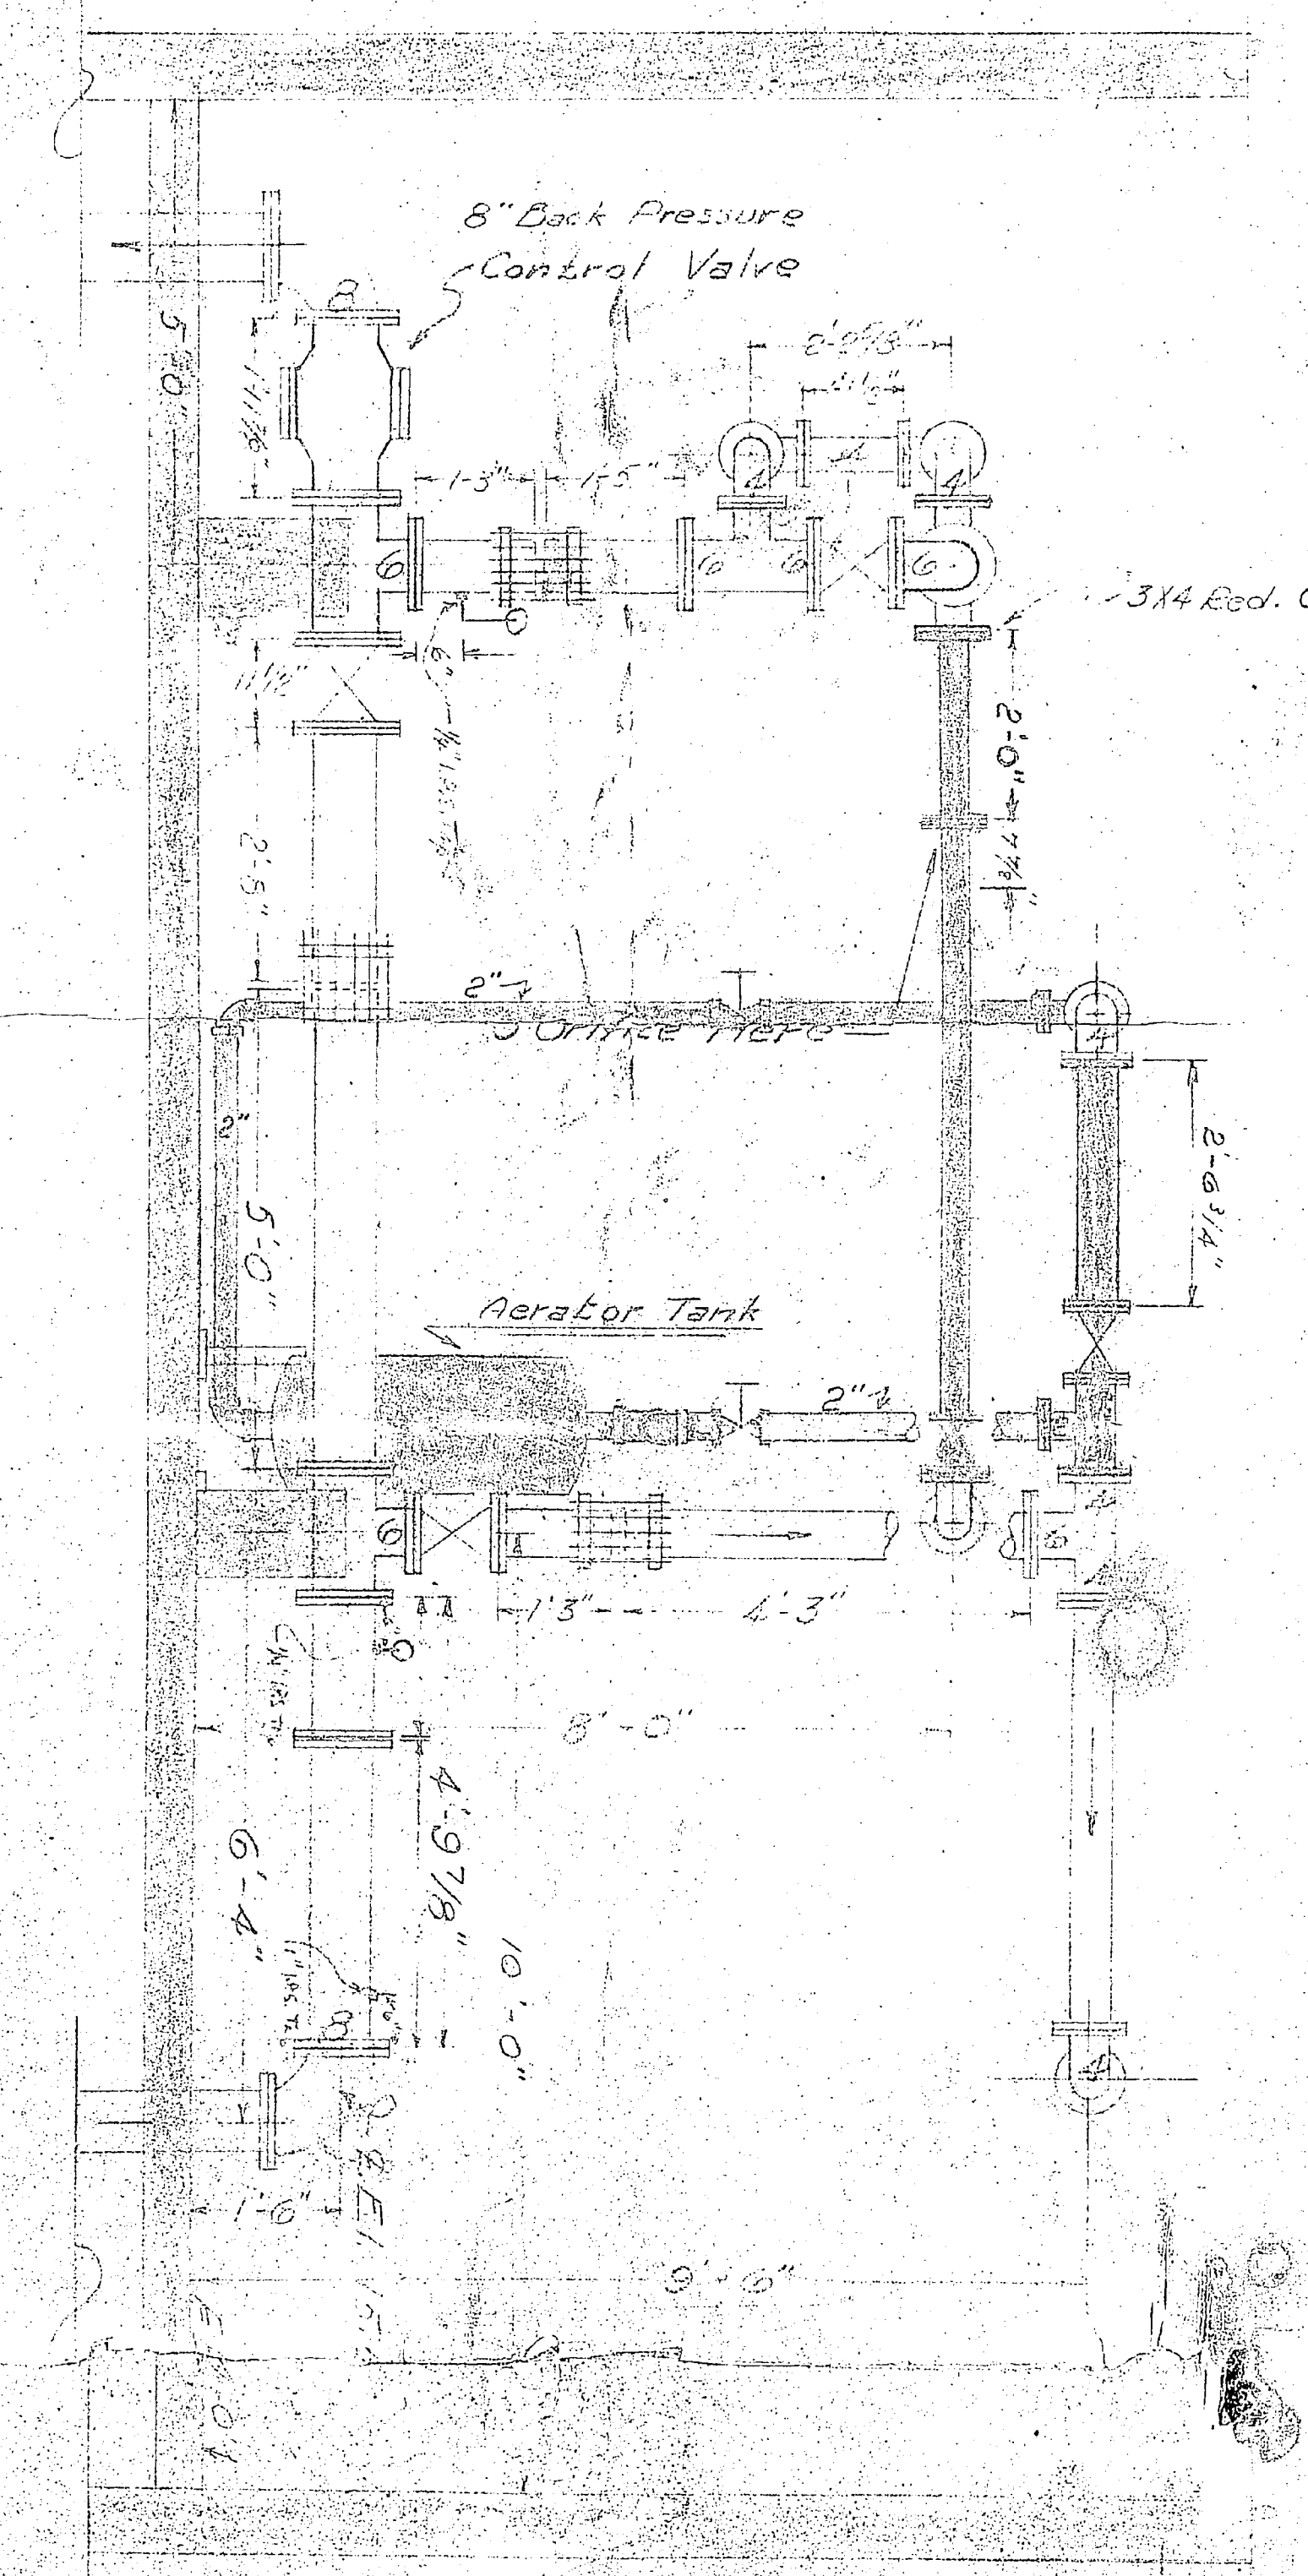

SECT - C-C

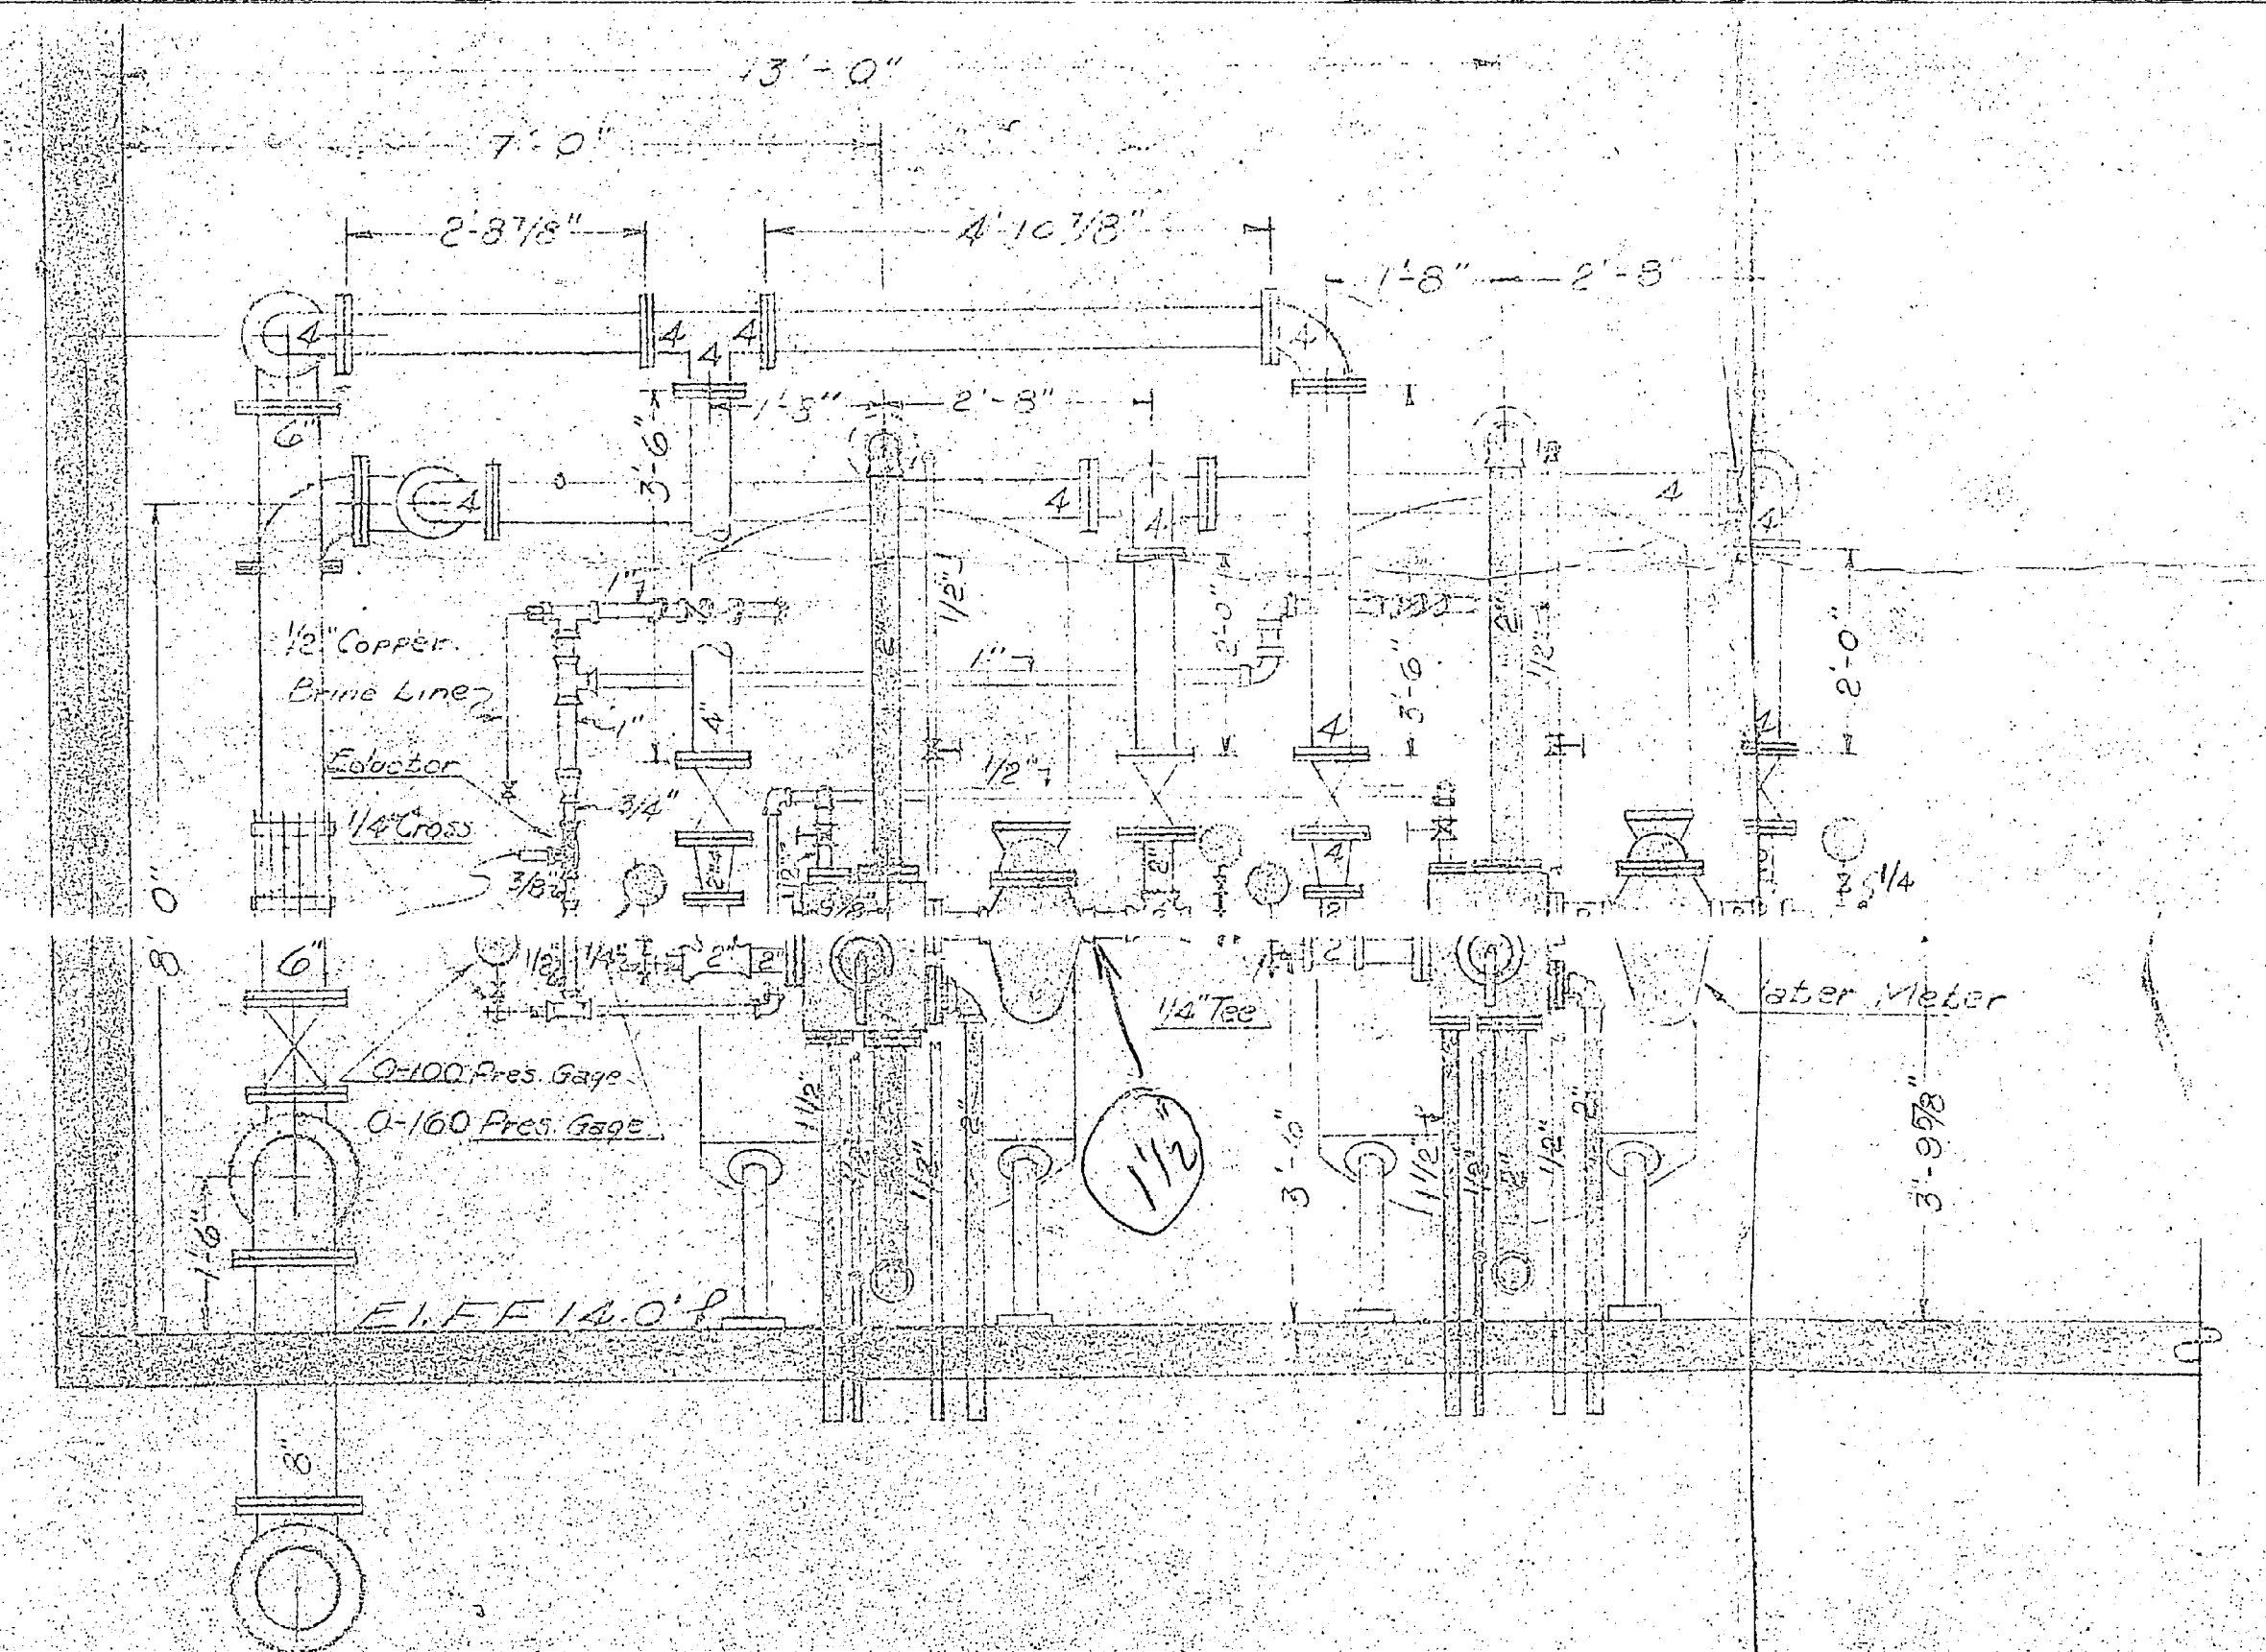

SECT - AA

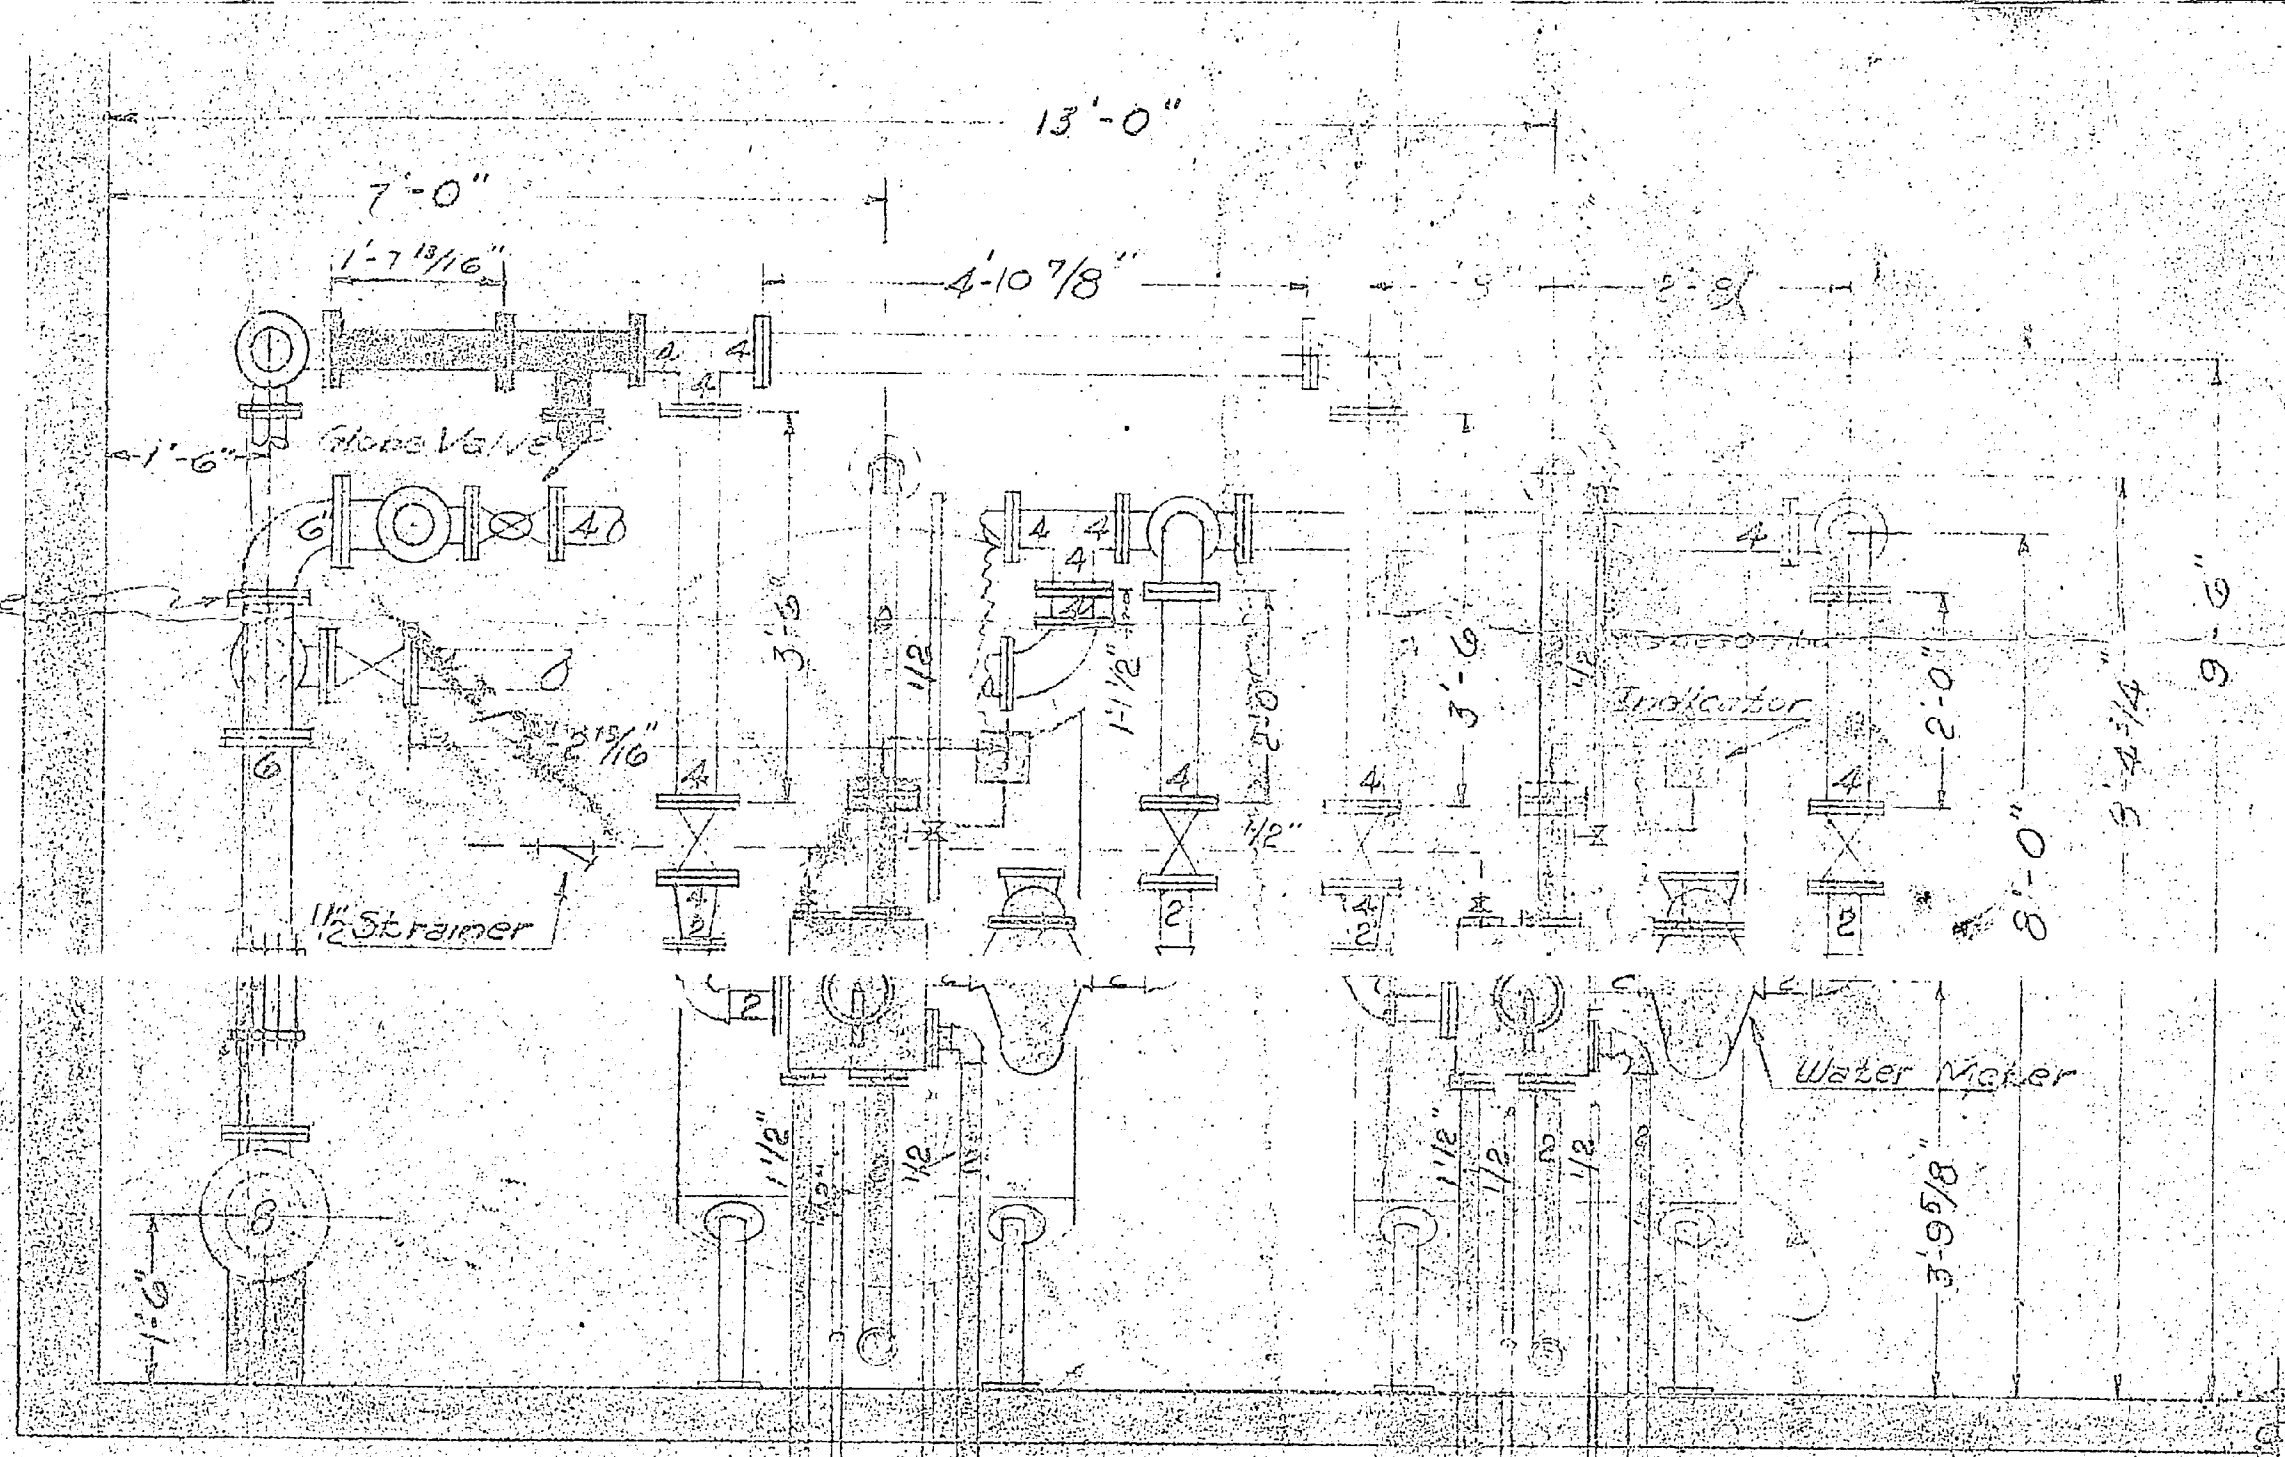

SECT - B-B

NOTE: Filters, Softeners & Materials Indicated By Shading - Furnished By Others - Other Materials Shown furnished by engineer.
 Red indicates new piping.
 12-20-56

REVISION NO.	DATE
Revision #1 - Aerator Piping, Red Water Service Flanges & Diagram Valve Orifice Flanges added	12-8-56

WATER PLANT
 ONSLOW BEACH
 MARINE CORPS BASE
 CAMP LEJUNDE, N.C.
 CHICORA CONST. CO.
 CONTRACTOR

DESIGNED BY: ABH Date: 3-2-56
 DRAWN BY: A.W. Date: 6-2-56
 INNEEL CO. INC. - CHAR. N.C.

