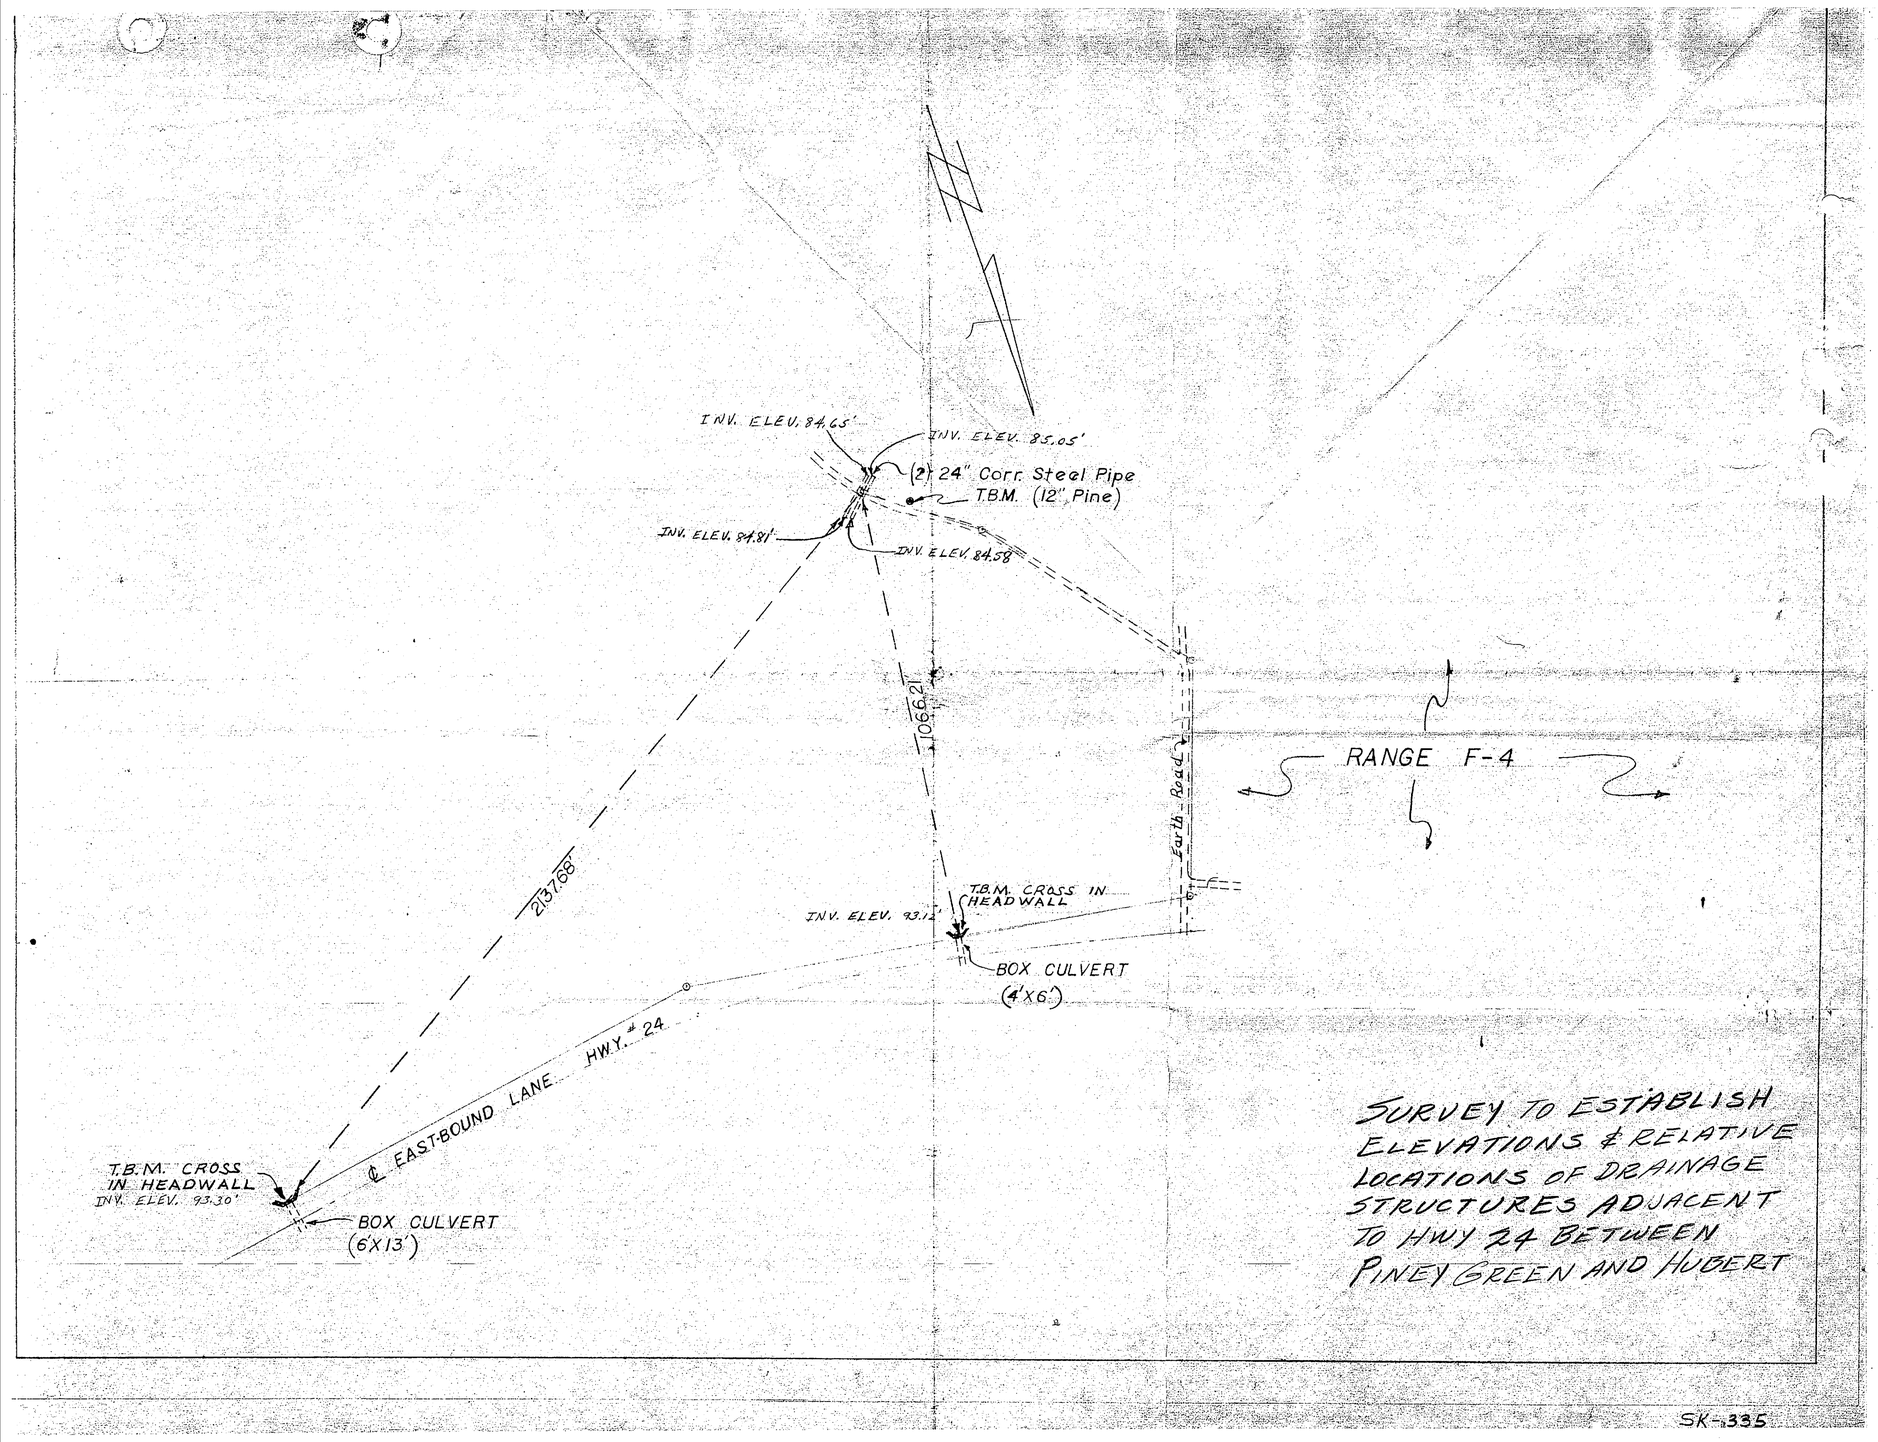

SURVEY TO ESTABLISH ELEVATIONS & RELATIVE LOCATIONS OF DRAINAGE STRUCTURES ADJACENT TO HWY 24 BETWEEN PINEY GREEN AND HUBERT

SK-335