
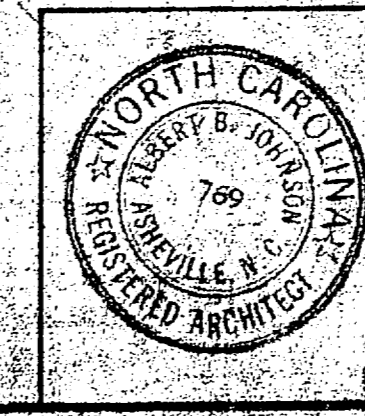
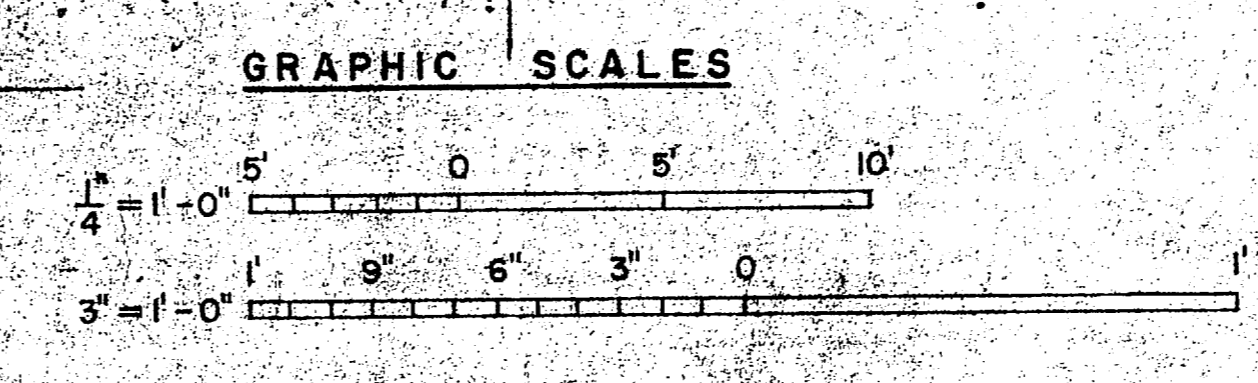
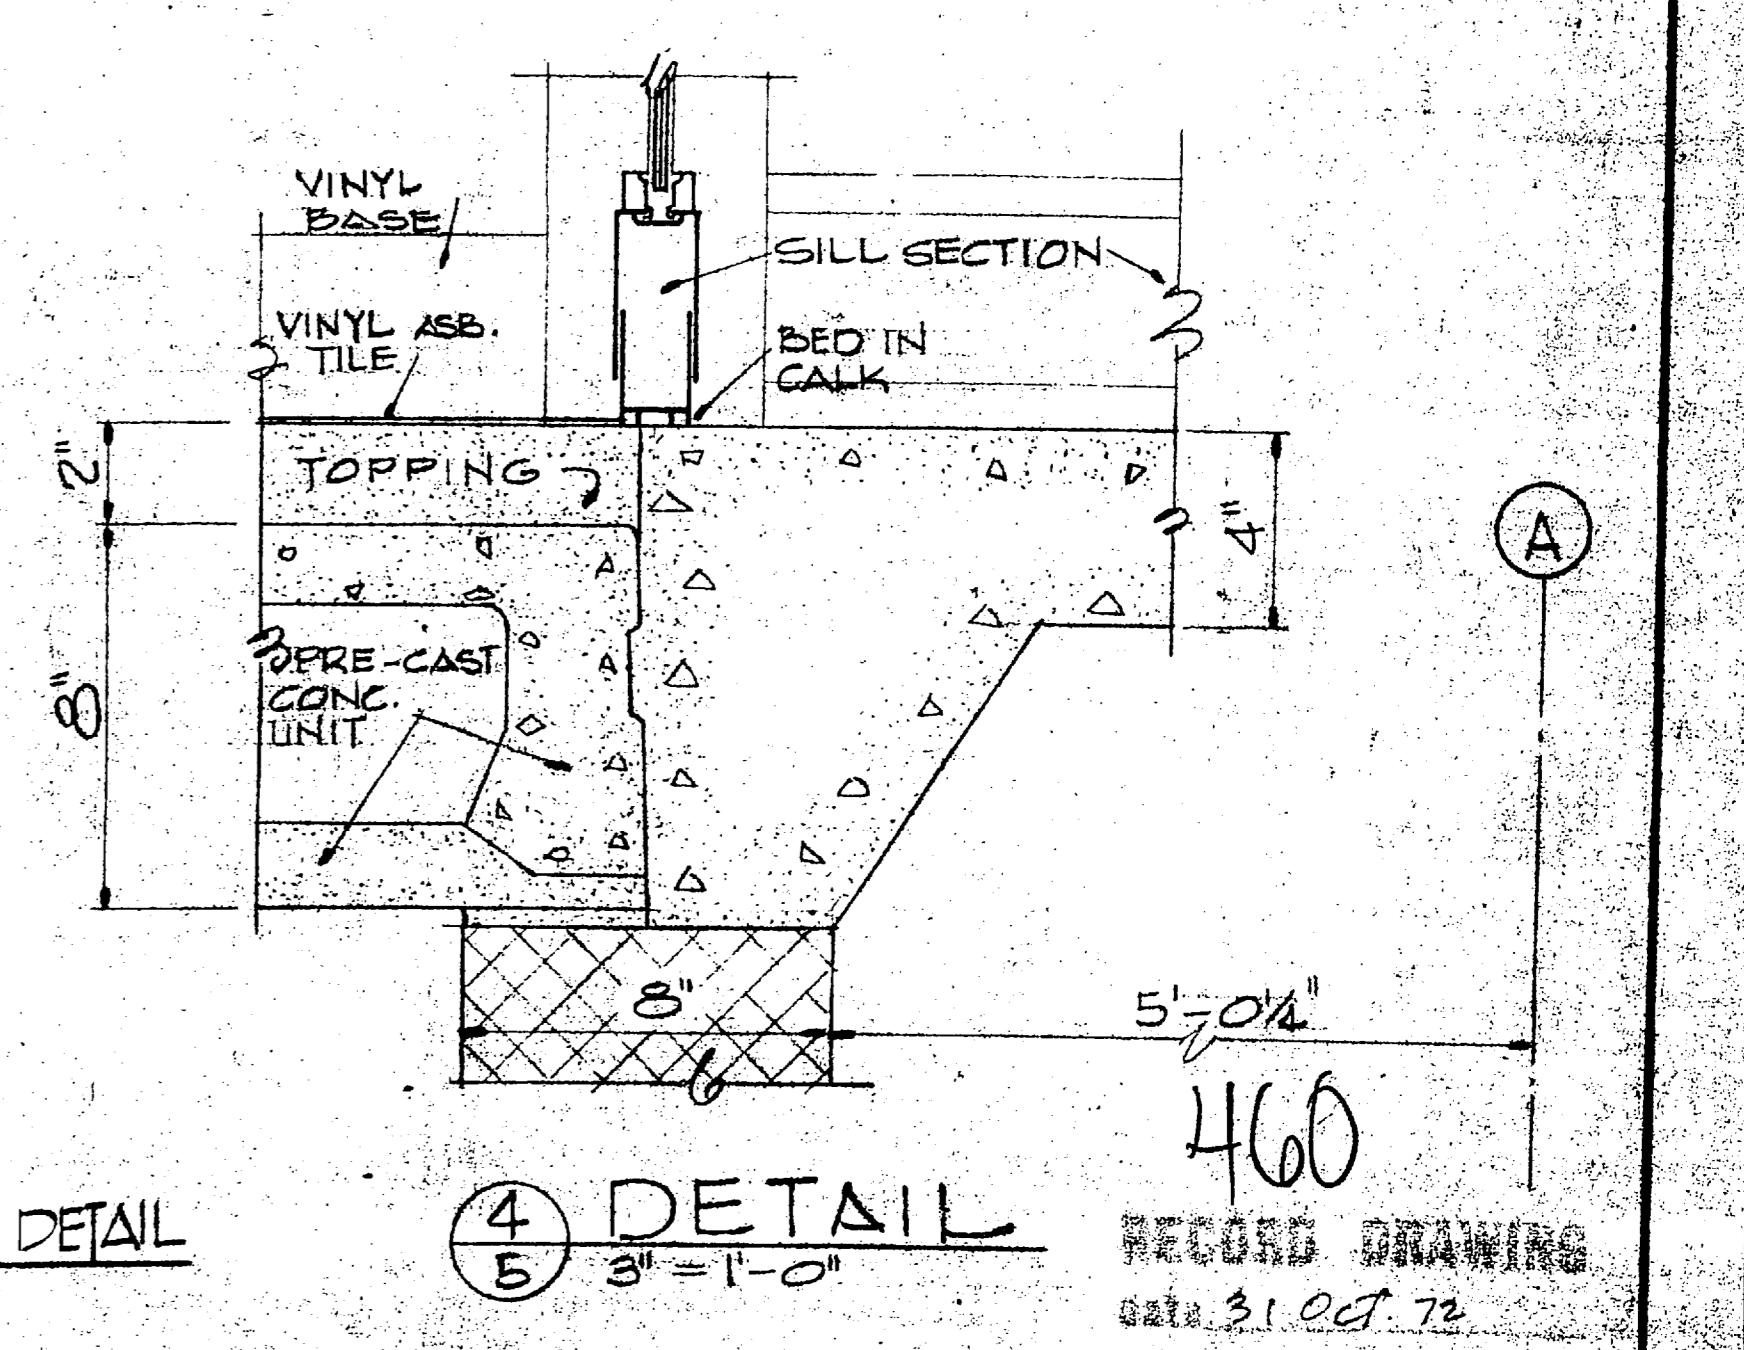
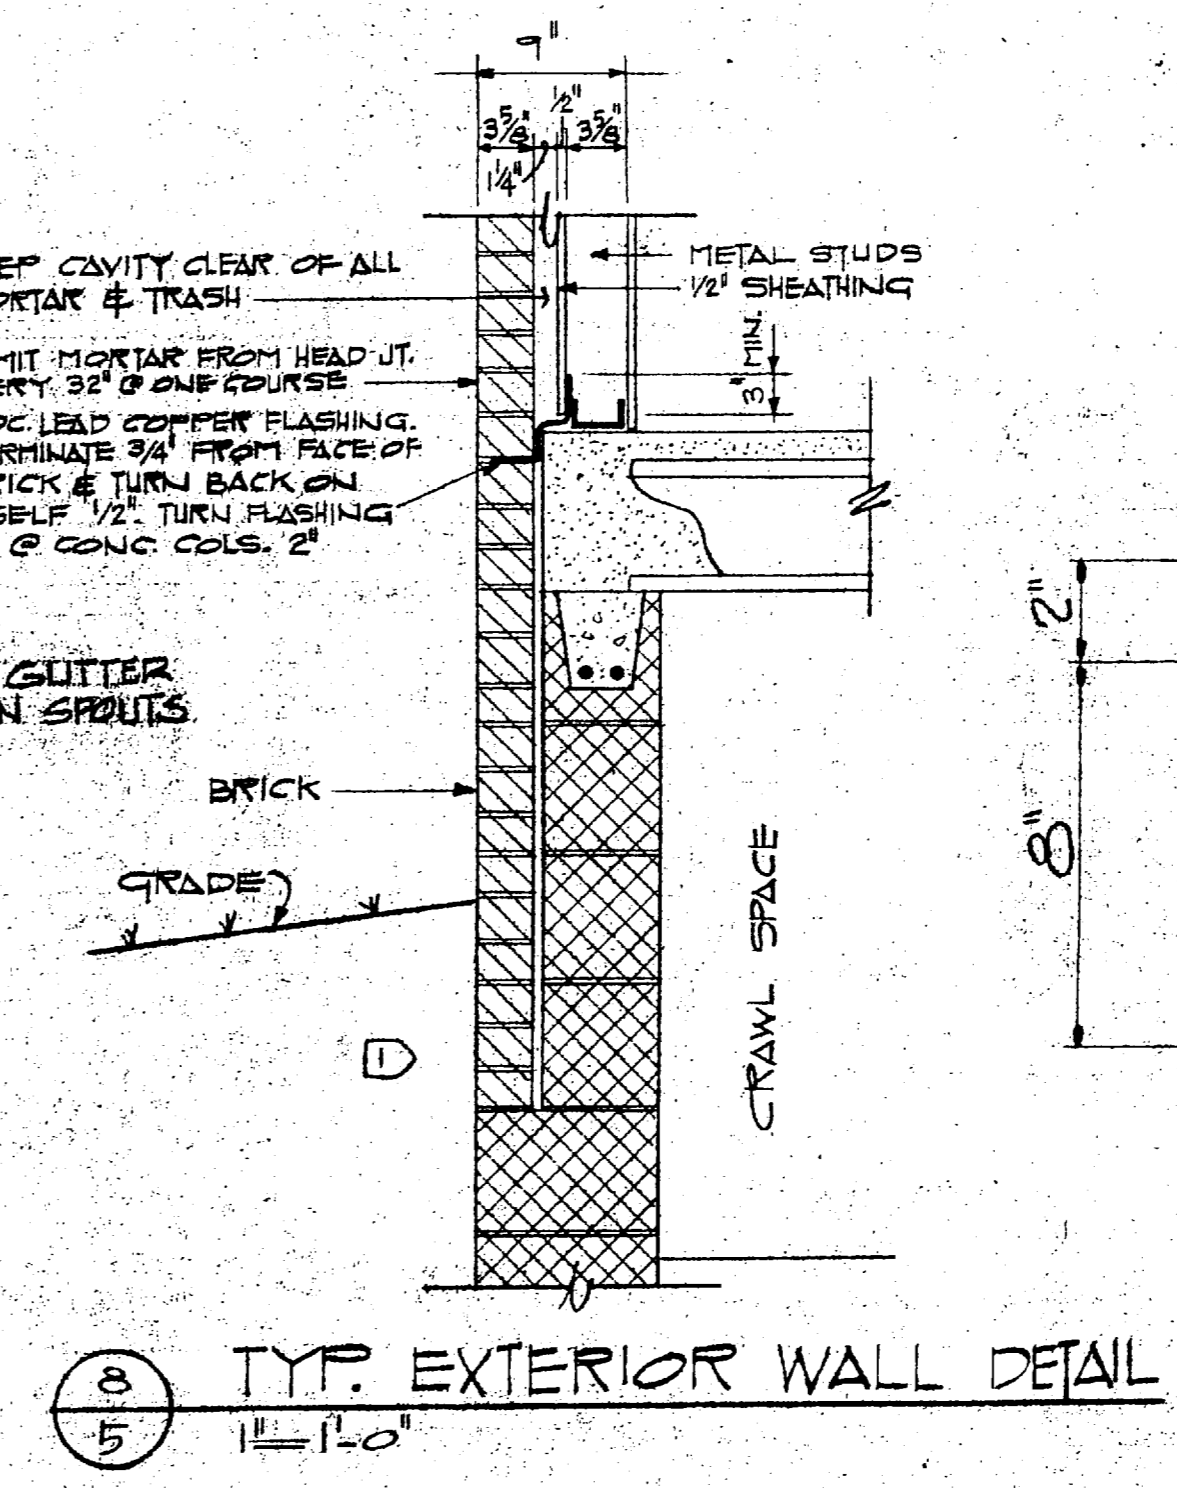
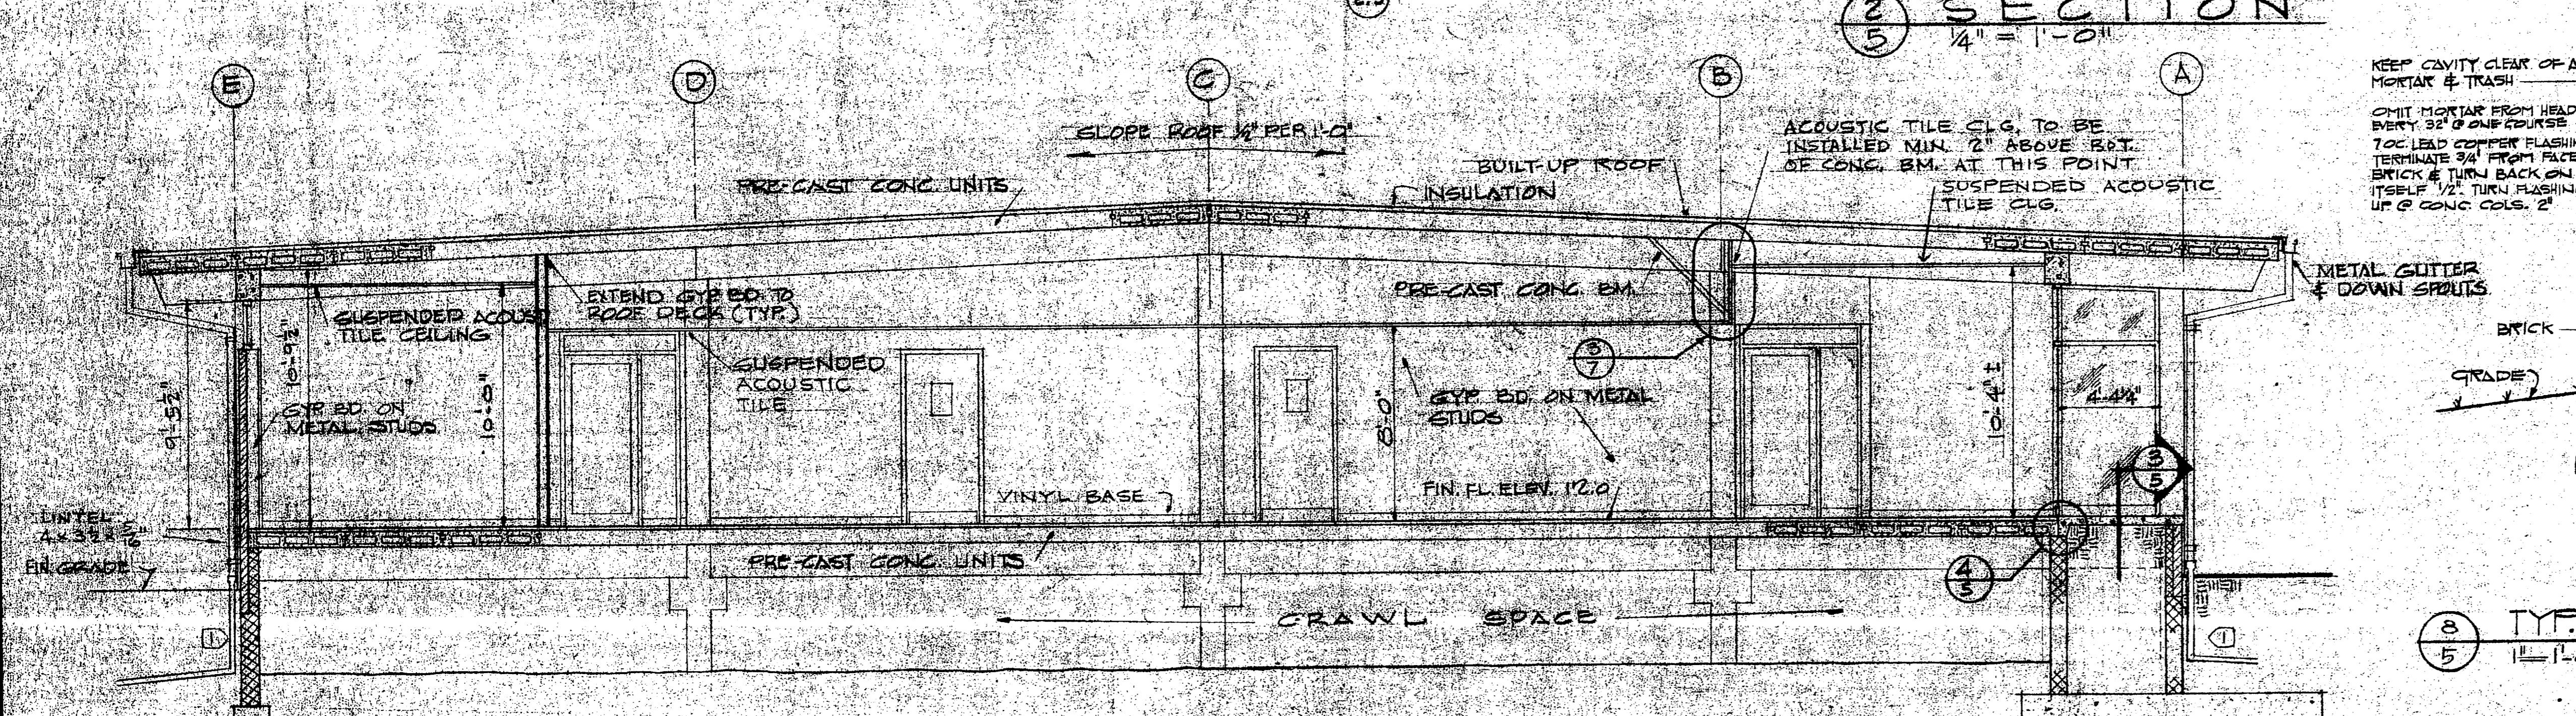
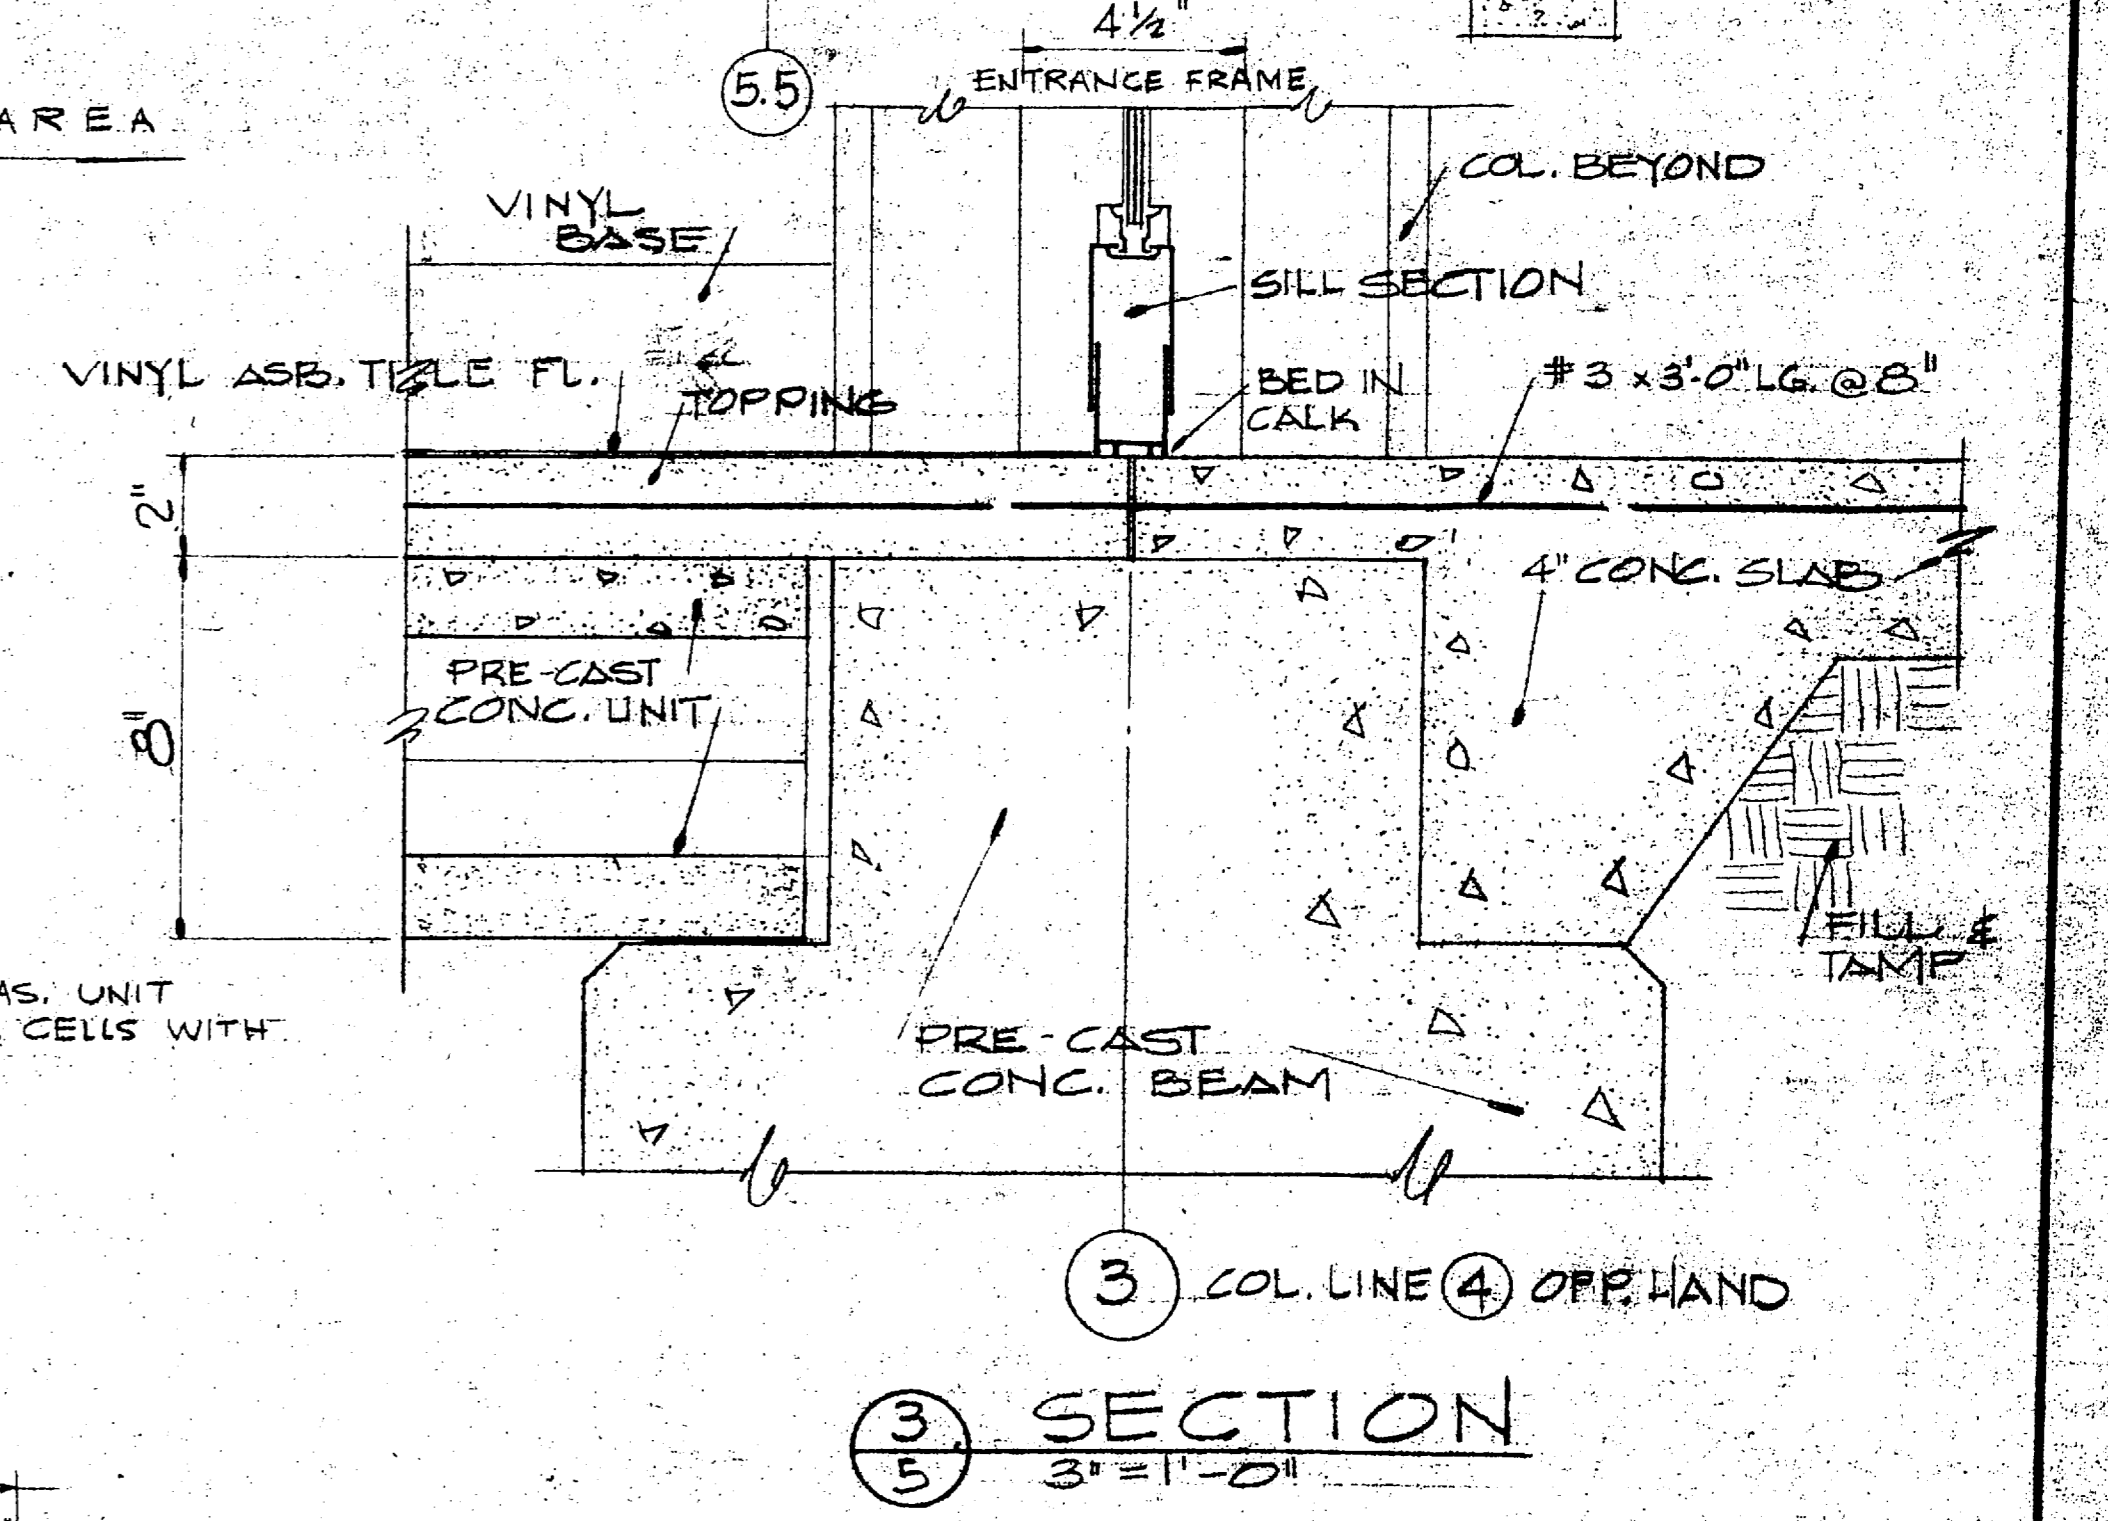
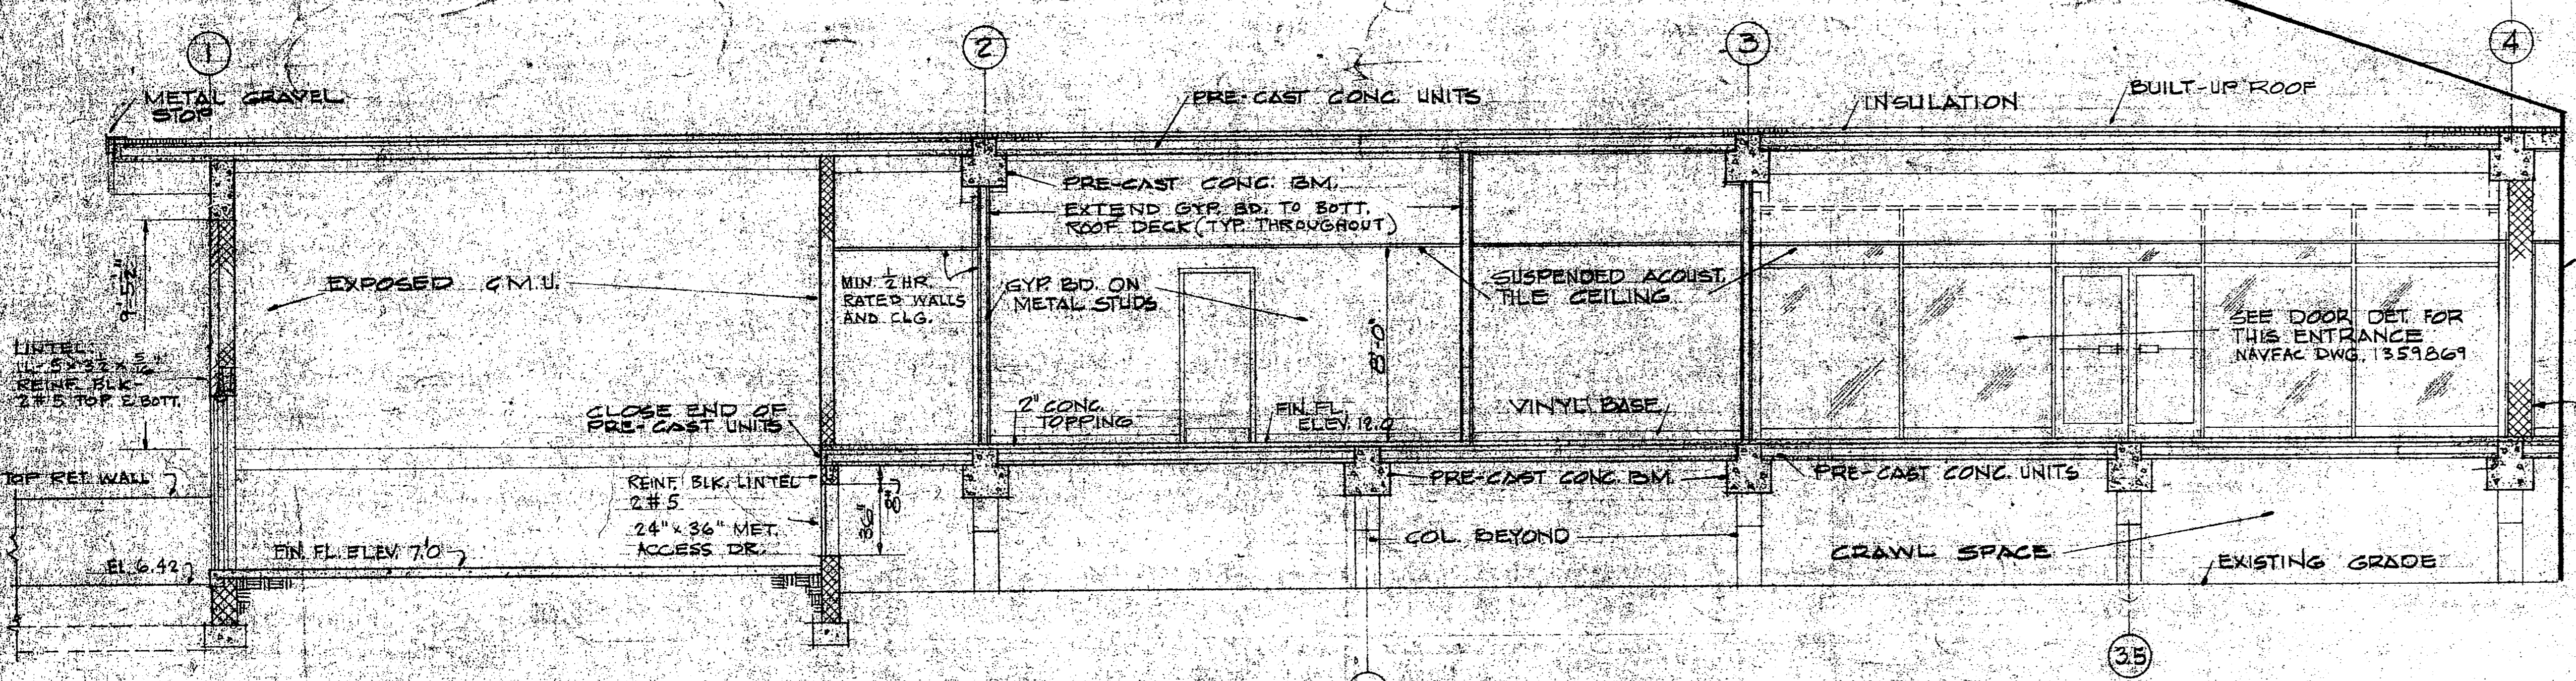
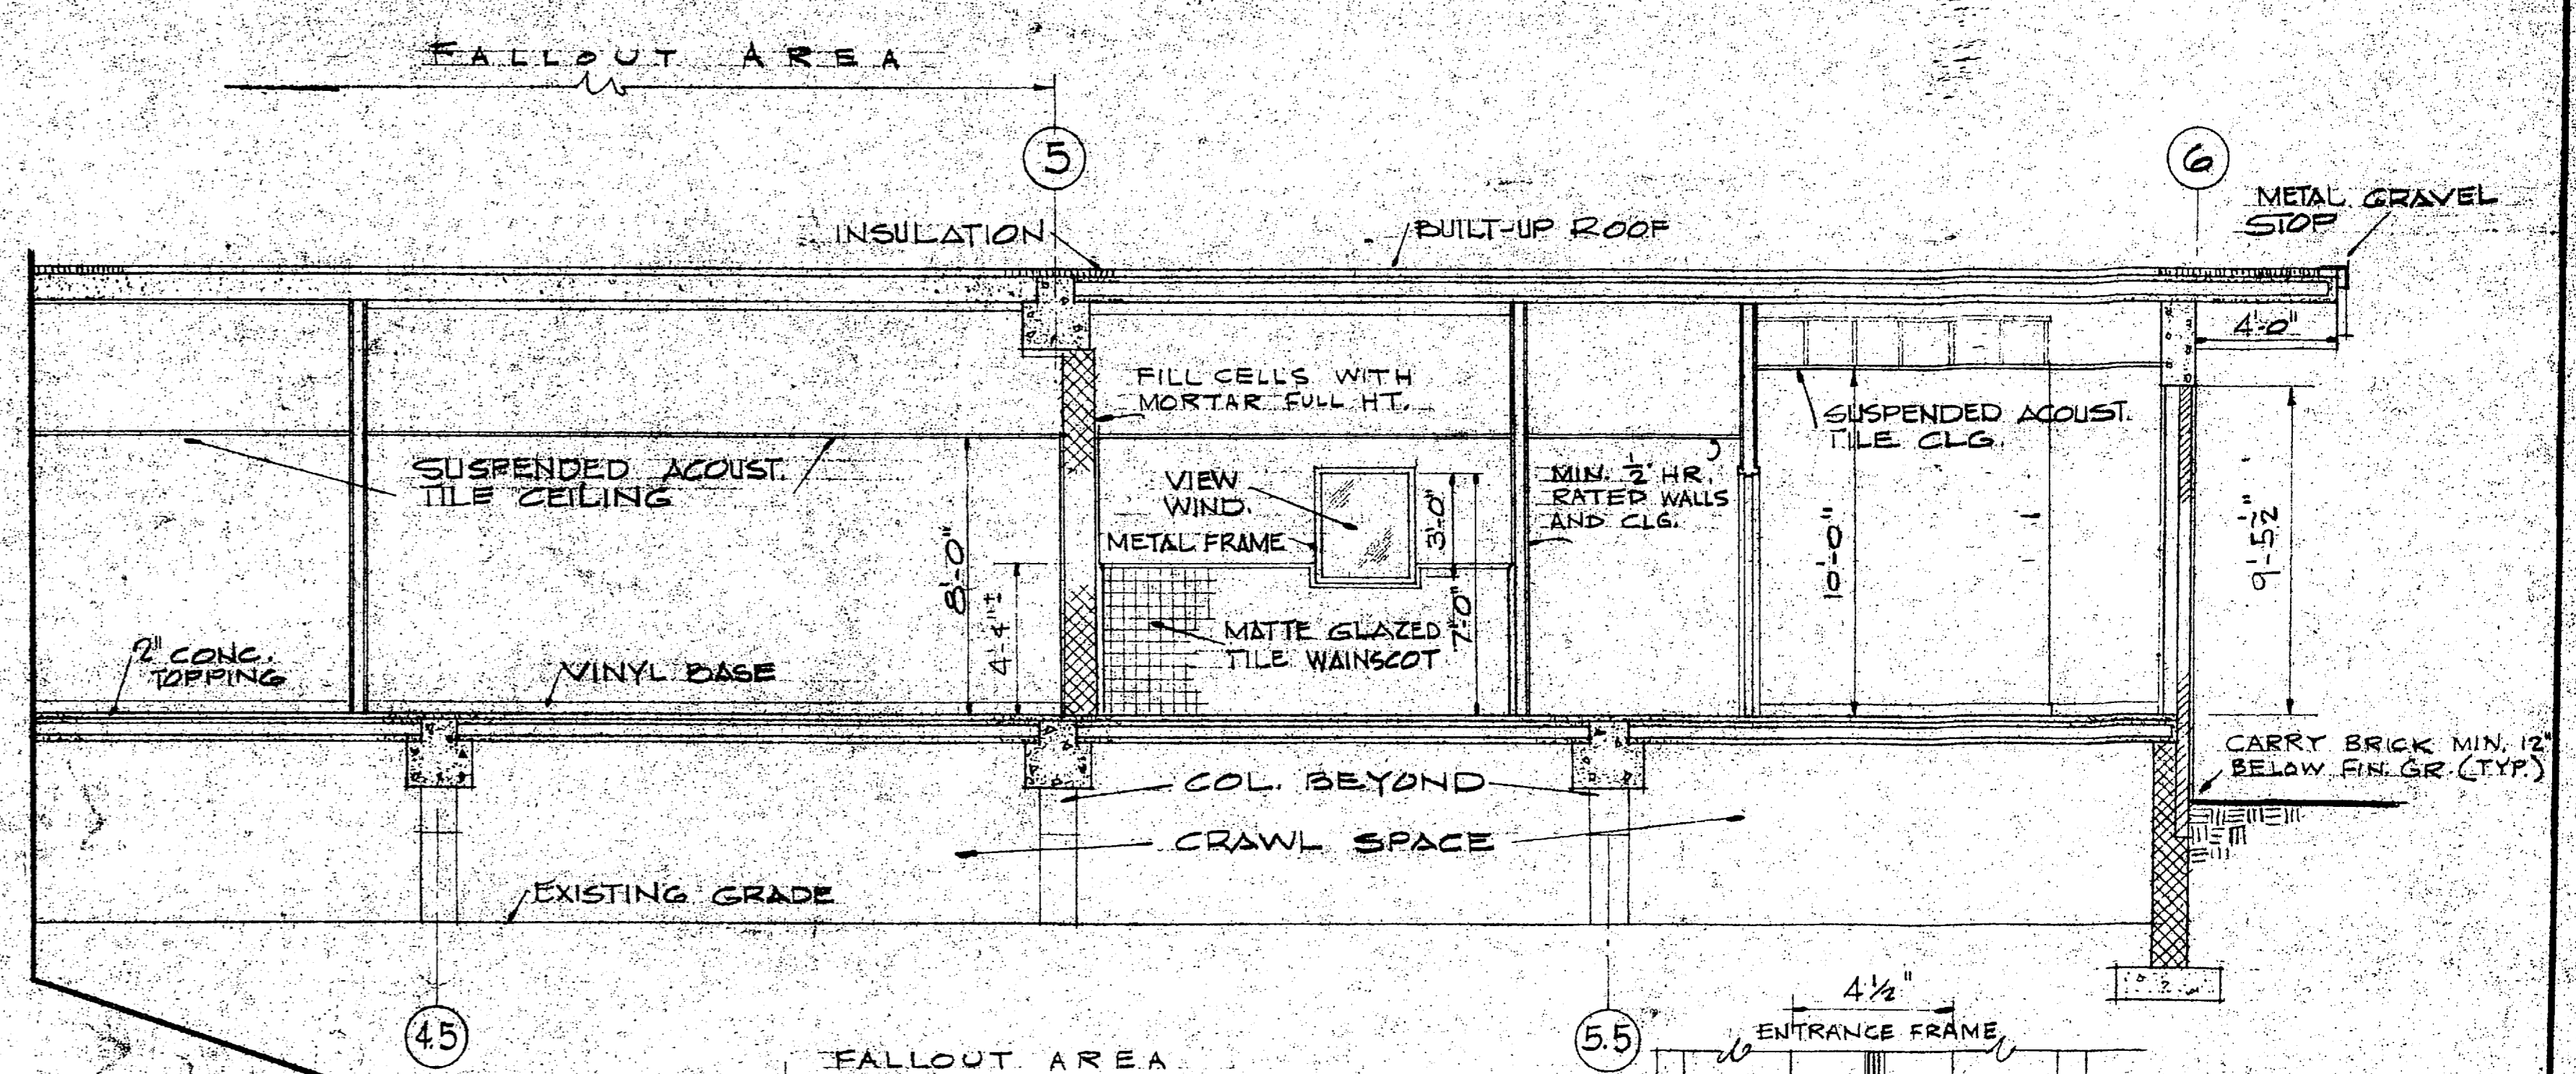
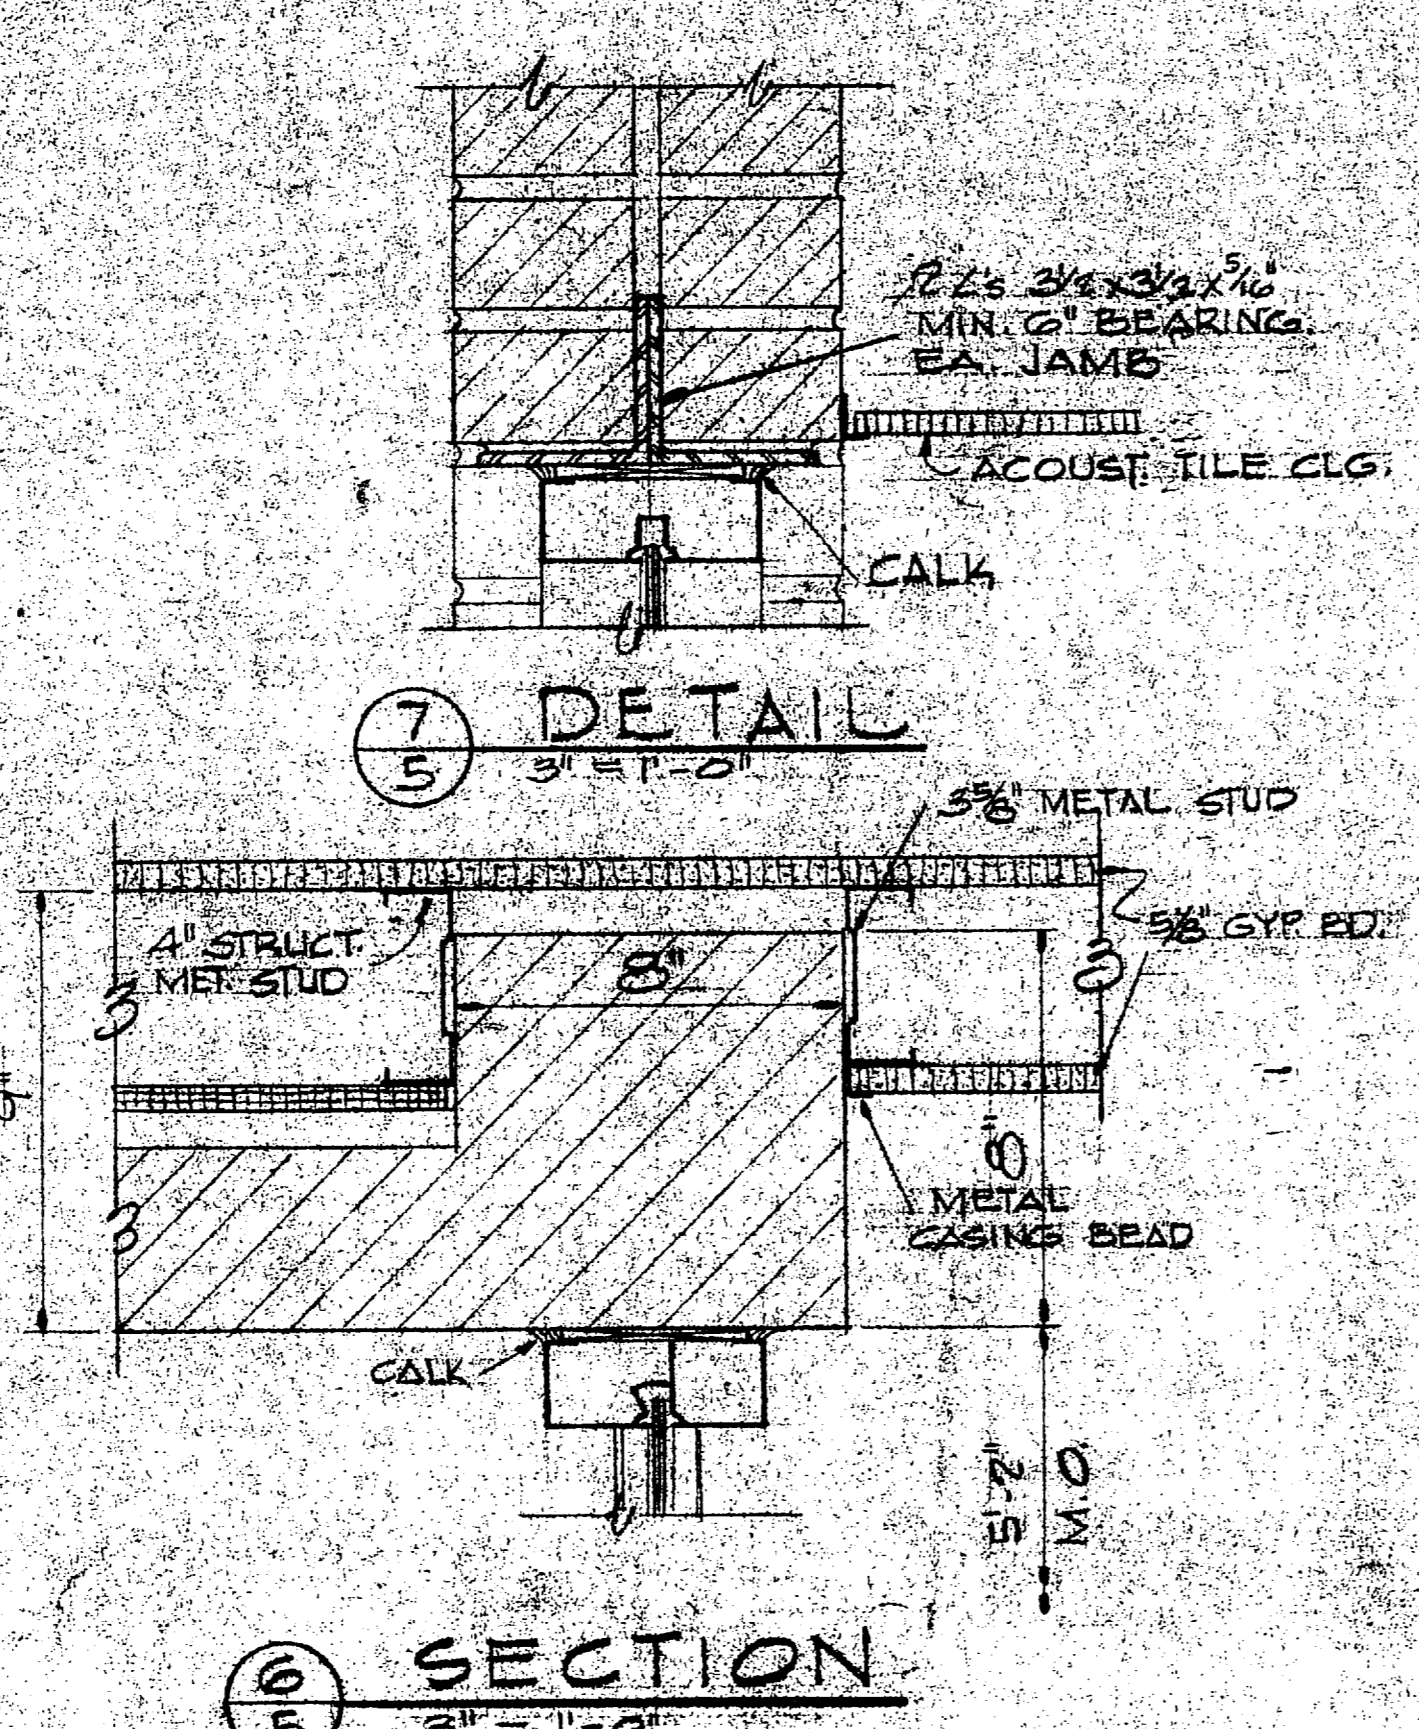


REVISIONS			
NO.	DESCRIPTION	DATE	APPROVED
1	CATG PIPE ADDEP. SPLASH BLOCK RELOCATED DET. 8 ADDED	6/19/72	A. S. J.

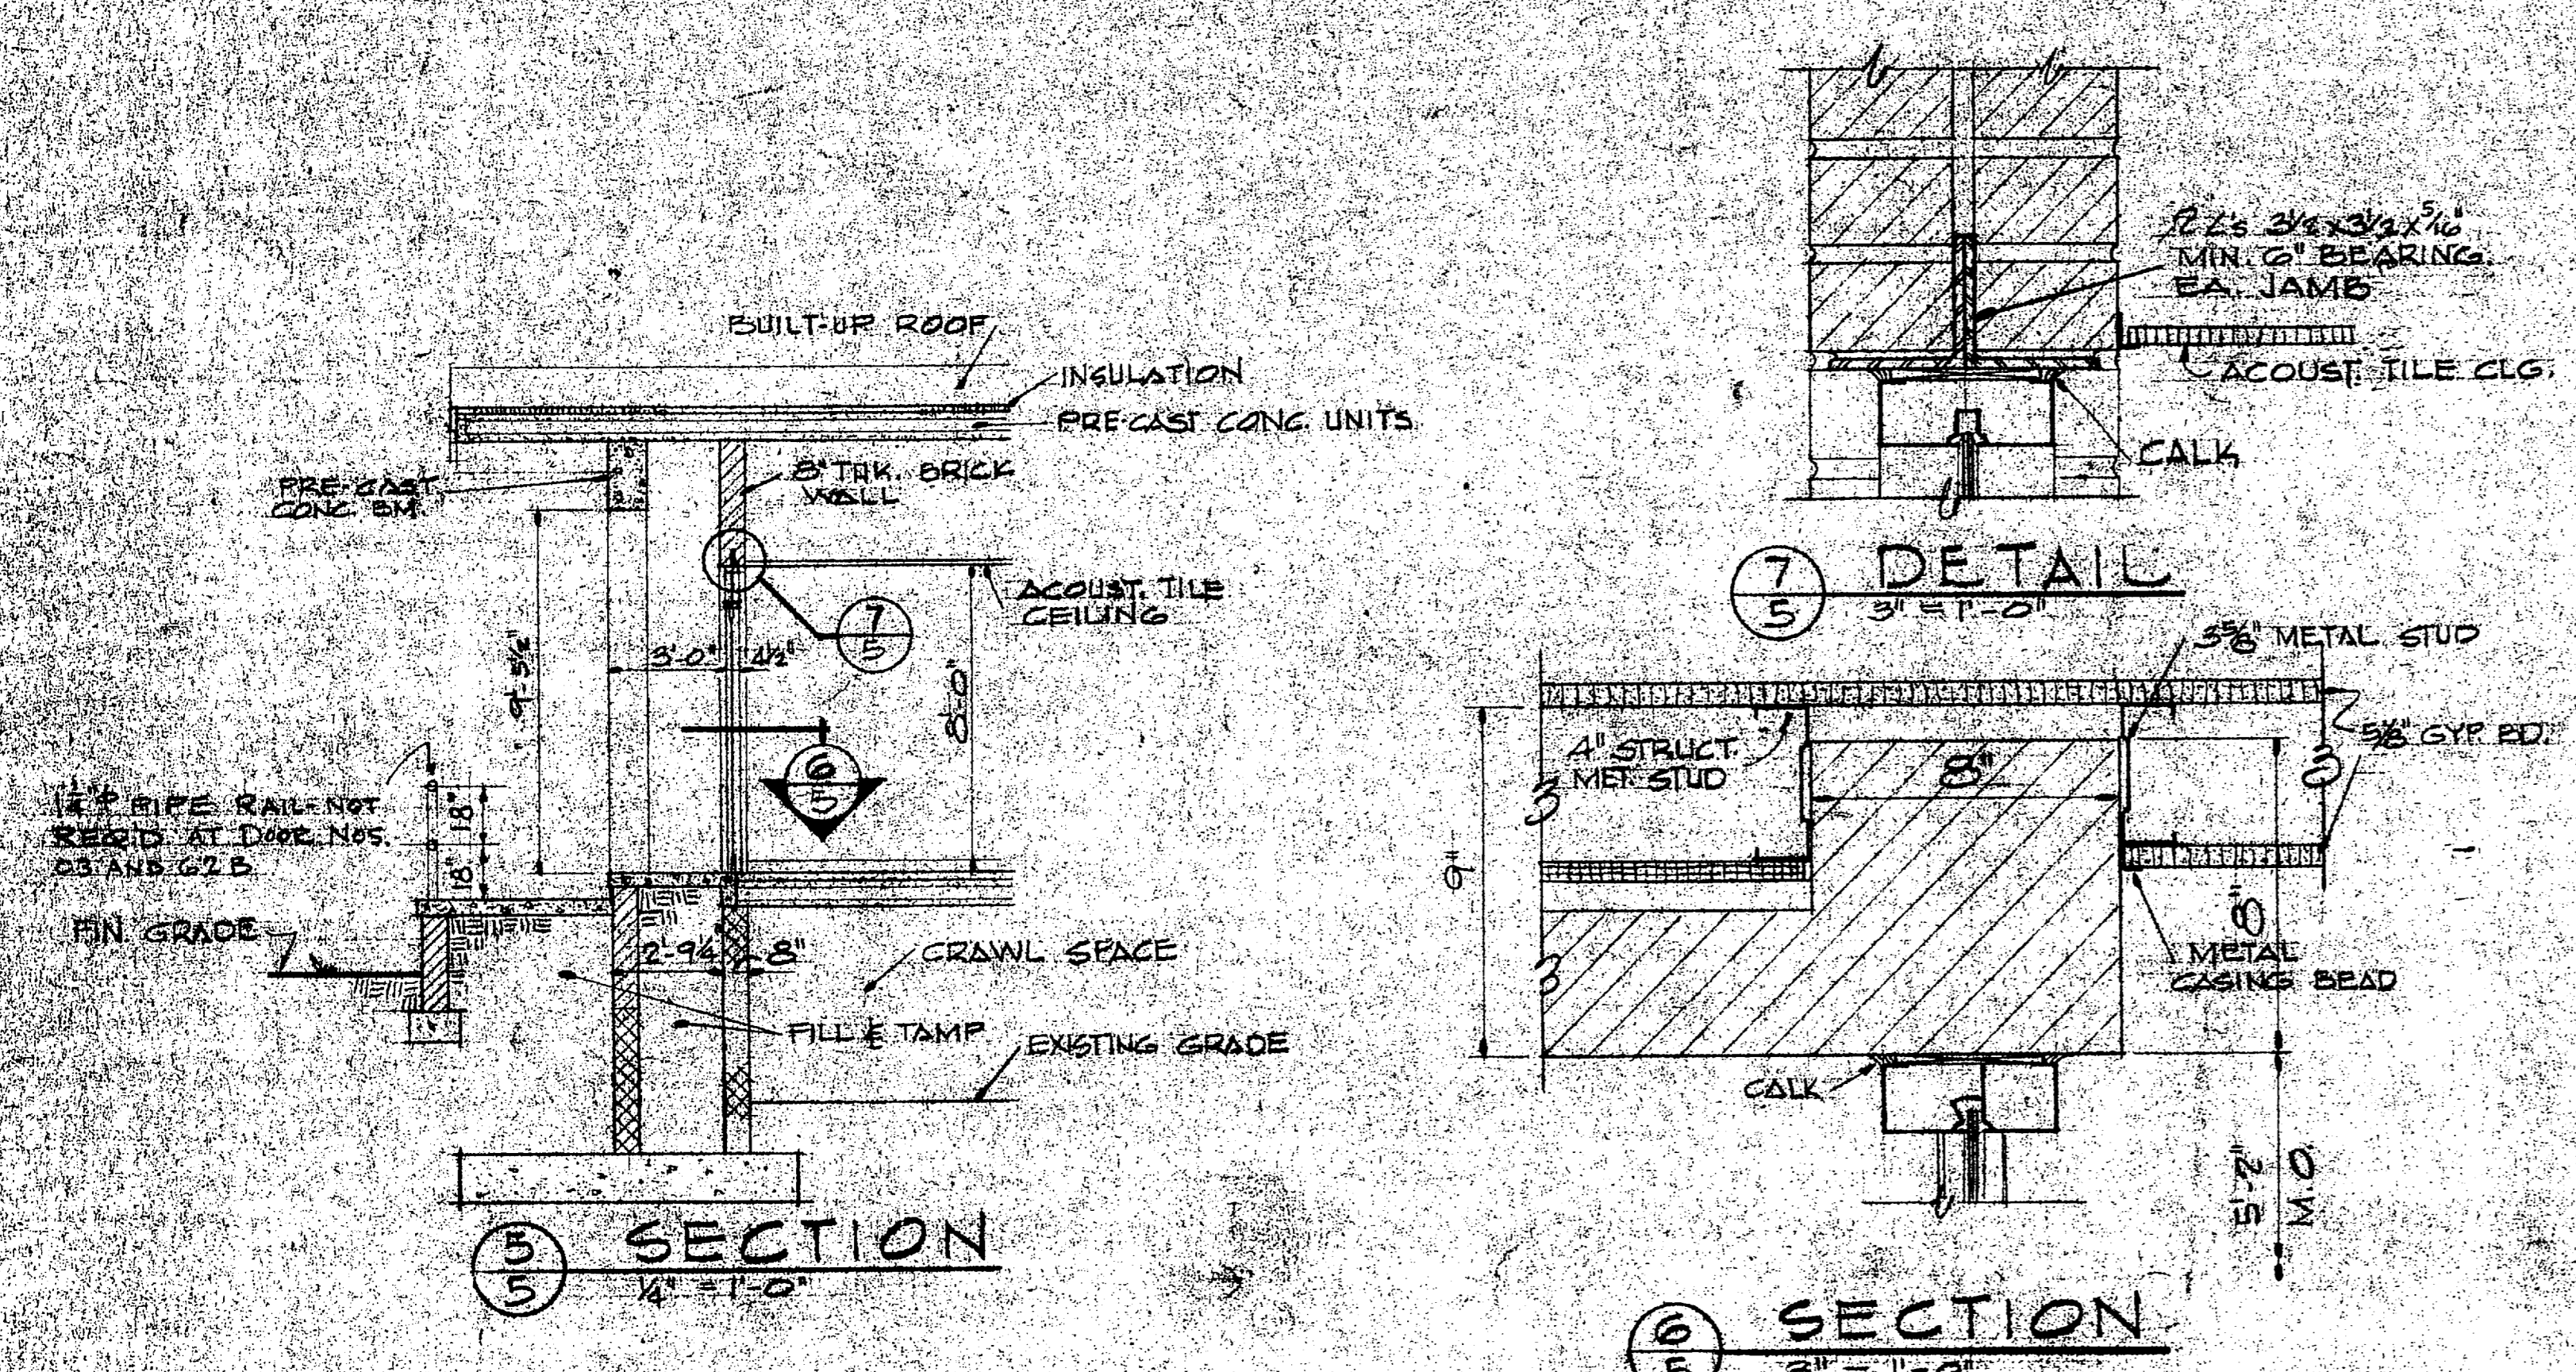

SIX ASSOCIATES INC. ARCHITECTS & ENGINEERS ASHEVILLE, N.C.

DEPARTMENT OF THE NAVY - NAVAL FACILITIES ENGINEERING COMMAND - ATLANTIC DIVISION - NAVAL STATION - MARINE CORPS BASE - CAMP LEJEUNE, N.C.

DENTAL CLINIC
BUILDING SECTIONS AND DETAILS

NAVFAF DRAWING NO. 1359870
CONSTR. CONTR. NO. N 62470-68-B-0863
SCALE: AS NOTED SPEC. 93672 / 68 SHEET 5 OF 25
86870

