



HP# 11 - Wired Wrong  
 #24 - Wired Wrong  
 #22 -

REVISIONS	
NO.	DESCRIPTION

FC-500 HVAC PLAN  
 SCALE: 1/8" = 1'-0"

SPACE	DESIGN CONDITIONS	
	SUMMER	WINTER
OUTSIDE	90°F DB, 79°F WB	23°F DB
ADMIN	78°F DB, 50% RH	68°F DB
MECH. RM.	107°F DB	45°F DB
TOILETS	HEAT & VENTILATE ONLY	68°F DB
CLOSETS	HEAT & VENTILATE ONLY	VENTILATE ONLY


- NOTES:
- 1) ALL SHEET METAL DUCT SHALL BE RATED FOR 1/2" W.G. POSITIVE STATIC PRESSURE AND 2500 FPM VELOCITY. NO SEALANT Req'd. UNLESS SHOWN OTHERWISE.
  - 2) ROUND RUNOUTS & FLEXIBLE DUCT SHALL BE SAME SIZE AS DIFFUSER NECK.
  - 3) UNITS HP-13, HP-27 & HP-28 SUPPLY TEMPERED OUTSIDE AIR TO PLENUM ABOVE CEILING IN CORRIDORS; UNITS ARE CONTROLLED BY T-STATS MOUNTED ABOVE THE CORRIDOR CEILING.
  - 4) TURN-DOWN HEAT PUMP CONDENSATE DRAIN LINES TO PLUMBING DRAIN. SEE PLUMBING DRAWINGS.
  - 5) LOCATE HEAT PUMPS CENTERED IN CORRIDORS AS SHOWN IN DIAGRAM 1, M1, M4.
  - 6) SEE ARCH. DWGS FOR DOOR UNDERCUTS IN ROOMS 103, 113A, 117A, 202, 207, 305, 306, 404A, 402A, 412, 413, 507A, & 508A.
  - 7) SEE REFLECTED CEILING PLAN DWG. A17 FOR EXACT DIFFUSER LOCATIONS.
  - 8) ALL SUPPLY, RETURN AND OUTSIDE AIR DUCTS SHALL BE INSULATED.

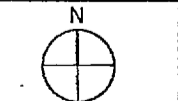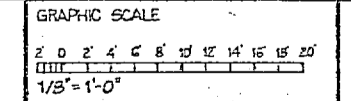

		DEPARTMENT OF THE NAVY NAVAL FACILITIES ENGINEERING COMMAND ATLANTIC DIVISION	
BATTALION HEADQUARTERS		NORFOLK, VA. CAMP LEJEUNE, N. C.	
FC-500 HVAC PLAN			
EPL DWG NO 25788A JOB ORDER NO SF5143 STA PROJ NO FV87-MCCK/P-031 DESIGNED BY DRAWN BY CHECKED BY DATE	SIZE <b>F 800SI</b>	INVOICE DATES NO 457684	EIGHTH CONTR NO N62470-85-B-5143
ACTIVITY - SATISFACTORY TO		SCALE 1/8" = 1'-0" DWG 05-85-5143	
APPROVED DATE		SHEET 45 OF 78	

REVISED HP-12



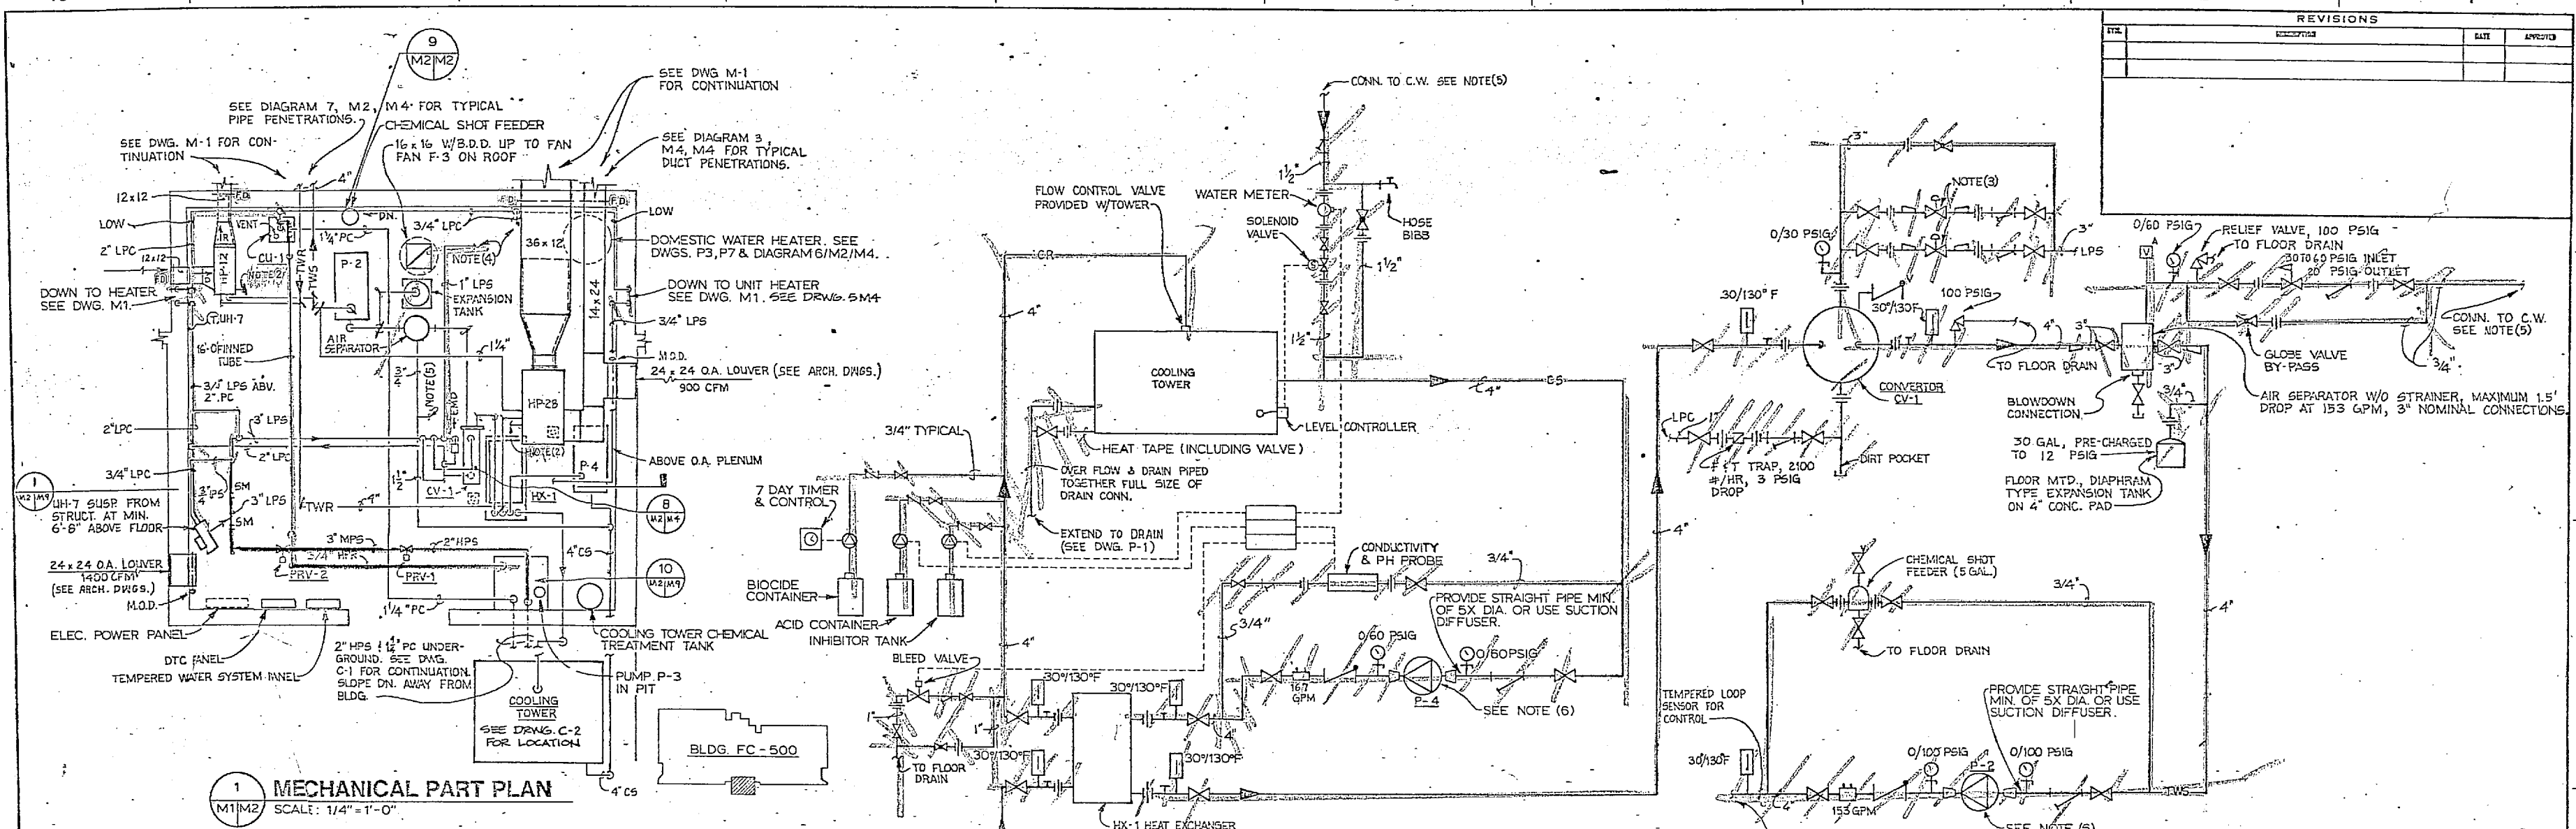


**1 MECHANICAL PART PLAN**  
SCALE: 1/4" = 1'-0"


**2 TEMPERED WATER LOOP & COOLING TOWER FLOW SCHEMATIC**  
NOT TO SCALE

- NOTES:**
- 1) LOCATE EXPANSION TANK AS CLOSE TO PUMP SUCTION AS POSSIBLE.
  - 2) RUN 1" CONDENSATE DRAIN TO FLOOR DRAIN NEAR BASEMENTS PUMPS.
  - 3) CONTROL VALVES SHALL HAVE 700#/HR & 350#/HR CAPACITY (SEE CONVERTOR SCHEDULE, DWG. M.5.)
  - 4) CONNECT TO DOMESTIC WATER HTR. SEE DIAGRAM 6, M.2, M.4.
  - 5) CONNECT 1/2" TO C.W. SEE PLBG. DWG. P-3.
  - 6) PUMPS P-2 & P-4 TO BE MOUNTED ON 4" CONC. PAD, INERTIA BASE, & VIBRATION ISOLATORS (SEE PUMP SCHEDULE ON DWG. M.6.) USE ELBOW SUPPORT & FLOOR FLANGE UNDER SUCTION PIPE.


**3 CHEMICAL SHOT FEEDER SUPPORT**  
NOT TO SCALE

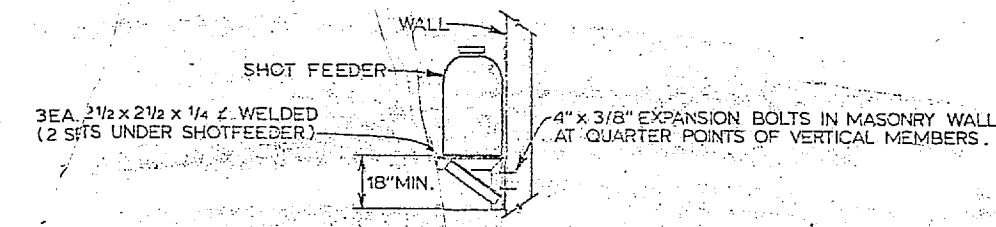


**4 AIR SEPARATOR SUPPORT**  
NOT TO SCALE

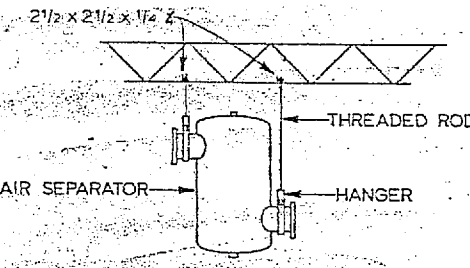


**5 TYPICAL HEAT PUMP PIPING SCHEMATIC**  
SCALE: 1/2" = 1'-0"

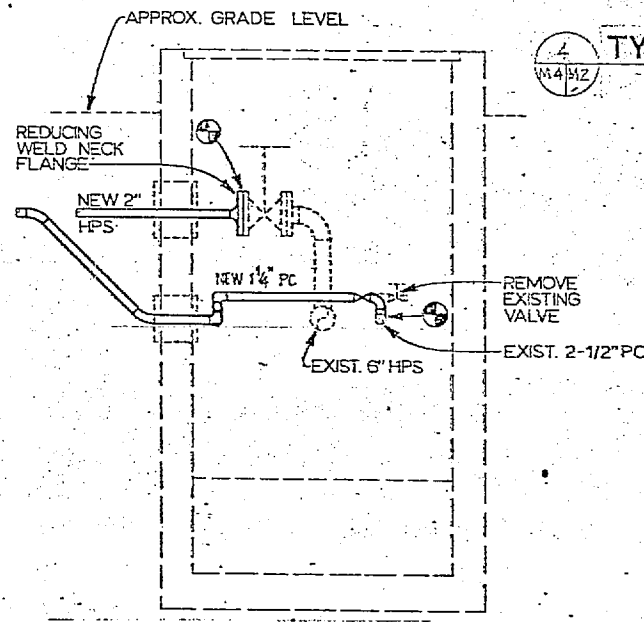



**6 EXISTING STEAM PIT - M.H. - 115**  
SCALE: 1/2" = 1'-0"

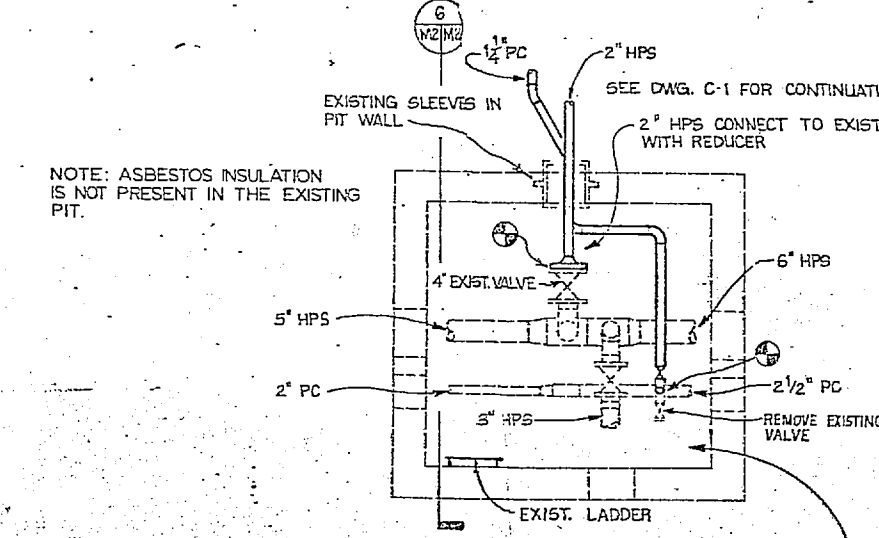

**7 M.H. - 115 ELEVATION**  
SCALE: 1/2" = 1'-0"


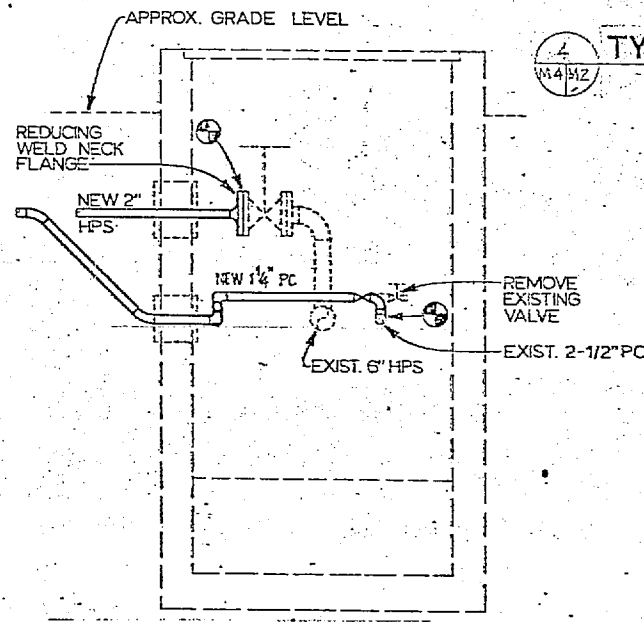


**8 HEAT TAPE DIAGRAM**  
NOT TO SCALE

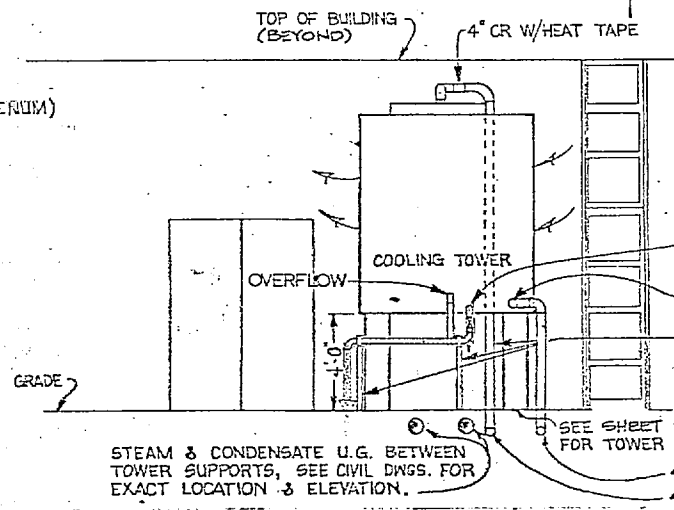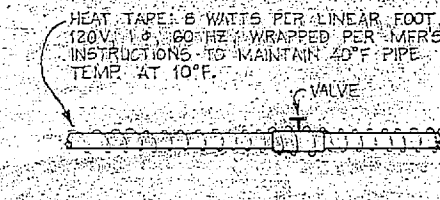

**9 COOLING TOWER SOUTH ELEVATION**  
SCALE: 1/4" = 1'-0"


**FC 500**

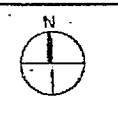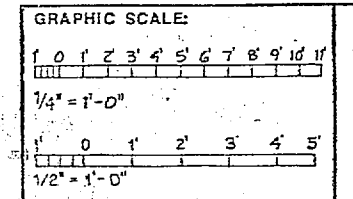

REVISIONS		DATE	APPROVED


  

		<b>M2</b>	
DEPARTMENT OF THE NAVY NAVAL FACILITIES ENGINEERING COMMAND			
ATLANTIC DIVISION			
NAVAL STATION		NORFOLK, VA	
MARINE CORPS BASE		CAMP LEJEUNE, N. C.	
<b>BATTALION HEADQUARTERS</b>			
FC-500 PART PLAN & FLOW SCHEMATIC			
APPROVED DATE	DESIGNED DATE	DRAWN DATE	CHECKED DATE
ACTIVITY SATISFACTORY TO	DATE	SCALE NOTED	SHEET NO.

 

REVISIONS		
NO.	DESCRIPTION	DATE


SEE 3/32" SCALE DRAWING THIS SHEET FOR CONTINUATION

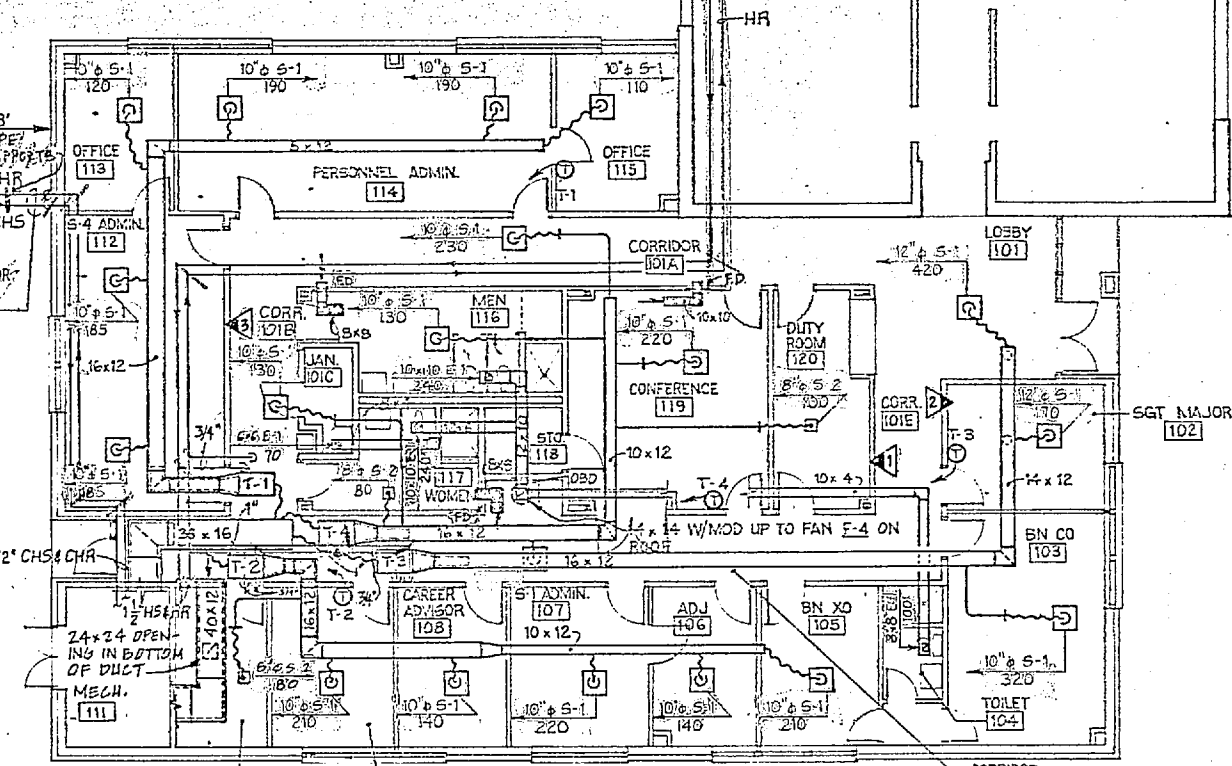


**HVAC FLOOR PLAN**  
SCALE: 1/8" = 1'-0"

SEE REFLECTED CEILING PLAN DWG. A17 FOR EXACT DIFFUSER LOCATIONS


- NOTES:
- 1) ALL DUCT SHALL BE RATED FOR 1" W.G. POSITIVE STATIC PRESSURE AND 2500 FPM VELOCITY EXCEPT THAT SUPPLY DUCT UPSTREAM OF TERMINAL UNITS SHALL BE RATED FOR 2" W.G. POSITIVE STATIC PRESSURE AND 2500 FPM VELOCITY. SEAL TRANSVERSE JOINTS IN 2" RATED DUCT ONLY.
  - 2) RETURN AIR THROUGH CEILINGS IS BY LIGHT TROFFER UNLESS SHOWN OTHERWISE.
  - 3) ALL SUPPLY, RETURN AND OUTSIDE AIR DUCTS SHALL BE INSULATED.

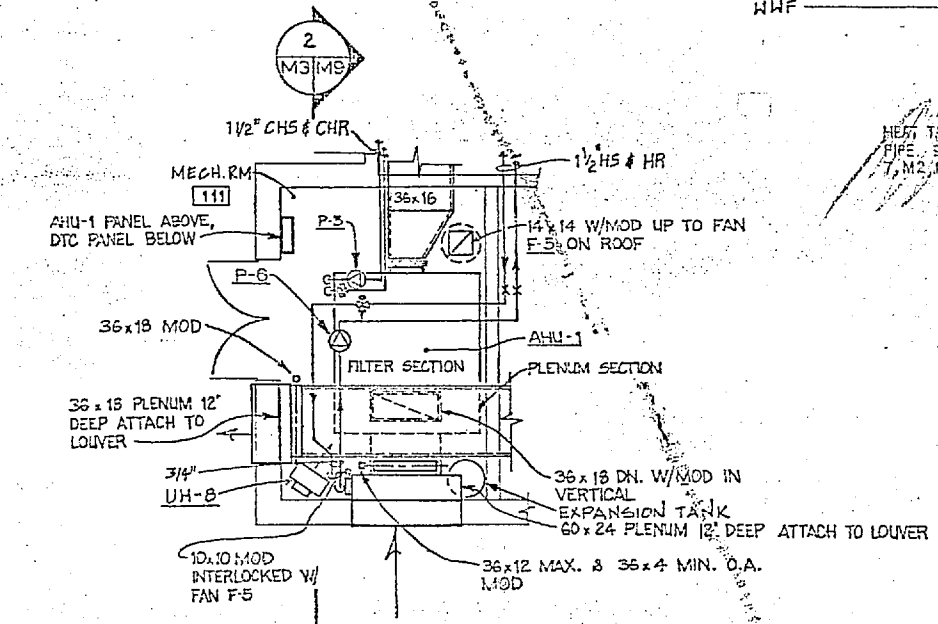


**MECHANICAL ROOM PART PLAN**  
SCALE: 1/4" = 1'-0"

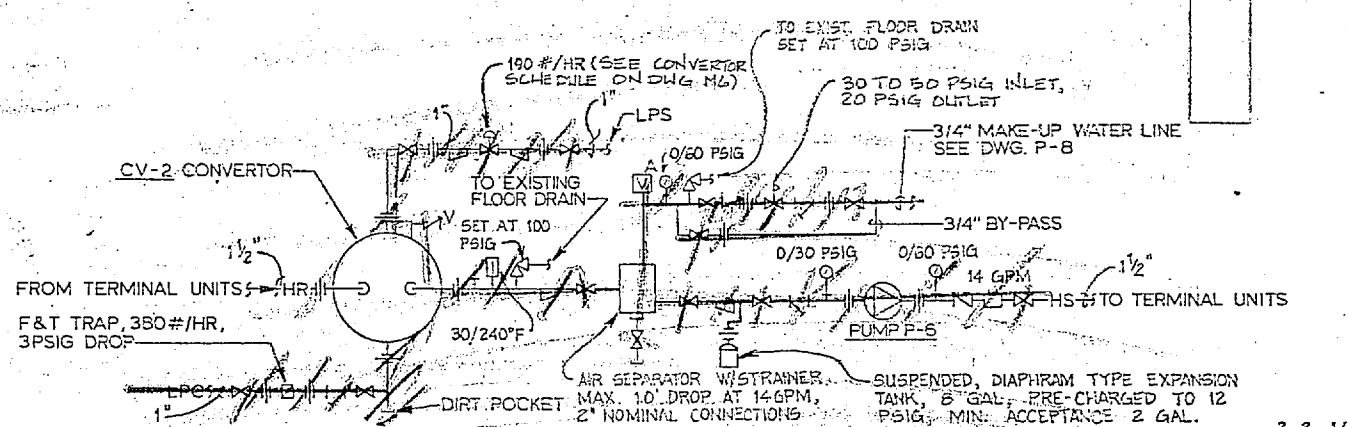


**CONVERTOR & HEATING HOT WATER FLOW SCHEMATIC**  
NTS

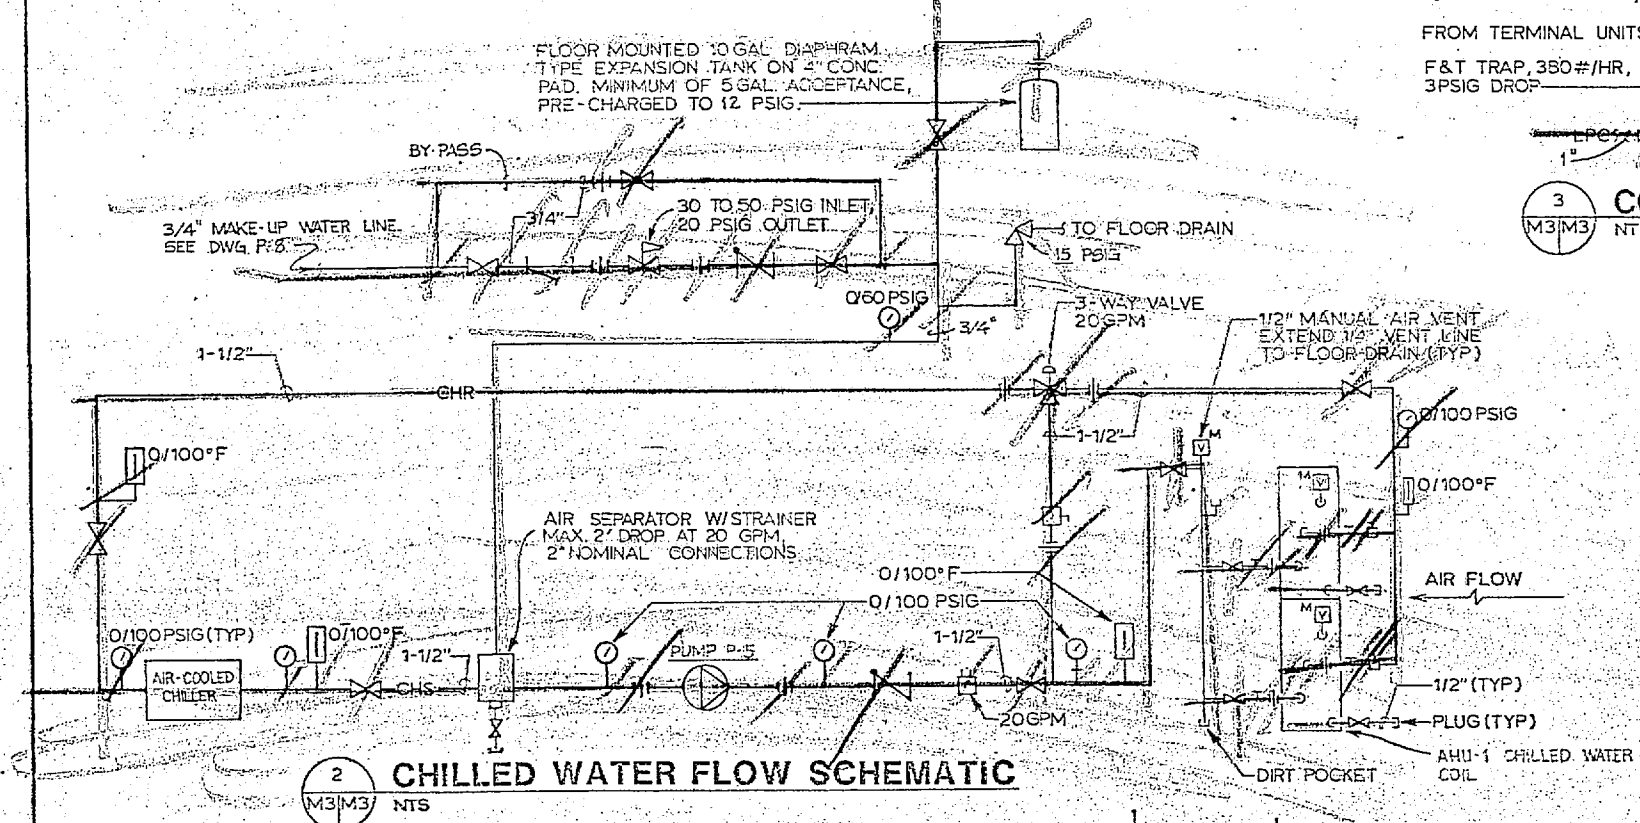


**CHILLED WATER FLOW SCHEMATIC**  
NTS

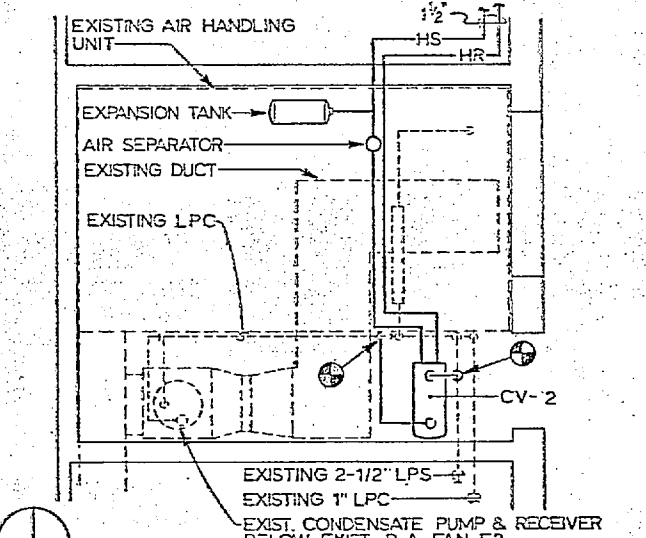


**EXIST. MECH. ROOM PLAN**  
SCALE: 1/4" = 1'-0"

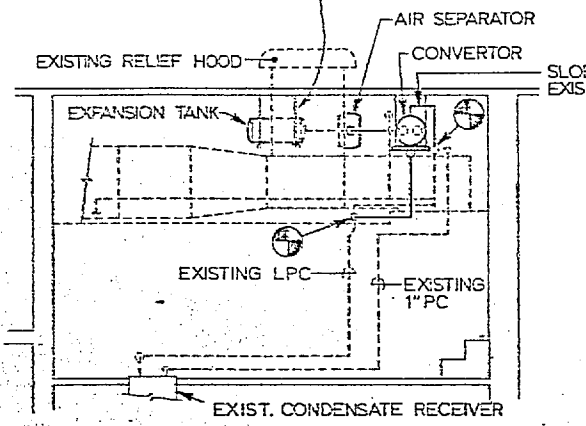

**EXIST. MECH. ROOM SECTION**  
SCALE: 1/4" = 1'-0"

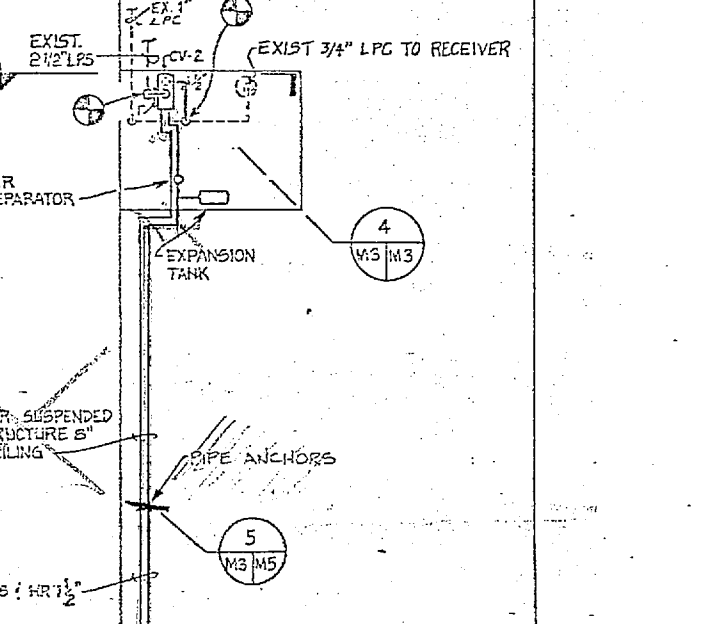


**HVAC FLOOR PLAN (EXISTING EAST WING)**  
SCALE: 3/32" = 1'-0"

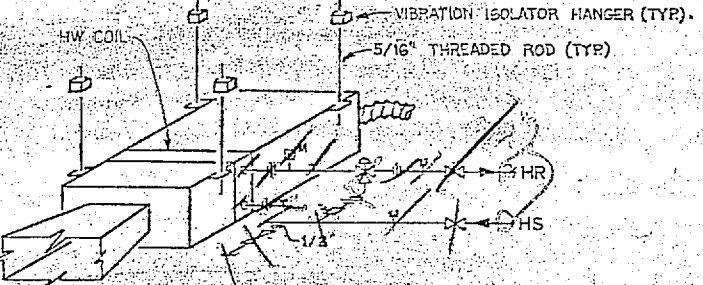

**TERMINAL UNIT DIAGRAM**  
NO SCALE

*FC 300  
New Addition*

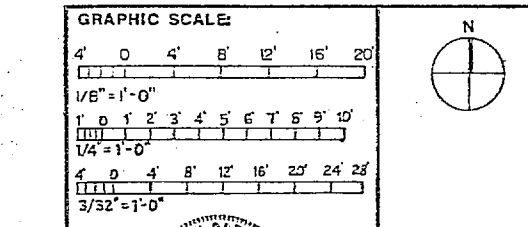


		M3	
		DEPARTMENT OF THE NAVY NAVAL FACILITIES ENGINEERING COMMAND ATLANTIC DIVISION NORFOLK, VA.	
NAVY STATION CAMP LEJEUNE, N. C.		BATTALION HEADQUARTERS	
FC-300 HVC PLAN			




CHS	CHILLED WATER SUPPLY	FD	FIRE DAMPER
CHR	CHILLED WATER RETURN	AP	ACCESS PANEL
CS	COOLING TOWER SUPPLY	AD	ACCESS DOOR
CR	COOLING TOWER WATER RETURN	OA	OUTSIDE AIR
D	DRAIN	RA	RETURN AIR
		FC	FLEXIBLE CONNECTION
		DB	DRY BULB
		WB	WET BULB
		φ	ROUND DUCTWORK
		NTS	NOT TO SCALE
		EAT	ENTERING AIR TEMPERATURE
		EWT	ENTERING WATER TEMPERATURE
		LWT	LEAVING WATER TEMPERATURE
		APD	AIR PRESSURE DROP
		MPD	WATER PRESSURE DROP
		HS	HOT WATER SUPPLY
		HR	HOT WATER RETURN
		TWS	TEMPERED WATER SUPPLY
		TWR	TEMPERED WATER RETURN
		HPS	HIGH PRESSURE STEAM
		MPS	MEDIUM PRESSURE STEAM
		LPS	LOW PRESSURE STEAM
		LPC	LOW PRESSURE CONDENSATE
		FC	FUMPED CONDENSATE
			CONNECT TO EXISTING
			COMBINATION SHUTOFF & BALANCING VALVE
			W/PRESSURE TAPS



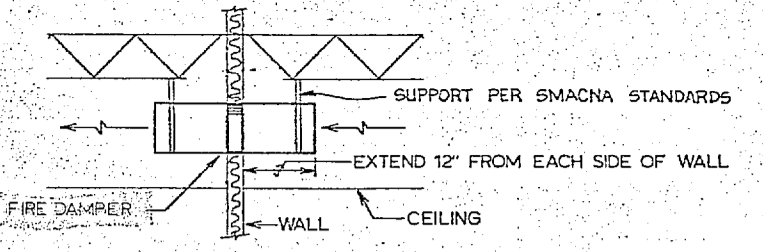


3 TRANSFER DUCT (TYPICAL)  
M4/M4 NTS

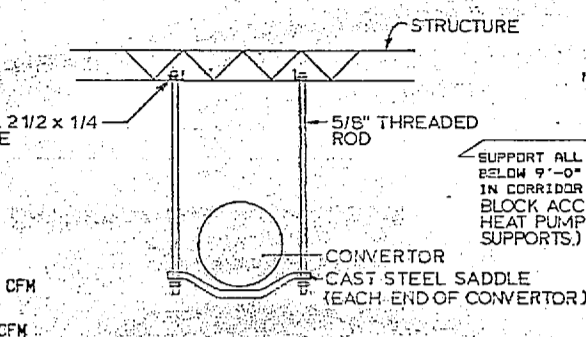


8 CONVERTOR SUPPORT  
NO SCALE (CV-1 ONLY)

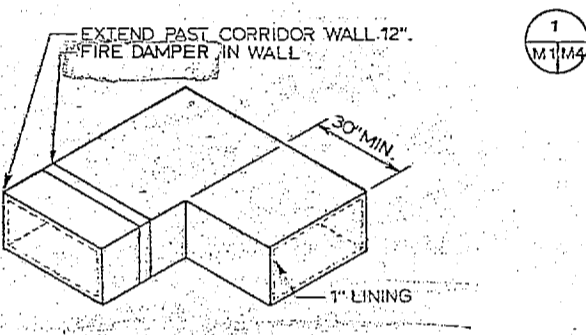


4 LINED ELBOW (TYPICAL)  
M4/M4 NTS

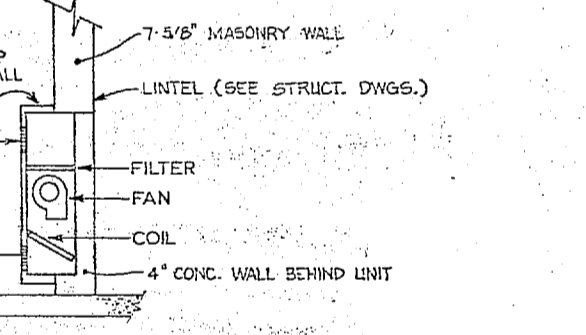


5 WALL MOUNTED CABINET UNIT HEATER  
M4/M4 NTS

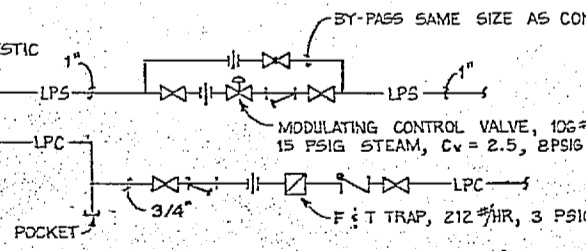


6 STEAM AND CONDENSATE CONNECTIONS TO DOMESTIC WATER HEATER IN BLDG. FC-500  
NO SCALE

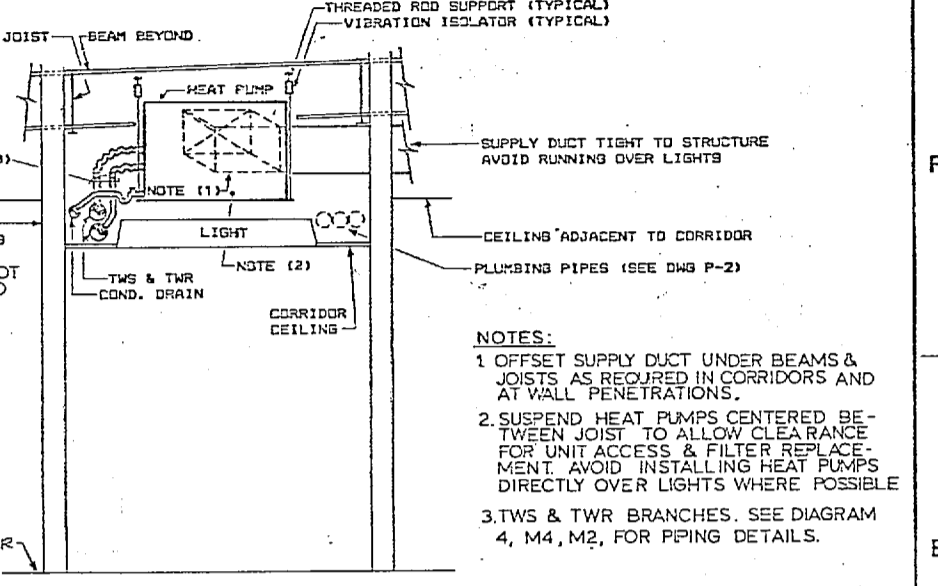



7 SECTION THROUGH CORRIDOR AT HEAT PUMP  
SCALE: 1/2"=1'-0"

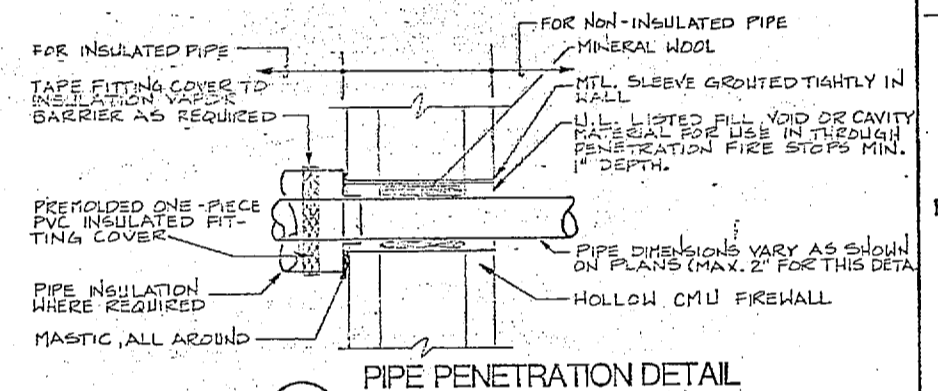

7 PIPE PENETRATION DETAIL (THROUGH FIRE RATED WALL)  
SIMILAR TO U.L. SYSTEM NO.48  
NOTE: DETAIL ILLUSTRATES PIPE INSULATION ON ONE SIDE OF FIRE RATED WALL. WHEN PIPE IS REQUIRED TO BE INSULATED ON BOTH SIDES, THE INSULATION END TREATMENT SHALL BE DUPLICATED ON BOTH SIDES.

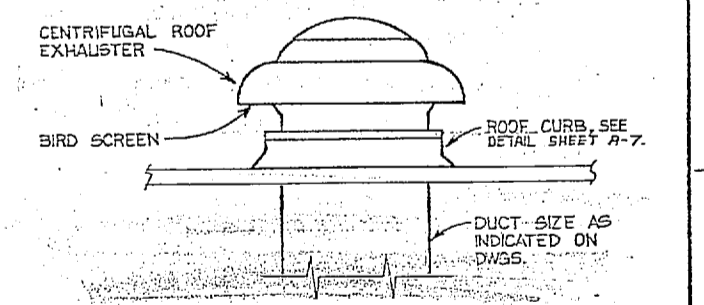

2 POWER ROOF VENTILATOR  
M4/M4 NTS

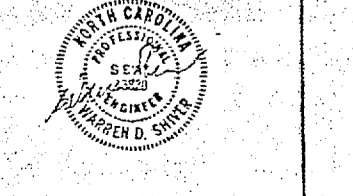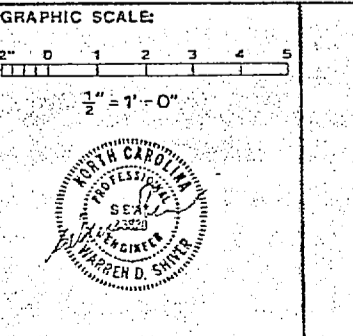


<b>M 4</b>	
LSBP	
DEPARTMENT OF THE NAVY NAVAL FACILITIES ENGINEERING COMMAND	
ATLANTIC DIVISION	
NAVAL STATION NORFOLK, VA.	
MARINE CORPS BASE CAMP LEJEUNE, N. C.	
<b>BATTALION HEADQUARTERS</b>	
HVAC SYMBOLS, ABBREVIATIONS & DETAILS	
APPROVED DATE	SCALE NOTED
ACTIVITY SATISFACTORY TO DATE	SCALE NOTED
FOR THE COMMANDER	SCALE NOTED

FC500




1  
2  
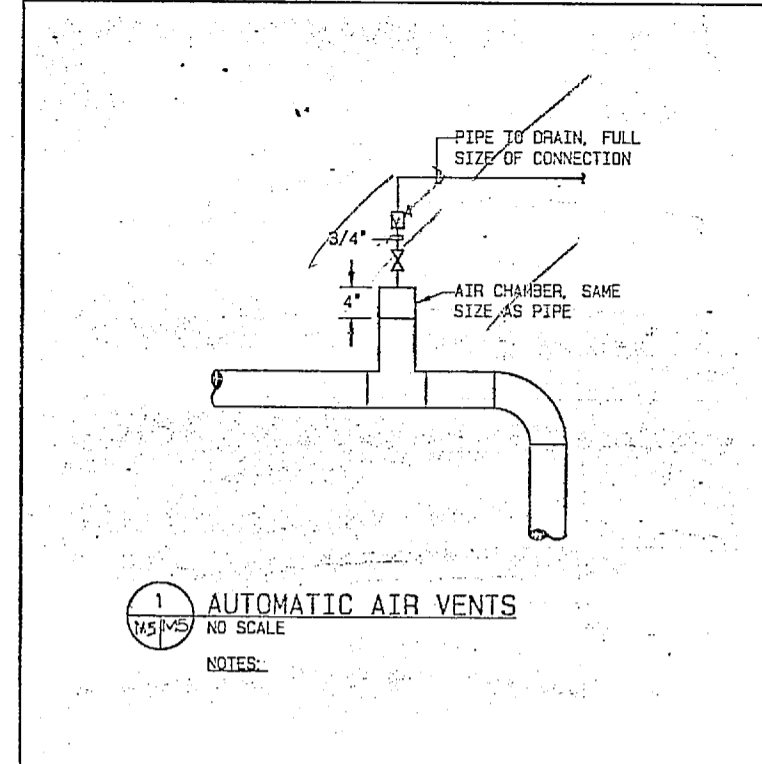


**1 AUTOMATIC AIR VENTS**  
NO SCALE

NOTES:

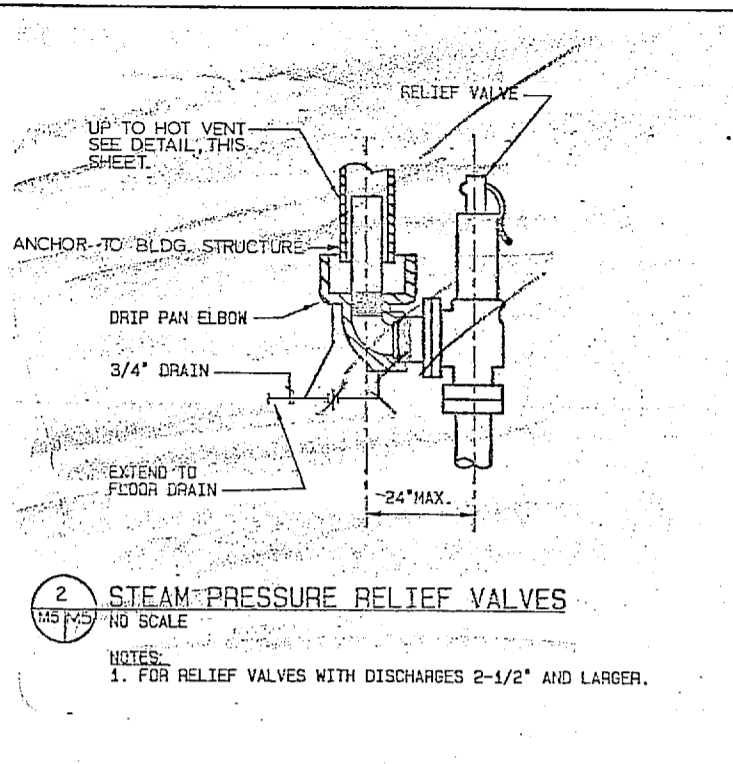


**2 STEAM PRESSURE RELIEF VALVES**  
NO SCALE

NOTES:  
1. FOR RELIEF VALVES WITH DISCHARGES 2-1/2" AND LARGER.

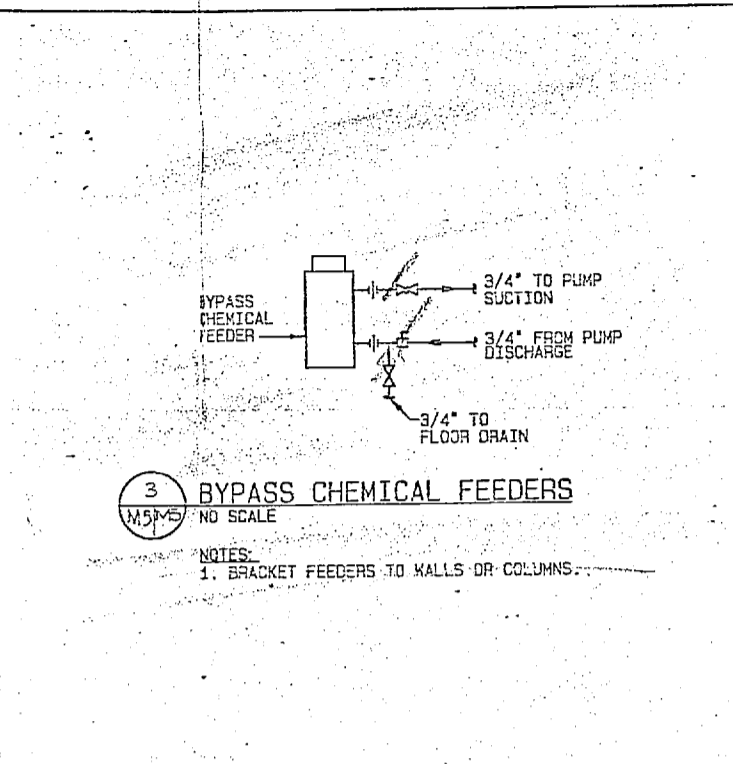


**3 BYPASS CHEMICAL FEEDERS**  
NO SCALE

NOTES:  
1. BRACKET FEEDERS TO WALLS OR COLUMNS.

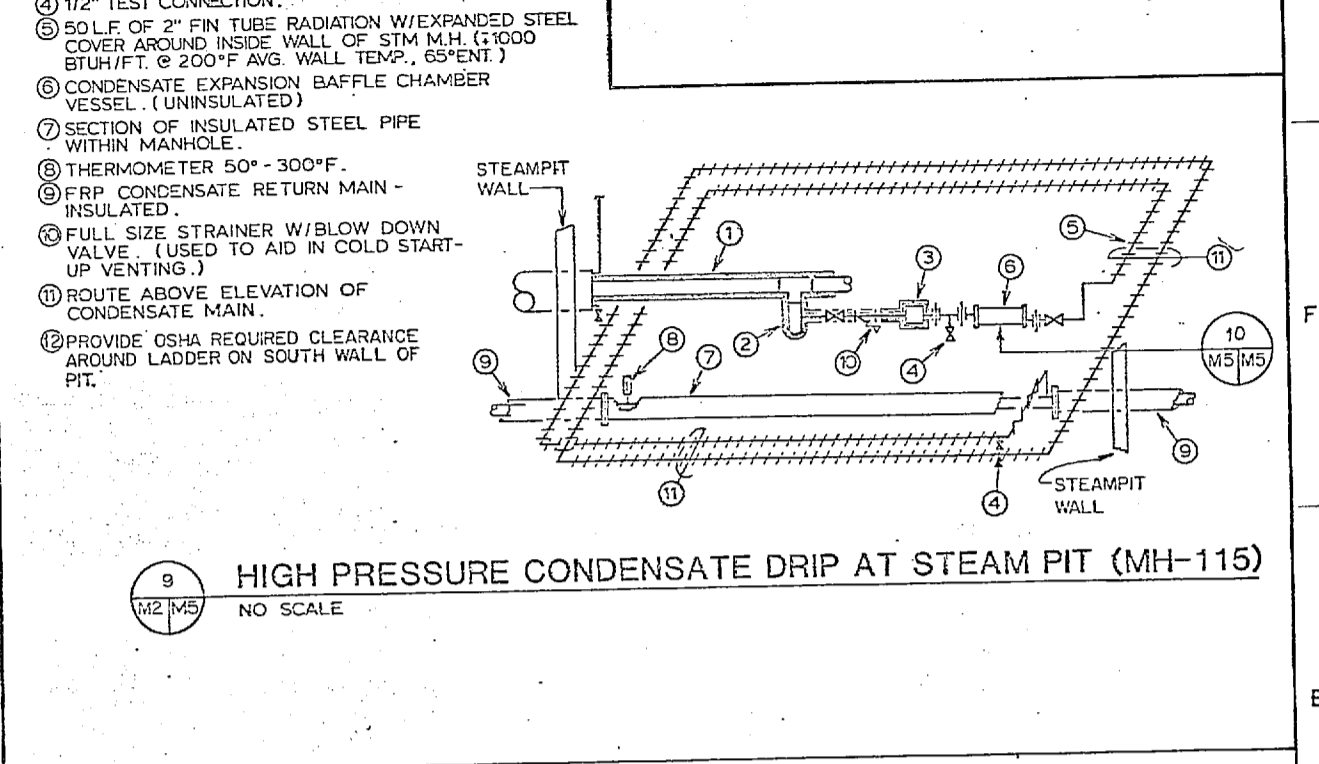


**9 HIGH PRESSURE CONDENSATE DRIP AT STEAM PIT (MH-115)**  
NO SCALE

- NOTES:**
- INSULATED STEAM MAIN.
  - FULL SIZE DRIP POCKET AS DEEP AS DESIGN PERMITS, BUT NOT LESS THAN 8".
  - INVERTED BUCKET TRAP W/FORMED REMOVABLE INSULATION. TRAP SIZED AS REQ'D FOR 3X STM LOAD.
  - 1/2" TEST CONNECTION.
  - 50 L.F. OF 2" FIN TUBE RADIATION W/EXPANDED STEEL COVER AROUND INSIDE WALL OF STM M.H. (1000 BTU/H.F. @ 200°F AVG. WALL TEMP., 65°ENT.)
  - CONDENSATE EXPANSION BAFFLE CHAMBER VESSEL (UNINSULATED)
  - SECTION OF INSULATED STEEL PIPE WITHIN MANHOLE.
  - THERMOMETER 50° - 300°F.
  - FRP CONDENSATE RETURN MAIN - INSULATED.
  - FULL SIZE STRAINER W/BLOW DOWN VALVE (USED TO AID IN COLD START-UP VENTING.)
  - ROUTE ABOVE ELEVATION OF CONDENSATE MAIN.
  - PROVIDE OSHA REQUIRED CLEARANCE AROUND LADDER ON SOUTH WALL OF PIT.

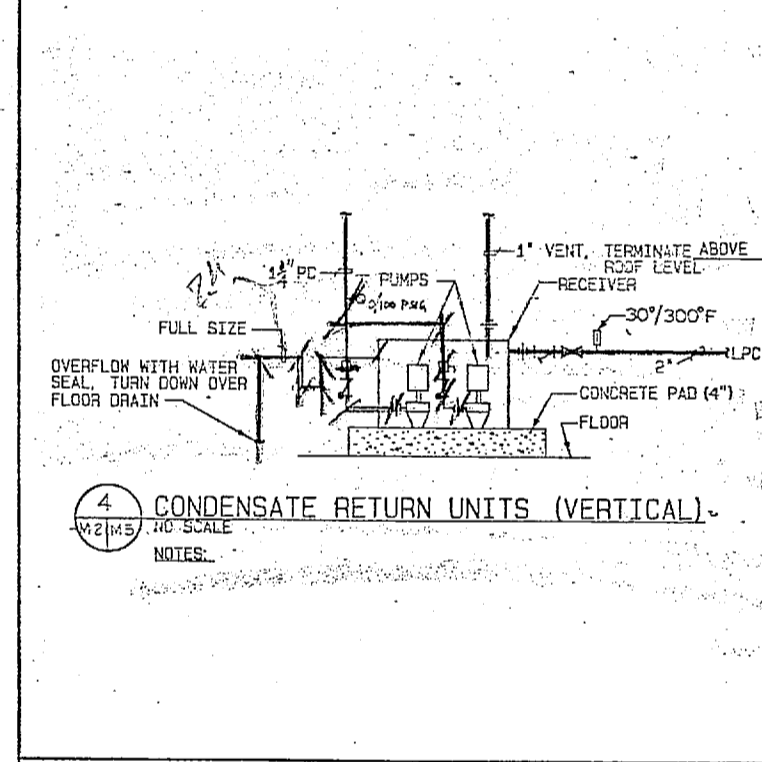


**4 CONDENSATE RETURN UNITS (VERTICAL)**  
NO SCALE

NOTES:

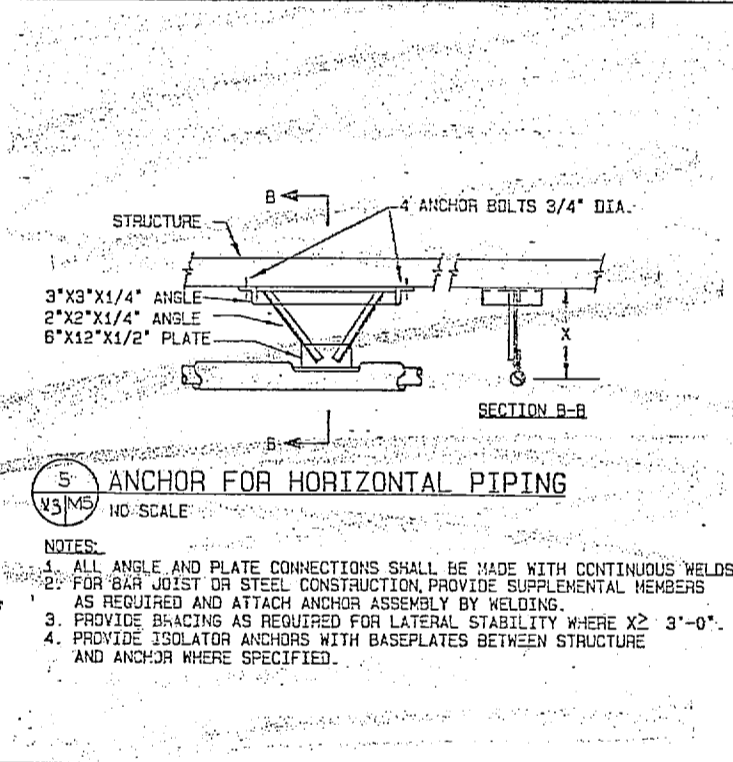


**5 ANCHOR FOR HORIZONTAL PIPING**  
NO SCALE

NOTES:  
1. ALL ANGLE AND PLATE CONNECTIONS SHALL BE MADE WITH CONTINUOUS WELDS.  
2. FOR BAR JOIST OR STEEL CONSTRUCTION, PROVIDE SUPPLEMENTAL MEMBERS AS REQUIRED AND ATTACH ANCHOR ASSEMBLY BY WELDING.  
3. PROVIDE BRACING AS REQUIRED FOR LATERAL STABILITY WHERE X2 3'-0".  
4. PROVIDE ISOLATOR ANCHORS WITH BASEPLATES BETWEEN STRUCTURE AND ANCHOR WHERE SPECIFIED.

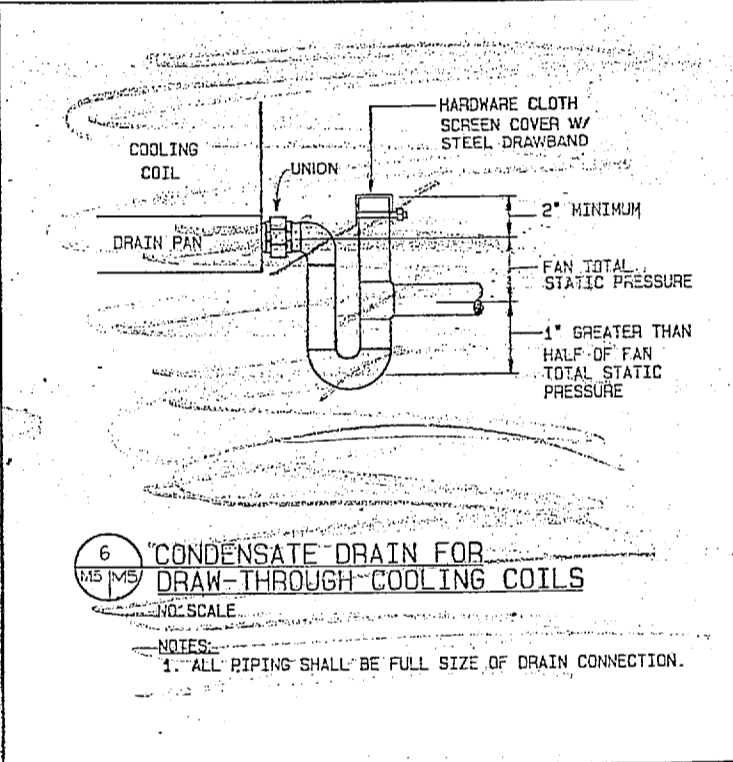


**6 CONDENSATE DRAIN FOR DRAW-THROUGH COOLING COILS**  
NO SCALE

NOTES:  
1. ALL PIPING SHALL BE FULL SIZE OF DRAIN CONNECTION.

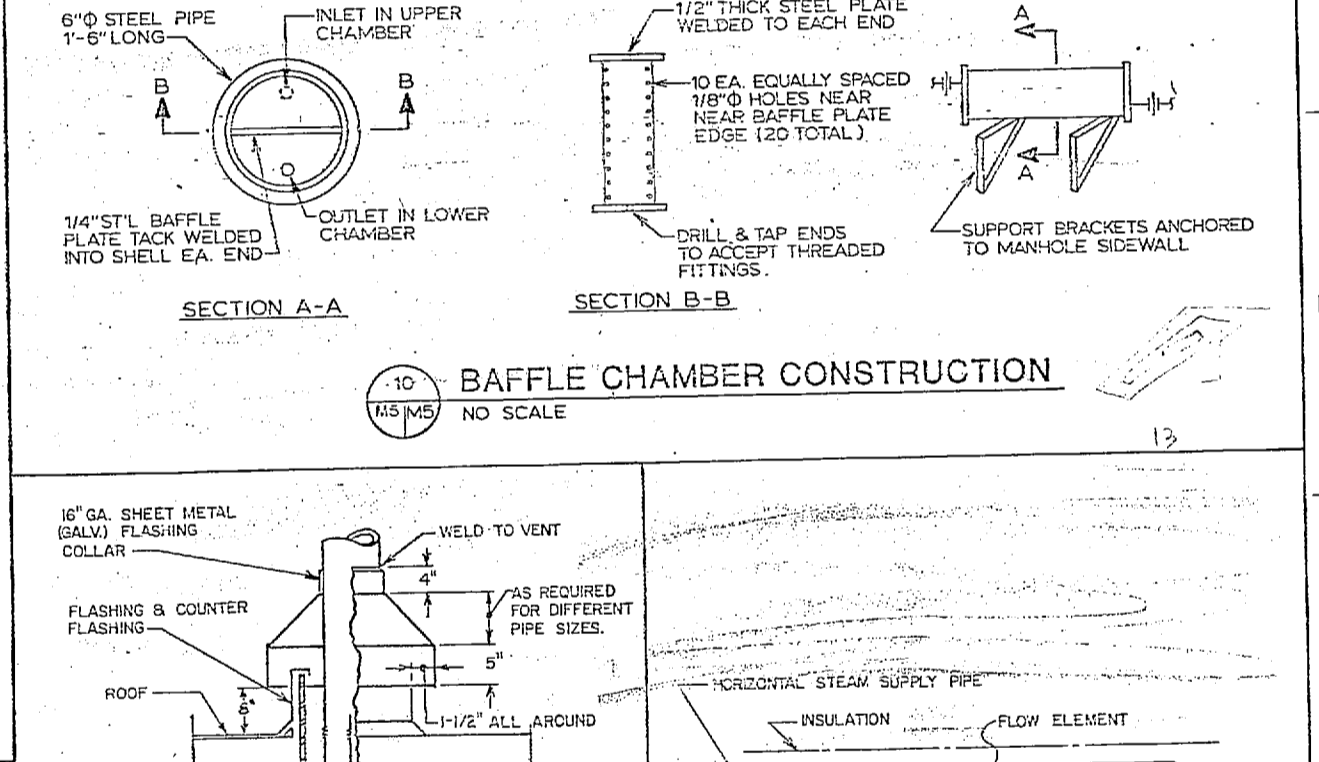


**10 BAFFLE CHAMBER CONSTRUCTION**  
NO SCALE

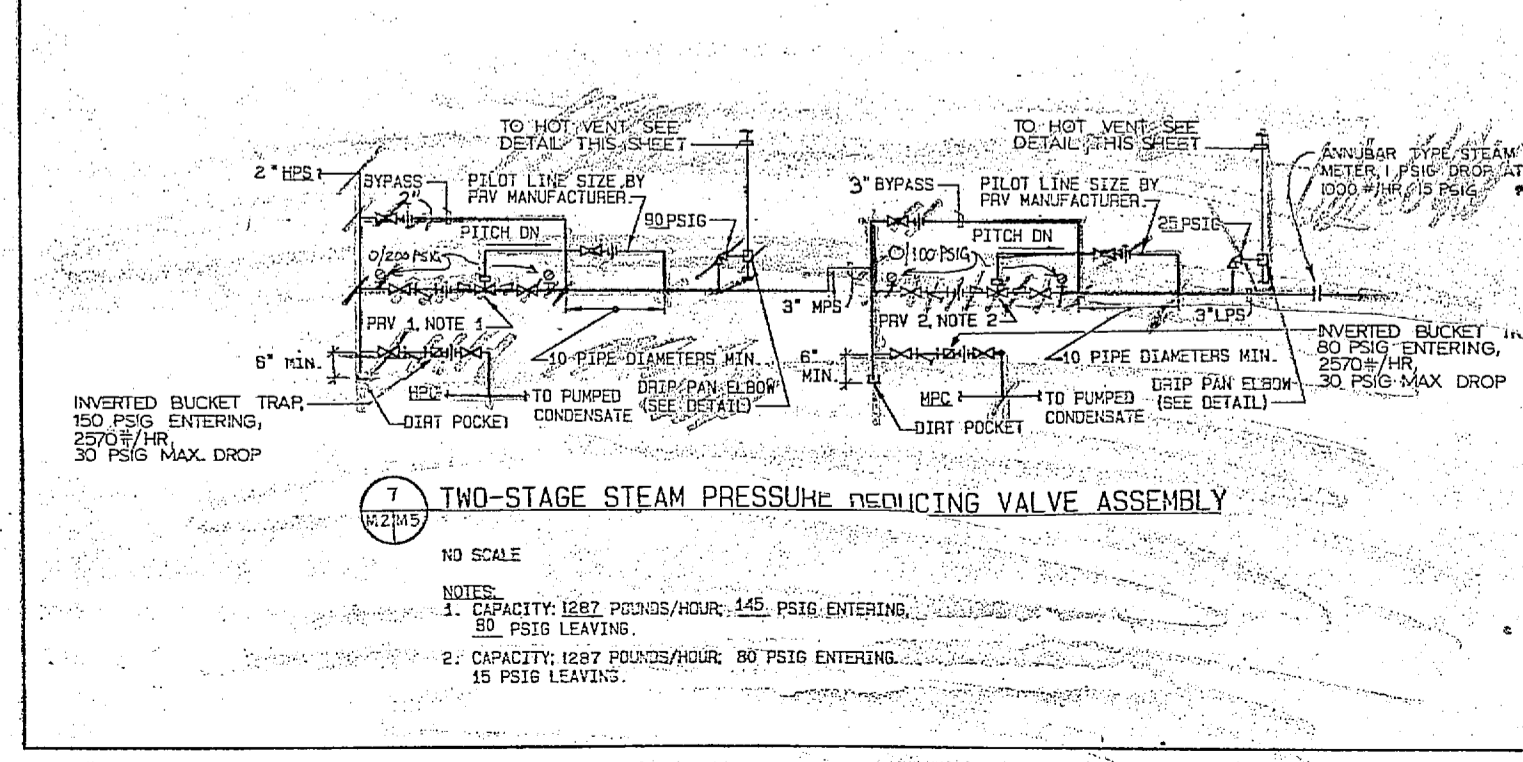


**7 TWO-STAGE STEAM PRESSURE REDUCING VALVE ASSEMBLY**  
NO SCALE


NOTES:  
1. CAPACITY: 1267 POUNDS/HOUR, 145 PSIG ENTERING, 80 PSIG LEAVING.  
2. CAPACITY: 1267 POUNDS/HOUR, 80 PSIG ENTERING, 15 PSIG LEAVING.

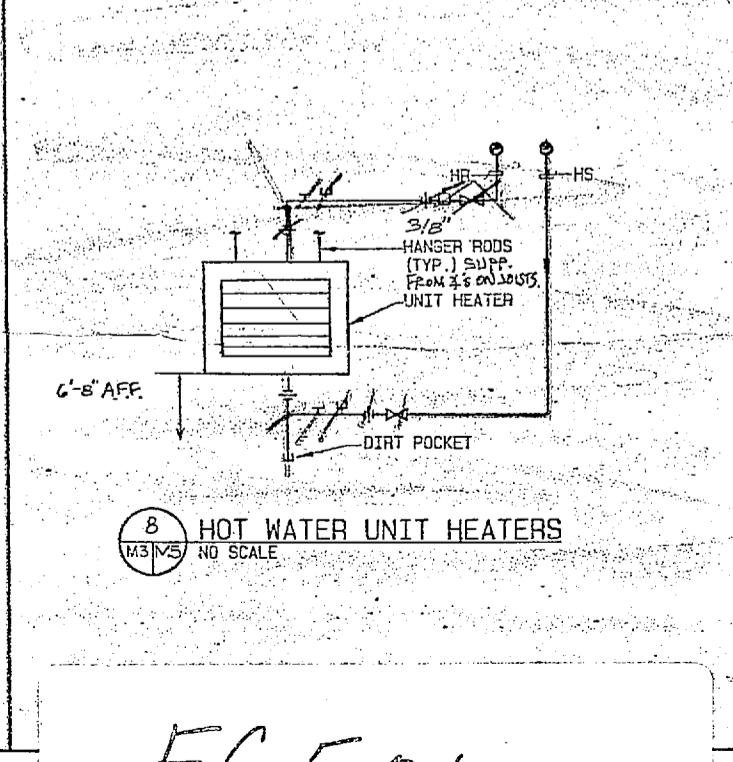

**8 HOT WATER UNIT HEATERS**  
NO SCALE

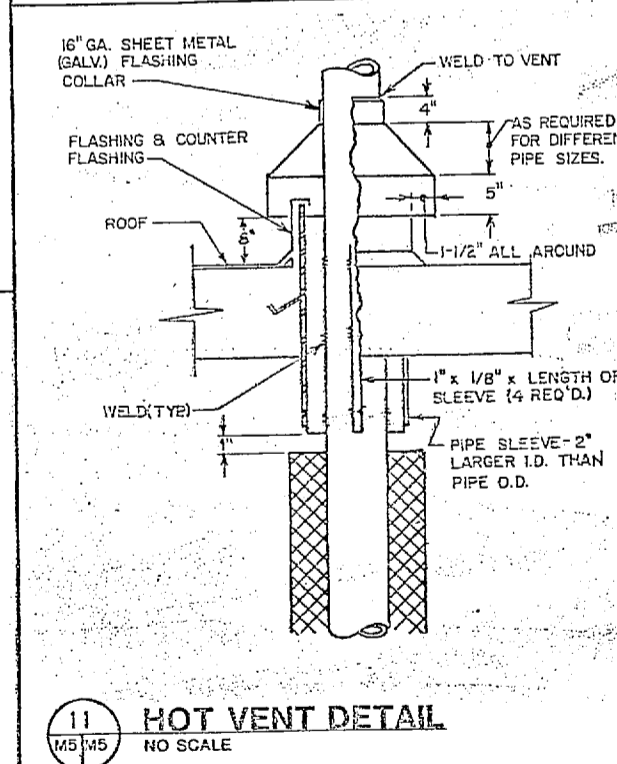

**11 HOT VENT DETAIL**  
NO SCALE

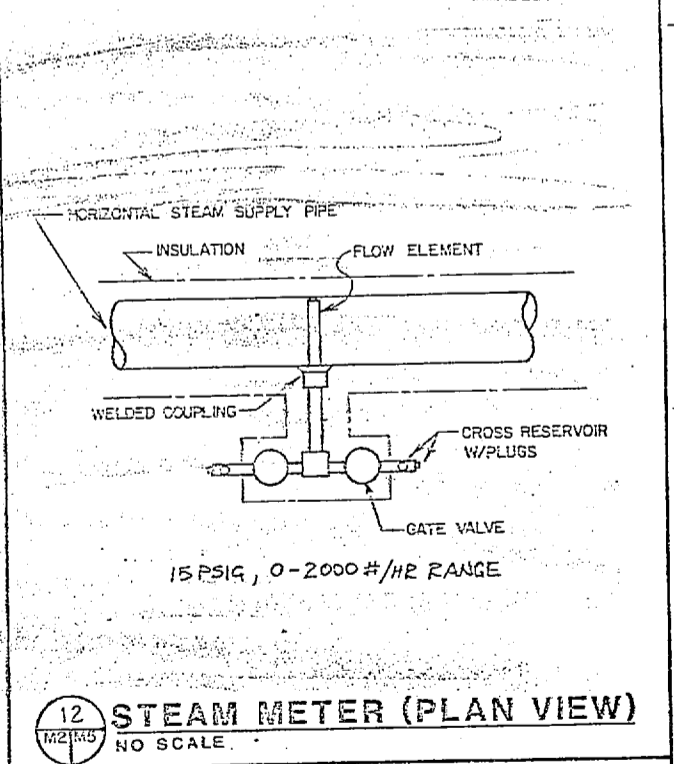


**12 STEAM METER (PLAN VIEW)**  
NO SCALE

REVISIONS		
NO.	DESCRIPTION	DATE

M5

<b>USBP</b>		DEPARTMENT OF THE NAVY	
NAVAL FACILITIES ENGINEERING COMMAND		ATLANTIC DIVISION	
NAVAL STATION		NORFOLK, VA.	
MARINE CORPS BASE		CAMP LEJEUNE, N. C.	
<b>BATTALION HEADQUARTERS</b>			
HVAC DETAILS			
PROJECT NO. 25768B	DATE 01/27/68	SCALE: NONE	SHEET 49 OF 78
JOB ORDER NO. SF5143	DATE 01/27/68		
STA ORDER NO. F-787-100000-03T			
DES. MGR. [Signature]			
PROJ. MGR. I. B. [Signature]			
EFD. MGR. [Signature]			
DR. MGR. [Signature]			
APPROVED DATE [Signature]			
ACTIVITY SATISFACTORY TO [Signature]			

FC500

 

NO.	AREA SERVED (NOTE 1)	TYPE (NOTE 2)	AIR HANDLING UNIT SCHEDULE										NOTES					
			CFM	RPM	TYPE (NOTE 3)	ESP. IN. WG (NOTE 4)	MOTOR HP (NOTE 5)	MIN. DIA. CFM (NOTE 6)	COOLING COIL	VIBRATION ISOLATION								
AHU-1	FC-300 BUILDING	VI-DT	3,940	1275	FC-VV	1.35	5	250	3,940	126.1	105.8	20	DB 83.4	WB 67.5	DB 59.0	WB 57.5	NOTE(9)	1-1/2

- NOTES:
- DESIGN CONDITIONS:
    - SUMMER: 80°F DB, 79°F WB
    - WINTER: 65°F DB, 68°F WB
    - OUTSIDE: 78°F DB, 60°F WB
    - TOILETS (HEAT ONLY): 70°F DB, 60°F WB
    - CLOSETS (VENT. ONLY): 70°F DB, 60°F WB
    - MECH. RMS. (H.V. ONLY): 70°F DB, 60°F WB
  - TYPES:
    - DT: DRAIN-THROUGH
    - BT: BLOW-THROUGH
    - HZ: HORIZONTAL
    - VT: VERTICAL
    - MZ: MULTIZONE
  - FAN TYPES:
    - FC: FORWARD CURVED
    - AF: AIRFOIL
    - CV: CONSTANT VOLUME
    - VV: VARIABLE VOLUME
  - EXTERNAL STATIC PRESSURE DOES NOT INCLUDE UNIT CASING OR UNIT MOUNTED HEATING AND COOLING COILS, BUT DOES INCLUDE FILTERS.
  - MAX. FOR VARIABLE VOLUME UNITS: 550 FPM COIL FACE VELOCITY, .85" WG AFD.
  - CHILLED WATER BASED ON 44°F EAT. AND MAX. 8" WPD.
  - MAX. 0.2" WG. AFD.
  - INLET WARE BY MFR. MINIMUM 185 CFM W/O SURGE.
  - UNHOUSED SPRING TYPE ISOLATOR.
  - 480 V/3Ø MOTOR WITH NEMA SIZE 0 STARTER.

NO.	AREA SERVED	TYPE (NOTE 1)	CFM	STATIC PRESSURE IN. WG	NDMINAL WHEEL DIAMETER, IN.	MAX. RPM	MAX. MOTOR HP	DRIVE (NOTE 2)	VIBRATION ISOLATION			NOTES
									TYPE (NOTE 3)	MINIMUM STATIC DEFLECTION, IN.	VIBRATION BASE	
F-1	FC-300 TOILETS	C	1720	3/8	20	730	1/4	B	YES	0.4	-	4
F-2	FC-300 TOILETS	C	330	3/8	14	320	1/8	D	YES	0.4	-	4
F-3	FC-300 MECH. RM.	C	1400	3/8	20	920	1/8	D	YES	0.4	-	4
F-4	FC-300 TOILETS	C	840	3/8	14	320	1/8	D	YES	0.4	-	4
F-5	FC-300 MECH. RM.	C	350	1/4	14	85	1/4	D	YES	0.4	-	4
F-6 & F-7	FC-300 TOILETS	D	100	1/8	8	120	1/8	D	YES	0.4	-	4
F-8	FC-ELECT. RM.	D	500	1/8	10	110	1/8	D	NO	-	-	4, 6
F-9 & F-10	FC-300 CONF. RMS	B	800	1/4	12	100	1/4	D	YES	0.4	-	4

- NOTES:
- TYPES: A. PROPELLER, B. CABINET, C. POWER ROOF VENTILATOR, D. CEILING MOUNTED W/GRILLE BY FAN MFR.
  - DRIVE: B. BELT, D. DIRECT, 3. RUBBER-IN-SHEAR
  - DISCONNECTS BY FAN MFR.
  - BACKDRAFT DAMPER AT FAN DISCHARGE BY FAN MFR.
  - ALL FANS 120V/1Ø.

NO.	CFM (NOTE 1)	CAPACITY, MBH (NOTE 2)		HEATING (NOTE 3)	GPM	RUNOUT SIZES, IN.	MAX. KW INPUT	VOLTS/Ø
		BASE	TOTAL					
HP-1	1280	33.5	39.4	25.1	7.0	3/4	3.92	480/3
HP-2	960	25.7	33.2	8.9	5.0	3/4	2.85	480/3
HP-3	960	25.7	32.0	8.9	5.0	3/4	2.85	480/3
HP-4	595	10.0	12.4	3.2	2.0	1/2	1.80	277/1
HP-5	595	14.7	18.0	4.5	2.5	1/2	1.80	277/1
HP-6	595	14.5	13.6	3.4	2.0	1/2	1.80	277/1
HP-7	960	26.7	33.0	8.5	5.0	3/4	3.85	480/3
HP-8	960	24.2	23.8	7.6	5.0	3/4	3.25	480/3
HP-9	600	22.0	26.5	6.7	4.0	3/4	2.70	480/3
HP-10	960	29.4	36.1	8.9	6.0	3/4	3.92	480/3
HP-11	1280	33.3	39.7	24.7	7.0	3/4	3.92	480/3
HP-12	1280	31.2	38.6	8.9	2.0	1/2	1.80	277/1
HP-13	1280	31.1	38.4	8.9	2.0	1/2	1.80	277/1
HP-14	1085	29.5	36.5	8.9	7.0	1/4	3.92	480/3
HP-15	1280	28.1	36.0	8.9	6.0	3/4	3.92	480/3
HP-16	580	10.1	20.7	8.1	3.0	1/2	2.00	277/1
HP-17	580	10.1	20.7	8.1	3.0	1/2	2.00	277/1
HP-18	960	14.1	25.8	8.6	4.0	1/2	2.70	480/3
HP-19	580	10.1	20.7	8.1	3.0	1/2	2.00	277/1
HP-20	1300	38.1	45.5	20.0	8.0	1-1/4	6.12	480/3
HP-21	1085	31.1	38.0	47.0	8.0	1-1/4	6.12	480/3
HP-22	1280	39.4	43.3	14.9	8.0	1-1/4	6.12	480/3
HP-23	1085	30.5	37.2	9.8	6.0	3/4	3.92	480/3
HP-24	1280	39.4	43.3	12.2	8.0	1-1/4	6.12	480/3
HP-25	1085	28.7	23.0	5.8	4.0	1/2	2.70	480/3
HP-26	1280	31.1	32.7	24.8	5.0	3/4	2.70	480/3
HP-27	1260	31.1	42.4	23.3	7.0	3/4	3.92	480/3
HP-28	3070	60.5	83.1	48.2	14.0	1-1/4	7.84	480/3

- NOTES:
- EXTERNAL STATIC PRESSURE IS 0.4" WG.
  - COOLING CAPACITY BASED ON 80°F DB F W 67°F WB EAT, 90° EWT; HEATING CAPACITY BASED ON 65°F DB EAT, 65°F EWT, EXCEPT FOR O.A. MAKE-UP UNITS.
  - MAX. 12" WPD, INCLUDING HOSE KITS.
  - O.A. MAKE-UP UNITS COOLING CAPACITY BASED ON 82°F I AND 70°F W W EAT, 90° EWT; HEATING CAPACITY BASED ON 55°F EAT, 65° EWT.
  - ALL UNITS SHALL BE HUNG WITH RUBBER-IN SHEAR VIBRATION ISOLATORS.
  - CONDENSER COIL FOULING FACTOR .0005 ON ALL UNITS.

CONDENSATE RETURN UNIT SCHEDULE					
NO.	TYPE (NOTE 1)	RECEIVER CAP. GAL.	DISCHARGE PRESSURE PSIG	GPM (NOTE 2)	MOTOR HP (NOTE 3)
CU-1	V-C	8	62	3	3

- NOTES:
- TYPES: V VERTICAL DUXLEX, C CAST IRON RECEIVER
  - GPM AND MOTOR HP IS FOR EACH PUMP.
  - 480V, 3Ø, 3500 RPM

NO.	AREA SERVED	TYPE (NOTE 1)	CAPACITY, MBH/KW (NOTE 2)	NDMINAL CFM	FLOW	PIPE RUNOUT SIZES, IN.	CONTROL VALVE	NOTES
UH-1, 2, 3&4	FC-300 ENTRANCES	CR	2.50 KW	300	-	-	-	ELECT.
UH-5&8	FC-300 ENTRANCES	H-CR	19.0 MBH	300	10.2 LB/HR	3/4" LFC 3/4" LPS	CV-4	STEAM
UH-7	FC-300 MECH. RM.	H	20.0 MBH	300	10.7 LB/HR	3/4" LFC 3/4" LPS	CV-6	STEAM
UH-8	FC-300 MECH. RM.	H	20.0 MBH	300	12 GPM	3/4" HR 3/4" HR	-	HOT WTR.
UH-9&10	FC-300 TOILETS	H	1.50 KW	200	-	-	-	ELECT.

- NOTES:
- TYPES: C CABINET WITH DUCT CONNECTION, H HORIZONTAL, CR CABINET RECESSED, CS CABINET SURFACE MOUNTED, H HALL, V VERTICAL
  - MBH GIVEN FOR HOT WATER & STEAM UNITS, KW FOR ELECTRIC BASED ON 60°F EAT.
  - ALL ELECTRIC UNIT HEATERS SHALL BE 277V/1Ø, ALL STEAM AND HOT WATER UNIT HEATERS SHALL BE 120V/1Ø.
  - HOT WATER UNITS BASED ON 180° EWT.

COOLING TOWER SCHEDULE								
NO.	EAT °F	LWT °F	GPM	MAX. MOTOR HP	VIBRATION ISOLATION	TYPE	MIN. STATIC DEFLECTION, IN.	NOTES
CT-1	100	85	167	5	NONE	-	-	1, 2, 3

- NOTES:
- ENTERING AIR WET BULB: 79°F.
  - ELECTRIC BASIN HEATERS: 5 KW/480V, 3-PHASE.
  - SIZE 0, COMBINATION STARTER.

AIR-COOLED CHILDER SCHEDULE							
NO.	CAPACITY, TONS (NOTE 1&2)	MAX. KW AT FULL LOAD	EVAPORATOR				NOTES
			EAT °F	LWT °F	GPM	MAX. PRESS. DROP, FT. WG	
CH-1	10	18.6	85	24	20	10	-

- NOTES:
- CAPACITY BASED ON 85°F AMBIENT TEMPERATURE, .0005 FOULING FACTOR.
  - PROVIDE LOW AMBIENT OPERATION DOWN TO 35°F.
  - INTEGRAL STARTER BY MFR.
  - MINIMUM OF 2 STAGES OPERATION.

AIR DISTRIBUTION SCHEDULE			
MARK	TYPE	DESCRIPTION	NOTES
G-1	CEILING DIFFUSER	24x24 LAY-IN COE FACE	4WAY THROW
E-1	EXHAUST REGISTER	SIZE AS SHOWN ON DRAWINGS	-

FC 500

REVISIONS			
NO.	DATE	BY	DESCRIPTION

CONVERTOR SCHEDULE													
NO.	WATER SYSTEM	MIN. SURFACE AREA, FTR	TYPE (NOTE 1)	SHELL			TUBES				NOTES		
				MEDIUM	LB/HR	PSIG	CONTROL VALVE	MEDIUM	GPM	ΔP, MAX		TEMP. °F	
CV-1	FC-300 TEMP. WTR.	10	U	STEAM	1049	7	5.2	WATER	153	1.4'	52.7	85	(2)(3)
CV-2	FC-300 ADDITION	4	U	STEAM	193	7	5.2	WATER	14.0	2.2'	197	180	(2)(3)

- NOTES:
- TYPES: U U-TUBE
  - .0005 FOULING FACTOR
  - CONTROL VALVES SIZED FOR 8 PSIG DROP.

PUMP SCHEDULE											
NO.	SERVICE	TYPE (NOTE 1)	GPM	TOTAL DYNAMIC HEAD, FT. WG	MINIMUM EFFICIENCY, PERCENT	MOTOR HP	VIBRATION ISOLATION		VOLTS/Ø	NEMA STARTER SIZE	
							MINIMUM STATIC DEFLECTION, IN.	INERTIA BASE			
P-1	(NOT USED)	-	-	-	-	-	-	-	-	-	
P-2	TEMPERED WATER	E	153	80	70	5	NOTE 2	1 1/2	YES	480/3	D
P-3	STEAM PUMP	E	25	22	N/A	1/8	NONE	-	-	115/1	NONE
P-4	COOLING TOWER	E	167	67	70	5	NOTE 2	1 1/2	YES	480/3	O
P-5	CHILLED WATER	T	20	50	35	1	NOTE 3	0.4	NO	480/3	O O
P-6	HOT WATER	T	14	50	55	3/4	NOTE 3	0.4	NO	480/3	O O

- NOTES:
- S SUBMERSIBLE PUMP PUMP
  1. TYPES: D DOUBLE SUCTION, E END SUCTION, BASE MTD. I) I INLINE, V VERTICAL TURBINE
  - UNHOUSED SPRING TYPE ISOLATOR
  - SPRING TYPE HANGER ISOLATOR
  - ALL PIPING WITHIN 25' OF PUMP-SUPPLIED EQUIP. SHALL BE HUNG WITH SPRING ISOLATOR HANGERS.

TERMINAL UNIT SCHEDULE									
NO.	TYPE (NOTE 1)	PRIMARY CFM		FAN	HOT WATER HEATING COIL	NOTES			
		MAX.	MIN.						
T-1	FP-S	930	245	1000	1/3   120/1	39.4   3.4   65.8   3.4			
T-2	FP-S	1000	250	1200	1/3   120/1	39.4   3.4   65.8   3.4			
T-3	FP-S	910	230	1000	1/3   120/1	39.4   3.4   65.8   3.4			
T-4	FP-S	1250	315	1400	1/3   120/1	39.4   1.8   65.8   3.4			

- NOTES:
- TYPES: FP-S FAN POWERED, SERIES, CV CONSTANT VOLUME, R REHEAT, T TRACKING
  - 10" ROUND OR OVAL INLET, 0.3" EXT. S.P. 0.5" MAX. INLET S.P. REQ'D., PRIMARY AIR VALVE NORMALLY CLOSED, MAXIMUM DEPTH OF UNIT 18"
  - RUBBER-IN-SHEAR HANGER ISOLATOR.
  - CAPACITY BASED ON 85°F EAT FOR VV-R AND CV-R UNITS, AND 60°F EAT AND 180°F WWT FOR FP-S AND FP-P UNITS.

PLATE HEAT EXCHANGER SCHEDULE											
NO.	SERVICE	CAPACITY, MBH	COOLING TOWER				TEMPERED WATER				NOTES
			EAT °F	LWT °F	MAX. ΔP, FT. WG	GPM	EAT °F	LWT °F	MAX. ΔP, FT. WG	GPM	
HX-1	FC-300	1255	167	100	85	200	153	105.4	90	20.0	(1)

- NOTES: 1. SIZE EXCHANGER BASED ON .0005 FOULING FACTOR.

STEAM PRESSURE REDUCING VALVE ASSEMBLY SCHEDULE					
NO.	LOCATION	STEAM PRESSURE (PSIG)		RELIEF VALVE	
		ENTERING	LEAVING	LBS/HR	PSIG
PRV-1	FC-300/MECH RM	100 TO 149	80	1287	1608
PRV-2	FC-300/MECH RM	80	15	1287	1608

- NOTES:

**U.S. NAVAL FACILITIES ENGINEERING COMMAND**

**ATLANTIC DIVISION**

NAVAL STATION NORFOLK, VA.

MARINE CORPS BASE CAMP LEJEUNE, N. C.

BATTALION HEADQUARTERS


---


HYAC SCHEDULES

APPROVED: \_\_\_\_\_ DATE: \_\_\_\_\_


ACTIVITY SATISFACTORY TO: \_\_\_\_\_ DATE: \_\_\_\_\_

SCALE: NONE SPEC: 05-85-5143

 


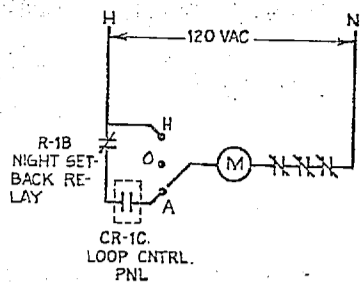


1 FANS F-1, F-2, F-6, F-7, F-8, F-9

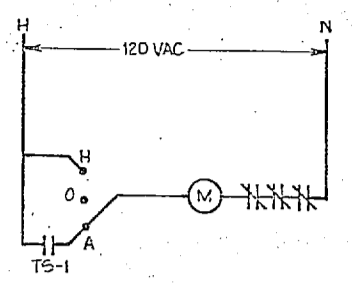


2 FAN F-3

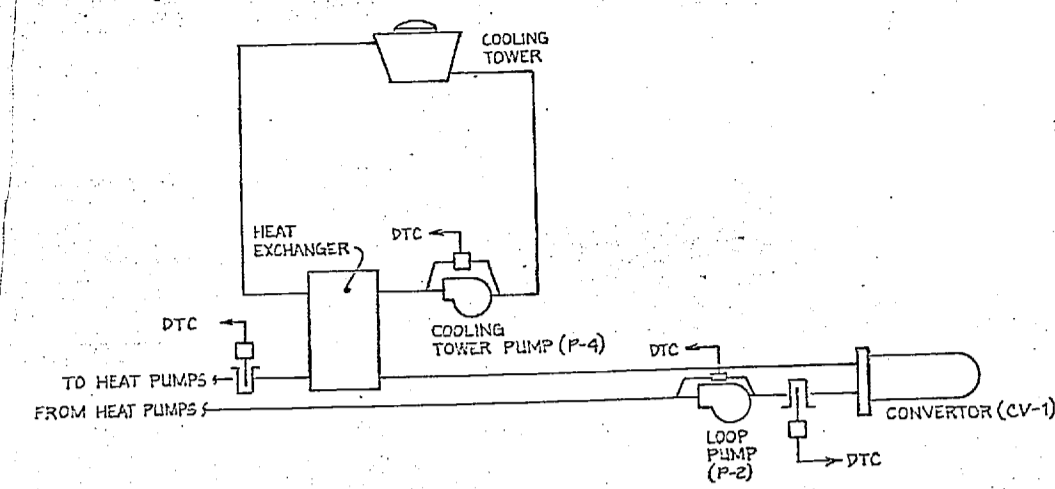


3 TEMPERED WATER LOOP

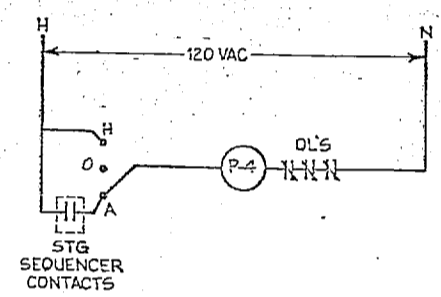


4 COOLING TOWER PUMPS

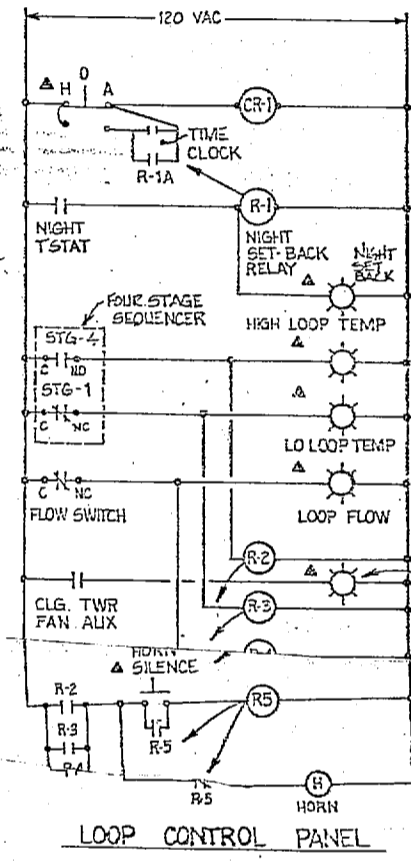


LOOP CONTROL PANEL

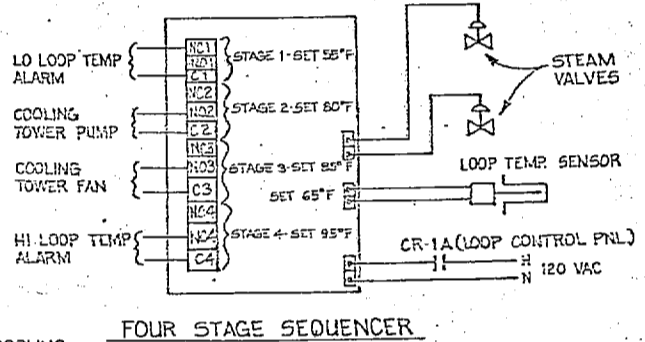

FOUR STAGE SEQUENCER

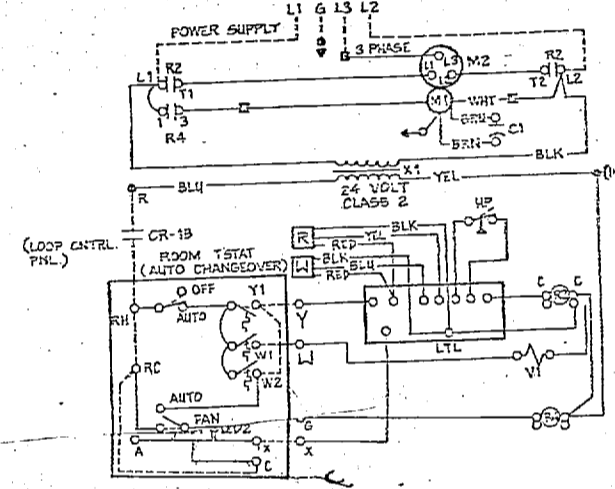


HEAT PUMP CONTROL

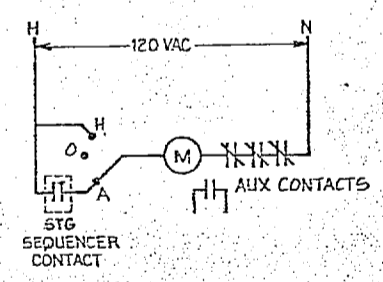

5 COOLING TOWER FAN

6 TEMPERED WATER SYSTEM

NOTE: NTS INDICATES PANEL MOUNTED DEVICES

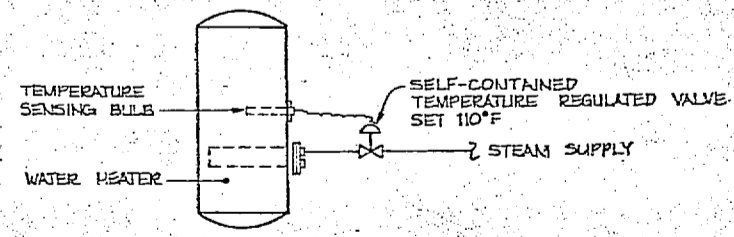

7 DOMESTIC HOT WATER CONTROL

FC 500

NO.	DESCRIPTION	REV.	DATE

CONTROL SEQUENCES (FC-500)

- I. The Controls for the Tempered Water System (serving the FC-500 Building) shall function as follows:
  - A. The system controls, the individual heat pump thermostats, and the tempered water loop pump P-2 shall be energized when the control panel is energized by the timeclock or by overrides.
  - B. A night setback thermostat shall override the timeclock "Off" position on a fall to set point. Outside air dampers at make-up air heat pumps HP-13, HP-27, and HP-28 shall remain closed and relief exhaust fans shall remain off in this mode.
  - C. The B-O-A switch mounted on the control panel shall override the timeclock in the "Stand" or "Off" position.
  - D. The pumps, valves, and cooling tower fan shall operate as scheduled below to maintain loop temperature between 65°F and 50°F inclusive. All functions shall be controlled by one temperature sensor.
 

Loop Temperature	Action
95°	High Temperature Alarm
85°	C.T. Fan On
80°	C.T. Fan Off - C.T. Pump On (P-4)
75°	C.T. Pump Off (P-4)
65°	Converter Steam Control Valve Modulates Open
55°	Low Temperature Alarm
  - E. The cooling tower chemical treatment system shall be energized when Pump P-4 is in operation.
  - F. The following shall be mounted on the control panel face unless noted otherwise:
    1. Tempered water supply thermometer.
    2. Tempered water return thermometer.
    3. High loop temperature alarm light.
    4. Low loop temperature alarm light.
    5. Cooling tower fan status light.
    6. Loop flow alarm light.
    7. Audible alarm for all alarms.
    8. Alarm silence switch.
    9. Night setback override mode light.
    10. Hand-Off-Automatic switch.
    11. Override timer.
    12. Timeclock (inside panel).
- II. The Controls for Converter CV-1 (serving FC-500 Tempered Water Loop) shall function as follows:
  - A. Activation of the Tempered Water System shall activate converter controls. When the Tempered Water System is off, the controls shall be deactivated and the steam valves shall close.
  - B. Modulate the two steam valves (1/3, 2/3 capacity) in sequence to maintain converter hot water leaving temperature set point.
- III. The Controls for Unit Heaters UH-5, UH-6, and UH-7 (serving the FC-500 Building) shall each function as follows:
  - A. Steam valve in sequence to maintain space temperature.
- IV. The Controls for Unit Heaters UH-1, UH-2, UH-3, UH-4, UH-9, and UH-10 shall each function as follows:
  - A. An integral thermostat shall cycle the unit heater fan and heating coil to maintain space temperature.
- V. The Controls for Fans F-1, F-2, F-6, and F-7 (serving the toilets in FC-500) shall function as follows:
  - A. The fans shall be automatically started with the Tempered Water System but shall remain off when the system is in the High Set-back Mode.
- VI. The Controls for Fan F-3 (serving the FC-500 Mechanical Room) shall operate as follows:
  - A. The fan shall be controlled by a room thermostat to maintain temperature set point.
- VII. The Controls for the domestic water heater shall function as follows:
  - A. The steam control valve shall modulate to maintain domestic hot water temperature setpoint.


GRAPHIC SCALE


USP DEPARTMENT OF THE NAVY NAVAL FACILITIES ENGINEERING COMMAND ATLANTIC DIVISION NAVAL STATION NORFOLK, VA. MARINE CORPS BASE CAMP LEJEUNE, N. C. BATTALION HEADQUARTERS FC-500 CONTROLS

DESIGNED BY: [Signature] DATE: [Date] CHECKED BY: [Signature] DATE: [Date]

ACTIVITY: SATISFACTORY TO [Signature] DATE: [Date]





SCALE: NONE SPEC: 05-85-5143 SHEET: 51 OF 76

 

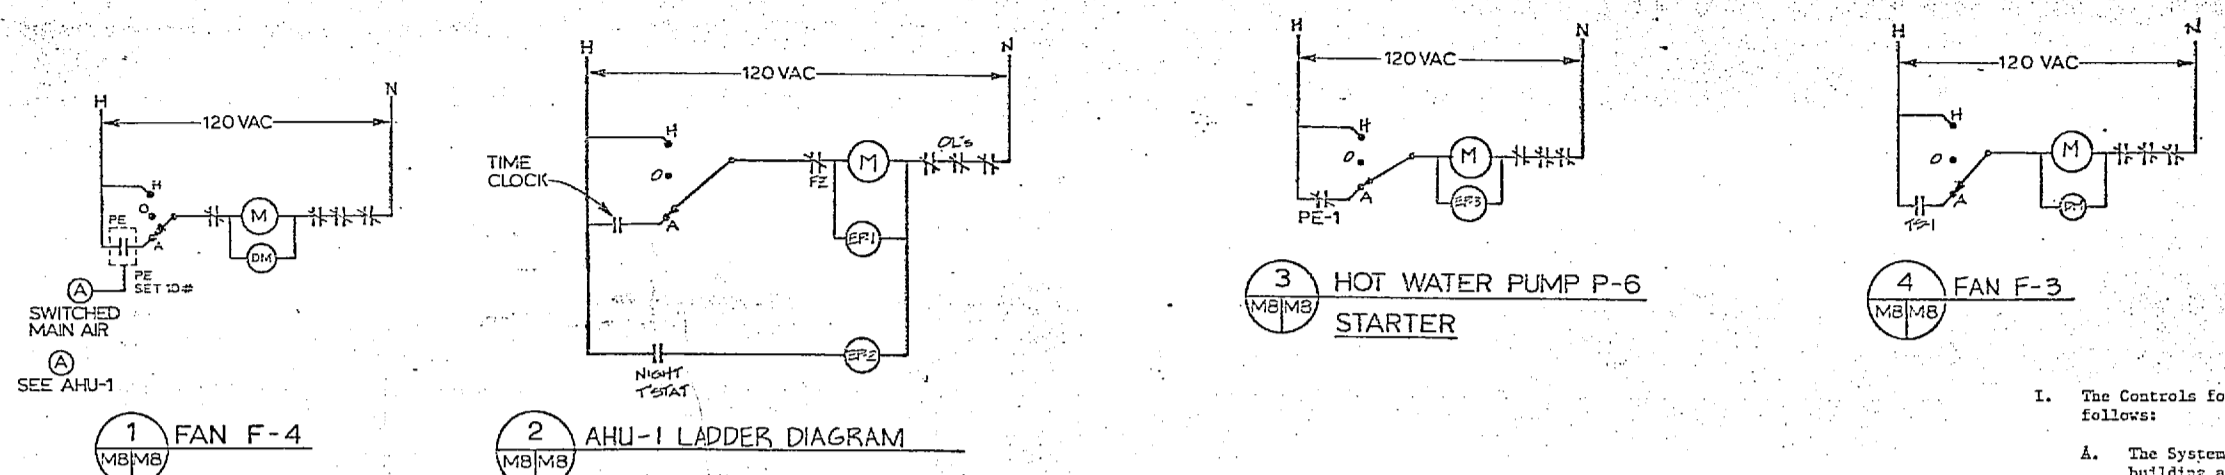


CONTROL SEQUENCES (FC-300)

- I. The Controls for AHU-1 (serving the FC-300 addition) shall function as follows:
  - A. The System shall be automatically started and stopped by the building automation system whenever the Hand-off-Automatic Switch is in the Automatic position, and manually started and stopped by the Hand position.
  - B. Controls shall be energized, and the minimum outside air, and return dampers shall open prior to fan starting. The relief and maximum outside air dampers shall remain closed. Terminal or Blenders shall be energized.
  - C. Modulate the three-way chilled water valve to maintain system discharge air temperature set point.
  - D. Initiate Economizer Mode operation on a drop in outside air dry bulb temperature below set point.
  - E. With the unit operating in the Economizer Mode, modulate the return, relief and maximum outside air dampers to maintain discharge air temperature set point. The return air damper shall modulate closed simultaneously as the relief and maximum outside air dampers modulate open. If the maximum outside air damper is fully open and the discharge air temperature set point still is not satisfied, the chilled water valve shall be modulated open to satisfy demand. A low limit control with averaging element sensing air entering the coils, overriding all other damper controls, shall modulate the maximum outside air and return dampers to limit mixed air temperature to 45°F adjustable minimum.
  - F. A separate low limit thermostat with element sensing the coldest portion of air entering the cooling coil, set at 40°F adjustable, shall stop the fan.
- II. Controls for the Chilled Water System (serving the FC-300 addition) shall function as follows:
  - A. The chilled water pump P-5 shall be activated by the timeclock.
  - B. The chiller's internal controls shall be activated, and the capacity controller shall be reset by a remote bulb thermostat sensing chilled water return. The compressors shall start unloaded.
  - C. The chiller shall have the following fail safe controls:
    1. A pressure differential controller shall stop the compressor in case of inadequate water flow through the cooler (low pressure differential across cooler).
    2. A manually reset pressure switch shall stop the compressor in case of low oil pressure.
    3. A manually reset pressure switch shall stop the compressor in case of high condenser pressure.
    4. A manually reset temperature switch shall stop the compressor in case of low refrigerant temperature.
    5. A thermostat with element in cooler discharge shall stop the compressor in case of low chilled water temperature.
  - D. All chiller controls provided and/or installed under this Section shall be approved by the chiller manufacturer.
- III. The Controls for Fan F-4 (serving FC-300 toilets) shall function as follows:
  - A. The fan shall be interlocked to operate with AHU-1, except when the system is in the Night Set-back or Warm-up Modes.
- IV. The Controls for Converter CV-2 (serving FC-300 Addition) shall function as follows:
  - A. Activation of Hot Water Pump P-6 shall activate converter controls. When the pump is off, the controls shall be deactivated and the steam valve shall close.
- V. The Controls for Unit Heater UH-6 (serving the FC-300 Mechanical Room) shall function as follows:
  - A. An integral thermostat shall cycle the unit heater fan to maintain space temperature.
- VI. The Controls for Fan F-5 (serving the FC-300 Mechanical Room) shall function as follows:
  - A. The fan shall be controlled by a room thermostat to maintain temperature setpoint.
- VII. The Controls for hot water pump P-5 shall operate as follows:
  - A. The pump shall run when the outside air is at or below 65°F (adjustable).
- VIII. Terminal units:
  1. Fan powered, series type - the fan shall be interlocked with the system. Each room thermostat cooling output shall, on a drop in temperature, modulate the primary air valve to the minimum position. Once the primary air valve is at minimum flow, the room thermostat heating output shall modulate the three-way hot water valve to maintain space temperature.
  2. A drop in space temperature below night setback set point shall override the supply fan interlock and allow the fan powered terminal units to run. The units shall operate under normal control during this mode. Outside air and relief dampers shall remain closed.
  3. On morning warm-up mode, the minimum and maximum outside air and relief dampers and chilled water valve shall be closed, all terminal units shall be fully open until return air temperature rises above a warm-up mode set point.

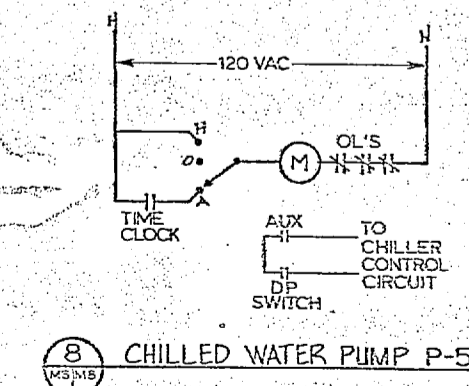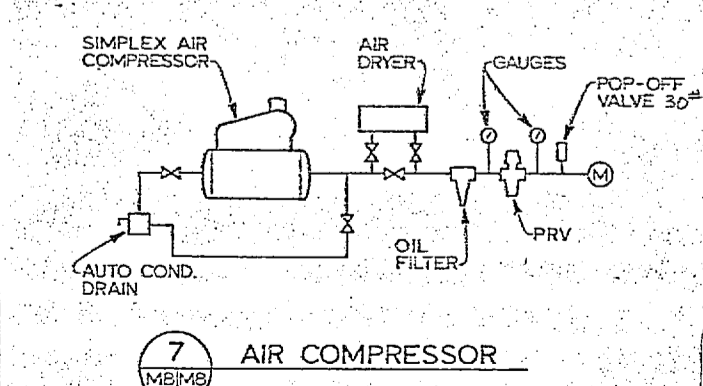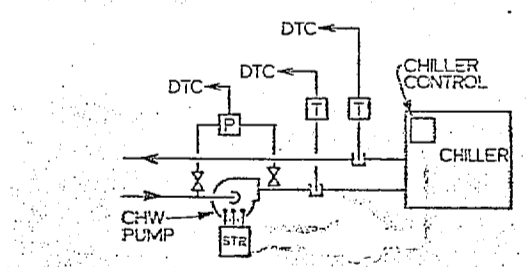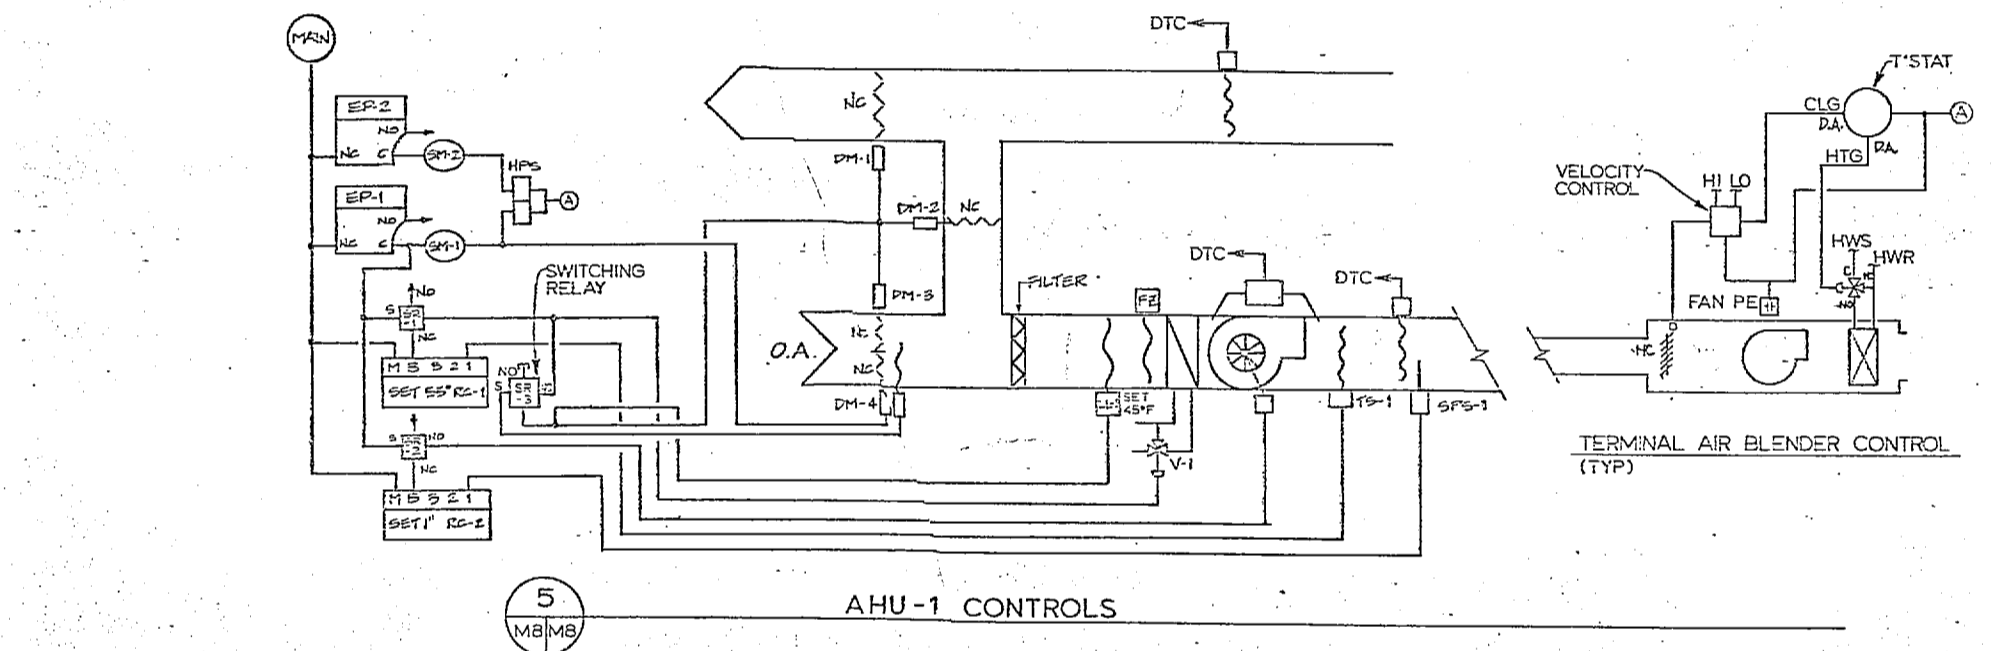

HW RESET SCHEDULE

O.A. (FDB)	HWS (°F)
23°F	180°F
60°F	90°F
65°F	VALV CLOSED

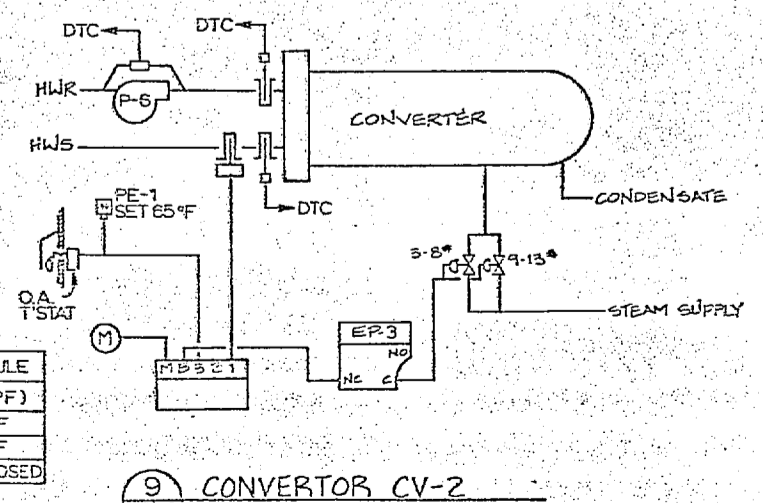


GRAPHIC SCALE




		DEPARTMENT OF THE NAVY NAVAL FACILITIES ENGINEERING COMMAND ATLANTIC DIVISION	
DTG DWG NO 257631 JOB ORDER NO 5F5143 STA PROJ NO F515-MCGRIP-031 DES 031	NAVAL STATION MARINE CORPS BASE BATTALION HEADQUARTERS	NORFOLK, VA. CAMP LEJEUNE, N. C.	FC-300 HVAC CONTROLS
PROJ NO 18 PROJ TITLE ON MODIFICATION VBP REV NO 1 DATE 11/20/78	APPROVED DATE ACTIVITY-SATISFACTORY TO DATE	SHEET NO F 800SI NONE	NAVY DRAWING NO 4157E91 DRAWING CODE NO N62470-85-B-5143 SHEET 52 OF 78


FC 500

 




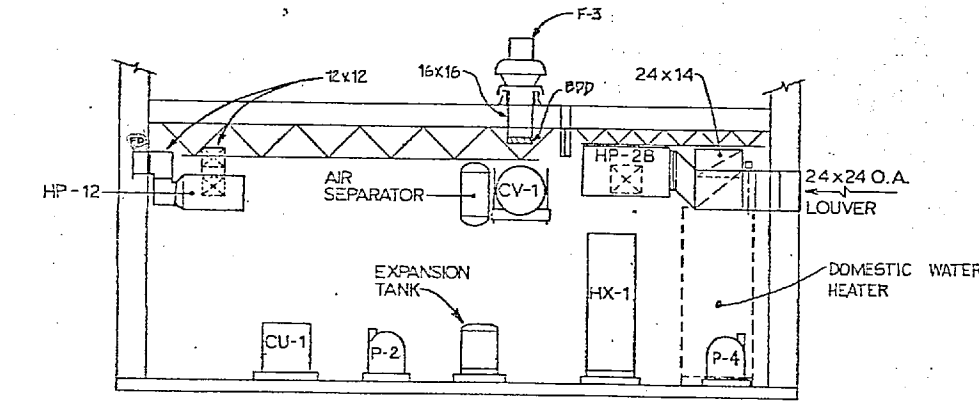

1 SECTION THROUGH BLDG. FC-500 MECH. ROOM  
SCALE: 1/4" = 1'-0"

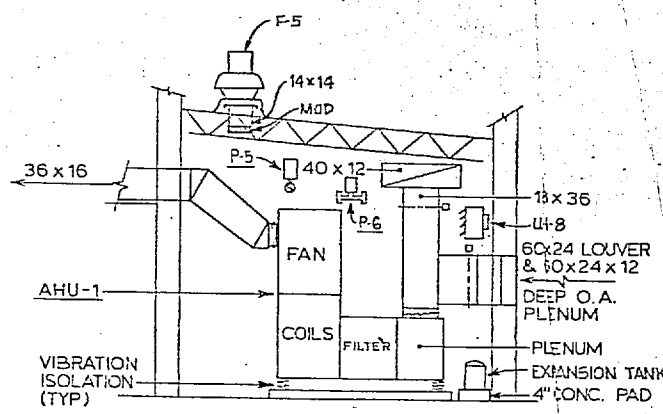


2 SECTION THROUGH BLDG. FC-300 ADDITION MECH. ROOM  
SCALE: 1/4" = 1'-0"

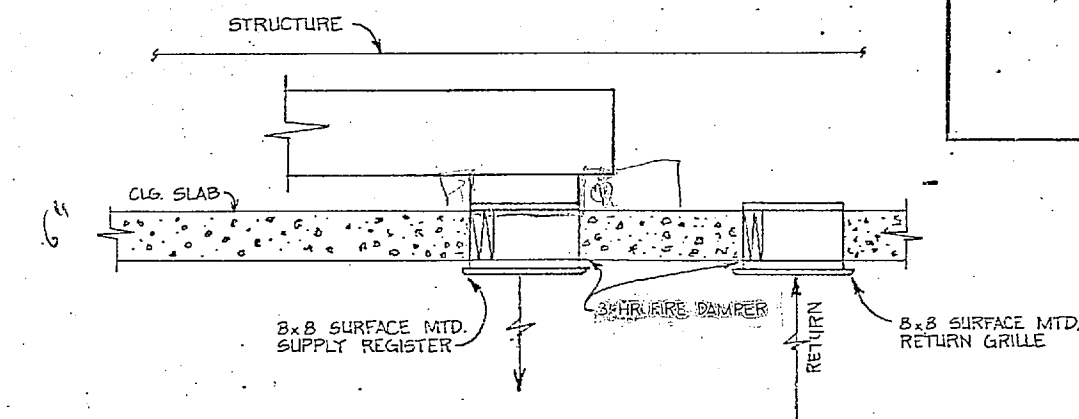


3 SUPPLY AIR & RETURN AIR PENETRATIONS AT CEILINGS IN ROOMS 104, 301, 419, & 210  
NO SCALE

INPUT/OUTPUT SUMMARIES	OUTPUTS		INPUTS	
	DIGITAL	ANALOG	DIGITAL	ANALOG
FC-300				
AHU-1				
SUPPLY FAN STATUS				
DISCHARGE AIR TEMPERATURE				
RETURN AIR TEMPERATURE				
CONVERTER CV-2				
HOT WATER PUMP P-6 STATUS				
HOT WATER SUPPLY TEMP.				
HOT WATER RETURN TEMP.				
CHILLED WATER SUPPLY TEMP.				
CHILLED WATER RETURN TEMP.				
CHILLER				
CHILLED WATER PUMP STATUS				
CHILLED WATER SUPPLY TEMP.				
CHILLED WATER RETURN TEMP.				


4 FC-300 I/O SUMMARIES

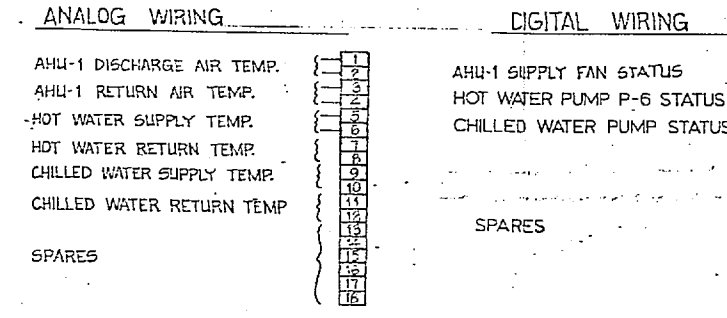

5 FC-300 DTC WIRING  
NO SCALE

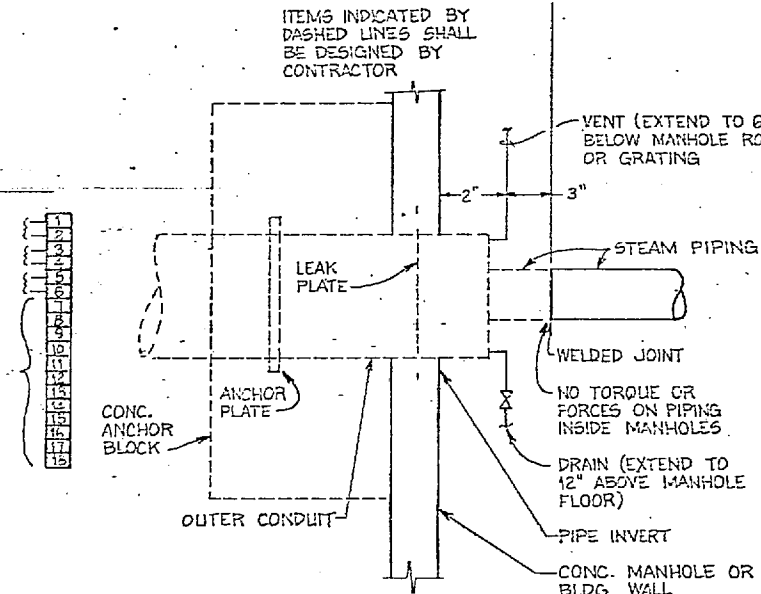


8 STEAM PIPE WALL PENETRATION  
NO SCALE

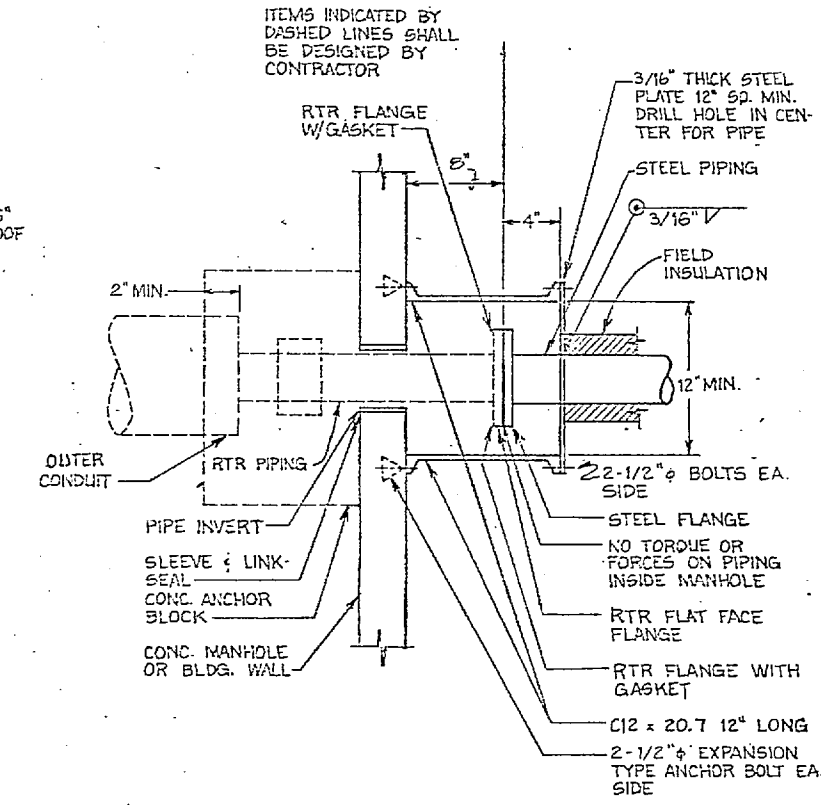


9 CONDENSATE PIPE WALL PENETRATION  
NO SCALE

INPUT/OUTPUT SUMMARIES	OUTPUTS		INPUTS	
	DIGITAL	ANALOG	DIGITAL	ANALOG
FC-500				
TEMPERED WATER LOOP				
LOOP PUMP STATUS				
TOWER PUMP STATUS				
LOOP SUPPLY WATER TEMP.				
LOOP RETURN WATER TEMP.				


6 FC-500 I/O SUMMARIES

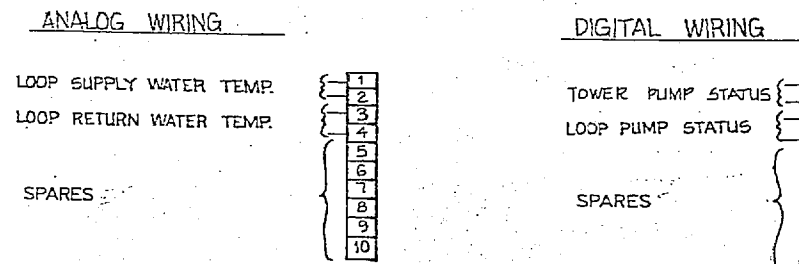


7 FC-500 DTC WIRING  
NO SCALE

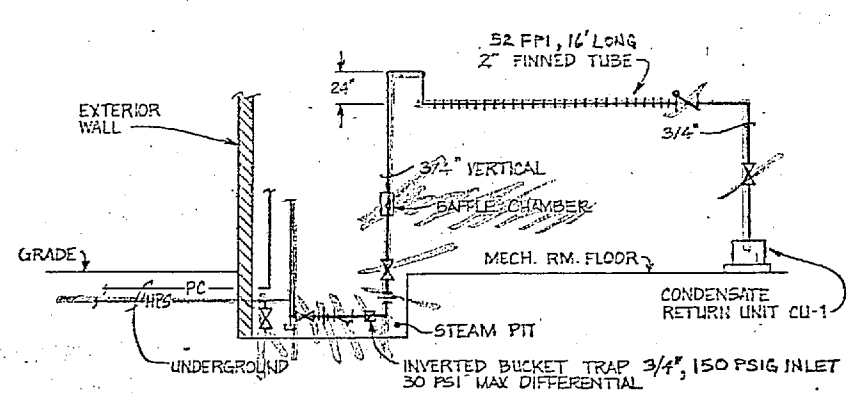

10 BLDG. FC-500 MECH. ROOM STEAM PIT PIPING  
NO SCALE

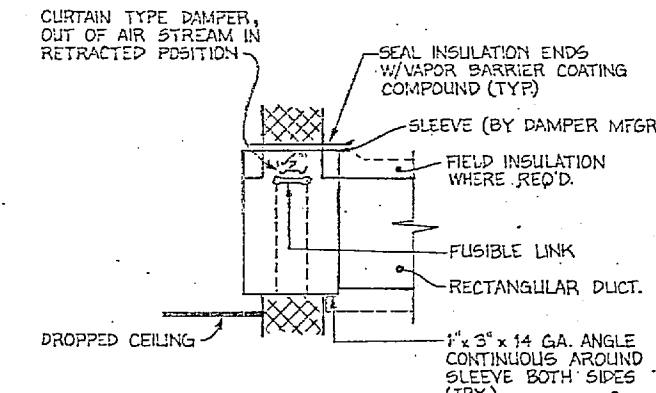

11 FIRE DAMPER IN WALL  
NO SCALE

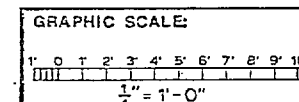

<b>M 9</b>	
DEPARTMENT OF THE NAVY NAVAL FACILITIES ENGINEERING COMMAND ATLANTIC DIVISION	
NAVAL STATION	NORFOLK, VA.
MARINE CORPS BASE	CAMP LEJEUNE, N. C.
<b>BATTALION HEADQUARTERS</b>	
HVAC DETAILS & EMCS	
APPROVED	DATE
ACTIVITY SATISFACTORY TO	DATE
SIZE	CODE CONT NO.
F 80091	4157692
CONTRACT NO.	NSA 470-B-5-5143
SCALE	DESIGNER
CS-85-5143	DESIGNER

FC 500

BATTALION HQ'S  
BLDG'S FC 300 / FC 300

TRANE  
Force Flo Heater  
RE 46E003  
3884 80858  
FUSE  
277VAC

TRANSFORMER  
277 Pri  
120V Sec  
100VA

