REVISIONS			
SYM.	DESCRIPTION	DATE	APPROVED

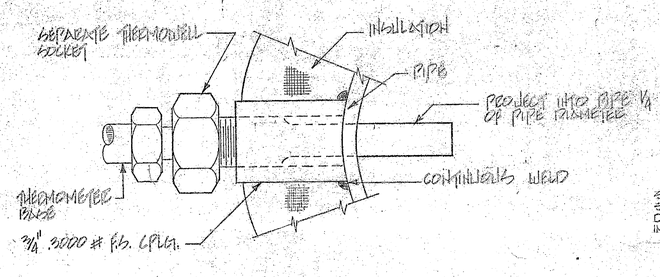

TYPICAL THERMOMETER INSTALLATION IN PIPE
SCALE: NONE

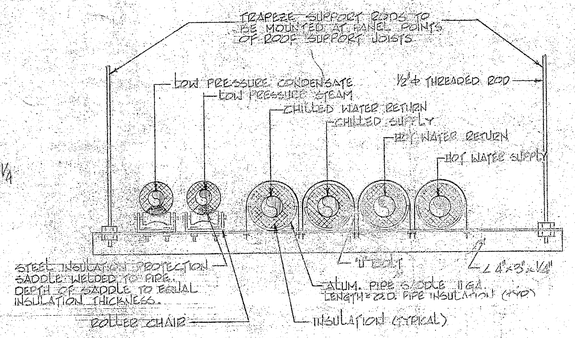

TYPICAL TRAPEZE PIPE SUPPORT DETAIL
SCALE: NONE

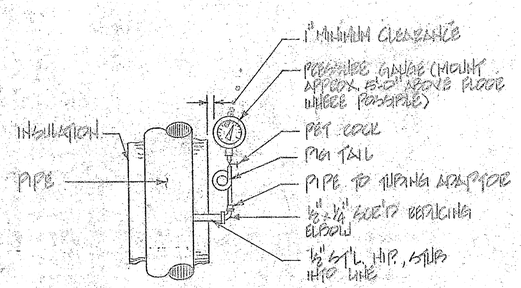

PRESSURE GAUGE DETAIL
SCALE: NONE

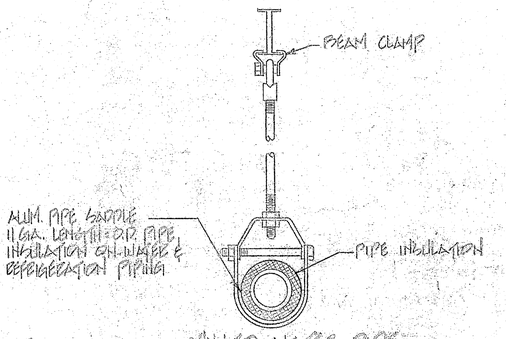

CHILLED WATER PIPE HANGER DETAIL
SCALE: NONE

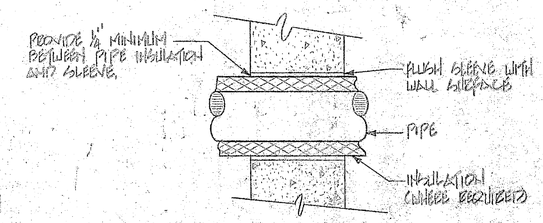

TYPICAL PIPE SLEEVE DETAIL
SCALE: NONE

NOTE: FOR STEAM & COND. LINE SIZES SEE PLAN, SHEET M-3. FOR TRAP SIZES SEE SCHEDULE SHEET M-11

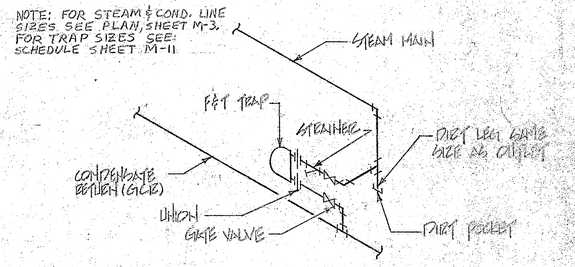

TYPICAL END OF MAIN DRIP (LOW PRESSURE)
SCALE: NONE

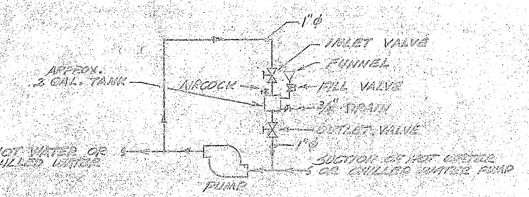

CHEMICAL FEED FOR HOT WATER AND CHILLED WATER SYSTEMS

OPERATION

1. TO FILL THE FEEDER, CLOSE THE INLET AND OUTLET VALVE.
2. NEXT OPEN THE DRAIN AND FILL VALVE AND COMPLETELY DRAIN THE FEEDER. CLOSE THE DRAIN VALVE.
3. OPEN THE AIRCOCK. MIX THE PROPER DOSAGE OF TREATMENT WITH AN EQUAL QUANTITY OF WARM WATER, AND POUR THE DILUTED DOSAGE INTO THE FEEDER THROUGH THE FUNNEL. POUR SLOWLY SO THE AIR HAS A CHANCE TO ESCAPE AS THE FEEDER IS FILLING. WHEN THE FEEDER IS FILLED, CLOSE BOTH THE AIRCOCK AND THE FILL VALVE.
4. NEXT, OPEN THE OUTLET, THEN THE INLET VALVE AND THE FULL DOSAGE OF TREATMENT WILL GO AT ONCE DIRECTLY INTO THE SYSTEM ALL IN ONE SHOT.

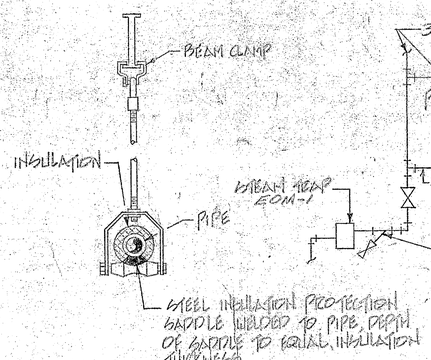

STEAM & CONDENSATE PIPE HANGER DETAIL
SCALE: NONE

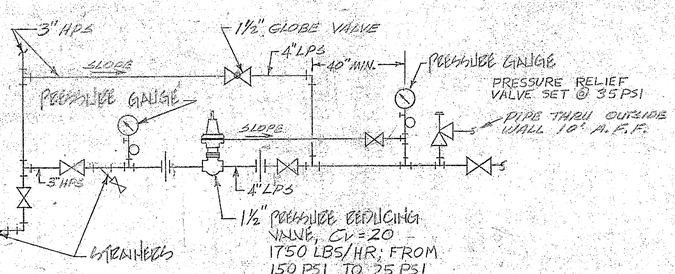

PRESSURE REDUCING VALVE STATION
SCALE: NONE

RECORD DRAWING
DATE 1-18-80
BLDG 1220

75128.01

1220

M-6

LOCKWOOD GREENE ENG., INC. SPARTANBURG, S. C. 29301 ARCHITECTS & ENGINEERS	DEPARTMENT OF THE NAVY NAVAL FACILITIES ENGINEERING COMMAND ATLANTIC DIVISION NAVAL STATION NORFOLK, VIRGINIA
DES. J. MOORE DR. F. ROSE CHK. M. BEAM	MARINE CORPS BASE, CAMP LEJEUNE, N. C. EXCHANGE CAFETERIA & RESTAURANT PIPING DETAILS H.V.A.C.
PROJ. MGR. J. HUNT CH. ENGR. J. [illegible]	
SUBMITTED BY DATE 11/17/72	
FIRM MEMBER PRINCIPAL	
EFD DIV. C. RVD. DIV. 2	
HD DIR.	
APPROVED DATE	
PUBLIC WORKS OFFICER APPROVED DATE	
EFD, FOR COMMANDER, NAVFAC	SIZE CODE IDENT. NO. 80091 NAVFAC DRAWING NO. 4032641 CONSTR. CONTR. NO. N62470-75-C-5328 SCALE AS NOTED SPEC. 75-76-5328 SHEET 46 OF 60

LANTDIV 09-0, 80