

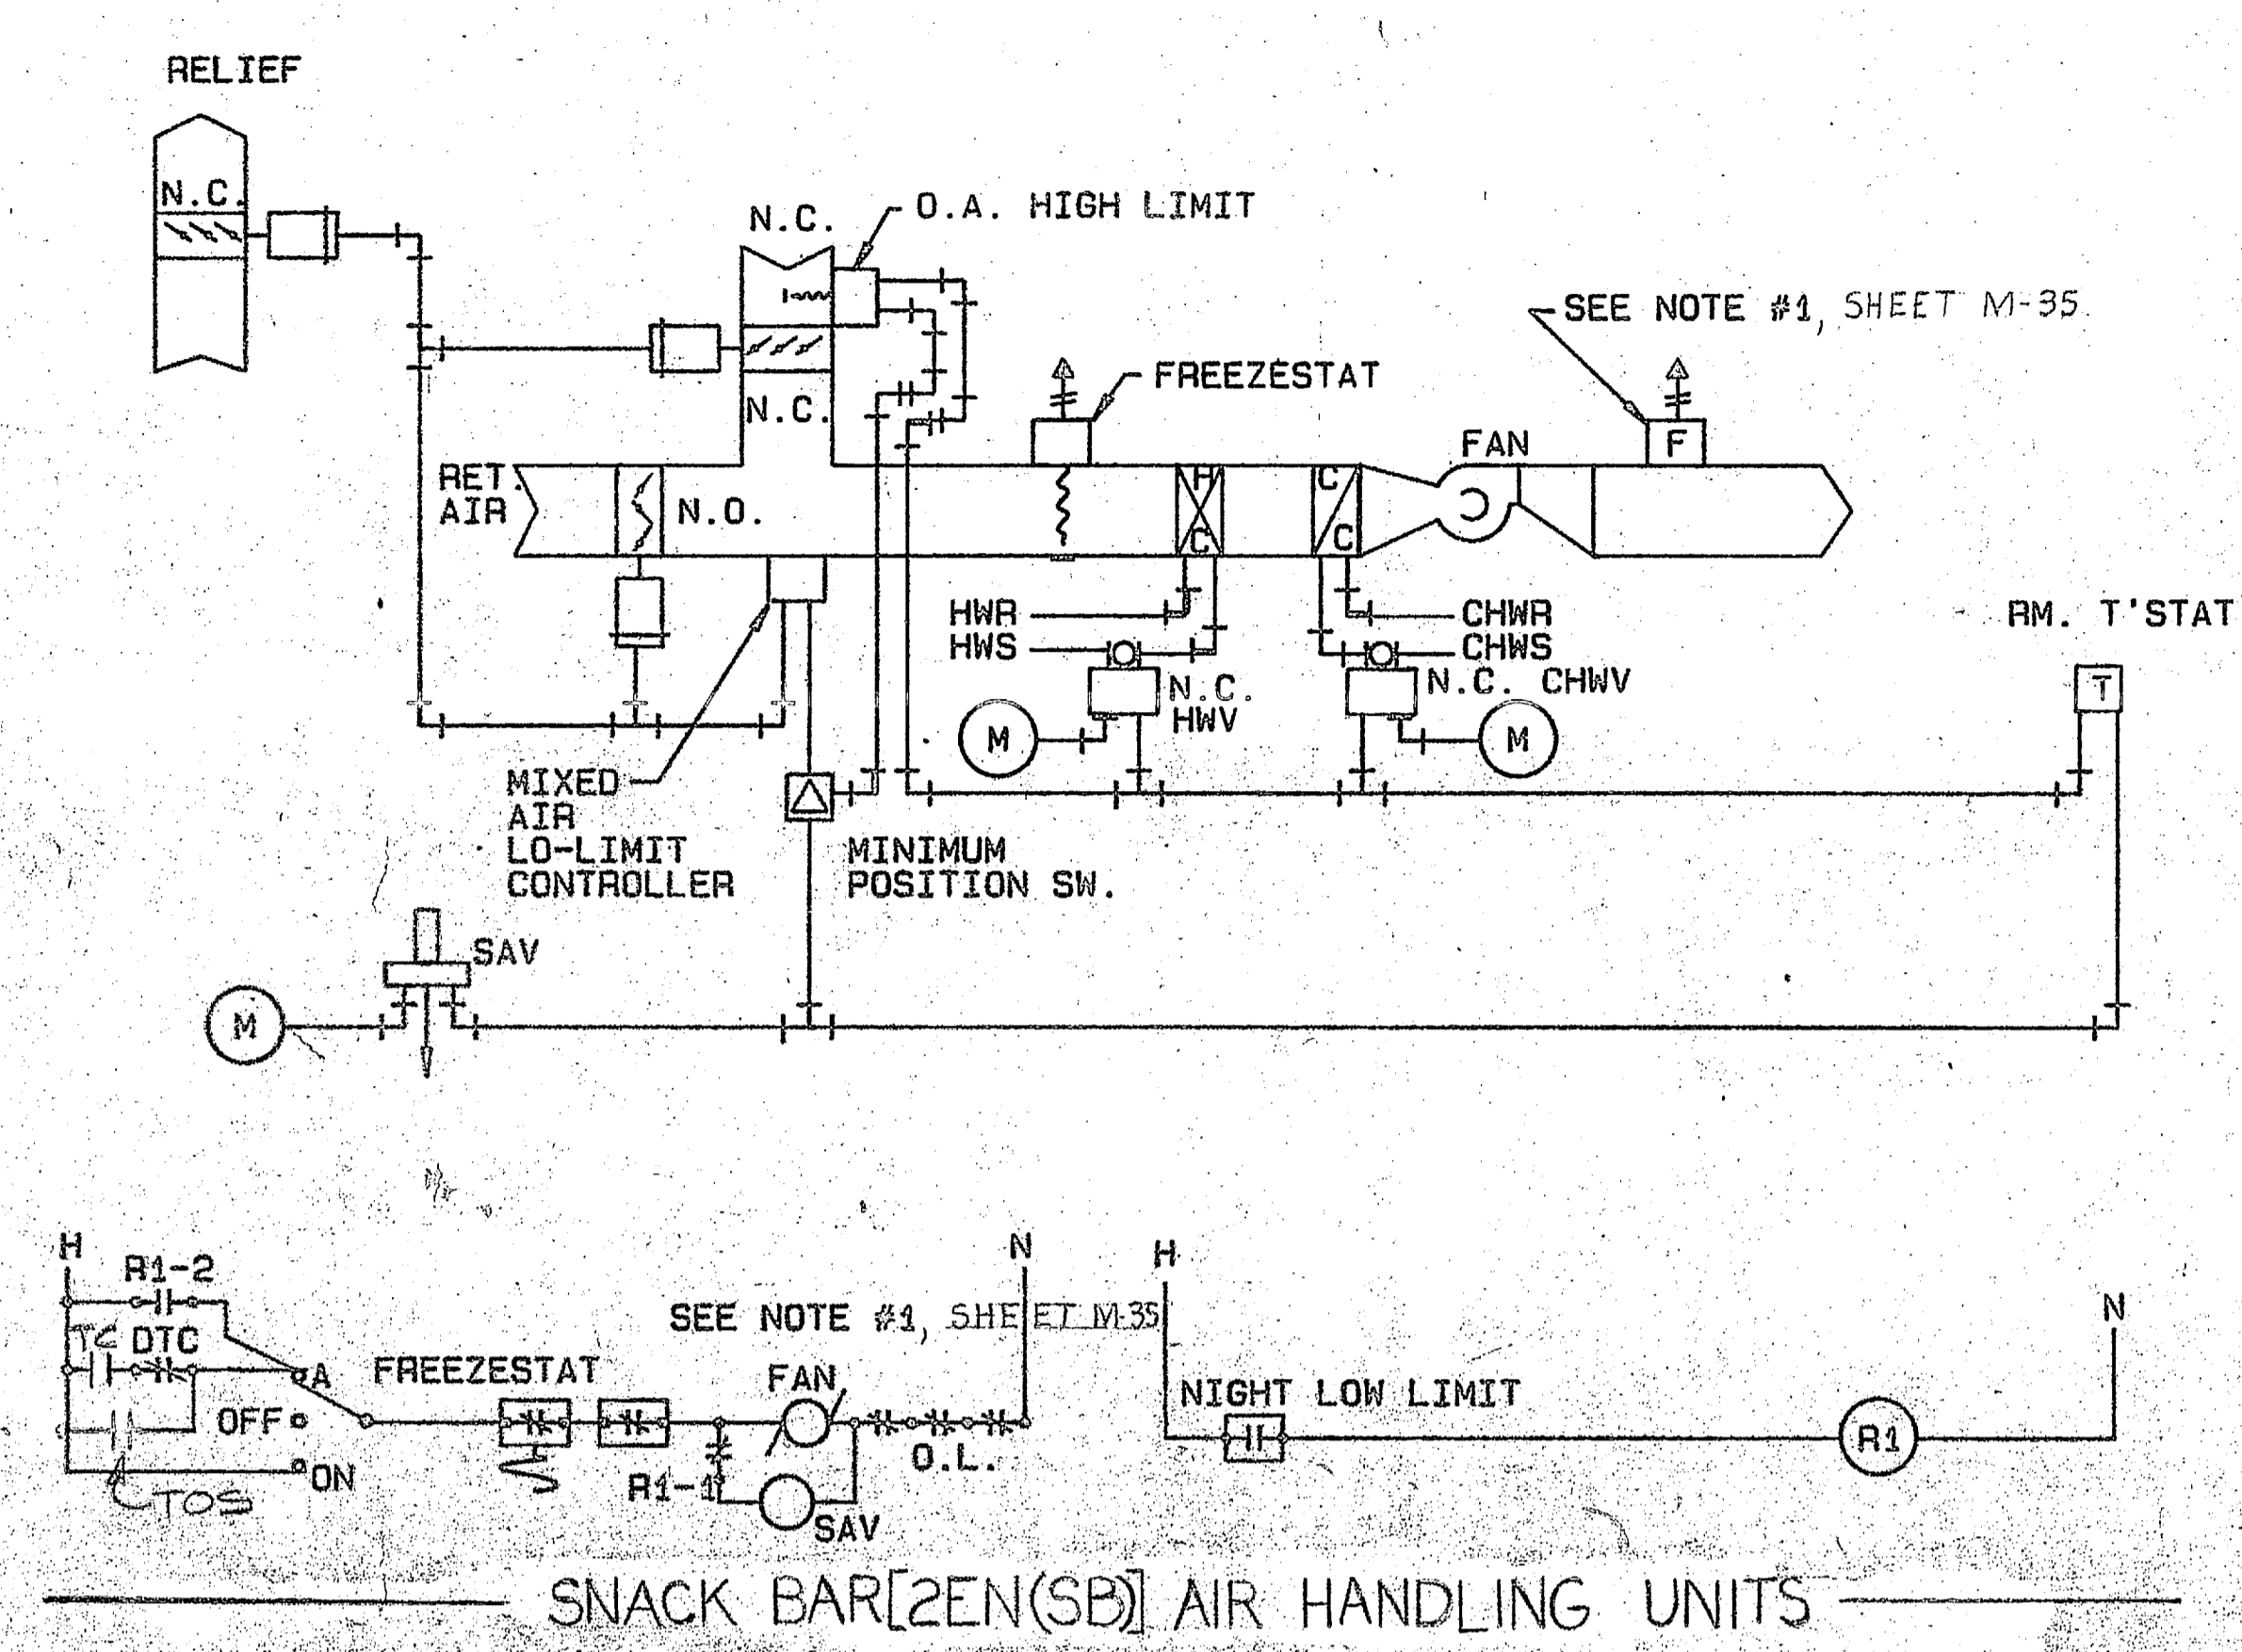
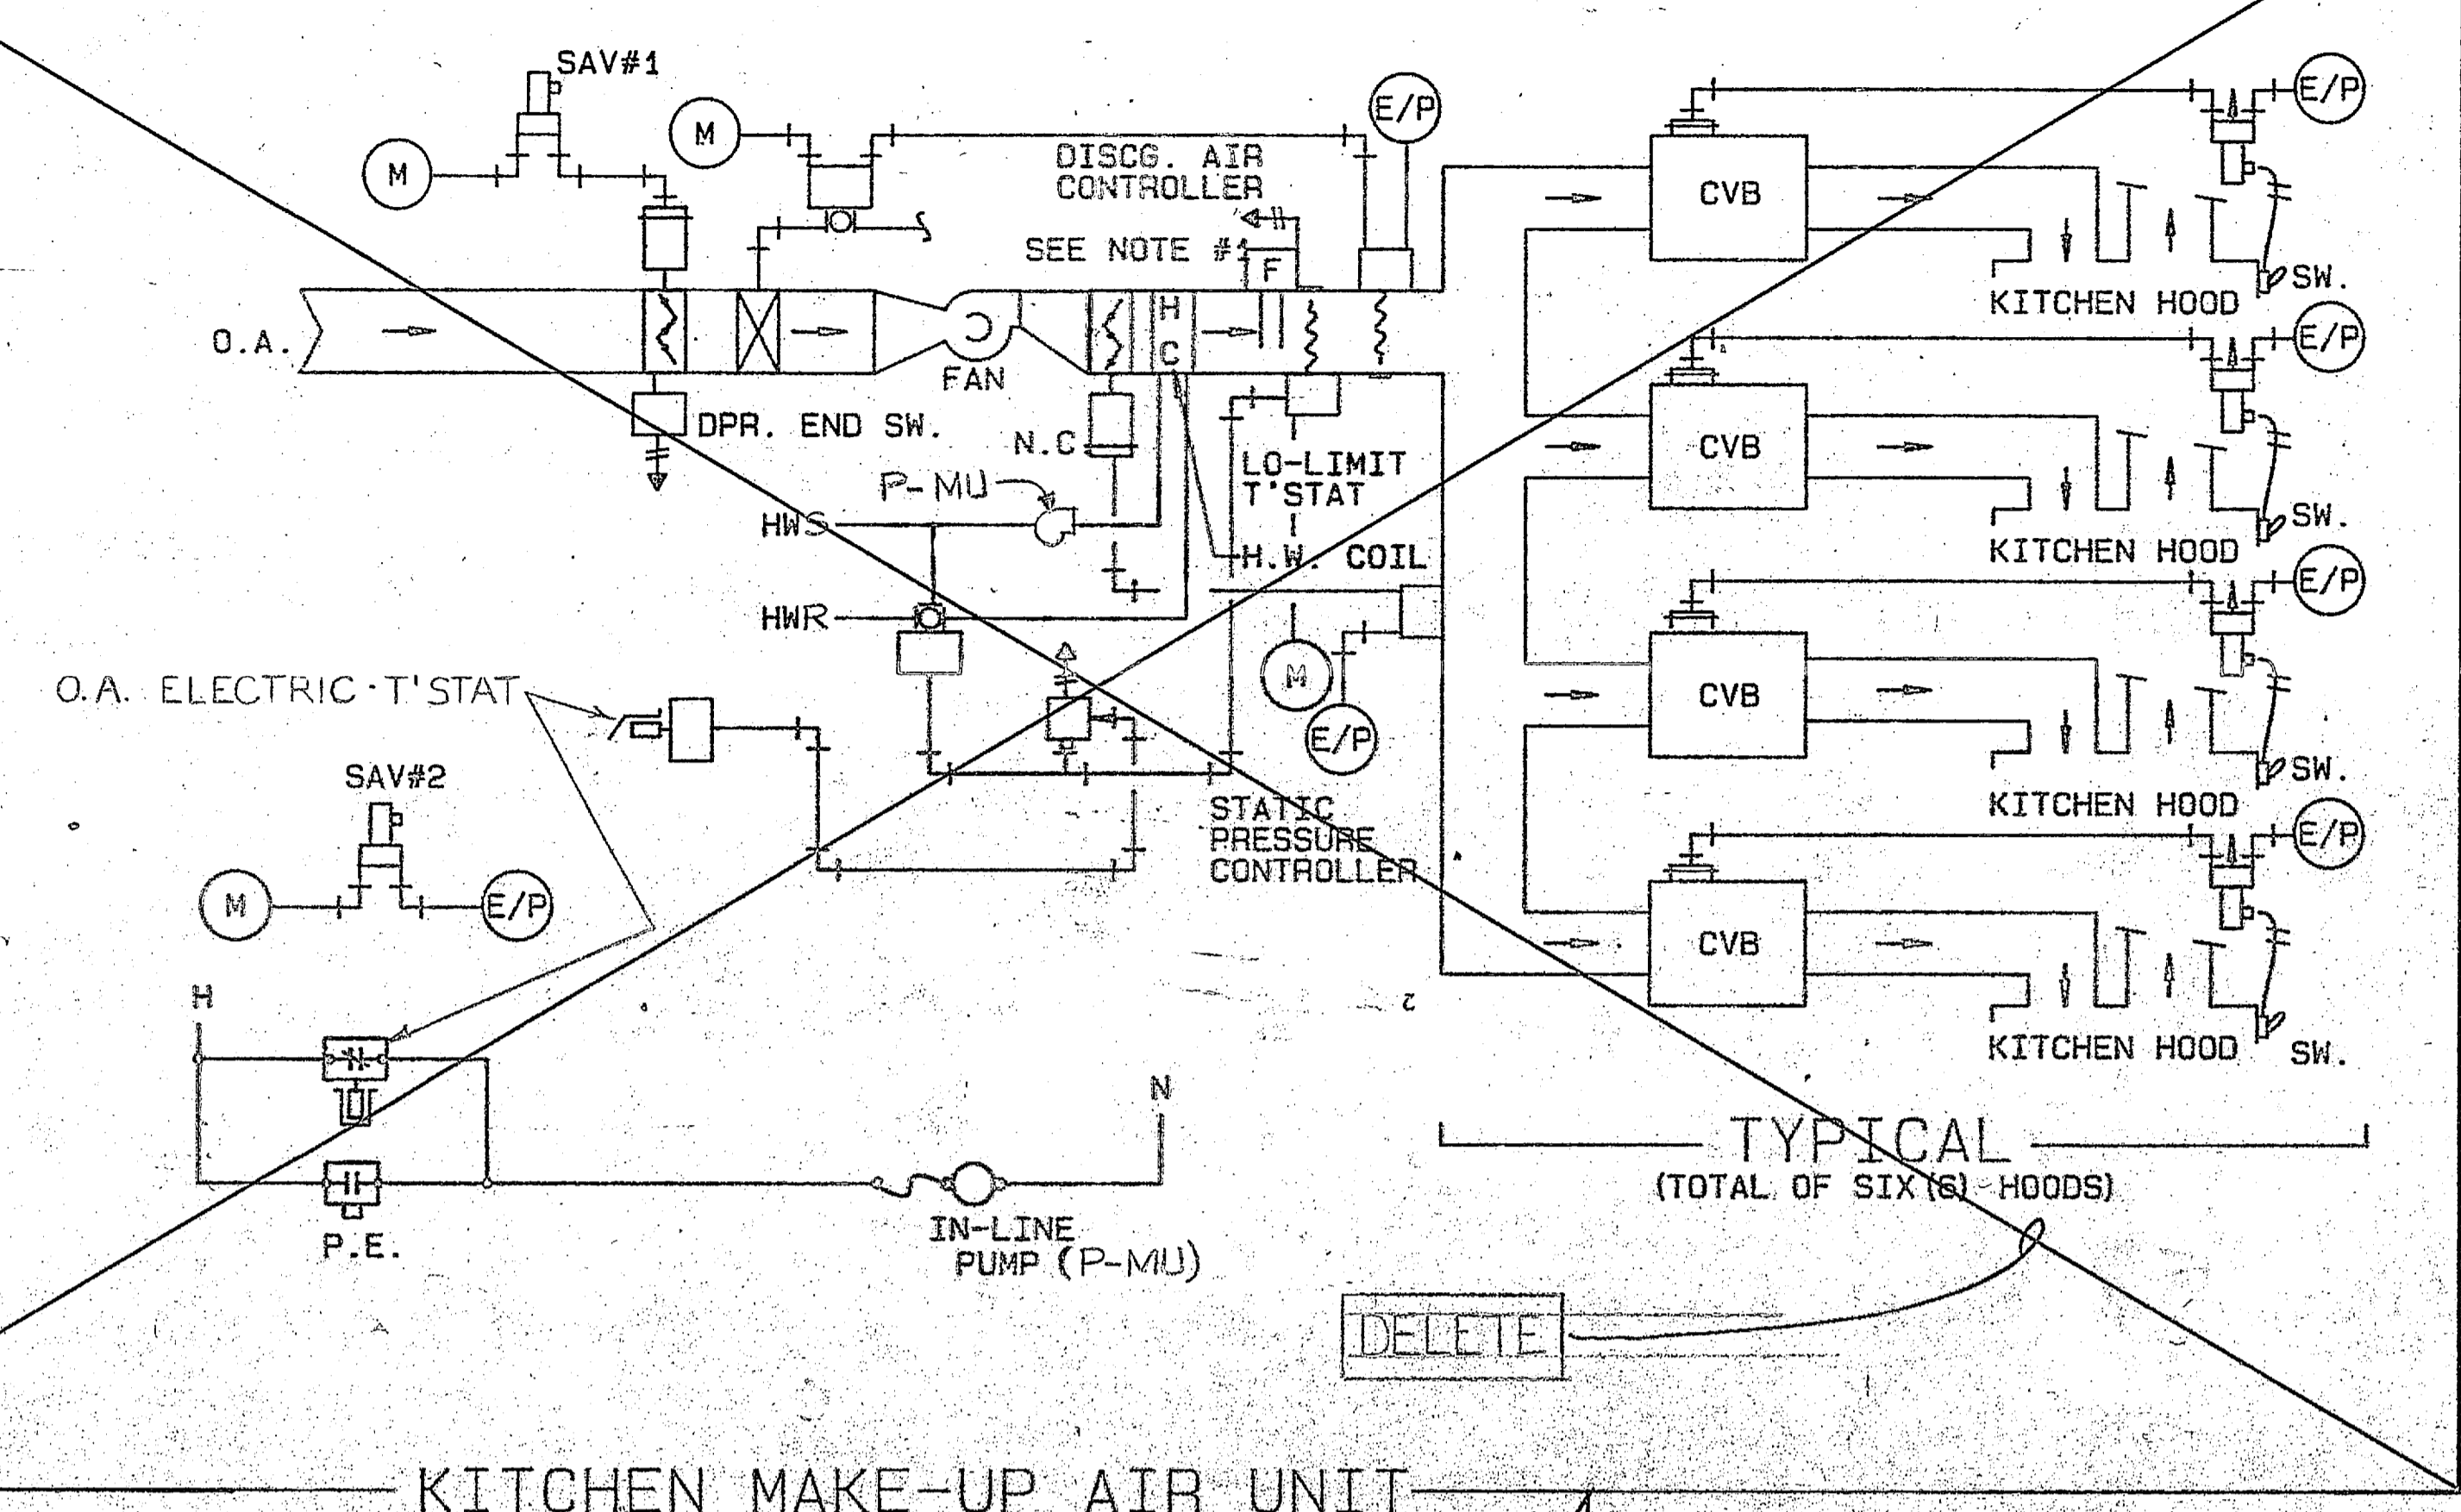
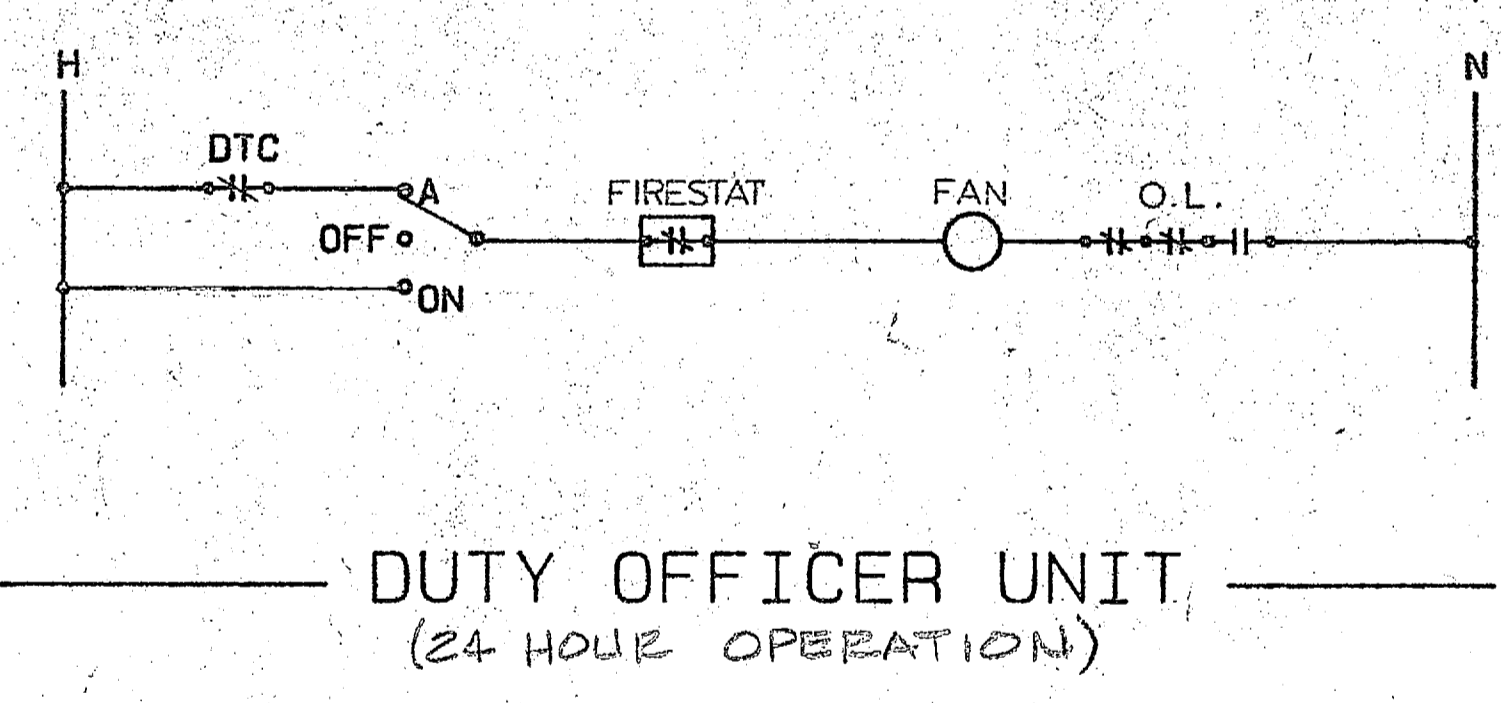
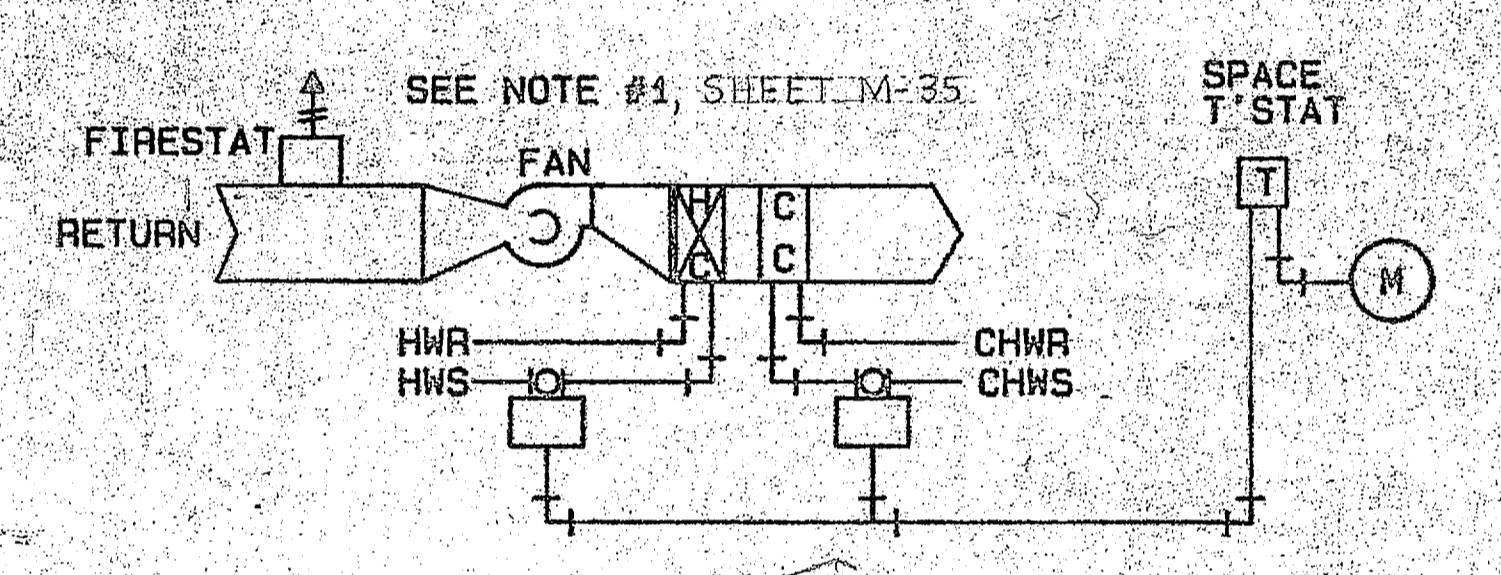
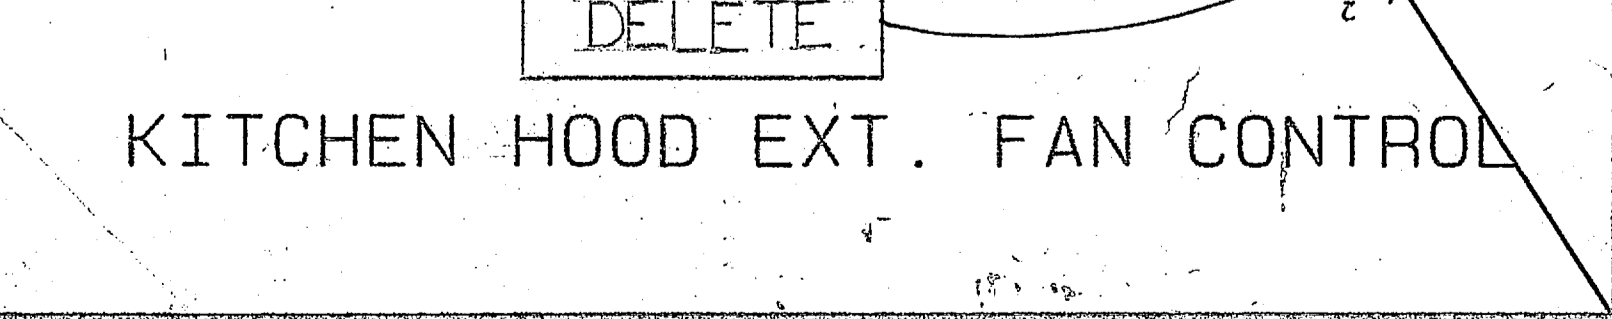
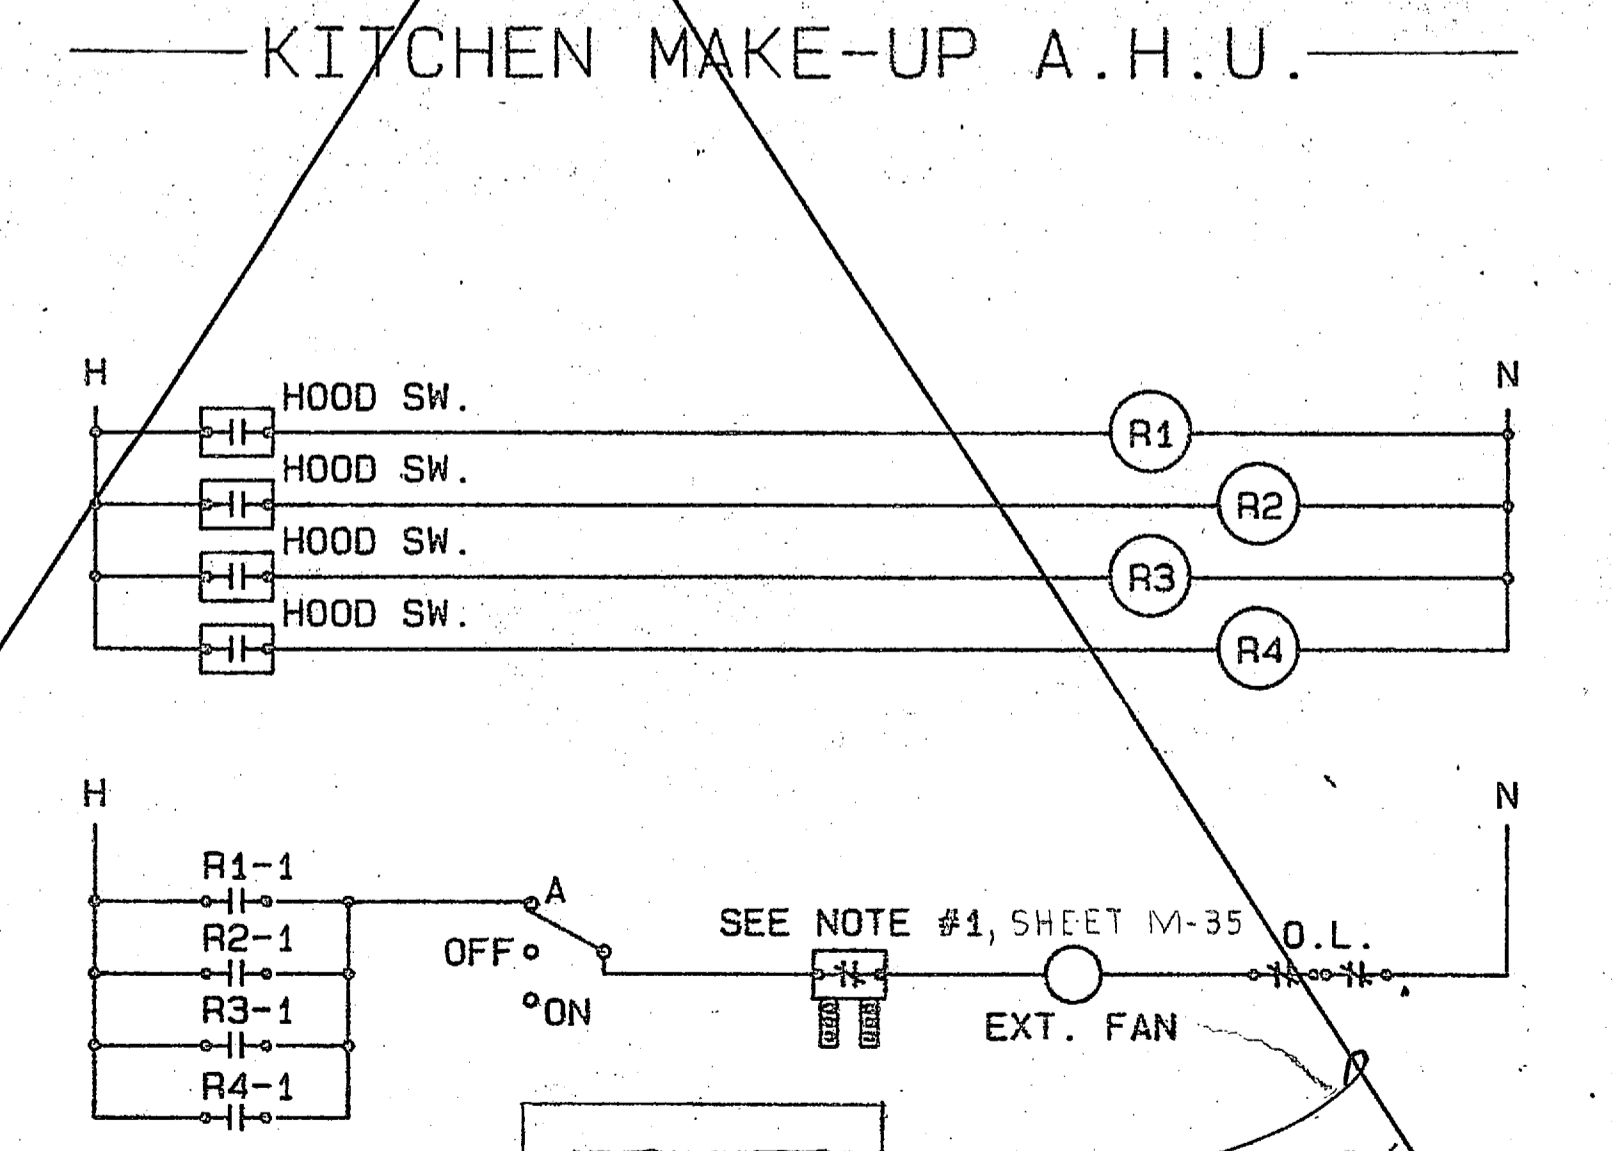


REVISIONS				
NO.	DESCRIPTION	BY	DATE	APPROVED
1	GENERAL REVISION	GHS	8/15/85	CS

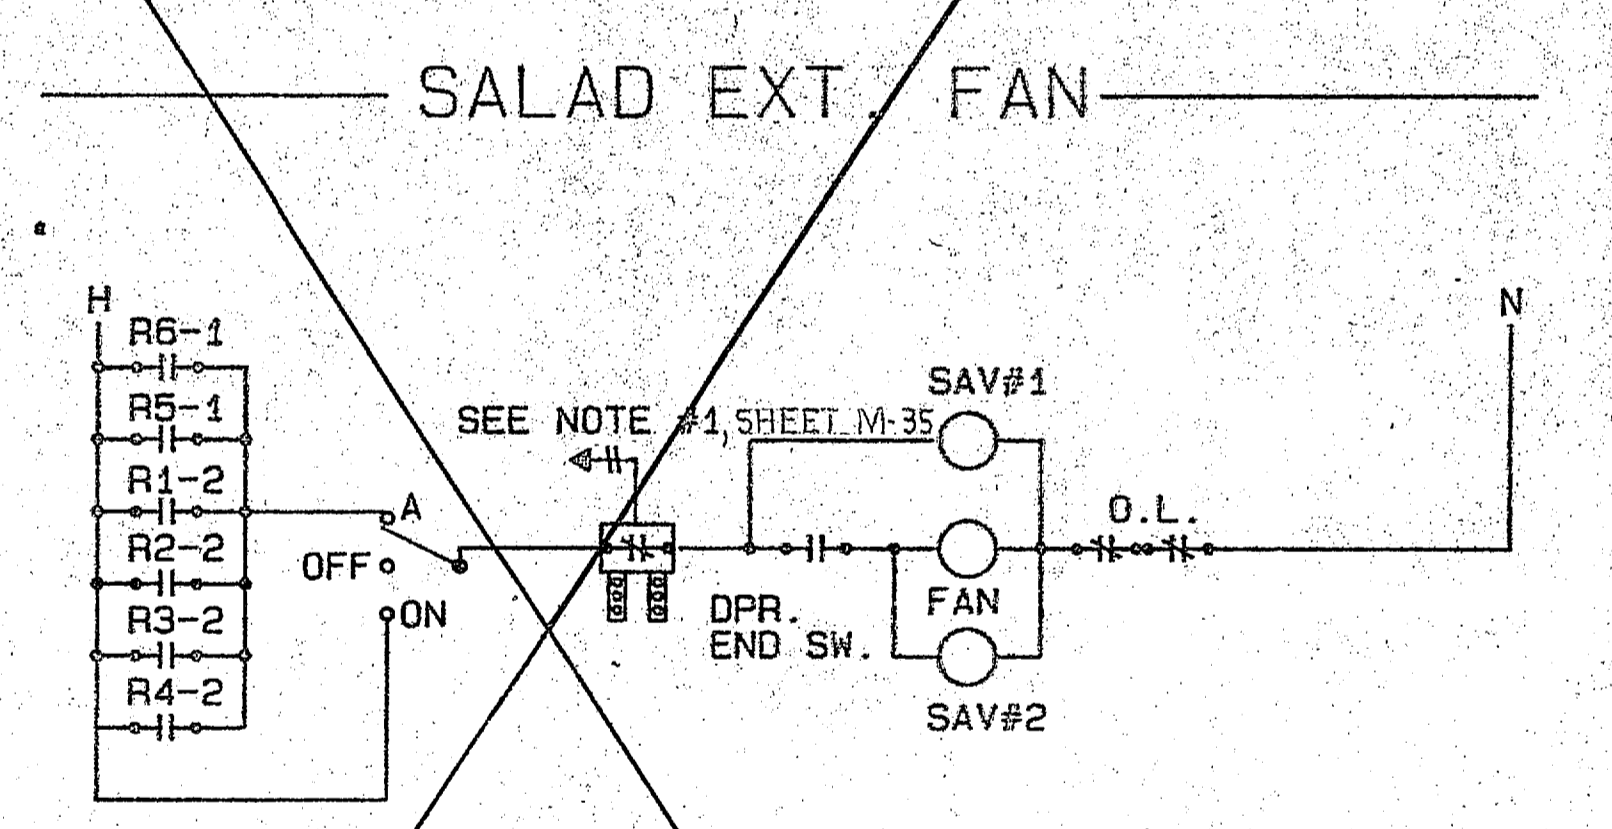


SYMBOL LEGEND	
TC	TIMECLOCK
O.A.	OUTDOOR AIR
S.A.V	SOLENOID AIR VALVE
H.W.	HOT WATER
CHW	CHILLED WATER
S/W	SUMMER/WINTER
P/E	PRESSURE-ELECTRIC SWITCH
PRV	PRESSURE REDUCING VALVE
R1	RELAY ONE (1)
N.C.	NORMALLY CLOSED
N.O.	NORMALLY OPEN
DTC	DATA TERMINAL CABINET
O.L.	OVERLOAD
CWP	CONDENSER WATER PUMP
BM	BRANCH AIR/MAIN AIR
S-W-AUTO	SUMMER-WINTER-AUTOMATIC SWITCH
H-O-A	HAND-OFF-AUTO SWITCH (NORMALLY LOCATED IN STARTER COVER)
(M)	MAIN AIR - 25 PSIG
(S)	TOGGLE SWITCH
(TS)	TIMED OVERRIDE SWITCH

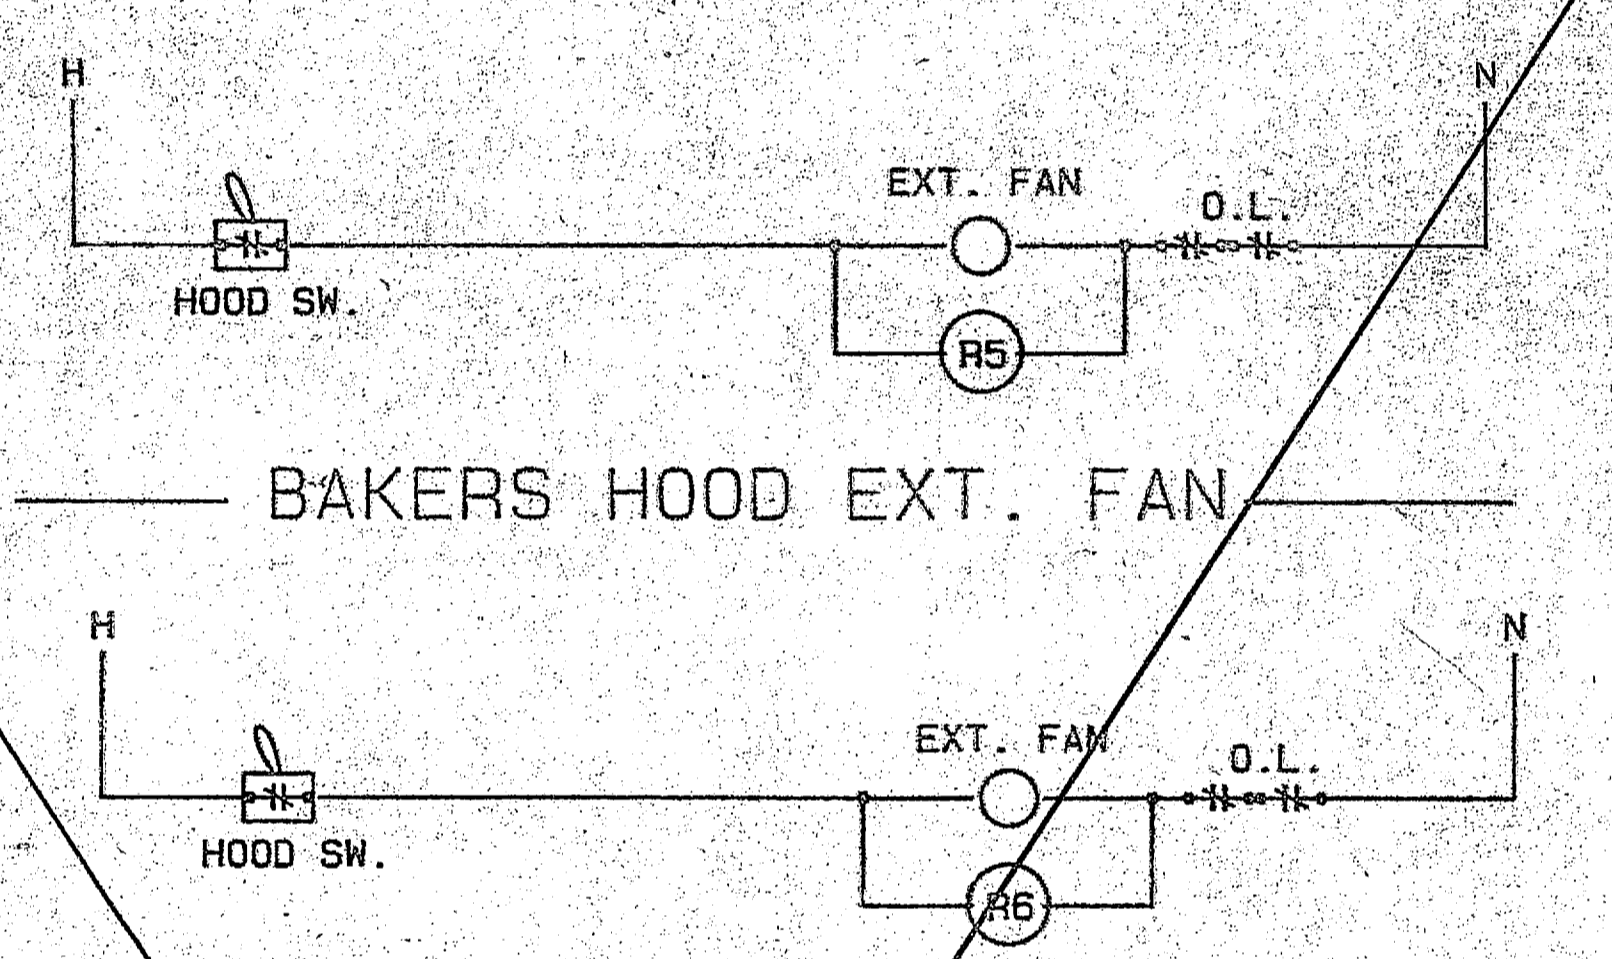

ENERGY MANAGEMENT CONTROL SYSTEM

- PROVIDE 3 DATA TERMINAL CABINETS TO SERVE THE FOLLOWING AREAS:
 - DATA TERMINAL CABINET NO. 1 SHALL SERVE ALL HVAC EQUIPMENT SERVING JAN, 1A5, 1B1, 1B2, 2EN, 2ES, 1CN, 1CS, 2CN, 2CS, 1DN, 1DS, 2DN, 2DS, 1EN, 1ES, 2EN, 2ES, 1HN, 1HS, 2HN, 2HS, 1JN, 1JS, 2JN, 2JS, 1IN, 1IS, 2IN, 2IS, 1LN, 1LS, 2LN, 2LS, 1ON, 1OS, 2ON, 2OS, 1PN, 1PS, 2PN, 2PS, 1RN, 1RS, 2RN, 2RS, 1SN, 1SS, 2SN, 2SS, 1TN, 1TS, 2TN, 2TS, 1UN, 1US, 2UN, 2US, 1VN, 1VS, 2VN, 2VS, 1WN, 1WS, 2WN, 2WS, 
 - DATA TERMINAL CABINET NO. 2 SHALL SERVE ALL HVAC EQUIPMENT LOCATED IN A/M-17, B/M-17, AND C/M-17 ALONG WITH EQUIPMENT SERVING 1ES, 2ES, 3EN, 3ES, 1EN (MESS HALL), 1EN (GALLEY), 2EN, 2EN, THE STEAM VALVES SERVING THE HOT WATER HEAT EXCHANGER HE-3 LOCATED IN THE TUNNEL IN SERVICE BAY 19, AND THE HOT WATER PRIMARY LOOP P-14.
 - DATA TERMINAL CABINET NO. 3 SHALL SERVE ALL HVAC EQUIPMENT SERVING 1FN, 1FS, 2FN, 2FS, 1GN, 1GS, 2GN, 2GS, 1HN, 1HS, 2HN, 2HS, 1JN, 1JS, 2JN, 2JS, 1KN, 1KS, 2KN, 2KS, 1LN, 1LS, 2LN, 2LS, 1ON, 1OS, 2ON, 2OS, 1PN, 1PS, 2PN, 2PS, 1RN, 1RS, 2RN, 2RS, 1SN, 1SS, 2SN, 2SS, 1TN, 1TS, 2TN, 2TS, 1UN, 1US, 2UN, 2US, 1VN, 1VS, 2VN, 2VS, 1WN, 1WS, 2WN, 2WS, 1XN, 1XS, 2XN, 2XS, 1YN, 1YS, 2YN, 2YS, 1ZN, 1ZS, 
- THE FOLLOWING POINTS SHALL BE MONITORED:
 - FOR EACH OF (32) AIR HANDLING UNITS, (6) ROOFTOP AIR CONDITIONING UNITS, AND (2) COMPUTER ROOM UNITS:
 - SUPPLY AIR TEMPERATURE
 - RETURN AIR TEMPERATURE
 - SUPPLY AIR RELATIVE HUMIDITY
 - RETURN AIR RELATIVE HUMIDITY
 - SUPPLY FAN START/STOP
 - SUPPLY FAN STATUS
 - SPACE TEMPERATURE
 - FILTER DIFFERENTIAL PRESSURE SWITCH
 - HYDRONIC SYSTEMS:
 - CHILLED WATER SUPPLY TEMPERATURE
 - CHILLED WATER RETURN TEMPERATURE
 - HOT WATER SUPPLY TEMPERATURE
 - HOT WATER RETURN TEMPERATURE
 - NINE SECONDARY HOT WATER PUMP STATUS
 - ONE SECONDARY DUAL TEMPERATURE PUMP STATUS
 - ONE PRIMARY HOT WATER PUMP STATUS
 - NINE SECONDARY CHILLED WATER PUMP STATUS
 - TWO PRIMARY CHILLED WATER PUMP STATUS
 - TWO TERTIARY CHILLED WATER PUMP STATUS
 - TWO CONDENSER WATER PUMP STATUS
 - THREE CHILLER START/STOP STATUS
 - TWO COOLING TOWER START/STOP STATUS
 - CONTROL POINT ADJUSTMENT FOR LEAK EXCHANGERS HE-1, HE-2, AND HE-3.
- PROVIDE A NIGHT LOW LIMIT THERMOSTAT FOR EACH AREA SERVED BY A TIMECLOCK.
- DATA TERMINAL CABINET NO. 1 (LOCATED IN ROOM 1C28)
 - AHU'S - 1AS, 1BN, 1BS, 1CN, 1CS, 1DN, 1DS, 2DS, 2CN, 2CS
 - PUMPS - P-C-AB, P-C-C, P-H-AB, P-H-C, P-H-D, P-C-D
 - CONTAINS TIME CLOCK #1
- DATA TERMINAL CABINET NO. 2 (LOCATED IN ROOM 1E54)
 - AHU'S - 1ES, 1EJ, 2EN, 2EN(SB), 2ES, 3EN, 3ES
 - PUMPS - P-CH-1, P-CH-2, P-CH-3, P-CD-1, P-CD-2, P-PC-1, P-PC-2, P-C-EN, P-C-ES, P-H-EN, P-H-ES
 - CHILLERS - 1, 2, 3
 - COOLING TOWERS - 1, 2
 - CONTAINS TIME CLOCKS # 2 & 3
- DATA TERMINAL CABINET NO. 3 (LOCATED IN ROOM 1G47)
 - AHU'S - 1FN, 1FS, 2FN, 2FS, 1GN, 1GS, 2GN, 2GS, 1HS, 2HN, 2HS, 1JN, 1JS, 2JN, 2JS, 1KN, 1KS, 2KN, 2KS, 1LN, 1LS, 2LN, 2LS, 1ON, 1OS, 2ON, 2OS, 1PN, 1PS, 2PN, 2PS, 1RN, 1RS, 2RN, 2RS, 1SN, 1SS, 2SN, 2SS, 1TN, 1TS, 2TN, 2TS, 1UN, 1US, 2UN, 2US, 1VN, 1VS, 2VN, 2VS, 1WN, 1WS, 2WN, 2WS, 1XN, 1XS, 2XN, 2XS, 1YN, 1YS, 2YN, 2YS, 1ZN, 1ZS, 2ZN, 2ZS, 1AN, 1AS, 1BN, 1BS, 1CN, 1CS, 1DN, 1DS, 1EN, 1ES, 1FN, 
 - PUMPS - P-C-F, P-C-G, P-C-H, P-C-J, P-H-F, P-H-G, P-H-H, P-H-I
 - CONTAINS TIME CLOCK # 4
- PROVIDE 7-DAY TIMECLOCKS W/12-HOUR RESERVE AS FOLLOWS:
 - TIME CLOCK #1
 - AHU - 1AS, 1BN, 1BS, 1CN, 1CS, 2CN, 2CS, 1DN, 1DS, 2DS
 - WVF - 1AS, 1BN, 1BS, 1CN, 1CS, 2CN, 2CS, 1DN, 1DS, 2DS
 - PUMPS - P-C-AB, P-C-C, P-G-D, P-H-AB, P-H-C, P-H-D
 - TIME CLOCK #2
 - AHU - 2EN, 3EN, 1ES, 2ES, 3ES & WVF-2ES
 - PUMPS - P-C-EN, P-C-ES, P-H-EN, P-H-ES
 - TIME CLOCK #3
 - AHU - 2EN(SB)
 - PUMPS - P-C-EN, P-H-EN
 - TIME CLOCK #4
 - AHU - 1FN, 1FS, 2FN, 2FS, 1GN, 1GS, 2GN, 2GS, 1HS, 2HN, 2HS, 1JN, 1JS, 2JN, 2JS, 1KN, 1KS, 2KN, 2KS, 1LN, 1LS, 2LN, 2LS, 1ON, 1OS, 2ON, 2OS, 1PN, 1PS, 2PN, 2PS, 1RN, 1RS, 2RN, 2RS, 1SN, 1SS, 2SN, 2SS, 1TN, 1TS, 2TN, 2TS, 1UN, 1US, 2UN, 2US, 1VN, 1VS, 2VN, 2VS, 1WN, 1WS, 2WN, 2WS, 1XN, 1XS, 2XN, 2XS, 1YN, 1YS, 2YN, 2YS, 1ZN, 1ZS, 2ZN, 2ZS, 1AN, 1AS, 1BN, 1BS, 1CN, 1CS, 1DN, 1DS, 1EN, 1ES, 1FN, 

 - PUMPS - P-C-F, P-C-G, P-C-H, P-C-J, P-H-F, P-H-G, P-H-H, P-H-I
- PROVIDE A 6-HOUR TIMED OVERRIDE SWITCH FOR EACH AHU OR WVF SERVED BY A TIME CLOCK.
- CONTROL CIRCUITS FOR THE FOLLOWING UNITS SHALL ORIGINATE FROM EMERGENCY PANELS:
 - AC-1, FCU-35, AHU-1EJ, AC-2, P-C-EN, P-C-ES, CHILLER NO. 3, P-PC-2 AND P-CH-3.

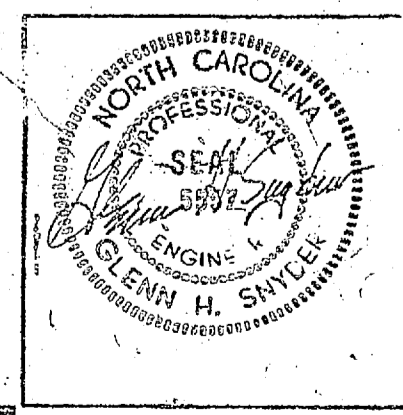

M-37 FEREBEE, WALTERS & ASSOCIATES ARCHITECTURE PLANNING CHARLOTTE, NORTH CAROLINA		DEPARTMENT OF THE NAVY NAVAL FACILITIES ENGINEERING COMMAND ATLANTIC DIVISION NAVAL STATION NORFOLK, VIRGINIA	
SUBMITTED BY: [Signature] FIRM MEMBER		MARINE CORPS BASE, CAMP LEJEUNE, NORTH CAROLINA CONVERT HOSPITAL TO DIVISION HEADQUARTERS MECHANICAL - TEMPERATURE CONTROLS	
APPROVED: [Signature] OFFICER IN CHARGE	DATE: 8/15/85	SIZE: F	CODE IDENT. NO.: 80091
APPROVED FOR EFD FOR COMMANDER, NAVFAC		CONSTR. CONTR. NO. 62470-82-B-2243 NAVFAC DRAWING NO. 4124305 SCALE: AS NOTED SPEC. 05-82-2243 (REV.) SHEET 150 OF 243 EFD DWG. NO. 224305	

