

VALUABLE

SUBJECT Profile & Location of
Water Line to Incinerator at
Montford Point.

RETURN TO
PUBLIC WORKS OFFICE
 CAMP LEJEUNE
 NEW RIVER, N. C.

FIELD PARTY

_____**IN CHARGE**
 _____**INSTRUMENT**
 _____**NOTES**
 _____**TAPE READ**
 _____**TAPE OR ROD**
 _____**TAPE OR ROD**
 _____**INSTRUMENT NO.**
 _____**TAPE NO.**

WEATHER

_____**CLEAR** _____**SNOW**
 _____**CLOUDY** _____**HOT**
 _____**WINDY** _____**MODERATE**
 _____**RAIN** _____**COLD**
 _____**FAIR** _____**FOG**

FILE No. 119-A

FLDR. No. _____

SHEET #1 of 2


FIGURED BY _____

NOTES CHECKED BY _____

PLOTTED BY _____ **DATE** 5/8 1944

Quad. No. 119

STATION	DIST.	ANGLE "	+	H. I.	VER. ANG. DIFF.	ELEVATION
B.M.		5.49	18.51		13.02	
				1.08	17.93	
		5.18	22.61			
0+49 ^E End of 6" x 4" Reducer				10.16	12.45	
1+0				9.25	13.36	
2+0				9.30	13.31	
2+39 ^E 4" x 4" Tee & Plug				9.36	13.25	
3+0				8.70	13.91	
4+0				9.35	13.26	
4+85				12.42	10.19	
5+0				12.00	10.61	
5+32 Bend						
5+32 Bend				11.20	11.41	
6+0				12.95	9.66	
T.P.				7.93	15.25	
		3.43	18.41			
7+0				15.10	3.61	
7+25 4" x 4" Tee				15.62	3.09	
7+80				17.15	1.56	
8+15				16.55	2.16	
8+84 4" x 4" x 2" Tee & Plug				11.93	7.38	
8+87 22 1/2° Bend						
8+88 2" 1/4 B						
9+0				11.15	7.52	

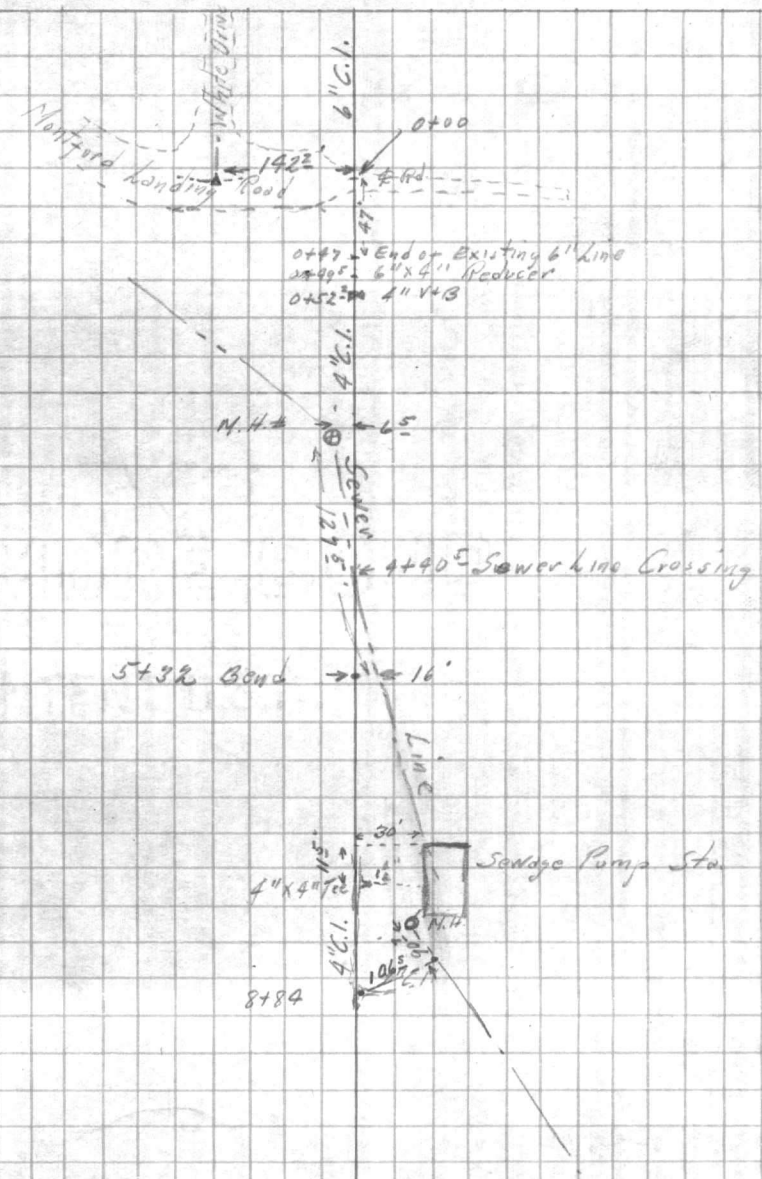

25.12

0.05
25.08

8.16
13.60
21.16

VALUABLE SUBJECT
RUSH TO
PUBLIC WORKS
OFFICE

N

342,975.37
61.01
342,914.36
50.79
342,863.62
476.24
342,387.38

89.04
87.38
1.66

E

2,502,460.02
6.91
2,502,453.11
997.66
2,502,900.77
50.56
2,502,850.21
848.58
81 1.66

VALUABLE

SUBJECT

*Water Line to Incinerator
Montford Point*

RETURN TO
PUBLIC WORKS
OFFICE

CAMP LEJEUNE
NEW RIVER, N. C.

FIELD PARTY

____ IN CHARGE
____ INSTRUMENT
____ NOTES
____ TAPE READ
____ TAPE OR ROD
____ TAPE OR ROD
____ INSTRUMENT NO.
____ TAPE NO.

WEATHER

CLEAR SNOW
CLOUDY HOT
WINDY MODERATE
RAIN COLD
FAIR FOG

FILE No.

FLDR. No.


FIGURED BY _____ SHEET *# 2 of 2*

NOTES CHECKED BY _____

PLOTTED BY _____ DATE *5/8 19 44*

Quad. No. *119*

STATION	DIST.	ANGLE "	+	H. I.	VER. DIFF.	ANG. DIFF.	ELEVATION
				<i>18.71</i>			
<i>9453 Bend</i>							<i>10.19 8.52</i>
<i>10+00 \approx 45° Bend</i>							<i>11.30 7.41</i>
<i>10+08 \approx Inlet at Bldg.</i>							<i>11.22 7.49</i>
<i>B.M.</i>							<i>5.69 13.02 (13.02)</i>

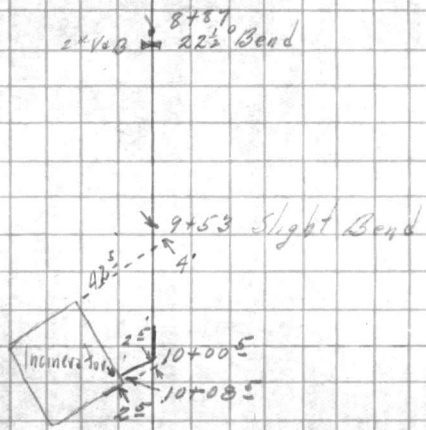

VALUABLE

SUBJECT

RETURN TO
PUBLIC WORKS
OFFICE




