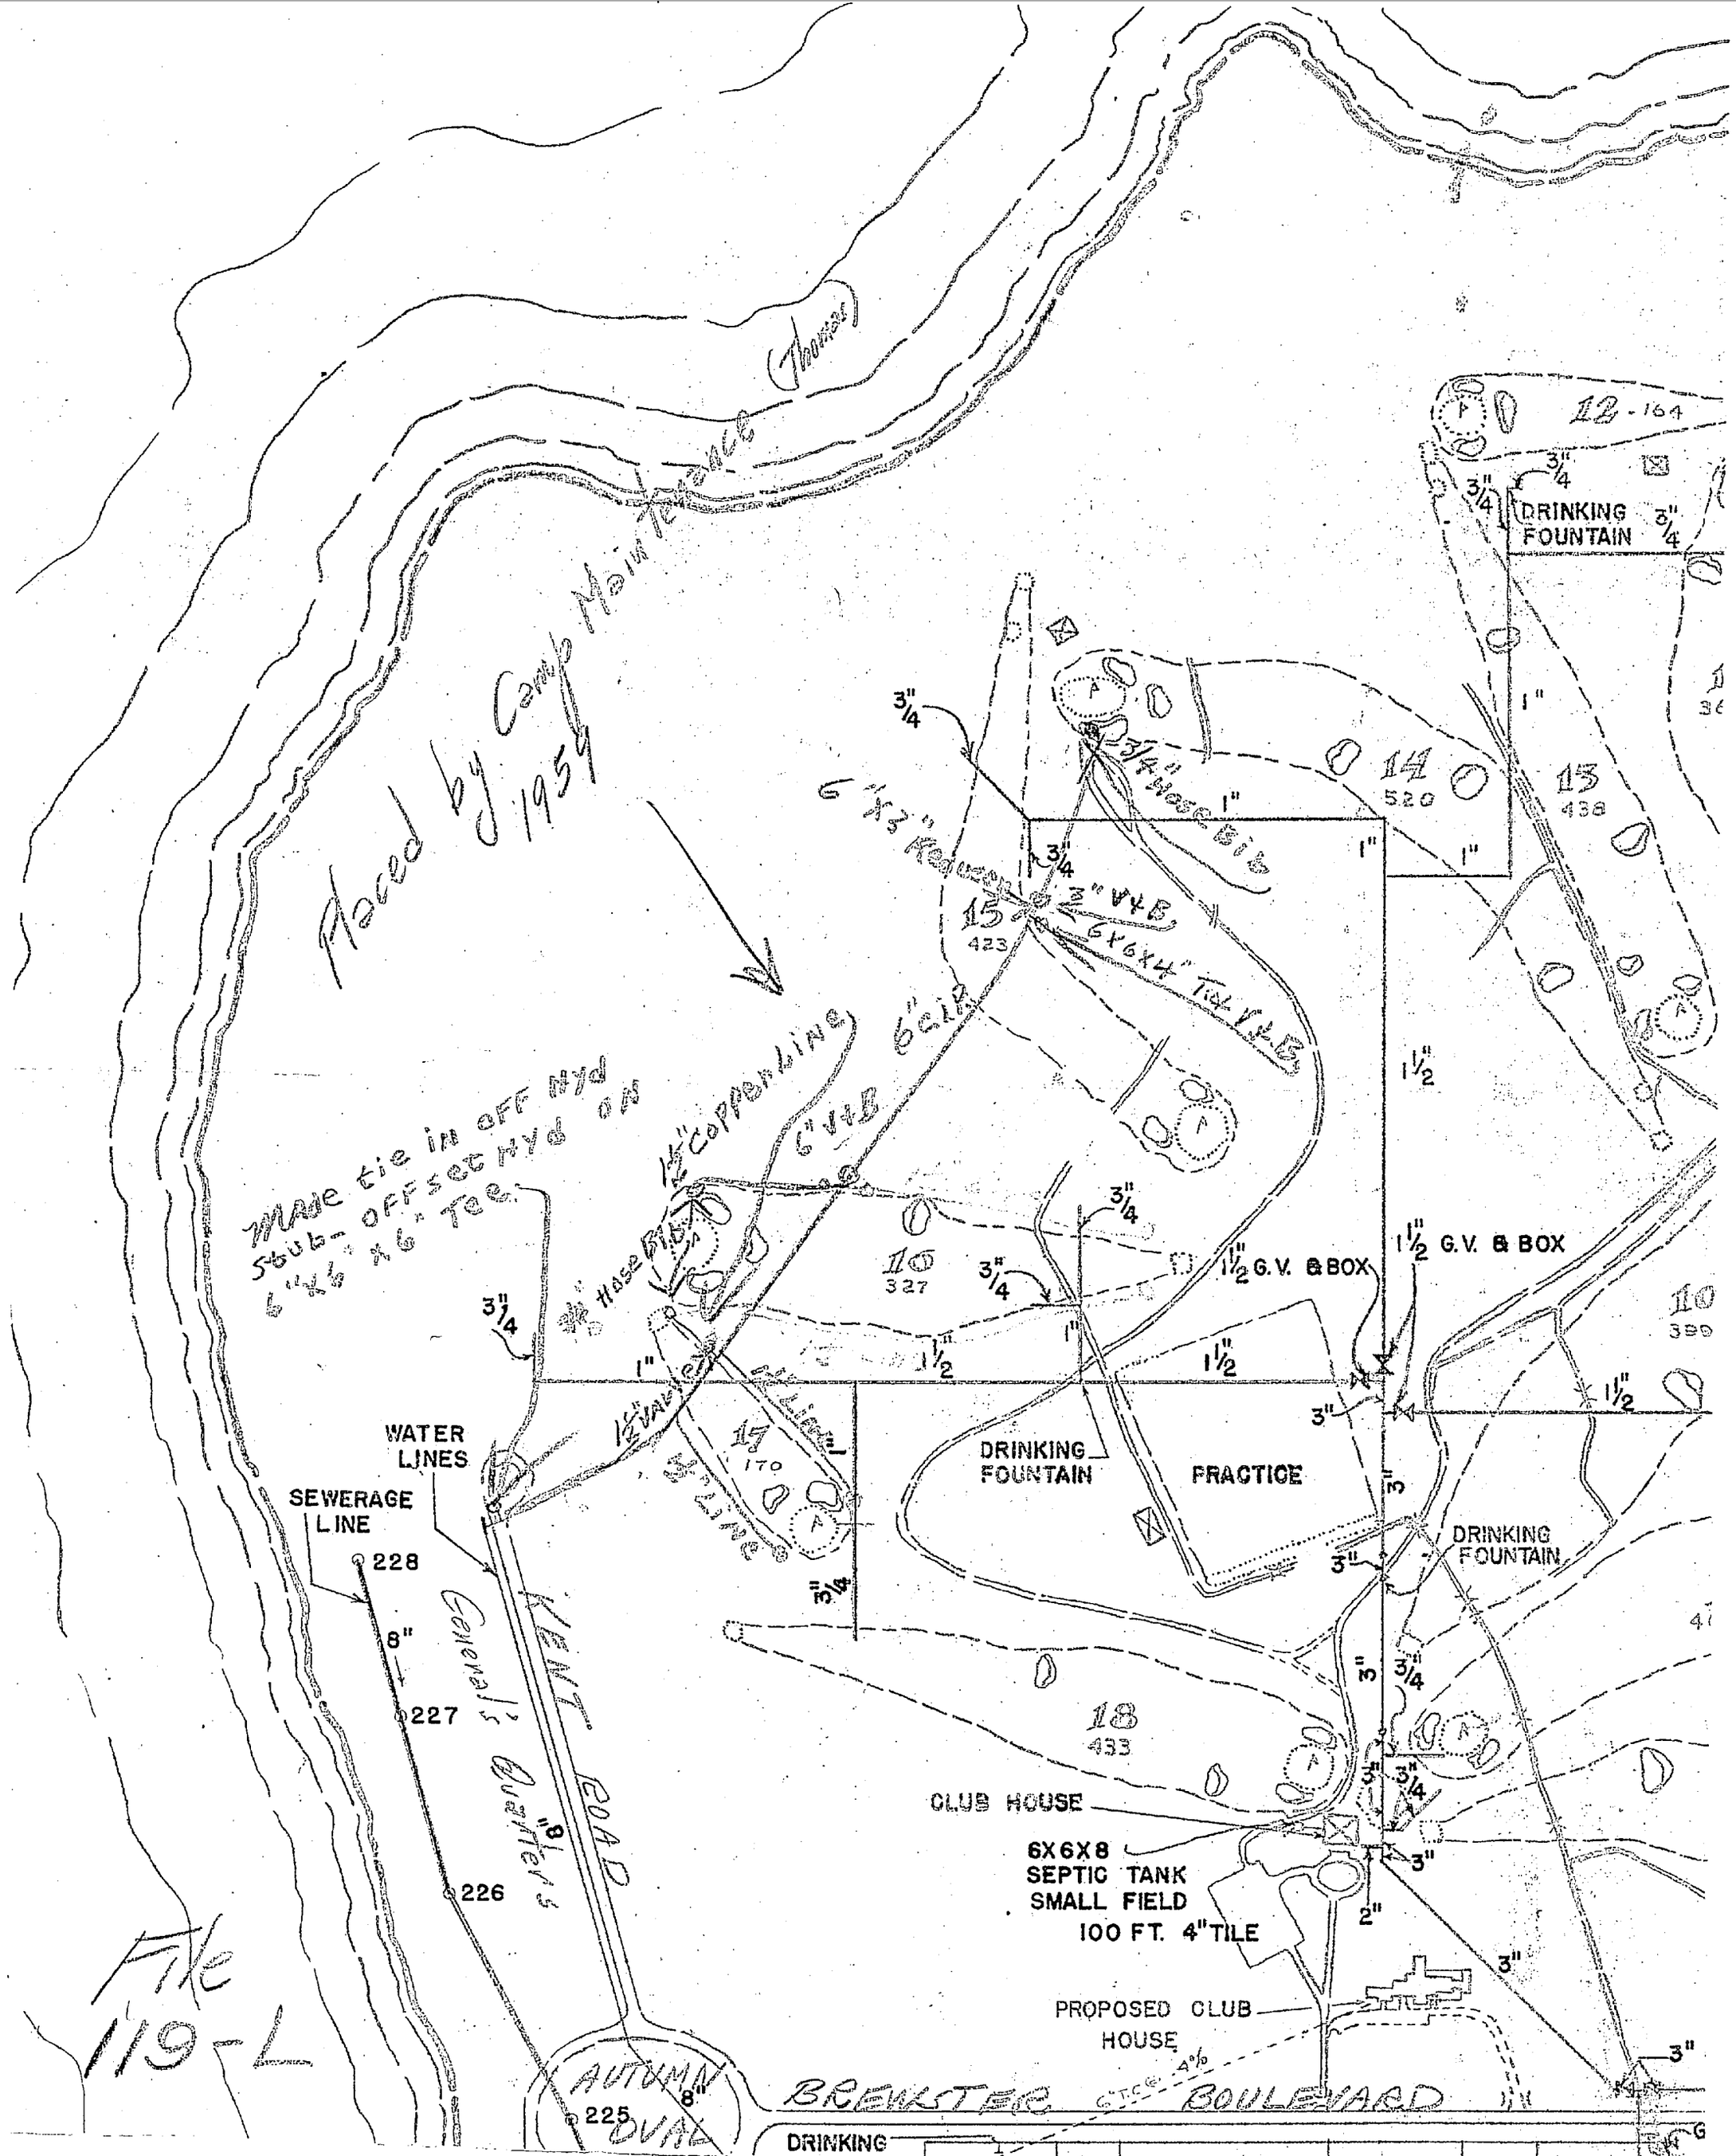
Placed by Camp Maintenance (Thomas) 1954
12-164
DRINKING FOUNTAIN
14 520
13 438
15 423
6"x3" Reducer
3"V+B
6x6x4" Tee V+B
6" V+B
6" Elb.
1½" copper line
Made tie in off Hyd stub - offset Hyd on 6"x6"x6" Tee.
¾" Hose Bib
16 327
1½ G.V. & BOX
17 170
DRINKING FOUNTAIN
PRACTICE
WATER LINES
SEWERAGE LINE
228
227
226
225
8"
KENT ROAD
General's Quarters
18 433
CLUB HOUSE
6X6X8 SEPTIC TANK SMALL FIELD 100 FT. 4" TILE
PROPOSED CLUB HOUSE
AUTUMN OVAL
BREWSTER BOULEVARD
File 119-L