

VALUABLE

Section
North Carolina
Carrington
Office
Public Works
Section

Subject

Section

Date

Area

±
Bearing

H. V.
Vertical

Dist. Elevation

FIELD PARTY

in Charge _____
Instrument _____
Notes _____
Time of Day _____
Type of Rod _____
Type of Trip _____

WEATHER


Clear _____
Cloudy _____
Fog _____
Rain _____
Snow _____
Thunder _____
Wind _____
Temperature _____
Barometer _____
Direction _____

FILE No.

Sheet

Date

Graph No.

 

VALUABLE

Return To
Public Works
Office
Camp Lejeune
North Carolina

SUBJECT Bldg. LOCATION AT COURT
House BAY.

FIELD PARTY
YELLMAN In Charge
Instrument _____
Notes _____
Tape Read _____
Tape or Rod _____
Tape or Rod _____
Instrument No. _____
Tape No. _____


WEATHER
Clear _____
Cloudy _____
Windy _____
Rain _____
Fair _____
Snow _____
Hot _____
Moderate _____
Cold _____
Fog _____
Figured By _____
Notes Checked By _____
Plotted By _____

FILE No. 220-5
Fldr. No. _____
Sheet 8-01-5
Date 7-15-46

Quad. No. _____

Station	Dist.	Angle	"	+	H. I. Bearing	Ver: Ang. Diff.	Elevation
COR. "X"	83.55	351°	54' 15"				
COR. "W"	85.92	332°	38' 30"				
COR. "V"	72.98	336°	02' 30"				
COR. "U"	74.72	331°	02' 15"				
COR. "T"	35.60	238°	06' 30"				
COR. "S"	157.25	155°	15' 30"				
COR. "R"	113.90	157°	31' 15"				
COR. "Q"	110.10	137°	20' 15"				
COR. "P"	152.15	131°	30' 15"				
COR. "O"	32.00	114°	30' 15"				
COR. "N"	20.32	126°	49' 30"				
COR. "M"	26.97	115°	30' 00"				
COR. "L"	33.76	107°	47' 45"				
COR. "K"	84.74	100°	04' 45"				
COR. "J"	39.05	60°	44' 15"				
COR. "I"	14.72	14°	22' 15"				
COR. "H"	38.97	71°	58' 45"				
COR. "G"	59.38	71°	18' 30"				
COR. "F"	52.21	68°	04' 15"				
COR. "E"	26.38	57°	15' 45"				
COR. "D"	58.60	52°	15' 45"				
COR. "C"	96.96	19°	19' 30"				
COR. "B"	77.97	14°	02' 30"				
COR. "A"	73.73	7°	47' 45"				

L 9 A 10

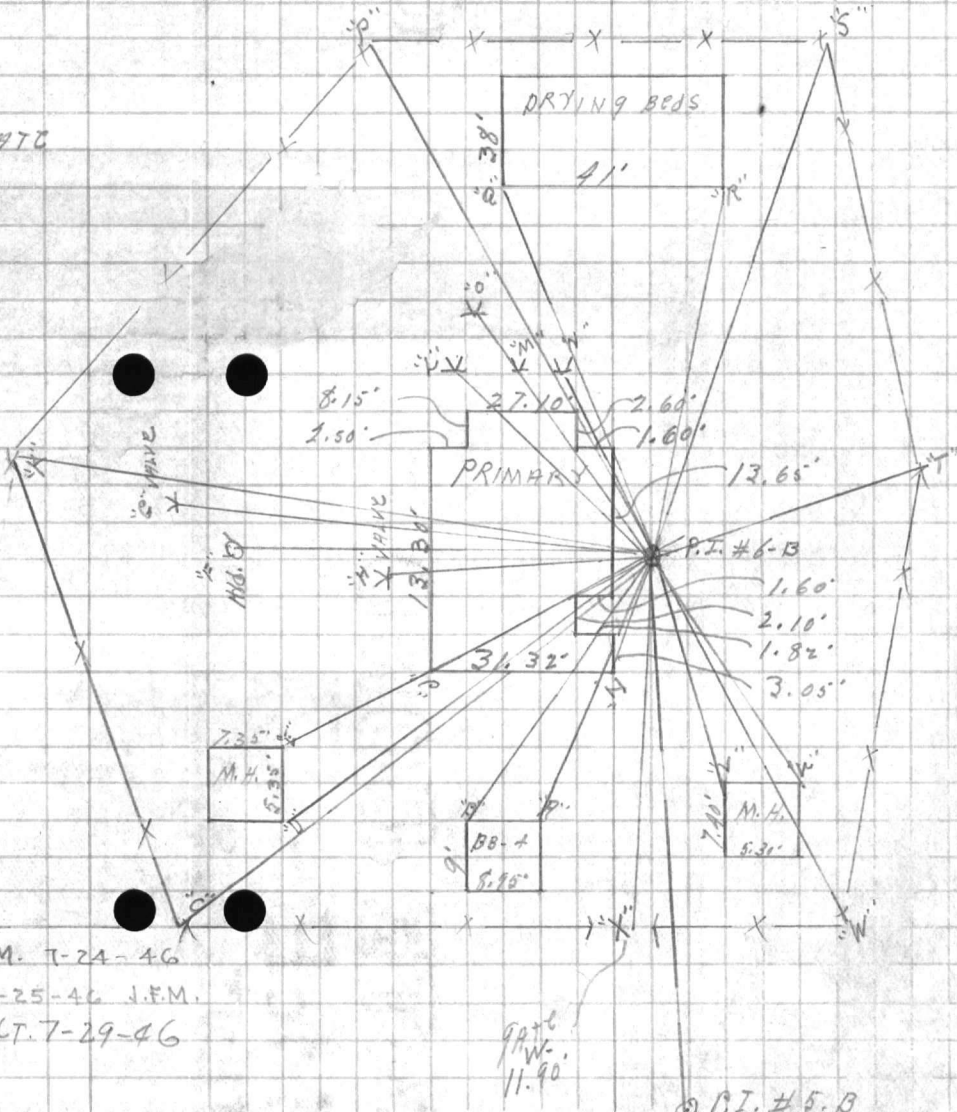

Plotted By: J.F.M. 7-24-46
Plotted C.B.G. 7-25-46 J.F.M.
Checked By: V.L.T. 7-29-46

9.10
W.
11.90

P.T. #5.B

P.T. #6-B
2773 60













VALUABLE

Return To
Public Works
Office
Camp Lejeune
North Carolina

SUBJECT Bldg. LOCATION AT COURT
HOUSE BAY

FIELD PARTY
KELLYN In Charge
Instrument _____
Notes _____
Tape Read _____
Tape or Rod _____
Tape or Rod _____
Instrument No. _____
Tape No. _____


WEATHER
Clear _____
Cloudy _____
Windy _____
Rain _____
Fair _____
Snow _____
Hot _____
Moderate _____
Cold _____
Fog _____
Figured By _____
Notes Checked By _____
Plotted By _____

FILE No. 220-K
Fldr. No. _____
Sheet d-0F5
Date 7-15-1946

Quad. No. _____

Station	Dist.	Angle " "	+	H. I. Bearing	Ver: Ang. Diff.	Elevation
---------	-------	--------------	---	------------------	--------------------	-----------

	502.51'					
P.I. #8-B	1-127° 05' 30"					
5+97.71'	3-21° 16' 30"					
MEAN-	127° 05' 30"					
	597.71'					
P.I. #7-B	1-263° 33' 15"					
2+97.60'	3-70° 39' 30"					
MEAN-	263° 33' 10"					
	281.6'					
P.I. #6-B	1-41° 26' 45"					
2+73.60'	3-13° 11' 30"					
MEAN-	41° 26' 30"					

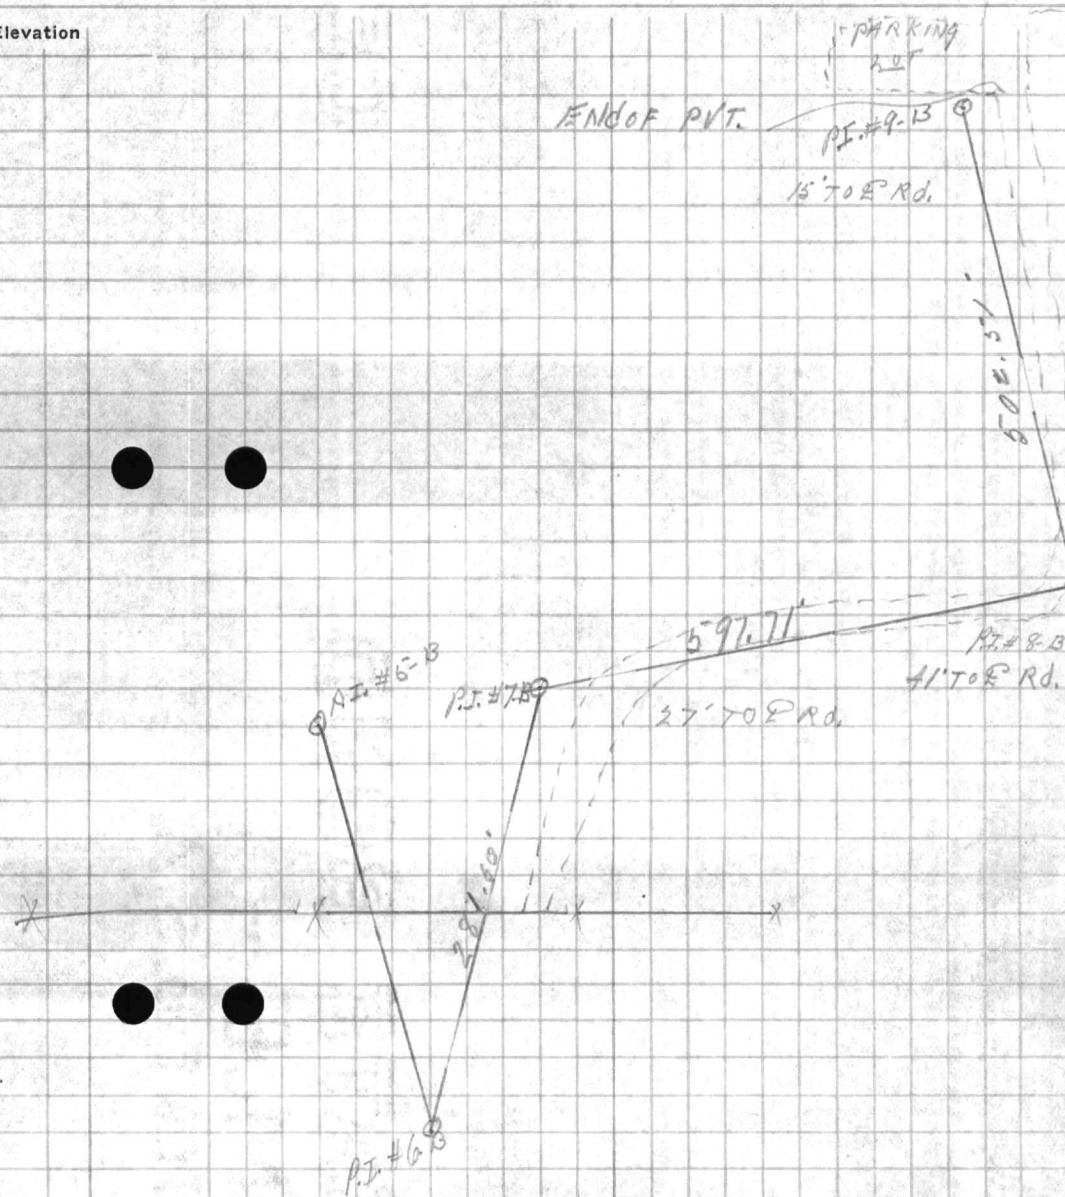












VALUABLE

SUBJECT Bldg. LOCATION COURT
HOUSEBAY.

Return To
Public Works
Office
Camp Lejeune
North Carolina


FIELD PARTY
KELLMAN In Charge
____ Instrument
____ Notes
____ Tape Read
____ Tape or Rod
____ Tape or Rod
____ Instrument No.
____ Tape No.

WEATHER
Clear _____
Cloudy _____
Windy _____
Rain _____
Fair _____
Snow _____
Hot _____
Moderate _____
Cold _____
Fog _____
Figured By _____
Notes Checked By _____
Plotted By _____

FILE No. 220-K
Fldr. No. _____
Sheet 5-0F5
Date 7-15 1946

Quad. No. _____

Station	Dist.	Angle ' "	+	H. I. Bearing	Ver: Ang. Diff.	Elevation
P.I. #4	1-	127° 02' 00"				
	3-	21° 06' 15"				
	MEAN-	127° 02' 05"				
P.I. #4B	1-	194° 57' 15"				
5702.57	3-	224° 52' 30"				
	MEAN-	194° 57' 30"				

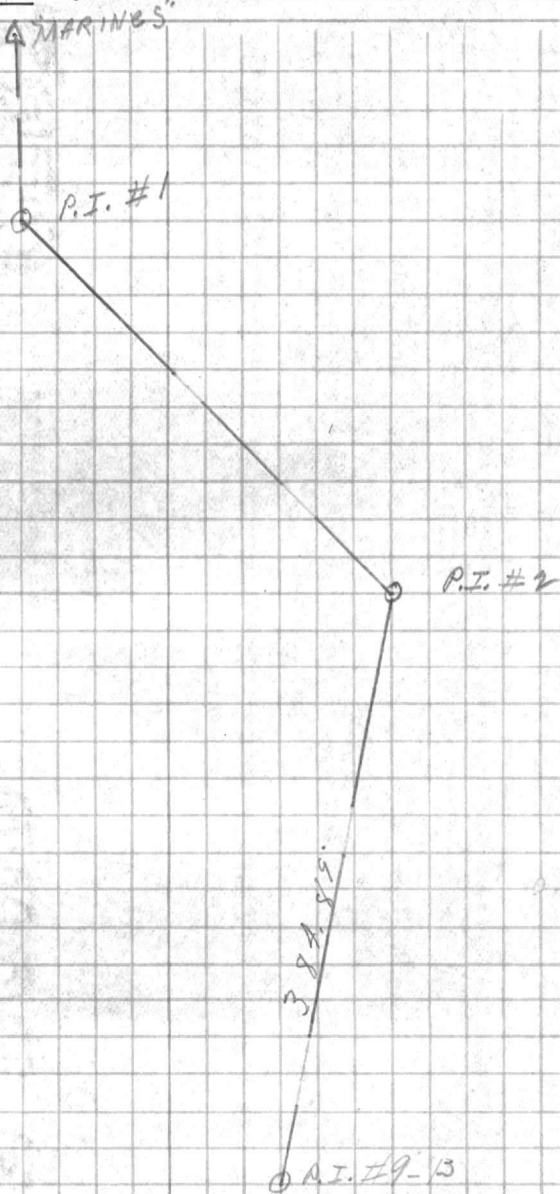

PUBLIC WORKS DEPARTMENT
Camp Lejeune, North Carolina
Survey Department

File 220-K
Quadrangle 220
Date 7/16/46
Sheet #2 of 3

Traverse Computation
Description

Building Co-ordinates - Engineer Batt. Area Sewage Treatment Plant.

Station	Distance	Bearing	Cosine	Sine	Latitude	Departure	X Coordinate North	X Coordinate East
P.I. #6 B from P.I. #5 B		N79°47'10"E					304,833.42	2,493,620.10
Cor. "A" Bldg. BB-4	73.73	S82°32'55"W	1296850	9915552	9.56	73.11	304,828.86	2,493,546.99
" " "B" " "	77.97	S88°50'40"W	0201669	9997966	1.57	77.95	304,831.85	2,493,542.15
Cor. "C" Fence	96.92	N86°53'20"W	0542724	9985262	5.26	96.78	304,838.78	2,493,523.82
" " "K" " "	84.74	N5°08'05"W	9959870	0894979	84.40	7.58	304,917.82	2,493,612.52
" " "P" " "	152.15	N31°17'25"E	8545470	5193241	130.02	79.02	304,963.44	2,493,699.12
" " "S" " "	157.25	N50°02'40"E	6421932	7665428	100.98	120.54	304,934.40	2,493,740.44
" " "T" " "	35.60	S97°06'20"E	6806498	7326089	24.23	26.08	304,809.19	2,493,646.18
" " "W" " "	85.92	S97°25'40"W	6765190	7364252	58.13	63.27	304,775.29	2,493,556.78
"X" Center of 12' Gate	83.55	S66°41'25"W	3957013	9183792	33.06	76.73	304,800.36	2,493,543.27
Cor. "D" of Manhole	58.60	N52°47'05"W	6048115	7963687	35.44	46.67	304,868.86	2,493,573.43
" " "E" " "	56.38	N47°57'05"W	6697609	7425768	37.76	41.87	304,871.18	2,493,578.23
"F" Hydrant	52.21	N37°08'35"W	7971304	6038072	41.62	31.52	304,875.04	2,493,588.58
"G" Valve	59.38	N33°56'20"W	8296335	5583083	49.26	33.15	304,882.88	2,493,586.95
H Valve	38.97	N33°14'05"W	8364323	5480702	32.60	21.36	304,866.02	2,493,598.74
Cor. "I" Primary Tank	14.72	S89°16'25"W	0126775	9999196	0.19	14.72	304,833.23	2,493,605.38
" " "J" " "	39.65	N44°58'35"W	7073991	7068153	28.05	28.02	304,861.47	2,493,592.08
"L"	33.76	N2°36'55"E	9989584	0456294	33.72	1.54	304,867.14	2,493,621.64
"M"	26.97	N10°17'10"E	9839283	1785637	26.54	4.82	304,859.96	2,493,624.82
"N"	20.22	N23°36'40"E	9162851	4005267	18.53	8.10	304,851.95	2,493,628.20
"O"	32.60	N9°17'25"E	9868831	1614364	32.17	5.26	304,865.59	2,493,625.36

Plotted By: J.F.M. 7-24-46
CHECKED BY: VLT 7-29-46

Plotted C.E.G. 7-25-46 J.F.M.

