

VALUABLE

RETURN TO
PUBLIC WORKS
OFFICE
CAMP LEJEUNE
NORTH CAROLINA

SUBJECT TELEPHONE LINE LOCATION
ALONG MILE HANNOCK BAY
ROAD FROM SNEADS FERRY
ROAD

FIELD PARTY

____ IN CHARGE
____ INSTRUMENT
____ NOTES
____ TAPE READ
____ TAPE OR ROD
____ TAPE OR ROD
____ INSTRUMENT No.
____ TAPE No.

WEATHER

CLEAR
CLOUDY
WINDY
RAIN
FAIR

SNOW
HOT
MODERATE
COLD
FOG

FILE No. 220-0

FLDR. No. _____

SHEET # 1

FIGURED BY _____
NOTES CHECKED BY _____
PLOTTED BY _____
DATE 12-28-1959

Quad. No. _____

STATION	DIST.	ANGLE ° ' "	H. I. BEARING	VER: ANG. DIFF.	ELEVATION
---------	-------	----------------	------------------	--------------------	-----------

Match 8 →



S.F. Rd.

TO C.H.
Bay →

Match 8 →

TO MILE
HANNOCK BAY →


24.8' 17

121.5' 16
118' 15
118' 14
118' 13
119.5' 12
118' 11
117.5' 10
117' 9
122' 8
111' 11
94.5' 11
34' 11
35' 10
25' 12




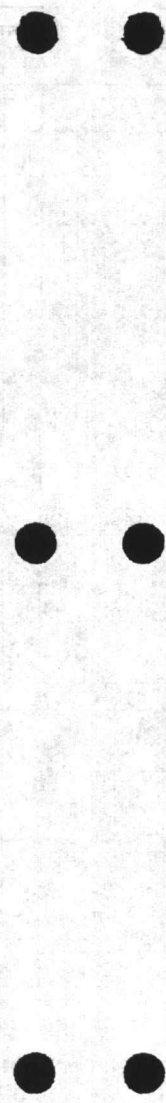

100

VALUABLE

SUBJECT TEL. LINE LOC. CONTD.

RETURN TO
PUBLIC WORKS
OFFICE
CAMP LEJEUNE
NORTH CAROLINA

FIELD PARTY

____ IN CHARGE
____ INSTRUMENT
____ NOTES
____ TAPE READ
____ TAPE OR ROD
____ TAPE OR ROD
____ INSTRUMENT NO.
____ TAPE NO.

WEATHER

____ CLEAR
____ CLOUDY
____ WINDY
____ RAIN
____ FAIR
____ SNOW
____ HOT
____ MODERATE
____ COLD
____ FOG

FILE No. _____


FLDR. No. _____

SHEET # 2

DATE 12-28-1959

NOTES CHECKED BY _____
PLOTTED BY _____
Quad. No. _____

STATION	DIST.	ANGLE " "	H. I. BEARING	VER. ANG. DIFF.	ELEVATION
---------	-------	--------------	------------------	--------------------	-----------

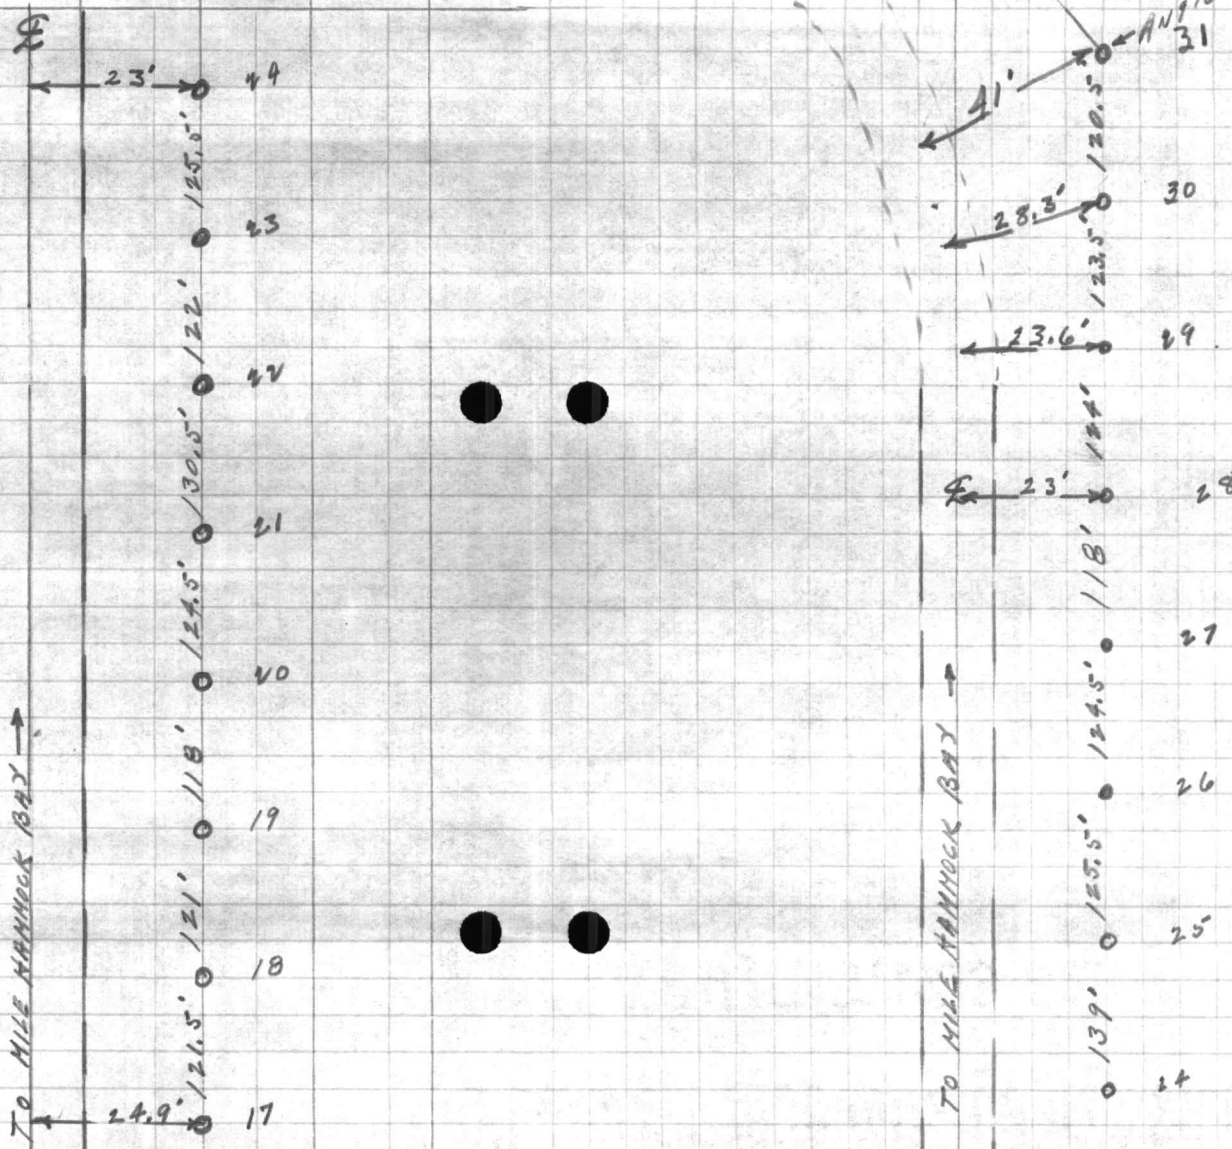

TO MILE HAMMOCK BAY →

TO MILE HAMMOCK BAY →

ANGLE pole to left.








VALUABLE

RETURN TO
PUBLIC WORKS
OFFICE
CAMP LEJEUNE
NORTH CAROLINA

SUBJECT TEL. LINE LOCATION
CONTINUED

FIELD PARTY

____ IN CHARGE
____ INSTRUMENT
____ NOTES
____ TAPE READ
____ TAPE OR ROD
____ TAPE OR ROD
____ INSTRUMENT No.
____ TAPE No.

WEATHER

CLEAR
CLOUDY
WINDY
RAIN
FAIR

SNOW
HOT
MODERATE
COLD
FOG

FILE No. _____

FLDR. No. _____

SHEET #3

FIGURED BY _____

NOTES CHECKED BY _____

PLOTTED BY _____

DATE 12-29 1959

Quad No. _____


STATION	DIST.	ANGLE ° ' "	H. I. BEARING	VER. ANG. DIF.	ELEVATION
---------	-------	----------------	------------------	-------------------	-----------

STATION	DIST.	ANGLE ° ' "	H. I. BEARING	VER. ANG. DIF.	ELEVATION
47					
46			114'		
45			108'		
44			110'		
43			115'		
42			112.5'		
41			114'		
40	25.5'		115'		
39			119.5'		

↑ TO MILE HAMMOCK BAY

--- dirt Rd. ---

MATCH

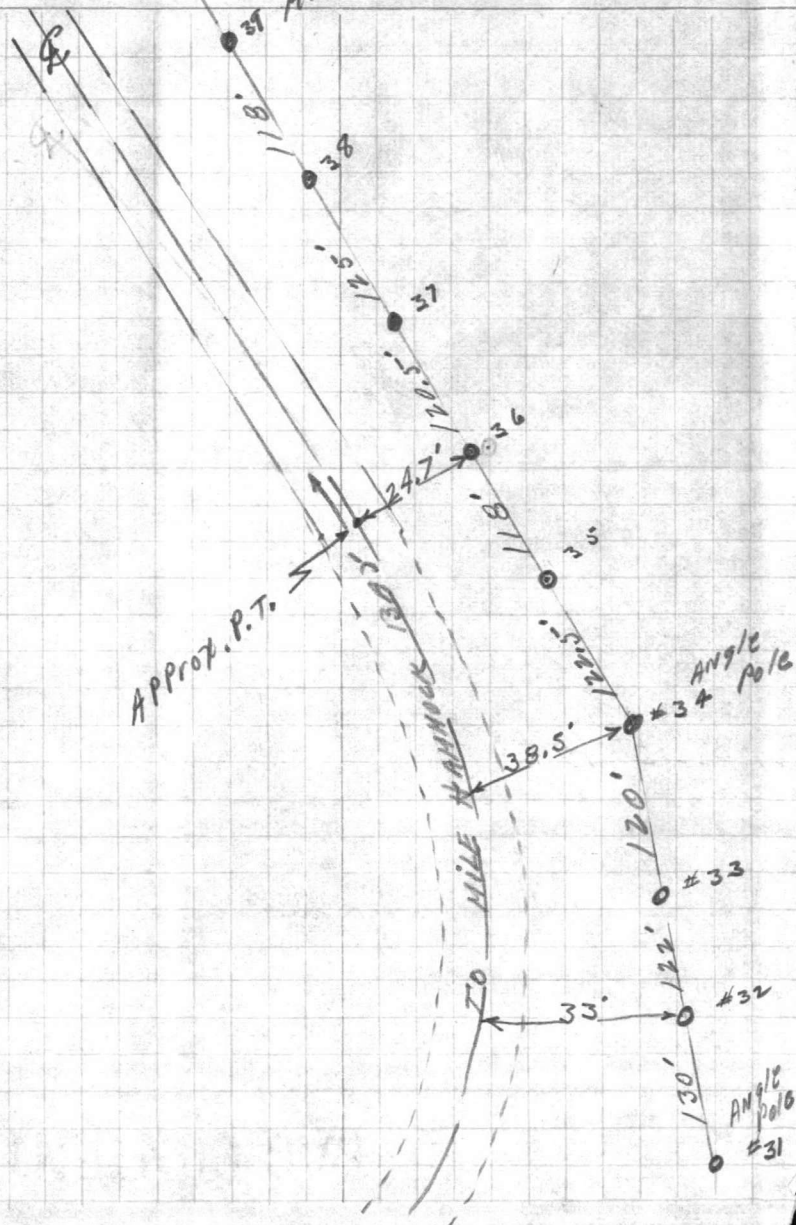



























VALUABLE

SUBJECT TEL. LINE LOG. CONTD.

RETURN TO
PUBLIC WORKS
OFFICE
CAMP LEJEUNE
NORTH CAROLINA

FIELD PARTY

IN CHARGE

INSTRUMENT

NOTES

TAPE READ

TAPE OR ROD

TAPE OR ROD

INSTRUMENT NO.

TAPE NO.

WEATHER

CLEAR
CLOUDY
WINDY
RAIN
FAIR
SNOW
HOT
MODERATE
COLD
FOG
FIGURED BY _____
NOTES CHECKED BY _____
PLOTTED BY _____

FILE No. _____


FLDR. No. _____

SHEET #4

DATE 12-29 1959

Quad. No. _____

STATION DIST. ANGLE
 ° ' ''
H. I. VER: ANG. ELEVATION
BEARING DIFF.

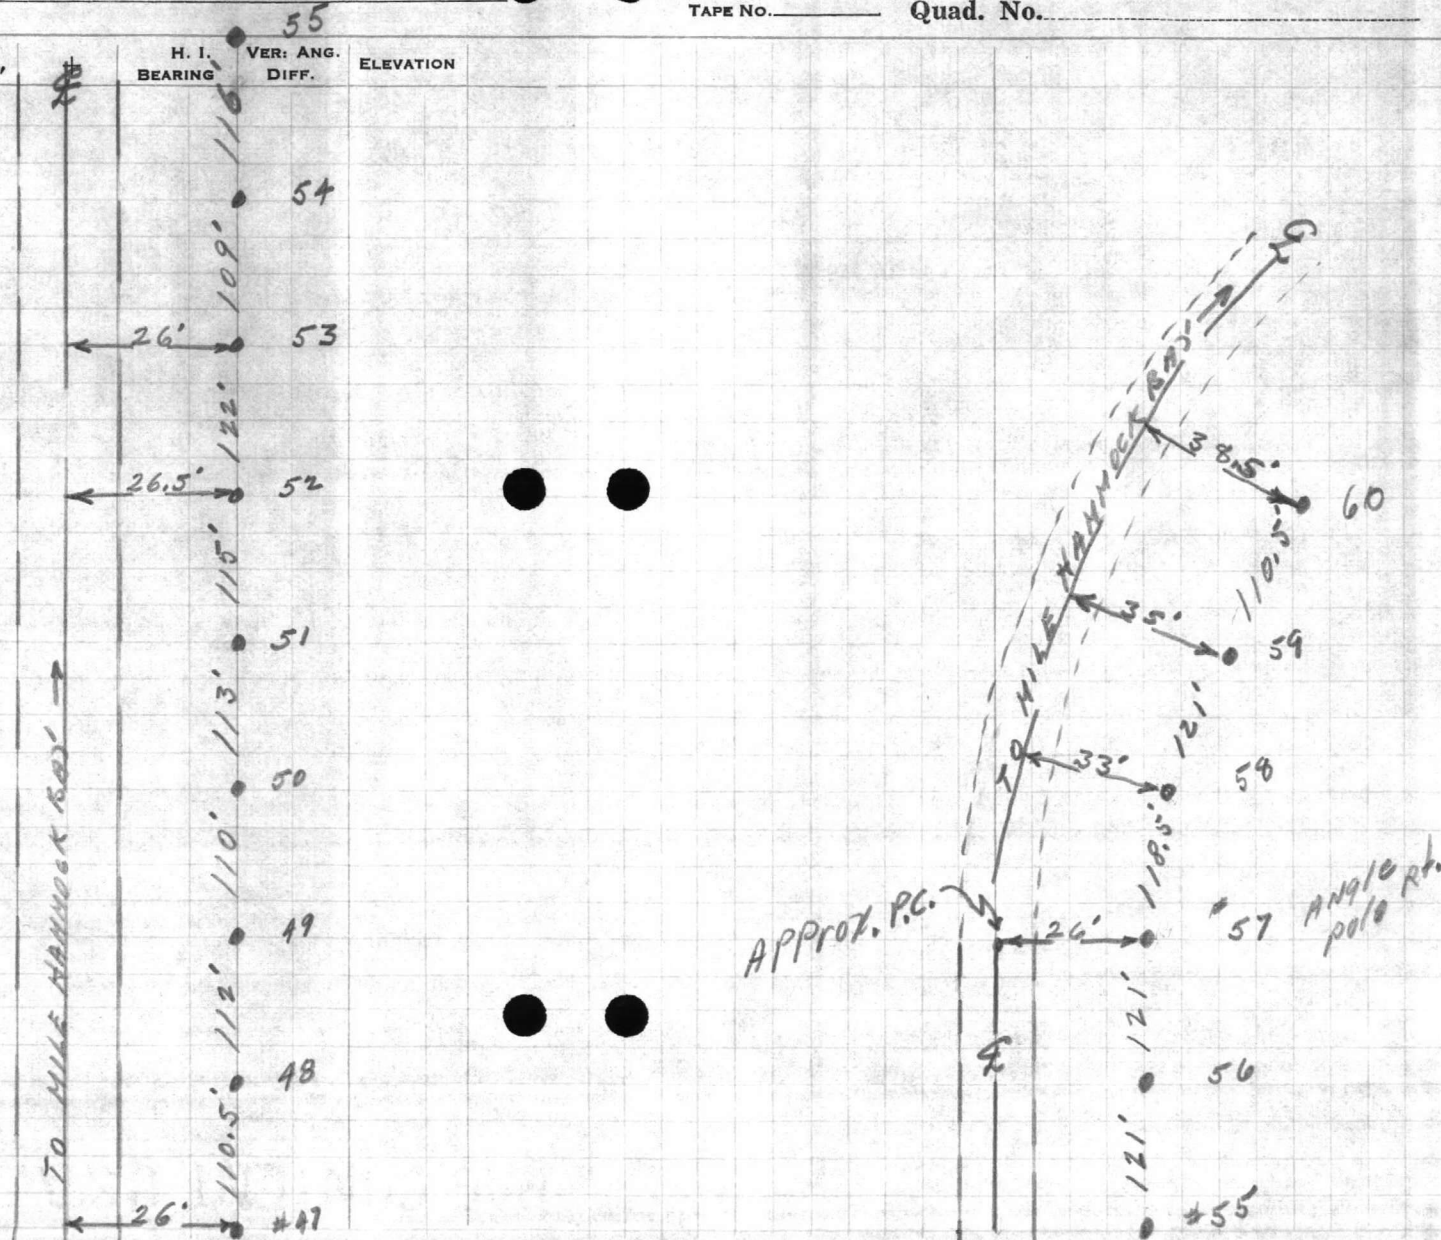








VALUABLE

SUBJECT TEL. LINE LOG. CONTD.

RETURN TO
PUBLIC WORKS
OFFICE
CAMP LEJEUNE
NORTH CAROLINA

FIELD PARTY

____ IN CHARGE
____ INSTRUMENT
____ NOTES
____ TAPE READ
____ TAPE OR ROD
____ TAPE OR ROD
____ INSTRUMENT NO.
____ TAPE NO.

WEATHER

CLEAR
CLOUDY
WINDY
RAIN
FAIR
SNOW
HOT
MODERATE
COLD
FOG
FIGURED BY _____
NOTES CHECKED BY _____
PLOTTED BY _____

FILE No. 121


FLDR. No. _____

SHEET #5

DATE 12-29 1959

Quad. No. _____

STATION	DIST.	ANGLE ° ' "	H. I. BEARING	VER: ANG. DIFF.	ELEVATION
---------	-------	----------------	------------------	--------------------	-----------

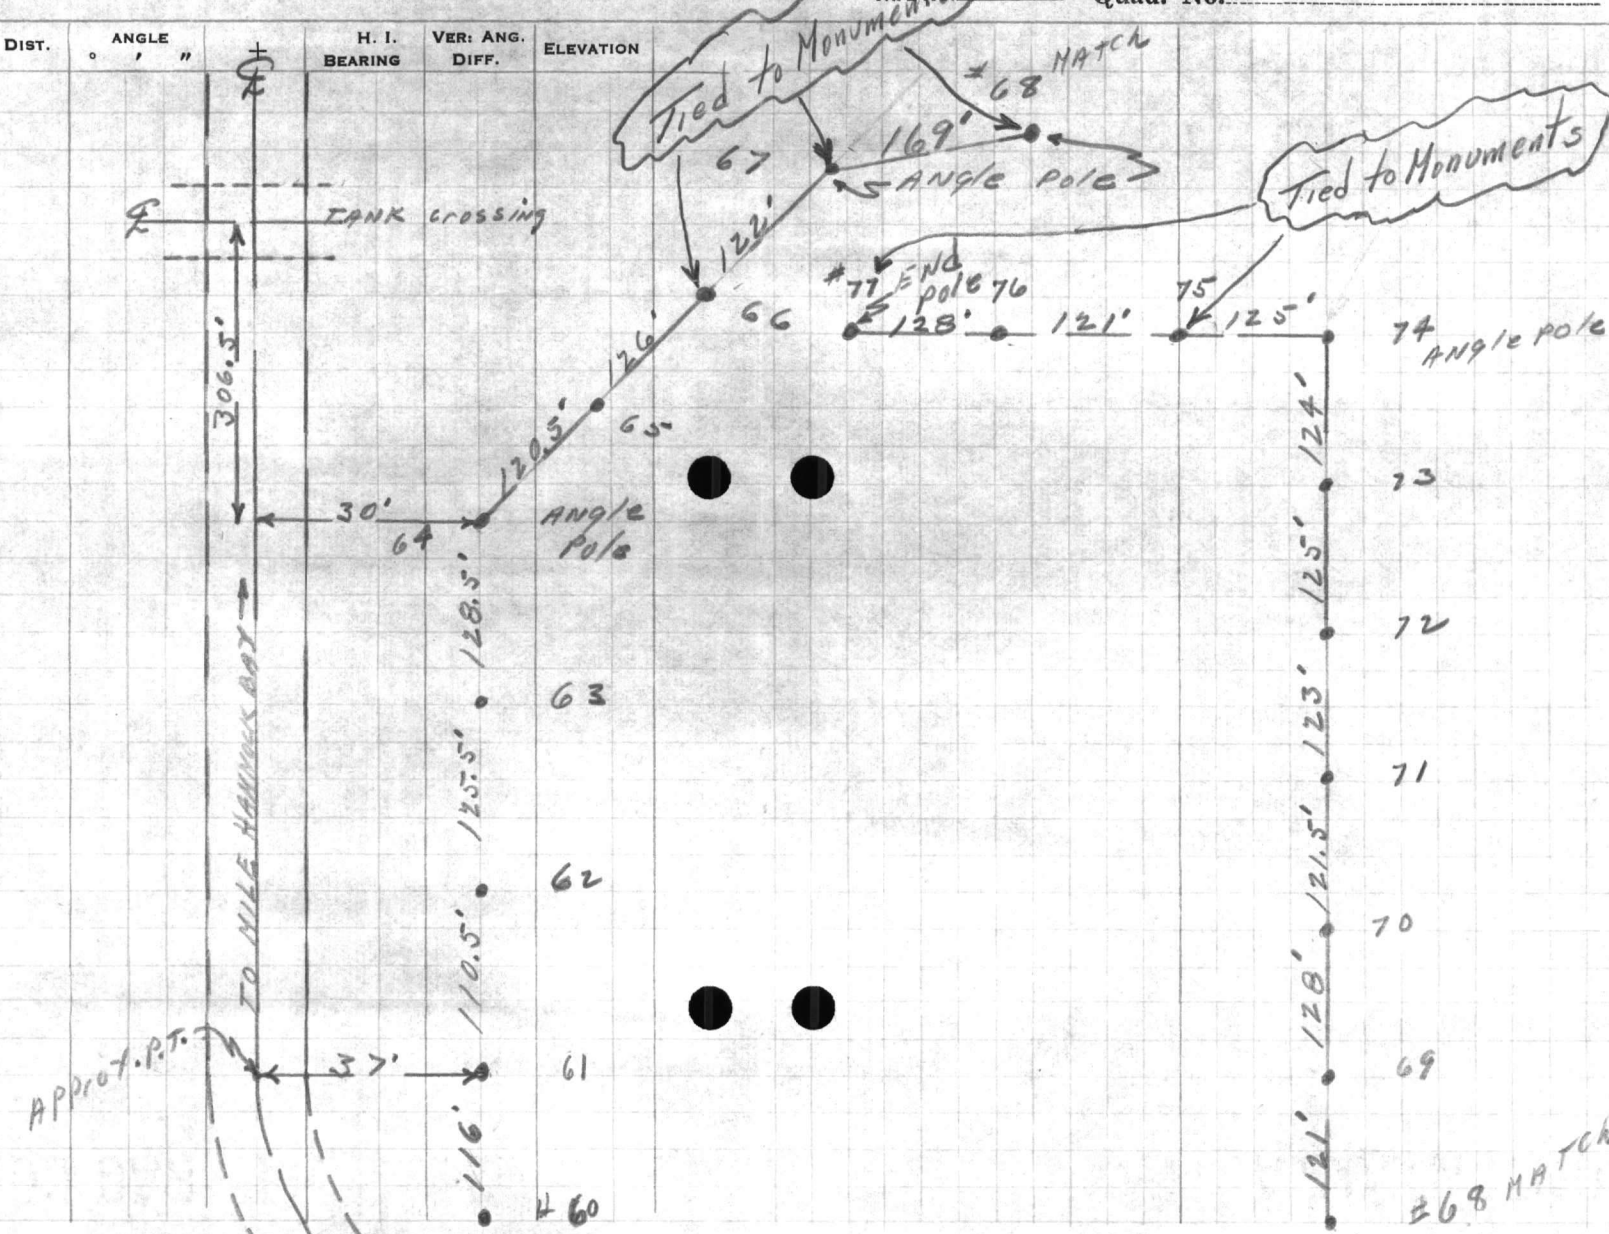

APPROX. P.T.


Tied to Monuments

Tied to Monuments

#68 MATCH

74 ANGLE POLE

ANGLE POLE

#77 END POLE 76

ANGLE POLE

RANK CROSSING

#68 MATCH
































VALUABLE

SUBJECT T.C.L. LINE LOG, CONTD.

RETURN TO
PUBLIC WORKS
OFFICE
CAMP LEJEUNE
NORTH CAROLINA

FIELD PARTY

____ IN CHARGE
____ INSTRUMENT
____ NOTES
____ TAPE READ
____ TAPE OR ROD
____ TAPE OR ROD
____ INSTRUMENT No.
____ TAPE No.

WEATHER

CLEAR
CLOUDY
WINDY
RAIN
FAIR
SNOW
HOT
MODERATE
COLD
FOG
FIGURED BY _____
NOTES CHECKED BY _____
PLOTTED BY _____

FILE No. _____

FLDR. No. _____

SHEET # 6

DATE 12-29-59


Quad. No. _____

STATION	DIST.	ANGLE " +	H. I. BEARING	VER: ANG. DIFF.	ELEVATION
---------	-------	--------------	------------------	--------------------	-----------

T MON. #2
R. S. MON. #1
Pole # 5208' 334° 08' 30"
Pole # 77244' 40° 11'
END POLE

TO INLAND WATER WAY

NOTE:
ALL ANGLES
CLOCKWISE

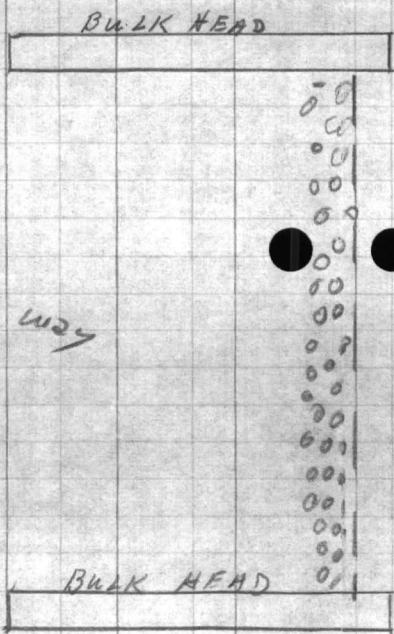

T MON. #1
R. S. MON. #2
Pole # 68430' 31° 17'
Pole # 67389' 54° 13' 30"
Pole # 66455' 68° 10'

MON. #2

MON. #1












