

VALUABLE

SUBJECT

Traverse from Marine
to San worth to fire
Power line Down

Return To
Public Works
Office
Camp Lejeune
North Carolina

FIELD PARTY

Tullington In Charge
Instrument
Notes
Tape Read
Tape or Rod
Tape or Rod
Instrument No.
Tape No.

WEATHER

Clear
Cloudy
Windy
Rain
Fair
Snow
Hot
Moderate
Cold
Fog
Figured By
Notes Checked By
Plotted By

FILE No. ^{220-P} ~~219-0~~

Fldr. No.


Sheet 1-6

Date 8-14 1947

Quad. No. 219-220

Station	Dist.	Angle "	+	H. I. Bearing	Ver. Ang. Diff.	Elevation
③	684	323.59.30				
2	1510	192.07				
1	930	68.0				
PI#2	638.94 Grid +0.08			88°		
	638.90					
	261.4645 65.2030 261.4650 M					
PI#1	347.98 Grid +0.04			88°		
	347.96					
	101.3015 304.31 101.3020 M					
T on DSN #1				N 305,267.91 E 2,491,782.86		

Primary line
2#6 Wires

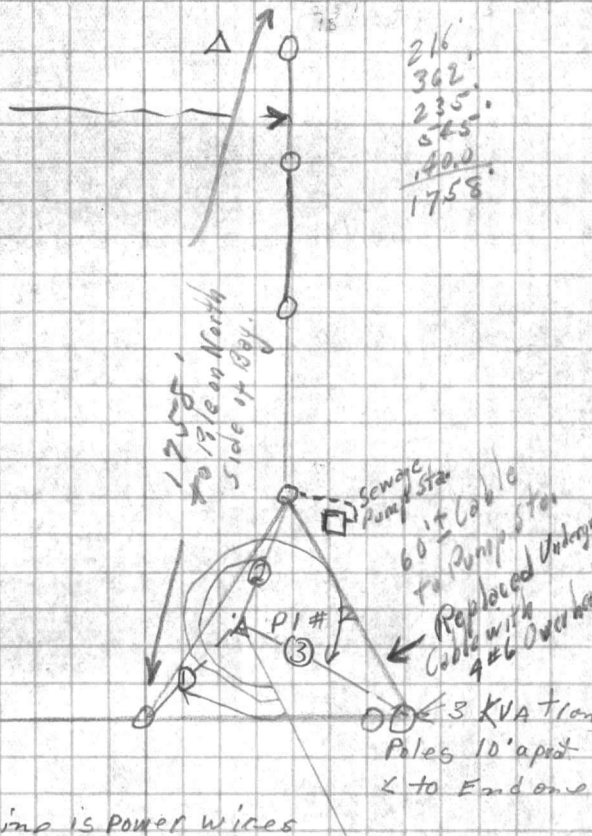

BS Fire tower at Smeal Ferry Bridge

576°46'40"E



































VALUABLE

SUBJECT _____

Return To
Public Works
Office
Camp Lejeune
North Carolina

FIELD PARTY

____ In Charge
____ Instrument
____ Notes
____ Tape Read
____ Tape or Rod
____ Tape or Rod
____ Instrument No.
____ Tape No.

WEATHER

Clear
Cloudy
Windy
Rain
Fair

Snow
Hot
Moderate
Cold
Fog

FILE No. _____

Fldr. No. _____

Figured By _____

Sheet 2-6


Notes Checked By _____

Plotted By _____

Date _____ 19__

Quad. No. _____

Station	Dist.	Angle "	+	H. I. Bearing	Ver: Ang. Diff.	Elevation
PI #5	418.03	+0.06		418.07 Grid 92°		
	197.16	00		M		56-30 W
(2)	5.70	180	00			
PI 4	497.54			92°		
	226.27	15		M		58-45 E
(1)	54.90	5	41 30	P0/4		
PI #3	801.11			92		
	190.00	30				
	210.02					
	190.00	40				

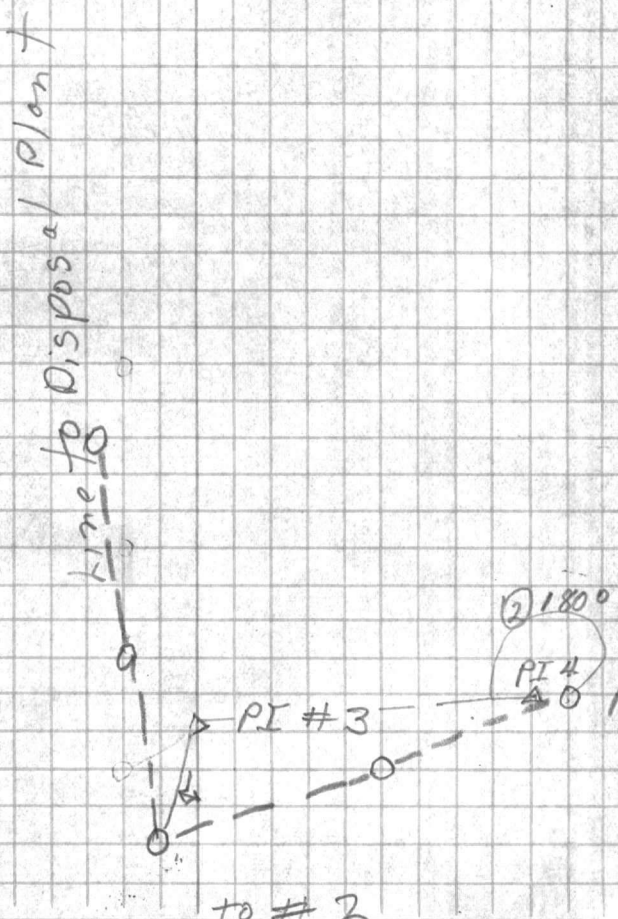


















VALUABLE

SUBJECT _____

Return To
Public Works
Office
Camp Lejeune
North Carolina

FIELD PARTY

____ In Charge
____ Instrument
____ Notes
____ Tape Read
____ Tape or Rod
____ Tape or Rod
____ Instrument No.
____ Tape No.

WEATHER

Clear
Cloudy
Windy
Rain
Fair

Snow
Hot
Moderate
Cold
Fog

Figured By _____
Notes Checked By _____
Plotted By _____

FILE No. _____

Fldr. No. _____


Sheet 3-6

Date _____ 19____

Quad. No. _____

I#7

Station	Dist.	Angle "	+	H. I. Bearing	Ver: Ang. Diff.	Elevation
PI#7	312.56	199 50 15		86		
		239 30 45				
		199 50 15 M				
B	50.20	2 35 15				
PI#6	920 ±	162 10		S 12° 15' E		
		126 30				
		162 10 M				
A	1250	13 22				

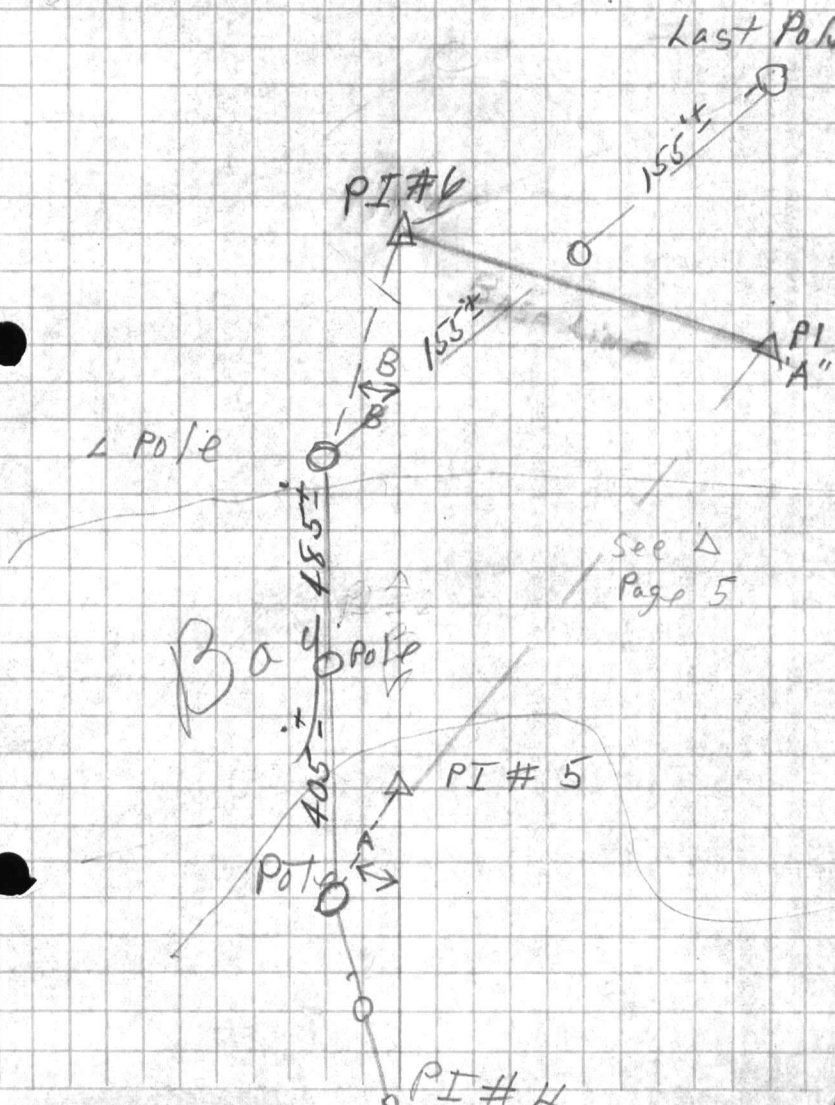

















VALUABLE

SUBJECT _____

Return To
Public Works
Office
Camp Lejeune
North Carolina

FIELD PARTY

_____ In Charge
_____ Instrument
_____ Notes
_____ Tape Read
_____ Tape or Rod
_____ Tape or Rod
_____ Instrument No.
_____ Tape No.

WEATHER

Clear _____
Cloudy _____
Windy _____
Rain _____
Fair _____
Snow _____
Hot _____
Moderate _____
Cold _____
Fog _____
Figured By _____
Notes Checked By _____
Plotted By _____

FILE No. _____

Fldr. No. _____

Sheet 4-6

Date _____ 19____

Quad. No. _____

Station	Dist.	Angle " "	+	H. I. Bearing	Ver: Ang. Diff.	Elevation
---------	-------	--------------	---	------------------	--------------------	-----------

Fire Tower Smead Ferry Bridge

N 307, 619.54 E 2,481,774.23

231 34 45
334 44 15
111 34 45 M

230.29 Grid
+0.03

San worth
230 27

88°

N 302, 836.48 E 2,493,469.88

238 23 45
355 10 45
238 23 35 M




















VALUABLE

SUBJECT _____

Return To
 Public Works
 Office
 Camp Lejeune
 North Carolina

FIELD PARTY

_____ In Charge
 _____ Instrument
 _____ Notes
 _____ Tape Read
 _____ Tape or Rod
 _____ Tape or Rod
 _____ Instrument No.
 _____ Tape No.

WEATHER

Clear
 Cloudy
 Windy
 Rain
 Fair

Snow
 Hot
 Moderate
 Cold
 Fog

FILE No. _____

Fldr. No. _____

Sheet 5-6

Figured By _____


Notes Checked By _____

Plotted By _____

Date _____ 19____

Quad. No. _____

Station	Dist.	Angle "	+	H. I. Bearing	Ver: Ang. Diff.	Elevation
Tat 'X' Bs on PI # 6 to pole in Bay						
		47 41				
		143 03				
		47 41				
C		9 58 15				
		29 54 30				
		9 58 10				
B		53 29 30				
		160 29				
		53 29 40				
A		116 32 30				
		349 37 15				
		116 32 25				

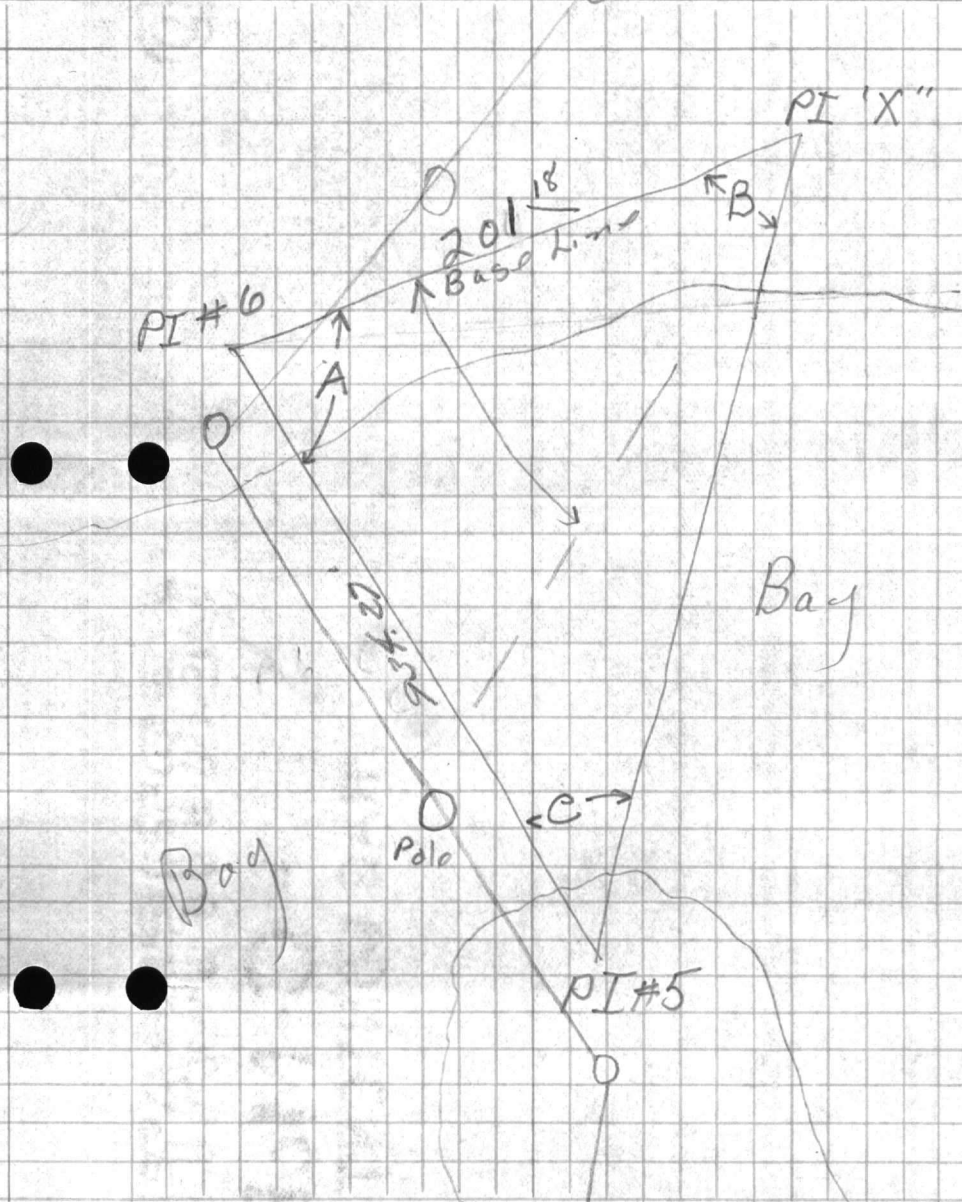














VALUABLE

SUBJECT _____

Return To
Public Works
Office
Camp Lejeune
North Carolina

FIELD PARTY

____ In Charge
____ Instrument
____ Notes
____ Tape Read
____ Tape or Rod
____ Tape or Rod
____ Instrument No.
____ Tape No.

WEATHER

Clear
Cloudy
Windy
Rain
Fair
Snow
Hot
Moderate
Cold
Fog
Figured By _____
Notes Checked By _____
Plotted By _____

FILE No. _____

Fldr. No. _____



Sheet 6-6

Date _____ 19____

Quad. No. _____

Station	Dist.	Angle "	+	H. I. Bearing	Ver: Ang. Diff.	Elevation
PI 7 L to Right	BS	PI 6				
A	32 ⁴⁵	46		48	30	
B	34 ⁰	67		09		
C	45 ⁸²	95		25	15	
D	65 ²⁰	110		31	15	
E	57 ⁵⁵	252		49	30	
F	71 ²⁰	277		27		
G	136 ²⁰	341		39		
H	146 ⁴⁵	349		50	30	
I	115 ⁵⁰	310		50		

Last pole as shown on page 3

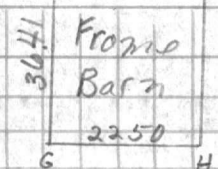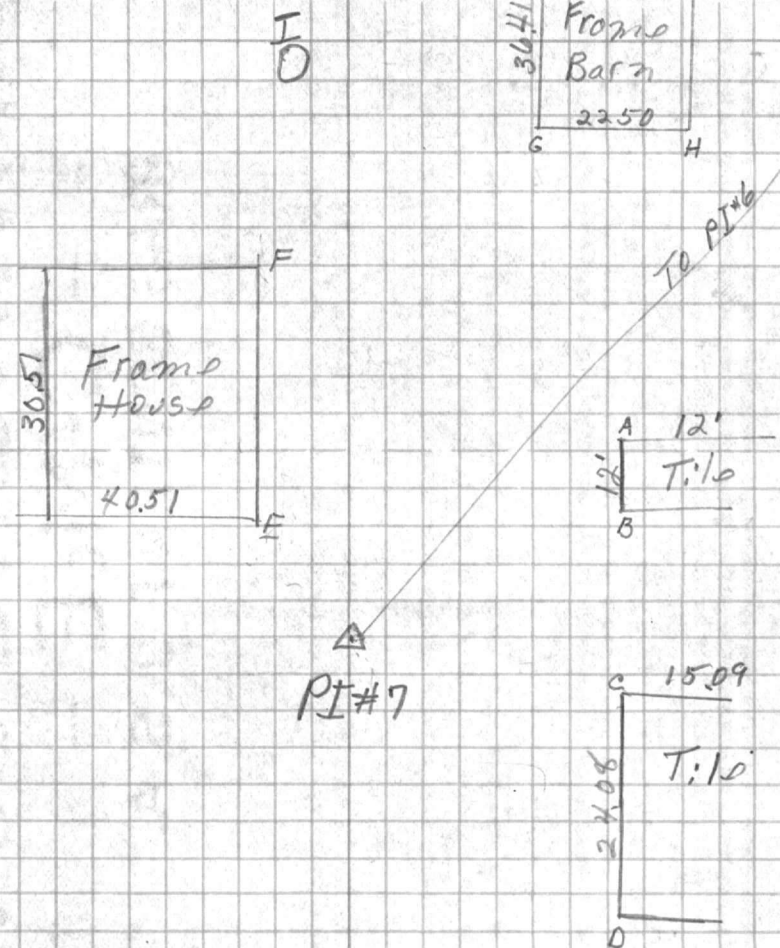








