

VALUABLE

SUBJECT TRAVERSE FOR PROPOSED
PIER SITE AT ONSLOW
BEACH.

RETURN TO
PUBLIC WORKS
OFFICE
CAMP LEJEUNE
NORTH CAROLINA

FIELD PARTY

KEITH IN CHARGE
____ INSTRUMENT
____ NOTES
____ TAPE READ
____ TAPE OR ROD
____ TAPE OR ROD
____ INSTRUMENT NO.

WEATHER

CLEAR
CLOUDY
WINDY
RAIN
FAIR

SNOW
HOT
MODERATE
COLD
FOG

FILE No. 241-C

FLDR. No. _____


FIGURED BY _____ SHEET 1-0F

NOTES CHECKED BY _____

PLOTTED BY _____ DATE 1-23 1959

TAPE No. 158.37 Quad. No. P.I. #2

STATION	DIST.	ANGLE ° ' "	H. I. BEARING	VER. ANG. DIFF.	ELEVATION
P.I. #2	1-	92° 59' 15"			
TO Hub	3-	278° 57' 00"			
ON BEACH	MEAN	92° 59' 00"			
Profile Line					
P.I. #2	1-	0° 44' 00"			
to water	3-	2° 12' 00"			
TANK	MEAN	0° 44' 00"			
P.O.T.					1789.14'
P.I. #1	1-	174° 44' 30"			
	3-	164° 15' 45"			
	MEAN	174° 44' 35"			
					1452.19'
					Mag: 557° 30' W
U.S.N. MON.	1-	182° 59' 45"			
#40	3-	188° 59' 15"			
	MEAN	182° 59' 45"			

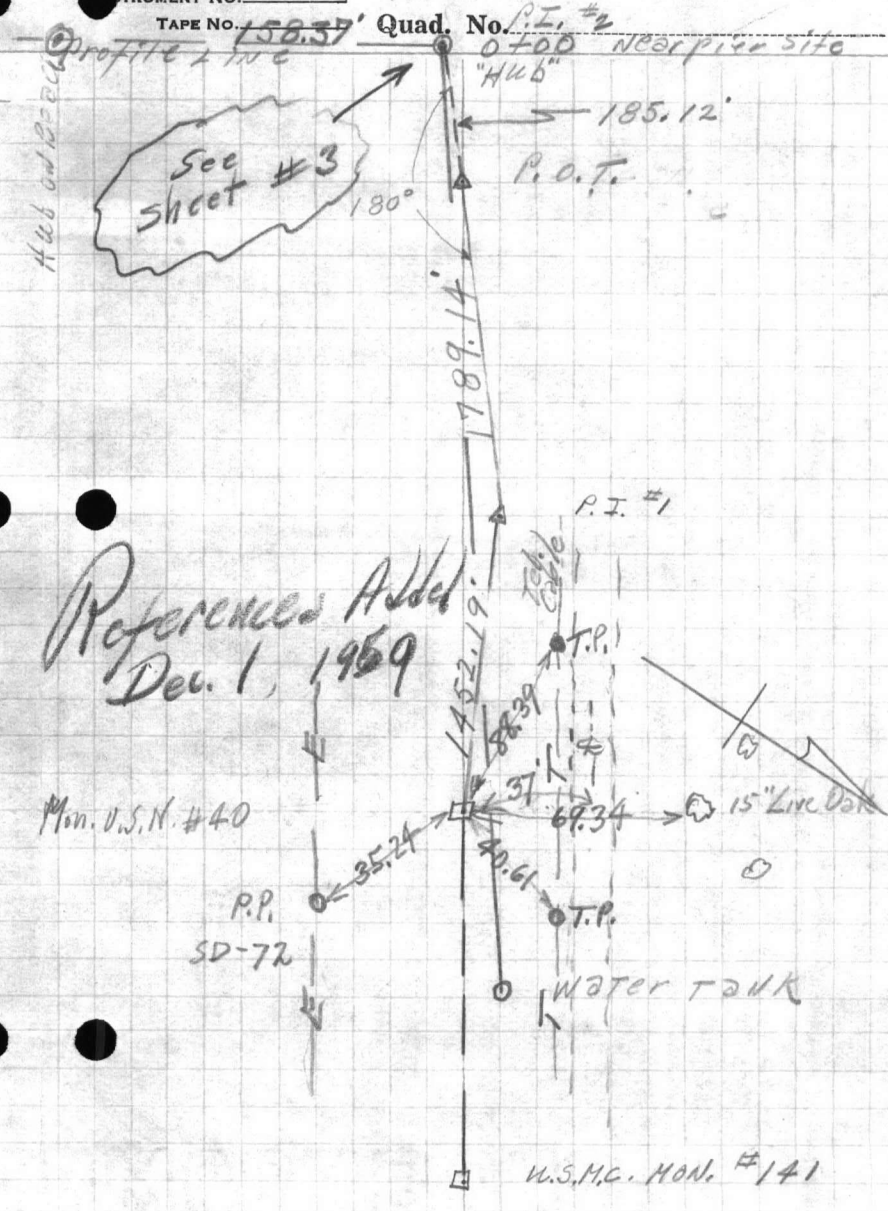

VALUABLE

SUBJECT BENCH LEVELS AND
Profile on Proposed Pier
Site - on Show Beach

RETURN TO
PUBLIC WORKS
OFFICE
CAMP LEJEUNE
NORTH CAROLINA

FIELD PARTY

____ IN CHARGE
____ INSTRUMENT
____ NOTES
____ TAPE READ
____ TAPE OR ROD
____ TAPE OR ROD
____ INSTRUMENT NO.
____ TAPE NO.

WEATHER

CLEAR _____ SNOW _____
CLOUDY _____ HOT _____
WINDY _____ MODERATE _____
RAIN _____ COLD _____
FAIR _____ FOG _____

FIGURED BY _____
NOTES CHECKED BY _____
PLOTTED BY _____

FILE No. _____

FLDR. No. _____

SHEET 2-07

DATE 1-23 1917

Quad. No. _____

STATION	DIST.	ANGLE ° ' "	+	H. I. BEARING	VER. ANG. DIFF.	ELEVATION
B.M.						6.47
			3.75	10.22		
T.P.			4.30	11.14	3.38	6.84
T.P.			7.81	13.67	5.28	5.86
T.P.			3.61	14.60	2.68	10.99
T.P.			3.90	13.68	4.82	9.78
T.P.			3.45	11.71	5.42	8.26
T.P.			7.54	13.94	5.31	6.40
B.M.			4.38	12.67	5.65	8.29
0+0				(12.7)	5.6	7.1
+18					4.8	7.9
+48					5.3	7.4
+56					3.6	9.1
+74					1.8	10.9
+95					3.9	8.8
1+34					4.2	8.5
1+58.37 Hub					5.6	7.1
2+					7.0	5.7
+31					8.2	4.5
+53					9.6	3.1
3+					11.7	1.0
+17					12.3	0.4
T.P. (B.M.)					4.38	8.29

U.S.N. MON. #40

47 - falls 2.1
1.6 x 47
2.1 / 1.6 = 1.3125
2.1 / 1.5 = 1.4
2.1 / 1.4 = 1.5
2.1 / 1.3125 = 1.6


spike in telephone pole 30' northerly from 0+00

1+58

Wash Line or Wave Wash.

Mean High Water Elev. = +1.5'

Edge of water at 3:20 P.M.

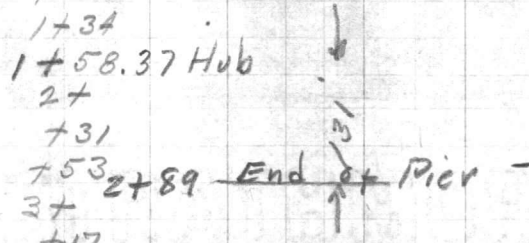




































VALUABLE

SUBJECT

BENCH LEVELS contd.

RETURN TO
PUBLIC WORKS
OFFICE
CAMP LEJEUNE
NORTH CAROLINA

FIELD PARTY

____ IN CHARGE
____ INSTRUMENT
____ NOTES
____ TAPE READ
____ TAPE OR ROD
____ TAPE OR ROD
____ INSTRUMENT NO.
____ TAPE NO.

WEATHER

CLEAR SNOW
CLOUDY HOT
WINDY MODERATE
RAIN COLD
FAIR FOG
FIGURED BY _____
NOTES CHECKED BY _____
PLOTTED BY _____

FILE No. _____

FLDR. No. _____

SHEET

3-01


DATE

1-23 1959

Quad. No. _____

STATION	DIST.	ANGLE ° ' "	+	H. I. BEARING	VER: ANG. DIFF.	ELEVATION
						8.29
T.P.		5.85	14.14		7.74	6.40
T.P.		5.14	11.54		3.28	8.26
T.P.		5.56	13.82		4.05	9.77
T.P.		5.17	14.94		3.99	10.95
T.P.		2.65	13.60		7.68	5.92
T.P.		4.91	10.83		4.36	6.47
T.P.		3.62	10.09		3.59	6.50
B.M.					3.59	6.50

U.S.N. MON. # 40

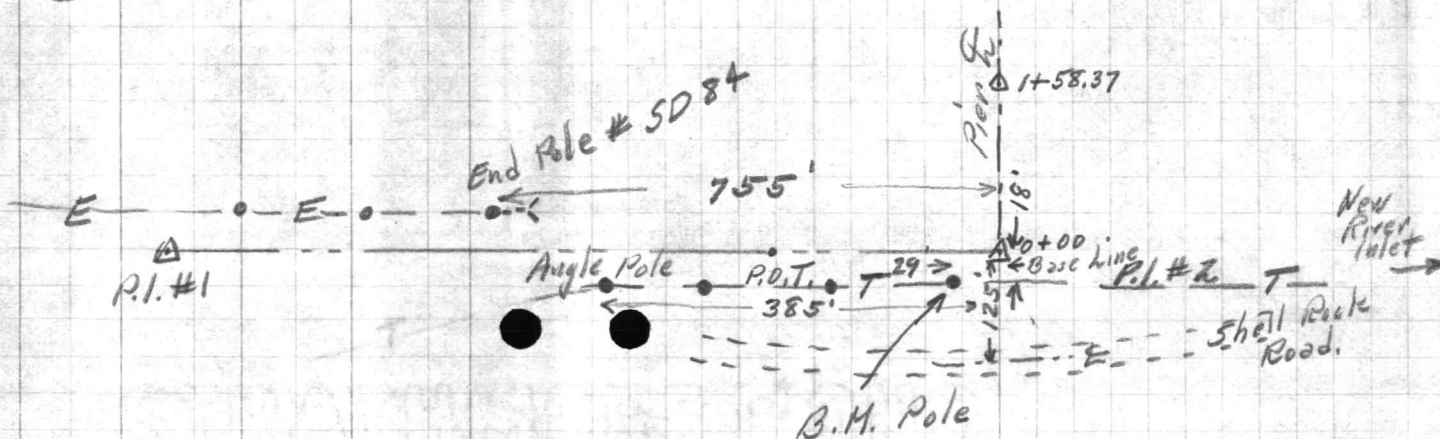








VALUABLE

SUBJECT

Profile for Pier Site

Onslow Beach

RETURN TO
PUBLIC WORKS
OFFICE
CAMP LEJEUNE
NORTH CAROLINA

FIELD PARTY

Dillon

IN CHARGE

INSTRUMENT

NOTES

TAPE READ

TAPE OR ROD

TAPE OR ROD

INSTRUMENT NO.

TAPE NO.

WEATHER

CLEAR
CLOUDY
WINDY
RAIN
FAIR

SNOW
HOT
MODERATE
COLD
FOG

FIGURED BY

NOTES CHECKED BY

PLOTTED BY

FILE No.

FLDR. No.

SHEET

DATE

#1 of 2

1/27/1959

Quad. No.

STATION	DIST.	ANGLE ° ' "	+	H. I. BEARING	VER. ANG. DIFF.	ELEVATION
---------	-------	----------------	---	------------------	--------------------	-----------

T.B.M.			6.2	13.3		7.1
					8.9	4.4

Hub on Pier Line at 1+58.37

Water Elev. at 2:00 P.M.


Time 10:
Water Level +2.0±
End +1.5±

π at Point "X" on Shore Base Line
Sight on Hub at 1+58.37 in Pier Line

Seaward

Sounding#

1	44° 40'	395	6.0	19	68° 10'	998	-17.5
2	52° 20'	518	-7.0	20	69° 40'	1080	-16.5
3	53° 20'	537	-7.0	21	70° 20'	1119	-18.5
4	55° 20'	578	-5.0	22	70° 50'	1151	-17.5
5	57° 00'	616	-7.0	23	71° 05'	1167	-17.5
6	58° 30'	653	-9.0	24	71° 40'	1207	-19.5
7	59° 40'	684	-10.0	25	72° 30'	1269	-20.5
8	61° 00'	722	-11.0	26	73° 00'	1308	-21.5
9	62° 00'	752	-13.0	27	73° 20'	1336	-21.5
10	63° 00'	785	-13.0	28	74° 05'	1403	-23.0
11	64° 00'	820	-14.0	29	74° 40'	1459	-23.0
12	65° 00'	856	-15.0				
13	66° 00'	900	-14.5				
14	66° 00'	900	-14.8				
15	66° 00'	900	-14.5				
16	66° 20'	913	-15				
17	66° 40'	927	-15				
18	67° 10'	950	-15.5				

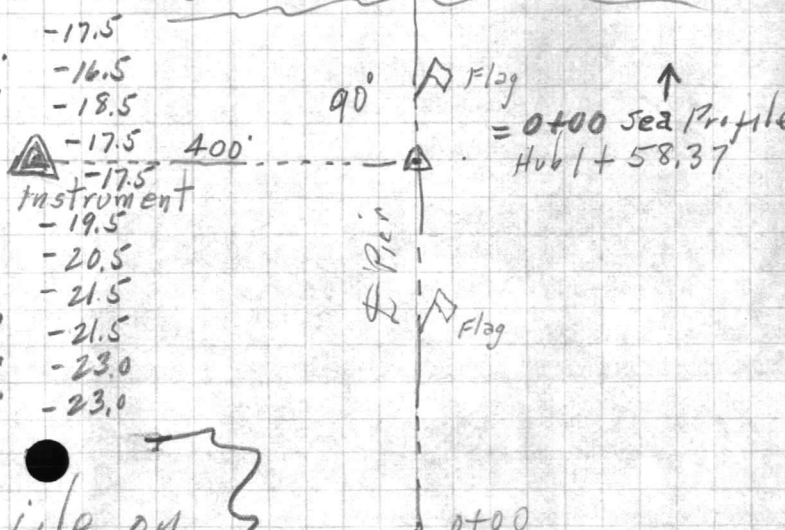

Use Profile on Next sheet






Pier Site - Onslow Beach

VALUABLE SUBJECT

Use This Profile
2nd Run.

RETURN TO
PUBLIC WORKS
OFFICE
CAMP LEJEUNE
NORTH CAROLINA

FIELD PARTY
____ IN CHARGE
____ INSTRUMENT
____ NOTES
____ TAPE READ
____ TAPE OR ROD
____ TAPE OR ROD
____ INSTRUMENT NO.
____ TAPE NO.

WEATHER
CLEAR _____
CLOUDY _____
WINDY _____
RAIN _____
FAIR _____
SNOW _____
HOT _____
MODERATE _____
COLD _____
FOG _____
FIGURED BY _____
NOTES CHECKED BY _____
PLOTTED BY _____

FILE No. _____
FLDR. No. _____
SHEET # 2 of 2
DATE 1/27/1959

Quad. No. _____

STATION	DIST.	ANGLE ° ' "	+	H. I. BEARING	VER. ANG. DIFF.	ELEVATION
						Time 10:30 M.S.L. Elev.
1		45° 30'		408	- 5.5	
2		50° 20'		480	- 6.5	
3		53° 20'		536	- 7.5	
4		54° 50'		568	- 7.5	
5		55° 40'		584	- 6.5	
6		57° 05'		616	- 6.5	
7		58° 40'		656	- 9.3	
8		60° 00'		692	- 10.0	
9		61° 20'		732	- 12.5	
10		63° 40'		808	- 12.5	
11		65° 20'		872	- 14.0	
12		66° 30'		920	- 14.2	
13		68° 10'		998	- 16.0	
14		69° 40'		1080	- 16.0	
15		71° 05'		1168	- 18.5	
16	72-20	73° 20'		1256	- 20.3	
17		73° 55'		1316	- 22.5	
18		74° 10'		1412	- 23.0	
19		75° 15'		1519	- 23.0	
20		75° 55'		1594	- 24.0	

Water Level +1.5 ±
+1.0 ±
Pier Baseline Station. 0+00 at Beginning of Pier
Subtract 131' for stationing.

Mean High Water +1.5
Mean Sea Level 0.0
Mean Low Water -1.5

14+63
2+84
12+52







See Sheets Dated 10/28/59 for Pier Co-ordinates.

PUBLIC WORKS DEPARTMENT
Camp Lejeune, North Carolina
Survey Department

Location of Bldgs. #130, 131, 132 + 133

Proposed Pier Location - Onslow Beach

File _____
Quadrangle _____
Date 1/26
Sheet 1 of 1

Traverse Computation
Description

Station	Distance	Bearing	Cosine	Sine	Latitude	Departure	Y Coordinate North	X Coordinate East
USN #40		N49-05-50E	TO	USMC #141			301,061.17	2,518,298.99
P.I. #1	1452.19	S52-05-35W	0.643808	0.7890096	892.20	1145.79	300,168.97	2,517,153.20
P.O.T.	1789.14'	S46-50-10W	0.6840875	0.7293999	1223.93	1305.00	298,945.04	2,515,848.20
P.I. #2	185.12	S46-50-10W	0.6840875	0.7293999	126.64	135.03	298,818.40	2,515,713.17
HUB ON BEACH	158.37	S40-10-50E	0.7640150	0.6451984	121.00	102.18	298,697.40	2,515,815.35
Onslow Beach waterfront Proposed END of Pier 2+89 = +1.5' Elev.	130.63	S40-10-50E	0.7640150	0.6451984	99.80	84.28	298,597.60	2,515,899.63
P.I. #1		S52-05-35W	from Mon #40				300,168.97	2,517,153.20
Cor. "A" Bldg. #130	215'	N49-16-35E	0.652411	0.757866	140.3	162.9	300,309.3	2,517,316.1
Pt. "B" Offset 10' from Cor "B-1" Bldg. #132	223'	S49-17-35W	0.652190	0.758055	145.4	169.0	300,023.6	2,516,984.2
N.E. Cor. of Pier On Pier	50.00	N49-49-10E	0.6451984	0.7640150	32.26	38.20	298,629.86	2,515,937.83
N.E. Corner of Pier 75' from E	25.00	"	"	"	16.13	19.10	298,645.99	2,515,956.93

1799
1632
1974

VALUABLE

SUBJECT

*Soundings - Fishing
Dier*RETURN TO
PUBLIC WORKS
OFFICE
CAMP LEJEUNE
NORTH CAROLINA*1st Run*

FIELD PARTY

Hellum

IN CHARGE

INSTRUMENT

NOTES

TAPE READ

TAPE OR ROD

TAPE OR ROD

INSTRUMENT NO.

TAPE NO.

WEATHER

CLEAR
CLOUDY
WINDY
RAIN
FAIRSNOW
HOT
MODERATE
COLD
FOG

FIGURED BY

NOTES CHECKED BY

PLOTTED BY

FILE No. _____

FLDR. No. _____

SHEET _____

DATE *1/27* 19 *59*

Quad. No. _____

STATION	DIST.	ANGLE ° ' "	+	H. I. BEARING	VER: ANG. DIFF.	ELEVATION
---------	-------	----------------	---	------------------	--------------------	-----------

1			8.0			16 - 16.0
2			10.0			17 - 16.5
3			9.0			18 16.5
4			9.0			19 17.0
5			7.0			20 19.0
6			9.0			21 18.0
7			11.0			22 20.0
8			12.0			23 19.0
9			13.0			24 19.0
10			15.0			25 21.0
11			15.0			26 22.0
12			16.0			27 23.0
13			17.0			28 23.0
14			16.0			29 24.5
15			16.3			30 24.5

*Use
Next
Sheet*


































VALUABLE

VALUABLE

SUBJECT

*Fishing Pier**2nd Run*RETURN TO
PUBLIC WORKS
OFFICE
CAMP LEJEUNE
NORTH CAROLINA

FIELD PARTY

Kellum IN CHARGE

INSTRUMENT

NOTES

TAPE READ

TAPE OR ROD

TAPE OR ROD

INSTRUMENT NO.

TAPE NO.

WEATHER

CLEAR
CLOUDY
WINDY
RAIN
FAIRSNOW
HOT
MODERATE
COLD
FOG

FILE No. _____

FLDR. No. _____

SHEET _____

NOTES CHECKED BY _____

PLOTTED BY _____

DATE *1/27* 19 *59*

Quad. No. _____

STATION	DIST.	ANGLE ° ' "	+	H. I. BEARING	VER: ANG. DIFF.	ELEVATION
1		7.0			17	23.5
2		8.0			18	24.0
3		9.0			19	24.0
4		9.0			20	25.0
5		8.0				
6		8.0				
7		10.8				
8		11.5				
9		14.0				
10		14.0				
11		15.5				
12		15.2				
13		17.0				
14		17.0				
15		19.5				
16		21.3				

Use these






























VALUABLE

SUBJECT Loc. Bldgs # 130, 131,
132 + 133
Onslow Beach

Supercedes Previous Locations

RETURN TO
PUBLIC WORKS
OFFICE
CAMP LEJEUNE
NORTH CAROLINA

FIELD PARTY
Dillon IN CHARGE
____ INSTRUMENT
____ NOTES
____ TAPE READ
____ TAPE OR ROD
____ TAPE OR ROD
____ INSTRUMENT NO.
____ TAPE NO.

WEATHER
CLEAR _____ SNOW _____
CLOUDY _____ HOT _____
WINDY _____ MODERATE _____
RAIN _____ COLD _____
FAIR _____ FOG _____
FIGURED BY _____
NOTES CHECKED BY _____
PLOTTED BY _____

FILE No. 221-X
FLDR. No. _____
SHEET #1 of
DATE 1/26/1959


Quad. No. _____

STATION	DIST.	ANGLE ° ' "	+	H. I. BEARING	VER: ANG. DIFF.	ELEVATION
---------	-------	----------------	---	------------------	--------------------	-----------

Tr at P.I. #1 on Pier Traverse
Sight on Mon. U.S.N. #40.

Cor. "A" 215° 35' 11" Bldg # 130. Sheet Metal Bldg. Concrete Floor.

Point "B" 223° 17' 12" Point on East Bldg. Line, 10' Southeast of Corner.

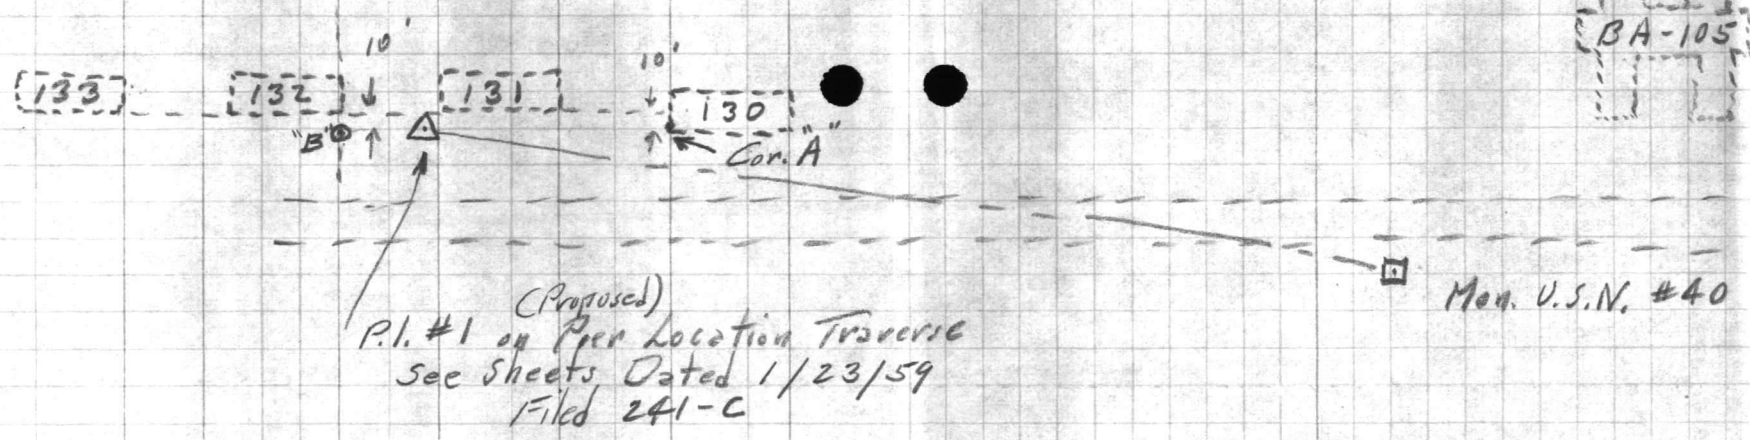

For Bldg. Coordinates - See Traverse above.


VALUABLE

SUBJECT Bldgs. BA-131, 132, 133

Location AT ONslow BEACH

RETURN TO
PUBLIC WORKS
OFFICE
CAMP LEJEUNE
NORTH CAROLINA

FIELD PARTY

Kellum IN CHARGE
____ INSTRUMENT
____ NOTES
____ TAPE READ
____ TAPE OR ROD
____ TAPE OR ROD
____ INSTRUMENT NO.
____ TAPE NO.

WEATHER

CLEAR
CLOUDY
WINDY
RAIN
FAIR
SNOW
HOT
MODERATE
COLD
FOG

FILE No. 241-E

FLDR. No. _____

FIGURED BY _____

SHEET 1-0/1

NOTES CHECKED BY _____

DATE 7-26-1959

PLOTTED BY _____


Quad. No. _____

BA-133


STATION	DIST.	ANGLE ° ' "	+	H. I. BEARING	VER: ANG. DIFF.	ELEVATION
---------	-------	----------------	---	------------------	--------------------	-----------

Use with
Corner Locations
on sheets Dated
shown
1/26/59

Bldgs. Arc Frame, Tar
Paper Siding, Metal
Roff - concrete Floor
14" walls

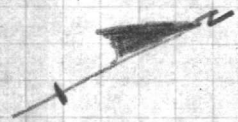

Co-ordinated

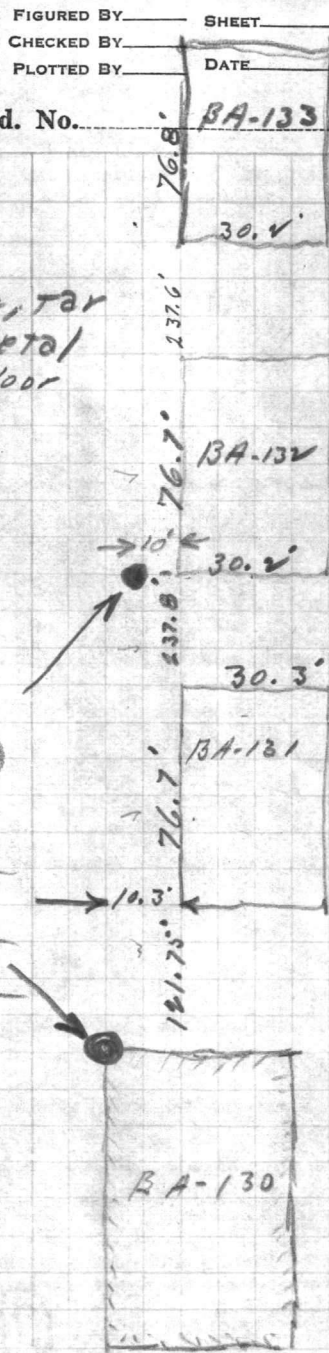






VALUABLE

RETURN TO
PUBLIC WORKS
OFFICE
CAMP LEJEUNE
NORTH CAROLINA

SUBJECT


*Location of Onslow Beach
Fishing Pier and Utilities*

FIELD PARTY
Pillon IN CHARGE
INSTRUMENT
NOTES
TAPE READ
TAPE OR ROD
TAPE OR ROD
STRUMENT NO.
TAPE NO.

WEATHER
CLEAR
CLOUDY
WINDY
RAIN
FAIR
SNOW
HOT
MODERATE
COLD
FOG
FIGURED BY
NOTES CHECKED BY
PLOTTED BY

FILE No. *241-C*
FLDR. No.
SHEET *#1 of 3*
DATE *10/28/1959*

Quad. No.

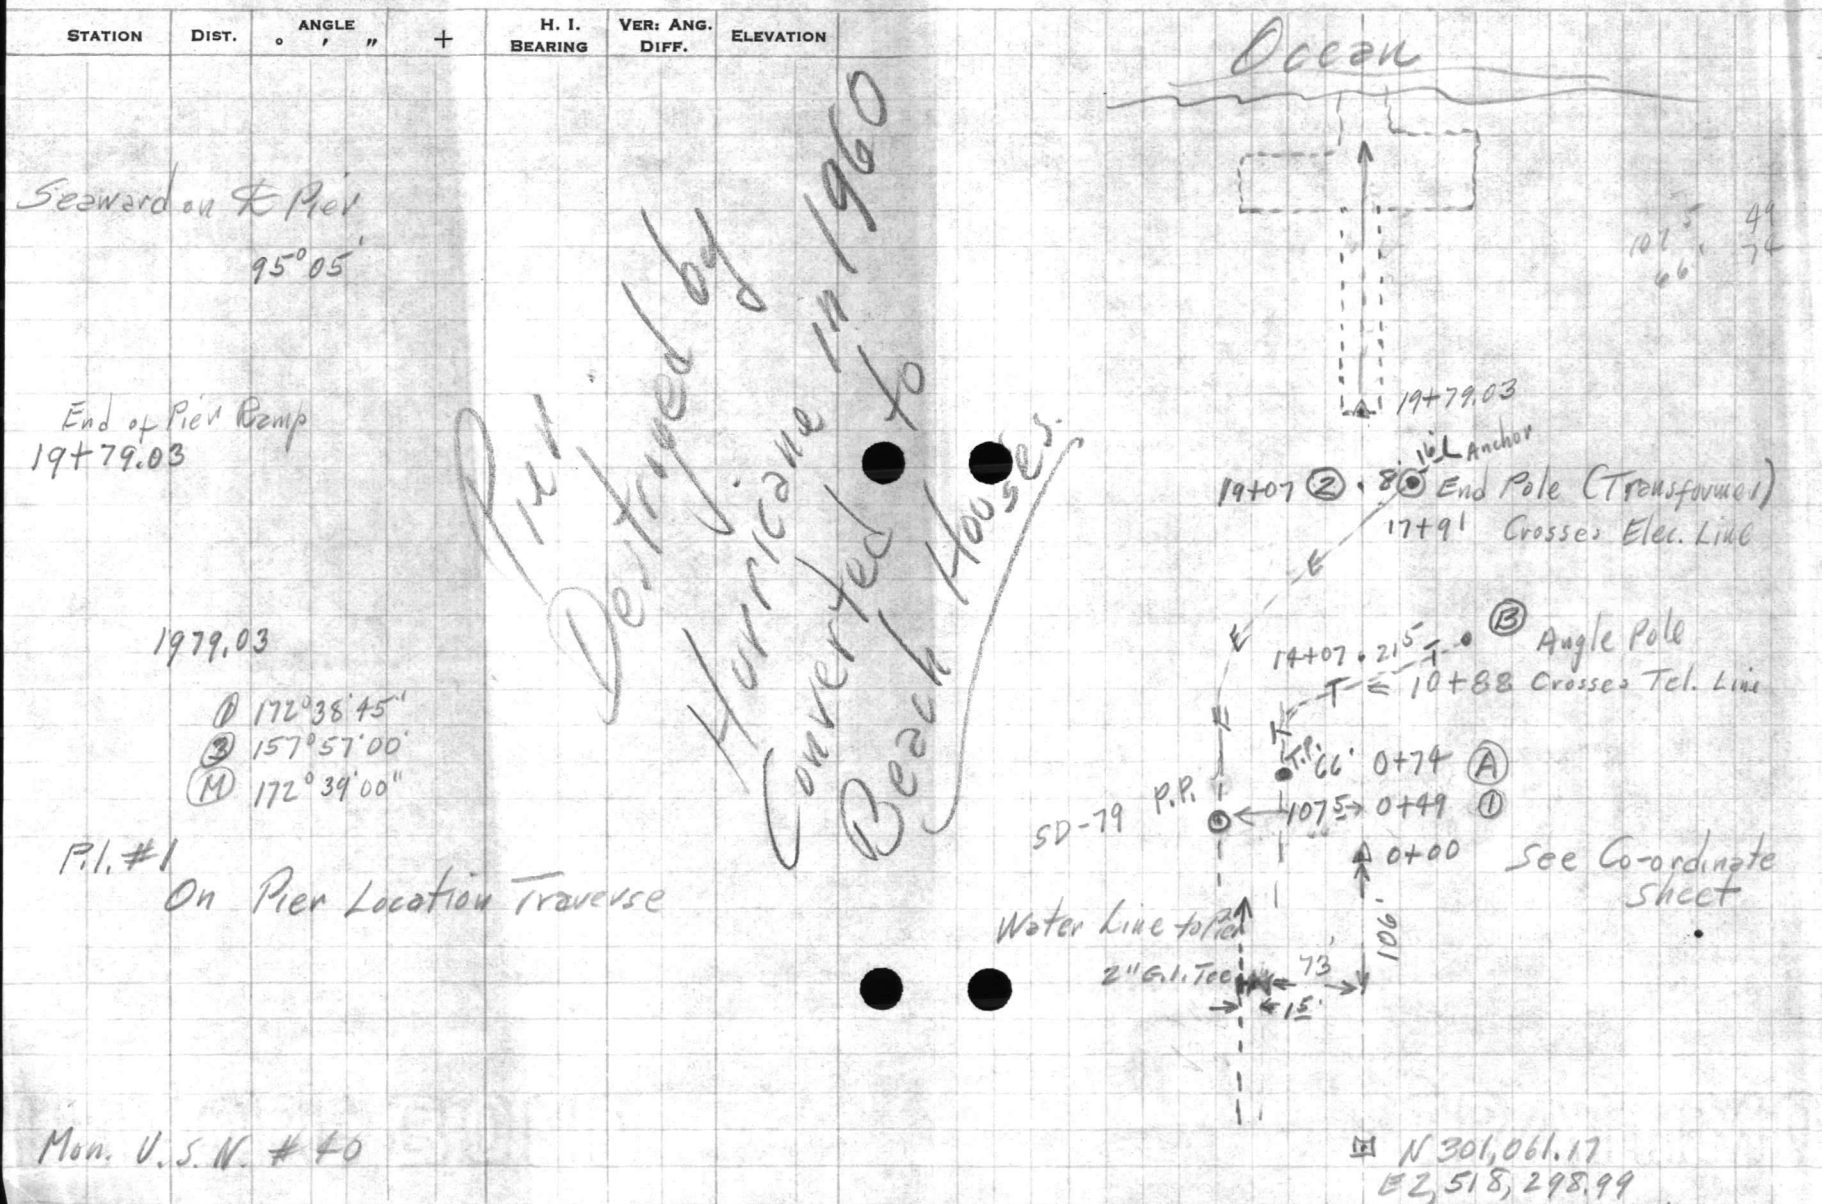

172-38-45
2 3
517 56 15
360 117
3 157-57-00
52-39-00

275-05
180
95

275.05
3
525 15
380
140.5

150
2 105-14-30
35-04-50

STATION
DIST
ANGLE
ELEVATION

STATION DIST ANGLE ELEVATION

FIELD PARTY
LEAD
ROD

WEATHER
CLEAR
CLOUDY
WINDY
RAIN
FOG

WEATHER
CLEAR
CLOUDY
WINDY
RAIN
FOG

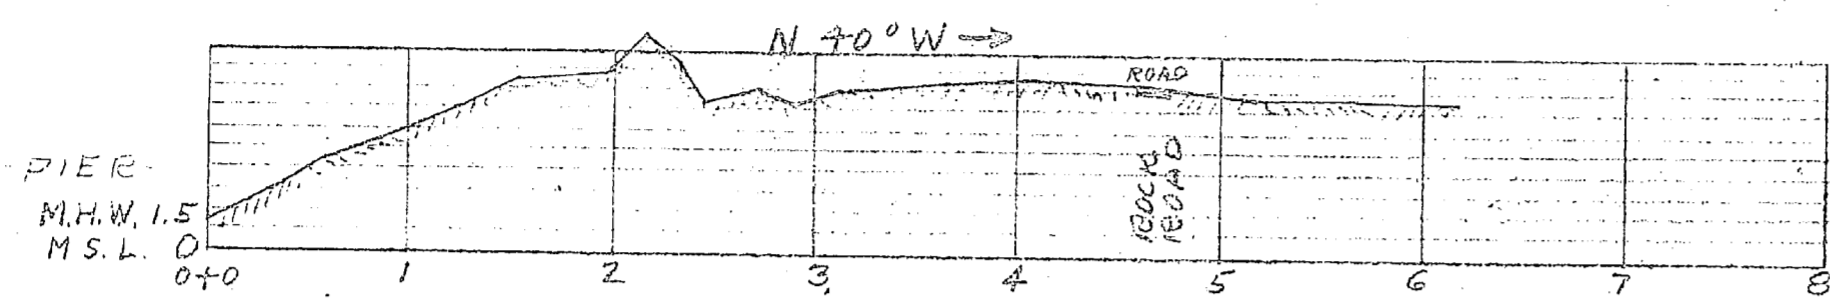

PROFILE
CENTER LINE OF PIER
FROM END OF PIER - SHOREWARD
SCALE: 1 Inch = 100 ft. Hor.
10 ft. Vert

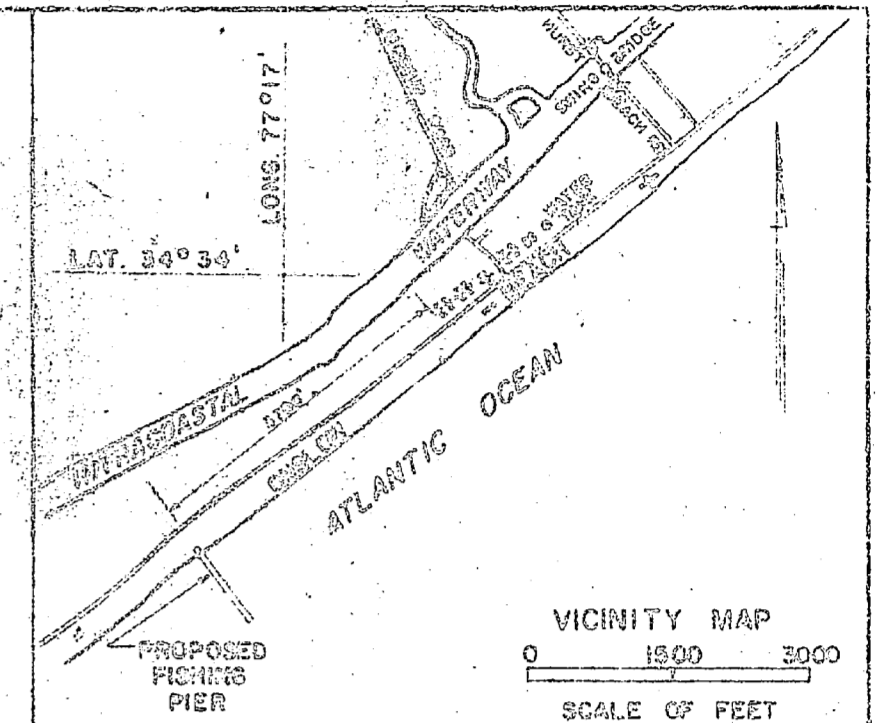

VICINITY MAP
SCALE OF FEET
FROM UNITED STATES - EAST COAST
NORTH CAROLINA APPROACHES TO
NEW RIVER INLET, NO. H.O. INSC. 75,042-25-2A

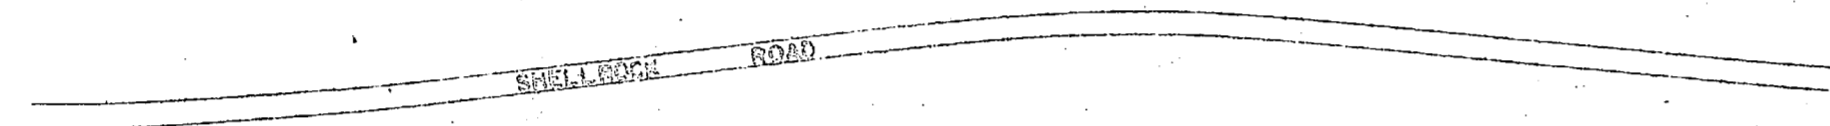

ONSLOW BEACH

S 44° 07' 10" W - 3364.27'

CONC. MON.
USN # 40
N 301,061.17
E 2,518,298.99

N 49° 49' 10" E - 150'


N 40° 10' 50" W - 1000'
PROPOSED FISHING PIER
S 40° 10' 50" E - 1000'
N 40° 10' 50" W - 150'

DESCRIPTION

A PARCEL OF OCEAN BOTTOM LOCATED IN SWANBORO TOWNSHIP, ONSLOW COUNTY, STATE OF NORTH CAROLINA AND LYING CONTIGUOUS WITH THE MEAN HIGH WATER LINE OF ONSLOW BEACH AND BEING MORE PARTICULARLY LOCATED AS FOLLOWS:
FROM U. S. NAVY MONUMENT LOCATED AT N. C. GRID COORDINATE N 301,061.17; E 2,518,298.99, AND ALSO BEING LOCATED APPROXIMATELY 300' IN A WESTWARD DIRECTION FROM BARRACKS BUILDING NO. 5A-105, PROCEED S 44° 07' 10" W A DISTANCE OF 3,364.27' TO A POINT LYING IN THE MEAN HIGH WATER LINE, SAID POINT BEING THE POINT OF BEGINNING; THENCE S 40° 10' 50" E, A DISTANCE OF 1000' TO A POINT; THENCE S 49° 49' 10" W, A DISTANCE OF 150' TO A POINT; THENCE N 40° 10' 50" W, A DISTANCE OF 1000' TO A POINT, SAID POINT BEING ALSO THE MEAN HIGH WATER LINE; THENCE WITH SAID MEAN HIGH WATER LINE N 49° 49' 10" E, A DISTANCE OF 150' TO POINT OF BEGINNING.

ABOVE DESCRIBED PARCEL CONTAINS 3.44 ACRES MORE OR LESS.
ALL BEARINGS REFERRED TO ARE NORTH CAROLINA STATE GRID.

ATLANTIC OCEAN

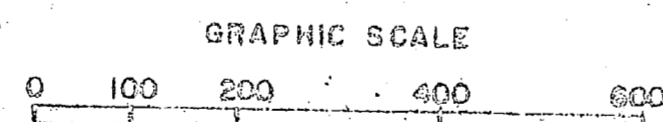

REV 'A' Shore Profile Added 3/21/53 T.S.B.	
P. O. DRAWING NO. 11429	MARINE CORPS BASE CAMP LEJEUNE, NORTH CAROLINA
PLAT METES AND BOUNDS ONSLOW BEACH FISHING PIER	
APPROVED V. W. GILBERTMASTER COMMANDER U. S. MARINE CORPS	APPROVED E. J. [Signature] PUBLIC WORKS OFFICER
SCALE GRAPHIC	755529

