REVISIONS			
SYM.	DESCRIPTION	DATE	APPROVED

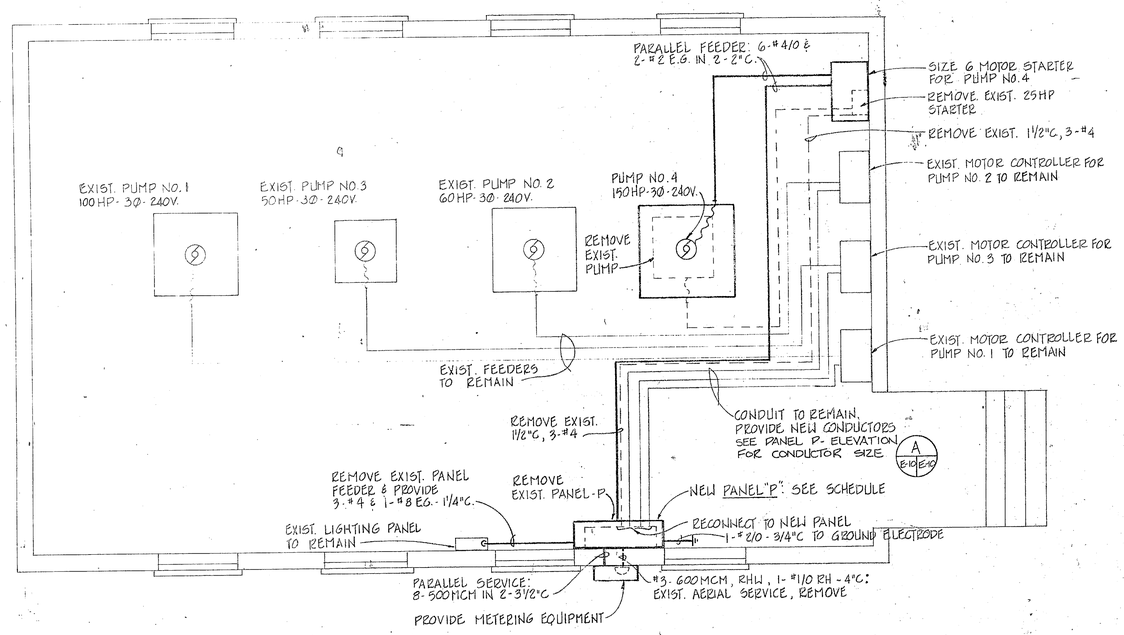

PUMP HOUSE- BUILDING TT-39A- TARAWA TERRACE

PANEL P

3 PHASE, 4 WIRE, 120/240 VOLTS, 800 AMPERE BUS, 800 AMPERE MAIN CIRCUIT BREAKER, 100 % NEUTRAL
SURFACE MOUNTING, NEMA- ENCLOSURE, EQUIPMENT GROUND BUS, INTEGRATED EQUIPMENT RATING OF 18,000 RMS SYMMETRICAL AMPERES MINIMUM U.L.S.E. LABEL REQ'D.

DESIGNATION TO BE TYPED IN PANEL CIRCUIT DIRECTORY	PHASE LOADING A	B	C	CKT BKR. TRIP	CKT. NO.	ABC	CKT. NO.	CKT BKR. TRIP	PHASE LOADING A	B	C	DESIGNATION TO BE TYPED IN PANEL CIRCUIT DIRECTORY
SPACE	--		--	3/70	1		2	3/70	29.2		29.2	LIGHTING PANEL
SPACE	--		--	3/100	3		4	3/100	--	--	--	SPACE
PUMP #2, 60 HP	134	134		3/225	5		6	3/200	130	130	130	PUMP #3, 50 HP
PUMP #1, 100 HP	148	148	148	3/400	7		8	3/600	360	360	360	PUMP #4, 150 HP

AS BUILT - 670 EXPANSION

AS BUILT