

VALUABLE

SUBJECT

Relocation of
Main transmission at
Snead Ferry Bridge

Return To
Public Works
Office
Camp Lejeune
North Carolina

FIELD PARTY

Tuckey In Charge
Instrument
Notes
Tape Read
Tape or Rod
Instrument No.
Tape No.

WEATHER

Clear
Cloudy
Windy
Rain
Fair
Snow
Hot
Moderate
Cold
Fog


FILE No. 219-6

Fldr. No.

Sheet

Date 11-18 19

Quad. No.

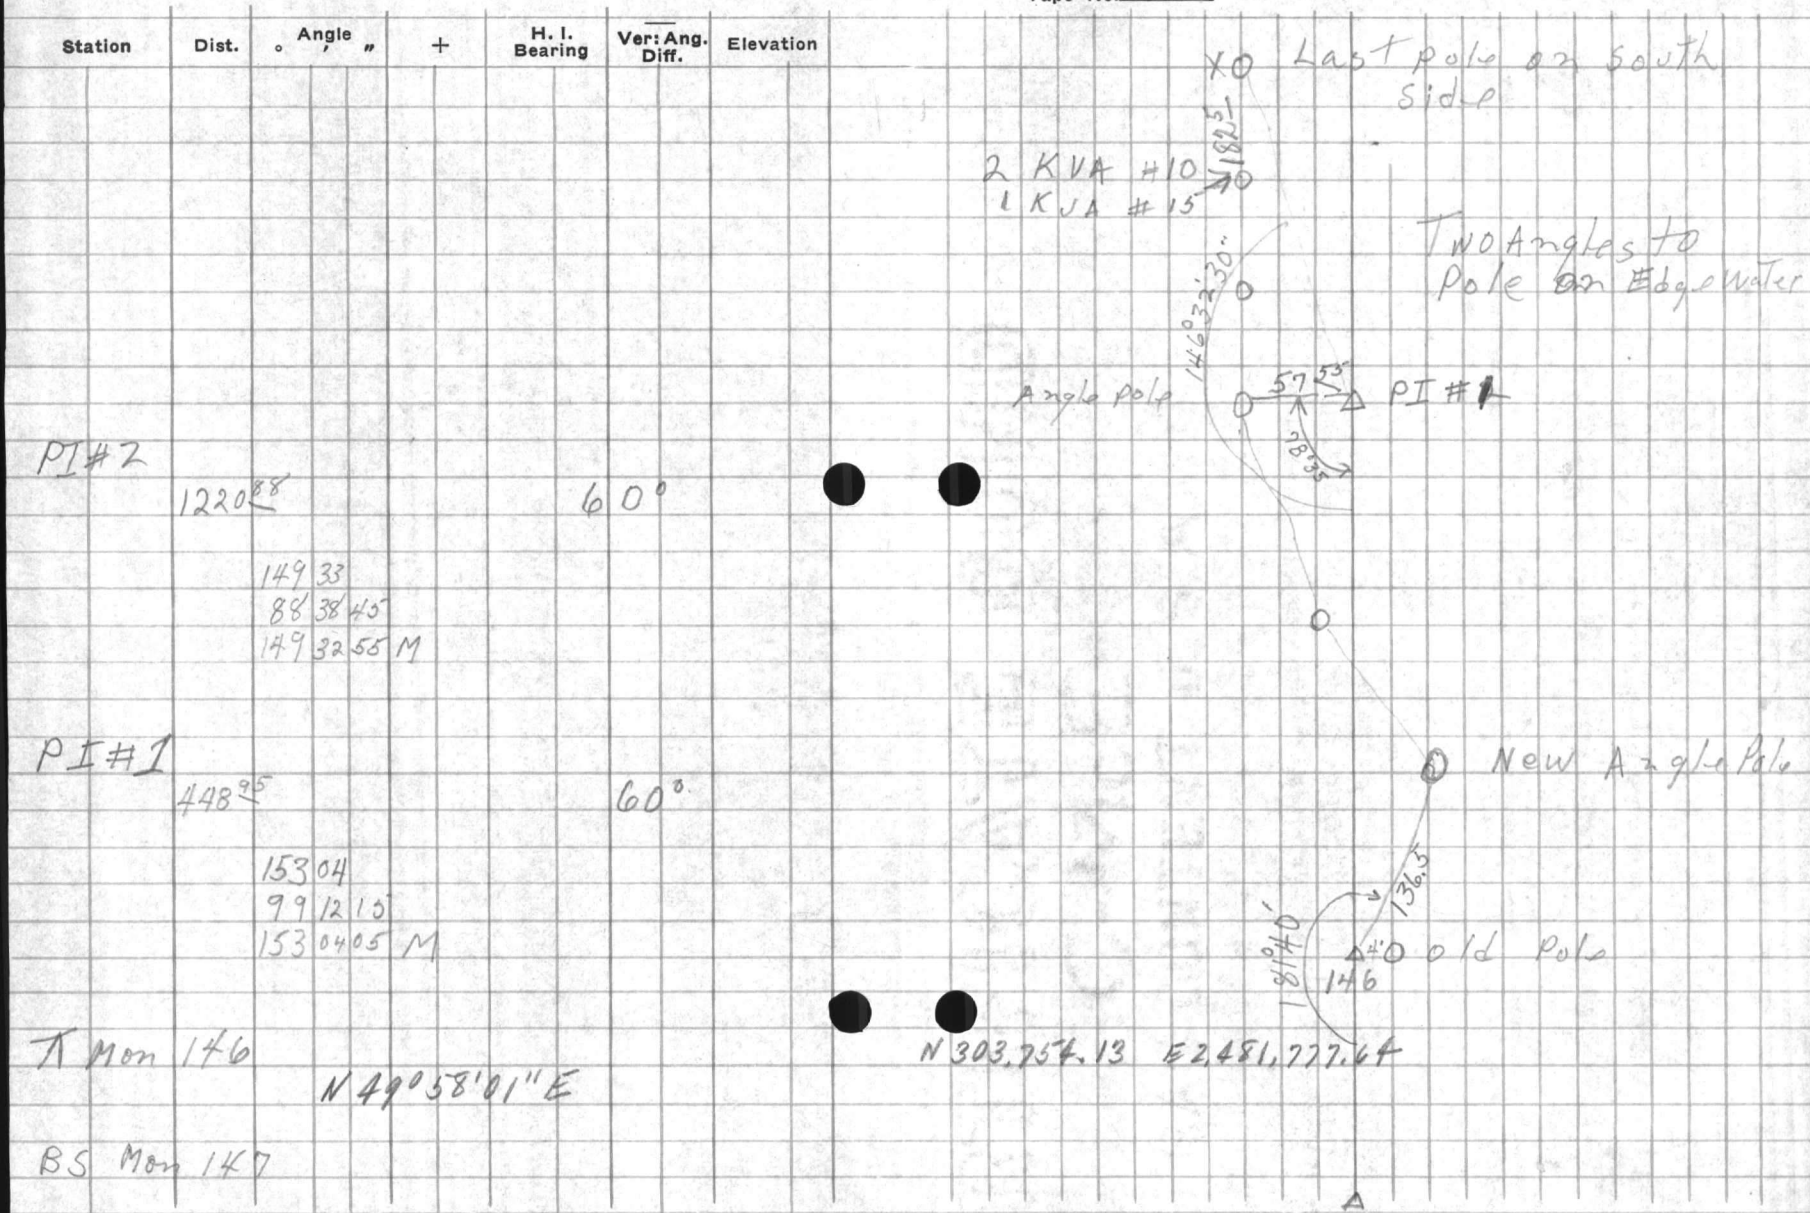









VALUABLE

RETURN TO
PUBLIC WORKS
OFFICE

CAMP LEJEUNE
NEW RIVER, N. C.

SUBJECT Test Boring

Guard House Site

Sneads Ferry Bridge

FIELD PARTY

Dillon IN CHARGE
INSTRUMENT
NOTES
TAPE READ
TAPE OR ROD
TAPE OR ROD
INSTRUMENT NO.
TAPE NO.

WEATHER

CLEAR SNOW
CLOUDY HOT
WINDY MODERATE
RAIN COLD
FAIR FOG

FILE No. 2196

FLDR. No. _____

SHEET 1 of 1

DATE 3/6 1945

Quad. No. 219

STATION	DIST.	ANGLE "	+	H. I.	VER. ANG. DIFF.	ELEVATION
B.M.				1.42	27.33	25.91
					7.4	19.9
	19.9					Ground Elevation
	19.2					Sand + Clay 50% - 50% Clay 95%
	16.6					Sand + Clay 60% Clay
	16.0					Brown Sand 95%
	13.3					White Sand 95%
	12.1					Sand + Clay 15% Clay
	9.7					Wet
						Sand 95% Wet
	8.0					Sand + Clay 50% - 50%
	7.5					Clay 95%


No Top Soil. Boring on site of Borrow Area.
Ground has been removed for a depth of approx. 3'

Probably Surface Water Elevation.
Small amount of Water.



348

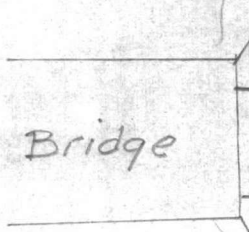


Bridge

heads Ferry Road

New River

540.15400

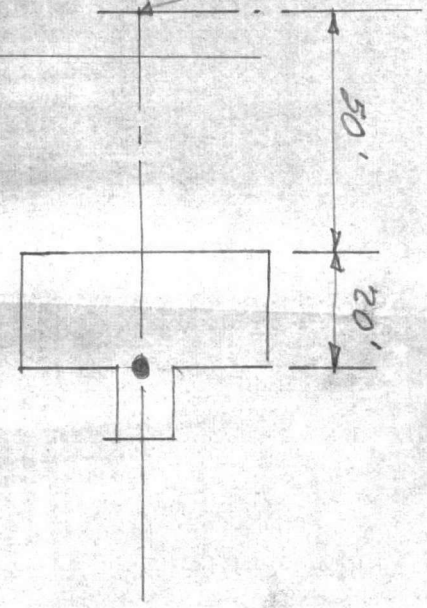



VALUABLE

Return To
Public Works
Office
Camp Lejeune
North Carolina

SUBJECT Flood stage week of
SEPT. 15TH 1946 AT SNEADS
FERRY BRIDGE

FIELD PARTY
KELUM In Charge
____ Instrument
____ Notes
____ Tape Read
____ Tape or Rod
____ Tape or Rod
____ Instrument No.
____ Tape No.

WEATHER
Clear _____
Cloudy _____
Windy _____
Rain _____
Fair _____
Snow _____
Hot _____
Moderate _____
Cold _____
Fog _____
Figured By _____
Notes Checked By _____
Plotted By _____

FILE No. 219-6
Fldr. No. _____
Sheet 1-021
Date 9-27 1946
Quad. No. 219

Station	Dist.	Angle " +	H. I. Bearing	Ver: Ang. Diff.	Elevation	Notes
B.M.		4.24	13.30		9.06	CUT OUT PLACE IN CONCRETE FENDER ON NORTHWEST SIDE OF BASE END OF SNEADS FERRY BRIDGE.
				11.7	1.6	EDGE OF WATER
				11.4	2.1	FLOOD LINE
				11.0	2.3	FLOOD LINE
				11.0	2.3	FLOOD LINE
B.M.		4.24			9.06	

ALPHABETIC

North Carolina
Camp Lejeune
Office
Public Works
Bldg. 70

SUBJECT

Station

Dist

Grid

Spring

Date

Elevation









































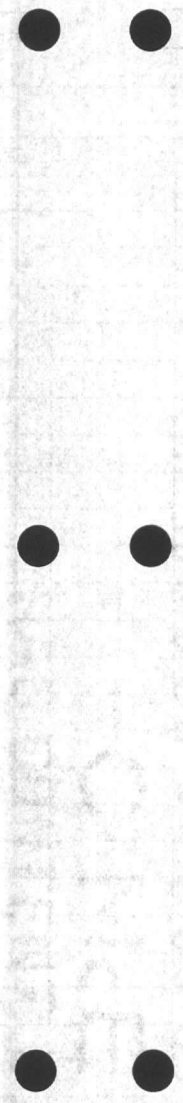

VALUABLE

SUBJECT

HIGH WATER
AT SNEADS FERRY BRIDGE

Return To
Public Works
Office
Camp Lejeune
North Carolina

FIELD PARTY

____ In Charge
____ Instrument
____ Notes
____ Tape Read
____ Tape or Rod
____ Tape or Rod
____ Instrument No.
____ Tape No.

WEATHER

Clear
Cloudy
Windy
Rain
Fair
Snow
Hot
Moderate
Cold
Fog

FILE No. 219-G

Fldr. No. _____

Figured By _____

Sheet _____

Notes Checked By _____

Date 11-4-47

Plotted By _____

Quad. No. _____

Station	Dist.	Angle ° ' "	+	H. I. Bearing	Ver: Ang. Diff.	Elevation	
B.M.				3.8812.94		9.06	AT END OF BRIDGE
					10.00	2.9	DEBRIS ON SHORE
					10.8	2.1	PRESENT TIDE LEVEL-3:05 P.M. 11-4-47






































































VALUABLE

SUBJECT HIGH WATER ELEVATION
AT SNEADS FERRY BRIDGE.

Return To
 Public Works
 Office
 Camp Lejeune
 North Carolina

FIELD PARTY
WELLMAN In Charge
 _____ Instrument
 _____ Notes
 _____ Tape Read
 _____ Tape or Rod
 _____ Tape or Rod
 _____ Instrument No.
 _____ Tape No.

WEATHER
 Clear _____
 Cloudy _____
 Windy _____
 Rain _____
 Fair _____
 Snow _____
 Hot _____
 Moderate _____
 Cold _____
 Fog _____
 Figured By _____
 Notes Checked By _____
 Plotted By _____

FILE No. 219-6
 Fldr. No. 219 B
 Sheet 1 OF 1
 Date 10-10-1946

Quad. No. _____

Station	Dist.	Angle " "	+	H. I. Bearing	Ver: Ang. Diff.	Elevation	
B.M.			3.69	2.75		9.06	+ IN CONCRETE IN FENDER ON NORTHSIDE OF EAST END OF BRIDGE.
			10.2	2.5			WATER LEVEL AT HIGH TIDE 9:40 A.M.






























VALUABLE

SUBJECT High Water Elevation
Hurricane 10/15/54
Smeads Ferry Bridge - New River

RETURN TO
PUBLIC WORKS
OFFICE
CAMP LEJEUNE
NORTH CAROLINA

FIELD PARTY
Dennis IN CHARGE
____ INSTRUMENT
____ NOTES
____ TAPE READ
____ TAPE OR ROD
____ TAPE OR ROD
____ INSTRUMENT NO.
____ TAPE NO.

WEATHER
CLEAR
CLOUDY
WINDY
RAIN
FAIR
SNOW
HOT
MODERATE
COLD
FOG
FIGURED BY _____
NOTES CHECKED BY _____
PLOTTED BY _____

FILE No. 2196
FLDR. No. _____
SHEET _____
DATE 10/18 1954

Quad. No. _____

STATION	DIST.	ANGLE			H. I. BEARING	VER. ANG. DIFF.	ELEVATION	
		°	'	"				
B.M.					3.63	12.69	9.06	Top of Wheel Guard on Camp End of Bridge
					9.50	3.19		West Side of Fill - Upstream side.
					7.80	4.89		East Side " " - Downstream side.











































