

219-d

T-1-3

RANGE AND BUILDING RECOVERY BB-151

LOCATION:

Toilet T-1-3 Courthouse Bay (Ref MSS Dev. Pln. Sheet 34 of 44)

SIZE OF BUILDING:	LENGTH	WIDTH	PEAK	FRONT	REAR
9' x 11' x 11'	11'	9'	11"	11"	11"
USABLE SPACE:	LENGTH	WIDTH	HEIGHT		

DISCRIPTION OF CONSTRUCTION

11' x 9' = 99 SF
wood frame construction

LOCATED 30 FEET FROM WATER'S EDGE 191' WEST OF BOATHOUSE

PART 19 Nov 63
LIST 25
TOILET T-1-3
GRID K-11

LOCATED IN
GRID 12-L

BB-151

OK
SAW

9 OCT 63

VALUABLE

SUBJECT

Stake-out Soil Test Borings
Water Treatment Plant Site

Courthouse Bay

RETURN TO
PUBLIC WORKS
OFFICE
CAMP LEJEUNE
NORTH CAROLINA

FIELD PARTY

Padgett
IN CHARGE
INSTRUMENT
NOTES
TAPE READ
TAPE OR ROD
TAPE OR ROD
INSTRUMENT NO.
TAPE NO.

WEATHER

CLEAR
CLOUDY
WINDY
RAIN
FAIR
SNOW
HOT
MODERATE
COLD
FOG

FILE No. 219-d


FLDR. No. _____

SHEET #1 of 4

DATE 8/10 1953

FIGURED BY _____
NOTES CHECKED BY _____
PLOTTED BY _____
Quad. No. _____

STATION	DIST.	ANGLE ° ' "	+	H. I. BEARING	VER: ANG. DIFF.	ELEVATION
---------	-------	----------------	---	------------------	--------------------	-----------

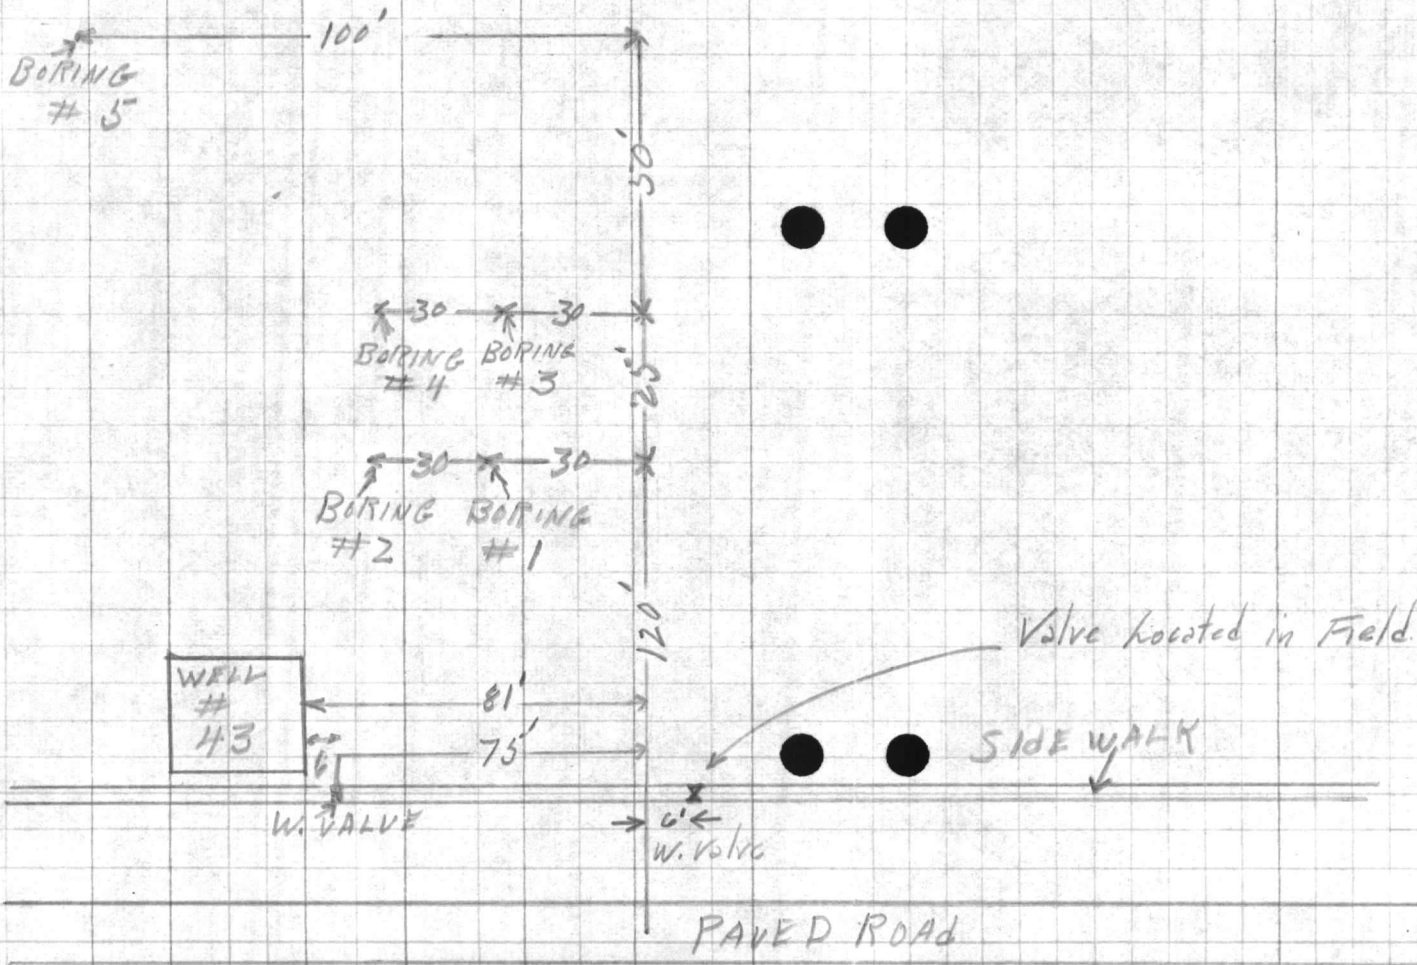





VALUABLE

SUBJECT _____

RETURN TO
PUBLIC WORKS
OFFICE
CAMP LEJEUNE
NORTH CAROLINAW. T. Plant
C. B.

FIELD PARTY

IN CHARGE

INSTRUMENT

NOTES

TAPE READ

TAPE OR ROD

TAPE OR ROD

INSTRUMENT NO.

TAPE NO.

WEATHER

CLEAR
CLOUDY
WINDY
RAIN
FAIR
SNOW
HOT
MODERATE
COLD
FOG

FILE No. _____

FLDR. No. _____

SHEET

#2048

NOTES CHECKED BY _____

PLOTTED BY _____

DATE

8/10 1953

Quad. No. _____

STATION	DIST.	ANGLE ° ' "	+	H. I. BEARING	VER. ANG. DIFF.	ELEVATION		
BORING #1				FROM		0 TO 1.2	WHITE SAND	
				"		1.2 " 2.0	BROWN "	
				"		2.0 " 4.0	YELLOW "	
				"		8.0 "	WATER TABLE	QUICK SAND STARTS
				"		4.0 " 10.0	WHITE SAND	
BORING #2				FROM		0 TO 2.0	DARK SAND	
				"		2.0 " 4.0	YELLOW "	
				"		8.5 "	WATER TABLE	QUICK SAND STARTS
				"		4.0 " 10.0	WHITE SAND	









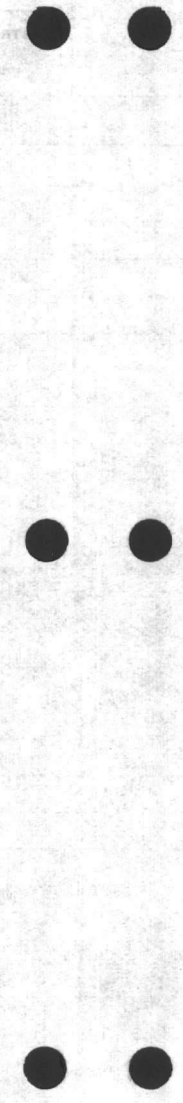

VALUABLE

SUBJECT

W. T. Plant

C. B.

RETURN TO
PUBLIC WORKS
OFFICE
CAMP LEJEUNE
NORTH CAROLINA

FIELD PARTY

IN CHARGE

INSTRUMENT

NOTES

TAPE READ

TAPE OR ROD

TAPE OR ROD

INSTRUMENT NO.

TAPE NO.

WEATHER

CLEAR
CLOUDY
WINDY
RAIN
FAIR

SNOW
HOT
MODERATE
COLD
FOG

FILE No. _____

FLDR. No. _____

SHEET

#3 of 4

DATE

8/10 1953

FIGURED BY _____

NOTES CHECKED BY _____

PLOTTED BY _____

Quad. No. _____

STATION	DIST.	ANGLE ° ' "	+	H. I. BEARING	VER: ANG. DIFF.	ELEVATION	
BORING #3				FROM		0 to 2.0	DARK SAND
				"		2.0" 4.0	YELLOW "
				"		8.5"	WATER TABLE QUICK SAND STARTS
				"		11.0" 11.0	WHITE SAND
BORING #4				FROM		0 to 1.0	WHITE SAND
				"		1.0" 4.0	DARK "
				"		8.0	WATER TABLE QUICK SAND STARTS
				"		11.0" 10.0	WHITE SAND
BORING #5				FROM		0 to 1.0	DARK "
				"		1.0" 4.0	YELLOW "
				"		8.0	WATER TABLE QUICK SAND STARTS
				"		11.0" 10.0	WHITE SAND















VALUABLE

SUBJECT W. T. Plant
C. B.

RETURN TO
PUBLIC WORKS
OFFICE
CAMP LEJEUNE
NORTH CAROLINA

FIELD PARTY

IN CHARGE

INSTRUMENT

NOTES

TAPE READ

TAPE OR ROD

STRUMENT NO.

TAPE NO.

WEATHER

CLEAR
CLOUDY
WINDY
RAIN
FAIR
SNOW
HOT
MODERATE
COLD
FOG

FILE No. _____
FLDR. No. _____
SHEET #4 of 4
DATE 8/10 1953

FIGURED BY _____
NOTES CHECKED BY _____
PLOTTED BY _____
Quad. No. _____

STATION	DIST.	ANGLE		+	H. I. BEARING	VER. ANG. DIFF.	ELEVATION
		°	"				
B.M.							13.06
					4.26	17.32	
					5.1	12.2	
					4.9	12.4	
					5.1	12.2	
					4.8	12.5	
					5.6	11.7	
B.M.					4.26	13.06	

BORING # 1

" # 2

" # 3

" # 4

" # 5

VALUABLE

SUBJECT _____

RETURN TO
PUBLIC WORKS
OFFICE
CAMP LEJEUNE
NORTH CAROLINA

FIELD PARTY

IN CHARGE

INSTRUMENT

NOTES

TAPE READ

TAPE OR ROD

TAPE OR ROD

INSTRUMENT NO.

TAPE NO.

WEATHER

CLEAR
CLOUDY
WINDY
RAIN
FAIR
SNOW
HOT
MODERATE
COLD
FOG

FILE No. _____

FLDR. No. _____

FIGURED BY _____

SHEET _____

NOTES CHECKED BY _____


PLOTTED BY _____

DATE _____

19 _____

Quad. No. _____

STATION	DIST.	ANGLE			H. I. BEARING	VER. ANG. DIFF.	ELEVATION
		°	'	"			
				+			

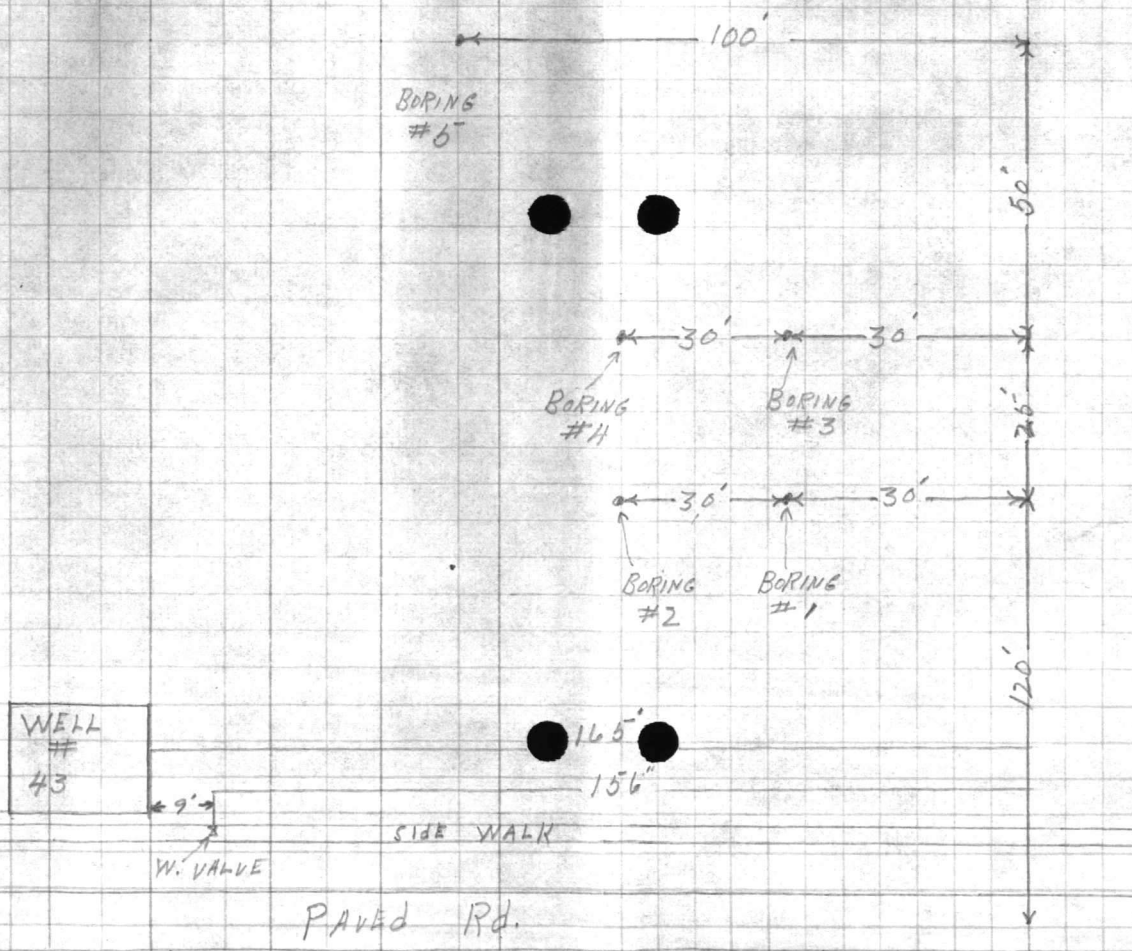
























VALUABLE

SUBJECT _____

RETURN TO
 PUBLIC WORKS
 OFFICE
 CAMP LEJEUNE
 NORTH CAROLINA

FIELD PARTY

 IN CHARGE

 INSTRUMENT

 NOTES

 TAPE READ

 TAPE OR ROD

 TAPE OR ROD

 INSTRUMENT NO. _____
 TAPE NO. _____

WEATHER

CLEAR
 CLOUDY
 WINDY
 RAIN
 FAIR

SNOW
 HOT
 MODERATE
 COLD
 FOG

FILE No. _____
 FLDR. No. _____
 SHEET _____
 DATE _____ 19__

FIGURED BY _____
 NOTES CHECKED BY _____
 PLOTTED BY _____
 Quad. No. _____

STATION	DIST.	ANGLE		+	H. I. BEARING	VER. ANG. DIFF.	ELEVATION		
		°	' "						
B.M.							13.81		
							2.72	16.53	
					5.0	11.5			BORING # 1 6
					4.8	11.7			BORING # 2 7
					4.4	12.1			BORING # 3 8
					5.0	11.6			BORING # 4 9
					4.2	12.3			BORING # 5 10
					2.72	13.81	(13.81)		











VALUABLE

SUBJECT _____

RETURN TO
PUBLIC WORKS
OFFICE
CAMP LEJEUNE
NORTH CAROLINA

FIELD PARTY

IN CHARGE

INSTRUMENT

NOTES

TAPE READ

TAPE OR ROD

TAPE OR ROD

INSTRUMENT No.

TAPE No.

WEATHER

CLEAR
CLOUDY
WINDY
RAIN
FAIR
SNOW
HOT
MODERATE
COLD
FOG

FILE No. _____

FLDR. No. _____

FIGURED BY _____ SHEET _____

NOTES CHECKED BY _____

PLOTTED BY _____ DATE _____ 19__

Quad. No. _____

STATION	DIST.	ANGLE ° ' "	+	H. I. BEARING	VER. ANG. DIFF.	ELEVATION	
BORING #1	FROM			0 TO 1.5			DARK SAND
	"			1.5 " 3.0			YELLOW "
	"			3.0 " 3.6"			SAND & CLAY
				9.0			WATER TABLE QUICK SAND STARTS
	"			3.6 " 10.5			WHITE SAND
BORING #2	FROM			0 TO 1.5			DARK SAND
	"			1.5 " 2.5			YELLOW "
	"			2.5 " 4.0			SAND & CLAY
				9.0			WATER TABLE QUICK SAND STARTS
	"			4.0 " 10.0			WHITE SAND

VALUABLE

SUBJECT _____

 RETURN TO
 PUBLIC WORKS
 OFFICE
 CAMP LEJEUNE
 NORTH CAROLINA

FIELD PARTY

 _____ IN CHARGE
 _____ INSTRUMENT
 _____ NOTES
 _____ TAPE READ
 _____ TAPE OR ROD
 _____ TAPE OR ROD
 _____ INSTRUMENT NO.
 _____ TAPE NO.

WEATHER

 CLEAR
 CLOUDY
 WINDY
 RAIN
 FAIR
 SNOW
 HOT
 MODERATE
 COLD
 FOG

FILE No. _____

FLDR. No. _____

SHEET _____

DATE _____ 19__

Quad. No. _____

STATION	DIST.	ANGLE " "	+	H. I. BEARING	VER. ANG. DIFF.	ELEVATION	
BORING # 3 (8)		FROM		0 TO 1.5			DARK SAND
		"		1.5 " 2.5			YELLOW "
		"		2.5 " 3.3			SAND & CLAY
		"		9.0 "			WATER TABLE QUICK SAND STARTS
		"		3.3 " 10.3			WHITE SAND
BORING # 4 (9)		FROM		0 TO 1.5			DARK SAND
		"		1.5 " 3.0			YELLOW "
		"		3.0 " 3.8			SAND & CLAY
		"		3.8 " 6.0			YELLOW SAND
		"		9.0 "			WATER TABLE QUICK SAND STARTS
		"		6.0 " 10.3			WHITE SAND
BORING # 5 (10)		FROM		0 TO 1.5			DARK SAND
		"		1.5 " 3.5			YELLOW SAND
		"		9.5 "			WATER TABLE QUICK SAND STARTS
		"		3.5 " 10.5			WHITE SAND

VALUABLE

RETURN TO
PUBLIC WORKS
OFFICE
CAMP LEJEUNE
NORTH CAROLINA

SUBJECT LOCATION WATER
LINES COURTHOUSE
BAY

FIELD PARTY
DEYNIS IN CHARGE

INSTRUMENT

NOTES

TAPE READ

TAPE OR ROD

TAPE OR ROD

INSTRUMENT NO.


TAPE NO.

WEATHER
CLEAR
CLOUDY
WINDY
RAIN
FAIR
SNOW
HOT
MODERATE
COLD
FOG
FIGURED BY _____
NOTES CHECKED BY _____
PLOTTED BY _____

FILE No. 219-2
FLDR. No. _____
SHEET 7 of 3
DATE 9-2-55

Quad. No. _____

STATION	DIST.	ANGLE ° ' "	+	H. I. BEARING	VER. ANG. DIFF.	ELEVATION
---------	-------	----------------	---	------------------	--------------------	-----------

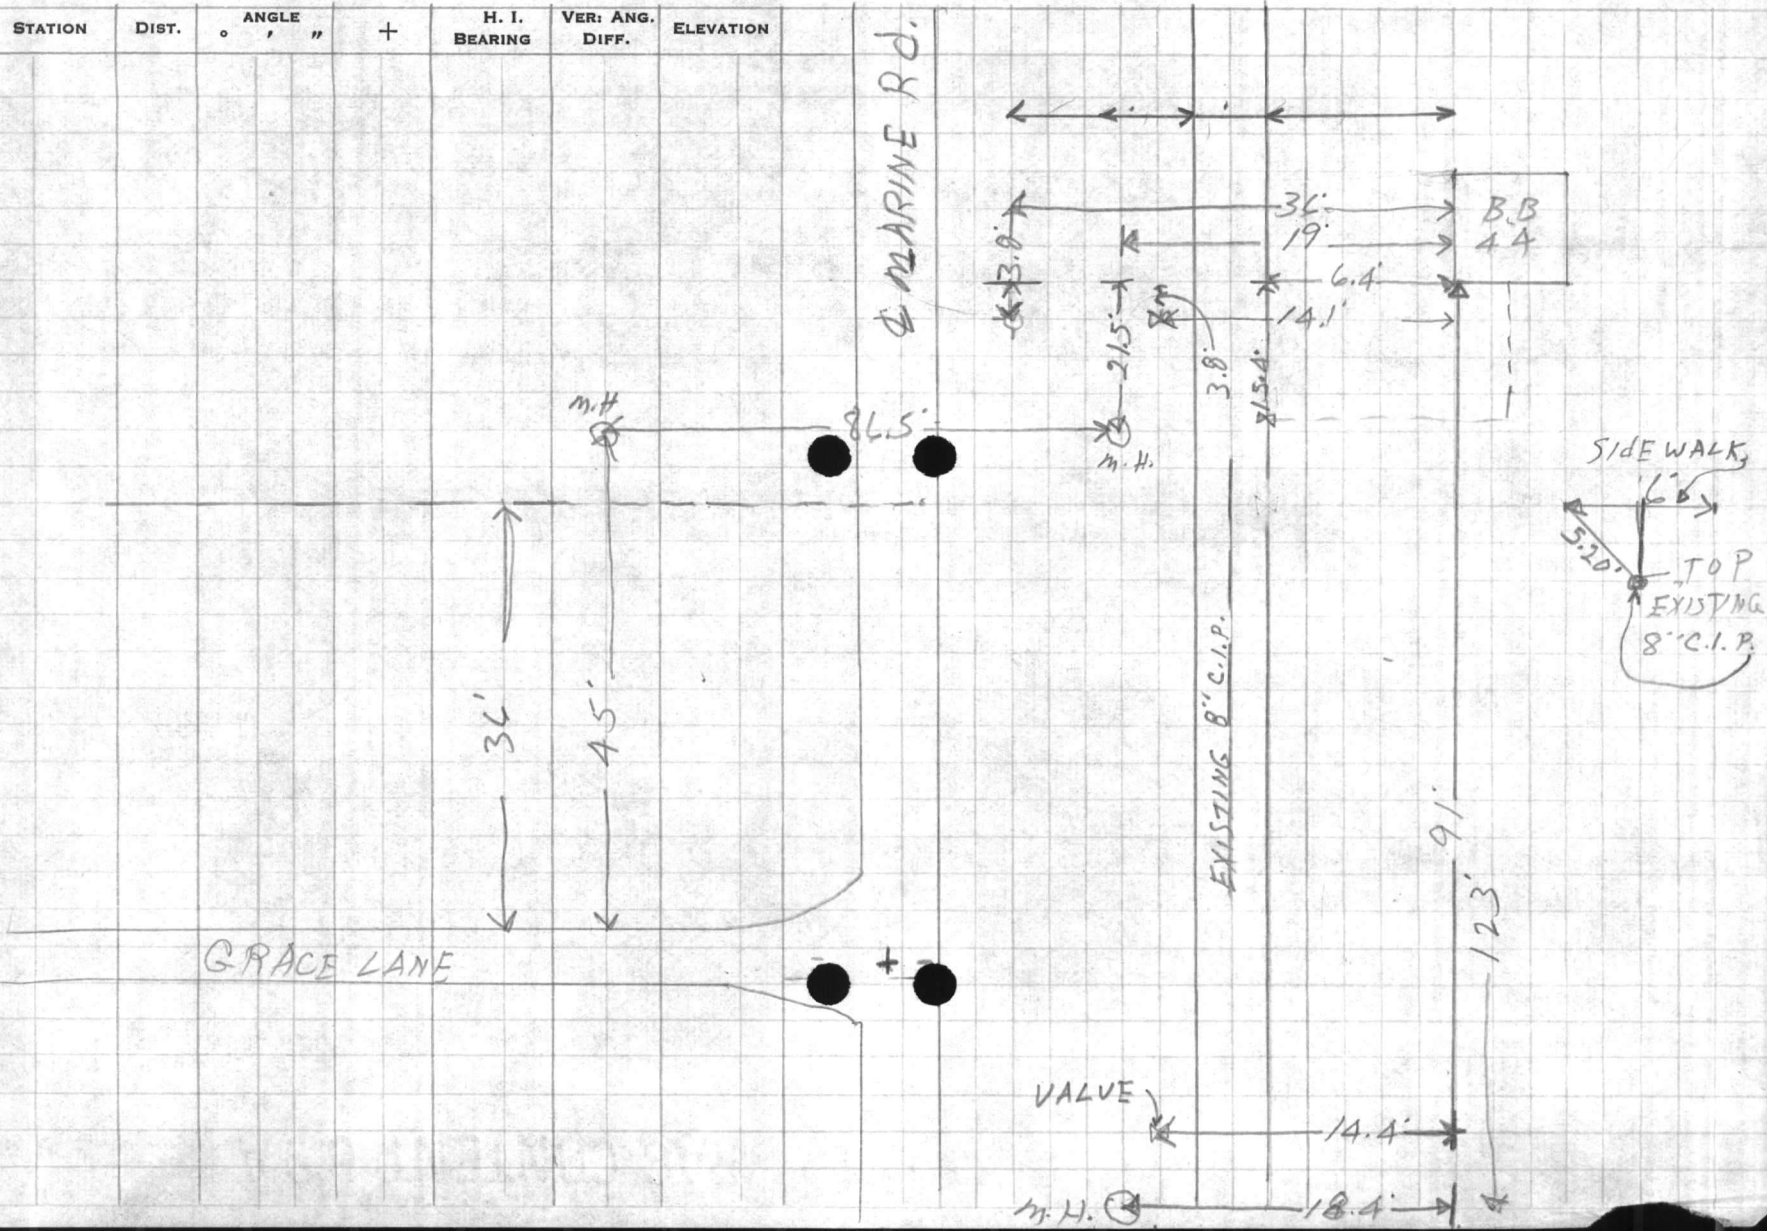




















VALUABLE

RETURN TO
PUBLIC WORKS
OFFICE
CAMP LEJEUNE
NORTH CAROLINA

SUBJECT PROFILE BY GROUND
FOR PROPOSED NEW 8"
C.I. WATER LINE COURT
HOUSE BAY NEAR B.B.44

FIELD PARTY

____ IN CHARGE
____ INSTRUMENT
____ NOTES
____ TAPE READ
____ TAPE OR ROD
____ TAPE OR ROD
____ INSTRUMENT NO.
____ TAPE NO.

WEATHER

CLEAR
CLOUDY
RAIN
FAIR
SNOW
HOT
MODERATE
COLD
FOG
FIGURED BY _____
NOTES CHECKED BY _____
PLOTTED BY _____

FILE No. _____
FLDR. No. _____
SHEET 30 of 3
DATE 9-2 1955

Quad. No. _____

STATION	DIST.	ANGLE ° ' "	+	H. I. BEARING	VER: ANG. DIFF.	ELEVATION	
B.M.			488			17 70	NAIL INT. MARINE RD. - 8 GRACE LANE
				22 58 22 6			
0+00				4 63	18 0		E C SIDE WALK
0+3				4 68	17 9		EDGE C SIDE WALK
0+14				5 2	17 4		BANK
0+19				6 3	16 3		EDGE COM. LINED DITCH
0+22				8 20	14 4		DN. COM. IN DITCH
0+24				8 20	14 4		DN. COM. IN DITCH
0+26				6 0	16 6		EDGE COM. LINED DITCH
0+29				4 5	18 1		BANK
0+34				4 2	18 4		
0+39				4 30	18 3		EDGE MARINE RD.
0+41				4 48	18 1		EDGE MARINE RD.
0+70				4 7	17 9		
0+80				5 3	17 3		
0+87				4 9	17 7		
1+00				5 2	17 4		
1+50				5 3	17 3		

26.00
23.00
14.50
12.00
32.00

127.50

168.28
127.50

40.78

599




VALUABLE

RETURN TO
PUBLIC WORKS
OFFICE
CAMP LEJEUNE
NORTH CAROLINA


SUBJECT LINE & TOPD. PROPOSED
STEAM BLDG. B.B. 9 TO
BLDG. # B.B. 31. COURT -
HOUSE BAY - LINE "A"
5480

FIELD PARTY
DENNIS IN CHARGE
INSTRUMENT
NOTES
TAPE READ
TAPE OR ROD
TAPE OR ROD
INSTRUMENT NO.
TAPE NO.

WEATHER
CLEAR
CLOUDY
WINDY
RAIN
FAIR
SNOW
HOT
MODERATE
COLD
FOG
FIGURED BY
NOTES CHECKED BY
PLOTTED BY

FILE No. 219J
FLDR. No. _____
SHEET 1 of 3
DATE 1-3 1956

Quad. No. _____

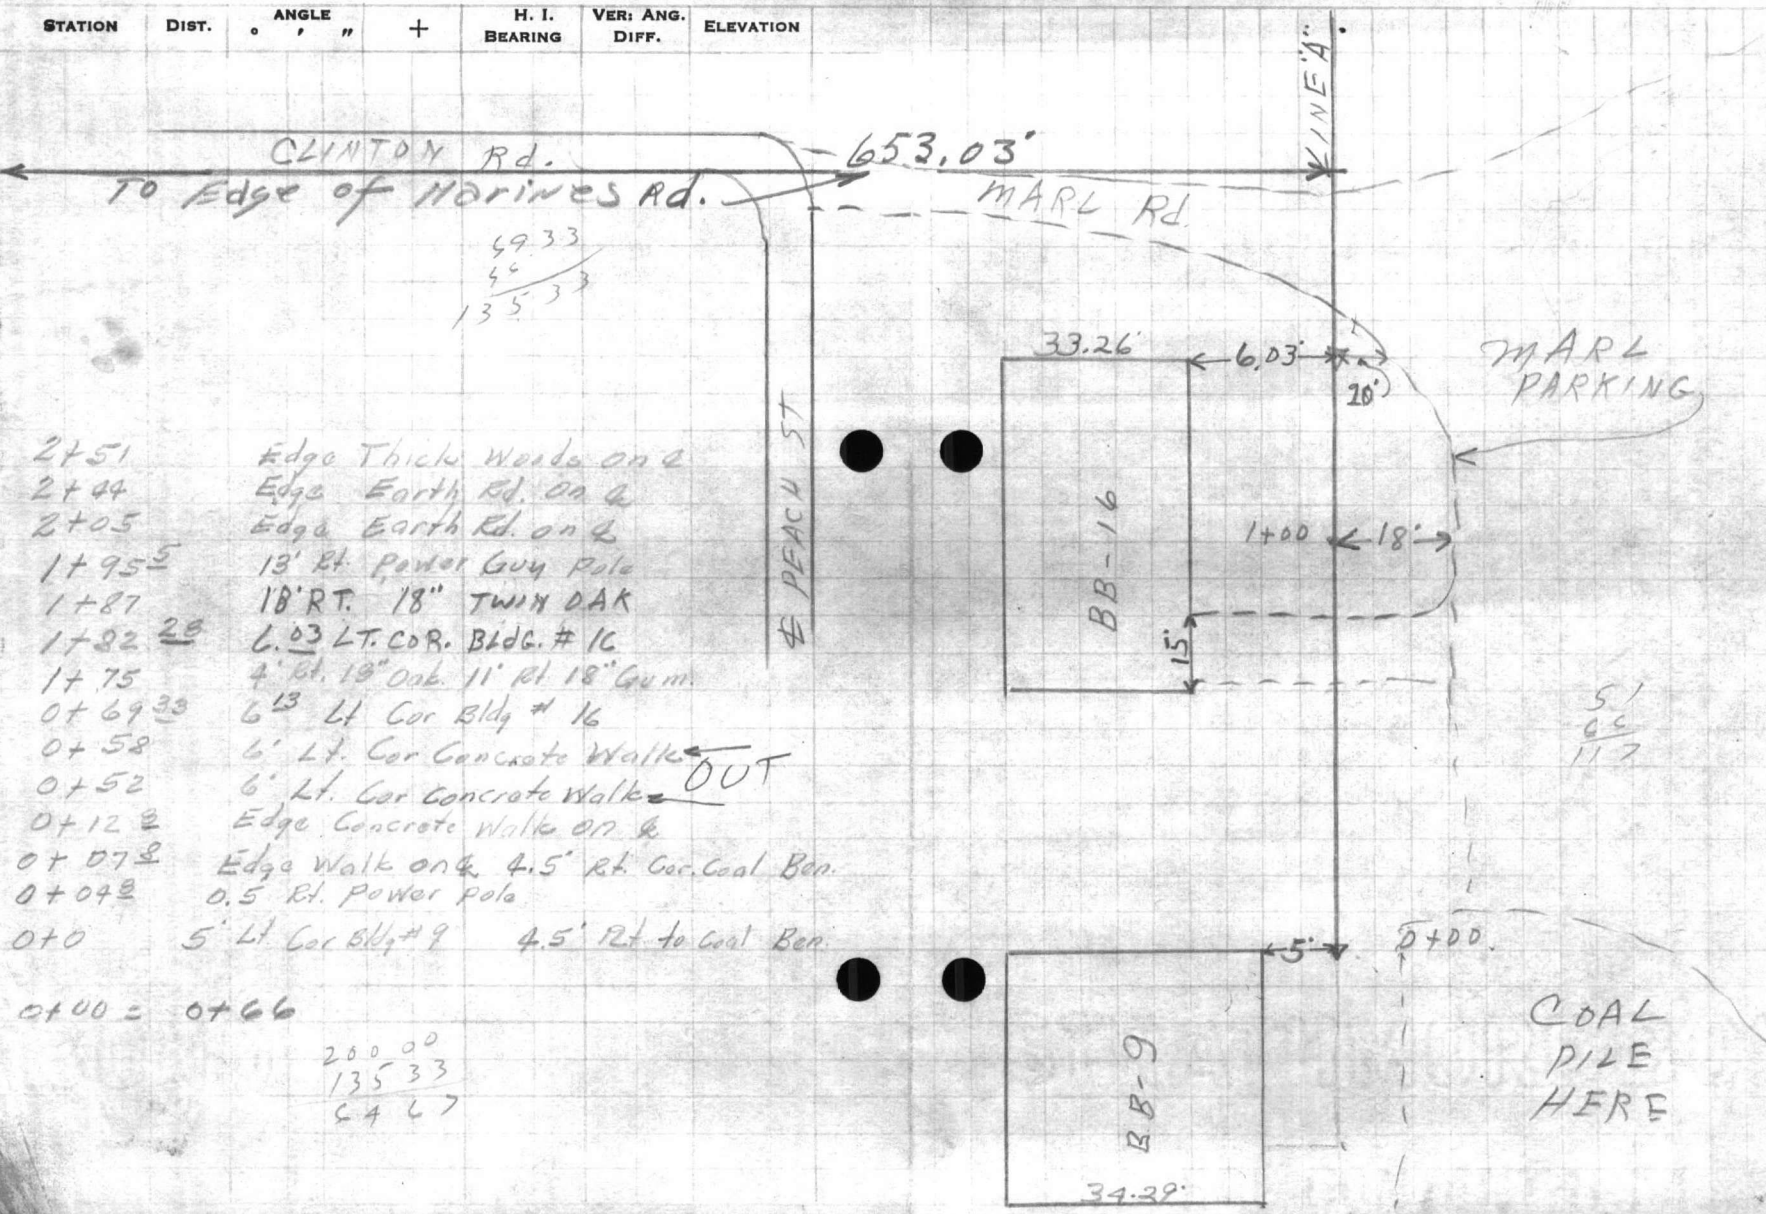

- 2+51 Edge Thick Woods on a
- 2+44 Edge Earth Rd. on a
- 2+05 Edge Earth Rd. on b
- 1+95.5 13' Rt. Power Guy Pole
- 1+87 18' RT. 18" TWIN OAK
- 1+82.25 6.03 LT. COR. BLDG. # 16
- 1+75 4' Rt. 18" Oak. 11' Rt. 18" Gum.
- 0+69.33 6' Lt. Cor Bldg # 16
- 0+58 6' Lt. Cor Concrete Walk
- 0+52 6' Lt. Cor Concrete Walk
- 0+12.2 Edge Concrete Walk on b
- 0+07.2 Edge Walk on a. 4.5' Rt. Cor. Coal Ben.
- 0+04.2 0.5 Rt. Power Pole
- 0+0 5' Lt. Cor Bldg # 9 4.5' Rt. to Coal Ben.

0+00 = 0+66
200.00
135.33
344.7

51
65
117

















 SUBJECT _____

 RETURN TO
 PUBLIC WORKS
 OFFICE
 CAMP LEJEUNE
 NORTH CAROLINA

FIELD PARTY

 _____ IN CHARGE
 _____ INSTRUMENT
 _____ NOTES
 _____ TAPE READ
 _____ TAPE OR ROD
 _____ TAPE OR ROD
 _____ INSTRUMENT NO.
 _____ TAPE NO.

WEATHER

 CLEAR SNOW
 CLOUDY HOT
 WINDY MODERATE
 RAIN COLD
 FAIR FOG
 FIGURED BY _____
 NOTES CHECKED BY _____
 PLOTTED BY _____

 FILE No. _____
 FLDR. No. _____
 SHEET 20
 DATE _____ 19__

Quad. No. _____

STATION	DIST.	ANGLE		+	H. I. BEARING	VER. ANG. DIFF.	ELEVATION
		°	' "				
9+05							
<u>66</u>							
8+39'							
8+77							
<u>8+19^{SD}</u>							
7+85							
<u>66</u>							
8+51							

 P.O.T. 6+09⁰³ 6+75⁰³

5+25 EDGE SWAMP AREA

 P.O.T. 4+49⁵⁹ 5+15⁵⁹

 4+22 BANK
 4+15 CENTER STREAM
 4+09 BANK
66
 8+55

 THIS AREA REAL
 THICK WITH BRUSH
 & VINES
 3+40 TO 5+50

 P.O.T. 4+49⁵⁹
66
5+15⁵⁹

STREAM

 2+48²⁸
 P.O.T. 1+82²⁸

 FLOOD LIGHT
 POLES
 POLE
 OPEN AREA
 SMALL PINES
 & GUMS IN THIS
 AREA

1894.10
 1780.97

 113.13

1636.97
 1605.52

 31.45



VALUABLE

SUBJECT _____

RETURN TO
PUBLIC WORKS
OFFICE
CAMP LEJEUNE
NORTH CAROLINA

FIELD PARTY

IN CHARGE _____

INSTRUMENT _____

NOTES _____

TAPE READ _____

TAPE OR ROD _____

TAPE OR ROD _____

INSTRUMENT NO. _____

TAPE NO. _____

WEATHER

CLEAR
CLOUDY
WINDY
RAIN
FAIR

SNOW
HOT
MODERATE
COLD
FOG

FILE No. _____

FLDR. No. _____

FIGURED BY _____ SHEET 304

NOTES CHECKED BY _____

PLOTTED BY _____ DATE 1-5-56

Quad. No. _____

STATION	DIST.	ANGLE	H. I. BEARING	VER. DIFF.	ANG. DIFF.	ELEVATION
17+95	18	178.43	LT. COR. BLDG. # 31			
16+56	18	26.45	LT. COR. BLDG.			
17+06	58					
16+31			EDGE MARL Rd.			
16+12	78		25.45' LT. COR. BLDG.			
16+78	65					
15+83			EDGE MARL Rd.			
15+79			142.50' RT. POWER POLE S.H. 11			
15+71			34' LT. FIRE HYD. ✓			
15+68			WOODS LINE ON E ✓			
15+58			13' LT. POWER POLE S.H. 10. ✓			
15+37			10' LT. GUY WIRE ✓			
15+31			20' RT. COR. WOODS 10' LT. GUY WIRE ✓			
14+85			6' RT. 8" GUM ✓			
14+83			3' RT. 8" GUM ✓			
14+70			8' RT. 10" PINE ✓			
14+67			1' RT. 16" PINE ✓			
14+58			13' RT. 18" PINE ✓			
13+62			15' LT. 18" PINE ✓			
13+54			6' RT. 14" PINE ✓			
13+29			6' LT. GUY WIRE			
13+12			.50' RT. 8" GUM			
13+08			WOOD LINE ON E 75' RT. COR. WOOD.			
13+05			45° LT. FLOOD LIGHT POLE			
12+44	00		84' RT. FLOOD LIGHT POLE			

$$\begin{array}{r} 166 \\ 12 \\ \hline 78 \end{array}$$

$$\begin{array}{r} 66 \\ 29 \\ \hline 95 \end{array}$$

$$\begin{array}{r} 02 \\ 63 \\ \hline 74 \end{array}$$


12+44

SS OPEN AREA

FLOOD LIGHT POLE

POT.
13+00FLOOD
LIGHT
POLE 0

POT. 14+09.03

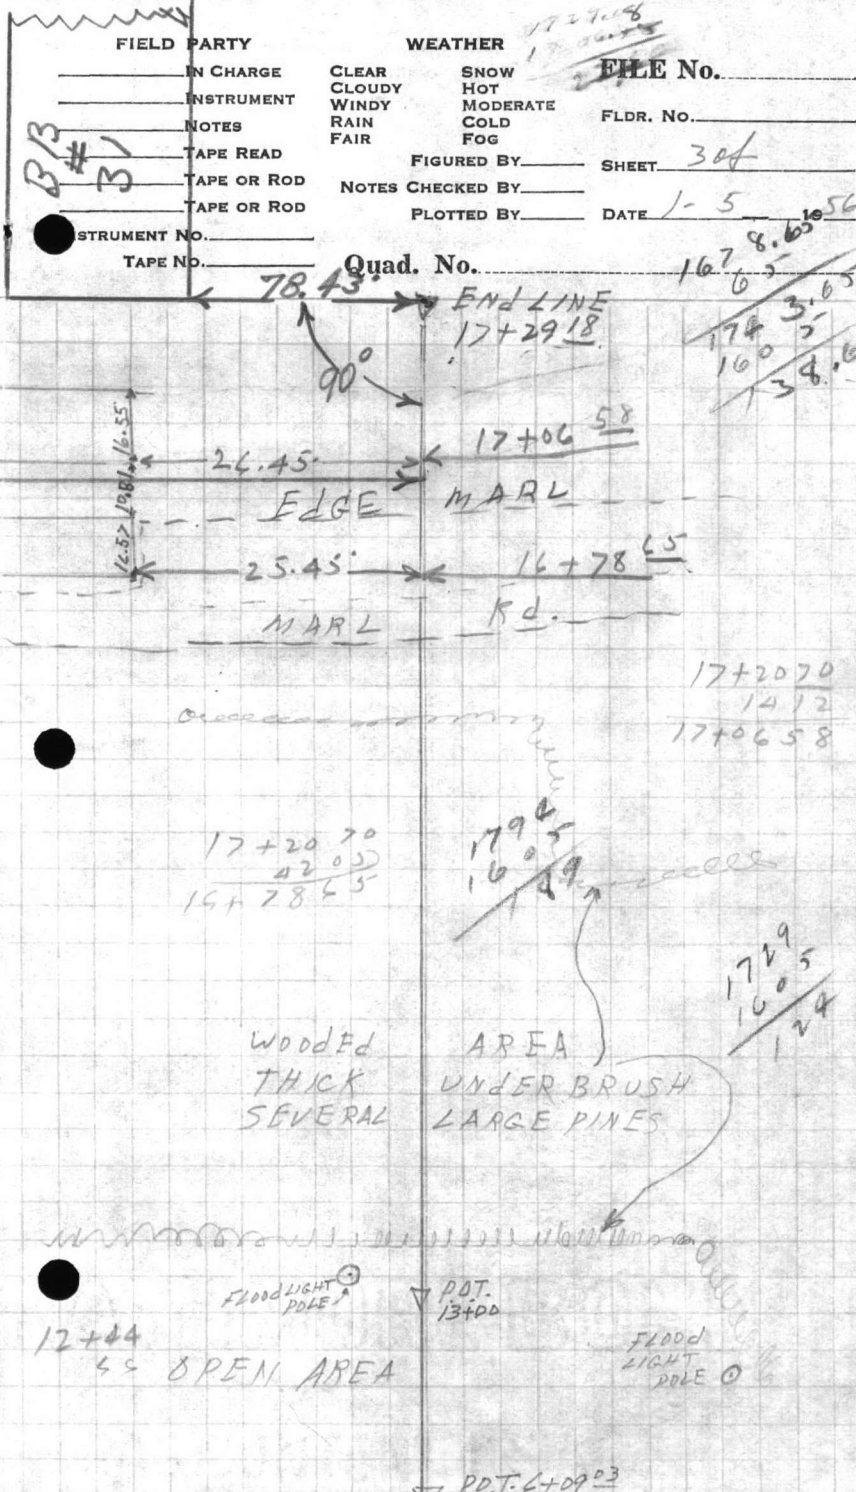











VALUABLE

SUBJECT _____

 RETURN TO
 PUBLIC WORKS
 OFFICE
 CAMP LEJEUNE
 NORTH CAROLINA

FIELD PARTY

 _____ IN CHARGE
 _____ INSTRUMENT
 _____ NOTES
 _____ TAPE READ
 _____ TAPE OR ROD
 _____ TAPE OR ROD
 _____ INSTRUMENT NO.
 _____ TAPE NO.

WEATHER

 CLEAR
 CLOUDY
 WINDY
 RAIN
 FAIR
 SNOW
 HOT
 MODERATE
 COLD
 FOG

FILE No. _____

FLDR. No. _____

SHEET 3 "A"

NOTES CHECKED BY _____

PLOTTED BY _____ DATE _____ 19__

Quad. No. _____

STATION	DIST.	ANGLE " "	+	H. I. BEARING	VER. ANG. DIFF.	ELEVATION	
B.m.				384 26 15		2231	FIRE HYD
STA. 15+56 ⁰⁰							34" LT. WATER VALVE
STA. 15+54 ³⁰						965 16.50	TOP 6" C.I. WATER MAIN
STA. 14+55 ⁰⁰							129' RT. SEWER MAN HOLE
STA. 14+65 ⁴⁰						820 17.95	TOP 6" C.I. SEWER LINE
B.m.				384 22 31		2231	FIRE HYD.

15+54






VALUABLE
 RETURN TO
 PUBLIC WORKS
 OFFICE
 CAMP LEJEUNE
 NORTH CAROLINA

 SUBJECT STAKE STEAM LINE
"B" FROM STA. 14+97.50 ON
LINE "A" TO A POINT 9.60'
FROM SOUTH EAST COR.
BLDG B.B. 26

FIELD PARTY

 _____ IN CHARGE
 _____ INSTRUMENT
 _____ NOTES
 _____ TAPE READ
 _____ TAPE OR ROD
 _____ TAPE OR ROD
 _____ INSTRUMENT NO.
 _____ TAPE NO.

WEATHER

 CLEAR
 CLOUDY
 WINDY
 RAIN
 FAIR
 SNOW
 HOT
 MODERATE
 COLD
 FOG

FILE No. _____

FLDR. No. _____

SHEET 1 of 1

FIGURED BY _____

NOTES CHECKED BY _____

PLOTTED BY _____


DATE 1-5-56

Quad. No. _____

STATION	DIST.	ANGLE " +	H. I. BEARING	VER. ANG. DIFF.	ELEVATION
5+29 ⁵⁵					
5+15 ⁴⁰					
5+14 ²⁵					
5+02	13.50'	RT. Φ			
4+73					
3+94					
3+88	3'	RT. 10"			
3+78	1'	LT. 14"			
3+57	5'	LT. 9"			
3+53	3'	LT. 12"			
3+50	11'	RT. 14"			
3+31	5'	LT. 4"			
2+93	13'	RT. 14"			
2+91	6.5'	LT. 14"			
2+49	3'	RT. 12"			
2+39	4'	LT. 12"			
2+00	10'	RT. 12"			
1+83	10'	LT. 20"			
1+75					
1+00	10'	LT. GUYWIRE	32.50'	LT. POWER POLE	
0+52					
0+15	3'	RT. 18"			

 P.O.T. 14+96⁵⁸ LINE "A"
 = 0+00 LINE "B"

 P.O.T.
 13+00

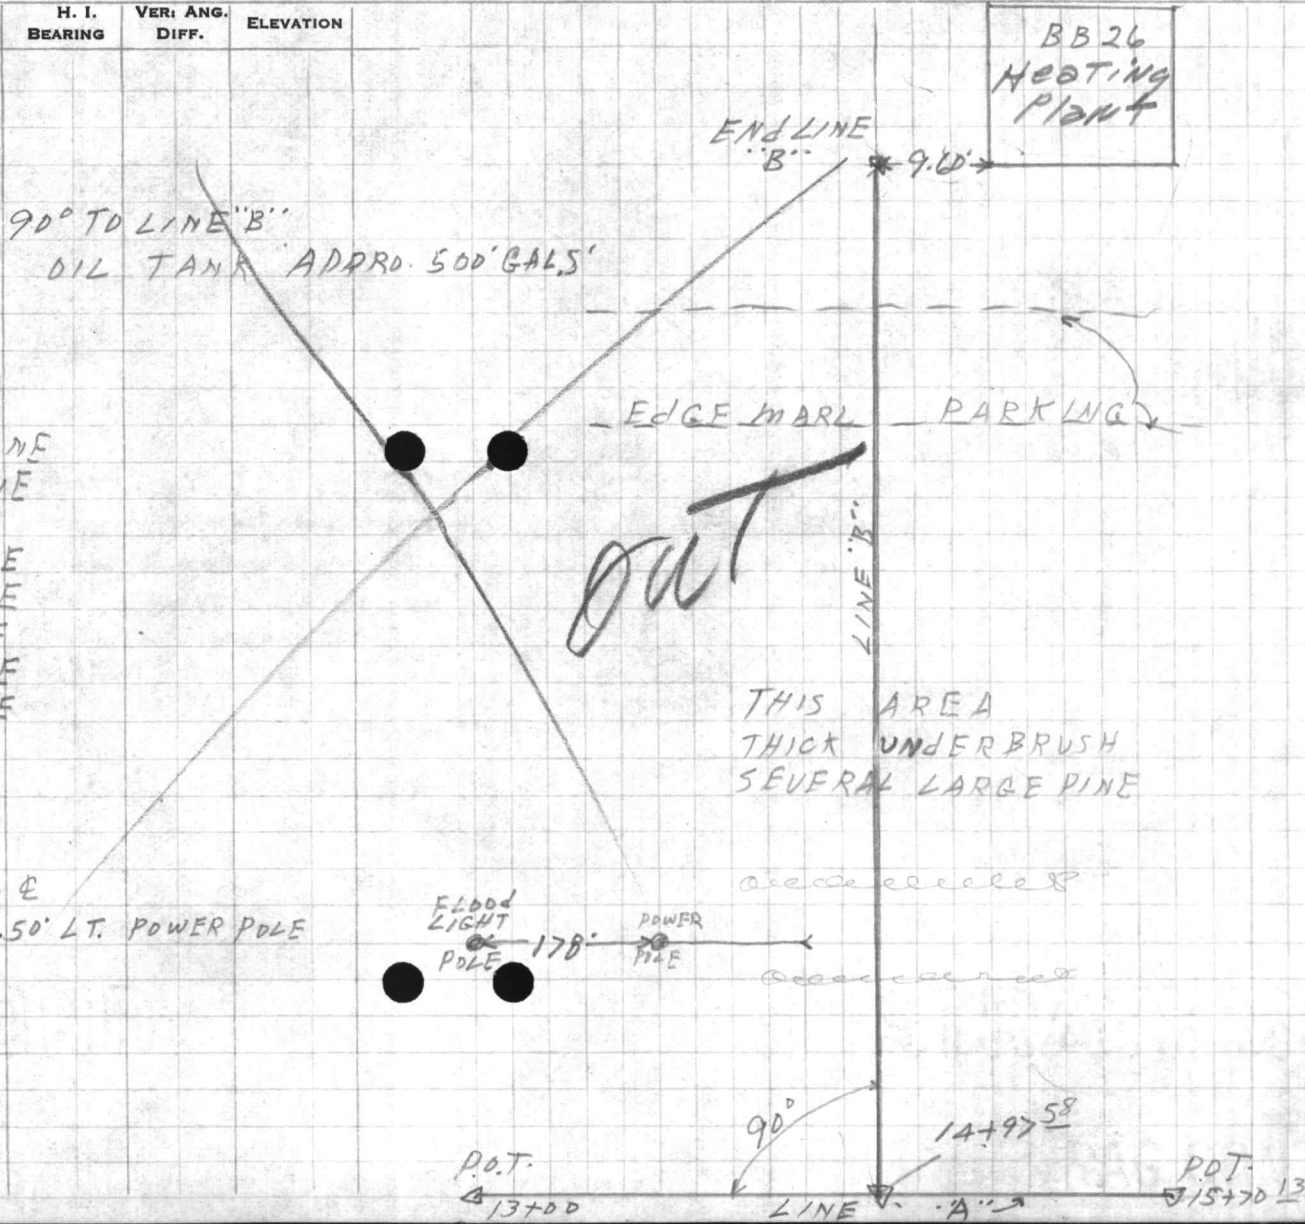 P.O.T.
 15+70¹³



















VALUABLERETURN TO
PUBLIC WORKS
OFFICE
CAMP LEJEUNE
NORTH CAROLINASUBJECT PROFILE ON PROPOSED
STEAM-BLDG. B.B. 9 TO
B.B. 17 COURT HOUSE
BAY LINE 'A' & 'B'

FIELD PARTY

DENNIS IN CHARGE

INSTRUMENT

NOTES

TAPE READ

TAPE OR ROD

TAPE OR ROD

INSTRUMENT No. _____
TAPE No. _____

WEATHER

CLEAR _____
CLOUDY _____
WINDY _____
RAIN _____
FAIR _____
SNOW _____
HOT _____
MODERATE _____
COLD _____
FOG _____

FILE No. _____

FLDR. No. _____

SHEET 1 of 6

FIGURED BY _____

NOTES CHECKED BY _____

PLOTTED BY _____

DATE 1-5 1956

Quad. No. _____

STATION	DIST.	ANGLE ' "	+	H. I. BEARING	VER. ANG. DIFF.	ELEVATION	
B.M.			278	16.55 16.65 <u>16.6</u>		13.875	NAK INTER. PEACH & MIDDLE ST.
0+0	0+66				4.0	12.6	
0+078	0+73.8				4.01	12.64	
0+128	0+78.8				4.01	12.64	
0+50	1+16				4.7	11.9	
1+00	1+66				4.7	11.9	
1+50	2+16				5.5	11.1	
1+82 ²⁴	2+48 ²⁸				5.9	10.7	
1+94	2+60				5.7	10.9	
2+00	2+66				6.1	10.5	
2+04	2+70				6.6	10.0	
2+05	2+71				7.2	9.4	MARL EDGE Rd.
2+28	2+94				6.8	9.8	
2+44	3+10				7.6	9.0	MARL EDGE Rd.
2+48	3+14				8.8	7.8	
T.P.			2.09	11.61 11.51	7.13	9.42	

































VALUABLE

SUBJECT _____

 RETURN TO
 PUBLIC WORKS
 OFFICE
 CAMP LEJEUNE
 NORTH CAROLINA

FIELD PARTY

 _____ IN CHARGE
 _____ INSTRUMENT
 _____ NOTES
 _____ TAPE READ
 _____ TAPE OR ROD
 _____ TAPE OR ROD
 _____ INSTRUMENT No.
 _____ TAPE No.

WEATHER

 CLEAR
 CLOUDY
 WINDY
 RAIN
 FAIR
 SNOW
 HOT
 MODERATE
 COLD
 FOG

FILE No. _____

FLDR. No. _____

FIGURED BY _____

SHEET 2 of

NOTES CHECKED BY _____

PLOTTED BY _____

DATE _____ 19__

Quad. No. _____

STATION	DIST.	ANGLE " "	+	H. I. BEARING	VER. ANG. DIFF.	ELEVATION	
2+68	3+34			⁶¹ 11.57 <u>11.6</u>	4.5	7.1	
2+92	3+58				3.4	8.2	
3+00	3+60				4.6	7.0	
3+27	3+93				5.3	6.3	
3+48	4+14				5.6	6.0	
3+55	4+21				4.8	6.8	
4+00	4+60				5.4	6.2	
4+06	4+12				5.9	5.7	BANK
4+15	4+81				8.5	3.1	ESTREAM
4+22	4+89				6.0	5.6	BANK
4+38	5+04				5.9	5.7	
4+49 ⁵⁸	5+15 ⁵⁸				3.5	8.1	
T-P.			448	54	3.55	7.96 8.00	
4+61	5+27			12.4 <u>12.5</u>	5.9	6.6	
4+80	5+46				6.1	6.4	




























VALUABLE

SUBJECT _____

 RETURN TO
 PUBLIC WORKS
 OFFICE
 CAMP LEJEUNE
 NORTH CAROLINA

FIELD PARTY

 _____ IN CHARGE
 _____ INSTRUMENT
 _____ NOTES
 _____ TAPE READ
 _____ TAPE OR ROD
 _____ TAPE OR ROD
 _____ INSTRUMENT NO.
 _____ TAPE NO.

WEATHER

 CLEAR
 CLOUDY
 WINDY
 RAIN
 FAIR
 SNOW
 HOT
 MODERATE
 COLD
 FOG

FILE No. _____

FLDR. No. _____

SHEET 3 of

NOTES CHECKED BY _____

FIGURED BY _____ PLOTTED BY _____ DATE _____ 19__

Quad. No. _____

STATION	DIST.	ANGLE ' "	+	H. I. BEARING	VER. ANG. DIFF.	ELEVATION
				⁵⁴ 12.77 <u>(12.5)</u>		
5+00	5+66				6.2	6.3
5+33	5+99				5.0	7.5
5+51	6+17				4.1	8.4
5+72	6+38				2.6	9.9
6+00	6+66				1.3	11.2
T.P.			7.21	⁷⁰ 18.60 <u>(18.2)</u>	1.05	11.39
6+50	7+16				7.0	11.7
7+00	7+66				6.1	12.6
7+50	8+16				5.3	13.4
8+00	8+66				4.5	14.2
8+22	8+88				4.5	14.2
8+50	9+16				5.6	13.2
9+00	9+66				6.3	12.4
9+50	10+16				6.1	12.6
10+0	10+66				5.6	13.1
10+50	11+16				5.2	13.5


































VALUABLE

SUBJECT _____

 RETURN TO
 PUBLIC WORKS
 OFFICE
 CAMP LEJEUNE
 NORTH CAROLINA

FIELD PARTY

 _____ IN CHARGE
 _____ INSTRUMENT
 _____ NOTES
 _____ TAPE READ
 _____ TAPE OR ROD
 _____ TAPE OR ROD
 _____ INSTRUMENT No.
 _____ TAPE No.

WEATHER

 CLEAR
 CLOUDY
 WINDY
 RAIN
 FAIR
 SNOW
 HOT
 MODERATE
 COLD
 FOG

FILE No. _____

FLDR. No. _____

SHEET 4 of

FIGURED BY _____

NOTES CHECKED BY _____

PLOTTED BY _____

DATE _____ 19__

Quad. No. _____

STATION	DIST.	ANGLE " "	+	H. I. BEARING	VER: ANG. DIFF.	ELEVATION
11+00	11+66			18.70 <u>(18.7)</u>	5.4	13.3
T.P.			7.91	22 04	4.57	14.0
11+50	12+16			21.94 <u>(22.0)</u>	8.5	13.5
12+00	12+66				8.0	14.0
12+50	13+16				7.3	14.7
13+00	13+66				5.2	16.8
13+14	13 80				4.2	17.8
13+50	14+16				3.1	18.9
14+00	14+66				2.3	19.7
14+50	15+16				1.6	20.4
T.P.			5.81	27 05	0.80	21.4
P.O.T. 1A+97	<u>58</u> 15+63 <u>58</u>			26.95 <u>(27.0)</u>	6.05	21.00 20.90
15+00	15+66				4.1	21.0
15+50	16+16				5.7	21.4
15+73	16+39				5.8	21.3








VALUABLE

RETURN TO
PUBLIC WORKS
OFFICE
CAMP LEJEUNE
NORTH CAROLINA

SUBJECT _____

1576
1642
1795
1539
254

FIELD PARTY

IN CHARGE

INSTRUMENT

NOTES

TAPE READ

TAPE OR ROD

TAPE OR ROD

INSTRUMENT No.

TAPE No.

WEATHER

CLEAR
CLOUDY
WINDY
RAIN
FAIR
SNOW
HOT
MODERATE
COLD
FOG
FIGURED BY _____
NOTES CHECKED BY _____
PLOTTED BY _____

FILE No. _____

FLDR. No. _____

SHEET 504

DATE _____ 19__

Quad. No. _____

STATION	DIST.	ANGLE " "	+	H. I. BEARING	VER: ANG. DIFF.	ELEVATION
15+79	16+42			26.95 27.05 (27.1)	7.4	19.7
15+79	16+95				5.5	21.4
16+00	16+66				4.6	22.5
16+29	16+95				4.5	22.6
16+35 6"	17+01				4.1	21.0
16+42	17+08				5.6	21.5
16+60	17+26				4.1	23.0
17+00	17+66				3.5	23.6
17+29 ¹⁸	17+95 ¹⁸				3.5	23.6
J.P.		0.87		18 4 74		22.27
0+00	LINE "B" = 14+97 ⁵⁸			23.2		
	LINE "A"			(23.2)		
0+50					2.2	21.0
1+00					4.0	19.2
1+50					5.1	18.1

15+39⁵²
16+66
16+05⁵²

END STEAM LINE "A"

FIRE HYD.

out


























VALUABLE

SUBJECT _____

 RETURN TO
 PUBLIC WORKS
 OFFICE
 CAMP LEJEUNE
 NORTH CAROLINA

FIELD PARTY

 IN CHARGE

 INSTRUMENT

 NOTES

 TAPE READ

 TAPE OR ROD

 TAPE OR ROD

 INSTRUMENT No. _____
 TAPE No. _____

WEATHER

CLEAR
 CLOUDY
 WINDY
 RAIN
 FAIR
 SNOW
 HOT
 MODERATE
 COLD
 FOG
 FIGURED BY _____
 NOTES CHECKED BY _____
 PLOTTED BY _____

FILE No. _____
 FLDR. No. _____
 SHEET 60f
 DATE _____ 19__

Quad. No. _____

STATION	DIST.	ANGLE		+	H. I. BEARING	VER: ANG. DIFF.	ELEVATION
		°	' "				
1+74					23 18 <u>23.2</u>	4.1	19 1
1+80						5.0	18 2
2+00						5.9	17 3
2+50						7.0	16 2
3+00						7.4	15 8
T.P.				507	77 <u>21.8</u>	6.48	16.6
3+50						4.7	17.1
3+88						4.4	17 4
3+95						5.5	16 3
4+00						5.2	16 6
4+39						4.9	16.9
4+77						5.9	15 9
5+0						5.8	16 0
5+14.25						8.43	13.34
5+15.30						8.38	13.39
5+29.55						6.1	15 7
B.M.						6.80	14.87 14.97

15-39.5-2
 189.64
 1729.16

out

TOP 2" C.I. STEAM CON.
 TOP 3" C.I. STEAM PIPE
 END LINE "B"
 NAIL INT. MARINER, NE ROBERTS ST.

VALUABLE

RETURN TO
PUBLIC WORKS
OFFICE
CAMP CLERK
NORTH CAROLINA

SUBJECT

STATION

DIST

ANGLE

BEAR

VERT. ANG. DIFF.

ELEVATION

FIELD PARTY

IN CHARGE

ASSISTANT

NOTES

TAPED HEAD

STAMP OR ROD

INSTRUMENT NO.

TYPE NO.

WEATHER

NOTES CHECKED BY

PLOTTED BY

SHEET

FLOR. NO.

FILE NO.

FILE NO.



STATION	DIST	ANGLE	BEAR	VERT. ANG. DIFF.	ELEVATION
1					
2					
VALUABLE

SUBJECT STAKE OUT PROPOSED
STEAM LINE COURT -
HOUSE BAY

RETURN TO
PUBLIC WORKS
OFFICE
CAMP LEJEUNE
NORTH CAROLINA

FIELD PARTY

DENNIS IN CHARGE

INSTRUMENT

NOTES

TAPE READ

TAPE OR ROD

TAPE OR ROD

INSTRUMENT No.

TAPE No.

WEATHER

CLEAR
CLOUDY
WINDY
RAIN
FAIR

SNOW
HOT
MODERATE
COLD
FOG

FIGURED BY

NOTES CHECKED BY

PLOTTED BY

FILE No. _____


FLDR. No. _____

SHEET 1 of 3

DATE 7-23-56

Quad. No. _____

STATION	DIST.	ANGLE " "	+	H. I. BEARING	VER. ANG. DIFF.	ELEVATION
				Bldg. # 51		
				LINE 'B'		
				55'		
				20+18 ³⁴		
				55'		
				5°		
				POWER POLE SHA		
				EDGE MARL ON Φ		
				20+00		
				15.70' RT. COR. MARL.		
				19+74		
				17.50' RT. Φ DROP INLET		
				19+00		
				8' RT. GARAGE RACK		
				18+92		
				EDGE MARL ON Φ		
				18+75 ⁶⁰		
				8" C.I. WATER LINE		
				18+69		
				46' LT. POWERPOLE		
				18+64		
				28' LT. GUY		
				POWER POLE		
				GUY WIRE		
				46'		
				28'		
				O.K.		
				17+20 ²⁰		
				12590200		
				B.S. 16+36 ²⁷		
				3570545		
				TO 20+18 ³⁴		
				M 2590155		

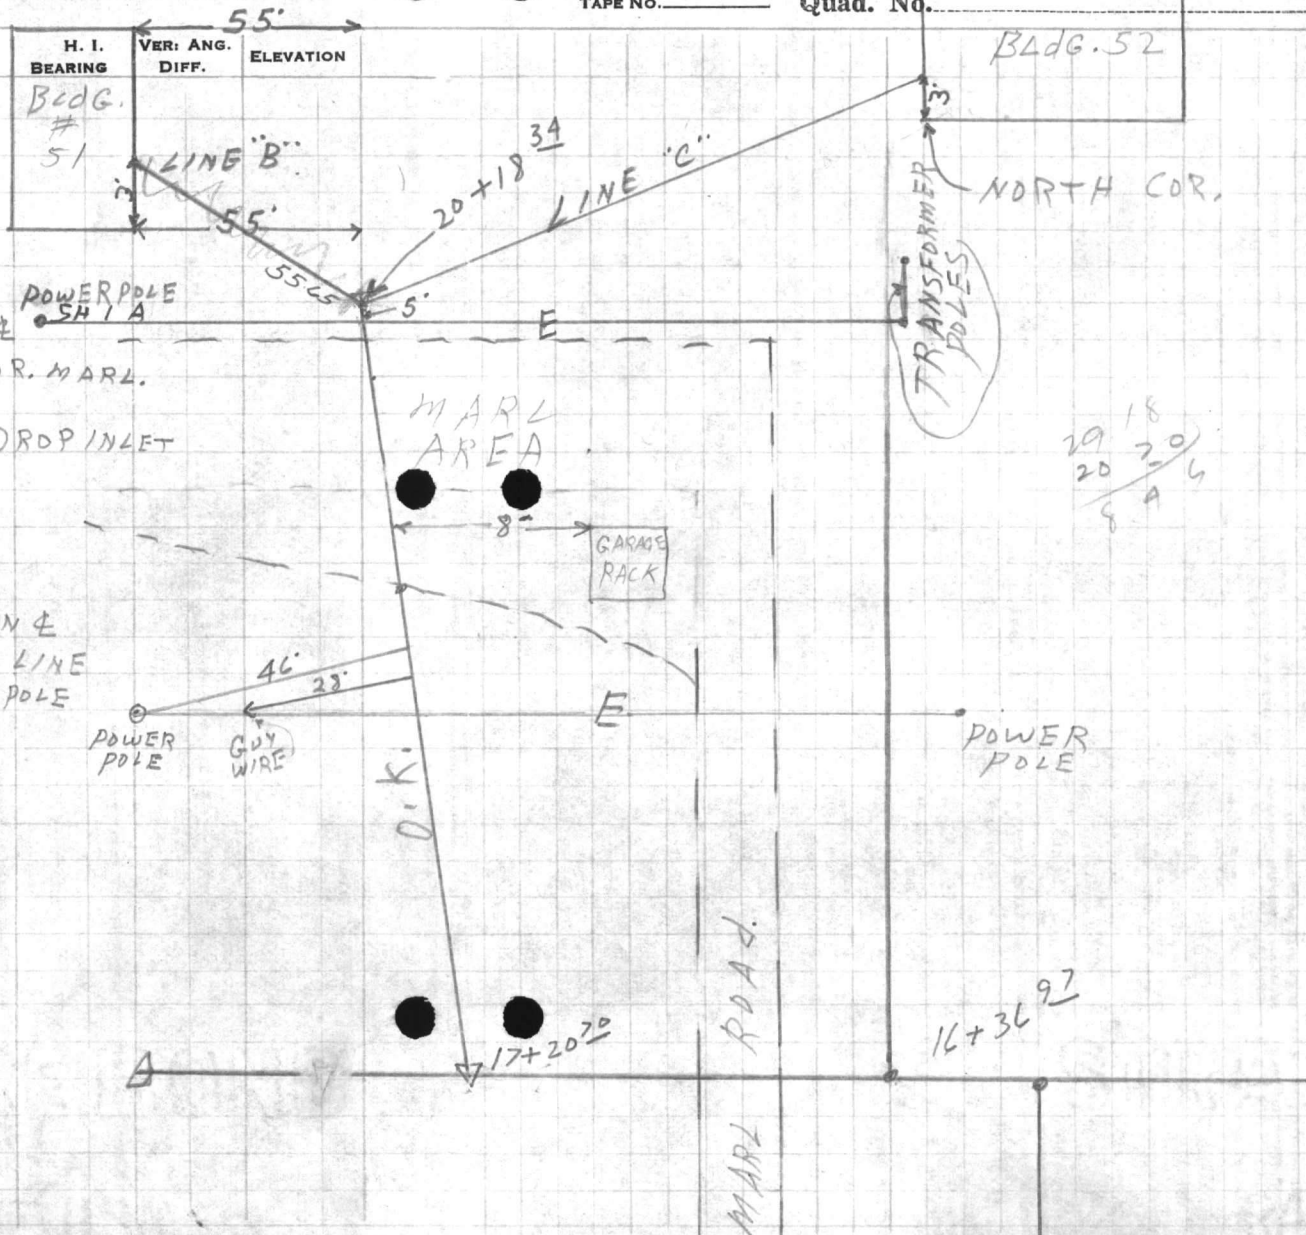

29 18
20 20
8 A

- ① 259° 02' 00"
 ③ 57° 05' 45"

$$\begin{array}{r}
 2590800 \\
 \underline{3} \\
 9770600 \\
 165 \\
 3 \overline{) 7770545} \\
 \underline{2590155}
 \end{array}$$

$$\begin{array}{r}
 120 \\
 \underline{45} \\
 3 \overline{) 615} \\
 \underline{58}
 \end{array}$$

VALUABLE

SUBJECT

LINE "B"

RETURN TO
PUBLIC WORKS
OFFICE
CAMP LEJEUNE
NORTH CAROLINA

FIELD PARTY

____ IN CHARGE
____ INSTRUMENT
____ NOTES
____ TAPE READ
____ TAPE OR ROD
____ TAPE OR ROD
____ INSTRUMENT NO.
____ TAPE NO.

WEATHER

CLEAR SNOW
CLOUDY HOT
WINDY MODERATE
RAIN COLD
FAIR FOG

FILE No. _____

FLDR. No. _____

SHEET


243

DATE

19 _____

Quad. No. _____

STATION	DIST.	ANGLE ° ' "	+	H. I. BEARING	VER. ANG. DIFF.	ELEVATION
---------	-------	----------------	---	------------------	--------------------	-----------

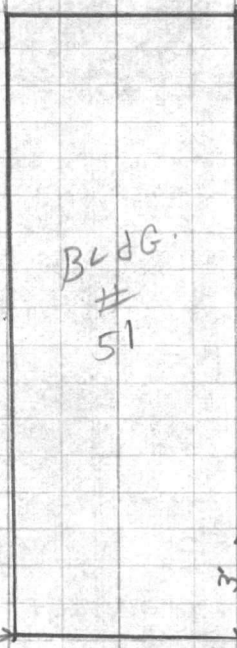

$\leftarrow 9.50$
 $\downarrow 3$
 D.I.

$20+18 \frac{34}{950}$
 $\frac{20+08 \ 84}{}$

$\nearrow 20+18 \frac{34}{}$
 B.S. $17+20 \frac{70}{}$ 3 296 15 30
 TO POINT m 984510
 3' EAST FROM
 SOUTH COR. BLDG.

P.I.
 $17+20 \frac{70}{}$







VALUABLE

SUBJECT

LINE "C"

RETURN TO
PUBLIC WORKS
OFFICE
CAMP LEJEUNE
NORTH CAROLINA

FIELD PARTY

____ IN CHARGE
____ INSTRUMENT
____ NOTES
____ TAPE READ
____ TAPE OR ROD
____ TAPE OR ROD
____ INSTRUMENT No.
____ TAPE No.

WEATHER

CLEAR SNOW
CLOUDY HOT
WINDY MODERATE
RAIN COLD
FAIR FOG

FILE No. _____

FLDR. No. _____

SHEET

3 of

FIGURED BY _____
NOTES CHECKED BY _____
PLOTTED BY _____

DATE

19__

Quad. No. _____

STATION	DIST.	ANGLE ° ' "	+	H. I. BEARING	VER: ANG. DIFF.	ELEVATION
---------	-------	----------------	---	------------------	--------------------	-----------

1+13 ⁴⁰ POINT 3' EAST ON BLDG. LINE FROM NORTH COR. BLDG.#52

1+04 3' C.I. WATER LINE ON Φ

1+00 8' LT- GUY WIRE

0+96 16' LT. SEWER M. H

0+90 18.30' RT. POWER POLE SH 13

0+86 27' RT- POWER POLE SH 12

0+85 ⁵⁰ SEWER LINE ON Φ

0+78 MARL ON Φ

0+69 33' RT. COR. MARL

0+45 6.60' LT- Φ DROP INLET

0+41 TOP. 18"

0+16 EDGE MARL. COR.

AT 20+18 ³⁹ 1256.5615

BS 17+20 ²⁰ 3 50 49 00

TO POINT M 256.5620



3' EAST FROM

NORTH COR. BLDG.# 52

18" STORM
R.C.P. SEWER

20+18 ³⁹ = 0+00

17+20 ²⁰

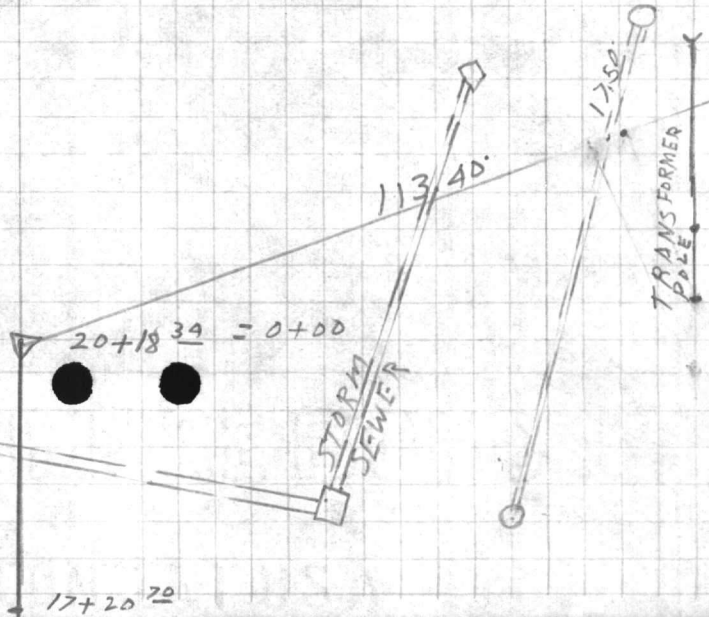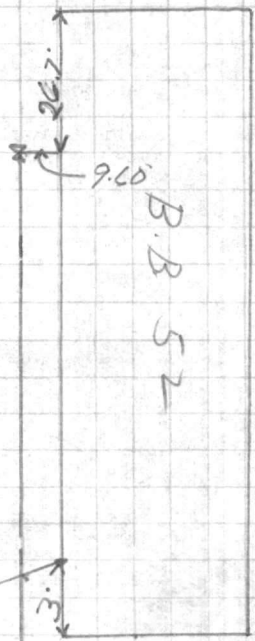

20 18.34
17 20.20
2 97.64

17 20.70
16 36.97
13

17 + 20 70
14 + 36 97
83 73

17 20
15 50
170
0021
170
34 00
- 35-7

18.50
135
18.14

VALUABLE

SUBJECT SEWER LINE & WATER
LINE CHECK LAT. TO BLDG.
51 COURTHOUSE BAY

RETURN TO
 PUBLIC WORKS
 OFFICE
 CAMP LEJEUNE
 NORTH CAROLINA

FIELD PARTY
DENNIS IN CHARGE
 _____ INSTRUMENT
 _____ NOTES
 _____ TAPE READ
 _____ TAPE OR ROD
 _____ TAPE OR ROD
 _____ INSTRUMENT No.
 _____ TAPE No.

WEATHER
 CLEAR _____ SNOW _____
 CLOUDY _____ HOT _____
 WINDY _____ MODERATE _____
 RAIN _____ COLD _____
 FAIR _____ FOG _____
 FIGURED BY _____
 NOTES CHECKED BY _____
 PLOTTED BY _____

FILE No. _____
 FLDR. No. _____
 SHEET 101
 DATE 9-13 1957

Quad. No. _____

STATION	DIST.	ANGLE ° ' "	+	H. I. BEARING	VER. ANG. DIFF.	ELEVATION	
				48833 70		28.82	
STA. 0+86 ⁰⁰				1150 22 20			TOP 8" T.C. SEWER
STA. 1+04 ²⁰				783 25 87			TOP 3" WATER LINE

6.17
2
 12.34

760
390
 115

023
760
 783















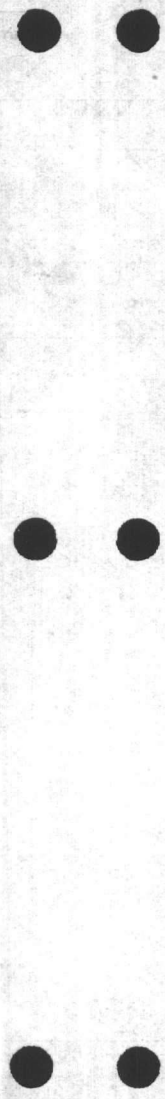

VALUABLE

RETURN TO
PUBLIC WORKS
OFFICE
CAMP LEJEUNE
NORTH CAROLINA


SUBJECT Proposed steam line
Location AT Court house Bay

FIELD PARTY
Kellam IN CHARGE
INSTRUMENT
NOTES
TAPE READ
TAPE OR ROD
TAPE OR ROD
INSTRUMENT No.
TAPE No.

WEATHER
CLEAR
CLOUDY
WINDY
RAIN
FAIR
SNOW
HOT
MODERATE
COLD
FOG
FIGURED BY
NOTES CHECKED BY
PLOTTED BY

FILE No. _____
FLDR. No. _____
SHEET 1 of _____
DATE 6-5-1956

Quad. No. _____

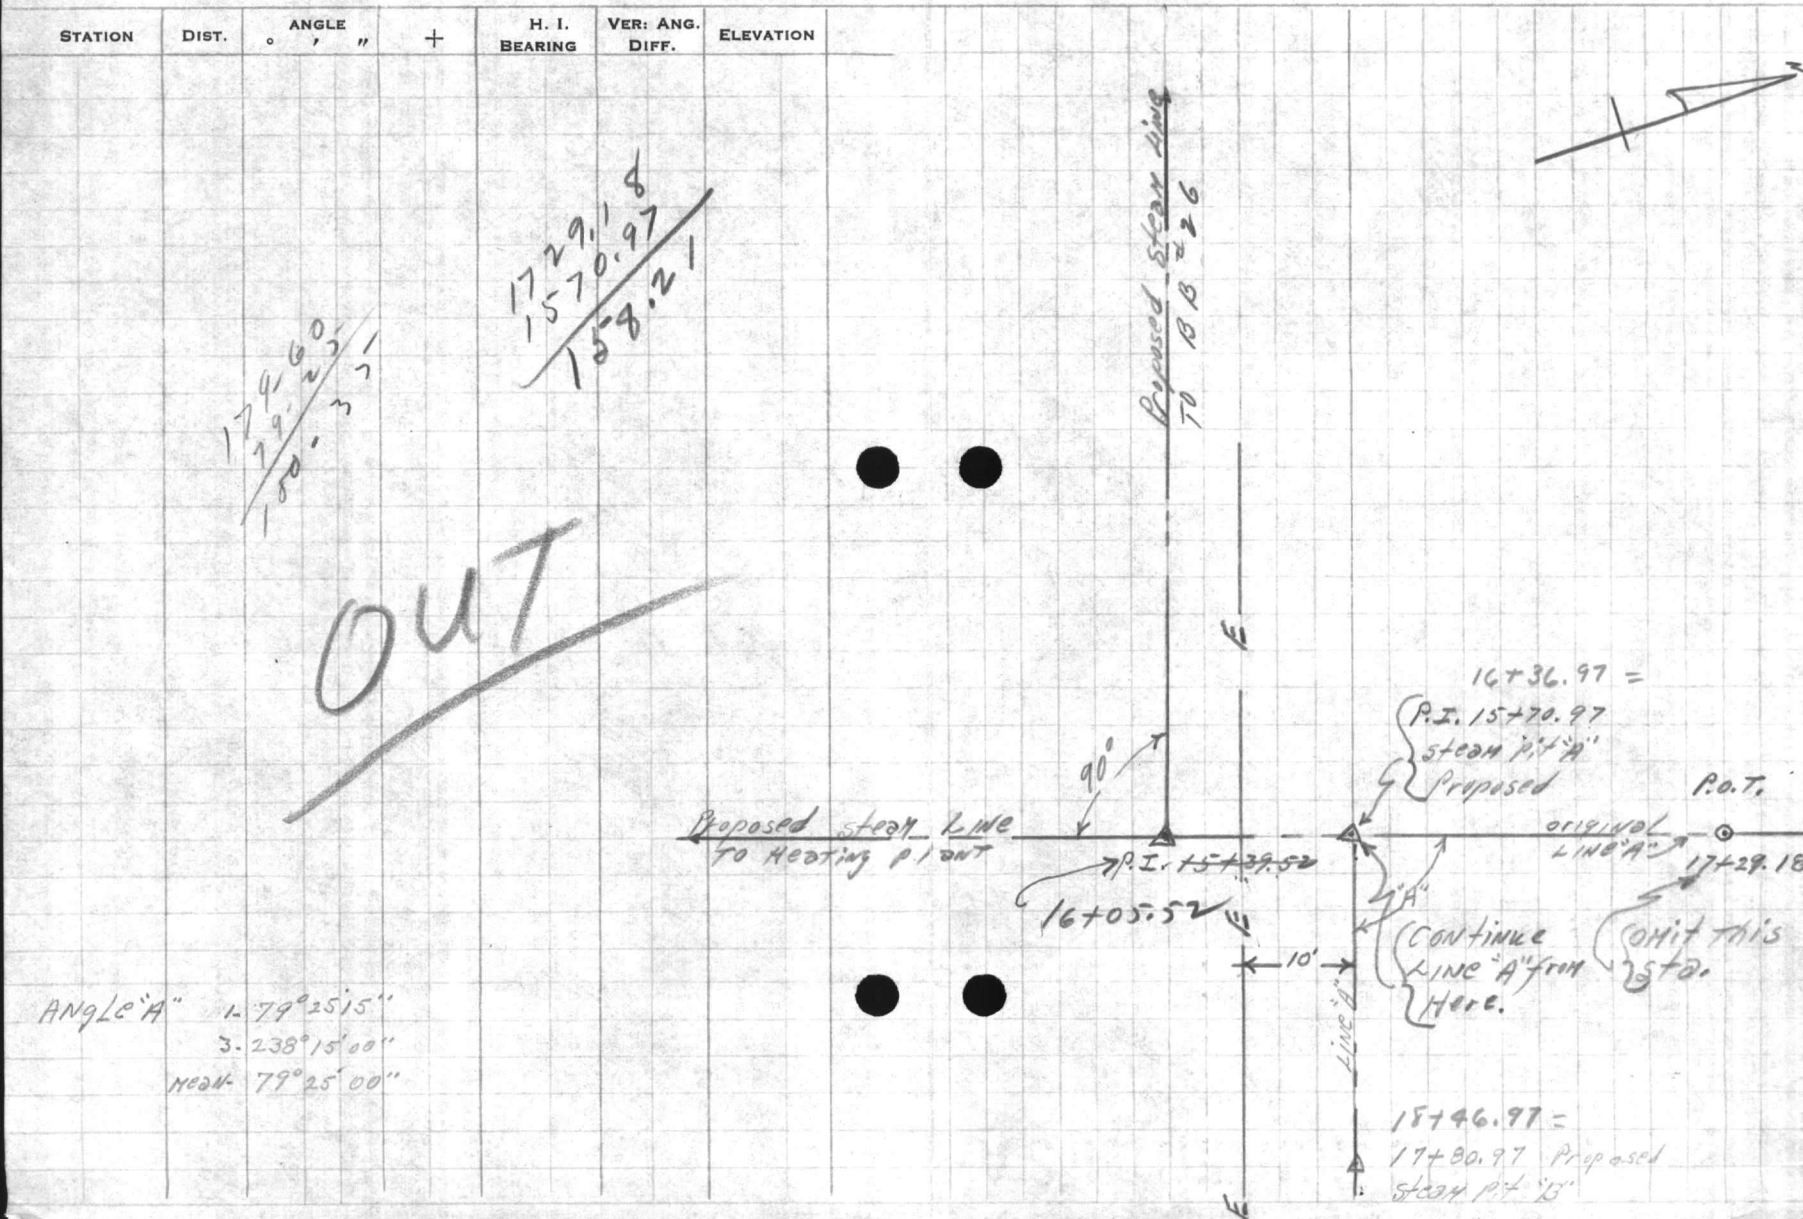

174.60
179.25
150.31

1729.18
1570.97
158.21

OUT

Proposed steam line
to Heating plant

Proposed steam line
to B.B. 226

16+36.97 =
P.I. 15+70.97
steam pit "A"
Proposed

P.I. 15+39.52
16+05.52

original
LINE "A"
17+29.18

CONTINUE
LINE "A" FROM
HERE.
HIT THIS
STA.

steam pit "B"

ANGLE "A"
1. 79° 25' 15"
3. 238° 15' 00"
MEAN 79° 25' 00"

STATION	DIST.	ANGLE ° ' "	+	H. I. BEARING	VER. ANG. DIFF.	ELEVATION
---------	-------	----------------	---	------------------	--------------------	-----------































VALUABLE

SUBJECT Proposed Steam Line
Location
Court House Bay

RETURN TO
 PUBLIC WORKS
 OFFICE
 CAMP LEJEUNE
 NORTH CAROLINA

FIELD PARTY

IN CHARGE _____
 INSTRUMENT _____
 NOTES _____
 TAPE READ _____
 TAPE OR ROD _____
 TAPE OR ROD _____
 INSTRUMENT NO. _____
 TAPE NO. _____


WEATHER

CLEAR _____ SNOW _____
 CLOUDY _____ HOT _____
 WINDY _____ MODERATE _____
 RAIN _____ COLD _____
 FAIR _____ FOG _____
 FIGURED BY _____
 NOTES CHECKED BY _____
 PLOTTED BY _____

FILE No. _____
 FLDR. No. _____
 SHEET 2-07
 DATE 6-5 1956

Quad. No. BB # 52

STATION	DIST.	ANGLE		+	H. I. BEARING	VER. ANG. DIFF.	ELEVATION
		°	"				

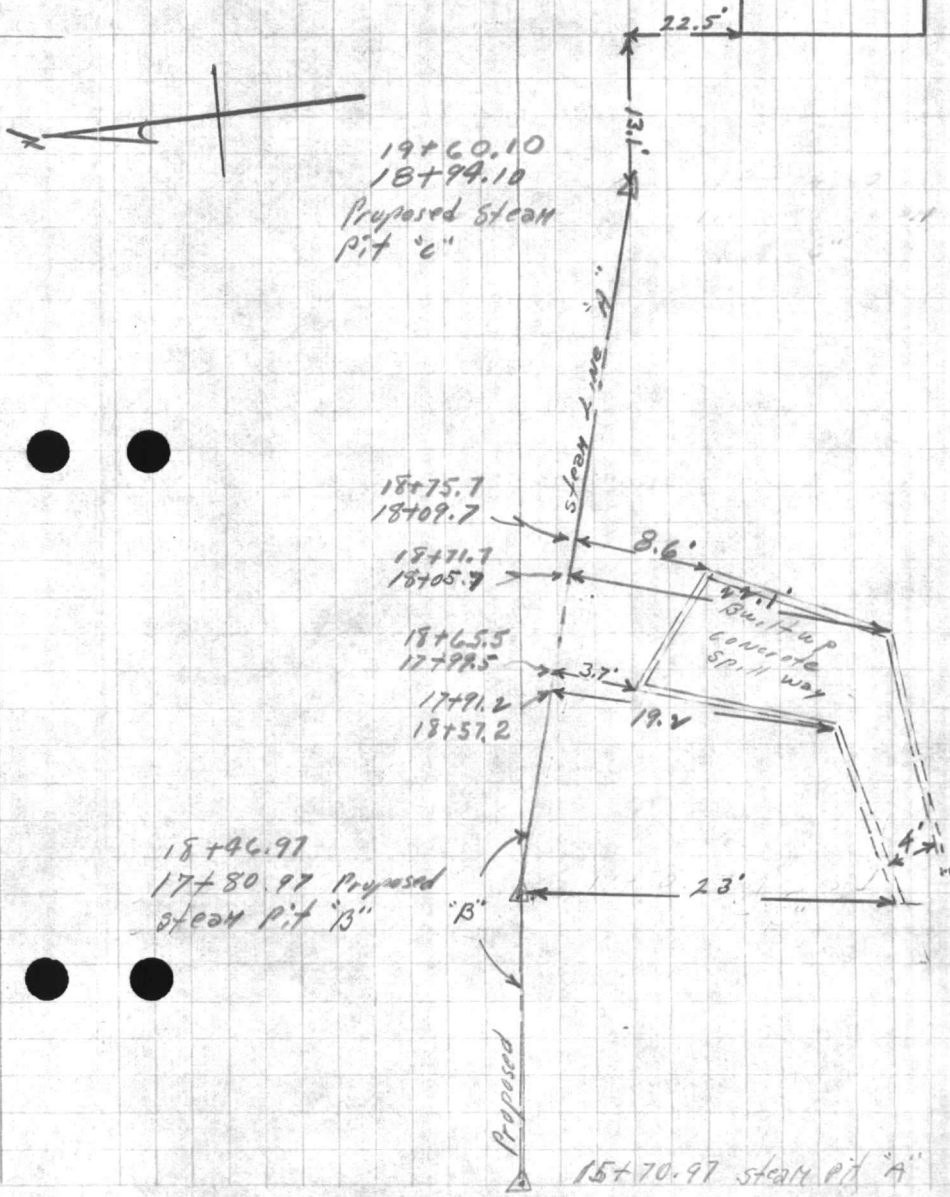

Angle 'B'
 1- 181° 51' 30"
 3- 105° 34' 30"
 Mean 181° 51' 30"

18+46.97
 17+80.97 Proposed
 Steam Pit 'B'

15+70.97 Steam Pit 'A'
























VALUABLE

RETURN TO
PUBLIC WORKS
OFFICE
CAMP LEJEUNE
NORTH CAROLINA

SUBJECT Proposed steam line
Loc. C.H. Bay

FIELD PARTY

____ IN CHARGE
____ INSTRUMENT
____ NOTES
____ TAPE READ
____ TAPE OR ROD
____ TAPE OR ROD
____ INSTRUMENT NO.
____ TAPE NO.


WEATHER

CLEAR _____ SNOW _____
CLOUDY _____ HOT _____
WINDY _____ MODERATE _____
RAIN _____ COLD _____
FAIR _____ FOG _____
FIGURED BY _____
NOTES CHECKED BY _____
PLOTTED BY _____

FILE No. _____
FLDR. No. _____
SHEET 3 of
DATE 6-5 1956

Quad. No. _____

STATION	DIST.	ANGLE ° ' "	+	H. I. BEARING	VER. ANG. DIFF.	ELEVATION
		179° 60'				
		87° 24'				
		92° 36'				
Angle "C"	1-	87° 24' 00"				
	3-	262° 11' 30"				
Head-		87° 23' 50"				

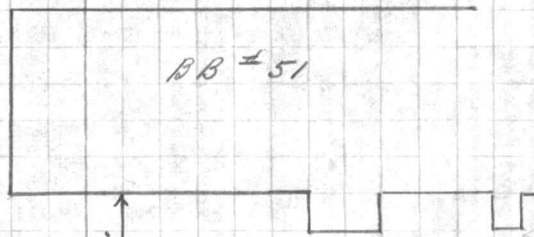

20+81.2
20+15.20
Proposed steam
Pit "D"



17+80.97
Proposed steam
Pit "B"

19+60.10
18+94.10
steam Pit "C"



























VALUABLE

SUBJECT Proposed Steam Line
LOCATION AT COURT HOUSE
B37

RETURN TO
PUBLIC WORKS
OFFICE
CAMP LEJEUNE
NORTH CAROLINA

FIELD PARTY

IN CHARGE _____
INSTRUMENT _____
NOTES _____
TAPE READ _____
TAPE OR ROD _____
TAPE OR ROD _____

WEATHER

CLEAR _____ SNOW _____
CLOUDY _____ HOT _____
WINDY _____ MODERATE _____
RAIN _____ COLD _____
FAIR _____ FOG _____

FILE No. _____

FLDR. No. _____

FIGURED BY _____ SHEET 4 of

NOTES CHECKED BY _____


PLOTTED BY _____ DATE 6-5-1956

INSTRUMENT No. _____

TAPE No. _____

Quad. No. _____

STATION	DIST.	ANGLE		+	H. I. BEARING	VER. ANG. DIFF.	ELEVATION
		°	"				

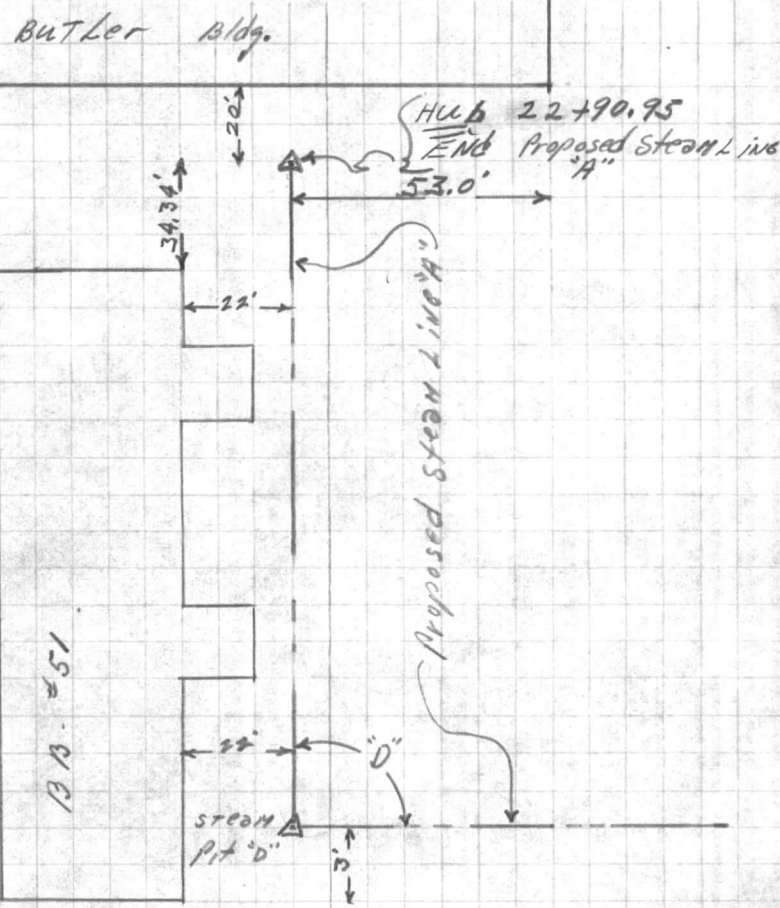

Angle
"D" 1-89°38'00"
3-268°54'30"
Mean 89°38'10"









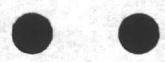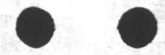

VALUABLERETURN TO
PUBLIC WORKS
OFFICE
CAMP LEJEUNE
NORTH CAROLINA

SUBJECT

*Profile on proposed
STEAM LINE
Court House Bay*

FIELD PARTY

IN CHARGE _____
INSTRUMENT _____
NOTES _____
TAPE READ _____
TAPE OR ROD _____
TAPE OR ROD _____
INSTRUMENT No. _____
TAPE No. _____

WEATHER

CLEAR _____
CLOUDY _____
WINDY _____
RAIN _____
FAIR _____
SNOW _____
HOT _____
MODERATE _____
COLD _____
FOG _____

FILE No. _____

FLDR. No. _____

SHEET *1-0 f*

FIGURED BY _____

NOTES CHECKED BY _____

PLOTTED BY _____

DATE *6-5*19*56*

Quad. No. _____

STATION	DIST.	ANGLE " "	+	H. I. BEARING	VER. ANG. DIFF.	ELEVATION
<i>B.M.</i>						<i>26.81</i>
	<i>2.15</i>			<i>28.96</i>		
<i>P.I. 15+39.52</i>				<i>29.0</i>	<i>7.9</i>	<i>21.1</i>
<i>0+00</i>						
<i>CONTINUE ON LINE "A"</i>						
<i>16+20.5</i>						
<i>15+54.5</i>				<i>12.7</i>		<i>16.3</i>
<i>16+25.5</i>						
<i>+59.5</i>						
<i>+59.5</i>						
<i>16+36.97</i>						
<i>P.I. 15+70.97</i>					<i>7.4</i>	<i>21.6</i>
<i>16+40</i>						
<i>+74</i>					<i>7.4</i>	<i>21.6</i>
<i>+42</i>						
<i>+76</i>					<i>8.5</i>	<i>20.5</i>
<i>16+66</i>						
<i>16+</i>					<i>8.7</i>	<i>20.3</i>
<i>16+83</i>						
<i>+17</i>					<i>8.1</i>	<i>20.9</i>
<i>+87</i>						
<i>+21</i>					<i>5.9</i>	<i>23.1</i>
<i>17+16</i>						
<i>+50</i>					<i>5.6</i>	<i>23.4</i>
<i>17+66</i>						
<i>17+</i>					<i>5.0</i>	<i>24.0</i>
<i>17+74</i>						
<i>+08</i>						
				<i>39.5</i>		
					<i>10.50</i>	<i>18.46</i>
					<i>4.51</i>	<i>24.45</i>

*Back Belt on Fire Hyd. near concrete spillway**TOP OF WATER LINE**13' Lft. to power Pole
Edge of woods**SANITARY SEWER MAN HOLE
INVERT INLET 8" F.C. SEWER**TOP OF M.H.*





















VALUABLE

SUBJECT Profile cont'd.

RETURN TO
PUBLIC WORKS
OFFICE
CAMP LEJEUNE
NORTH CAROLINA

39

FIELD PARTY

____ IN CHARGE
____ INSTRUMENT
____ NOTES
____ TAPE READ
____ TAPE OR ROD
____ TAPE OR ROD
____ INSTRUMENT NO.
____ TAPE NO.


WEATHER

CLEAR SNOW
CLOUDY HOT
WINDY MODERATE
RAIN COLD
FAIR FOG
FIGURED BY _____
NOTES CHECKED BY _____
PLOTTED BY _____

FILE No. _____
FLDR. No. _____
SHEET 2 of
DATE 6-5 1956

Quad. No. _____

STATION	DIST.	ANGLE		+	H. I. BEARING	VER. ANG. DIFF.	ELEVATION	
		°	' "					
17+80					28.96			
17+14	10' RT.				Power pole			
18+16								
17+50						4.1	24.9	
P.I. 18+46.97								
17+80.97						3.2	25.8	
18+55								
+92	13' RT.				water valve - 9' LFT. to Fire Hydr.			
+92						2.6	21.9	Top of water line to Hydrant
18+66								
18+0						3.1	25.9	
						1.86	27.10	Top of concrete wall of spill way
T.P.								
						1.42	27.54	
					6.08 33.62			
18+70					33.6			
18+04	7' RT.				END 18" R.C.P.			
18+73								
18+07						11.05	22.57	Top of 18" R.C.P.
18+76								
18+10.3						7.6	26.0	
18+14						8.1	25.5	Edge of Rd.
18+80								
18+86.3								
18+20.3	10.3' RT.					12.34	21.28	Top of water line
19+04								
+38						7.1	26.5	

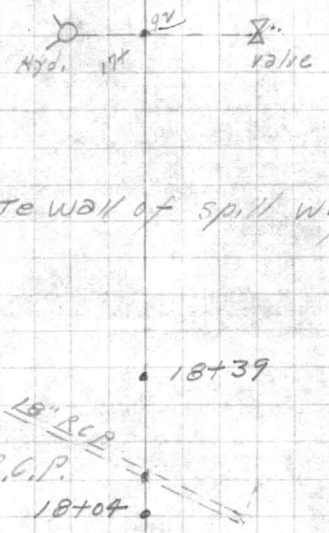







VALUABLE

SUBJECT

Profile contd.

RETURN TO
PUBLIC WORKS
OFFICE
CAMP LEJEUNE
NORTH CAROLINA

FIELD PARTY

IN CHARGE _____
INSTRUMENT _____
NOTES _____
TAPE READ _____
TAPE OR ROD _____
TAPE OR ROD _____

WEATHER

CLEAR _____
CLOUDY _____
WINDY _____
RAIN _____
FAIR _____

SNOW _____
HOT _____
MODERATE _____
COLD _____
FOG _____

FILE No. _____

FLDR. No. _____

SHEET

3-07

DATE

6-5 1956

INSTRUMENT No. _____

TAPE No. _____

FIGURED BY _____

NOTES CHECKED BY _____

PLOTTED BY _____

Quad. No. _____

STATION	DIST.	ANGLE		+	H. I. BEARING	VER. ANG. DIFF.	ELEVATION
		°	' "				
					33.62		
					33.6		
19+05							
18+39	68' Lft.				TOP of D.I.	8.14	25.48
19+31							
+65						6.7	26.9
19+34							
+68						5.9	27.7
19+46							
+80	6" Rt.				Power Pole		
19+55							
+89	5" Rt.				Power Pole		
	19+60.10						
P.I.	18+99.10					5.1	28.5
19+63.5							
18+97.5	27' Rt.					11.61	22.01
19+66							
19+0						5.4	28.2
19+0	8" sanitary				sewer crosses		Proposed steam line
19+72							
+06						5.6	28.0
19+73							
+07						6.3	27.3
20+97							
+45.5	7.2 Rt.				TOP of D.I.	6.70	26.92
+42.5						6.7	26.9
+42.5						7.9	25.7
20+23							
+57						6.1	27.5
+29						5.7	27.9
20+35							
+07						5.1	28.5

Edge Rd.

sanitary sewer man hole
invert outlet 8" T.C. sewer

Proposed steam line

Edge Rd.

ON ground
TOP of 18" R.C.P.

Edge Rd.

Edge of grass plot - Edge of stone Area on Rt.












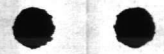

VALUABLE

SUBJECT

Profile road.

RETURN TO
PUBLIC WORKS
OFFICE
CAMP LEJEUNE
NORTH CAROLINA

FIELD PARTY

IN CHARGE _____
INSTRUMENT _____
NOTES _____
TAPE READ _____
TAPE OR ROD _____
TAPE OR ROD _____
STRUMENT NO. _____
TAPE NO. _____

WEATHER

CLEAR _____ SNOW _____
CLOUDY _____ HOT _____
WINDY _____ MODERATE _____
RAIN _____ COLD _____
FAIR _____ FOG _____

FILE No. _____

FLDR. No. _____

FIGURED BY _____ SHEET *4-07*

NOTES CHECKED BY _____



PLOTTED BY _____ DATE *6-5-1926*

Quad. No. _____

STATION	DIST.	ANGLE ° ' "	+	H. I. BEARING	VER. ANG. DIFF.	ELEVATION
20+66				33.62		
20+0				33.6	3.9	29.7
20+91.20						
P.I. 20+152.0					3.3	30.3
21+16						
+50					3.2	30.4
21+66						
21+					3.3	30.3
+50						
+79	7.5' 2 ft. cor. conc. slab.				3.5	30.1
+92	7.5' 2 ft. cor. conc. slab					
22+0					3.5	30.1
+50					3.4	30.2
+60	Edge stone Area				3.1	30.5
+80					1.0	32.6
22+90.95	END LINE				0.3	33.3
B.M.					6.81	16.81

Edge of stone Area

BWT/er B/dg.

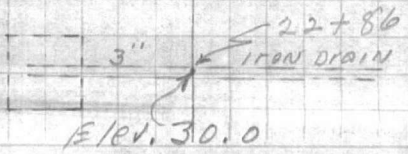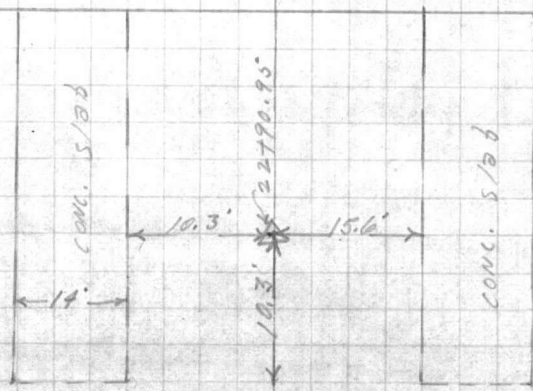






VALUABLE

RETURN TO
PUBLIC WORKS
OFFICE
CAMP LEJEUNE
NORTH CAROLINA

SUBJECT sketch showing
STORM AND SANITARY SEWERS
ON STEAM LINE LOCATION
AT COURT HOUSE Bldg

FIELD PARTY

IN CHARGE _____
INSTRUMENT _____
NOTES _____
TAPE READ _____
TAPE OR ROD _____
TAPE OR ROD _____
INSTRUMENT NO. _____
TAPE NO. _____

WEATHER

CLEAR _____ SNOW _____
CLOUDY _____ HOT _____
WINDY _____ MODERATE _____
RAIN _____ COLD _____
FAIR _____ FOG _____

FILE No. _____

FLDR. No. _____

SHEET 5 of

DATE 6-5 1956

FIGURED BY _____
NOTES CHECKED BY _____
PLOTTED BY _____


Quad. No. _____

STATION	DIST.	ANGLE ° ' "	+	H. I. BEARING	VER. ANG. DIFF.	ELEVATION
---------	-------	----------------	---	------------------	--------------------	-----------

18+46.97
P.I. 17+80.97

19+60.10
P.I. 18+94.10

P.I.
20+15.20

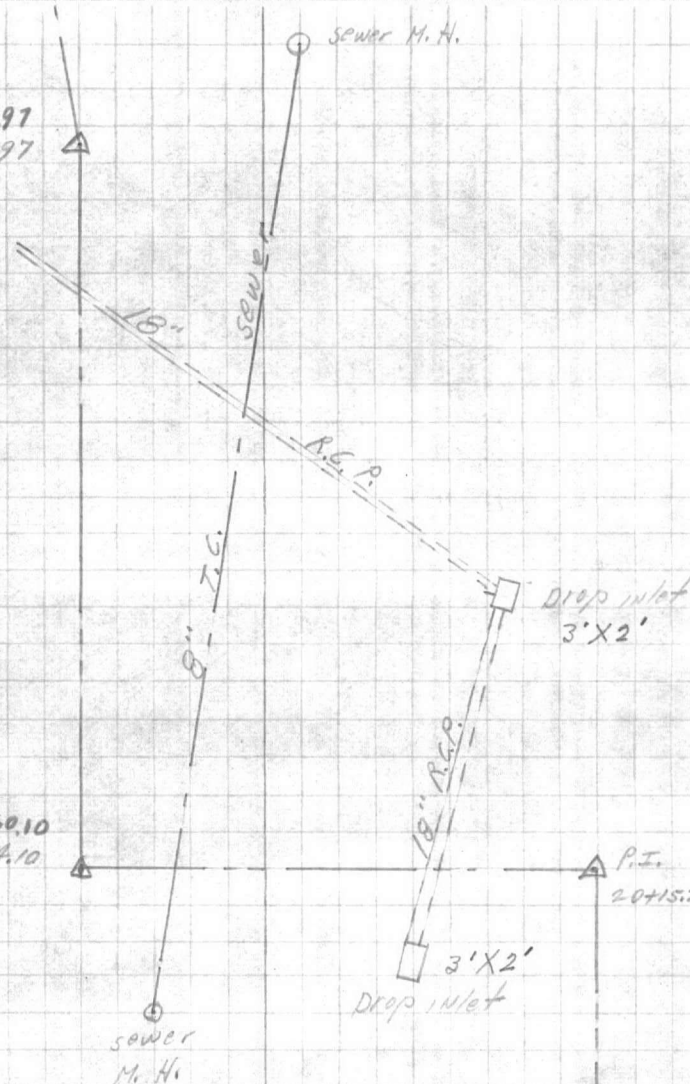






VALUABLE

SUBJECT PROFILE

RETURN TO
PUBLIC WORKS
OFFICE
CAMP LEJEUNE
NORTH CAROLINA

FIELD PARTY

IN CHARGE

INSTRUMENT

NOTES

TAPE READ

TAPE OR ROD

TAPE OR ROD

INSTRUMENT NO.

TAPE NO.

WEATHER

CLEAR

CLOUDY

WINDY

RAIN

FAIR

SNOW

HOT

MODERATE

COLD

FOG
FIGURED BY _____
NOTES CHECKED BY _____
PLOTTED BY _____

FILE No. _____

FLDR. No. _____

SHEET 2 of 2

DATE _____ 19__

Quad. No. _____

STATION	DIST.	ANGLE ° ' "	+	H. I. BEARING	VER. ANG. DIFF.	ELEVATION	
B.m.			488	33.70 33.7		28.82	NAIL IN TRANS. POLE # SH-12
0+00					48	28.9	
0+05 ⁸⁰					805	25.65	TOP 3" WATER LINE
0+15 ²⁰							8.50' RT. P.P. # ? NO NUMBER
0+18							9.50' RT. P.P. # SH-13
0+20					49	28.8	
0+23 ²⁰							OVERHEAD POWER LINE
0+26 ²⁰							11.35' RT. P.P. # SH-12
0+33 ⁶⁰							14.60' LT. GUYWIRE FOR P.P. # SH-12
0+41 ²⁰					53	28.4	BANK
0+46					69	26.8	
0+50					69	26.8	EDGE DIRT RD.
0+74 ⁵⁰					77	26.0	
0+84 ⁵⁰					76	26.1	
0+84 ⁵⁰							8.3' LT. COR. CONC. WASH RACK
1+00					70	26.7	END LINE
FLOOR. BLDG. #52					4.11	29.59	








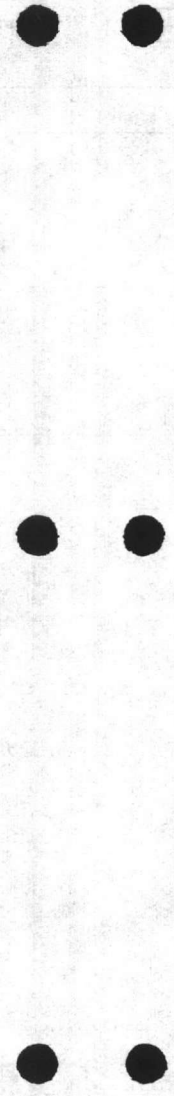

VALUABLE

SUBJECT PROFILE ON PROPOSED
STEAM LINE "A" "B" + "C"

RETURN TO
PUBLIC WORKS
OFFICE
CAMP LEJEUNE
NORTH CAROLINA

FIELD PARTY
DENNIS IN CHARGE
INSTRUMENT _____
NOTES _____
TAPE READ _____
TAPE OR ROD _____
TAPE OR ROD _____
INSTRUMENT NO. _____
TAPE NO. _____

WEATHER
CLEAR _____ SNOW _____
CLOUDY _____ HOT _____
WINDY _____ MODERATE _____
RAIN _____ COLD _____
FAIR _____ FOG _____
FIGURED BY _____
NOTES CHECKED BY _____
PLOTTED BY _____

FILE No. _____
FLDR. No. _____
SHEET 1 of 3
DATE 7-23 1956

Quad. No. _____

STATION	DIST.	ANGLE ° ' "	+	H. I. BEARING	VER. ANG. DIFF.	ELEVATION	
B.m.			4 27	31.08 (31.1)		26 81	BACK BOLT FIRE HYD.
17+20 ²⁰					8 1	23 0	
17+50					7 5	23 5	
18+00					7 0	24 1	
18+50					6 5	24 6	
18+75 ⁶⁰					6 8	24 3	GROUND
18+75 ⁶⁰					10 11	20 97	TOP 8" C.I. WATER
18+83					6 2	24 9	
18+88					6 9	24 2	
18+93					6 0	25 1	
19+00					5 7	25 4	
19+50					5 2	25 9	
19+79					5 5	25 6	GROUND
19+79					6 7	24 4	TOP 18" R.C.P. ON E
19+74	17.50'	RT.			5 60	25 48	TOP DROP INLET
19+74	17.50'	RT.			9 04	22 04	BOTTOM DROP INLET
20+00					4 3	26. 27.8	




VALUABLE

SUBJECT _____

RETURN TO
PUBLIC WORKS
OFFICE
CAMP LEJEUNE
NORTH CAROLINA

FIELD PARTY

IN CHARGE

INSTRUMENT

NOTES

TAPE READ

TAPE OR ROD

TAPE OR ROD

INSTRUMENT No.

TAPE No. _____

WEATHER

CLEAR
CLOUDY
WINDY
RAIN
FAIR
SNOW
HOT
MODERATE
COLD
FOG

FILE No. _____

FLDR. No. _____

SHEET

DATE

2073

19

Quad. No. _____

STATION	DIST.	ANGLE ° ' "	+	H. I. BEARING	VER: ANG. DIFF.	ELEVATION		
				31.08 (31.1)				
20+02 ⁵⁰		H.			3.5	27.6		
20+11		0'			2.4	28.7		
20+18 ³⁵					2.2	28.9		
20+18 ³⁵		LINE "A" = 0+00 LINE "B"						
0+00					2.2	28.9		
0+27					1.0	30.1		
0+45					0.6	30.5		
0+55 ⁶⁵					0.5	30.6	ON BLDG. LINE BB 51	
20+18 ³⁵		LINE "A" = 0+00 LINE "C"						
0+19					2.5	28.5		
0+22					3.5	27.6		
0+41					4.0	27.1	GROUND	
0+41					5.2	25.9	TOP. 18" R.C.P.	
0+78					3.5	27.6		








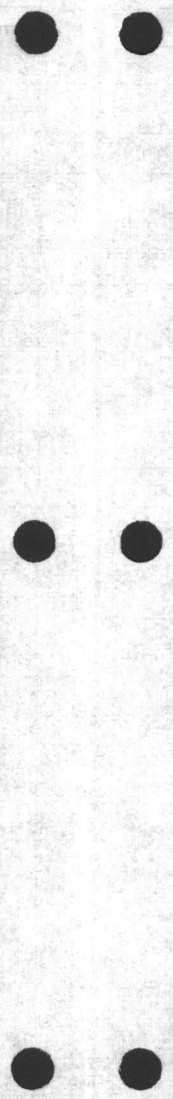

VALUABLE

SUBJECT _____

 RETURN TO
 PUBLIC WORKS
 OFFICE
 CAMP LEJEUNE
 NORTH CAROLINA

FIELD PARTY

 _____ IN CHARGE
 _____ INSTRUMENT
 _____ NOTES
 _____ TAPE READ
 _____ TAPE OR ROD
 _____ TAPE OR ROD
 _____ TRUMENT NO.
 _____ TAPE NO.

WEATHER

 CLEAR
 CLOUDY
 WINDY
 RAIN
 FAIR
 SNOW
 HOT
 MODERATE
 COLD
 FOG

FILE No. _____

FLDR. No. _____

SHEET

36/3

FIGURED BY _____

NOTES CHECKED BY _____

PLOTTED BY _____

DATE

19 _____

Quad. No. _____

STATION	DIST.	ANGLE ° ' "	+	H. I. BEARING	VER. ANG. DIFF.	ELEVATION	
				31.08 31.11			
0+45	6.60'				4.2	26.9	TOP. D. I.
0+45	6.60'				6.5	24.6	BOTTOM D. I.
0+78'					3.5	27.6	EDGE MARL ON Q
0+79					2.8	28.3	
1+00					2.9	28.7	
1+04					2.1	29.0	GROUND.
1+04					5.25	25.83	TOP 3" C.I. WATER PIPE.
1+13 ⁴⁰					2.3	28.8	Bldg. LINE BB52
B.M.					4.25	26.82	(26.81) BACK BOLT. FIRE HYD.










VALUABLE

SUBJECT Location Proposed
Steam Line Court
House Bay

RETURN TO
 PUBLIC WORKS
 OFFICE
 CAMP LEJEUNE
 NORTH CAROLINA

FIELD PARTY

Morton IN CHARGE
 _____ INSTRUMENT
 _____ NOTES
 _____ TAPE READ
 _____ TAPE OR ROD
 _____ TAPE OR ROD
 _____ INSTRUMENT NO.
 _____ TAPE NO.

WEATHER

CLEAR _____ SNOW _____
 CLOUDY _____ HOT _____
 WINDY _____ MODERATE _____
 RAIN _____ COLD _____
 FAIR _____ FOG _____

FILE No. _____


FLDR. No. _____

SHEET 1 of 4

NOTES CHECKED BY _____
 PLOTTED BY _____
 DATE 3/19 1956

Quad. No. _____

STATION	DIST.	ANGLE " +	H. I. BEARING	VER. ANG. DIFF.	ELEVATION
18+84	19				
18+51	17				
18+51	10.8				
18+50	9				
18+14	9				
17+77					
17+66	3				
18+20	11				
17+54	11				
18+15	17				
17+77	11				
18+10	18				
17+44	3				
18+08	11				
17+42	11				
17+96	17.5				
17+20	17.5				
17+82					
17+76					
16+78	13				
16+12	17				
16+32	17				
15+64					
16+30					
15+50					
16+16					
15+39	52				
16					
16+05	52				

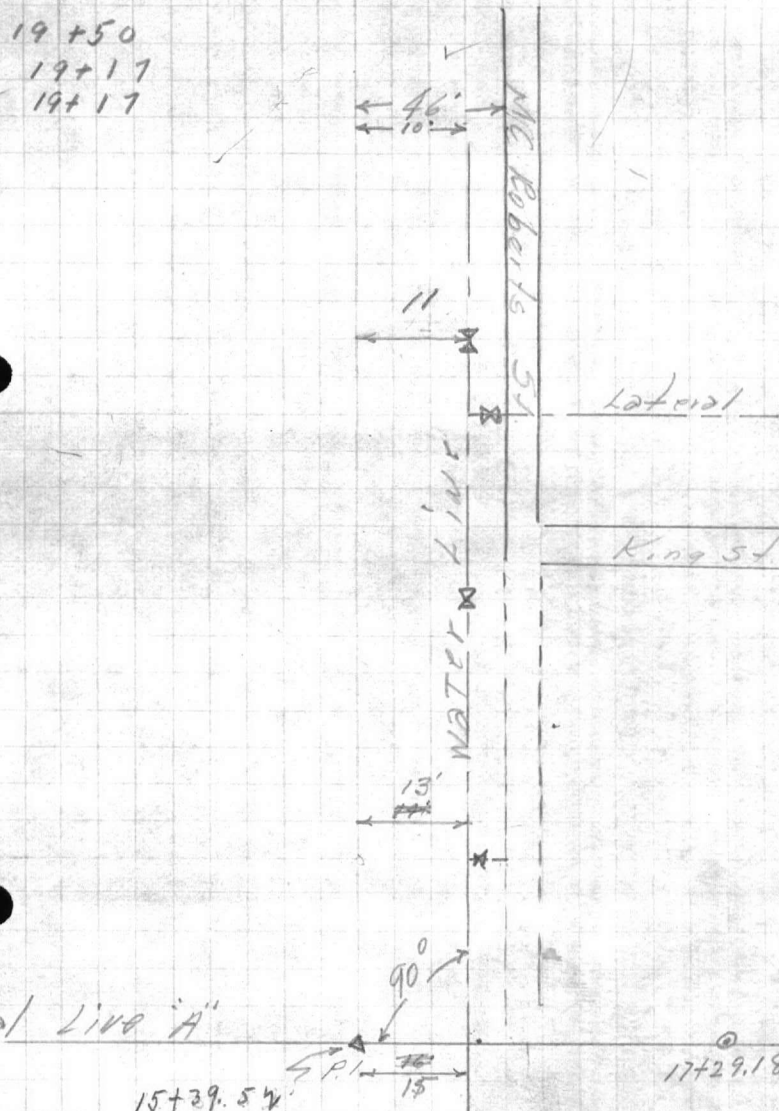

19+50
 19+17
 19+17

17+29.18

15+39.52

10-10-50




VALUABLE

SUBJECT _____

RETURN TO
 PUBLIC WORKS
 OFFICE
 CAMP LEJEUNE
 NORTH CAROLINA

FIELD PARTY

 IN CHARGE

 INSTRUMENT

 NOTES

 TAPE READ

 TAPE OR ROD

 TAPE OR ROD


 INSTRUMENT NO. _____
 TAPE NO. _____

WEATHER

CLEAR _____ SNOW _____
 CLOUDY _____ HOT _____
 WINDY _____ MODERATE _____
 RAIN _____ COLD _____
 FAIR _____ FOG _____
 FIGURED BY _____
 NOTES CHECKED BY _____
 PLOTTED BY _____

FILE No. _____
 FLDR. No. _____
 SHEET 2 of 4
 DATE _____ 19__

Quad. No. _____

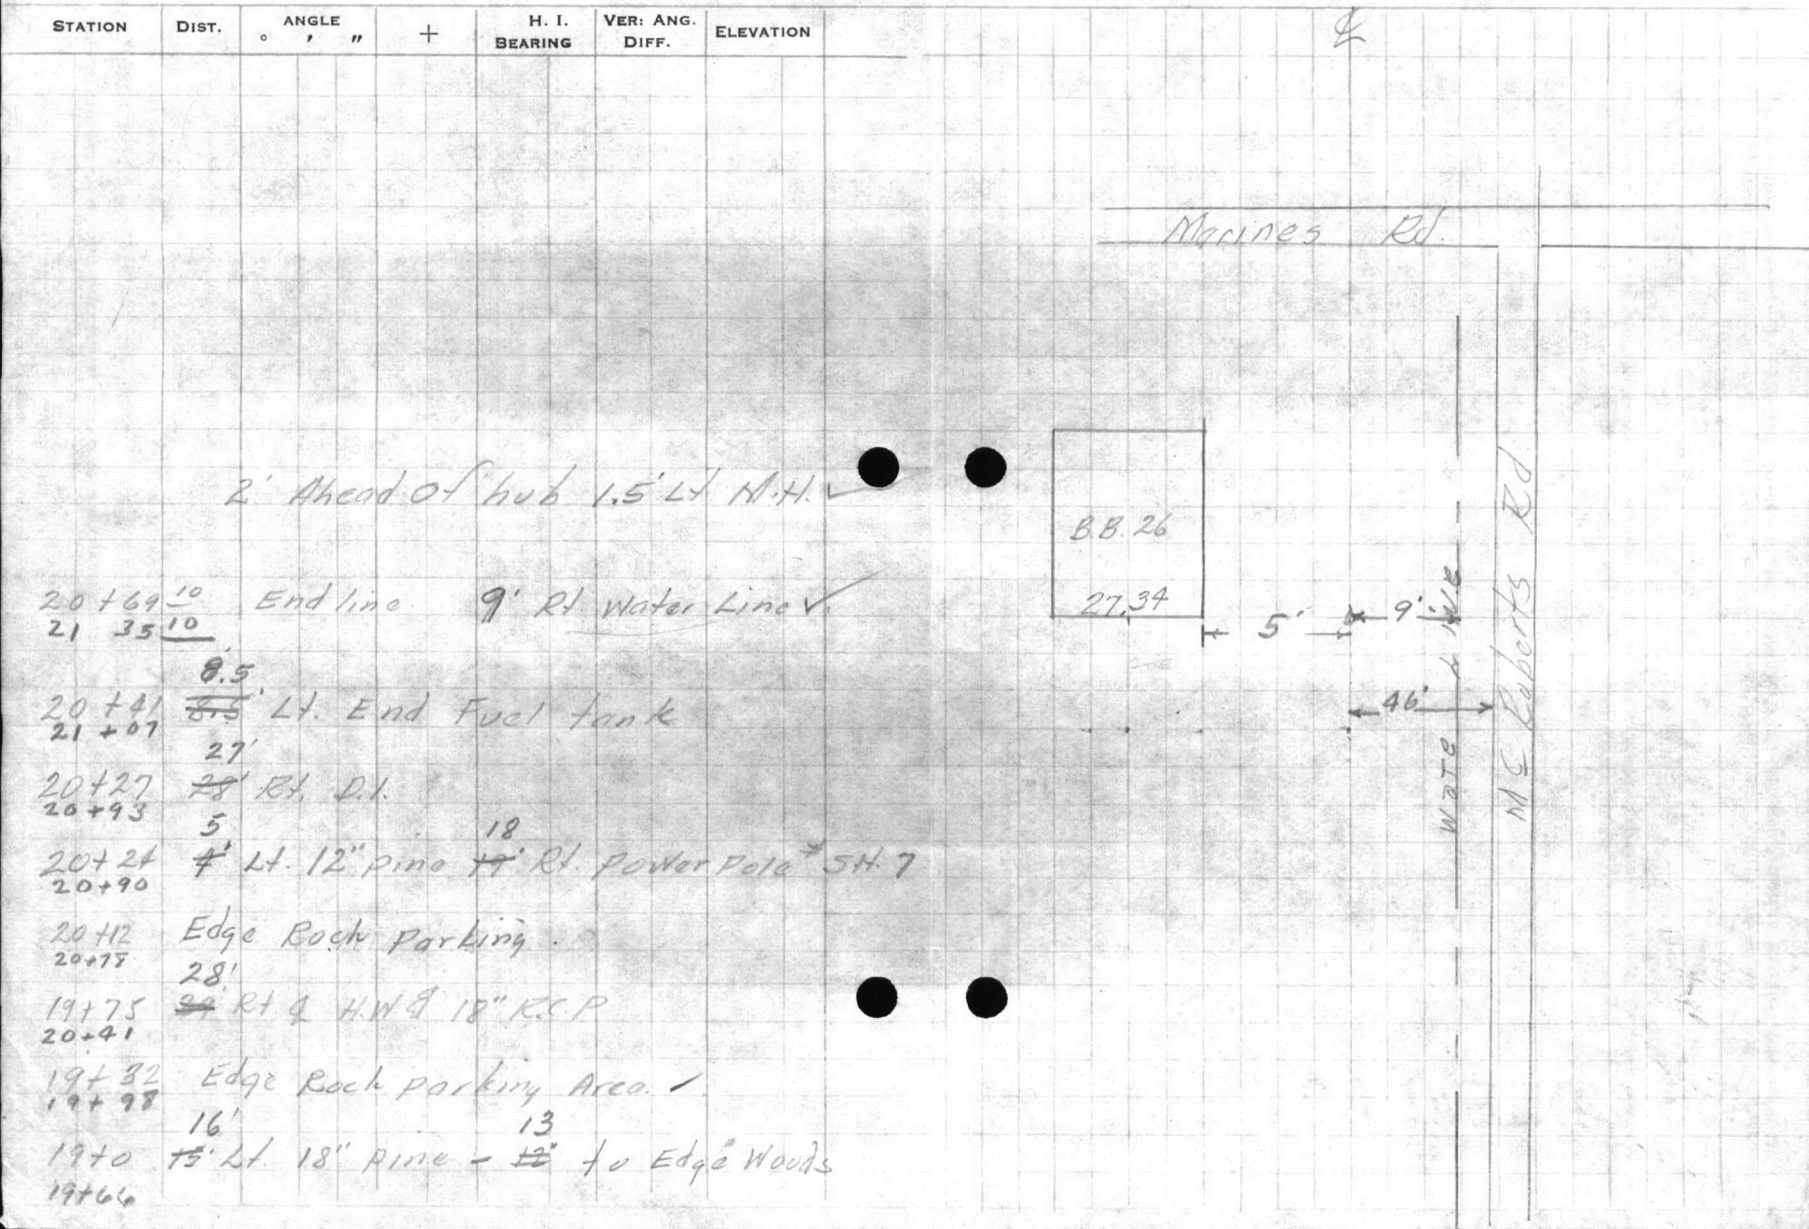





VALUABLE

SUBJECT

Profile Steam Line
Court House BayRETURN TO
PUBLIC WORKS
OFFICE
CAMP LEJEUNE
NORTH CAROLINA

FIELD PARTY

Martin IN CHARGE

INSTRUMENT

NOTES

TAPE READ

TAPE OR ROD

TAPE OR ROD

INSTRUMENT No.

TAPE No.

WEATHER

CLEAR
CLOUDY
WINDY
RAIN
FAIRSNOW
HOT
MODERATE
COLD
FOG

FILE No. _____

FLDR. No. _____

SHEET 3 of 4

DATE _____ 19__

Quad. No. _____

STATION	DIST.	ANGLE ° ' "	+	H. I. BEARING	VER. ANG. DIFF.	ELEVATION	
B.M.			0.26	27.07 27.1		26.81	TOP bolt on Hydrant
P.L. 15+39.52 16+05.52					6.0	21.1	TOP
15+39.52 16+05.52					10.62	16.45	^{15'} 16' Rt. Top Water Line
15+50 16+16	0+10.4				6.3	20.8	
16+0 16+66	0+61				6.7	20.4	
16+12 16+78					11.23	15.84	^{13'} 14' Rt. Top Water Line
16+50 17+16	0+73 1+11				7.5	19.6	
17+0 17+66	1+61				7.9	19.2	
T.P.					6.93	20.14	
			1.83	21.97 22.0			
17+50 18+16	2+11				4.0	18.0	
18+0 18+66	2+77				5.2	16.8	
18+50 19+16	3+11				4.3	17.7	
18+51 19+17	3+12				7.70	14.27	10.8' Top Water Line
19+0 19+66	3+61				4.3	17.7	
					4.4	17.6	

VALUABLE








VALUABLE

SUBJECT _____

RETURN TO
PUBLIC WORKS
OFFICE
CAMP LEJEUNE
NORTH CAROLINA

FIELD PARTY

IN CHARGE

INSTRUMENT

NOTES

TAPE READ

TAPE OR ROD

TAPE OR ROD

INSTRUMENT No.

TAPE No. _____

WEATHER

CLEAR SNOW
CLOUDY HOT
WINDY MODERATE
RAIN COLD
FAIR FOG

FILE No. _____

FLDR. No. _____

FIGURED BY _____ SHEET 4 of 4

NOTES CHECKED BY _____

PLOTTED BY _____ DATE _____ 19__

Quad. No. _____

STATION	DIST.	ANGLE ° ' "	+	H. I. BEARING	VER: ANG. DIFF.	ELEVATION	
19+29		3+90		21.97 22.0	5.8	16.2	
19+95							
19+37		3+98			5.4	16.6	
20+03							
19+50					5.3	16.7	
20+16		4+11					
20+0					5.9	16.1	
20+66		4+61					
20+37		4+98			6.0	16.0	
21+03							
20+69 ¹⁰		5+295 ⁵			6.2	15.8	
21+35 ¹⁰							
20+69 ¹⁰					10.18	11.79	Top Water Line 9' El.
21+35 ¹⁰							
T.P.					1.87	20.10	
				6.99	27.09		
B.M.					0.28	26.81	TOP Hydrom

VALUABLE










VALUABLE

SUBJECT BLDG. LOCATION AT
COURT HOUSE BAY.


Return To
 Public Works
 Office
 Camp Lejeune
 North Carolina

FIELD PARTY
KELLM In Charge
 Instrument _____
 Notes _____
 Tape Read _____
 Tape or Rod _____
 Tape or Rod _____
 Instrument No. _____
 Tape No. _____

WEATHER
 Clear _____
 Cloudy _____
 Windy _____
 Rain _____
 Fair _____
 Snow _____
 Hot _____
 Moderate _____
 Cold _____
 Fog _____
 Figured By _____
 Notes Checked By _____
 Plotted By _____

FILE No. 219-D
 Fldr. No. _____
 Sheet 1-058
 Date 7-10 19-26
 Quad. No. 219-220

Station	Dist.	Angle "	+	H. I. Bearing	Ver: Ang. Diff.	Elevation
	562.26'	-0.036. +0.087				
P.I. #2-A	1-179° 22' 30"					
	13419.64	3-178° 07' 30"				
	MEAN-179° 22' 30"					
COR. 'B'	35.22'	289° 02' 14"				
COR. 'A'	33.27'	268° 29' 31"				
	1319.64'	-0.086 +0.087				
P.I. #1	1-179° 30' 30"					
	3-174° 31' 18"					
	MEAN-179° 30' 35"					

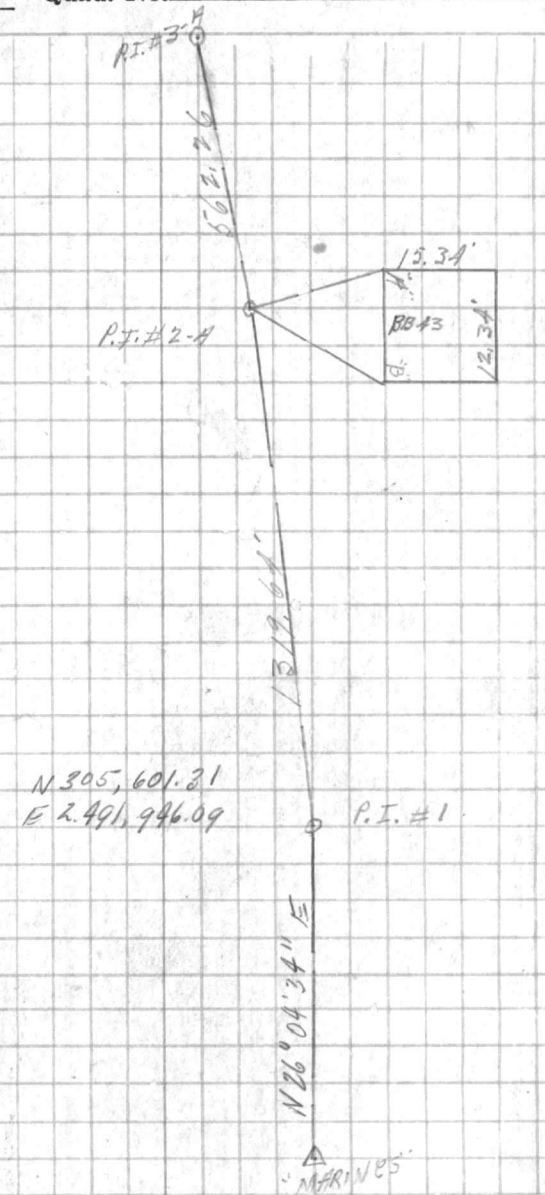

Plotted By: J.F.M. 7-24-46
 Plotted C.E.G. 7-24-46 J.F.M.
 Checked By: V.L.T. 7-30-46



















VALUABLE


SUBJECT Bldg. LOCATION AT COURT HOUSE BAY.

Return To
Public Works
Office
Camp Lejeune
North Carolina

FIELD PARTY
RE/100M In Charge
Instrument _____
Notes _____
Tape Read _____
Tape or Rod _____
Tape or Rod _____
Instrument No. _____
Tape No. _____

WEATHER
Clear _____
Cloudy _____
Windy _____
Rain _____
Fair _____
Snow _____
Hot _____
Moderate _____
Cold _____
Fog _____
Figured By _____
Notes Checked By _____
Plotted By _____

FILE No. 219-1
Fldr. No. _____
Sheet 3-058
Date 7-10 1946
Quad. No. 219-220

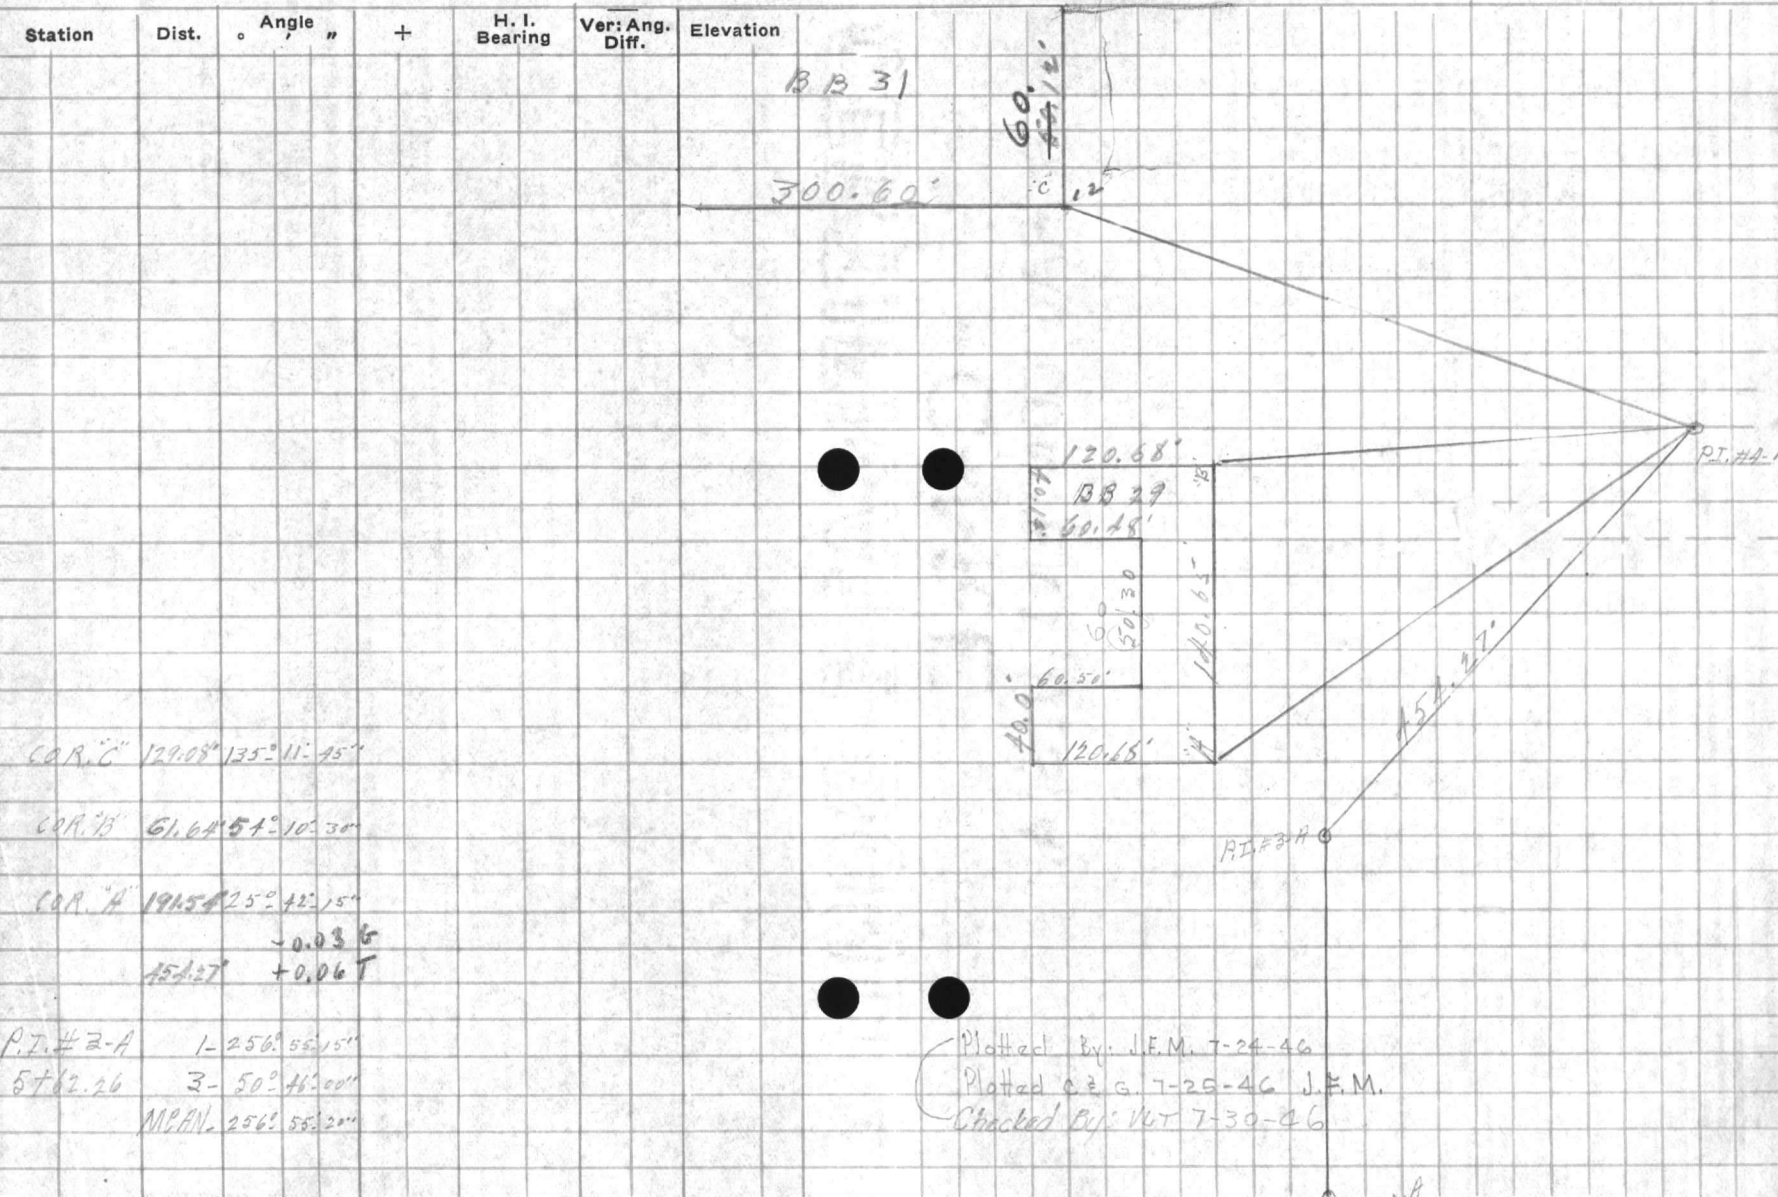





















VALUABLE

SUBJECT BLDG. LOCATION # T
COURT HOUSE BLDG.


Return To
 Public Works
 Office
 Camp Lejeune
 North Carolina

FIELD PARTY
KELLEN In Charge
 _____ Instrument
 _____ Notes
 _____ Tape Read
 _____ Tape or Rod
 _____ Tape or Rod
 _____ Instrument No.
 _____ Tape No.

WEATHER
 Clear _____
 Cloudy _____
 Windy _____
 Rain _____
 Fair _____
 Snow _____
 Hot _____
 Moderate _____
 Cold _____
 Fog _____
 Figured By _____
 Notes Checked By _____
 Plotted By _____
 Quad. No. _____

FILE No. 219-J
 Fldr. No. _____
 Sheet 1-0F 8
 Date 7-11 19 46
219-220

Station	Dist.	Angle ° ' "	+	H. I. Bearing	Ver: Ang. Diff.	Elevation
	292.37'					
					- 0.02 G. + 0.04 T	
P.I. #5-A	1-186°	58-30"				
2+01.93	3-	200° 55' 15"				
MPAN-	186°	58' 25"				
COR. "B"	32.16'	313°		57.45"		
COR. "H"	28.39'	46°		44.30"		
	201.93'				- 0.01 G. + 0.03 T	
P.I. #4-A	1-	185° 21.31"				
A+54.27	3-	205° 05' 15"				
MPAN-	184°	21.75"				

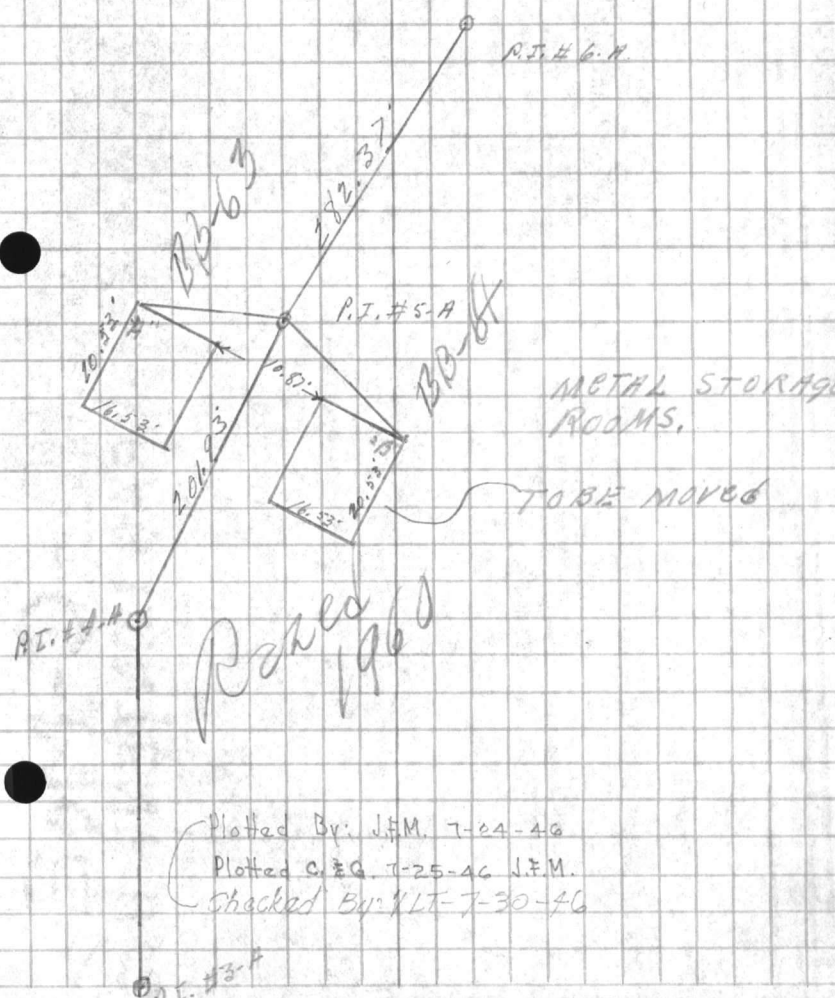

Plotted By: J.F.M. 7-24-46
 Plotted C.E.G. 7-25-46 J.F.M.
 Checked By: M.L.T. 7-30-46





























VALUABLE

Return To
Public Works
Office
Camp Lejeune
North Carolina

SUBJECT BLDG. LOCATION W.T. COURT
HOUSE BAY.

FIELD PARTY
KEY/ANN In Charge
____ Instrument
____ Notes
____ Tape Read
____ Tape or Rod
____ Tape or Rod
____ Instrument No.
____ Tape No.

WEATHER
Clear _____
Cloudy _____
Windy _____
Rain _____
Fair _____
Snow _____
Hot _____
Moderate _____
Cold _____
Fog _____
Figured By _____
Notes Checked By _____
Plotted By _____

FILE No. 219-J
Fldr. No. _____
Sheet 5-018
Date 7-11 1946
Quad. No. 219-220

Station	Dist.	Angle	"	+	H. I. Bearing	Ver: Ang. Diff.	Elevation
---------	-------	-------	---	---	---------------	-----------------	-----------

-0.04 G

613.34' +0.08 T

P.I. # 6-A 1- 52° 05' 30"
2782.37 3- 156° 16' 15"
MEAN 52° 00' 35"


COR. 'D' 86.91' 219° 10' 15"

COR. 'C' 62.44' 128° 00' 10"

COR. 'B' 138.39' 92° 31' 15"

COR. 'A' 169.58' 89° 41' 30"

Plotted By: J.F.M. 7-24-46
Plotted C.E.G. 7-25-46
Checked By: W.T. 7-30-46

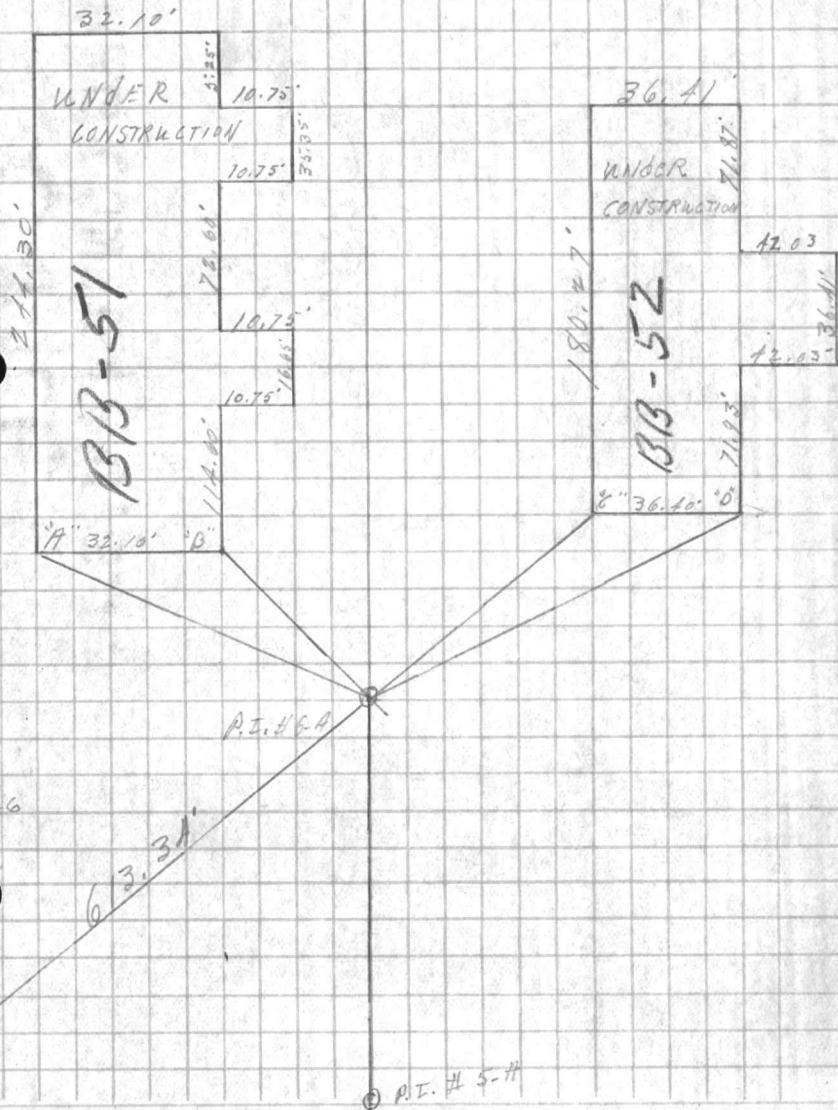






















VALUABLE

Return To
Public Works
Office
Camp Lejeune
North Carolina

SUBJECT Bldg. Location AT
Court House 154 Y.

FIELD PARTY

KELVIN In Charge
____ Instrument
____ Notes
____ Tape Read
____ Tape or Rod
____ Tape or Rod
____ Instrument No.
____ Tape No.

WEATHER

Clear
Cloudy
Windy
Rain
Fair

Snow
Hot
Moderate
Cold
Fog


FILE No. 219-D
Fldr. No. _____
Sheet 7-01-8
Date 7-11 19 46
Quad. No. 219-220

Station	Dist.	Angle "	+	H. I. Bearing	Ver. Ang. Diff.	Elevation
---------	-------	---------	---	---------------	-----------------	-----------

P.I. #10-A

-0.046
+0.097

670.63

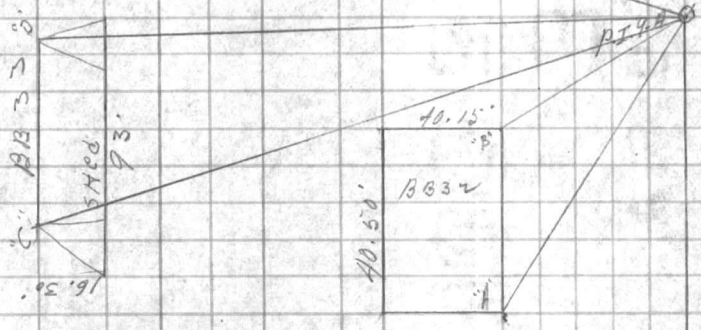

P.I. #9-A 1- 92° 22' 45"
7431.84 3- 480° 08' 30"
MEAN- 93° 22' 50"

COR. D	65.0	70° 52' 45"	1.54
COR. C	147.50	46° 39' 30"	
COR. B	106.68	26° 55' 15"	
COR. A	110.41	8° 25' 30"	

Plotted By: J.M. 7-24-46
Plotted C.E.G. 7-25-46 J.F.M.
Checked By: VLT 7-30-46

P.I. #9-A

VALUABLE
North Carolina
Cable Letters
Office
Public Works
Station

SUBJECT

FIELD PARTY

WEATHER

in Charge
Instrument
Notes
Type Read
Type of Rod
Type of Rod
Number
Date

Clear
Snow
Fog
Cloudy
Windy
Mist
Rain
Sleet
Fogged By
Notes Checked By
Plotted By
Chart No.

FILE NO.

Plot No.

Sheet

Date

Vertical Elevation
Barometer

Station
Date
Name

VALUABLE

SUBJECT Bldg. Location AT COURT
House BHT


Return To
 Public Works
 Office
 Camp Lejeune
 North Carolina

FIELD PARTY
KELLY In Charge
 Instrument _____
 Notes _____
 Tape Read _____
 Tape or Rod _____
 Tape or Rod _____
 Instrument No. _____
 Tape No. _____

WEATHER
 Clear _____
 Cloudy _____
 Windy _____
 Rain _____
 Fair _____
 Snow _____
 Hot _____
 Moderate _____
 Cold _____
 Fog _____
 Figured By _____
 Notes Checked By _____
 Plotted By _____

FILE No. 219-2
 Fldr. No. _____
 Sheet 8-0 F 8
 Date 7-12 19 46
 Quad. No. 219-220

Station	Dist.	Angle	"	+	H. I. Bearing	Ver: Ang. Diff.	Elevation
MON # 85							
MON # 86	1-101.0	27.15"					
5717.56	3-304.0	21.15"					
MEAN	101.0	27.05"					
							-0.056
5717.56							+0.117
P.I. # 11-A	1-257.0	54.15"					
3490.95	3-53.0	45.00"					
MEAN	257.0	55.00"					
COR. "D"	196.53	278.55	15"				
COR. "C"	175.85	278.0	15.40"				
COR. "B"	130.57	39.0	11.15"				
COR. "A"	146.10	29.0	30.15"				
							-0.026
390.98							+0.067
P.I. # 10-A	1-123.0	04.45"					
6720.63	3-9.0	14.45"					
MEAN	123.0	04.55"					

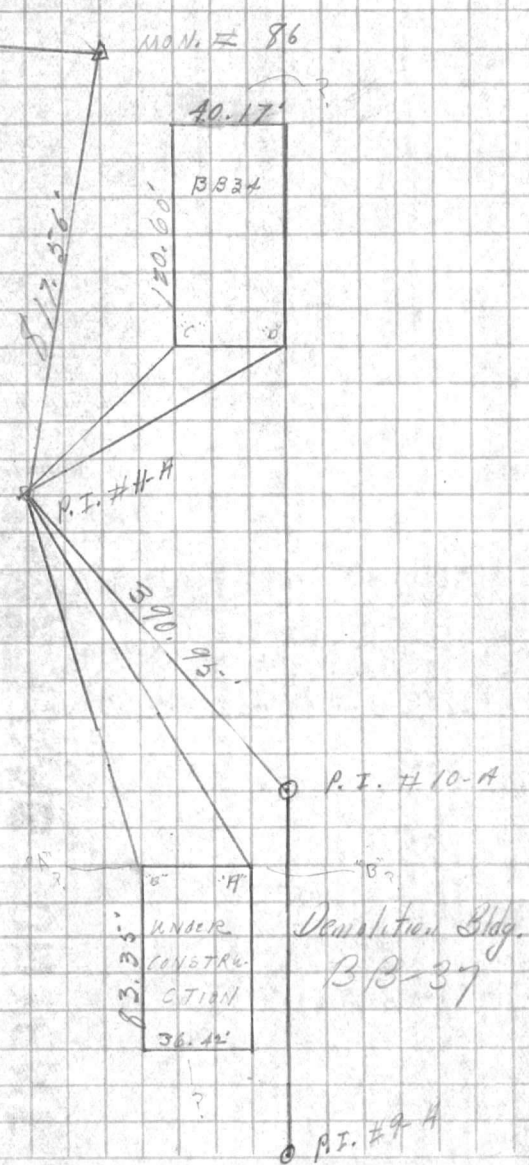

Plotted By: J.F.M. 7-24-46
 Checked By: VLT 7-30-46

AVAILABLE

SUBJECT

Return to
Public Works
Office
Camp Station
North Carolina

Station

Date

Angle

To

Base

Dir

Vertical Elevation











WEATHER

FIELD PARTY

File No.

File No.

Sheet

Date

Grid No.

VALUABLE

SUBJECT Bldg. LOCATION COURT HOUSE

1345

Return To
Public Works
Office
Camp Lejeune
North Carolina

FIELD PARTY

KELLUM In Charge
____ Instrument
____ Notes
____ Tape Read
____ Tape or Rod
____ Instrument No.
____ Tape No.

WEATHER

Clear
Cloudy
Windy
Rain
Fair

Snow
Hot
Moderate
Cold
Fog

FILE No. 219-2

Fldr. No. _____

Figured By _____ Sheet 1-OF-1

Notes Checked By _____


Plotted By _____ Date 7-15 1946

Quad. No. 219-280

Station	Dist.	Angle	"	+	H. I. Bearing	Ver: Ang. Diff.	Elevation
---------	-------	-------	---	---	------------------	--------------------	-----------

COR. 13' 291.75' 4° 22' 30"

COR. 17' 291.52' 3° 11' 45"

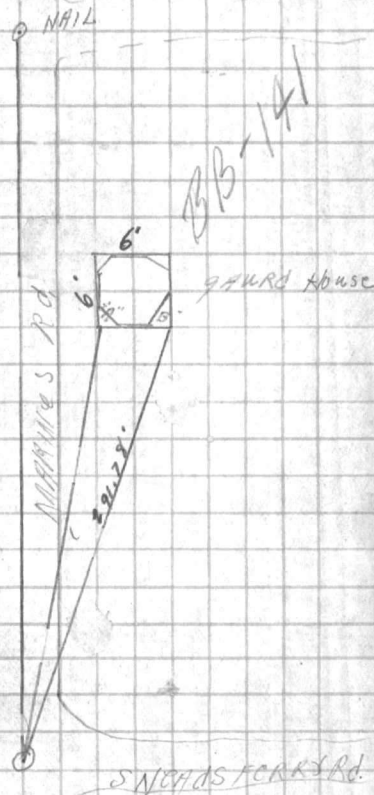




































VALUABLE

SUBJECT WATER TREATMENT PLANT
LOCATION AT COURT HOUSE BAY

Return To
 Public Works
 Office
 Camp Lejeune
 North Carolina

FIELD PARTY

KEINAM In Charge
 _____ Instrument
 _____ Notes
 _____ Tape Read
 _____ Tape or Rod
 _____ Instrument No.
 _____ Tape No.

WEATHER

Clear _____
 Cloudy _____
 Windy _____
 Rain _____
 Fair _____
 Snow _____
 Hot _____
 Moderate _____
 Cold _____
 Fog _____

FILE No. _____

Fldr. No. _____


Figured By _____ Sheet 1-051

Notes Checked By _____

Plotted By _____ Date 9-27 1946

Quad. No. _____

Station	Dist.	Angle ' "	+	H. I. Bearing	Ver: Ang. Diff.	Elevation
---------	-------	--------------	---	------------------	--------------------	-----------

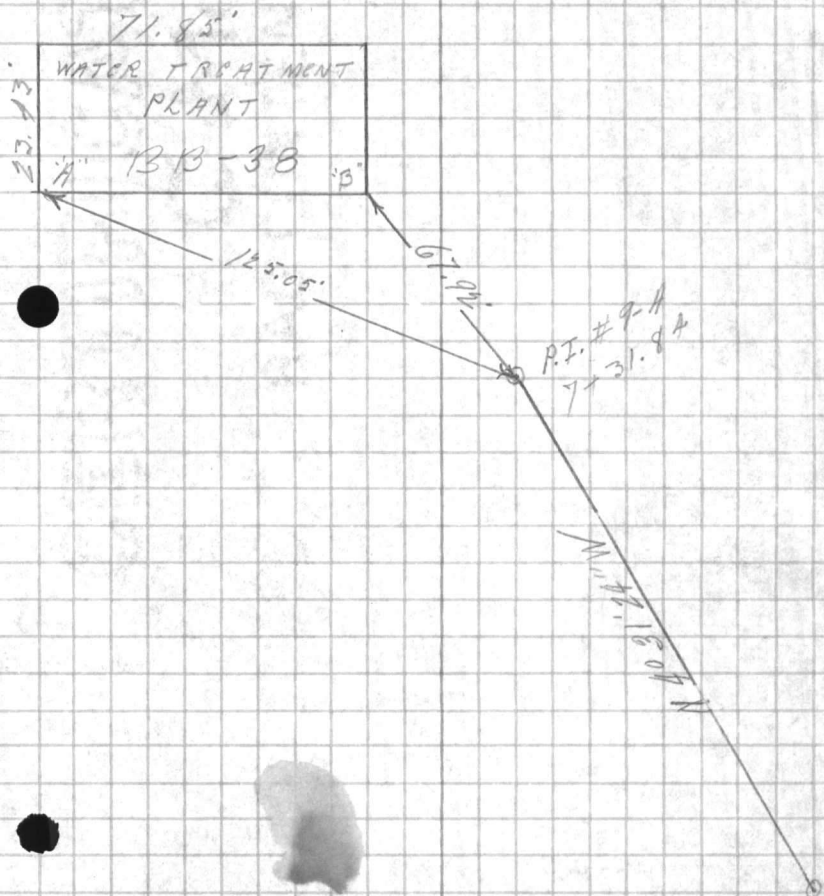

TO COR. B
 1-173° 02' 15"
 2-346° 04' 45"
 MEAN - 173° 02' 20"

TO COR. H
 1-145° 40' 30"
 2-291° 21' 13"
 MEAN - 145° 40' 37"

PUBLIC WORKS DEPARTMENT
Camp Lejeune, North Carolina
Survey Department

File 219-J
Quadrangle 219-220
Date 7/22/46
Sheet 2 of 4

Traverse Computation
Description

Building Coordinates - Engr. Bldg. School Area - Courthouse Bay

Station	Distance	Bearing	Cosine	Sine	Latitude	Departure	Y Coordinate North	X Coordinate East
P.I. #2A from P.I. #1		N25°35'18"E					306,791.24	2,492,515.86
Cor. "A" Bldg. BB-43	33.27	S65°55'12"E	4080118	9129767	13.57	30.37	306,777.67	2,492,546.23
" " "B" " "	35.22	S45°21'57"E	7025775	7116072	24.74	25.06	306,766.50	2,492,540.92
P.I. #3A from P.I. #2A		N24°57'57"E					307,300.89	2,492,753.03
Cor. "A" Bldg. BB-27	169.27	N55°19'15"E	5689805	822351	96.31	139.20	307,391.20	2,492,892.33
" " "B" " "	188.69	N64°20'30"E	4330037	9013921	81.70	170.08	307,382.59	2,492,923.25
Cor. "C" Bldg. BB-26	103.44	S76°38'45"E	2309697	9729609	23.89	100.64	307,277.00	2,492,853.77
" " "D" " "	101.31	S61°25'45"E	1782448	8782265	48.45	88.97	307,252.44	2,492,842.10
Cor. "E" Photogrametry Bldg.	133.87	S32°45'15"E	8409997	5410356	112.58	72.42	307,188.31	2,492,825.55
" " "F" " "	106.38	S23°01'45"E	9203058	3911997	97.90	41.61	307,202.99	2,492,794.94
P.I. #4A from #3A		S78°06'34"E					307,207.28	2,493,197.55
Cor. "A" Bldg. #BB29	191.54	N52°24'19"W	6100722	7923458	116.85	151.76	307,324.13	2,493,045.99
" " "B" " "	61.64	N23°56'04"W	9140102	4056911	56.34	25.00	307,263.62	2,493,172.55
Cor. "C" Bldg. #BB31	129.08	N57°05'11"E	5433739	8394908	70.14	108.36	307,277.42	2,493,305.94
P.I. #5A from #4A		S69°44'40"E					307,137.36	2,493,386.95
Cor. "A" Metal Storage Bldgs.	28.34	N23°00'10"W	9204854	3907758	26.08	11.07	307,163.44	2,493,375.88
" " "B" " "	32.14	S64°13'05"W	4349474	9004559	13.99	28.96	307,123.37	2,493,357.99

Plotted By: J.F.M. 7-24-46
Checked By: M.T. 7-30-46

Plotted C.E.G. 7-25-46 J.F.M.

Under construction

To be moved

PUBLIC WORKS DEPARTMENT
Camp Lejeune, North Carolina
Survey Department

File 219-d
Quadrangle 219-720
Date 7/22/46
Sheet # 3 of 4

Traverse Computation
Description

Building Coordinates - Engr. Bldg. School Area - Courthouse Bldg

Under Construction

Station	Distance	Bearing	Cosine	Sine	Latitude	Departure	Y Coordinate North	X Coordinate East
P.I. #6A from #5A		$562^{\circ}46'06''E$					307,008.14	2,493,637.96
Cor. "A" } BB-51	169.58	$N26^{\circ}55'24''E$	8916132	452.9978	151.20	76.78	307,159.34	2,493,719.74
" "B" }	138.39	$N29^{\circ}45'09''E$	8681772	496.2544	120.15	68.68	307,128.29	2,493,706.64
Cor. "C" } BB-52	62.44	$S44^{\circ}41'21''E$	7109325	703.2603	44.39	43.86	306,963.95	2,493,681.82
" "D" }	86.91	$S23^{\circ}35'21''E$	9164384	4001758	79.65	34.78	306,928.49	2,493,672.74
P.I. #7A from #6A		$N10^{\circ}40'22''W$					307,610.78	2,493,524.38
Cor. "A" + Bldg. BB31	108.42	$S55^{\circ}11'53''W$	5707414	8211298	61.88	89.03	307,548.90	2,493,435.32
P.I. #8A from #7A		$N85^{\circ}49'13''W$					307,645.93	2,493,043.38
Cor. "A" Bldg. BB30	163.30	$S54^{\circ}19'58''E$	5830765	8124172	95.21	132.66	307,550.72	2,493,175.97
" "B" " "	174.90	$S41^{\circ}19'28''E$	7509825	6603221	131.35	115.49	307,514.58	2,493,158.80
Cor. "C" Bldg. BB44	69.69	$N34^{\circ}49'28''W$	8209056	5710638	57.21	39.80	307,703.12	2,493,003.51
" "D" " "	76.61	$N26^{\circ}42'58''W$	893245	4495702	68.43	34.44	307,719.36	2,493,008.87
Cor. "E" Bldg. BB28	91.30	$N6^{\circ}29'02''E$	9936036	1129238	90.72	10.31	307,736.65	2,493,053.02
" "F" " "	158.24	$N82^{\circ}19'32''E$	1335442	9910429	21.13	156.82	307,667.06	2,493,200.13
P.I. 9-A from 8-A		$N4^{\circ}31'24''W$					308,375.39	2,492,985.58
Cor. "A" Water Treatment Plant	125.05	$N38^{\circ}50'47''W$	77883	62723	97.39	78.44	308,472.78	2,492,907.14
" "B" " " " "	67.92	$N11^{\circ}29'02''W$	97998	19909	66.56	13.52	308,441.95	2,492,972.06

BB-38

Plotted By: J.F.M. 7-24-46
Checked By: V.L.T. 7-30-46
Plotted C. & G. 7-25-46 J.F.M.

PUBLIC WORKS DEPARTMENT
Camp Lejeune, North Carolina
Survey Department

File 219-J
Quadrangle 219-220
Date 7/23/46
Sheet 4 of 4


Traverse Computation
Description

Building Co-ordinates - Engr. Bldg. School Area - Courthouse Bldg

Station	Distance	Bearing	Cosine	Sine	Latitude ϕ	Departure	Y Coordinate North	X Coordinate East
P.I. #9 A from #8 A		N4°31'24"W					308,375.39	2,492,985.58
Cor. "A" Bldg BB-32	110.41 ✓	S0°54'06"W	9998762 ✓	0157369 ✓	110.40 ✓	1.74 ✓	308,264.99	2,492,983.84
" "B" " "	100.68 ✓	S22°23'51"W	9245627 ✓	38103 ✓	93.08 ✓	38.36 ✓	308,282.31	2,492,947.22
Cor. "C" " BB-33	147.50 ✓	S42°08'06"W	7415662 ✓	6708797 ✓	109.38 ✓	98.95 ✓	308,266.01	2,492,886.63
" "D" " "	65.00 ✓	S66°21'21"W	4010553 ✓	9160538 ✓	26.07 ✓	59.54 ✓	308,349.32	2,492,926.04
P.I. #11 A from #10 A		S31°56'39"W					308,030.24	2,492,108.04
Cor. "A" Demolition Bldg. BB-37	148.10	N61°26'54"E	4779510	8783865	70.78	130.09	308,101.02	2,492,238.13
" "B" " "	120.54	N71°41'29"E	3141582	9493707	37.87	114.44	308,068.18	2,492,222.48
Cor. "C" Bldg. BB-34	175.85	N49°47'36"W	6455465	7637209	113.52	134.30	308,143.76	2,491,973.74
" "D" " "	196.53	N39°09'06"W	7754774	6313753	152.40	124.08	308,182.64	2,491,983.96

Plotted By: J.F.M. 7-24-46
Plotted C.E.G. 7-25-46 J.F.M.
Checked By: VLT 7-30-46

Does Not Check X

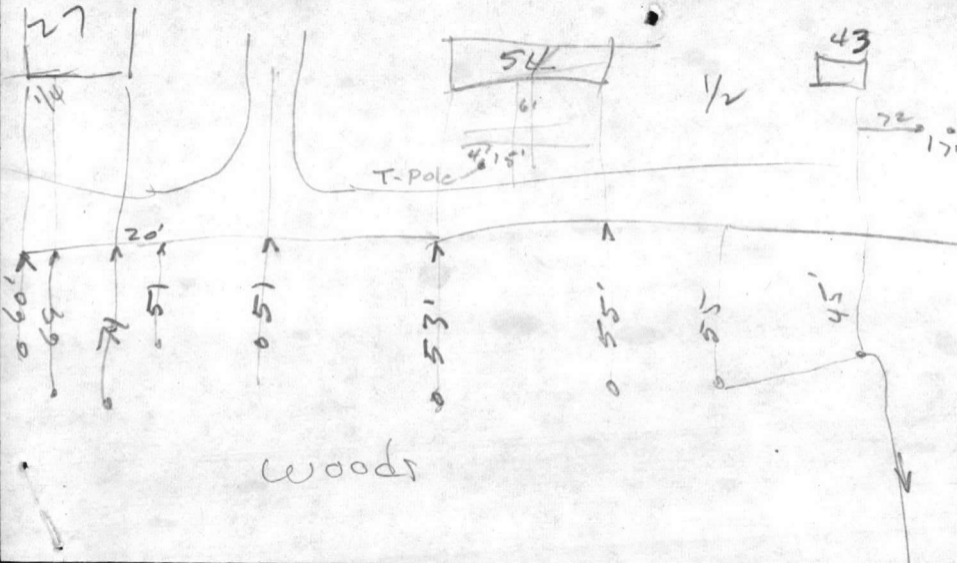

woods

T-Pole 4' 15''

54

43

1/2

72 17''

20'

109'
68'

15'

51'


53'

55'

55'



45'


115

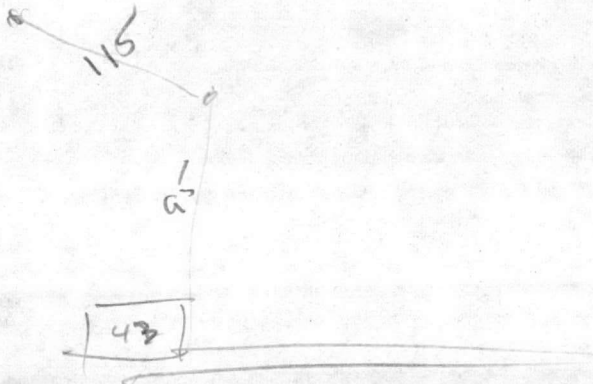

153

43

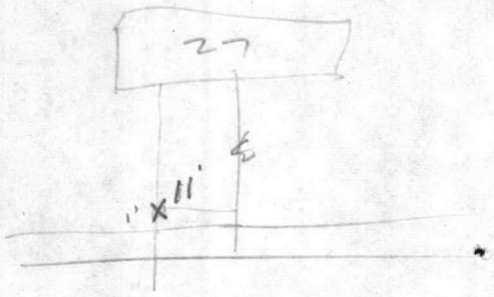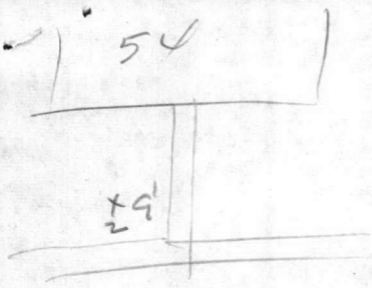

 

7.3 62
VALUABLE

SUBJECT _____

RETURN TO
 PUBLIC WORKS
 OFFICE
 CAMP LEJEUNE
 NORTH CAROLINA

14.2
 4.7
 9.5

FIELD PARTY

 IN CHARGE

 INSTRUMENT

 NOTES

 TAPE READ

 TAPE OR ROD

 TAPE OR ROD

 INSTRUMENT No. _____
 TAPE No. _____

WEATHER

CLEAR
 CLOUDY
 WINDY
 RAIN
 FAIR
 SNOW
 HOT
 MODERATE
 COLD
 FOG
 FIGURED BY _____
 NOTES CHECKED BY _____
 PLOTTED BY _____

FILE No. _____
 FLDR. No. _____
 SHEET _____
 DATE _____ 19__

Quad. No. _____

STATION	DIST.	ANGLE ° ' "	+	H. I. BEARING	VER. ANG. DIFF.	ELEVATION	
TBM TCA	BS ON WALK			4.16	17.36	13 20	FIN FL. WELL HSE BB#43
	270.00					3.8	13 6 EP
	66					4.3	13.1 SHOULDER
	79					5.3	12.1 BOT DITCH
	83					4.6	12.8 TOP DITCH BANK
	126					4.6	12.8 GS
	200					5.3	12.1 GS
	259					4.7	12.7 EW, 10" PINE 5' LEFT
	0	0-00				4.7	12.7
TCA	BS ON A			4.6	17.3	12.7	TBM @ A
	258						
	30	180-00				4.8	12.5 GS, WILD CHERRY 15" TWIG 2' LEFT
	54					6.0	11.3 TOP OF BANK 15" GUM 3' LEFT
	64					10.6	6.7 BOTTOM OF BANK
	96					12.1	5.2 GS, 8" GUM 1' RT.
	125					13.3	4.0 GS





































VALUABLE

SUBJECT

Water Line Location

Courthouse Bay

RETURN TO
PUBLIC WORKS
OFFICE
CAMP LEJEUNE
NORTH CAROLINA

FIELD PARTY

____ IN CHARGE
____ INSTRUMENT
____ NOTES
____ TAPE READ
____ TAPE OR ROD
____ TAPE OR ROD
____ INSTRUMENT NO.
____ TAPE NO.

WEATHER

CLEAR
CLOUDY
WINDY
RAIN
FAIR

SNOW
HOT
MODERATE
COLD
FOG

85.7 81.0

FILE No. _____

FLDR. No. _____

SHEET #1

FIGURED BY _____

NOTES CHECKED BY _____

PLOTTED BY _____


DATE _____ 19__

Quad. No. _____

STATION	DIST.	ANGLE ° ' "	+	H. I. BEARING	VER. ANG. DIFF.	ELEVATION
B.M.	5	Stoop of Well	3.81	17.01		13.20
Top 10" C.I. by 10" Valve					8.23	8.78
Inv. of 90° Ell from Well					9.0	8.0

B.M. 5 Stoop of Well
3.81 17.01

Top 10" C.I. by 10" Valve
Inv. of 90° Ell from Well

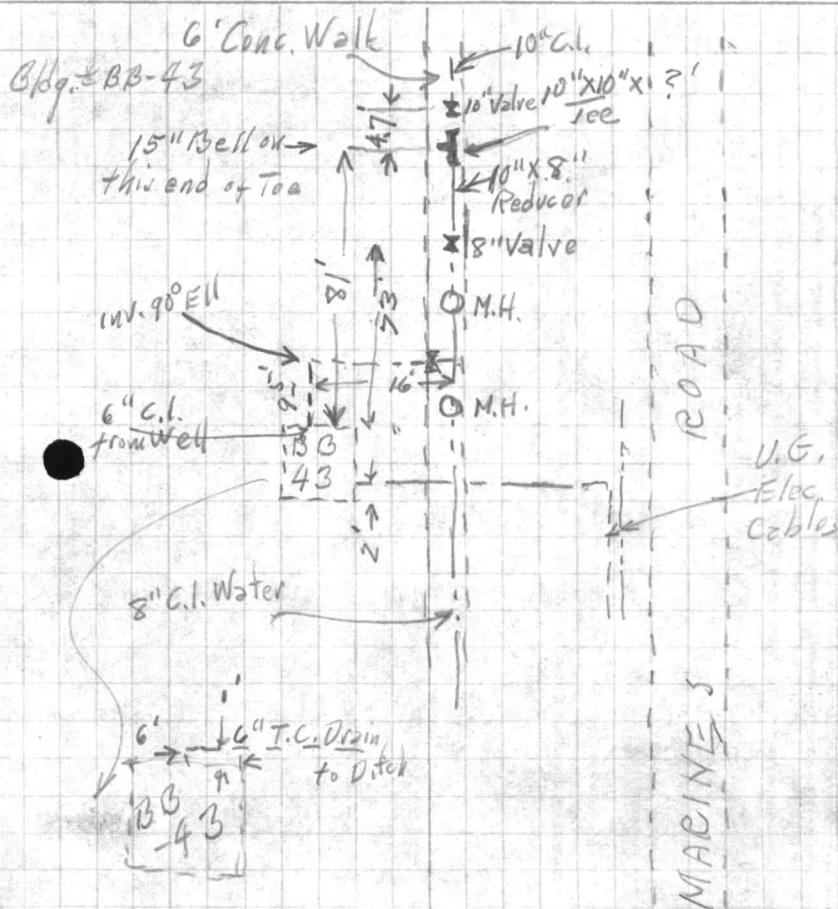

Floor of Well is .03' Higher than stoop used as B.M.

8.9

3.9

BB
43

WARRANT

SEARCHED

INDEXED
SERIALIZED
FILED

STATION







 

BB #43

ALIX ENG.

WISCONSIN AIR COOLED

SERIAL No. 1771825



MODEL VE 4

SIZE 3X 3 1/4



SPEC No 49744

MOTOR 10HP

CHECK UA 1'-4" LL

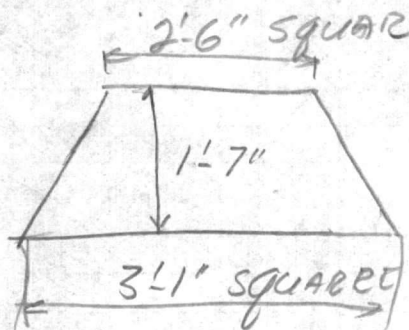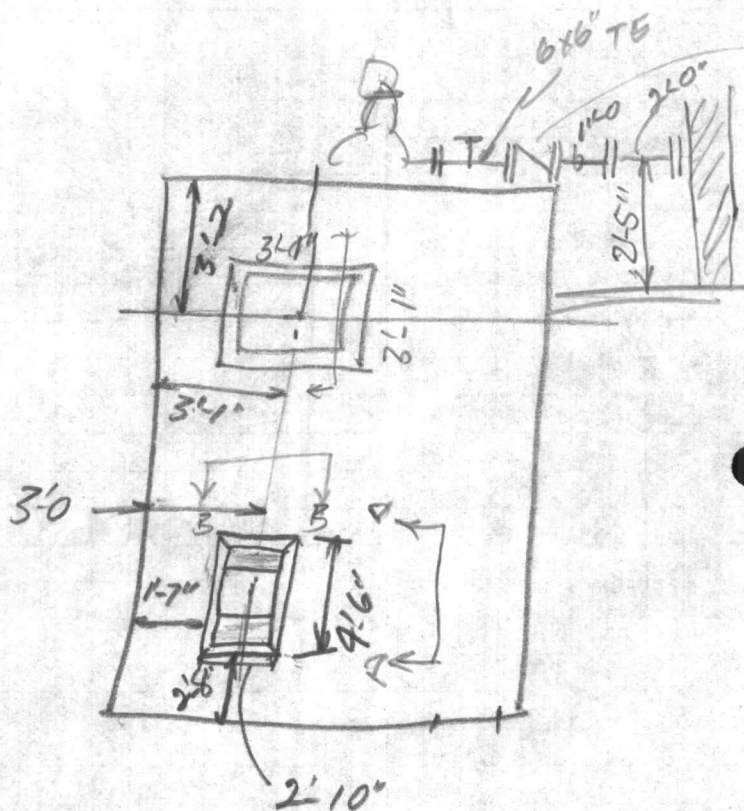

Pump Base

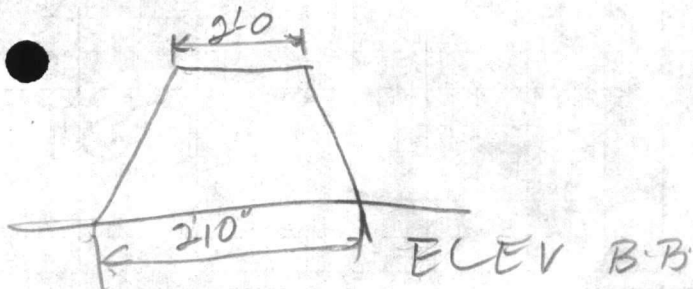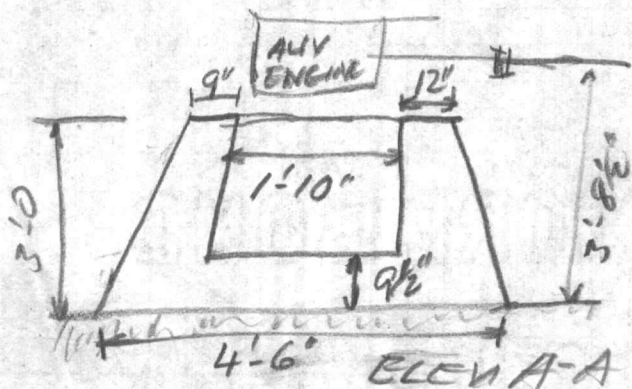

VALUABLE
 SUBJECT _____

 RETURN TO
 PUBLIC WORKS
 OFFICE
 CAMP LEJEUNE
 NORTH CAROLINA

FIELD PARTY

 _____ IN CHARGE
 _____ INSTRUMENT
 _____ NOTES
 _____ TAPE READ
 _____ TAPE OR ROD
 _____ TAPE OR ROD
 _____ INSTRUMENT NO.
 _____ TAPE NO.

WEATHER

 CLEAR
 CLOUDY
 WINDY
 RAIN
 FAIR
 SNOW
 HOT
 MODERATE
 COLD
 FOG

FILE No. _____

FLDR. No. _____

FIGURED BY _____ SHEET _____

NOTES CHECKED BY _____

PLOTTED BY _____ DATE _____ 19__

Quad. No. _____

STATION	DIST.	ANGLE		+	H. I. BEARING	VER: ANG. DIFF.	ELEVATION
		°	"				

2nd M.H.

Corp. Cock in Main
8" C.I.


Elev. - 4.3 below Top of 2nd M.H. from
Well

1st M.H. 6" stub toward Well

Elev. of Main 8" - 4.4 below top of M.H.
Corp. Cock in Main.

FR ——— 203 SERVICE
TO FILLING STA

o 1775 ?
o

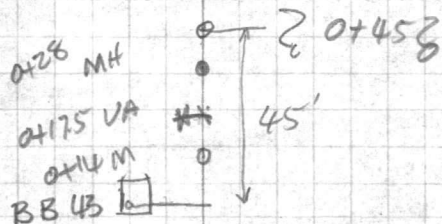






VALUABLE

RETURN TO
CARR & J. E.
GREINER CO.
JACKSONVILLE,
N. C.

SUBJECT Elev. of water in tanks
at time of overflow

FIELD PARTY
M. G. King IN CHARGE
INSTRUMENT
NOTES
TAPE READ
TAPE OR ROD
TAPE OR ROD
INSTRUMENT NO.
TAPE NO.

WEATHER
CLEAR CLOUDY RAIN FAIR
SNOW HOT MODERATE COLD FOG
FIGURED BY
NOTES CHECKED BY
PLOTTED BY

FILE NO.
FLDR. NO.
SHEET
DATE Oct 28 1942

STATION	DIST.	ANGLE	+ Elev. H. I. Trapdoor	- VERI. ANG. DIFF.	ELEVATION
Tank in Housing Area	161.12			1.40	159.72
" " Officers Quarters	162.00			2.03	159.97
" " Industria) Area	160.84			1.25	159.59 160.59
" " Reg. Area 1-	161.94			1.53	160.41
" " Reg. Area 5	162.19			1.80	160.39
" " TENT CAMP #1	168.33				
" " TENT CAMP #2	168.57			1.32	167.25
" " RIFLE RANGE	175.69			1.4	174.29
MUMFORD #1					109.3
BALLOON BARRAGE	137.55				136.75 CAPACITY LINE (NO OVERFLOW PIPE)

Water Elev In Tanks
@ Time of Overflow

STATION

DATE
TIME
MILEAGE

STATION

REMARKS

DATE
TIME

STATION

DATE
TIME

REMARKS

STATION

DATE
TIME

REMARKS

STATION

VALUABLE

SUBJECT Topo For Water Treat.
Plant

RETURN TO
PUBLIC WORKS
OFFICE
CAMP LEJEUNE
NORTH CAROLINA

FIELD PARTY

IN CHARGE Dillon
INSTRUMENT Morris
NOTES
TAPE READ Ellington
TAPE OR ROD
TAPE OR ROD
INSTRUMENT No.
TAPE No.

WEATHER

CLEAR
CLOUDY
WINDY
RAIN
FAIR
SNOW
HOT
MODERATE
COLD
FOG
FIGURED BY
NOTES CHECKED BY
PLOTTED BY

FILE No. _____
FLDR. No. _____
SHEET 1
DATE 3 Apr. 1967

Quad. No. _____

STATION	DIST.	ANGLE ° ' "	+	H. I. BEARING	VER. ANG. DIFF.	ELEVATION	
T.B.M.			4.64	17 84		13.20	Fl. Elev. Well House 1313-43
TOP							
274	350-10				3.5	14.3	E RD
272	352-30				3.7	14.1	ES
272	354-45				4.4	13.4	ES
272	356-20				7.7	10.1	E B PIPE
270	357-25				5.3	12.5	ES
270	358-45				4.7	13.1	Top MH
270	0-00				4.7	13.1	E WALK
272	11-05				3.5	14.3	ES
283	22-55				4.0	13.8	WL
285	28-55				4.1	13.7	WL
290	35-10				6.1	11.7	GS
303	43-20'				6.0	11.8	GS
329	50-45				4.7	13.1	GS
388	60-40'				2.0	15.8	WL & Top of BANK
419	62-50'				5.3	12.5	GS IN FIELD
377	69-10				5.9	11.9	" " "
350	67-25				2.7	15.1	WL & Top of BANK
317	64-50				3.8	14.0	GS
275	59-35				4.9	12.9	GS
233	51-50				6.4	11.4	GS
198	43-10				5.8	12.0	GS
162	27-15				4.2	13.6	WL
145	11-25				4.1	13.7	WL
139	0-00				4.5	13.3	E WALK
140	356-50				5.0	12.8	Top of B SLOPE
140	353-45				7.9	9.9	E BRD
142	349-35				4.1	13.7	ES
143	345-30 345-30				3.5	14.3	EP




VACUUM

ROBERT WOOD
JOHN F. WOOD

1950

1950

 

VALUABLE

SUBJECT _____

RETURN TO
PUBLIC WORKS
OFFICE
CAMP LEJEUNE
NORTH CAROLINA

FIELD PARTY

IN CHARGE

INSTRUMENT

NOTES

TAPE READ

TAPE OR ROD

TAPE OR ROD

INSTRUMENT No.

TAPE No.

WEATHER

CLEAR SNOW
CLOUDY HOT
WINDY MODERATE
RAIN COLD
FAIR FOG

FILE No. _____

FLDR. No. _____

SHEET 2

FIGURED BY _____
NOTES CHECKED BY _____

PLOTTED BY _____ DATE _____ 19__

Quad. No. _____

STATION	DIST.	ANGLE ° ' "	+	H. I. BEARING	VER: ANG. DIFF.	ELEVATION	
TOA				1784			
147	344-30				3.5	14.3	RD
78	323-10				3.6	14.2	RD
72	330-00				3.6	14.2	EP
67	338-20				4.4	13.4	E.S.
65	346-10				8.2	9.6	RD
64	350-35				6.2	11.6	B.SLOPE
63	0-00				4.9	12.9	WALK
122	3°20'				4.6	13.2	VAL BOX CON BLDG
123	10-35'				4.4	13.4	" "
115	12-15'						VAL BOX MH
112	2-35'						" "
101	12-10'						" "
96	357-55						ST. LIGHT POLE
84	41-40				5.3	12.5	(W) LENS
130	62-35				5.6	12.2	GS
170	71-00				5.0	12.8	"
222	77-10				4.1	13.7	"
283	83-50				3.2	14.6	WL @ Top of BANK
324	87-10				6.6	11.2	GS IN FIELD
298	97-35				7.1	10.7	" " "
253	97-40				6.0	11.8	WL
188	94-20				5.4	12.4	GS
142	90-00				5.9	11.9	PROPOSED MH
95	92-00				6.4	11.4	GS
35	85-40				5.4	12.4	WL
0	0-00				4.8	13.0	WALK
10	265-00				6.2	11.6	B.SLOPE
15	266-30				8.3	9.5	RD
25	266-30				4.5	13.3	ES

VALUABLE

SUBJECT _____

RETURN TO
 PUBLIC WORKS
 OFFICE
 CAMP LEJEUNE
 NORTH CAROLINA

FIELD PARTY

 IN CHARGE

 INSTRUMENT

 NOTES

 TAPE READ

 TAPE OR ROD

 TAPE OR ROD

 INSTRUMENT No. _____
 TAPE No. _____

WEATHER

CLEAR SNOW
 CLOUDY HOT
 WINDY MODERATE
 RAIN COLD
 FAIR FOG

FILE No. _____

FLDR. No. _____

SHEET 3

FIGURED BY _____
 NOTES CHECKED BY _____

PLOTTED BY _____ DATE _____ 19__

Quad. No. _____

STATION	DIST.	ANGLE " ' "	+	H. I. BEARING	VER: ANG. DIFF.	ELEVATION	
<u>TOA</u>				<u>17 83</u>			
36	209-20				3.6	14.2	ERD
46	269-20				3.6	14.2	ERD
94	240-00						POWER POLE
81	238-10						BUY
85	252-45						"
185	246-20						SERVICE POLE
170	243-50						COR. PARKING
164	210-00						BUY
179	207-05						PRIMARY POLE
78	216-40				3.6	14.2	ERD
71	210-10				3.8	14.0	ERD
65	202-05				4.7	14.1	B.S.
62	193-40				8.6	9.2	B 1/2 ERD
61	189-15				6.1	11.7	B SCOPE
61	180-00				4.7	14.1	E WALK - G' WALK
72	180-40						VAL BOX
97	180-20						LIGHT POLE
68	148-10				5.2	12.6	WOODS LINE
106	123-30				7.0	10.4	GS
147	116-20				7.5	10.3	GS
193	112-20				7.7	10.1	GS
248	112-20				7.4	10.4	W.G
297	112-20				8.0	9.8	GS
298	122-50				8.6	9.2	GS
263	126-20				8.8	9.0	WL
220	134-15				7.8	10.0	WL
180	137-15				8.4	9.4	GS
190	148-45				7.9	9.9	WL
223	153-10				8.4	9.4	WL
142	159-00				6.6	11.2	GS WL

VALUABLE

SUBJECT _____

RETURN TO
PUBLIC WORKS
OFFICE
CAMP LEJEUNE
NORTH CAROLINA

FIELD PARTY

IN CHARGE

INSTRUMENT

NOTES

TAPE READ

TAPE OR ROD

TAPE OR ROD

INSTRUMENT No.

TAPE No.

WEATHER

CLEAR
CLOUDY
WINDY
RAIN
FAIR

SNOW
HOT
MODERATE
COLD
FOG

FILE No. _____

FLDR. No. _____

SHEET 4

FIGURED BY _____
NOTES CHECKED BY _____

PLOTTED BY _____ DATE _____ 19__

Quad. No. _____

STATION	DIST.	ANGLE " "	+	H. I. BEARING	VER: ANG. DIFF.	ELEVATION	
<i>TOA</i>				1784			
130	168-00				5.5	12.3	WL
125	180-00				5.3	12.5	E WALK
125	183-55				6.2	11.6	B.S.
127	186-40				8.6	9.2	BOT BRD
129	190-10				5.3	12.5	GS
131	193-05				4.1	13.7	GS
133	195-40				3.8	14.0	E.P.
137	200-00				3.8	14.0	BRD
190	194-05				4.1	13.7	BRD
190	190-55				4.3	13.5	EP
189	187-20				5.3	12.5	GS
190	184-40				8.8	9.0	BOT BRD
190	183-10				7.2	10.6	B.S.
191	180-00				6.5	11.3	E WALK
156	181-55				5.88	11.96	SEC M.H. TOP
192	173-45				7.5	10.3	GS
200	168-10				7.9	9.9	WL
245	150-30				8.6	9.2	WL
292	141-35				8.6	9.2	GS
347	136-15				8.8	9.0	GS
390	144-10				9.1	8.7	GS
350	150-40				8.4	9.4	WL
330	156-00				8.3	9.5	GS
305	163-25				8.8	9.0	GS
295	169-10				9.4	8.4	GS
295	176-20				9.0	8.8	WL
288	180-00				8.1	9.7	EIN
287	182-35				7.6	10.2	BS
284	183-10				9.0	8.8	BRD
287	184-30				6.5	11.3	GS
290	185-45				5.4	12.4	GS

VALUABLE

STATION
DATE
TIME
NAME
NO.

STATION
DATE
TIME
NAME
NO.

VALUABLE

SUBJECT _____

RETURN TO
PUBLIC WORKS
OFFICE
CAMP LEJEUNE
NORTH CAROLINA

FIELD PARTY

 _____ IN CHARGE
 _____ INSTRUMENT
 _____ NOTES
 _____ TAPE READ
 _____ TAPE OR ROD
 _____ TAPE OR ROD
 _____ INSTRUMENT NO.
 _____ TAPE NO.

WEATHER

 CLEAR SNOW
 CLOUDY HOT
 WINDY MODERATE
 RAIN COLD
 FAIR FOG

FILE No. _____

FLDR. No. _____

SHEET 5

DATE _____ 19__

 FIGURED BY _____
 NOTES CHECKED BY _____
 PLOTTED BY _____

Quad. No. _____

STATION	DIST.	ANGLE		+	H. I. BEARING	VER: ANG. DIFF.	ELEVATION	
		°	' "					
<i>TCA</i>					<i>17 84</i>			
<i>290</i>	<i>187-10</i>					<i>5.0</i>	<i>12.8</i>	<i>EP</i>
<i>291</i>	<i>189-15</i>					<i>4.9</i>	<i>12.9</i>	<i>E RD</i>
<i>340</i>	<i>193-55</i>							<i>POWER POLE</i>
<i>318</i>	<i>180-50</i>							<i>LIGHT POLE</i>
<i>780</i>	<i>132-00</i>					<i>9.9</i>	<i>7.9</i>	<i>JUNCTION OF 1/2 RD PIPE</i>
<i>720</i>	<i>119-00</i>					<i>10.1</i>	<i>7.7</i>	<i>DITCH COR</i>
<i>550</i>	<i>181-20</i>					<i>10.5</i>	<i>7.3</i>	<i>GULVERT INU</i>

STATE OF NORTH CAROLINA
COUNTY OF _____
DEED BOOK _____
PAGE _____

15-11 From well


VALUABLE

LIBRARY

WITHDRAWN
FROM CIRCULATION
DATE
BY

NO. 1
SERIALS



 

VALUABLE

SUBJECT

Gas Sta.

Chouse Bay

RETURN TO
PUBLIC WORKS
OFFICE
CAMP LEJEUNE
NORTH CAROLINA

FIELD PARTY

____ IN CHARGE
____ INSTRUMENT
____ NOTES
____ TAPE READ
____ TAPE OR ROD
____ TAPE OR ROD
____ INSTRUMENT NO.
____ TAPE NO.

WEATHER

CLEAR
CLOUDY
WINDY
RAIN
FAIR
SNOW
HOT
MODERATE
COLD
FOG
FIGURED BY _____
NOTES CHECKED BY _____
PLOTTED BY _____

FILE No. _____

FLDR. No. _____

SHEET

#2 of 3

DATE

11/2 1965

Quad. No. _____

STATION	DIST.	ANGLE ° ' "	+	H. I. BEARING	VER. ANG. DIFF.	ELEVATION
				17.97		
28	77'	312° 35'			4.9	13.1
29	72'	303° 15'			4.8	13.2
30	76'	296° 20'			4.7	13.3
31	76'	293° 15'			4.7	13.3
32	85'	291° 10'			4.4	13.6
33	105'	296° 35'			4.2	13.8
34	110'	320° 40'				
35	99'	313° 05'				
36	265'	344° 55'				
Rd.	267'	336° 50'			5.2	12.8
38	286'	328° 55'				
39	220'	00° 00'			5.8	12.2
40	225'	7° 10'			7.7	10.3
41	222'	15° 10'			7.5	10.5
42	147'	00° —			5.2	12.8
43	150'	11° 50'			6.5	11.5
44	185'	24° 25'			9.3	8.7
45	140'	24° 25'			6.4	11.6
46	125'	32° 10'			5.9	12.1
47	170'	36° 15'			8.3	9.7
48	127'	49° 15'			6.0	12.0
49	157'	"				
50	145'	64° 25'			6.0	12.0
51	158'	62° 55'			9.2	8.8
52	146'	73° 50'			6.3	11.7
53	156'	"			10.3	7.7
54	142'	91° —			5.7	12.3
55	111'	110° 25'			5.0	13.0
56	80'	125° 10'			5.2	12.8
57	64'	134° —			5.6	12.4

End Curb & End Return
Center Rod

~~14. Return~~
Arc Light Pole (2 Lights)
Grip Anchor
Light Pole

Power Pole
Grip at Curb


Woods Line
Grip at Curb

Woods Line

15" Oak
Woods Line
30" Pine
Woods Line

+ 20' to Woods Line

+ 40' to Woods Line
8" Pine

 

VALUABLE

SUBJECT

Gas Sta.

House Bdy.

RETURN TO
PUBLIC WORKS
OFFICE
CAMP LEJEUNE
NORTH CAROLINA

FIELD PARTY

____ IN CHARGE
 ____ INSTRUMENT
 ____ NOTES
 ____ TAPE READ
 ____ TAPE OR ROD
 ____ TAPE OR ROD
 ____ INSTRUMENT NO.
 ____ TAPE NO.

WEATHER

CLEAR SNOW
 CLOUDY HOT
 WINDY MODERATE
 RAIN COLD
 FAIR FOG

FILE No. _____

FLDR. No. _____

SHEET

3 of 3

DATE

11/2 19 65

FIGURED BY _____

NOTES CHECKED BY _____

PLOTTED BY _____

Quad. No. _____

STATION	DIST.	ANGLE ° ' "	+	H. I. BEARING	VER: ANG. DIFF.	ELEVATION
				17.97		
58	48'	175°			4.9	13.1
59	0'	00'			4.9	13.1
60	41'	71° 10'			5.7	12.3
61	62'	00°			4.9	13.1
62	76'	28° 45'			6.2	11.8
63	114'	170° 35'			6.5	11.5

At set-up - Grd shot.
 Grd shot at curb









