

**VALUABLE**

RETURN TO  
PUBLIC WORKS  
OFFICE  
CAMP LEJEUNE  
NORTH CAROLINA

SUBJECT Elev. pipes under  
High #17 from 1st St to  
Curtis Rd


FIELD PARTY  
W. H. ... IN CHARGE  
INSTRUMENT \_\_\_\_\_  
NOTES \_\_\_\_\_  
TAPE READ \_\_\_\_\_  
TAPE OR ROD \_\_\_\_\_  
TAPE OR ROD \_\_\_\_\_  
STRUMENT NO. \_\_\_\_\_  
TAPE NO. \_\_\_\_\_

WEATHER  
CLEAR \_\_\_\_\_  
CLOUDY \_\_\_\_\_  
WINDY \_\_\_\_\_  
RAIN \_\_\_\_\_  
FAIR \_\_\_\_\_  
SNOW \_\_\_\_\_  
HOT \_\_\_\_\_  
MODERATE \_\_\_\_\_  
COLD \_\_\_\_\_  
FOG \_\_\_\_\_  
FIGURED BY \_\_\_\_\_  
NOTES CHECKED BY \_\_\_\_\_  
PLOTTED BY \_\_\_\_\_

FILE No. 97-Gen  
FLDR. No. \_\_\_\_\_  
SHEET lot 2  
DATE 2/23 1953

Quad. No. \_\_\_\_\_

STATION	DIST.	ANGLE ° ' "	+	H. I. BEARING	VER: ANG. DIFF.	ELEVATION
B.M.			3.14	40.65		37.51
<del>#1</del>					10.15	30.50
②					11.5	29.1
T.P.					7.72	32.93
	2.99	35.92			6.36	29.56
	2.53	32.09			8.6	23.5
③					10.4	21.7
T.P.					4.44	27.65
	2.95	30.60			4.95	25.65
T.P.			3.56	29.21		
T.P.					6.42	22.79
	3.07	25.86			(21.77)	
B.M. <del>#4</del>					4.01	21.85
	2.82	<del>24.59</del>			(21.77)	
		24.59				
⑤					15.8	8.8
⑥					15.4	9.2
T.P.					9.81	14.78
	7.45	22.23				

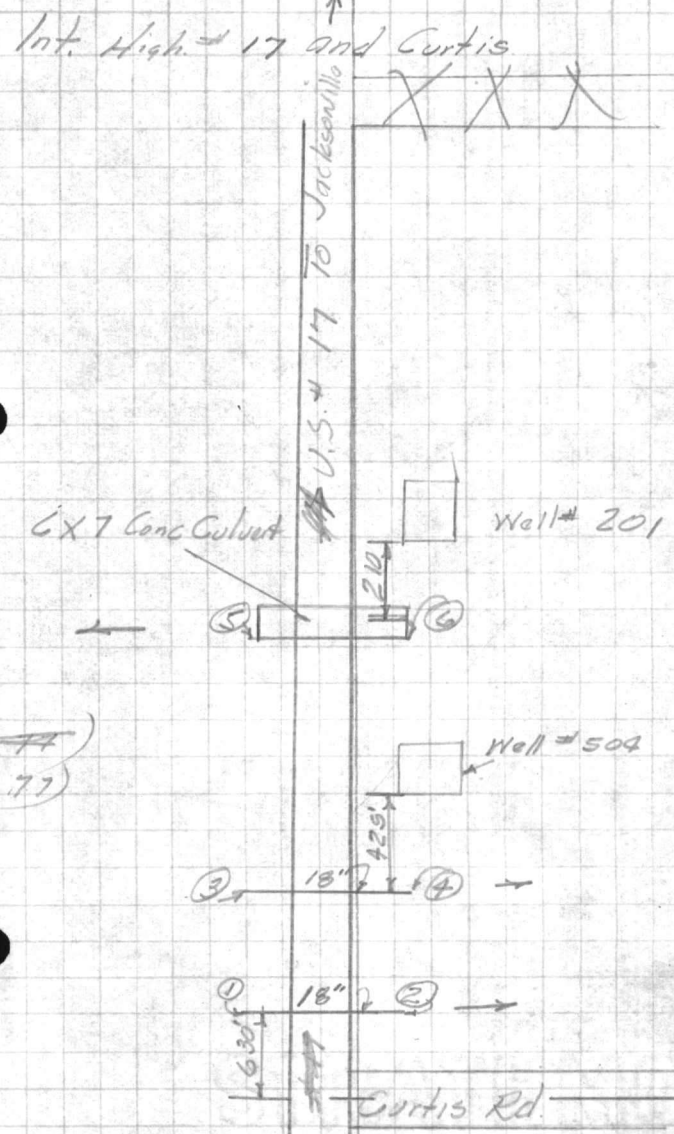




8.5  
0.5  
8.0

8.5  
0.5  
8.0

**VALUABLE**

RETURN TO  
PUBLIC WORKS  
OFFICE  
CAMP LEJEUNE  
NORTH CAROLINA

SUBJECT Elcu pipes under  
Highway 17 from 1st st. to  
Curtis Rd.


FIELD PARTY  
Morton IN CHARGE  
INSTRUMENT  
NOTES  
TAPE READ  
TAPE OR ROD  
TAPE OR ROD  
INSTRUMENT NO.  
TAPE NO.

WEATHER  
CLEAR  
CLOUDY  
WINDY  
RAIN  
RAIN  
FAIR  
SNOW  
HOT  
MODERATE  
COLD  
FOG  
FIGURED BY  
NOTES CHECKED BY  
PLOTTED BY

FILE No. \_\_\_\_\_  
FLDR. No. \_\_\_\_\_  
SHEET 2 of 2  
DATE \_\_\_\_\_ 19\_\_

Quad. No. \_\_\_\_\_

STATION	DIST.	ANGLE ' "	+	H. I. BEARING	VER: ANG. DIFF.	ELEVATION
T.P.				22.23	2.49	19.74
⑦		2.93		22.67	12.3	10.4
⑧					6.9	15.8
⑨					13.2	9.5
⑩					14.3	8.4
⑪					10.4	12.3
⑫					11.7	11.0
⑬					7.6	15.1
⑭					7.1	15.6
B.M. Mon # 313					1.71	19.96 (1997)

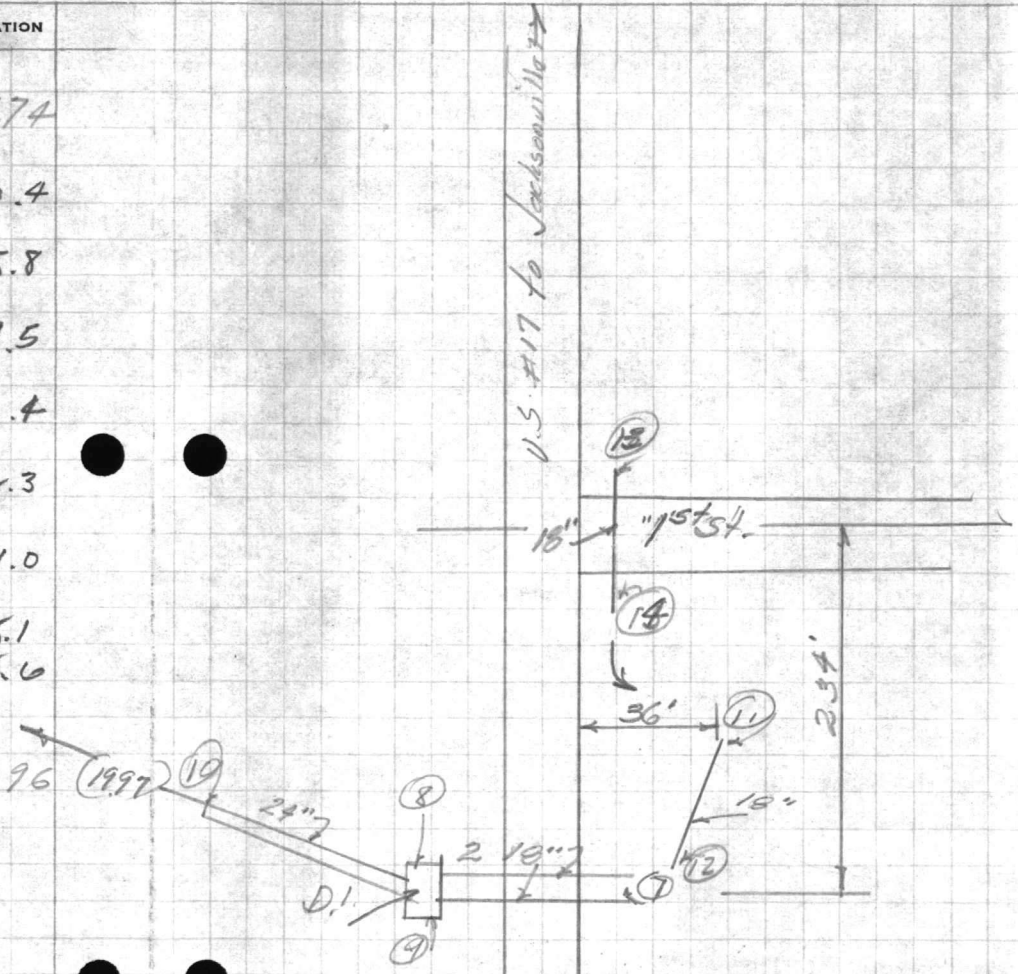

$$\begin{array}{r} 61 \\ \underline{15} \\ 76 \end{array}$$

$$\begin{array}{r} 56 \\ \underline{15} \\ 71 \end{array}$$






**VALUABLE**

RETURN TO  
PUBLIC WORKS  
OFFICE  
CAMP LEJEUNE  
NORTH CAROLINA

SUBJECT Floor Elevations of Relocated  
Wells #202, #604, #1000 and "H"  
along N.C. Hwy. #17 at Camp Geiger

FIELD PARTY  
Dillon IN CHARGE  
\_\_\_\_ INSTRUMENT  
\_\_\_\_ NOTES  
\_\_\_\_ TAPE READ  
\_\_\_\_ TAPE OR ROD  
\_\_\_\_ TAPE OR ROD  
\_\_\_\_ TRUMENT No.  
\_\_\_\_ TAPE No.

WEATHER  
CLEAR \_\_\_\_\_ SNOW \_\_\_\_\_  
CLOUDY \_\_\_\_\_ HOT \_\_\_\_\_  
WINDY \_\_\_\_\_ MODERATE \_\_\_\_\_  
RAIN \_\_\_\_\_ COLD \_\_\_\_\_  
FAIR \_\_\_\_\_ FOG \_\_\_\_\_  
FIGURED BY \_\_\_\_\_  
NOTES CHECKED BY \_\_\_\_\_  
PLOTTED BY \_\_\_\_\_

FILE No. 97 Gen.  
FLDR. No. \_\_\_\_\_  
SHEET #1  
DATE 3/31 1960


Quad. No. \_\_\_\_\_

STATION	DIST.	ANGLE " "	+	H. I. BEARING	VER. ANG. DIFF.	ELEVATION
B.M.			4.80	25.59		20.79
Floor Elev. New Well #202					3.58	22.01
Finished Ground Grade					3.9	21.7
Old Original Ground					4.7	20.9
Air Vent Top			Fl. Elev. + 2.40 =			24.4
B.M. Floor Elev. of Well #504						23.88
			4.47	28.35		
					4.61	23.74
			4.71	28.45		
					2.63	25.82
			6.80	32.62		
Floor Elev. New Well #604					5.08	27.54
Finished Ground Grade					5.3	27.3
Old Original Ground					5.8	26.8
Air Vent Top			Fl. Elev. + 1.87			29.4
B.M.			4.67	36.81		32.14
Floor Elev. New Well #1000					3.44	33.37
Finished Ground					3.6	33.2
Old Original Ground					4.2	32.6
Air Vent Top			Fl. Elev. + 1.97			35.3
B.M.			6.44	34.21		27.77
Floor Elev. New Well #201					3.17	31.04
Finished Ground					3.5	30.7
Old Original Ground					4.0	30.2
Air Vent Top			Fl. Elev. + 1.67			32.7

Square cut in top of curb around Sentry Booth  
at Main Entrance to Geiger

Approximate  
At Gauge Location

Relocated in 1957

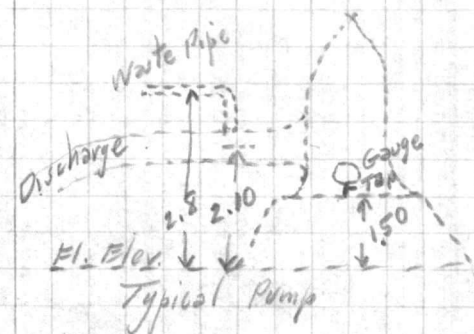

Approximate

Intersection of Hawkins Blvd. + Aderholm St.

Approximate

Man. U.S.M.C. #60

Approximate


































