

VALUABLE

RETURN TO
PUBLIC WORKS
OFFICE
CAMP LEJEUNE
NORTH CAROLINA

SUBJECT

Topography for Proposed

Gas Station Site

Camp Geiger

FIELD PARTY

Morris IN CHARGE
Dillon INSTRUMENT
NOTES
TAPE READ
TAPE OR ROD
TAPE OR ROD
INSTRUMENT NO.
TAPE NO.

WEATHER

CLEAR
CLOUDY
WINDY
RAIN
FAIR

SNOW
HOT
MODERATE
COLD
FOG

FILE No. *98-U*

FLDR. No. _____

SHEET *#1 of 2*

DATE *12/17/1962*

FIGURED BY _____

NOTES CHECKED BY _____


PLOTTED BY _____

Quad. No. _____

STATION	DIST.	ANGLE " "	+	H. I. BEARING	VER. ANG. DIFF.	ELEVATION
B.M.				0.91 26.58		25.67
				0.87 26.54		
				26.56		
				4.80 26.59		21.79
				26.57		
Instr. Point (A)				Sight on Cor. Bldg. (X) #900		
#1	47'	146° 35'				
#2	52'	138° 56'				
Invert					13.85	12.7
M.H.	31'	224° 53'			5.8	20.8
	31'				5.0	21.6
Bldg. 900	41'	00° 00'			4.8	21.8
	15'	46° 40'			4.8	21.8
	40'	161° 30'			5.3	21.3
	51'	137° 46'			5.1	21.5
	64'	136° 55'			5.2	21.4
	102'	138° 13'			5.2	21.4
	101'	132° 07'			5.3	21.3
	123'	137° 56'			5.0	21.6
1 st Pole	62'	160° 54'				
	61'	196° 35'				
	55'	286° 45'				
	55'	281° 20'				
	52'	269° 05'				
	55'	251° 20'				
	64'	235° 03'				

Well House

Underbuilt Power & U.G. Cable to Well.

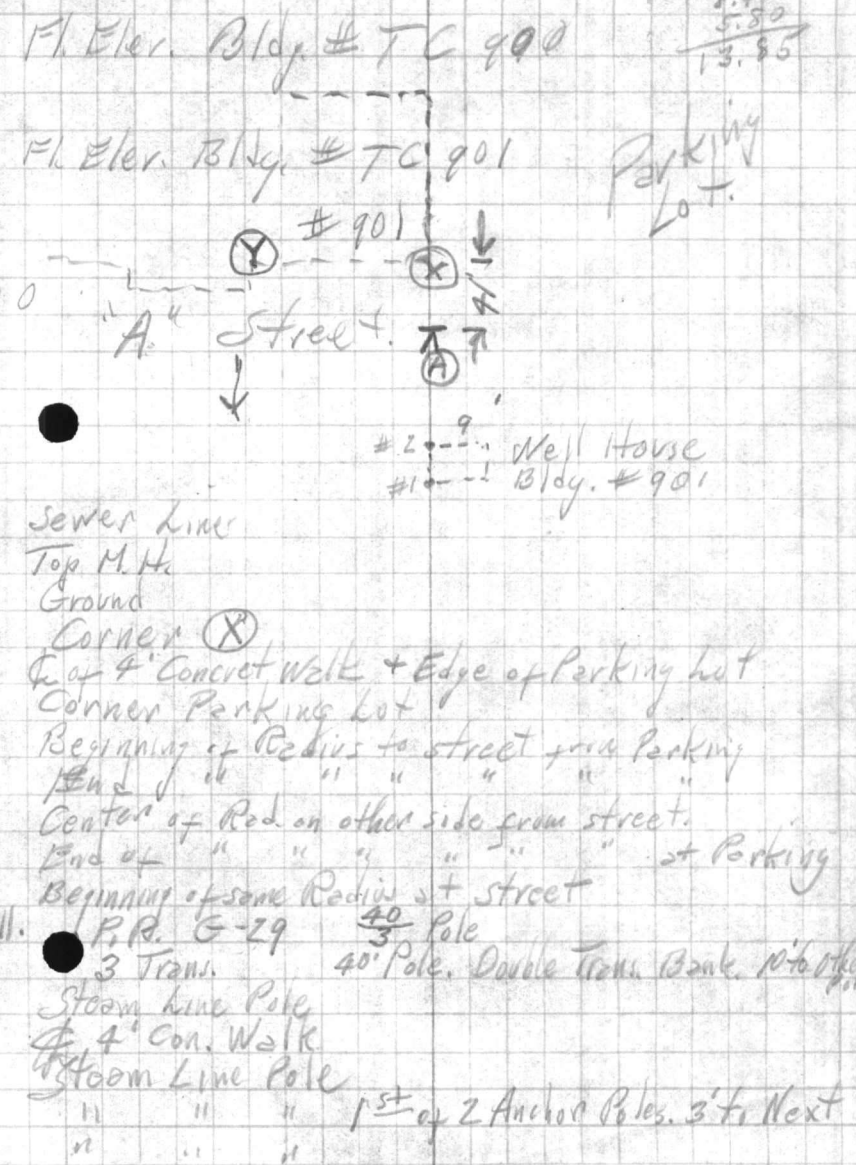

5.05
5.80
13.85

Parking Lot

#2 Well House
#1 Bldg. #901








VALUABLE

SUBJECT _____

 RETURN TO
 PUBLIC WORKS
 OFFICE
 CAMP LEJEUNE
 NORTH CAROLINA

FIELD PARTY

 IN CHARGE

 INSTRUMENT

 NOTES

 TAPE READ

 TAPE OR ROD

 INSTRUMENT NO. _____
 TAPE NO. _____

WEATHER

CLEAR
 CLOUDY
 WINDY
 RAIN
 FAIR
 SNOW
 HOT
 MODERATE
 COLD
 FOG
 FIGURED BY _____
 NOTES CHECKED BY _____
 PLOTTED BY _____

FILE No. _____
 FLDR. No. _____
 SHEET #2 of 2
 DATE 12/17/1962

Quad. No. _____

STATION	DIST.	ANGLE ° ' "	+	H. I. BEARING	VER. ANG. DIFF.	ELEVATION
(Y) 40'	263°15'			26.6		
25'	208°55'					
82'	300°00'			See sheet #1		
150'	116°45'				5.4	21.2
181'	109°10'				5.8	20.8
132'	95°50'				4.8	21.8
142'	64°38'				4.7	21.9
163'	50°42'				4.8	21.8
177'	33°42'				5.1	21.5
157'	20°40'				4.9	21.7
165'	16°15'					
160'	9°50'					
148'	8°20'					
145'	2°15'					
147'	70°48'				4.2	22.4
135'	85°30'				3.7	22.9
162'	82°20'				4.1	22.5
174'	73°45'				4.1	22.5
156'	69°25'				5.1	21.5
162'	67°35'				5.1	21.5
152'	65°25'				4.1	22.5
158'	73°55'				4.7	21.9
133'	90°28'				4.8	21.8
136'	90°28'				3.7	22.9
140'	99°20'				4.8	21.8
155'	99°55'				4.1	22.5
176'	99°20'				4.7	21.9
180'	93°15'				4.1	22.5
188'	93°35'				4.2	22.4

Crab Apple Shrub 8' Dia
 Cedar Shrub 8' Dia
 Bldg. line at beginning of Center Bldg.
 COR. OF PARK LOT
 P. POLE G 22 (40')
 EDGE PARKING LOT
 EDGE OF PARKING LOT
 " " " "
 " " " "
 RADIUS POINT FOR DRIVE
 " " " "
 " " " "
 " " " "
 COR. PARKING LOT
 18" PINE TREE
 18" " "
 G.S.
 24" PINE TREE
 15" " "
 12" " "
 12" " "
 G.S.
 G.S.
 G.S.
 G.S.
 18" PINE TREE
 18" " "
 15" " "
 G.S.




































































VALUABLE

SUBJECT

Garbage House

Mess Hall # 920

RETURN TO
PUBLIC WORKS
OFFICE
CAMP LEJEUNE
NORTH CAROLINA

FIELD PARTY

____ IN CHARGE
 ____ INSTRUMENT
 ____ NOTES
 ____ TAPE READ
 ____ TAPE OR ROD
 ____ TAPE OR ROD
 ____ INSTRUMENT No.
 ____ TAPE No.

WEATHER

____ CLEAR
 ____ CLOUDY
 ____ WINDY
 ____ RAIN
 ____ FAIR
 ____ SNOW
 ____ HOT
 ____ MODERATE
 ____ COLD
 ____ FOG

FILE No. 98-U

FLDR. No. _____

SHEET # 10 of 2

DATE 19 57


FIGURED BY _____

NOTES CHECKED BY _____

PLOTTED BY _____

Quad. No. _____

STATION	DIST.	ANGLE ' "	+	H. I. BEARING	VER: ANG. DIFF.	ELEVATION
				0.97	22.90	21.93
COR. A	FLOOR				4.94	17.96
" B	"				4.94	
" C	"				4.94	
" D	"				5.02	17.88
E	BOTTOM SUMP			5.68		17.22
F	TOP 4" DRAIN			5.68		
A	CONCRETE FOOTER					27" HIGH
B	"			"		2' "
C	"			"		3' "
D	"			"		4' 46' "
B.M.				0.97		

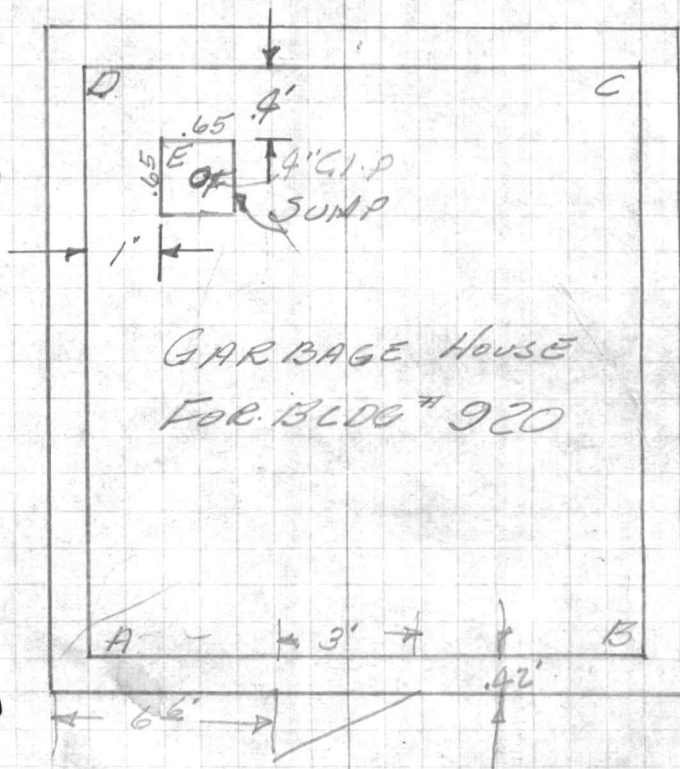









































VALUABLE

RETURN TO
PUBLIC WORKS
OFFICE
CAMP LEJEUNE
NORTH CAROLINA

SUBJECT Existing Garbage
disposal Bldg
At Camp Geiger

FIELD PARTY

IN CHARGE _____
INSTRUMENT _____
NOTES _____
TAPE READ _____
TAPE OR ROD _____
TAPE OR ROD _____
INSTRUMENT No. _____
TAPE No. _____

WEATHER

CLEAR _____ SNOW _____
CLOUDY _____ HOT _____
WINDY _____ MODERATE _____
RAIN _____ COLD _____
FAIR _____ FOG _____
FIGURED BY _____
NOTES CHECKED BY _____
PLOTTED BY _____


FILE No. _____
F&DR. No. _____
SHEET 2 of 2
DATE 3-15-56

Quad. No. _____

STATION	DIST.	ANGLE ° ' "	+	H. I. BEARING	VER. ANG. DIFF.	ELEVATION
---------	-------	----------------	---	------------------	--------------------	-----------

MESS HALL
Bldg. #920

1- CONCRETE FLOOR
FROM CURB 4.15' UP WOOD SIDE
FROM WOOD SIDE 2.08' UP SCREEN
FROM SCREEN 0.30' UP TO ROOF IN REAR
FROM SCREEN 1.75' UP TO ROOF IN FRONT
ASPHALT PAPER ROOF
SHOULD GO TOWARD
RD. FROM BLDG.

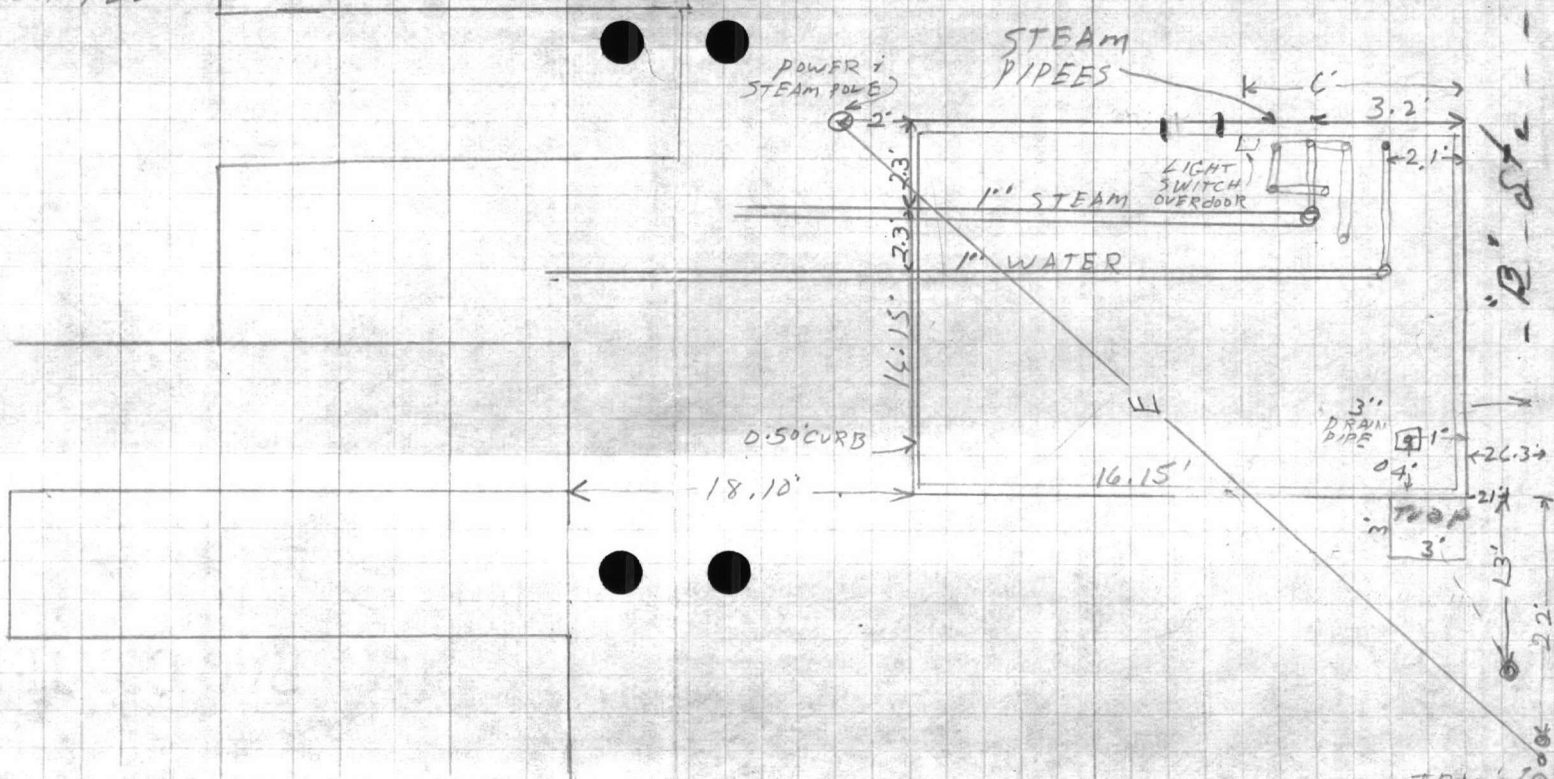

TRAN'S













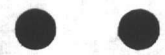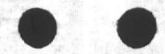

439.96

13

VALUABLE

SUBJECT _____

Return To
Public Works
Office
Camp Lejeune
North Carolina

FIELD PARTY

Martin In Charge

Instrument _____

Notes _____

Batson Tape ReadPHILIPS Tape or Rod _____

Tape or Rod _____

Instrument No. _____

Tape No. _____

WEATHER

Clear
Cloudy
Windy
Rain
Fair

Snow
Hot
Moderate
Cold
Fog

FILE No. 98-U

Fldr. No. _____

Sheet 10E2Date 9/12 1951

Figured By _____


Notes Checked By _____

Plotted By _____

Quad. No. _____

Station	Dist.	Angle	"	+	H. I. Bearing	Ver: Ang. Diff.	Elevation
---------	-------	-------	---	---	------------------	--------------------	-----------

40' | 60.05 | 40.03 | 59.91 | 40.04 | 60.01 | 40.02 | 60.03 | 40'

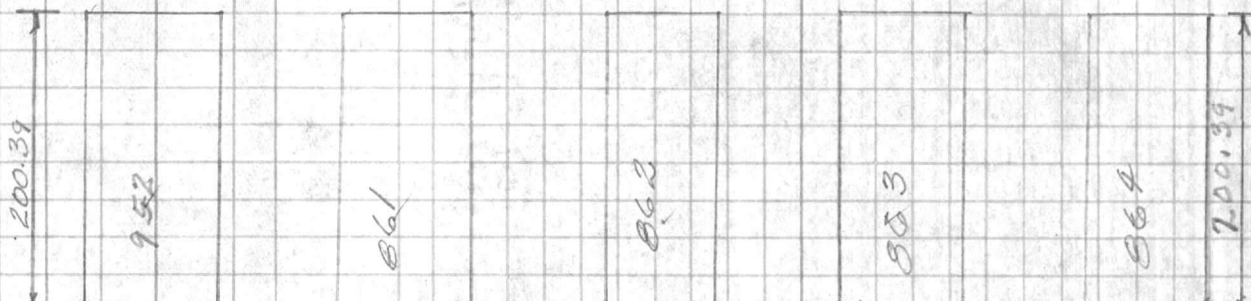

Cor Bldg 864
(380.82) (380.83)

3380600 D

2941745 @

3380555 M

Cor Bldg 952
85.49

3084100 N.

2660300


2084100

NOT P.I. B

B.S. P.I. 7

P.I. # 8

typical

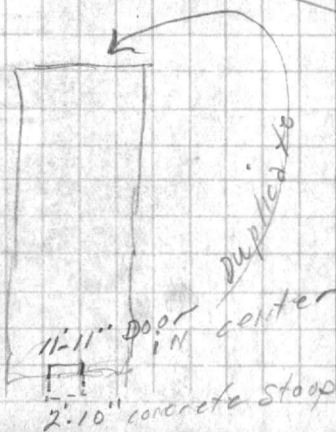

P.I. # 7

VALUABLE

SUBJECT _____

 Return To
 Public Works
 Office
 Camp Lejeune
 North Carolina

FIELD PARTY

WATSON In Charge
 _____ Instrument
 _____ Notes
RODSON Tape Read
PHILIPS Tape or Rod
 _____ Tape or Rod
 _____ Instrument No.
 _____ Tape No.

WEATHER

Clear
 Cloudy
 Windy
 Rain
 Fair

Snow
 Hot
 Moderate
 Cold
 Fog

FILE No. _____


Fldr. No. _____

Figured By _____ Sheet 80F 2

Notes Checked By _____

Plotted By _____ Date 9/12 1951

Quad. No. _____

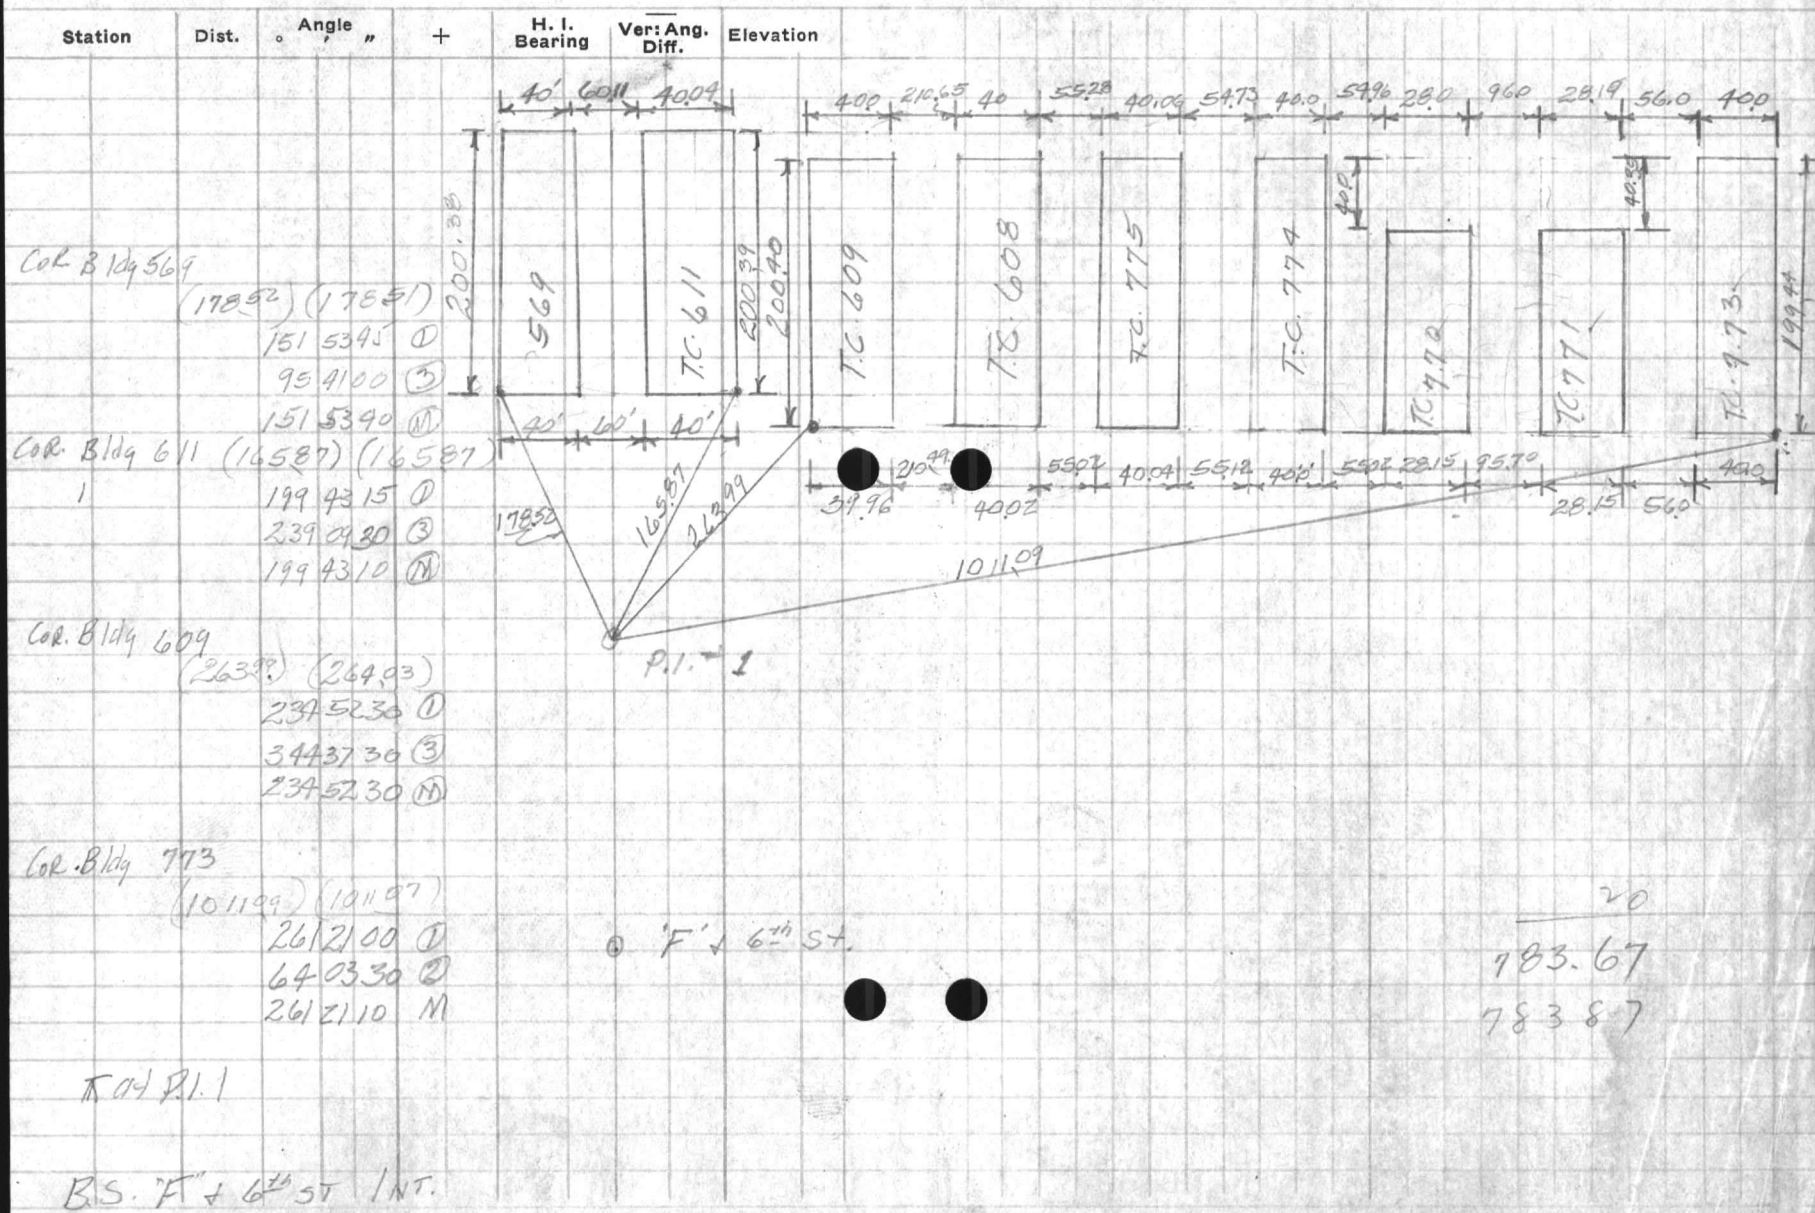

VALUABLE

Subject

Return to
Public Works
Office
Camp Lejeune
North Carolina





















VALUABLE

SUBJECT WAREHOUSE LOCATION AT
TENT CAMP #1

Butler Buildings


Return To
Public Works
Office
Camp Lejeune
North Carolina

FIELD PARTY
KELUM In Charge
____ Instrument
____ Notes
____ Tape Read
____ Tape or Rod
____ Tape or Rod
____ Instrument No.
____ Tape No.

WEATHER
Clear _____
Cloudy _____
Windy _____
Rain _____
Fair _____
Snow _____
Hot _____
Moderate _____
Cold _____
Fog _____
Figured By _____
Notes Checked By _____
Plotted By _____

FILE No. 98-0
Fldr. No. _____
Sheet 1-01-3
Date 9-17 1946

Quad. No. 98

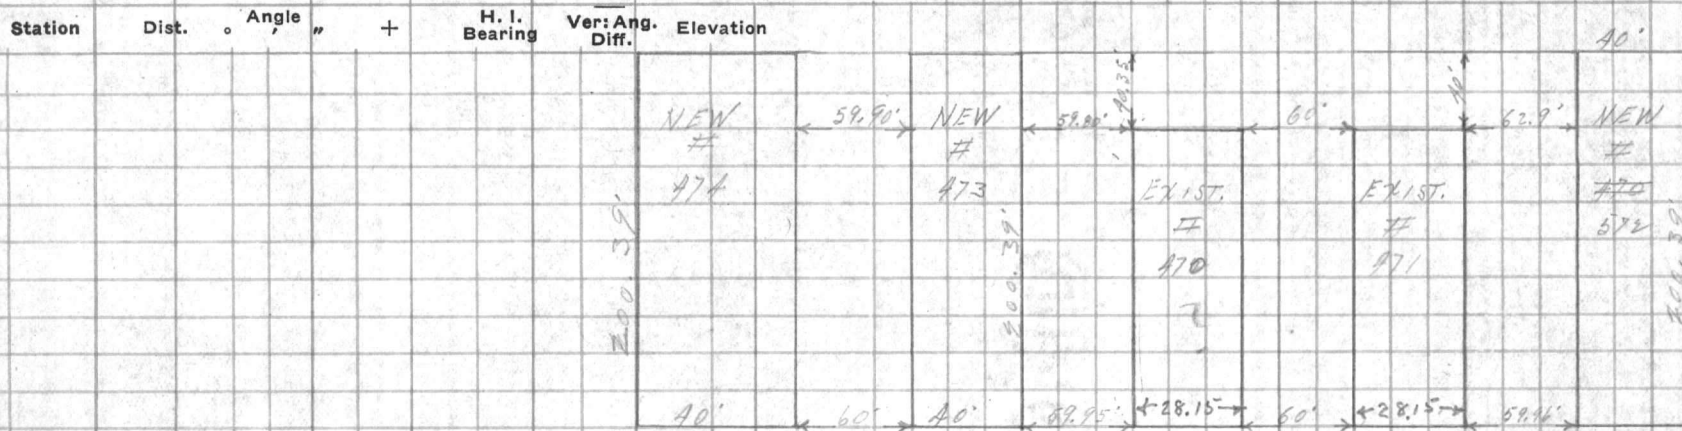

411.16
40
451.16









VALUABLE


SUBJECT WAREHOUSE LOCATION AT
JUNT CAMP #1

Return To
Public Works
Office
Camp Lejeune
North Carolina

FIELD PARTY
KELLMAN In Charge
Instrument _____
Notes _____
Tape Read _____
Tape or Rod _____
Tape or Rod _____
Instrument No. _____
Tape No. _____

WEATHER
Clear _____
Cloudy _____
Windy _____
Rain _____
Fair _____
Snow _____
Hot _____
Moderate _____
Cold _____
Fog _____
Figured By _____
Notes Checked By _____
Plotted By _____

FILE No. 98-U
Fldr. No. _____
Sheet 2-013
Date 9-17 1946
Quad. No. 98

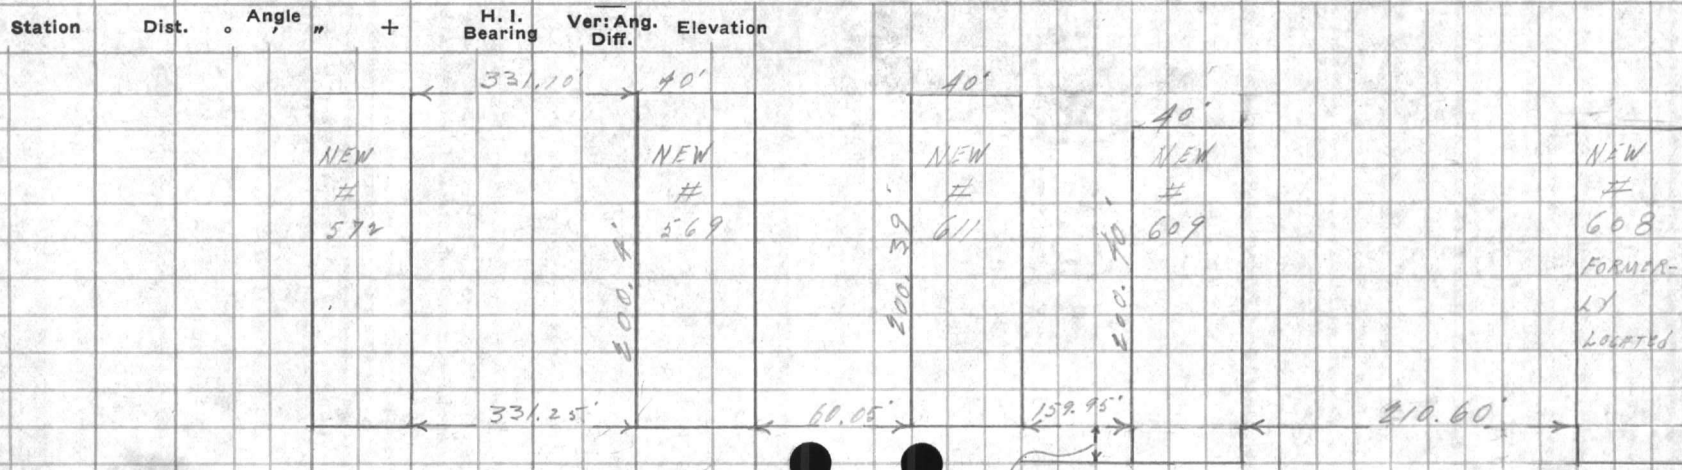

NOTE: WAREHOUSES # 474, 475,
476, 477, 472, 509, 4611
ARE IN LINE.
WAREHOUSES # 609, 608,
775, 774, 770, 771 + 773
ARE IN LINE.

WALL AME

SUBJECT

Return to
Public Works
Office
Camp Lejeune
New Carolina

Section

Beating

DIR. Division

WIND DATA

Direction

Force

Time

Remarks

Time of Day

Time of Day

Time of Day

Time of Day

WEATHER

Clear

Cloudy

Hot

Moderate

Cold

Fair

Fog

Thunder

FILE NO.

FILE NO.

Sheet

Sheet

Sheet No.

ORIGINAL

VALUABLE

SUBJECT WARE HOUSE LOCATION
AT TENT CAMP #1 FLOOR
ELEVATIONS
Butler Buildings

Return To
 Public Works
 Office
 Camp Lejeune
 North Carolina


FIELD PARTY
KELLY In Charge
 Instrument _____
 Notes _____
 Tape Read _____
 Tape or Rod _____
 Instrument No. _____
 Tape No. _____

WEATHER
 Clear _____
 Cloudy _____
 Windy _____
 Rain _____
 Fair _____
 Snow _____
 Hot _____
 Moderate _____
 Cold _____
 Fog _____
 Figured By _____
 Notes Checked By _____
 Plotted By _____
 Quad. No. 98

FILE No. 98-U
 Fldr. No. _____
 Sheet 3-01-3
 Date 9-17 1946
 Date _____ 19____

Station	Dist.	Angle " +	H. I. Bearing	Ver: Ang. Diff.	Elevation	
B.M.		0.05	19.92		19.87	TOP OF MOST NORTHERN BOLT IN WEST NORTHERN PIER OF WATER BANK TENT CAMP #1
WHSE # 509				1.95	17.97	
WHSE # 611				3.58	16.34	
WHSE # 569				3.18	16.74	
T.P.		3.69	20.16	3.45	16.47	
WHSE # 572				5.42	14.74	
WHSE # 473				3.05	17.11	
WHSE # 474				3.57	16.59	
T.P.		5.29	21.70	3.75	16.41	
B.M.				3.16	18.54	(18.57) NAIL IN POWER POLE AT 9TH AND "D" ST.

Handwritten note:
 This is posted
 in yellow

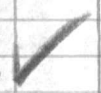

W. H. HARRIS

Station To
Public Works
Office
Camp Lejeune
North Carolina

SUBJECT

Station

Angle

H. I.
Boat

Vert. Ang. Elevation
D.V.

FIELD PARTY

W. H. Harris







WEATHER

Clear

Partly Cloudy

Light Rain

Heavy Rain

Thunder

Light Snow

Heavy Snow

Field No.

Station

Angle

Vertical

Elevation

D.V.

Remarks

Remarks

130
148.74
65.48

344.22


VALDARRE

SUBJECT

Return To
Field Work
Office
Camp 1 1/2 miles
North of ...

Station

Angle

H. I.
Reading

Year and
D.M. Elevation

FIELD PARTY

In Charge

Assistant

Notes

Tape Read

Type of Rod

Type of Rod

Instrument

Topo No.

WEATHER

Clear

Cloudy

Fog

Thunder

Wind

Temp

Bar

FILE No.

Plot No.

Sheet

Notes Checked By

Checked By

Grid No.

[Handwritten scribbles]

VALUABLE

SUBJECT _____

Return To
Public Works
Office
Camp Lejeune
North Carolina

BORINGS

FIELD PARTY

_____ In Charge
_____ Instrument
_____ Notes
_____ Tape Read
_____ Tape or Rod
_____ Tape or Rod
_____ Instrument No.
_____ Tape No.

WEATHER

Clear _____
Cloudy _____
Windy _____
Rain
Fair _____
Snow _____
Hot _____
Moderate _____
Cold _____
Fog _____

FILE No. _____

Fldr. No. _____

Figured By _____ Sheet Sheet 2

Notes Checked By _____

Plotted By _____ Date Mar 3 1952

Quad. No. _____

Station	Dist.	° Angle "	+	H. I. Bearing	Ver: Ang. Diff.	Elevation
---------	-------	-----------	---	---------------	-----------------	-----------

BORING # 4

0.0

Top natural ground

-0.5

Topsoil

-2.5

yellow sand - 10% clay

Water Table =

-3.0

-4.0

Grey sand - 15% to 20% clay

-6.0

light grey sand - 15% to 20% clay

BORING # 1

0.0

Top natural ground

-1.5

Topsoil & humus

Water Table =

-3.0

-3.5

Grey sand - 10% clay

-5.0

Grey sand - 5% clay

-6.0

WATER

North Carolina
Camp Lejeune
Office
Public Works
Returns To

SUBJECT

Station

Dist

Angle

M

Station

M. I.

Vertical

Elevation

FIELD PARTY

In Charge

Instrument

Notes

Tape Road

Type of Rod

Type of Pole

Instrument No.

Tape No.

WEATHER

Clear

Cloudy

Windy

Fog

Light

Dark

Thunder

Lightning

MILE

Point

Station

Checked By

Plotted By

Sheet No.

RECEIVED
MAY 19 1954
U.S. ARMY
CAMP LEJUNE

VALUABLE

SUBJECT _____

Return To
 Public Works
 Office
 Camp Lejeune
 North Carolina

FIELD PARTY

_____ In Charge
 _____ Instrument
 _____ Notes
 _____ Tape Read
 _____ Tape or Rod
 _____ Instrument No.
 _____ Tape No.

WEATHER

Clear _____
 Cloudy _____
 Windy _____
 Rain _____
 Fair _____
 Snow _____
 Hot _____
 Moderate _____
 Cold _____
 Fog _____
 Figured By _____
 Notes Checked By _____
 Plotted By _____

FILE No. _____
 Fldr. No. _____
 Sheet _____
 Date _____ 19__

Quad. No. _____

Station	Dist.	Angle " +	H. I. Bearing	Ver: Ang. Diff.	Elevation	
<i>BORING # 3</i>						
				0.0		<i>Top natural ground</i>
				-1.0		<i>Topsoil & humus</i>
				-3.0		<i>Yellow sand - less than 5% clay</i>
				<i>Water Table =</i> -3.5		
				-6.0		<i>Brown sand - less than 5% clay</i>
<i>BORING # 2</i>						
				0.0		<i>Top natural ground</i>
				-1.0		<i>Black topsoil & humus</i>
				-3.0		<i>Black sand - 10% clay & humus</i>
				-3.5		<i>Black sand (course) - less than 5% clay</i>
				-6.0		<i>" " " " " "</i>

VALUABLE

SUBJECT

Return To
Public Works
Office
Camp Lejeune
North Carolina

Station

Dist.

Angle

Backsight

Vertical
Dist. Elevation

FIELD PARTY

In Charge

Instrument

Notes

Tap or Rod

Tap or Rod

Tap or Rod

Instrument No.

Tap No.

WEATHER

Snow

Fog

Moderate

Wind

Clear

Barometer

Notes Checked

Checked By

Sheet No.

Sheet

Date

FILE NO.

FILE NO.

ADDRESS

Return To
Public Works
Office
Camp Johnson
North Carolina

SUBJECT

Station

Date




FIELD PARTY

In Charge
Instrument
Notes
Tape Read
Tape on Pad
Tape of Pad
Instrument No.
Tape No.

WEATHER

Clear
Snow
Wet
Windy
Fog
Rain
Ice

FILE NO.

Plotted By

Checked By

Date

Field No.

VALUABLE

SUBJECT LOCATION OF 8" WATER
LINE INTER. 8TH & "F" ST.
NORTH.

RETURN TO
 PUBLIC WORKS
 OFFICE
 CAMP LEJEUNE
 NORTH CAROLINA

FIELD PARTY

DENNIS IN CHARGE
 _____ INSTRUMENT
 _____ NOTES
 _____ TAPE READ
 _____ TAPE OR ROD
 _____ TAPE OR ROD
 _____ INSTRUMENT NO.
 _____ TAPE NO.


WEATHER

CLEAR _____ SNOW _____
 CLOUDY _____ HOT _____
 WINDY _____ MODERATE _____
 RAIN _____ COLD _____
 FAIR _____ FOG _____

FILE No. 98-0
 FLDR. No. _____
 SHEET 3 of 3
 DATE 10-11 1954

Quad. No. _____

STATION	DIST.	ANGLE			H. I. BEARING	VER. ANG. DIFF.	ELEVATION
		°	'	"			

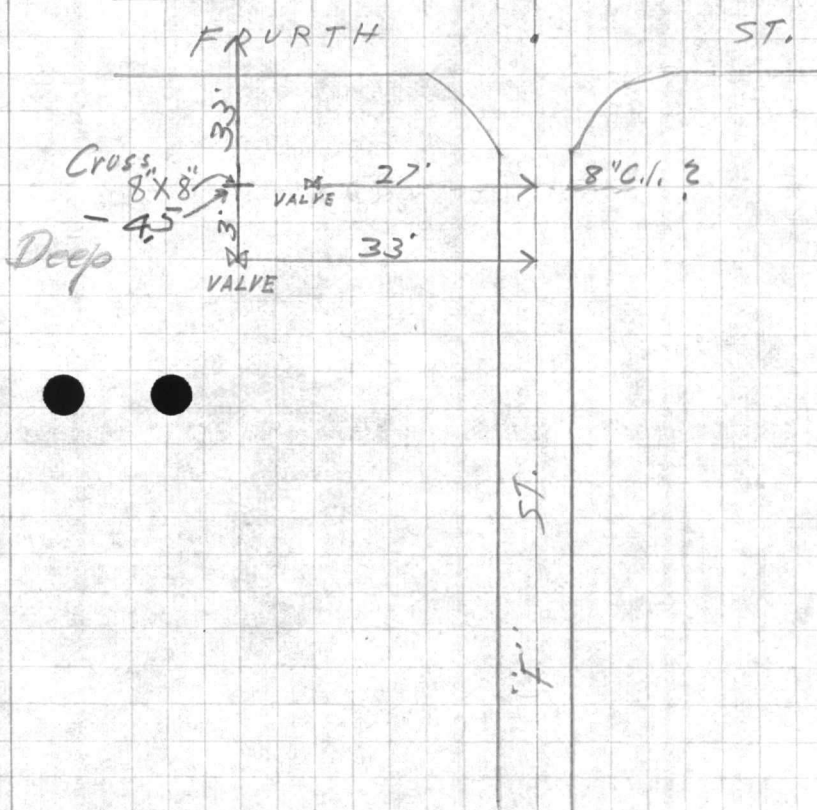

VALUABLE

SUBJECT

Test Borings

Fire Station Site
Camp Geiger

RETURN TO
PUBLIC WORKS
OFFICE
CAMP LEJEUNE
NORTH CAROLINA

FIELD PARTY

Pedgett

IN CHARGE

INSTRUMENT

NOTES

TAPE READ

TAPE OR ROD

TAPE OR ROD

INSTRUMENT NO.

TAPE NO.

WEATHER

CLEAR
CLOUDY
WINDY
RAIN
FAIR

SNOW
HOT
MODERATE
COLD
FOG

FIGURED BY

NOTES CHECKED BY

PLOTTED BY

FILE No. *98U*


Fldr. No.


SHEET *#1 of 2*

DATE *3/10/1954*

Quad. No.

STATION	DIST.	ANGLE			H. I. BEARING	VER. ANG. DIFF.	ELEVATION
		°	'	"			

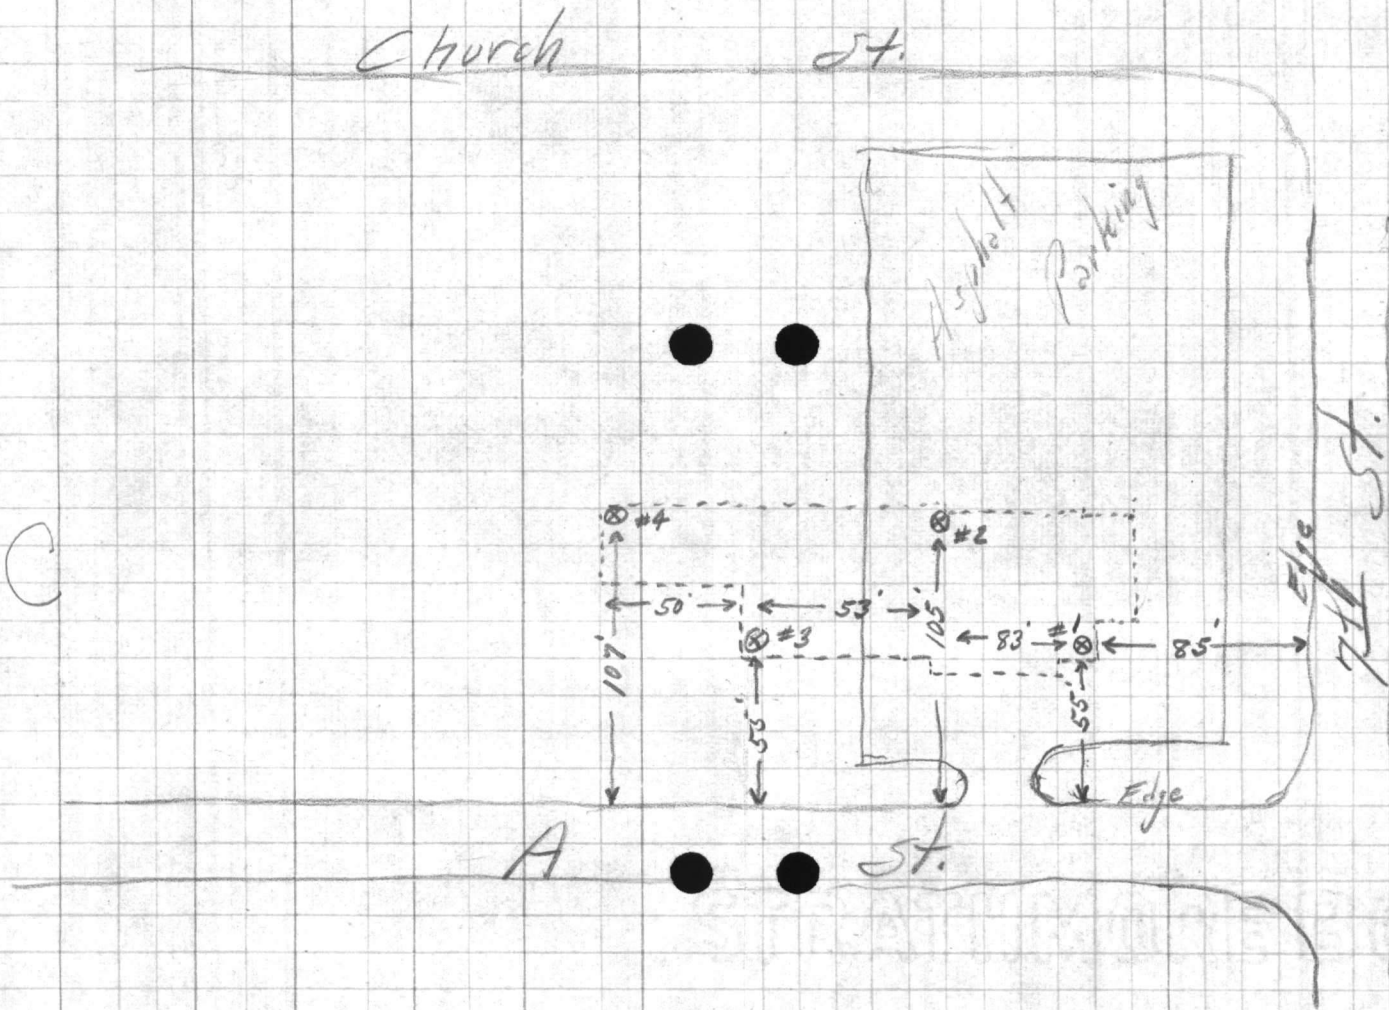

 

VALUABLE

SUBJECT test Boring Between
church st. + "A" st.

RETURN TO
PUBLIC WORKS
OFFICE
CAMP LEJEUNE
NORTH CAROLINA

FIELD PARTY

____ IN CHARGE
____ INSTRUMENT
____ NOTES
____ TAPE READ
____ TAPE OR ROD
____ TAPE OR ROD
____ INSTRUMENT No.
____ TAPE No.

WEATHER

CLEAR
CLOUDY
WINDY
RAIN
FAIR

SNOW
HOT
MODERATE
COLD
FOG

FILE No. _____

FLDR. No. _____

SHEET # 2 of 2

DATE 3/10/19 54

FIGURED BY _____
NOTES CHECKED BY _____
PLOTTED BY _____
Quad. No. _____

STATION	DIST.	ANGLE " "	+	H. I. BEARING	VER. ANG. DIFF.	ELEVATION
BM. ON PINE	INT			7 st + church		21.57
				2.70 24.27		
BORING # 1.				4.2		20.1
" " 2				4.5		19.8
" " 3				4.8		19.5
" " 4				5.4		18.7
BM.				2.70		21.57 (21.57)

DEPTH	SOIL TYPE	PERCENTAGE	DEPTH	SOIL TYPE	PERCENTAGE
0.2	ASPHALT + ROCK		0.3	ASPHALT + ROCK	
-0.8	TOP SOIL			TOP SOIL	
-6.0	DARK SAND	100%	-2.0	SAND	80%
				CLAY	20%
-10'	YELLOW SAND	100%	-6.0	YELLOW SAND	100%
			-8.3	JUMBO	
			-10'	DARK SAND	100%

No definite
Water Table. Earth
damp at Bottom of Hole

DEPTH	SOIL TYPE	PERCENTAGE	DEPTH	SOIL TYPE	PERCENTAGE
-0.8	TOP SOIL		-2.0	TOP SOIL	
-2.0	YELLOW SAND	100%	-7.0	DARK SAND	100%
-3.9	SAND	90%		COARSE SAND	
	CLAY	10%	-10'	+ GRAVEL	
-6.0	SAND	100%			
-7.0	MUD SAND	60%			
		40%			
-10'	DARK SAND	100%			
	SAND				







VALUABLE

RETURN TO
 PUBLIC WORKS
 OFFICE
 CAMP LEJEUNE
 NORTH CAROLINA

SUBJECT

Over
 ELEV. & LOCATIONS
 SEWER M.H. & 10"X10"
 TEE


FIELD PARTY
 DENNIS IN CHARGE
 _____ INSTRUMENT
 _____ NOTES
 _____ TAPE READ
 _____ TAPE OR ROD
 _____ TAPE OR ROD
 _____ INSTRUMENT NO.
 _____ TAPE NO.

WEATHER
 CLEAR _____
 CLOUDY _____
 WINDY _____
 RAIN _____
 FAIR _____
 SNOW _____
 HOT _____
 MODERATE _____
 COLD _____
 FOG _____
 FIGURED BY _____
 NOTES CHECKED BY _____
 PLOTTED BY _____

FILE No. 98U
 FLDR. No. _____
 SHEET 1 of 1
 DATE 10-21-55

Quad. No. _____

STATION	DIST.	ANGLE " "	+	H. I. BEARING	VER. ANG. DIFF.	ELEVATION
B.M.				331 24 85		21 54
'A'					8 73	16.12
'B'					8 76	16.09
'C'					8 45	16.40
'D'	TOP, M.H.				5 05	19.80

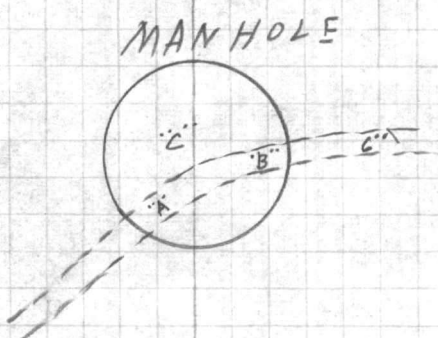

10 05 14.80

TOP 10 X 10" TEE SOUTH WEST
 COR. 'A' & 7TH ST.

8 54 16.31

TOP 8" C.I. WATER PIPE
 SOUTH WEST COR. 'A' & 7TH ST.

