

VALUABLE

SUBJECT Proposed water line
Location, Tarawa Terrace
Relocation of Well site #9

RETURN TO
PUBLIC WORKS
OFFICE
CAMP LEJEUNE
NORTH CAROLINA

FIELD PARTY		WEATHER		FILE No. _____
<u>Dillon</u>	IN CHARGE	CLEAR	SNOW	FLDR. No. _____
<u>Kellum</u>	INSTRUMENT	CLOUDY	HOT	SHEET <u>#1 of 2</u>
	NOTES	WINDY	MODERATE	DATE <u>8-30 1961</u>
<u>Dennis</u>	TAPE READ	RAIN	COLD	
	TAPE OR ROD	FAIR	FOG	
	TAPE OR ROD <u>MON. #</u>			
	INSTRUMENT No. _____			
	TAPE No. <u>129.35</u>			
				FIGURED BY _____
				NOTES CHECKED BY _____
				PLOTTED BY _____
				Quad. No. _____


STATION	DIST.	ANGLE ° ' "	+	H. I. BEARING	VER: ANG. DIFF.	ELEVATION
---------	-------	----------------	---	------------------	--------------------	-----------

MON. #55
 1- 311° 09' 15"
 3- 213° 27' 30"
 MEAN 311° 09' 10"

P.I. 5+33.40
 1- 221° 21' 00"
 3- 304° 02' 15"
 MEAN 221° 20' 45"

P.I. 8+71.45
 1- 129° 35' 15"
 3- 28° 45' 30"
 MEAN 129° 35' 10"

871.45
 533.40
 1404.85

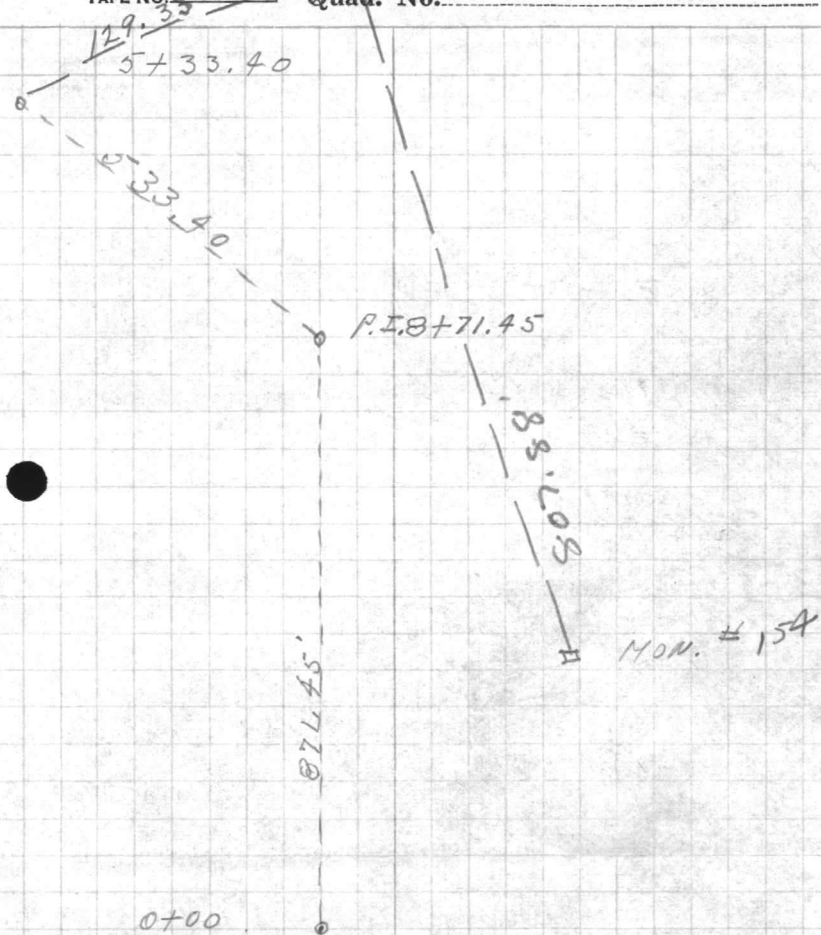

221-21-00

304-02-15

300

135

3) 664 62

221-20-45

311-09-15

213-27-30

720

3) 933

311-09-10

VALUABLE

SUBJECT _____

RETURN TO
PUBLIC WORKS
OFFICE
CAMP LEJEUNE
NORTH CAROLINA

FIELD PARTY

IN CHARGE

INSTRUMENT

NOTES

TAPE READ

TAPE OR ROD

TAPE OR ROD

INSTRUMENT NO.

TAPE NO.


WEATHER

CLEAR _____ SNOW _____
CLOUDY _____ HOT _____
WINDY _____ MODERATE _____
RAIN _____ COLD _____
FAIR _____ FOG _____
FIGURED BY _____
NOTES CHECKED BY _____
PLOTTED BY _____

FILE No. _____
FLDR. No. _____
SHEET # 2 of 2
DATE 8/30/1961

Quad. No. _____

STATION	DIST.	ANGLE			H. I. BEARING	VER. ANG. DIFF.	ELEVATION
		°	'	"			

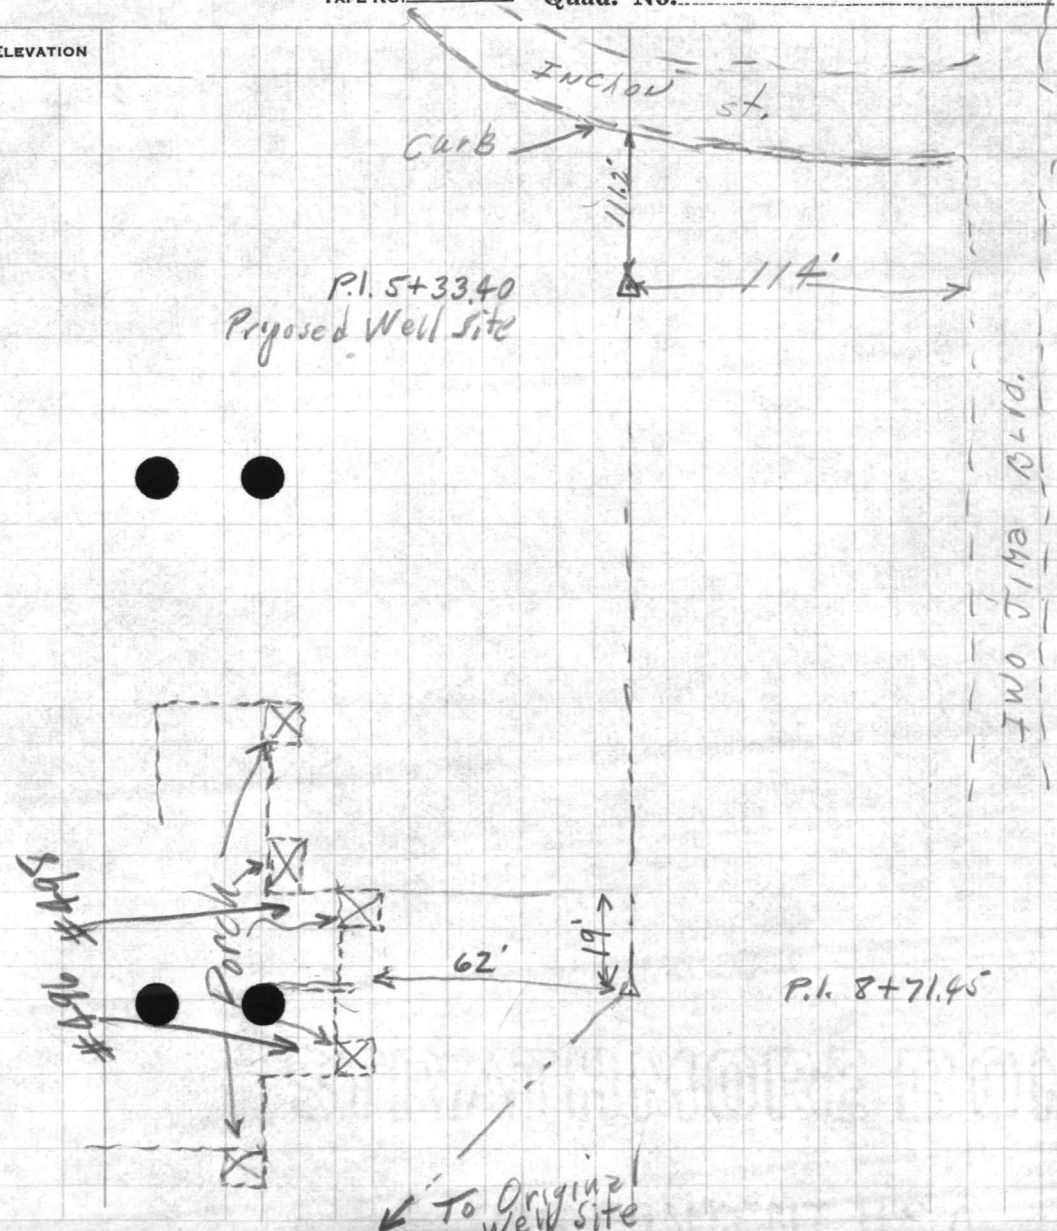

VALUABLE

SUBJECT Profile on Proposed
Water Line Tarawa
Terrace

RETURN TO
PUBLIC WORKS
OFFICE
CAMP LEJEUNE
NORTH CAROLINA

FIELD PARTY

IN CHARGE

INSTRUMENT

NOTES

TAPE READ

TAPE OR ROD

TAPE OR ROD

INSTRUMENT NO.

TAPE NO.

WEATHER

CLEAR
CLOUDY
WINDY
RAIN
FAIR
SNOW
HOT
MODERATE
COLD
FOG
FIGURED BY _____
NOTES CHECKED BY _____
PLOTTED BY _____

FILE No. _____
FLDR. No. _____
SHEET 10 of 2
DATE 8-30 1961

Quad. No. _____

STATION	DIST.	ANGLE ° ' "	+	H. I. BEARING	VER: ANG. DIFF.	ELEVATION	
B.M.				✓		25.97	s Pike IN transformer Pole
0+0			5.12	31.09	4.7	26.4	Ground on top of existing 10" water line
+11	9.5'	Left		GUM			
+28					4.9	26.2	4' Rt. 16" PINE
+41					5.3	25.8	
+50					4.8	26.3	7' Left. 12" PINE
+7					4.6	26.5	
+84							8' Rt. 14" PINE
T.P.				✓		27.13	TOP of New Well casing
			4.05	31.18	4.9	26.3	
+7							
+04							10' Rt. 10" oak
+20							4.5' Left. 16" PINE
+68					5.3	25.9	
+37					5.1	26.1	
+58							1.5' Rt. 15" PINE
+85							2' Rt. 18" PINE
+7					4.8	26.4	
+24							4.5' Rt. 15" PINE
+48					4.7	26.5	8' Rt. 5" PINE
+64							8.5' Rt. 18" PINE
+57					4.9	26.3	
+28							15' Rt. BRUSH LINE
+60					4.4	26.8	
+67					4.0	27.2	27' Rt. BRUSH LINE
+40					3.6	27.6	3' Left. 10" PINE
+53							4.5' Left. 12" PINE
+86					3.5	27.7	

































VALUABLE

SUBJECT

Profile continued

RETURN TO
PUBLIC WORKS
OFFICE
CAMP LEJEUNE
NORTH CAROLINA

FIELD PARTY

IN CHARGE

INSTRUMENT

NOTES

TAPE READ

TAPE OR ROD

TAPE OR ROD

INSTRUMENT NO.

TAPE NO.

WEATHER

CLEAR
CLOUDY
WINDY
RAIN
FAIR
SNOW
HOT
MODERATE
COLD
FOG
FIGURED BY _____
NOTES CHECKED BY _____
PLOTTED BY _____

FILE No. _____

FLDR. No. _____

SHEET

2 of 2

DATE

8-30-1961

Quad. No. _____

STATION	DIST.	ANGLE ° ' "	+	H. I. BEARING	VER. ANG. DIFF.	ELEVATION
7+				<i>31.18</i> <i>(31.2)</i>	<i>3.5</i>	<i>27.7</i> ✓
T.P.				✓	<i>3.33</i>	<i>27.85</i> ✓
7+10	<i>12.5' Lt.</i>	<i>18" PINE</i>		<i>2.44</i> <i>30.29</i> <i>(30.3)</i>		
+92						
+96	<i>24.5' Lt.</i>					
8+					<i>3.1</i>	<i>27.2</i> ✓
+13						
P.I. 8+	<i>71.45</i>				<i>4.6</i>	<i>25.7</i> ✓
						<i>BR=0100 Wood</i>
140	<i>9+71.45</i>				<i>5.4</i>	<i>24.9</i> ✓
+58	<i>10+29.45</i>				<i>5.9</i>	<i>24.4</i> ✓
2+	<i>10+71.45</i>				<i>5.6</i>	<i>24.7</i> ✓
+50	<i>11+21.45</i>				<i>6.2</i>	<i>24.1</i> ✓
3+	<i>11+71.45</i>				<i>6.0</i>	<i>24.3</i> ✓
T.P.				✓	<i>4.13</i>	<i>26.16</i> ✓
4+	<i>12+71.45</i>			<i>2.58</i> <i>28.74</i> <i>(28.7)</i>	<i>4.6</i>	<i>24.1</i> ✓
+83	<i>13+54.45</i>				<i>4.8</i>	<i>23.9</i> ✓
+89	<i>13+60.45</i>				<i>6.7</i>	<i>22.0</i> ✓
5+	<i>13+71.45</i>				<i>4.4</i>	<i>24.3</i> ✓
+16	<i>13+87.45</i>				<i>4.3</i>	<i>24.4</i> ✓
P.I. 5+	<i>33.40 = 14+04.85</i>				<i>4.4</i>	<i>24.3</i> ✓
R.M.					<i>6.27</i>	<i>22.47</i> ✓ <i>(22.49)</i>

7.5' Rt. 15" PINE
8.5' Rt. 20" PINE
APARTMENT NO. 496

8.5' Lt. 24" PINE

17' Rt. Woods LINE L TO LINE ahead
27' Rt. Woods LINE

WOODS LINE

BANK
2' Bottom Ditch
BANK
WOODS LINE

MON. #155
































VALUABLE

RETURN TO
PUBLIC WORKS
OFFICE
CAMP LEJEUNE
NORTH CAROLINA

SUBJECT WATER LINE SIZE
Verification NEAR TT-27
AND IWO JIMA BLVD. AT
Tarawa Terrace

FIELD PARTY

Kellum IN CHARGE
____ INSTRUMENT
____ NOTES
____ TAPE READ
____ TAPE OR ROD
____ TAPE OR ROD
____ INSTRUMENT No.
____ TAPE No.


WEATHER

CLEAR _____ SNOW _____
CLOUDY _____ HOT _____
WINDY _____ MODERATE _____
RAIN _____ COLD _____
FAIR _____ FOG _____
FIGURED BY _____
NOTES CHECKED BY _____
PLOTTED BY _____

FILE No. 99
FLDR. No. _____
SHEET # 1
DATE 3-10 1961

Quad. No. _____

STATION	DIST.	ANGLE ° ' "	+	H. I. BEARING	VER: ANG. DIFF.	ELEVATION
B.M. SPIKE IN TRANSFORMER POLE NEAR WELL TT-27						26.29
	4.49	30.78				
TOP OF 8" C.I. AT 'A'						8.0722.71
TOP OF 10" C.I. AT 'B'						7.7323.05

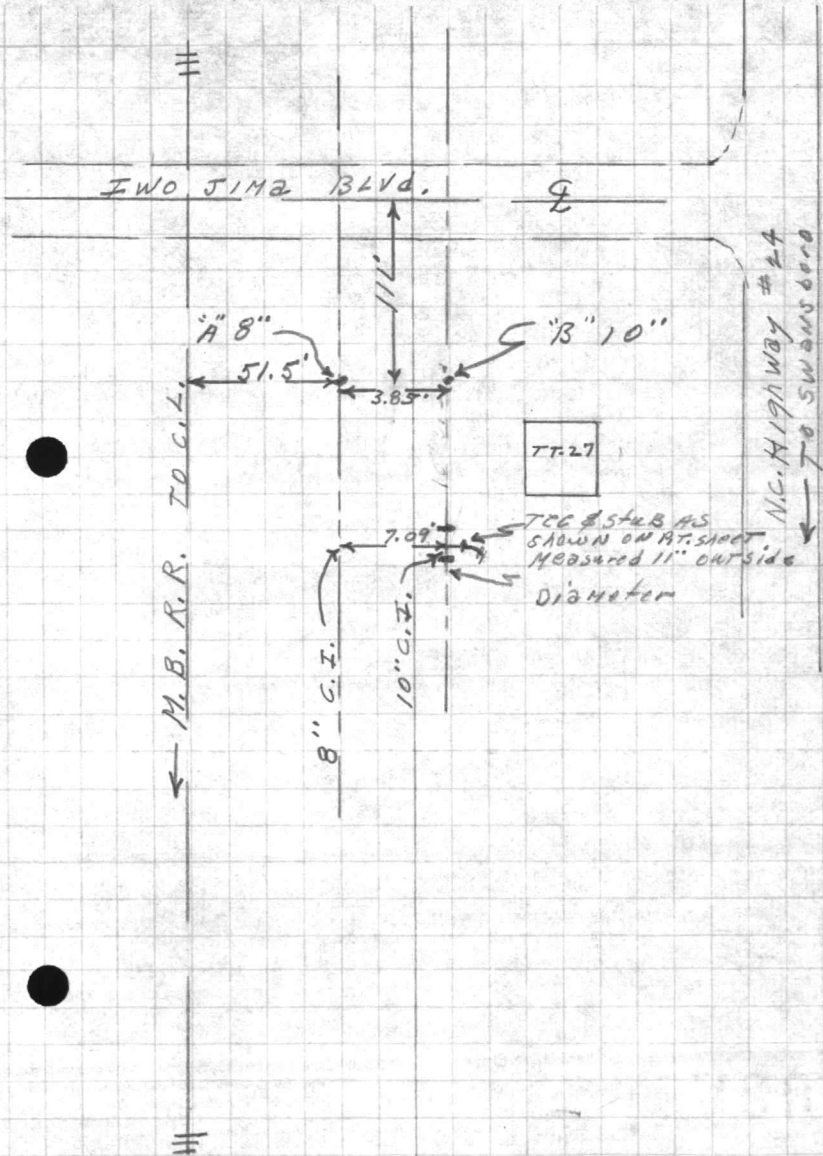





























VALUABLE


RETURN TO
PUBLIC WORKS
OFFICE
CAMP LEJEUNE
NORTH CAROLINA

SUBJECT Pipe location at
Water treatment plant at
Tarawa Terrace #1

FIELD PARTY
Kellum IN CHARGE
INSTRUMENT
NOTES
TAPE READ
Tape or Rod
Tape or Rod
Instrument No.
Tape No.

WEATHER
CLEAR SNOW
CLOUDY HOT
WINDY MODERATE
RAIN RAIN
FAIR FOG
FIGURED BY
NOTES CHECKED BY
PLOTTED BY
DATE
FILE No. 99
FLDR. No.
SHEET #1
DATE 3-10 1961
Quad. No.

STATION	DIST.	ANGLE ° ' "	+	H. I. BEARING	VER. ANG. DIFF.	ELEVATION
B.M.						24.31
"A" top of DRAIN from Reservoir	1.09	25.40			13.07	12.33

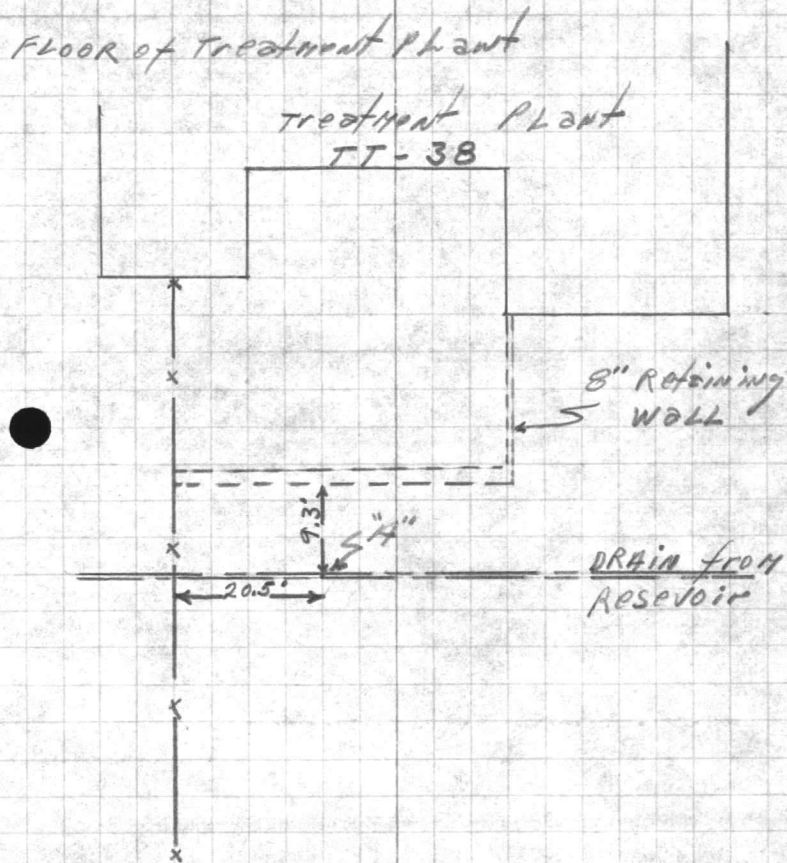


































VALUABLE
 RETURN TO
 PUBLIC WORKS
 OFFICE
 CAMP LEJEUNE
 NORTH CAROLINA

SUBJECT

 Profile of Proposed Water
 Line between Proposed New Wells at
 Tarawa Terrace

FIELD PARTY

 Dillon
 IN CHARGE
 INSTRUMENT
 NOTES
 TAPE READ
 TAPE OR ROD
 TAPE OR ROD
 INSTRUMENT NO.
 TAPE NO.

WEATHER

 CLEAR
 CLOUDY
 WINDY
 RAIN
 FAIR
 SNOW
 HOT
 MODERATE
 COLD
 FOG

FILE No. 99-Gen.

FLDR. No.

SHEET

#1 of 3

DATE

11/9/1960

Quad. No.

STATION	DIST.	ANGLE " "	+	H. I. BEARING	VER. ANG. DIFF.	ELEVATION
B.M.						
Top Hub at 0+00			4.57	30.54	✓	25.97
					4.45	26.09 ✓
0-37						22.58
0-25						24.13
0+0	0+37.5				4.4	26.1
1+0	1+37.5				4.8	25.7
1+99	2+36.5				4.3	26.2
2+01	Edge Borrow 2+38.5				5.3	25.2
2+15	Edge Borrow 2+54.5				5.5	25.0
2+19	2+56.5				4.9	25.6
2+54	2+91.5				4.9	25.6
2+75	3+12.5				4.1	26.4
3+0	3+37.5				4.1	26.4
4+0	4+37.5				4.0	26.5
T.P.					✓	27.80 ✓
		3.48		31.28		
4+92	Top Ditch Bank 5+29.5				4.6	26.7

On Elec. Trans. P.P. near Bldg #430 + Parking lot

Top of 10" C.I. Water Line

Top of 4" M.I. Gas Line

Approximate

Woods Line

Small Borrow Area 15' Square

Top Stake 4+0











VALUABLE

SUBJECT _____

RETURN TO
PUBLIC WORKS
OFFICE
CAMP LEJEUNE
NORTH CAROLINA

FIELD PARTY

 _____ IN CHARGE
 _____ INSTRUMENT
 _____ NOTES
 _____ TAPE READ
 _____ TAPE OR ROD
 _____ TAPE OR ROD
 _____ INSTRUMENT No.
 _____ TAPE No.

WEATHER

 CLEAR
 CLOUDY
 WINDY
 RAIN
 FAIR
 SNOW
 HOT
 MODERATE
 COLD
 FOG

FILE No. _____

FLDR. No. _____

SHEET # 2 of 3

DATE 11/9/1960

Quad. No. _____

STATION	DIST.	ANGLE		+	H. I. BEARING	VER. ANG. DIFF.	ELEVATION
		°	"				
					31.28		
4+95	5+32.5					7.0	24.3
4+98	5+35.5					6.1	25.2
4+98	Top U.G. Cable					9.1	22.2
5+0	5+37.5					5.8	25.5
5+06	5+43.5					5.2	26.1
5+23	5+60.5					4.7	26.6
5+33	5+70.5 Center 2' Ditch					6.4	24.9
5+39	5+74.5					5.2	26.1
6+0	6+37.5					5.1	26.2
6+52	6+89.5					4.5	26.8
6+57	6+94.5					4.9	26.4
7+0	7+37.5					3.9	27.4
8+0	8+37.5					3.5	27.8
9+0	9+37.5					4.0	27.3
T.P.					4.28	2.84	28.44
					32.72		

Top Stake 9+0








VALUABLE

SUBJECT _____

RETURN TO
PUBLIC WORKS
OFFICE
CAMP LEJEUNE
NORTH CAROLINA

FIELD PARTY

 _____ IN CHARGE
 _____ INSTRUMENT
 _____ NOTES
 _____ TAPE READ
 _____ TAPE OR ROD
 _____ TAPE OR ROD
 _____ INSTRUMENT NO.
 _____ TAPE NO.

WEATHER

 CLEAR _____ SNOW _____
 CLOUDY _____ HOT _____
 WINDY _____ MODERATE _____
 RAIN _____ COLD _____
 FAIR _____ FOG _____

FILE No. _____

FLDR. No. _____

SHEET # 3 of 3

NOTES CHECKED BY _____

PLOTTED BY _____ DATE 11/9/1960

Quad. No. _____

STATION	DIST.	ANGLE ° ' "	+	H. I. BEARING	VER. ANG. DIFF.	ELEVATION
---------	-------	----------------	---	------------------	--------------------	-----------

32.72

10+0	10+37.5				4.6	28.1
------	---------	--	--	--	-----	------

10+60	10+97.5				3.9	28.8
-------	---------	--	--	--	-----	------

10+78	11+15.5				5.4	27.3
-------	---------	--	--	--	-----	------

11+0	11+37.5				6.1	26.6
------	---------	--	--	--	-----	------

11+15	11+52.5				6.2	26.5
-------	---------	--	--	--	-----	------

Woods line

11+59	11+96.5				5.2	27.5
-------	---------	--	--	--	-----	------

Approximate site Well "Y"

11+89 ⁵	12+27				4.9	27.8
--------------------	-------	--	--	--	-----	------

11+89 ⁵	Top U.G. Tel. Cable				6.9	25.8
--------------------	---------------------	--	--	--	-----	------

12+0	12+37.5				4.7	28.0
------	---------	--	--	--	-----	------


B.M.					2.64	30.08 (30.05)
------	--	--	--	--	------	---------------

 Alt. Test Well site #9

12+34.57 = 12+72.07



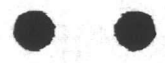






VALUABLE

SUBJECT _____

RETURN TO
 PUBLIC WORKS
 OFFICE
 CAMP LEJEUNE
 NORTH CAROLINA

FIELD PARTY

IN CHARGE _____
 INSTRUMENT _____
 NOTES _____
 TAPE READ _____
 TAPE OR ROD _____
 TAPE OR ROD _____
 INSTRUMENT NO. _____
 TAPE NO. _____

WEATHER

CLEAR _____ SNOW _____
 CLOUDY _____ HOT _____
 WINDY _____ MODERATE _____
 RAIN _____ COLD _____
 FAIR _____ FOG _____
 FIGURED BY _____
 NOTES CHECKED BY _____
 PLOTTED BY _____


FILE No. _____
 FLDR. No. _____
 SHEET #2 of 3
 DATE 11/9/1960

Quad. No. _____


STATION	DIST.	ANGLE ' "	H. I. BEARING	VER: ANG. DIFF.	ELEVATION
---------	-------	--------------	------------------	--------------------	-----------

6.23
 2.35
 8.58


P.I. Hub Temp. 13. M. - 26.09
 + 5.07
 31.16
 8.58
 22.58
 Top 10" C.I. Water - 8.58
 Top 4" W.I. Gas. - 7.03
 24.13

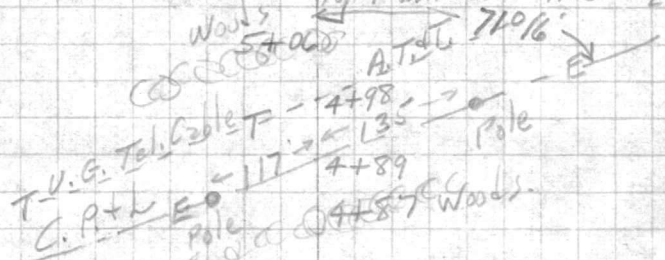

29°58'30" Counter Clock-wise

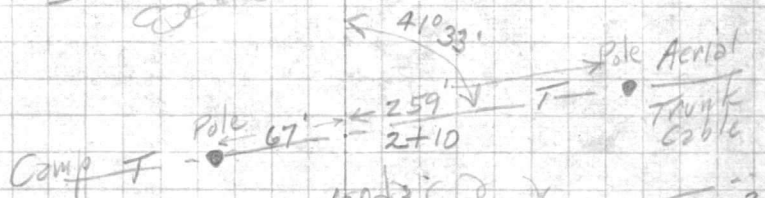

P.I. "X" for Well Location

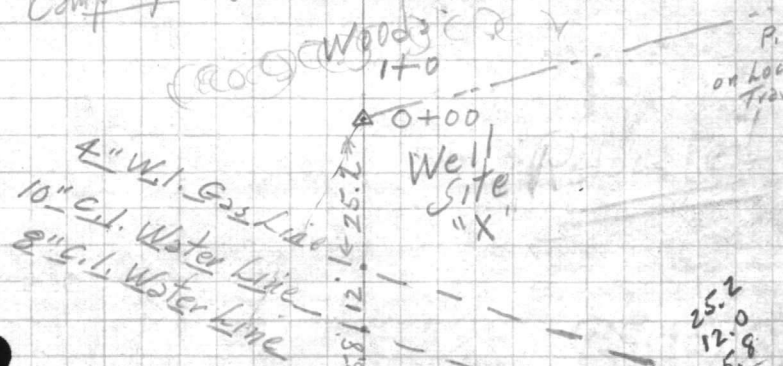

25.2
 12.0
 5.8
 45.0

P.I. #7 on Control Traverse

42.0
 32.2
 5.8

29°58'30"

VALUABLE

SUBJECT _____

RETURN TO
PUBLIC WORKS
OFFICE
CAMP LEJEUNE
NORTH CAROLINA

FIELD PARTY

 _____ IN CHARGE
 _____ INSTRUMENT
 _____ NOTES
 _____ TAPE READ
 _____ TAPE OR ROD
 _____ TAPE OR ROD
 _____ INSTRUMENT NO.
 _____ TAPE NO.

WEATHER

 CLEAR _____ SNOW _____
 CLOUDY _____ HOT _____
 WINDY _____ MODERATE _____
 RAIN _____ COLD _____
 FAIR _____ FOG _____

FILE No. _____


FLDR. No. _____

SHEET # 3 of 3

DATE 11/9/1960

Quad. No. _____

STATION	DIST.	ANGLE		+	H. I. BEARING	VER. ANG. DIFF.	ELEVATION
		°	' "				
P.I.							

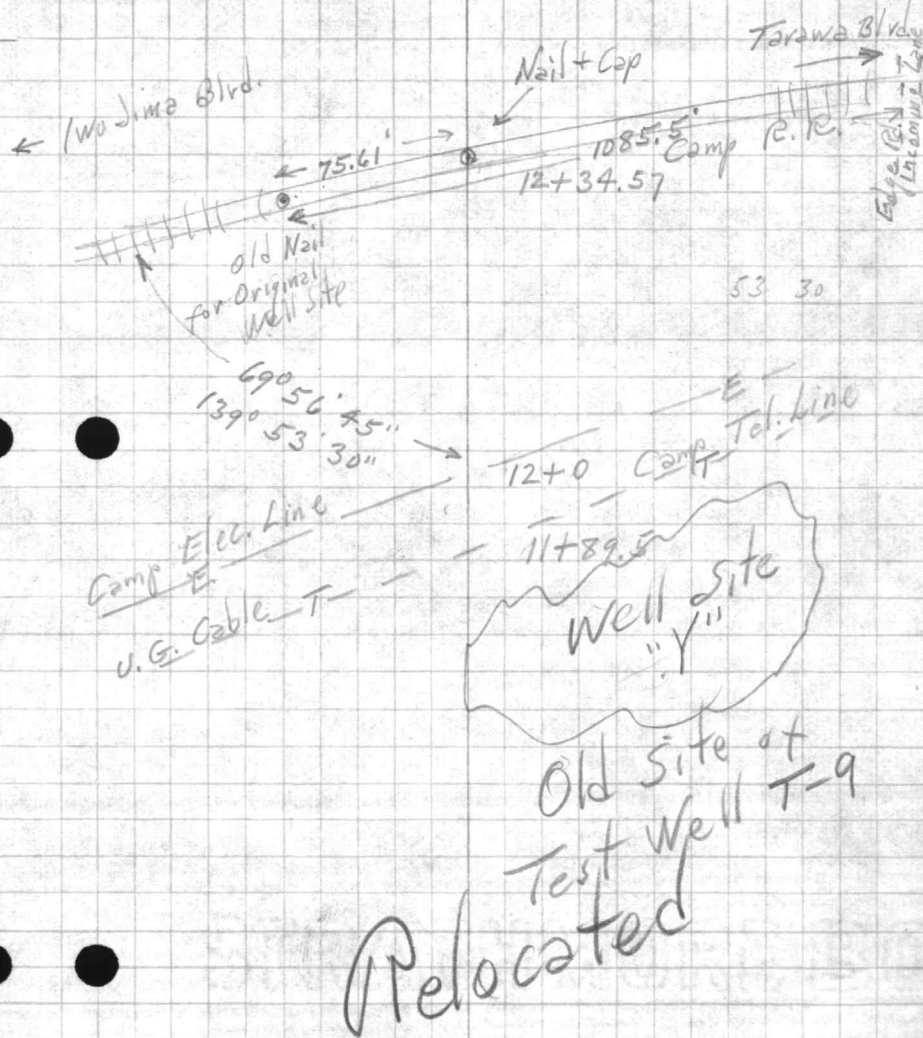






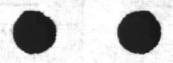





VALUABLE

RETURN TO
PUBLIC WORKS
OFFICE
CAMP LEJEUNE
NORTH CAROLINA



SUBJECT

Pipe locations and elevations at Water Treatment Plant at Tarawa Terrace

FIELD PARTY
Dillon IN CHARGE
____ INSTRUMENT
____ NOTES
____ TAPE READ
____ TAPE OR ROD
____ TAPE OR ROD
____ STRUMENT NO.
____ TAPE NO.

9.33
7.98
19.50
+ 1.51
WEATHER
CLEAR
CLOUDY
WINDY
RAIN
FAIR
SNOW
HOT
MODERATE
COLD
FOG
FIGURED BY
NOTES CHECKED BY
PLOTTED BY
FILE No. 99T
FLDR. No. _____
SHEET #1 of 2
DATE 3/10/1961
Quad. No. _____

STATION	DIST.	ANGLE ° ' "	+	H. I. BEARING	VER. ANG. DIFF.	ELEVATION
				25.16		
TOP of 10" 90° BEND					8.77	16.39
TOP of 10" 22 1/2° BEND					5.99	19.17
B.M.						24.31
	2.10		✓	26.41		
			+		17.69	44.10
			+		19.50	45.91
			+		21.01	47.42
B.M.						24.31
	0.85		✓	25.16		
			+		17.98	43.14
			-		1.46	23.70
					0.96	24.20
			+		3.18	28.34
					4.21	20.95

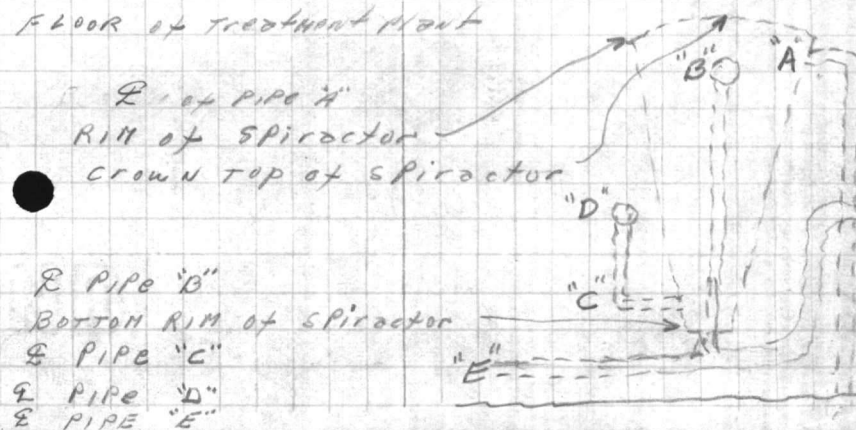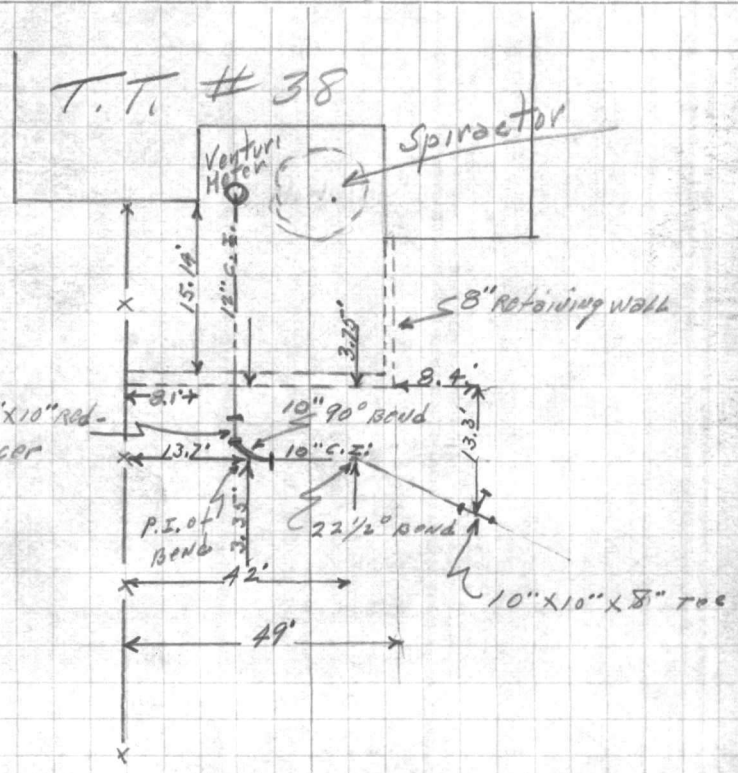




VALUABLE

RETURN TO
PUBLIC WORKS
OFFICE
CAMP LEJEUNE
NORTH CAROLINA

SUBJECT Profile Along Existing
ROW Water Line from TT-27

FIELD PARTY

IN CHARGE _____
INSTRUMENT _____
NOTES _____
TAPE READ _____
TAPE OR ROD _____
TAPE OR ROD _____
INSTRUMENT NO. _____
TAPE NO. _____

WEATHER

CLEAR
CLOUDY
WINDY
RAIN
FAIR

SNOW
HOT
MODERATE
COLD
FOG

742
036
7.8 FILE No. 99-Gen
FLDR. No. _____
#1
SHEET _____
DATE 3-14-1961

Quad. No. _____

STATION	DIST.	ANGLE ° ' "	+	H. I. BEARING	VER. ANG. DIFF.	ELEVATION
B.M.						26.29
	5.25			31.54		
1+0				31.5	5.0	26.5
2+0					4.8	26.7
3+0					4.9	26.6
4+0					4.6	26.9
5+0					4.8	26.7
T.P.					4.13	27.41
	3.65			31.06		
5+0				31.1	7.80	23.26
5+0					7.69	23.37
6+0					4.3	26.8
7+0					4.9	26.2
8+0					4.9	26.2
9+0					5.0	26.1
10+0					4.7	26.4
11+0					4.8	26.3
T.P.					4.24	26.82
	4.63			31.45		
12+0				31.4	4.8	26.6
13+0					4.5	26.9
14+0					4.6	26.8
15+0					5.0	26.4
16+0					5.0	26.4
17+0					5.5	25.9
B.M.					5.50	25.95
						25.97

SPIKE IN TRANS. Pole Near Well TT-27

TOP 10" 0+00
TOP 8"



opposite well site
ON ASPHALT in parking lot
ON Transformer Pole Near House #430
















































VALUABLE

SUBJECT _____

RETURN TO
 PUBLIC WORKS
 OFFICE
 CAMP LEJEUNE
 NORTH CAROLINA

FIELD PARTY

 IN CHARGE

 INSTRUMENT

 NOTES

 TAPE READ

 TAPE OR ROD

 TAPE OR ROD

 INSTRUMENT No. _____
 TAPE No. _____

WEATHER

CLEAR
 CLOUDY
 WINDY
 RAIN
 FAIR
 SNOW
 HOT
 MODERATE
 COLD
 FOG
 FIGURED BY _____
 NOTES CHECKED BY _____
 PLOTTED BY _____

7 26
 160
 85#
FILE No. _____
 FLDR. No. _____
 SHEET # 2
 DATE 3-14 1961

Quad. No. _____


STATION	DIST.	ANGLE ° ' "	+	H. I. BEARING	VER: ANG. DIFF.	ELEVATION
B.M.						25.97
		5.85		31.82		
18+0				(31.8)	6.1	25.7
149					6.8	25.0
19+0					5.9	25.9
20+0					4.7	27.1
20+0					6.24	25.58
20+0					8.04	23.78
21+0					4.9	26.9
22+0					4.9	26.9
T.P.					4.72	27.10
		3.75		30.85		
23+0				(30.8)	5.0	25.8
23+24	E NATHA ST.				5.22	25.63
24+0					4.4	26.4
T.P.					3.62	27.23
		3.16		30.39		
25+0				(30.4)	4.1	26.3
26+0					4.6	25.8
27+0					4.7	25.7
28+0					6.2	24.2
28+70					6.8	23.6
B.M.					6.05	24.34 (24.31)

SPike IN Transformer Pole Near House #430

E West Palokew Dr.

TOP of 8" C.I.
 TOP of 10" C.I.

West Palokew

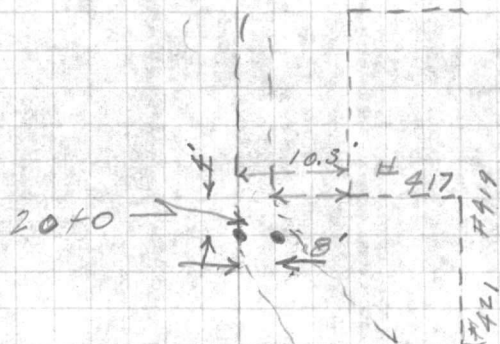

Water Treatment Plant Fence (Northside)
 FLOOR of TREATMENT PLANT







VALUABLE

RETURN TO
PUBLIC WORKS
OFFICE
CAMP LEJEUNE
NORTH CAROLINA

SUBJECT

Mer. & Pipe Locations
at Well House TT 28

Tarawa Terrace

FIELD PARTY

IN CHARGE
INSTRUMENT
NOTES
TAPE READ
TAPE OR ROD
TAPE OR ROD
INSTRUMENT NO.
TAPE NO.

WEATHER

CLEAR
CLOUDY
WINDY
RAIN
FAIR
SNOW
HOT
MODERATE
COLD
FOG

FILE No. 99 Gen.

FLDR. No.

SHEET #1 of 1

DATE 10/27/1960


Quad. No.

STATION	DIST.	ANGLE ° ' "	+	H. I. BEARING	VER. ANG. DIFF.	ELEVATION
---------	-------	----------------	---	------------------	--------------------	-----------

B.M.				3.97	31.82	27.85
Top of Tee					7.91	23.91
Ground					4.3	27.5

Spike in 14" Pine near House #2001 + R.P.

← To Tarawa #2 Tarawa Blvd.

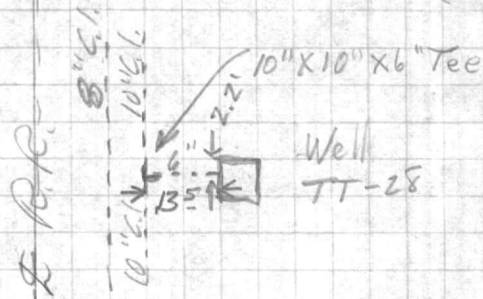

Well
TT-28

May 24

NY








44

VALUABLE

SUBJECT Location and elevations of
8" and 10" C.I. Water Lines at
Tarawa Terrace.

RETURN TO
 PUBLIC WORKS
 OFFICE
 CAMP LEJEUNE
 NORTH CAROLINA

FIELD PARTY

Dillon IN CHARGE
 _____ INSTRUMENT
 _____ NOTES
 _____ TAPE READ
 _____ TAPE OR ROD
 _____ TAPE OR ROD
 _____ INSTRUMENT NO.
 _____ TAPE NO.

WEATHER

CLEAR
 CLOUDY
 WINDY
 RAIN
 FAIR

SNOW
 HOT
 MODERATE
 COLD
 FOG


FILE No. 99
 FLDR. No. _____
 SHEET # 1 of 3
 DATE 10/26/1960
 Plotted By: _____
 Notes Checked By: _____
 Figured By: _____
 Quad. No. _____

STATION	DIST.	ANGLE " "	+	H. I. BEARING	VER: ANG. DIFF.	ELEVATION
B.M.			6.07	32.36		26.29
"X"					10.27	22.09
					9.25	23.11
Ground					5.9	26.5
Top North Rail of R.R. Siding			3.25			29.11
"Y"					9.25	23.11
					10.34	22.02
" "					7.60	24.76
Ground					8.72	23.64
					5.6	26.8

$$\begin{array}{r} 2.97 \\ 6.25 \\ \hline 9.25 \end{array}$$

$$\begin{array}{r} 3.99 \\ 6.28 \\ \hline 10.27 \end{array}$$

$$\begin{array}{r} 4.06 \\ 6.28 \\ \hline 10.34 \end{array}$$

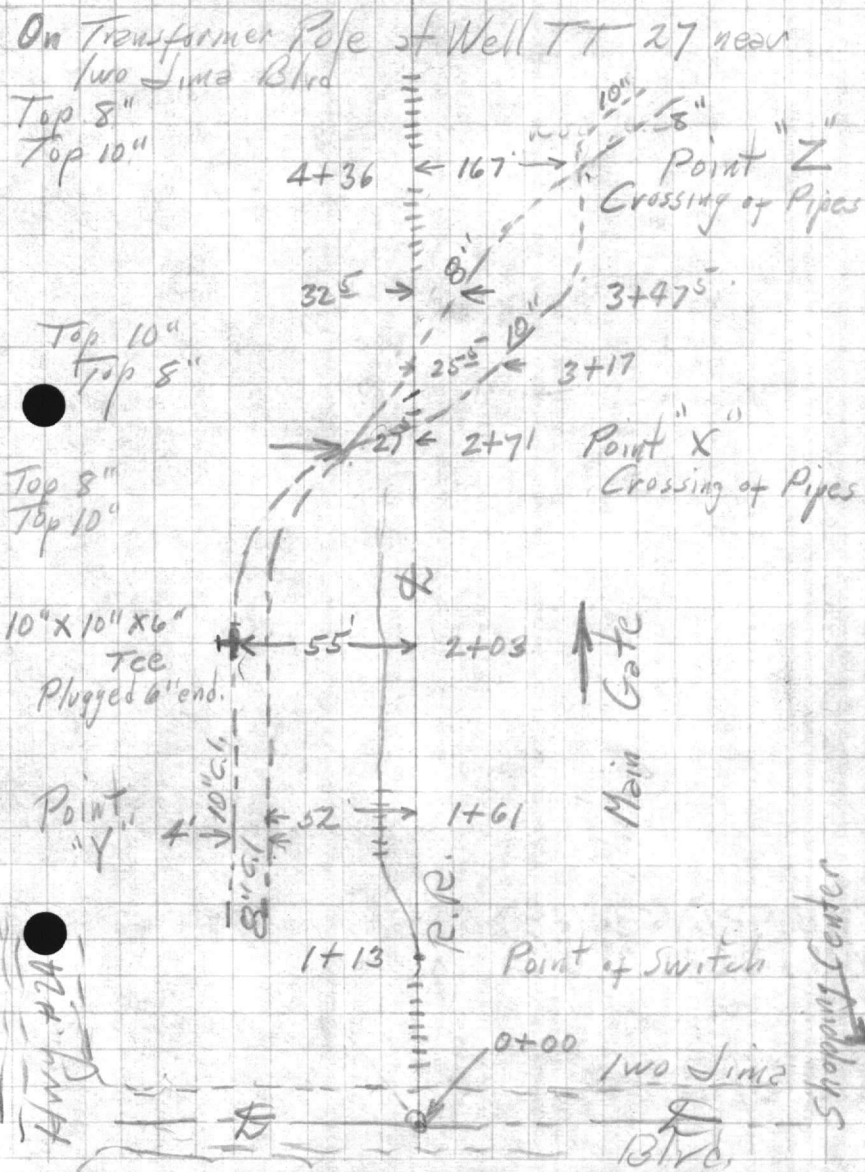

Handwritten note: Handy #24









VALUABLE

SUBJECT Location and Elevation of
Pipes at Equalizer between 8" and
10" Water Pipes - West of Two Lima Blvd.
in Trava Terrace

RETURN TO
PUBLIC WORKS
OFFICE
CAMP LEJEUNE
NORTH CAROLINA

FIELD PARTY

IN CHARGE

INSTRUMENT

NOTES

TAPE READ

TAPE OR ROD

TAPE OR ROD

INSTRUMENT NO.

TAPE NO.

WEATHER

CLEAR
CLOUDY
WINDY
RAIN
FAIR
SNOW
HOT
MODERATE
COLD
FOG


FILE No. 99

FLDR. No. _____
SHEET # 2 of 3
DATE 10/27/1960

Quad. No. _____

STATION	DIST.	ANGLE " "	+	H. I. BEARING	VER: ANG. DIFF.	ELEVATION
B.M.						
	6.43			32.72		26.29
Top 8" Tee					9.97	22.75
Top 10" x 10" x 8" Tee					10.07	22.65
Ground					6.8	25.9

An Trans. Pole at Well TT-27

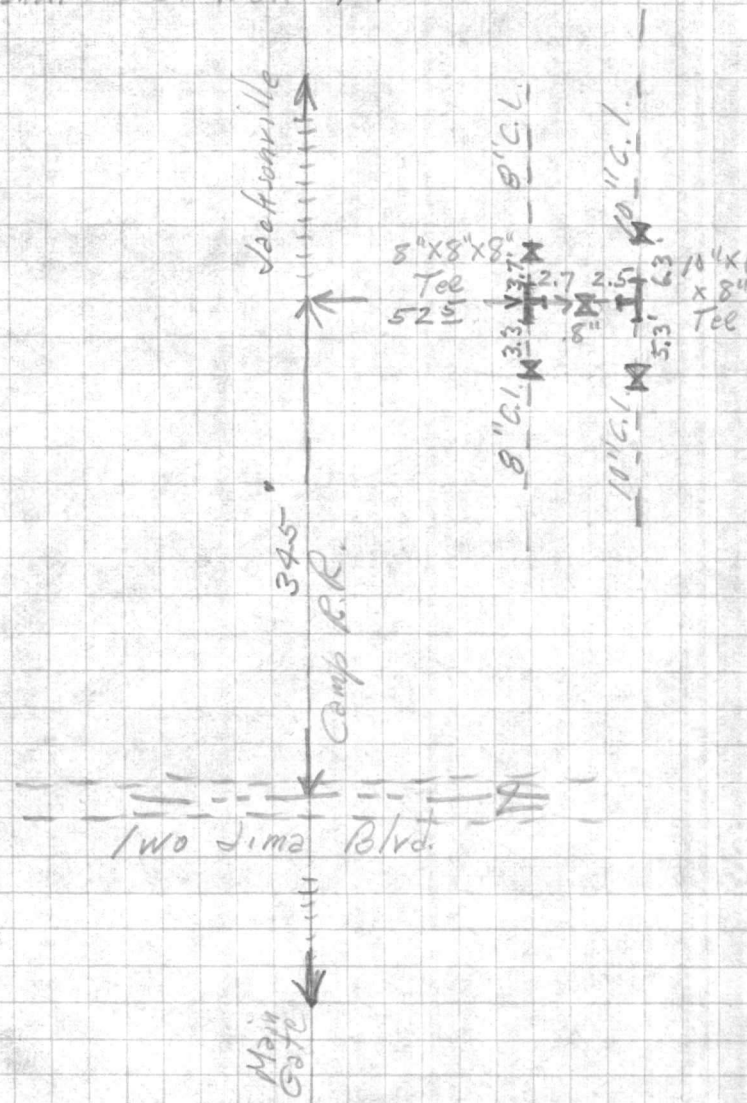










































































































VALUABLE

SUBJECT _____

RETURN TO
PUBLIC WORKS
OFFICE
CAMP LEJEUNE
NORTH CAROLINA

FIELD PARTY

IN CHARGE

INSTRUMENT

NOTES

TAPE READ

TAPE OR ROD

TAPE OR ROD

INSTRUMENT No.

TAPE No.

795
135
680
CLEAR
CLOUDY
WINDY
RAIN
FAIR

WEATHER

SNOW
HOT
MODERATE
COLD
FOG

FILE No. 99

FLDR. No. _____

SHEET # 3 of 3

DATE 10/27/1960

Quad. No. _____

STATION	DIST.	ANGLE			H. I. BEARING	VER. ANG. DIFF.	ELEVATION
		°	'	"			
12.M.						25.90	
			5.68	31.58			
Top of 5"X6"X6" Tee					8.80	22.78	







MON. # 39

H.I. way to 29
to Main rd

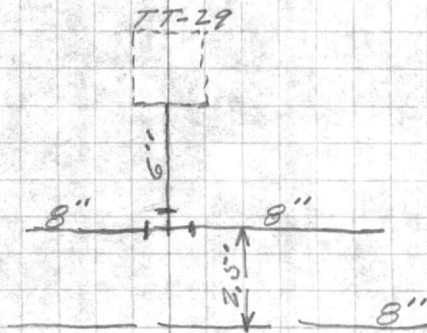





























VALUABLE

SUBJECT Locatio Water valves
Camp Knox EXT proposed

RETURN TO
PUBLIC WORKS
OFFICE
CAMP LEJEUNE
NORTH CAROLINA

FIELD PARTY

Morton IN CHARGE
INSTRUMENT _____
NOTES _____
TAPE READ _____
TAPE OR ROD _____
TAPE OR ROD _____
INSTRUMENT No. _____
TAPE No. _____

WEATHER

CLEAR _____ SNOW _____
CLOUDY _____ HOT _____
WINDY _____ MODERATE _____
RAIN _____ COLD _____
FAIR _____ FOG _____
FIGURED BY _____
NOTES CHECKED BY _____
PLOTTED BY _____

FILE No. 99M
FLDR. No. _____
SHEET 1 of 1
DATE 6/14 1953

Quad. No. _____

STATION	DIST.	ANGLE ' "	+	H. I. BEARING	VER. ANG. DIFF.	ELEVATION
---------	-------	--------------	---	------------------	--------------------	-----------

Camp Knox Rd 47

9" C.I. Water Lines 3' below Ground

Ground

25.2

3.0

22.2

Water Lines


R.R.

C.R.R.

8" C.I. Water Line

N.C. # 24

TO Jacksonville Highway

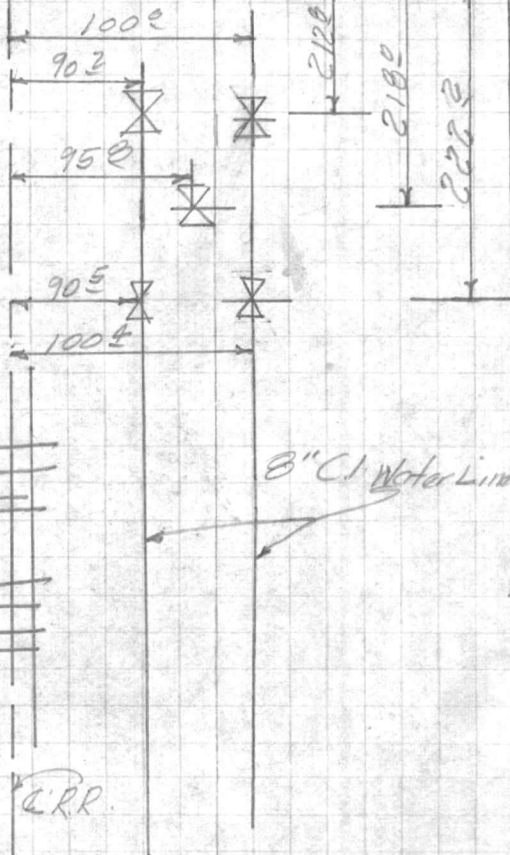















































VALUABLE

SUBJECT _____

RETURN TO
PUBLIC WORKS
OFFICE
CAMP LEJEUNE
NORTH CAROLINA

FIELD PARTY

 _____ IN CHARGE
 _____ INSTRUMENT
 _____ NOTES
 _____ TAPE READ
 _____ TAPE OR ROD
 _____ TAPE OR ROD
 _____ INSTRUMENT NO.
 _____ TAPE NO.

WEATHER

 CLEAR
 CLOUDY
 WINDY
 RAIN
 FAIR
 SNOW
 HOT
 MODERATE
 COLD
 FOG

FILE No. _____

FLDR. No. _____

SHEET 10 of 1

FIGURED BY _____ NOTES CHECKED BY _____

PLOTTED BY _____ DATE 10-20 1960

Quad. No. _____

STATION	DIST.	ANGLE ° ' "	+	H. I. BEARING	VER: ANG. DIFF.	ELEVATION
---------	-------	----------------	---	------------------	--------------------	-----------

B.M.				4 28 29.69		25.41
					8 45	21.23
					8 35	21.34

MON. # 8 A

8" X 8" X 8" TEE

TOP 8" LINE FROM TEE TO VALVE

 153
 080
 550


VALUABLE

SUBJECT Location of 8" and 10" C.I.
Water Collection Main in Tarawa
Terrace #1

RETURN TO
PUBLIC WORKS
OFFICE
CAMP LEJEUNE
NORTH CAROLINA

FIELD PARTY

Dillon IN CHARGE
INSTRUMENT _____
NOTES _____
TAPE READ _____
TAPE OR ROD _____
TAPE OR ROD _____
INSTRUMENT NO. _____
TAPE NO. _____


WEATHER

CLEAR _____ SNOW _____
CLOUDY _____ HOT _____
WINDY _____ MODERATE _____
RAIN _____ COLD _____
FAIR _____ FOG _____

FILE No. 99 Gen
FLDR. No. _____
SHEET #1 of 2
DATE 10/28/1960

Quad. No. _____

STATION	DIST.	ANGLE ° ' "	+	H. I. BEARING	VER: ANG. DIFF.	ELEVATION
---------	-------	----------------	---	------------------	--------------------	-----------

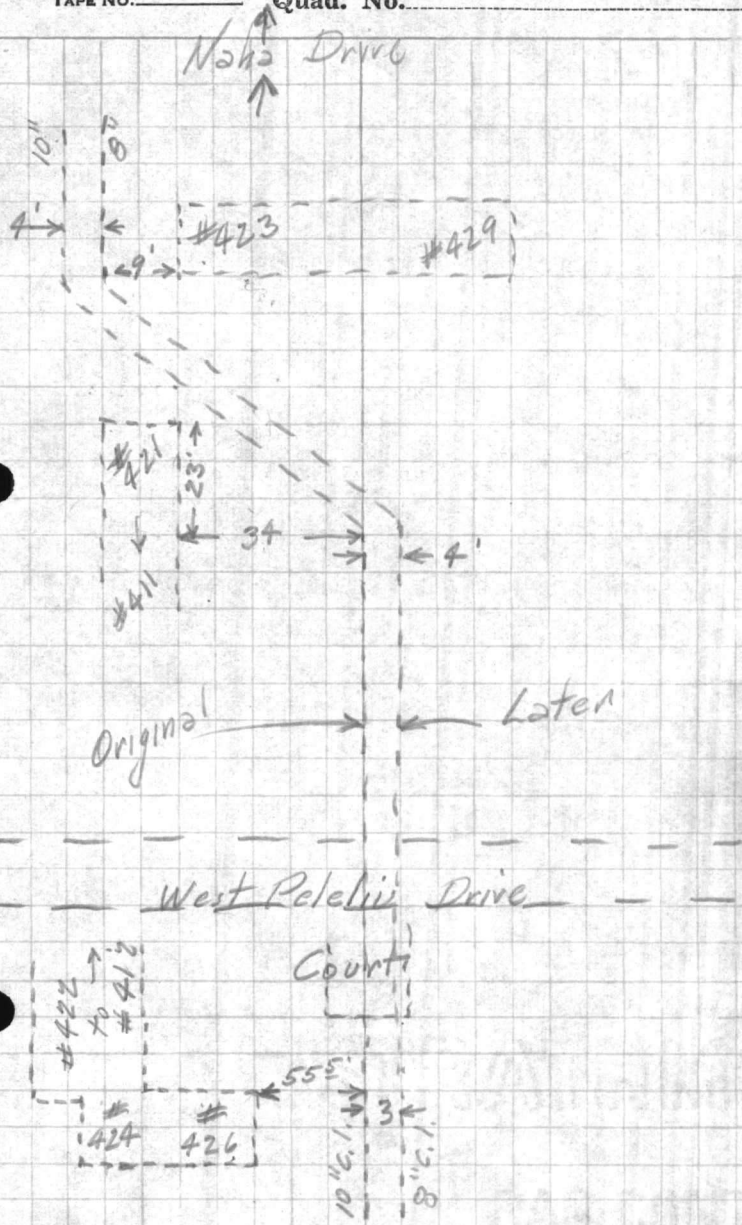





VALUABLE

SUBJECT Water Lines
Raw Water Collection
Tarawa Terrace

RETURN TO
PUBLIC WORKS
OFFICE
CAMP LEJEUNE
NORTH CAROLINA

FIELD PARTY

IN CHARGE

INSTRUMENT

NOTES

TAPE READ

TAPE OR ROD

TAPE OR ROD

INSTRUMENT NO.

TAPE NO.

WEATHER


CLEAR
CLOUDY
WINDY
RAIN
FAIR

SNOW
HOT
MODERATE
COLD
FOG

FILE No. _____
FLDR. No. _____
SHEET # 2 of 2
DATE _____ 19__

FIGURED BY _____
NOTES CHECKED BY _____
PLOTTED BY _____
Quad. No. _____

STATION	DIST.	ANGLE ° ' "	+	H. I. BEARING	VER: ANG. DIFF.	ELEVATION
---------	-------	----------------	---	------------------	--------------------	-----------

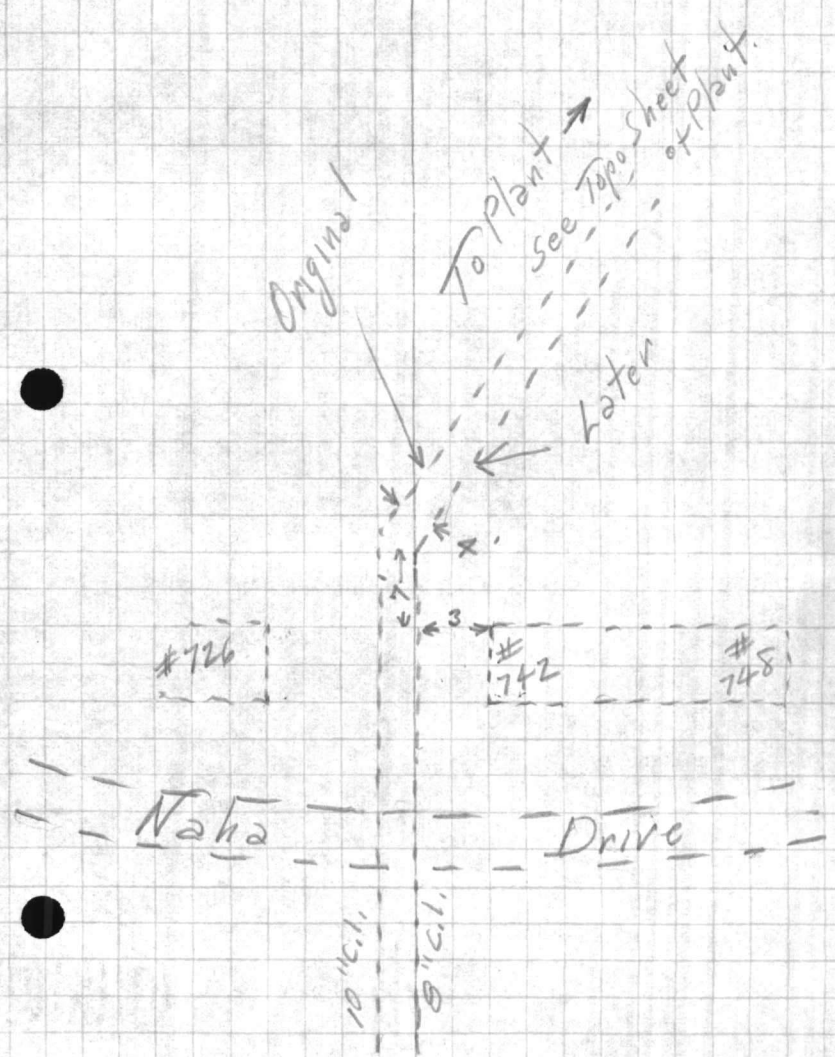




























VALUABLE

RETURN TO
PUBLIC WORKS
OFFICE
CAMP LEJEUNE
NORTH CAROLINA

SUBJECT Sketch showing
Base Line for cross
sections at sewage
Disposal Plant
Tarawa Terrace

FIELD PARTY

Kollum IN CHARGE
INSTRUMENT
NOTES
TAPE READ
TAPE OR ROD
TAPE OR ROD
INSTRUMENT No.
TAPE No.


WEATHER

CLEAR
CLOUDY
WINDY
RAIN
FAIR
SNOW
HOT
MODERATE
COLD
FOG

FILE No. 99-K
FLDR. No. _____
SHEET 1.0 of 2
DATE 12-23-1960

Quad. No. _____

STATION	DIST.	ANGLE ° ' "	+	H. I. BEARING	VER: ANG. DIFF.	ELEVATION
---------	-------	----------------	---	------------------	--------------------	-----------

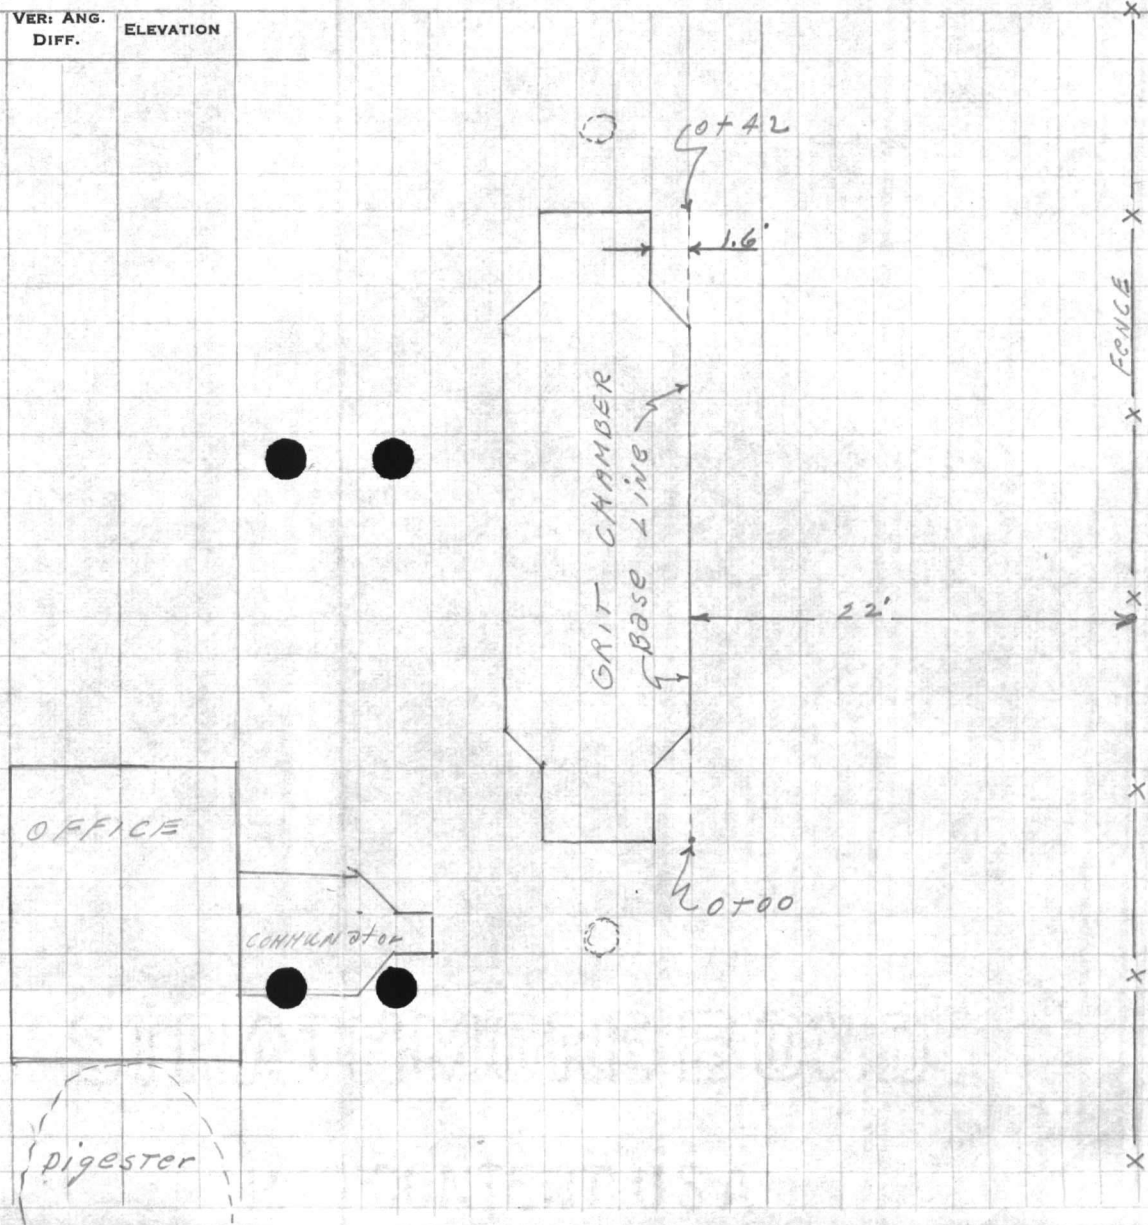






VALUABLE

SUBJECT CROSS SECTIONS
AT sewage disposal
PLANT AT Tarawa
Terrace

RETURN TO
 PUBLIC WORKS
 OFFICE
 CAMP LEJEUNE
 NORTH CAROLINA

FIELD PARTY

 IN CHARGE

 INSTRUMENT

 NOTES

 TAPE READ

 TAPE OR ROD

 TAPE OR ROD

 INSTRUMENT NO.

 TAPE NO. _____

WEATHER

CLEAR _____
 CLOUDY _____
 WINDY _____
 RAIN _____
 FAIR _____
 SNOW _____
 HOT _____
 MODERATE _____
 COLD _____
 FOG _____

FILE No. _____
 FLDR. No. _____
 SHEET 2 of 2
 DATE 12-23 1960

FIGURED BY _____
 NOTES CHECKED BY _____
 PLOTTED BY _____
 Quad. No. _____

STATION	DIST.	ANGLE		+	H. I. BEARING	VER: ANG. DIFF.	ELEVATION
		°	"				

B.M.							23.91
				3.60	27.51		

0+00							
						0.98	16.53

TOP of Grit chamber wall

0+05							

0+15							

0+25							

0+35							

0+42							

0+50							

0+52	B.M.					3.60	13.91

9' RT. GUY ANCHOR

spike in power pole near fence

Fence
 -1.6 0 7 11 22 35
 3.0 2.8 3.2 3.2 3.6 4.1
 24.5 24.7 24.3 24.3 23.9 23.4

Fence
 0 2 11 22 35
 3.0 2.8 3.1 3.6 4.0
 24.5 24.7 24.4 23.9 23.5

Fence
 0 2 13 22 35
 3.2 3.0 3.2 3.7 3.9
 24.3 24.5 24.3 23.8 23.6

Fence
 0 2 12 22 35
 3.0 2.9 3.1 3.6 4.0
 24.5 24.6 24.4 23.9 23.5

Fence
 0 2 13 22 35
 3.0 2.9 3.3 3.8 4.2
 24.5 24.6 24.2 23.7 23.3

Fence
 -1.6 0 9 22 35
 2.8 2.7 3.1 3.8 4.1
 24.7 24.8 24.4 23.7 23.4

Fence
 0 9 22 35
 3.0 3.2 3.9 4.3
 24.5 24.3 23.6 23.2










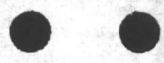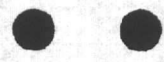

VALUABLE

SUBJECT under ground utilities
Loc. at sewerage plant
Tarawa Terrace

RETURN TO
 PUBLIC WORKS
 OFFICE
 CAMP LEJEUNE
 NORTH CAROLINA

FIELD PARTY

 IN CHARGE

 INSTRUMENT

 NOTES

 TAPE READ

 TAPE OR ROD

 TAPE OR ROD

 INSTRUMENT NO.

 TAPE NO. _____

WEATHER

CLEAR _____
 CLOUDY _____
 WINDY _____
 RAIN _____
 FAIR _____
 SNOW _____
 HOT _____
 MODERATE _____
 COLD _____
 FOG _____

FILE No. 99-X
 FLDR. No. _____
 SHEET #1 of 2
 DATE 12-30-1960
 Quad. No. _____

STATION	DIST.	ANGLE ° ' "	+	H. I. BEARING	VER: ANG. DIFF.	ELEVATION
T MON. #97						
B.S. MON. #98						
	105'	345°				top of west sewer line at fence
	67'	19°28'				" " " " " "
	86'	79°31'				" " " " " "
	106.5'	332°45'				top of EAST sewer line at fence
	100'	329°07'				" " " " " "
	80'	299°09'				" " " " " "
	100'	252°30'				" " " " " "
	43'	338°40'				top of water line
	42'	165°54'				" " " " " "
	139'	163°42'				" " " " " "
	102.5'	341°15'				6" X 6" Tee of Cross. Bend in water line (Near Fence)
	127'	316°45'				Top of Pipe 4.2 below Ground 6" Water Line
	171'	307°08'				Fire Hydrant near Bldg. #35 Shown on other location sheets.
	163'	363°35'				6" X 6" Tee to F.H. Valve 3' toward F.H.
	198'	298°51'				W.L. on Curve
	229'	300°48'				P.T. on W.L.
T at Cor. "B" of Sludge Beds.				S.W. Corner		See Bldg. Co-ord. Sheets.
Sight on Cor. "A"				N.W. Corner		
"	129'	358°20'				10" C.I. line from Digester to Sludge Beds. Bend.
"	154'	358°49'				
"	214'	340°06'				
	166'	341°34'				6" X 6" Tee on W.L. to Bldg. & F.H. at Primary Settling.
	195'	323°45'				6" X 6" Tee to Bldg. #35 Valve 2' toward Bldg.
	218'	316°08'				Fire Hydrant No Valve.












VALUABLESUBJECT Water LinesRETURN TO
PUBLIC WORKS
OFFICE
CAMP LEJEUNE
NORTH CAROLINATarawa Terrace Sewage Plant

FIELD PARTY

Dillon IN CHARGE
INSTRUMENT
NOTES
TAPE READ
TAPE OR ROD
TAPE OR ROD
INSTRUMENT NO.
TAPE NO.

WEATHER

CLEAR
CLOUDY
WINDY
RAIN
FAIR
SNOW
HOT
MODERATE
COLD
FOG

FILE No. _____

FLDR. No. _____

SHEET # 2 of 2DATE 1/3/1960FIGURED BY _____
NOTES CHECKED BY _____
PLOTTED BY _____
Quad. No. _____

STATION	DIST.	ANGLE ° ' "	+	H. I. BEARING	VER: ANG. DIFF.	ELEVATION
---------	-------	----------------	---	------------------	--------------------	-----------

T at Sludge Bed.

56' 297° 20' Fire Hydrant.

50' 300° 29' 6" X 6" Tee to F.H. — Valve 3' toward F.H.

Valve 3' Ahead on 6" Line. (toward)

41.5' 263° 16'

59' 231° 06' On Curve on W.L.

84' 222° 44' "

129' 226° 40' "

168' 232° 21' 6" Bend.

Valve 2' Ahead toward. →

165' 233° 53'

171' 236° 06' 6" X 6" Tee to F.H. and line to Bldg. # 36

177' 234° 20' Fire Hydrant

180' 238° 55'









VALUABLE

SUBJECT

Stadia Topog
Tarawa Terraced
Sewage Disposal Plant

RETURN TO
 PUBLIC WORKS
 OFFICE
 CAMP LEJEUNE
 NORTH CAROLINA

FIELD PARTY

Pilou IN CHARGE
Keenan INSTRUMENT
 NOTES
 TAPE READ
Dennis TAPE OR ROD
 TAPE OR ROD
 INSTRUMENT NO.
 TAPE NO.

WEATHER

CLEAR
 CLOUDY
 WINDY
 RAIN
 FAIR
 SNOW
 HOT
 MODERATE
 COLD
 FOG
 FIGURED BY
 NOTES CHECKED BY
 PLOTTED BY

FILE No.

FLDR. No.

SHEET

DATE *12/27/1940*

Quad. No.

STATION	DIST.	ANGLE ° ' "	+	H. I. BEARING	VER. ANG. DIFF.	ELEVATION
---------	-------	----------------	---	------------------	--------------------	-----------

1st Mon. # 97 near Entrance
Sight on Mon. # 98 toward River

1	187'	165°53'				
2	125'	165°36'				
3	238'	19°51'				
4	75'	149°59'				
5	49'	129°08'				
6	167'	24°40'				
7	65'	67°03'				
8	115'	47°20'				
9	34'	104°26'				
10	30'	193°06'				
11	103'	322°29'				
12	60'	235°21'				
13	103'	260°33'				
14	178'	228°10'				
15	68'	211°05'				
16	99'	177°54'				
17	150'	273°25'				
18	181'	278°56'				
19	205'	283°25'				
20	235'	279°				
21	242'	292°05'				
22	316'	300°32'				
23	301'	353°13'				
24	226'	3°40'				
25	305'	350°12'				

3" Magnolia tree

int. of Rds.

E Rd.

P.T. Rd.

Fence 3.5' off Edge Rd.

E Rd.

E Rd.

E Rd. 1.5' of Edge Rd. cor. fence ^{210°} gates

int. of Rds.

E Rd.

E Rd.

E Rd.

40' Power pole (P.M.) ANCHOR 19' ON BISECT

E Rd.

int. of Rds.

POINT ON POWER LINE NEXT POLE 155' NORTH

E Rd.

E Rd.

E Rd.

E Rd.

E Rd. ON FENCE LINE (2-10' GATES)

COR. FENCE

E Rd.


COR. FENCE 9' FROM EDGE RD. ^{35' pole}

TRANSFORMER POLE (2 TRANSFORMERS) END POLE

ANCHOR 18.5' EXTENDED.

ANGLE POLE NO ANCHOR (35' POLE)

See Back of sheet.

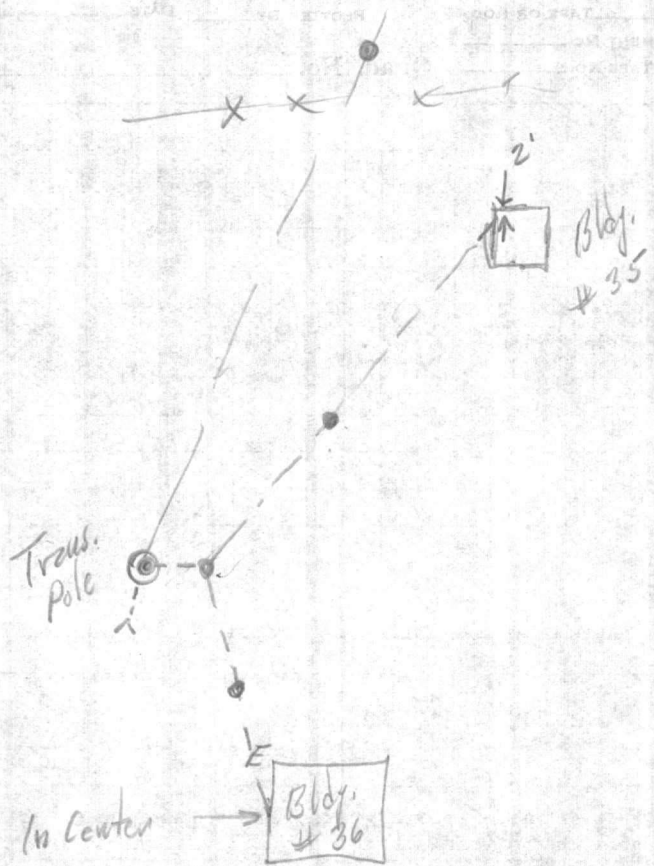

VALUABLE

SUBJECT _____

RETURN TO
PUBLIC WORKS
OFFICE
CAMP LEJEUNE
NORTH CAROLINA

FIELD PARTY

IN CHARGE

INSTRUMENT

NOTES

TAPE READ

TAPE OR ROD

TAPE OR ROD

INSTRUMENT No.

TAPE No.

WEATHER

CLEAR
CLOUDY
WINDY
RAIN
FAIR

SNOW
HOT
MODERATE
COLD
FOG

FILE No. _____

FLDR. No. _____

FIGURED BY _____ SHEET 2 of

NOTES CHECKED BY _____

PLOTTED BY _____ DATE 12-27 1960

Quad. No. _____


STATION	DIST.	ANGLE ° ' "	+	H. I. BEARING	VER. ANG. DIFF.	ELEVATION
T MON. #98						
Sight MON. #97						
26	121'	0°08'				
27	107'	355°40'				
28	200'	29°23'				
29	83'	4°34'				
30	65'	29°16'				
31	173'	56°45'				
32	56'	44°12'				
33	155'	52°24'				
34	72'	59°06'				
35	137'	73°55'				
36	110'	86°11'				
37	238'	64°24'				
38	149'	94°05'				
39	196'	94°27'				
40	219'	92°16'				
41	238'	88°56'				
42	255'	83°41'				
43	328'	65°27'				
44	297'	87°06'				
45	248'	81°08'				
46	360'	109°43'				
47	290'	126°35'				
48	293'	121°03'				
49	228'	122°40'				
50	155'	118°22'				
51	165'	104°27'				
52	203'	96°43'				
53	237'	99°12'				
54	266'	102°36'				

P.C. of FENCE
P.C. Rd.
40' Power pole
E Rd.
int. Rd. of 10' drive to Bldg. #36
E drive at Bldg. #36
int. of 12' Mark Rd. with Edge of ^{Asphalt} Rd.
End of 15" RCP 4.5' Head wall
E Rd. FENCE 3.5' off edge of Rd.
E 2'x1.5' D.I.
E Rd.
Fire Hyd. (no valve)
E Rd.
E Rd.
E Rd.
E Rd.
P.T. Rd.
P.C. Rd.
COR. FENCE
COR. FENCE
ON FENCE line 70' from end of fence
ON EAST END of 6' Head wall
E 12' Mark Drive
" " "
" " "
E 3.5' x 2.5' D.I.
E of 12' Mark edge of Edge of Asphalt Rd.
E 12' Mark Drive
E 16' " "

Note: 41.5' from Man Hole
Down Board walk Fence



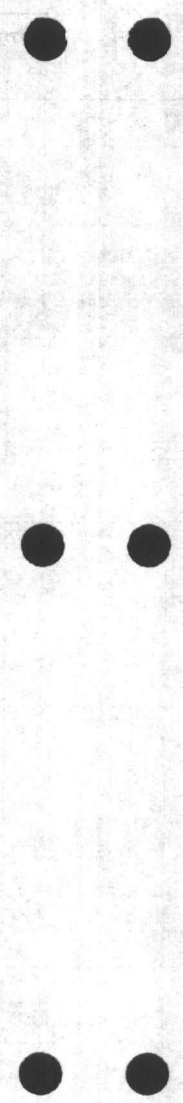

VALUABLE

SUBJECT _____

RETURN TO
PUBLIC WORKS
OFFICE
CAMP LEJEUNE
NORTH CAROLINA

FIELD PARTY

IN CHARGE

INSTRUMENT

NOTES

TAPE READ

TAPE OR ROD

TAPE OR ROD

INSTRUMENT NO.

TAPE NO.

WEATHER

CLEAR
CLOUDY
WINDY
RAIN
FAIR
SNOW
HOT
MODERATE
COLD
FOG
FIGURED BY _____
NOTES CHECKED BY _____
PLOTTED BY _____

FILE No. _____

FLDR. No. _____

SHEET 3

DATE 12-27-60

Quad. No. _____

STATION	DIST.	ANGLE ° ' "	+	H. I. BEARING	VER: ANG. DIFF.	ELEVATION
---------	-------	----------------	---	------------------	--------------------	-----------

55	306'	112°49'				
56	302'	116°46'				

± 29' MARL Dr.
Edge MARL

Inst. at ^{COR.} Point "B" in Sledge Beds
Sight on ^{COR.} Point "A" " "

187'	32°20'	Corner Fence
170'	32°23'	Corner Asphalt
94'	100°49'	" "
102'	102°30'	Corner Fence
20'	208°20'	Corner Asphalt with 10' Rad. at
69'	205°01'	E Rd.
25'	226°55'	E Rd.
56'	297°24'	Fire Hydrant — Valve, 7' toward Instrument
74'	346°08'	E Rd.
30'	276°17'	3' x 2' Drip Inlet.
129'	347°54'	" " "
145'	352°55'	E Rd.
143'	356°32'	Corner Asphalt with 10' Radius.
174'	14°02'	
99'	126°50'	
218'	316°08'	Fire Hydrant.
197'	324°07'	Valve
214'	340°07'	Valve

Note: Woods Line on outside of Fence
approx 5' — Shoulder also.

Outlet of 15" R.C.P. — 4.5' Endwell
" " " " — 4.5' "
















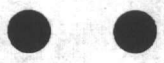

VALUABLE

SUBJECT Building Location
AT sewage disposal
Area AT Tarawa Terrace

RETURN TO
 PUBLIC WORKS
 OFFICE
 CAMP LEJEUNE
 NORTH CAROLINA

FIELD PARTY

____ IN CHARGE
 ____ INSTRUMENT
 ____ NOTES
 ____ TAPE READ
 ____ TAPE OR ROD
 ____ TAPE OR ROD
 ____ INSTRUMENT NO.
 ____ TAPE NO.

WEATHER

CLEAR
 CLOUDY
 WINDY
 RAIN
 FAIR

SNOW
 HOT
 MODERATE
 COLD
 FOG

FILE No. 99-X

FLDR. No. _____

SHEET 1-04DATE 8-25-1960

FIGURED BY _____

NOTES CHECKED BY _____

PLOTTED BY _____

Quad. No. _____

STATION	DIST.	ANGLE ° ' "	+	H. I. BEARING	VER: ANG. DIFF.	ELEVATION
---------	-------	----------------	---	------------------	--------------------	-----------

M.H. #3 368.2 117° 36'

M.H. #2 210.33 51° 16' 15"

"E" 227.15 46° 58' 30"

M.H. #1 199.0 49° 13' 30"

COR. "D" 81° 44' 30"


COR. "C" 64° 28' 00"

COR. "B" 60° 44' 30"

COR. "A" 54° 28' 30"

T MON. #98

R.S. MON. #97

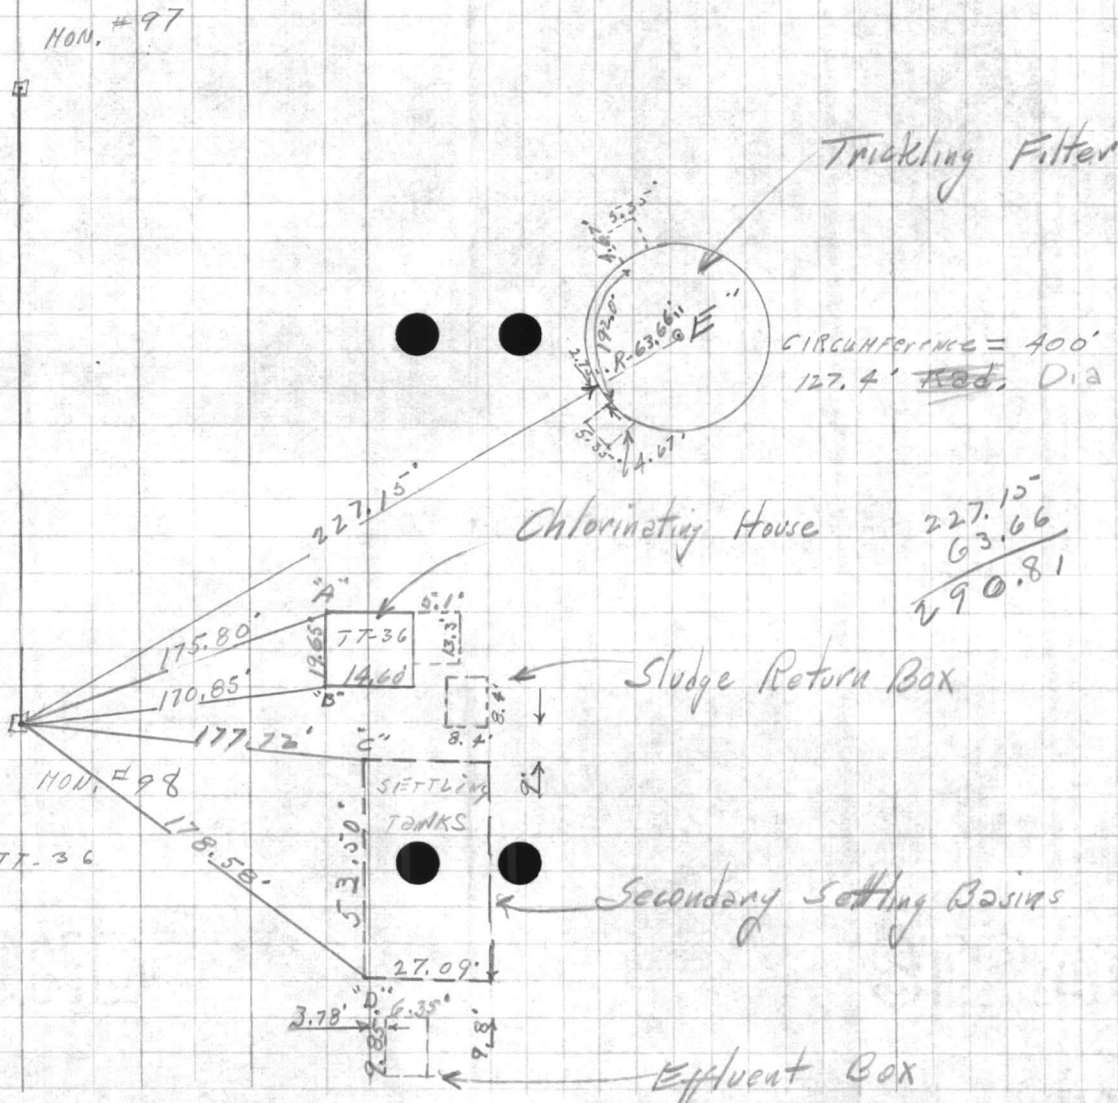




VALUABLE

SUBJECT _____

 RETURN TO
 PUBLIC WORKS
 OFFICE
 CAMP LEJEUNE
 NORTH CAROLINA

FIELD PARTY

IN CHARGE _____
 INSTRUMENT _____
 NOTES _____
 TAPE READ _____
 TAPE OR ROD _____
 TAPE OR ROD _____
 INSTRUMENT NO. _____
 TAPE NO. _____


WEATHER

CLEAR _____
 CLOUDY _____
 WINDY _____
 RAIN _____
 FAIR _____
 SNOW _____
 HOT _____
 MODERATE _____
 COLD _____
 FOG _____
 FIGURED BY _____
 NOTES CHECKED BY _____
 PLOTTED BY _____

FILE No. _____
 FLDR. No. _____
 SHEET 2 of _____
 DATE 8-25-1960

Quad. No. _____

STATION	DIST.	ANGLE ° ' "	+	H. I. BEARING	VER. ANG. DIFF.	ELEVATION
M.H. #7	212'	347°11'30"				
M.H. #6	210'	349°38'30"				
"G"	186'	333°11'30"	} Stadia	CHO. TANK		
"F"	166'	330°34'		CHO. TANK		
"E"	254.0'	340°56'		COR. settling tank		
"D"	255.80'	339°52'30"		COR. settling tank		
"C"	174.50'	317°32'45"		COR. T.T. 35'		
"B"	183.65'	311°55'30"		COR. T.T. 35'		
"A"	190.20'	309°59'		Q. Digester		
M.H. #5	131.33'	336°40'30"				
M.H. #4	154.68'	309°53'30"				

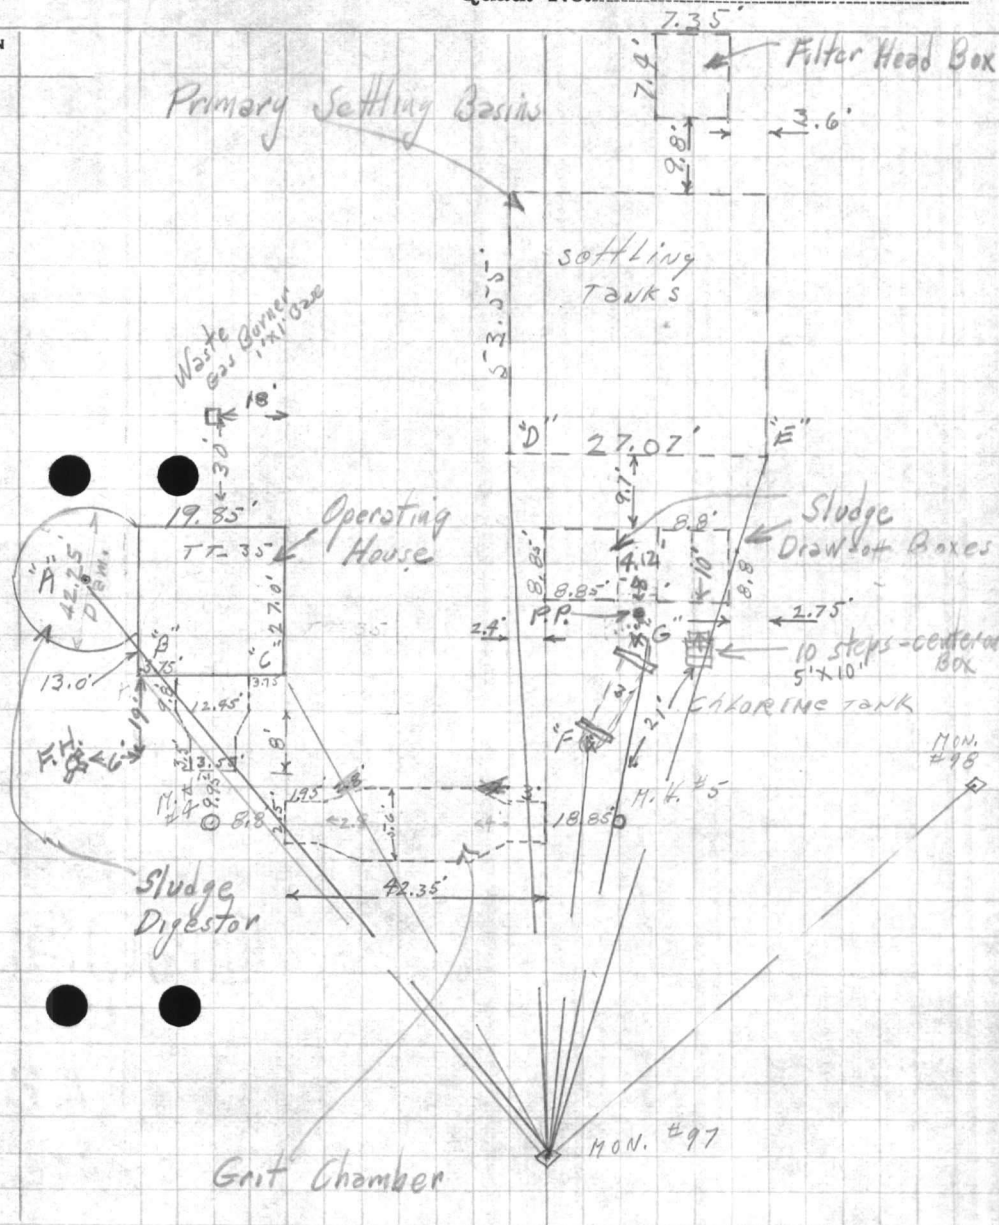

190.20
 21.12
 211.32

VALUABLE

PROPERTY
PUBLIC WORKS
OFFICE






















































VALUABLE

SUBJECT _____

RETURN TO
PUBLIC WORKS
OFFICE
CAMP LEJEUNE
NORTH CAROLINA

FIELD PARTY

IN CHARGE

INSTRUMENT

NOTES

TAPE READ

TAPE OR ROD

TAPE OR ROD

INSTRUMENT NO.


TAPE NO.

WEATHER

CLEAR
CLOUDY
WINDY
RAIN
FAIR
SNOW
HOT
MODERATE
COLD
FOG

FILE No. _____
FLDR. No. _____
SHEET 3 of _____
DATE 8-25-60

Quad. No. _____

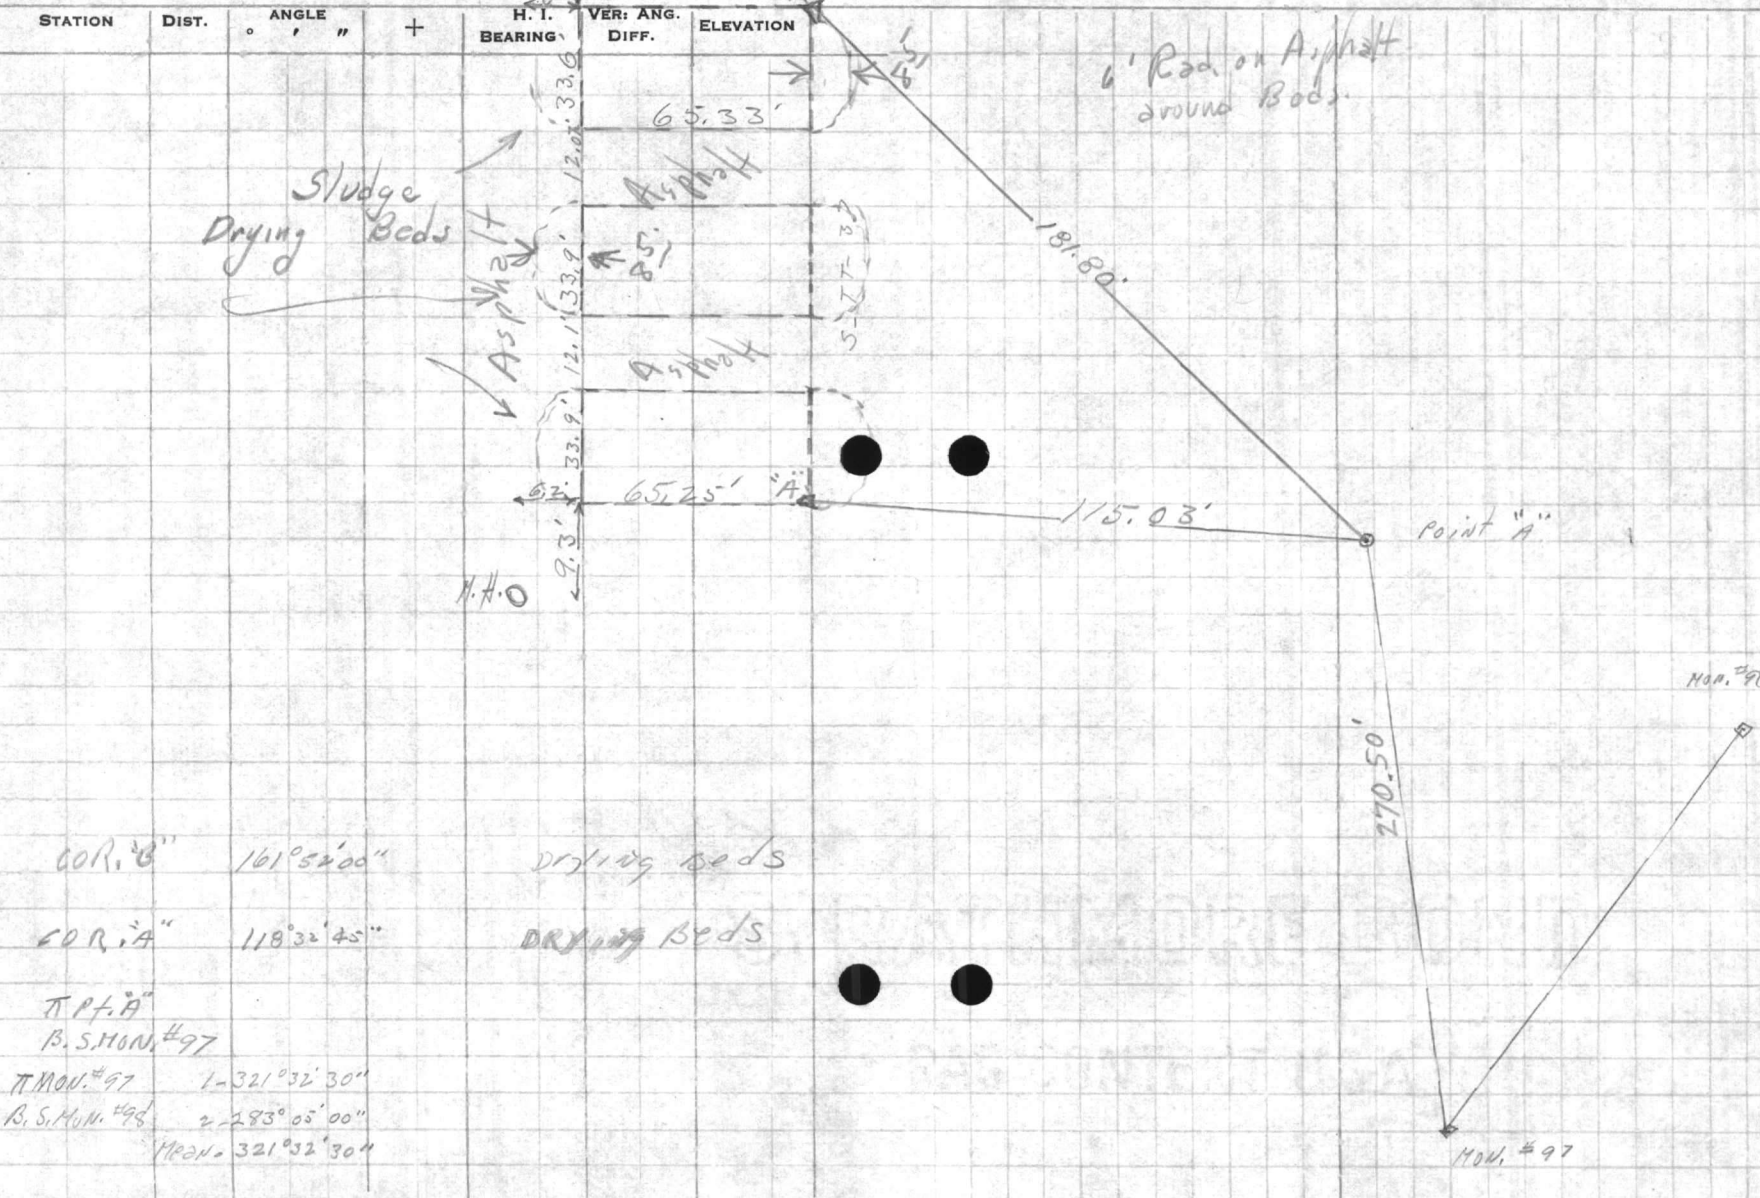

RECEIVED

DATE

BY

NO.

DATE

RECEIVED
DATE
BY



VALUABLE

SUBJECT

Outfall Sewer

RETURN TO
PUBLIC WORKS
OFFICE
CAMP LEJEUNE
NORTH CAROLINA

FIELD PARTY

IN CHARGE

INSTRUMENT

NOTES

TAPE READ

TAPE OR ROD

TAPE OR ROD

INSTRUMENT NO.

TAPE NO.

WEATHER

CLEAR
CLOUDY
WINDY
RAIN
FAIR
SNOW
HOT
MODERATE
COLD
FOG

FILE No. _____

Fldr. No. _____

FIGURED BY _____

NOTES CHECKED BY _____

PLOTTED BY _____

SHEET

4 of


DATE

8-25-1960

Quad. No. _____

STATION	DIST.	ANGLE ° ' "	+	H. I. BEARING	VER. ANG. DIFF.	ELEVATION
---------	-------	----------------	---	------------------	--------------------	-----------

*Northeast
Branch
of
New River*

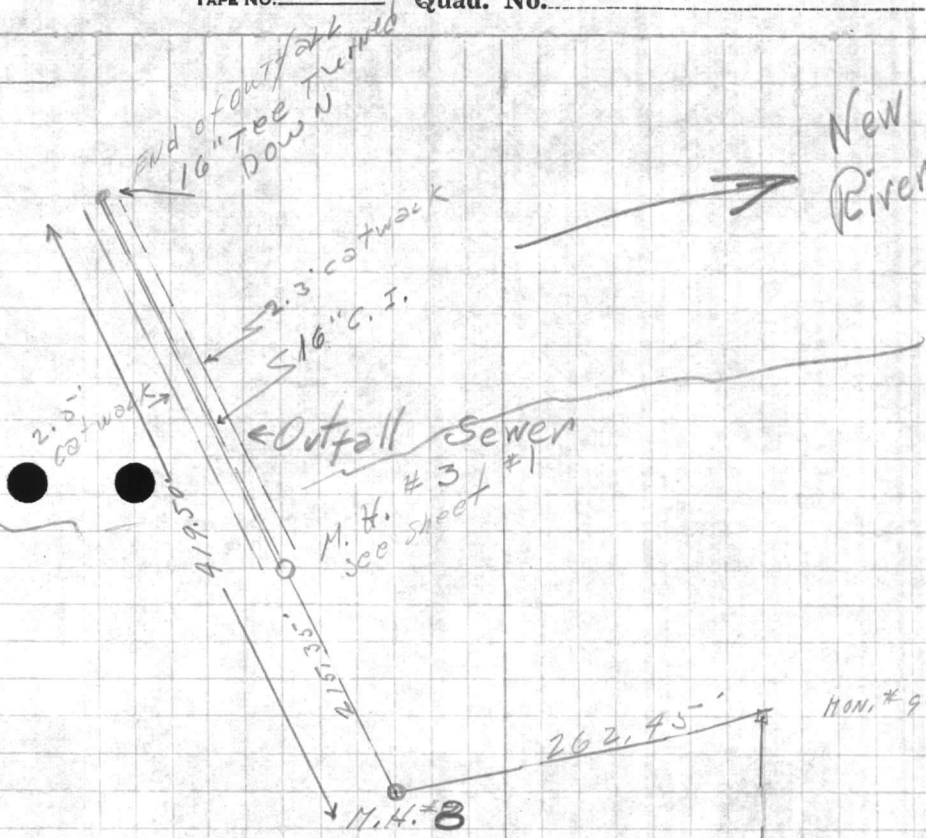

End of outfall *259°38'00"*

*T.M.#7
B.S.#98*

T.M.#98 1-82°31'30"
B.S.#97 2-165°03'15"
T.O.M.#8 MON. 82°31'37"

MON.#98

MON.#97

New River





VALUABLE

SUBJECT Elevations
Sewage Disposal Plant
Tarawa Terrace

RETURN TO
 PUBLIC WORKS
 OFFICE
 CAMP LEJEUNE
 NORTH CAROLINA

FIELD PARTY

____ IN CHARGE
 ____ INSTRUMENT
 ____ NOTES
 ____ TAPE READ
 ____ TAPE OR ROD
 ____ TAPE OR ROD
 ____ INSTRUMENT NO.
 ____ TAPE NO.

WEATHER

CLEAR
 CLOUDY
 WINDY
 RAIN
 FAIR

SNOW
 HOT
 MODERATE
 COLD
 FOG

FILE No. _____
 FLDR. No. 99-X
 SHEET _____
 DATE _____ 19__

FIGURED BY _____
 NOTES CHECKED BY _____
 PLOTTED BY _____
 Quad. No. _____

STATION	DIST.	ANGLE ° ' "	+	H. I. BEARING	VER. ANG. DIFF.	ELEVATION	
B.M.						14.48	Floor Bldg. # TT-36
			5.15	19.63			
①					5.17	14.46	top of secondary settling tanks
②					5.38	14.25	top of Effluent Box
③					5.30	14.33	" " sludge return box
④					2.89	16.74	" " wall outside chlorinating house
⑤					0.19	19.44	" " curbing around trickling filter
B.M.						23.91	spike in power pole near Bldg. TT-35
			10.53	34.44			
⑥					2.95	31.49	top of sludge draw off chamber
⑦					2.54	31.90	top of primary settling tanks
⑧					2.52	31.92	top of trickling filter head box
MON. #97					16.92	22.52 (22.57)	
B.M.					10.53	23.91	spike in pole
B.M.						23.91	spike in pole
			5.24	29.15			
⑨					2.60	26.55	top of grit chamber
⑩					3.62	25.53	top of comminutor
⑪					3.12	26.03	Floor of TT-35
⑫			+		6.40	35.55	top of digester wall

VALUABLE






VALUABLE

SUBJECT

Floor Elevations
Bldg. at Sewage Disposal Field

Tarana Terrace #2

RETURN TO
PUBLIC WORKS
OFFICE
CAMP LEJEUNE
NORTH CAROLINA

FIELD PARTY

Dennis IN CHARGE
INSTRUMENT
NOTES
TAPE READ
TAPE OR ROD
TAPE OR ROD
INSTRUMENT No.
TAPE No.

WEATHER

CLEAR
CLOUDY
WINDY
RAIN
FAIR
SNOW
HOT
MODERATE
COLD
FOG

FILE No. _____

FLDR. No. *99-X*

SHEET _____

NOTES CHECKED BY _____


PLOTTED BY _____


DATE *5/1* 19*59*

Quad. No. _____

STATION	DIST.	ANGLE ° ' "	+	H. I. BEARING	VER: ANG. DIFF.	ELEVATION	
B. m.			5 43	29 34	✓	23 91	✓ SPIKE IN P.P. NEAR TT 35
						3 30 26.04	✓ FLOOR TT-35
T.P			0 16	22 29	✓	7 21 22 13	✓
						7 81 14.48	✓ FLOOR TT-36 3.24
						8 44 13.85	✓ TOP DRYING BED S TT-37
						11 68 10.61	✓ BOTTOM DRYING BED S TT-37
T.P.			7 14	25 76	✓	3 67 18 62	✓
B. m						1 84 23.92	✓ SPIKE IN P.P. NEAR TT-35

60# Pressure

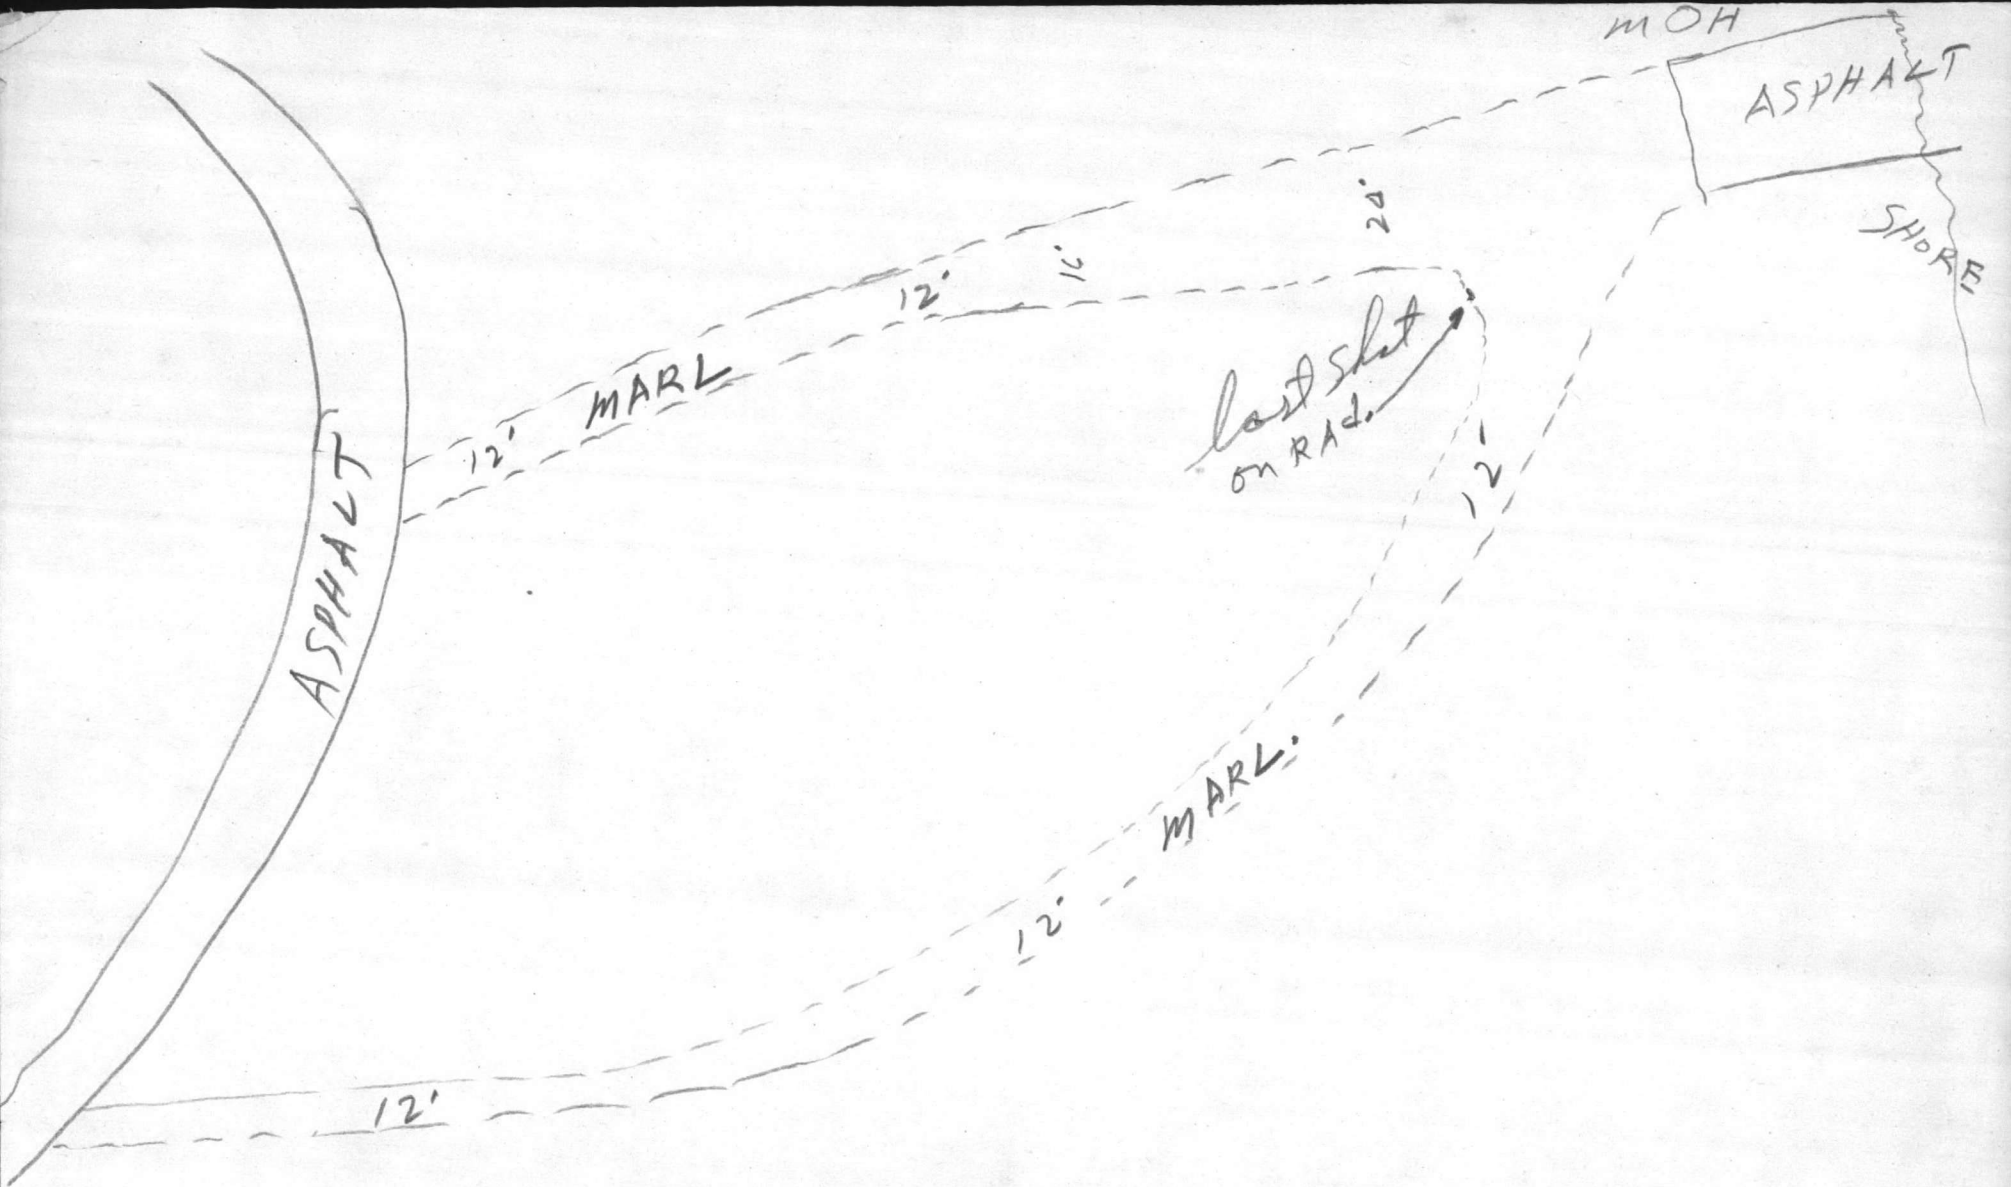

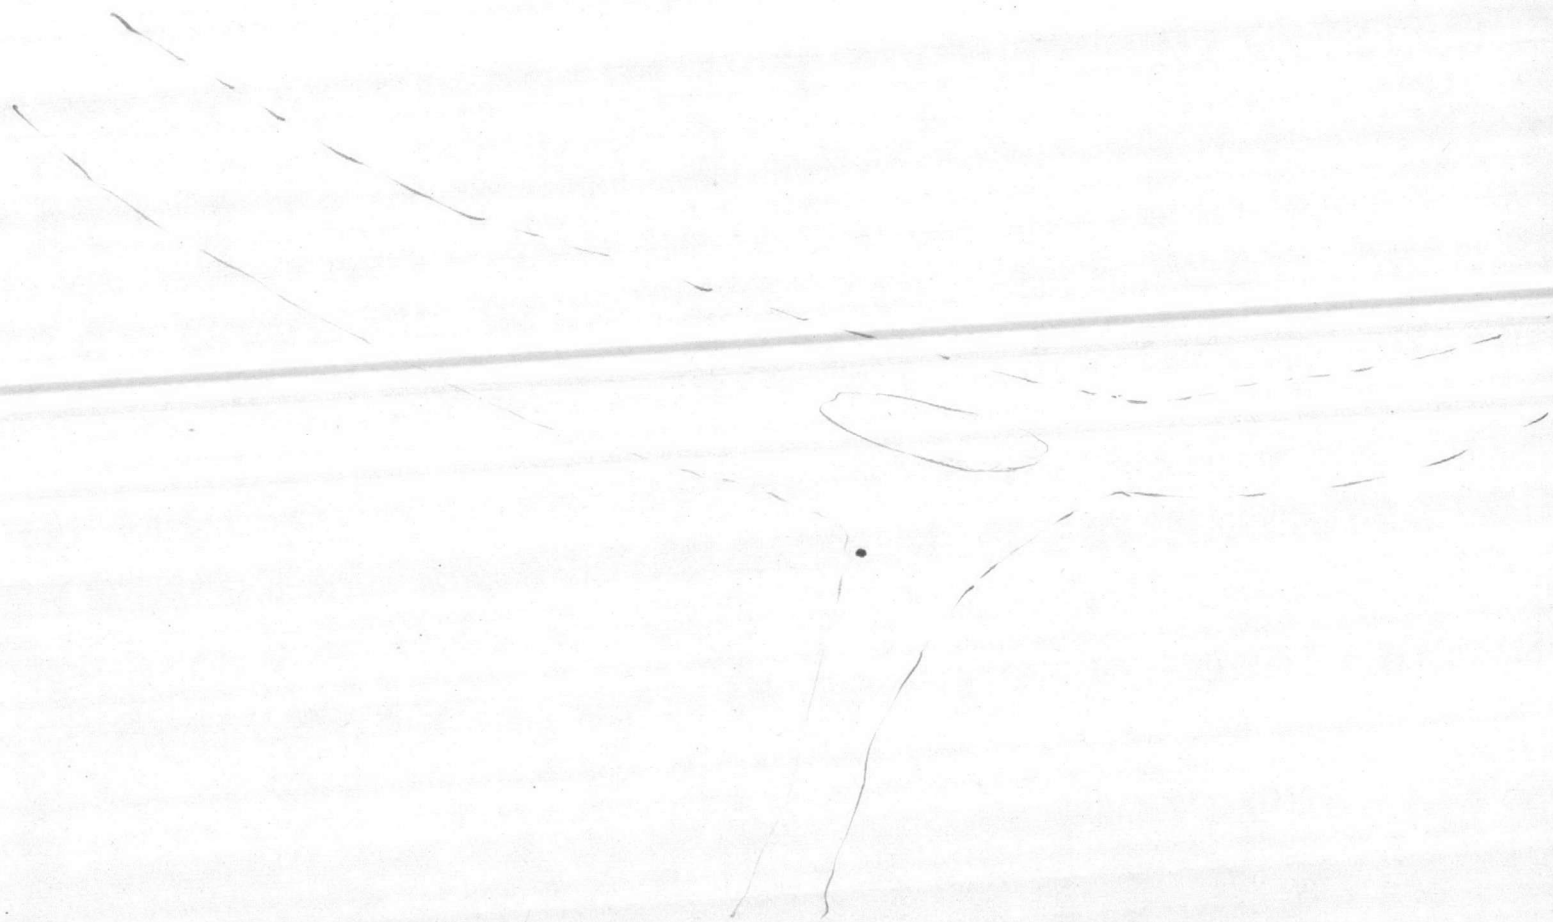

PUBLIC WORKS DEPARTMENT
Camp Lejeune, North Carolina
Survey Department




File _____
Quadrangle _____
Date _____
Sheet 2 of 3


Traverse Computation
Description

Station	Distance	Bearing	Cosine	Sine	Latitude	Departure	Y Coordinate North	X Coordinate East
MON. #97		S 31-13-13 W			TO MON. #98		360,293.86	2,487,218.36
#6 M.H. #4	154.68	S 18-53-17 E	9461529	3237202	146.35	50.07	360,147.51	2,487,268.43
#1 M.H. #5	131.33	S 7-53-43 W	9905208	1373629	130.08	18.04	360,163.78	2,487,200.32
"A" E Digester	211.32	S 18-47-47 E	9466695	3222060	200.05	68.09	360,093.81	2,487,286.45
COR. "B" TT-35	183.65	S 16-51-17 E	9570430	2899460	175.76	53.25	360,118.10	2,487,271.61
COR. "C" TT-35	174.50	S 11-14-02 E	9808401	1948145	171.16	34.00	360,122.70	2,487,252.36
COR. "D" settling tank	255.80	S 6-05-43 W	9943467	1061821	254.35	27.16	360,039.51	2,487,191.20
COR. "E" " "	254.0	S 12-09-13 W	9775867	2105334	248.31	53.48	360,045.55	2,487,164.88
"F" END of CHLORINE TANK	166.0	S 1-53-13 W	9994577	0329274	165.91	5.47	360,127.95	2,487,212.89
"G" " " " "	186.0	S 4-24-43 W	9970267	0769269	185.45	14.31	360,108.41	2,487,204.05
#2 M.H. #6	210.0	S 21-51-43 W	9280838	3723714	194.90	78.20	360,098.96	2,487,140.16
#3 M.H. #7	312.0	S 19-24-40 W	9431582	3323440	294.27	103.69	359,999.59	2,487,114.67
POINT "A"	270.50	S 7-14-17 E	9920312	1259922	268.34	34.08	360,025.52	2,487,252.44



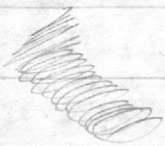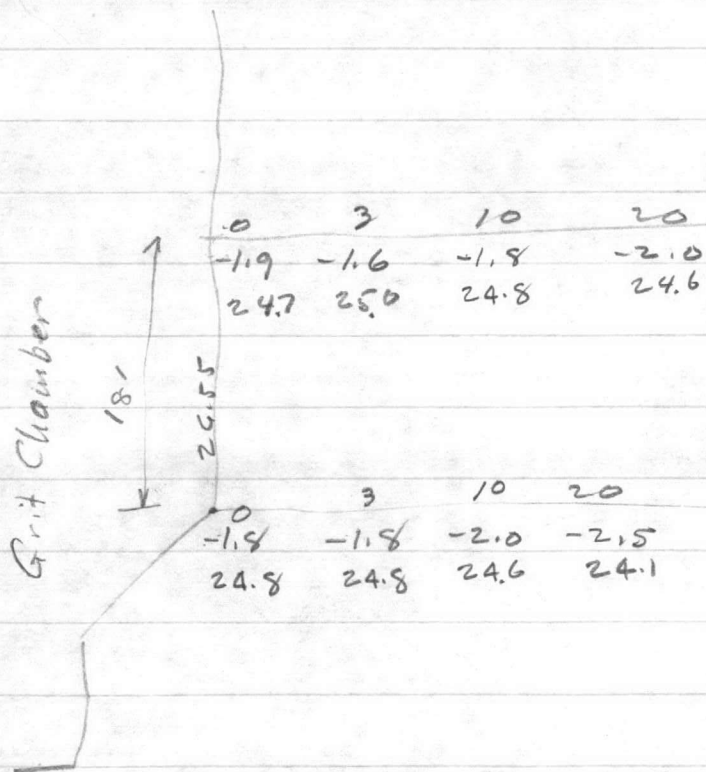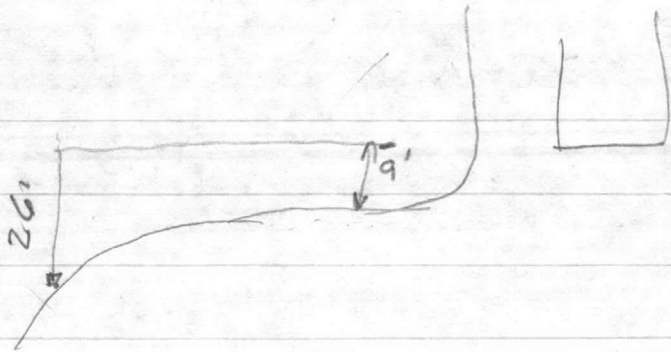

 

VALUABLE

SUBJECT

Floor Elevations

Tarawa Terrace #1

RETURN TO
PUBLIC WORKS
OFFICE
CAMP LEJEUNE
NORTH CAROLINA

FIELD PARTY

____ IN CHARGE
____ INSTRUMENT
____ NOTES
____ TAPE READ
____ TAPE OR ROD
____ TAPE OR ROD
____ INSTRUMENT NO.
____ TAPE NO.

WEATHER

CLEAR _____ SNOW _____
CLOUDY _____ HOT _____
WINDY _____ MODERATE _____
RAIN _____ COLD _____
FAIR _____ FOG _____
FIGURED BY _____
NOTES CHECKED BY _____
PLOTTED BY _____

FILE No. 996en.
FLDR. No. _____
SHEET 12 of
DATE 5-2-59

Quad. No. _____

STATION	DIST.	ANGLE ° ' "	+	H. I. BEARING	VER: ANG. DIFF.	ELEVATION	Fl. Elev.		
				32 ⁸⁴ 33		28.76	29.1	440	STOOP
						28.36	28.7	467	STOOP
						28.36	28.7	469	STOOP
T.P.				C 32 32 ¹⁴ 33		25 ⁸² 27			
						28.97	29.3	464	STOOP
						28.91	29.3	462	STOOP
						28.95	29.3	460	STOOP
						27.76	28.1	451	STOOP
						27.79	28.1	449	STOOP
						27.82	28.2	447	STOOP
						27.80	28.2	445	STOOP
						27.92	28.3	443	STOOP
						27.85	28.2	441	STOOP
B.m.				5 59 31 56		25.97	25.97		
B.m.						26.06	25.97		
						26.87	27.2	428	STOOP
						26.96	27.3	414	STOOP
						27.80	28.2	433	STOOP
						27.58	27.9	423	STOOP
T.P.				C 41 30.96		24.55			
						26.94	26.9	411	FLOOR
						26.12	26.5	403	STOOP

Add 0.35 for Floor above stoop elev.

ON CURB & WALK LEADING TO 451

SPIKE IN P.D. ON CURB NEAREST 440

ON CURB & WALK LEADING TO 410

1941

OFFICE
DATE
BY

VERB AND
BEARING



VALUABLE

SUBJECT _____

RETURN TO
PUBLIC WORKS
OFFICE
CAMP LEJEUNE
NORTH CAROLINA

FIELD PARTY

IN CHARGE

INSTRUMENT

NOTES

TAPE READ

TAPE OR ROD

TAPE OR ROD

INSTRUMENT No.

TAPE No.

WEATHER

CLEAR
CLOUDY
WINDY
RAIN
FAIR
SNOW
HOT
MODERATE
COLD
FOG
FIGURED BY _____
NOTES CHECKED BY _____
PLOTTED BY _____

FILE No. _____
FLDR. No. _____
SHEET 130
DATE _____ 19__

Quad. No. _____

STATION	DIST.	ANGLE ° ' "	+	H. I. BEARING	VER. ANG. DIFF.	ELEVATION		
				3096	✓		Fl. Elev.	
				357				
				499		25.97	26.0	373 STOOD
				432		26.64	27.0	373 FLOOR
				364		27.32	27.7	396 STOOD
				393		27.03	27.8	388 STOOD
								380 STOOD
T.P.				733	✓	23.63		ON CURB & WALK LEADING TO 372
				699	30	62		
				368		26.94	27.3	364 STOOD
				293		27.69	28.0	352 STOOD
				368				
				161		29.01	29.0	340 STOOD
				392		27.70	28.0	340 FLOOR
						26.70	27.0	328 STOOD
T.P.				715	✓	23.47		ON CURB EAST EDGE WALK LEADING TO 367, 365
				482	28	39		363 & 361
				311		25.18	25.5	361 STOOD
				376		24.53	24.9	313 STOOD
				427		24.02	24.4	312 STOOD
				409		24.20	24.5	305 STOOD
B.m.				473	✓	23.56	23.57	SPIKE IN P.P. COR. TARA WA BLVD. PELELIU DR. NEAREST
				328	26	27		MAINT. BLDG.
				075		26.10	26.4	137 STOOD
				081		26.04	26.4	139 STOOD
				179	5.06	25.89	25.4	141 ✓
B.m.				596	20.78	20.88	MON # 153	

VALUABLE

SUBJECT _____

RETURN TO
 PUBLIC WORKS
 OFFICE
 CAMP LEJEUNE
 NORTH CAROLINA

FIELD PARTY

 IN CHARGE

 INSTRUMENT

 NOTES

 TAPE READ

 TAPE OR ROD

 TAPE OR ROD

 INSTRUMENT NO. _____
 TAPE NO. _____

WEATHER

CLEAR
 CLOUDY
 WINDY
 RAIN
 FAIR
 SNOW
 HOT
 MODERATE
 COLD
 FOG
 FIGURED BY _____
 NOTES CHECKED BY _____
 PLOTTED BY _____

FILE No. _____
 FLDR. No. _____
 SHEET 14 of _____
 DATE _____ 19__

Quad. No. _____

STATION	DIST.	ANGLE " "	+	H. I. BEARING	VER. ANG. DIFF.	ELEVATION		
B.m.				864 29.52	✓	<u>20.88</u> Elev.	MON. # 153	
						4.78 24.74 25.1	201	STOOD
						4.14 25.38 25.7	200	STOOD
						5.46 24.06 24.4	170	STOOD
						3.06 26.46 26.8	149	STOOD
						0.72 28.80 29.1	161	STOOD
						2.74 26.78 27.1	173	STOOD
						3.63 25.89 26.2	174	STOOD
T.P.				790 27.54	✓	8.88 19.64		TOP STEP LEADING TO 176
						1.55 25.99 26.3	181	STOOD
						3.08 24.46 24.8	190	STOOD
						1.57 25.97 26.3	1501	STOOD
						1.55 25.99 26.3	1518	STOOD
						4.69 22.85 23.2	1500	STOOD
						7.02 20.52 20.9	189	STOOD
B.m.				583 24.54	✓	8.83 18.71 <u>18.71</u> SPIKE IN P.P. NEAR		1500
						1.94 22.60 23.0	197	STOOD
						0.91 23.63 24.0	209	STOOD
						5.37 19.17 19.17 WATER PLANT TT.	38	FLOOR
						0.10 24.44 24.8	204	STOOD
						3.90 20.64 21.0	218	STOOD
B.m.				4.88 22.34	✓	<u>17.46</u> 2.09 17.45 <u>17.47</u> SPIKE IN P.P.		215
						1.50 20.84 21.2	217	STOOD







11.09

VALUABLE

SUBJECT _____

RETURN TO
 PUBLIC WORKS
 OFFICE
 CAMP LEJEUNE
 NORTH CAROLINA

FIELD PARTY

 IN CHARGE

 INSTRUMENT

 NOTES

 TAPE READ

 TAPE OR ROD

 TAPE OR ROD

 INSTRUMENT NO. _____
 TAPE NO. _____

WEATHER

CLEAR _____
 CLOUDY _____
 WINDY _____
 RAIN _____
 FAIR _____
 SNOW _____
 HOT _____
 MODERATE _____
 COLD _____
 FOG _____
 FIGURED BY _____
 NOTES CHECKED BY _____
 PLOTTED BY _____

FILE No. _____
 FLDR. No. _____
 SHEET 15 of
 DATE _____ 19__

Quad. No. _____

STATION	DIST.	ANGLE ° ' "	+	H. I. BEARING	VER: ANG. DIFF.	ELEVATION		
T.P.				22 ³⁴ 35		16.52	Fl. Elev.	
				135	82	16.52		TOP STEP WALK LEADING TO 219
	3.01			20 14				
						462	15.51	15.9
						179	18.34	18.7
						176	18.37	18.7
						088	19.25	19.6
						200	18.13	18.5
B.M.				59	5.90	14.24	14.20	SPIKE IN
	4.39	18						229 & 231
						306	15.53	15.9
						085	17.74	18.1
						208	16.51	16.9
T.P.				45	5.35	13.24		TOP STEP LEADING TO 253
	11.46	24						
						172	22.97	23.3
						159	23.10	23.5
T.P.				765	10.06	14.63		TOP STEP WALK LEADING TO 250
	11.46	22						
						050	21.78	22.1
						459	17.69	18.0
						569	16.59	16.9
						573	16.55	16.9
T.P.				15.99	11.13	11.15		ON CURB DRAIN BETWEEN 263 & 1146
	4.04							
B.M.				4.00		11.99	11.98	(11.99) SPIKE IN P.D. 1143 & 1145



























VALUABLE

SUBJECT _____

RETURN TO
 PUBLIC WORKS
 OFFICE
 CAMP LEJEUNE
 NORTH CAROLINA

FIELD PARTY

 IN CHARGE

 INSTRUMENT

 NOTES

 TAPE READ

 TAPE OR ROD

 TAPE OR ROD

 INSTRUMENT NO. _____
 TAPE NO. _____

WEATHER

CLEAR
 CLOUDY
 WINDY
 RAIN
 FAIR
 SNOW
 HOT
 MODERATE
 COLD
 FOG
 FIGURED BY _____
 NOTES CHECKED BY _____
 PLOTTED BY _____

FILE No. _____
 FLDR. No. _____
 SHEET 16 of
 DATE _____ 19__

Quad. No. _____

STATION	DIST.	ANGLE ° ' "	+	H. I. BEARING	VER. ANG. DIFF.	ELEVATION	Pl. Elev.		
B. m.				230 19. 76		17. 77	17.46	SPIKE IN P.D.	215
T. P.				987 27. 68	.67 96	17. 80		ON CURB & WALK LEADING TO 802	
						C 34 21.33	21.7		804 STOOD P
						4 95 22.72	23.1		812 STOOD P
						2 98 24.69	25.0		818 STOOD P
						2 16 25.51	25.9		820 STOOD P
						2.14 25.53	25.9		826 STOOD P
						2.01 25.66	26.0		828 STOOD P
						2.25 25.42	25.8		829 STOOD P
						1.60 26.07	26.4		823 STOOD P
						4.52 23.15	23.5		809 STOOD P
						23 26.4	26.4		821 STOOD P
B. m.				157 28. 80	78	0 44 27. 31	25.9	BACK BOLT (TOP)	FIRE HYD. NEAR 832
						3 15 25.63	26.0		797 STOOD P
						3 22 25.56	25.9		840 STOOD P
						3 44 25.14	25.5		833 STOOD P
						3 93 24.85	25.2		837 STOOD P
						3 93 24.85	25.2		851 STOOD P
						3 88 24.90	25.2		857 STOOD P
						4 14 24.64	25.0		865 STOOD P
						4 23 24.55	24.9		856 STOOD P
						4 42 24.36	24.7		864 STOOD P
B. m.				5.07 23. 74	.73	23.70		SPIKE IN P.D.	596 & 594
B. m.				255 29. 76		27. 24	21	BACK BOLT FIRE HYD.	NEAR BLDG. # 832
						4 71 25.05	25.4		200 STOOD P
						4 09 25.67	26.0		784 STOOD P












1/2

VALUABLE

SUBJECT _____

 RETURN TO
 PUBLIC WORKS
 OFFICE
 CAMP LEJEUNE
 NORTH CAROLINA

FIELD PARTY

 IN CHARGE

 INSTRUMENT

 NOTES

 TAPE READ

 TAPE OR ROD

 TAPE OR ROD

 INSTRUMENT NO. _____
 TAPE NO. _____

WEATHER

CLEAR
 CLOUDY
 WINDY
 RAIN
 FAIR
 SNOW
 HOT
 MODERATE
 COLD
 FOG
 FIGURED BY _____
 NOTES CHECKED BY _____
 PLOTTED BY _____

FILE No. _____
 FLDR. No. _____
 SHEET 12 of
 DATE _____ 19__

Quad. No. _____

STATION	DIST.	ANGLE ° ' "	+	H. I. BEARING	VER: ANG. DIFF.	ELEVATION			
				29 26			Fl. Elev.		
					3 75	26.01	26.4	795	STOOD
					3 76	26.00	26.4	785	STOOD
					2 68	27.08	27.4	779	STOOD
T.P.				4 38	25. 38				
	554	30							ON CURB & WALK LEADING TO 736 & 762
					3 72	27.22	27.6	767	STOOD
					3 35	27.59	27.9	751	STOOD
					3 49	27.45	27.8	747	STOOD
					2 59	28.35	28.7	750	STOOD
					2 94	28.00	28.4	742	STOOD
					4 05	26.89	27.2	733	STOOD
T.P.				4 08	24. 87				ON CURB & WALK LEADING TO 724
	451	29							
					4 42	24.96	25.3	723	STOOD
					7			709	STOOD
					3 91	25.47	25.5	709	FLOOR
					1 72	27.66	28.0	708	STOOD
					1 71	27.67	28.0	720	STOOD
					8 51	.84			
B.m.				5 08	19 28	20. 87	20.88		
B.m.						19.24	14.20		MON. #153 SPIKE IN BP. NEAR 229 & 231
T.P.				9 45	22 22	25.1			TOP STEP LEADING IN BLDG. # 1444
					3 66	22.56	22.9	1431	STOOD
					5 42	20.80	21.2	1442	STOOD
					2 59	23.63	24.0	1418	STOOD








VALUABLE

SUBJECT _____

RETURN TO
 PUBLIC WORKS
 OFFICE
 CAMP LEJEUNE
 NORTH CAROLINA

FIELD PARTY

 IN CHARGE

 INSTRUMENT

 NOTES

 TAPE READ

 TAPE OR ROD

 TAPE OR ROD

 INSTRUMENT NO. _____
 TAPE NO. _____

WEATHER

CLEAR
 CLOUDY
 WINDY
 RAIN
 FAIR
 SNOW
 HOT
 MODERATE
 COLD
 FOG
 FIGURED BY _____
 NOTES CHECKED BY _____
 PLOTTED BY _____

FILE No. _____
 FLDR. No. _____
 SHEET 18 of _____
 DATE _____ 19__

Quad. No. _____

STATION	DIST.	ANGLE ° ' "	+	H. I. BEARING	VER. ANG. DIFF.	ELEVATION	
T.P.				24 22 28.96	3 39	22.83 27.00	ON CURB & WALK LEADING TO 1374
						4 11 24.85 25.2	14 19 STOOD
						2 9 2 26.04 26.4	14 11 STOOD
						5 9 5 23.01 23.4	13 9 9 STOOD
						2 5 5 26.41 26.8	18 8 7 STOOD
						2 2 4 26.72 27.1	13 2 5 STOOD
T.P.	5/14/59			28 81 5.54	5 6 9	23.27 27	ON CURB & WALK LEADING TO 1372
						2 5 8 26.23 26.6	13 6 4 STOOD
						2 9 4 25.87 26.2	13 6 4 FLOOR
						3 2 2 25.59 25.9	13 5 2 STOOD
						3 7 4 25.07 25.4	13 6 3 STOOD
						4 3 7 24.44 24.8	13 5 1 STOOD
							13 4 4 STOOD
T.P.				28 42 5.54	5 9 3	22.88 22	ON CURB & WALK LEADING TO 1328
						2 6 1 25.81 26.2	13 3 9 STOOD
						2 3 4 26.08 26.4	13 2 7 STOOD
						3 7 0 24.72 25.1	13 2 3 STOOD
T.P.				25.97 2.09	4 5 4	23.88 26.01	TOP STEP WALK LEADING TO 1549 & 1551
B.m.				4 8 1	21.16 21.18		BACK BOLT FIRE HXW NEAR 1026




























VALUABLE

SUBJECT _____

RETURN TO
 PUBLIC WORKS
 OFFICE
 CAMP LEJEUNE
 NORTH CAROLINA

FIELD PARTY

 IN CHARGE

 INSTRUMENT

 NOTES

 TAPE READ

 TAPE OR ROD

 TAPE OR ROD

 INSTRUMENT NO. _____
 TAPE NO. _____

WEATHER

CLEAR _____ SNOW _____
 CLOUDY _____ HOT _____
 WINDY _____ MODERATE _____
 RAIN _____ COLD _____
 FAIR _____ FOG _____
 FIGURED BY _____
 NOTES CHECKED BY _____
 PLOTTED BY _____

FILE No. _____
 FLDR. No. _____
 SHEET 19 of
 DATE 5-8-59

Quad. No. _____

STATION	DIST.	ANGLE " "	+	H. I. BEARING	VER: ANG. DIFF.	ELEVATION		
B.m.			6 58	27.76	✓	21.18	✓	BACKBOLT FIREHYD 1026
T.P.			5.09	28.82	✓	4.03	23.73	✓ TOP STEP WALK LEADING TO 1547
						4.00	24.82	25.2 1322 STOOP
						2.50	26.32	26.7 1545 STOOP
						3.18	25.64	26.0 1533 STOOP
						3.27	25.55	25.9 1538 STOOP
T.P.			5.88	30.68	✓	4.02	24.80	✓ ON CURB & WALK LEADING TO 1529
						4.42	26.26	26.6 1530 STOOP
						3.40	27.08	27.4 1521 STOOP
						3.51	27.17	27.5 1505 STOOP
T.P.			3.75	23.80	✓	10.63	20.05	✓ ON CURB & WALK LEADING TO 1500
B.m.						5.08	18.72	(18.70) SPIKE IN P.P. 1500
B.m.			6 66	34.42	✓	27.76	✓	SPIKE IN P.P. NEAR BLDG # 913
						4.99	30.3	1216
						3.12	29.43	29.8 1200 STOOP
						3.98	31.30	31.7 1201 STOOP
						4.51	30.44	30.8 1204 STOOP
							29.91	30.3 1212 STOOP
T.P.			5 27	33.13	✓	12 6 56	27.86	016 ON CURB & WALK LEADING TO 1212

29.91
 30.20













VALUABLE

SUBJECT _____

RETURN TO
PUBLIC WORKS
OFFICE
CAMP LEJEUNE
NORTH CAROLINA

FIELD PARTY

IN CHARGE

INSTRUMENT

NOTES

TAPE READ

TAPE OR ROD

TAPE OR ROD

INSTRUMENT NO.

TAPE NO. _____

WEATHER

CLEAR
CLOUDY
WINDY
RAIN
FAIR
SNOW
HOT
MODERATE
COLD
FOG
FIGURED BY _____
NOTES CHECKED BY _____
PLOTTED BY _____

FILE No. _____
FLDR. No. _____
SHEET 200f
DATE _____ 19__

Quad. No. _____

STATION	DIST.	ANGLE ° ' "	+	H. I. BEARING	VER: ANG. DIFF.	ELEVATION		
				3372 2313				
				33.12	1 81	31.31	31.7	1 205 STOODP
					3 33	29.79	30.1	1 213 STOODP
					3 20	29.92	30.2 30.3	1 222 STOODP
					3 58	29.54	29.9	1 224 STOODP
					3 58	29.54	29.9	1 234 STOODP
					3 40	29.72	30.1	1 236 STOODP
					3 96	29.16 27.98	29.5	1 239 STOODP
T.P.				46 5.12	10 01.032			TOP STEP WALK LEADING TO 1239
				348 31 49				27.8 → 1283
					3 46	28.00	28.4	1 247 STOODP
					2 18	29.28	29.6	1 255 STOODP
					1 79	29.67	28.2 30.0	1 263 STOODP
					2 39	29.07	29.4	1 275 STOODP
					4 02	27.44	27.8	1 285 STOODP
					2 98	28.48	28.8	1 292 STOODP
					2 93	28.53	28.9	1 254 STOODP
						28 28.9		← Same
T.P.				37 5.09 30 42	16 25 33	25.048		ON CURB @ WALK LEADING TO 1296 & 1298
					2 94	27.43	27.8	1 296 STOODP
					3 53	26.84	27.2	1 299 STOODP
					3 89	26.48	26.8	1 311 STOODP
					4 01	26.36	26.7	1 319 STOODP
					3 49	26.88	27.2	1 304 STOODP
T.P.				445 28.79	6.28	24.44	24.004	ON CURB LEADING TO 1310
					2 24	26.55	26.9	1 312 STOODP
B.m.					7 53	21.26	21.21	BACKBOLT FIREHYD. NEAR 1028

VALUABLE

SUBJECT _____

RETURN TO
PUBLIC WORKS
OFFICE
CAMP LEJEUNE
NORTH CAROLINA

FIELD PARTY

IN CHARGE

INSTRUMENT

NOTES

TAPE READ

TAPE OR ROD

TAPE OR ROD

INSTRUMENT NO.

TAPE NO. _____

WEATHER

CLEAR SNOW
CLOUDY HOT
WINDY MODERATE
RAIN COLD
FAIR FOG
FIGURED BY _____
NOTES CHECKED BY _____
PLOTTED BY _____

FILE No. _____
FLDR. No. _____
SHEET 21 of
DATE _____ 19__

Quad. No. _____

STATION	DIST.	ANGLE ° ' "	H. I. BEARING	VER. ANG. DIFF.	ELEVATION	
B.M.			390 27 47		23 57	SPIKE IN P.P. COR TARAWA BLVD. & PELELIU DR. NEAREST MAINT. BLDG. # TT 42
				4 12 23 35	23.35	TT 42 FLOOR





























99-Gen

VALUABLE

SUBJECT Floor Elevations at
Torawa Terrace.

RETURN TO
PUBLIC WORKS
OFFICE
CAMP LEJEUNE
NORTH CAROLINA

outlying Well Houses

FIELD PARTY

IN CHARGE

INSTRUMENT

NOTES

TAPE READ

TAPE OR ROD

TAPE OR ROD

INSTRUMENT NO.

TAPE NO.

WEATHER

CLEAR _____
CLOUDY _____
WINDY _____
RAIN _____
FAIR _____
SNOW _____
HOT _____
MODERATE _____
COLD _____
FOG _____

FILE No. 99

FLDR. No. _____

FIGURED BY _____ SHEET 1-of-1

NOTES CHECKED BY _____

PLOTTED BY _____ DATE 6-4 1959

Quad. No. _____

STATION	DIST.	ANGLE " "	+	H. I. BEARING	VER: ANG. DIFF.	ELEVATION	
B.M.			3.20	28.49	✓	25.29	MON # 84
T.P.				4.30		24.19	
			3.50	27.69		90	
B.M. (T.P.)				3.77	✓	23.92	SPIKE IN 12" PINE 25' SOUTH FROM WELL HOUSE NO. <u>45</u> WELL HOUSE LOCATED 200' SOUTH OF E HI-WAY #24 AND APPROX. 1000' WEST OF N.B. R.R. (<u>WGT = 5</u>) #45
			3.42	27.34	✓		
T.P.				3.20	✓	24.14	
			5.10	29.24			
				3.91	✓	25.33	MON # 84

(25.29)




VALUABLE

SUBJECT Floor Elevations
Torawa Terrace #2

RETURN TO
 PUBLIC WORKS
 OFFICE
 CAMP LEJEUNE
 NORTH CAROLINA

FIELD PARTY
DENNIS IN CHARGE
MORTON INSTRUMENT

NOTES
 TAPE READ
 TAPE OR ROD
 TAPE OR ROD
 INSTRUMENT NO.
 TAPE NO.

WEATHER
 CLEAR
 CLOUDY
 WINDY
 RAIN
 FAIR

SNOW
 HOT
 MODERATE
 COLD
 FOG

FIGURED BY
 NOTES CHECKED BY
 PLOTTED BY

FILE No. _____
 FLDR. No. _____
 SHEET 1 of 1
 DATE 6-9 1959

Quad. No. _____

STATION	DIST.	ANGLE ° ' "	+	H. I. BEARING	VER. ANG. DIFF.	ELEVATION	
B.m.				656 29.05	✓	22.49	✓ MON. # 155
				—————		3.88 25.17	✓ ——— FLOOR T.T. 43
T.P.				608 29.91	✓	5.22 23.83	✓
				—————		3.94 25.97	————— TT - 2477
B.m.						637 23.54	✓ 23.55 MON. # 154



PRESSURE
DIRECTION
SPEED
STATE



VALUABLE

SUBJECT BENCH MARKS ON
BOUGAINVILLE DR. TARRAWA
TERRACE #2

RETURN TO
PUBLIC WORKS
OFFICE
CAMP LEJEUNE
NORTH CAROLINA

FIELD PARTY

IN CHARGE

INSTRUMENT

NOTES

TAPE READ

TAPE OR ROD

TAPE OR ROD

INSTRUMENT NO.

TAPE NO.

WEATHER

CLEAR
CLOUDY
WINDY
RAIN
FAIR
SNOW
HOT
MODERATE
COLD
FOG
FIGURED BY _____
NOTES CHECKED BY _____
PLOTTED BY _____

FILE No. _____
FLDR. No. _____
SHEET 11 of 1
DATE 6-2 1959

Quad. No. _____

STATION	DIST.	ANGLE ° ' "	+	H. I. BEARING	VER. ANG. DIFF.	ELEVATION	
B. m.			5 00	30 55		25 55 ✓	SPIKE IN P.P. NEAR ST. IN FRONT 2006
B. m.			3 76	30 64	3 67	26 88 0025	SPIKE IN P.P. NEAR ST. NEAR 2534
B. m.			4 34	29 90	5 08	25 56 25 55 0050	SPIKE IN P.P. NEAR ST. NEAREST 2588 & 2586
B. m.			3 10	27 71	5 29	24 60 24 60 0075	SPIKE IN P.P. NEAR ST. NEAREST 2648
B. m.			4 72	30 40	2 03	25 68 25 67 0100	SPIKE IN P.P. NEAR ST. NEAREST 2707
B. m.			3 67	28 88	5 19	25 21 25 20 0125	SPIKE IN P.P. NEAR ST. (ON COR) NEAREST 2753
B. m.			3 65	27 00	5 53	23 35 23 33 0150	SPIKE IN P.P. NEAR ST. BETWEEN 2808 & 2824
B. m.			5 14	27 48	4 66	22 34 22 32 0175	SPIKE IN P.P. NEAR ST. (ON COR) NEAREST 2880 & 2882
B. m.			3 35	24 13 24 11 (24 11) ✓			SPIKE IN P.P. NEAR ST. NEAREST 2442 & 2244

8 1.02
10025

23.74
 0.93
 29.67
 61.29
 23.36

23.35
 5.60
 28.95
 51.2
 23.73

28.95
 23.74
 25.21

C1055

115
 2105730
 4215500
 350
 2151

442031115

VALUABLE

RETURN TO
PUBLIC WORKS
OFFICE
CAMP LEJEUNE
NORTH CAROLINA

SUBJECT Bench Levels for
Well House Floor Elev.
Tarawa Terrace
Outlying Wells

FIELD PARTY
D _____ IN CHARGE
_____ INSTRUMENT
_____ NOTES
_____ TAPE READ
_____ TAPE OR ROD
_____ TAPE OR ROD
_____ INSTRUMENT NO.
_____ TAPE NO.

WEATHER
CLEAR _____ SNOW _____
CLOUDY _____ HOT _____
WINDY _____ MODERATE _____
RAIN _____ COLD _____
FAIR _____ FOG _____
FIGURED BY _____
NOTES CHECKED BY _____
PLOTTED BY _____

FILE No. _____
FLDR. No. _____
SHEET 1 of 1
DATE 6-4 1959

Quad. No. _____

STATION	DIST.	ANGLE ° ' "	+	H. I. BEARING	VER; ANG. DIFF.	ELEVATION	NOTES
B.m.				5 52 31.07	✓	25.55 ✓	SPIKE IN P.P. NEAR ST. FRONT 200L
B.m.				3 28 31.13	✓	3 22 27.85 ✓	SPIKE IN 14' PINE BETWEEN 2001 & R.R. TRACK & WELL # 77-28
B.m.					✓	5 58 25.55 (25.55) ✓	SPIKE IN P.P. NEAR ST FRONT 220L

VALUABLE

SUBJECT Bench Mark for
Well House TT-27
Outlying wells

RETURN TO
 PUBLIC WORKS
 OFFICE
 CAMP LEJEUNE
 NORTH CAROLINA

FIELD PARTY
Dennis IN CHARGE
MORTON INSTRUMENT
 NOTES
 TAPE READ
 TAPE OR ROD
 TAPE OR ROD
 INSTRUMENT NO.
 TAPE NO.

WEATHER
 CLEAR
 CLOUDY
 WINDY
 RAIN
 FAIR
 SNOW
 HOT
 MODERATE
 COLD
 FOG
 FIGURED BY
 NOTES CHECKED BY
 PLOTTED BY

FILE No. _____
 FLDR. No. _____
 SHEET 1 of 1
 DATE 6-4 1959

Quad. No. _____

STATION	DIST.	ANGLE ° ' "	+	H. I. BEARING	VER: ANG. DIFF.	ELEVATION	
B.m.				3,59 28.70		24.47	SPIKE IN P.P. NEAR ST- FRONT 2648
T.P.				791 30.60	70 5 41	22.69	
T.P.				427 30.57	67 4 30	26.30	
T.P.				5,40 32.75	85 3 22	27.35	
B.m.				547 31.98	29 31	26.21	SPIKE P.P. (TRANSFORMER) pole NEAR TT-27
T.P.				3.66 31.03	55 1 26	26.47	
T.P.				3.55 28.66	55 1 27	27.37	
T.P.				3.55 29.56	50 2 25	25.11	
B.m.				508 24.18	50 2 26	24.04	
					23 58	23.54	MON # 154

2956
 2354
 602










22/70c
3

VALUABLE

SUBJECT FLOOR ELEVATIONS
Torawa Terrace #2

RETURN TO
PUBLIC WORKS
OFFICE
CAMP LEJEUNE
NORTH CAROLINA

FIELD PARTY
DEYHIS IN CHARGE
MORTON INSTRUMENT
NOTES
TAPE READ
TAPE OR ROD
TAPE OR ROD
INSTRUMENT NO.
TAPE NO.

WEATHER
CLEAR
CLOUDY
WINDY
RAIN
FAIR
SNOW
HOT
MODERATE
COLD
FOG
FIGURED BY
NOTES CHECKED BY
PLOTTED BY

FILE No. _____
FLDR. No. _____
SHEET 1 of 2
DATE 6-4-59

Quad. No. _____

STATION	DIST.	ANGLE " +	H. I. BEARING	VER. ANG. DIFF.	ELEVATION	Notes
B.M.		4 13	30 24		26 11	Stoop Floor Elev. ✓
				5 97		
				5 57	24.67	
				5 40	24.84	25.19
T.P.		✓ 64	30 23	95	24.007	ON CURB & WALK LEADING TO 2910
		5 69	29 53			
				3 55	26.09	26.44
				3 62	26.02	26.27
				4 18	25.46	25.81
				3 72	25.92	26.27
T.P.		✓ 97	4 69	95	24.014	ON CURB (EAST) WEST DR. TO T.T. SCHOOL
		6 02	30 52			
				4 85	26.12	26.47
				4 45	26.52	26.87
				4 54	26.43	26.78
				5 19	25.78	26.13
				4 95	26.02	26.37
				4 75	26.22	26.57
				5 05	25.92	26.27
T.P.		✓ 15	6 24	74	24.020	ON CURB & WALK LEADING TO 2996
		5 41	30 13			
				4 48	25.67	26.02
				4 95	25.19	25.54
				5 12	25.03	25.38
				4 73	25.42	25.77
				4 57	25.58	25.93
				4 51	25.64	25.99

Add 0.35 to Stoop for Floor
BACK BOLT FIRE HYD. NEAR ST. Bldg. # 2201

2904 } STOOP
2904 } FLOOR .40
2908 } STOOP

2909 } STOOP
2921 } STOOP
2920 } STOOP
2928 } STOOP

2927 } STOOP
2941 } STOOP
2949 } STOOP
2961 } STOOP
2973 } STOOP
2985 } STOOP
2994 } STOOP

2997 } STOOP
3013 } STOOP
3025 } STOOP
3018 } STOOP
3008 } STOOP
3006 } STOOP

VALUABLE

SUBJECT _____

RETURN TO
 PUBLIC WORKS
 OFFICE
 CAMP LEJEUNE
 NORTH CAROLINA

FIELD PARTY

 IN CHARGE

 INSTRUMENT

 NOTES

 TAPE READ

 TAPE OR ROD

 TAPE OR ROD

 INSTRUMENT NO. _____
 TAPE NO. _____

WEATHER

CLEAR
 CLOUDY
 WINDY
 RAIN
 FAIR

SNOW
 HOT
 MODERATE
 COLD
 FOG

FILE No. _____
 FLDR. No. _____
 SHEET 2 of 2
 DATE 6-4-59

FIGURED BY _____
 NOTES CHECKED BY _____
 PLOTTED BY _____
 Quad. No. _____

STATION	DIST.	ANGLE ° ' "	+	H. I. BEARING	VER. ANG. DIFF.	ANG. DIFF.	ELEVATION	STOOP FLOOR Elev.	STATION	STOOP
	_____			30.75	✓	350	24.55	24.90	3034	STOOP
T.P.	517	28.75		✓	61	55	23.50	.027	ON CURB & WALK LEADING TO 3034	
	_____			410		24.68	25.03		3039	STOOP
	_____			461		24.17	24.52		3042	STOOP
T.P.	473	27.69		✓	579	22.96	.034	ON CURB & WALK LEADING TO 3044		
B.M.				313	✓	24.56	24.60	24.60	SPIKE IN RD. NEAR ST. FRONT. 2448	

66.040
 .007







VALUABLE

SUBJECT FLOOR ELEVATIONS
AT TARAWA TERRACE

RETURN TO
PUBLIC WORKS
OFFICE
CAMP LEJEUNE
NORTH CAROLINA

BENCH LEVELS TO WELLS
TT-30 & TT-31
OUTLYING WELLS

FIELD PARTY

____ IN CHARGE
____ INSTRUMENT
____ NOTES
____ TAPE READ
____ TAPE OR ROD
____ TAPE OR ROD
____ INSTRUMENT NO.
____ TAPE NO.

WEATHER

CLEAR _____ SNOW _____
CLOUDY _____ HOT _____
WINDY _____ MODERATE _____
RAIN _____ COLD _____
FAIR _____ FOG _____

FILE No. _____

Fldr. No. _____

SHEET 1 of 2

FIGURED BY _____

NOTES CHECKED BY _____

PLOTTED BY _____

DATE 6-4-39

Quad. No. _____

STATION	DIST.	ANGLE		H. I. BEARING	VER. ANG. DIFF.	ELEVATION	
		°	' "				
B.M.				3.20 28.49 ✓		25.29	MON.# 84
T.P.				2.82 26.36 ✓	4.95	23.54 ✓	
T.P.				2.18 24.13 ✓	4.41	21.95 ✓	
T.P.				2.51 23.01 ✓	3.63	20.50 ✓	NOTE: LEVELS ADJUSTED AT B.M.'S ONLY.
T.P.				4.65 23.72 ✓	3.94	19.07 ✓	
B.M.				1.40 23.69 ✓	1.43	22.28 ✓	SPIKE IN 15" OAK 40' EAST OF (E.COR) TT 30
T.P.				3.12 22.02 ✓	4.79	18.90 ✓	
T.P.				4.52 27.34 ✓	2.20	19.82 ✓	
T.P.				4.78 27.09 ✓	2.03	22.82 ✓	
T.P.				4.07 28.10 ✓	3.06	22.31 ✓	
				5.15 28.91 ✓		24.03 ✓	FLOOR TT-31
B.M.				5.57 31.94 ✓	4.76	22.95 ✓	SPIKE IN 16" PINE 5' FROM DOOR TT-31








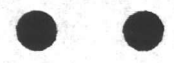

VALUABLE

SUBJECT Floor Elev. contd.

RETURN TO
PUBLIC WORKS
OFFICE
CAMP LEJEUNE
NORTH CAROLINA

FIELD PARTY
IN CHARGE _____
INSTRUMENT _____
NOTES _____
TAPE READ _____
TAPE OR ROD _____
TAPE OR ROD _____
INSTRUMENT NO. _____
TAPE NO. _____

WEATHER
CLEAR _____
CLOUDY _____
WINDY _____
RAIN _____
FAIR _____
SNOW _____
HOT _____
MODERATE _____
COLD _____
FOG _____
FIGURED BY _____
NOTES CHECKED BY _____
PLOTTED BY _____

FILE No. _____
FLDR. No. _____
SHEET 2 of 2
DATE 6-4 1959

Quad. No. _____

STATION	DIST.	ANGLE		+	H. I. BEARING	VER: ANG. DIFF.	ELEVATION
		°	' "				
B.M.					31.91		22.17
					28.91	6 72	25.19
T.P.	4 12				31.31		24.33
					28.31		27.33
T.P.	2 68				27.01	3 98	27.33
					30.01		22.31
T.P.	2 31				24.62	4 70	25.31
					27.62		20.01
T.P.	2 55				22.56	4 61	23.01
					25.56		18.96
T.P.	3 45				22.41	3 60	21.96
					25.41		19.41
T.B.H. (T.P.)	4 13				23.54	3 00	22.41
					26.54		20.65
T.P.	4 43				25.08	2 89	23.65
					28.08		21.59
T.P.	4 30				25.89	3 49	24.59
					28.89		23.15
T.P.	4 17				27.32	2 74	26.15
					30.32		24.58
T.P.	4 93				29.51	2 74	27.58
					32.51		25.16
T.P.	4 46				29.62	4 35	28.16
					32.62		25.97
B.M.					3 65	28.77	25.90

WEST SIDE CAMP LEJEUNE RR TRACK
MOST WEST COR. SOUTHWEST END HEADWALL APPROX. 144' NORTH OF TT 31

NAIL IN C' PINE

22 / .003
 .070

25.90 NOV. 4 39

VALUABLE

SUBJECT FLOOR ELEVATIONS of
Well Houses AT Tarawa
Terrence

RETURN TO
PUBLIC WORKS
OFFICE
CAMP LEJEUNE
NORTH CAROLINA

NOTE: ALL ROD READINGS
FINGER SPOTTED.

FIELD PARTY

____ IN CHARGE
____ INSTRUMENT
____ NOTES
____ TAPE READ
____ TAPE OR ROD
____ TAPE OR ROD
____ INSTRUMENT No.
____ TAPE No.

WEATHER

CLEAR
CLOUDY
WINDY
RAIN
FAIR
SNOW
HOT
MODERATE
COLD
FOG
FIGURED BY _____
NOTES CHECKED BY _____
PLOTTED BY _____

FILE No. _____
FLDR. No. _____
SHEET 1 of
DATE 6-5-1959

Quad. No. _____

STATION	DIST.	ANGLE ° ' "	+	H. I. BEARING	VER. ANG. DIFF.	ELEVATION	
B.M.						26.29 ✓	Spike in transformer pole near well House TT-27
			4.83	31.12		26.35 ✓	FLOOR well House TT-27
					4.77		
B.M.						27.85 ✓	Spike in 14" Pine Midway Between House # 2001 AND Well House # TT-28
			3.89	31.74		27.85 ✓	FINISH FLOOR of Well House TT-28
					3.89		
B.M.						27.50 ✓	MON. #416
			2.25	29.75		26.49 ✓	FINISH FLOOR Well House TT-29
					3.26		
B.M.						23.90 ✓	Spike in 12" Pine near Well House No. 45 ⁸
			4.47	28.37		24.49 ✓	WEST of M.B.R.R. AND SOUTH of Hl-way #24
					3.88		FINISH FLOOR of Well House Described Above. (Well #5) #45
B.M.						22.28 ✓	Spike in 15" oak 40' EAST of EAST COR. of Well House TT-30
			4.55	26.83		23.18 ✓	FINISH FLOOR Well House TT-30
					3.65		




















VALUABLE

SUBJECT Location of Well
Site #1 Title III Housing
Area

Return To
 Public Works
 Office
 Camp Lejeune
 North Carolina


FIELD PARTY
Kellom In Charge
 _____ Instrument
 _____ Notes
 _____ Tape Read
 _____ Tape or Rod
 _____ Tape or Rod
 _____ Instrument No.
 _____ Tape No.

WEATHER
 Clear _____
 Cloudy _____
 Windy _____
 Rain _____
 Fair _____
 Snow _____
 Hot _____
 Moderate _____
 Cold _____
 Fog _____
 Figured By _____
 Notes Checked By _____
 Plotted By _____

FILE No. 99-60
 Fldr. No. _____
 Sheet 1 of _____
 Date 4-18-1951

Quad. No. _____

Station	Dist.	Angle	"	+	H. I. Bearing	Ver: Ang. Diff.	Elevation
---------	-------	-------	---	---	------------------	--------------------	-----------

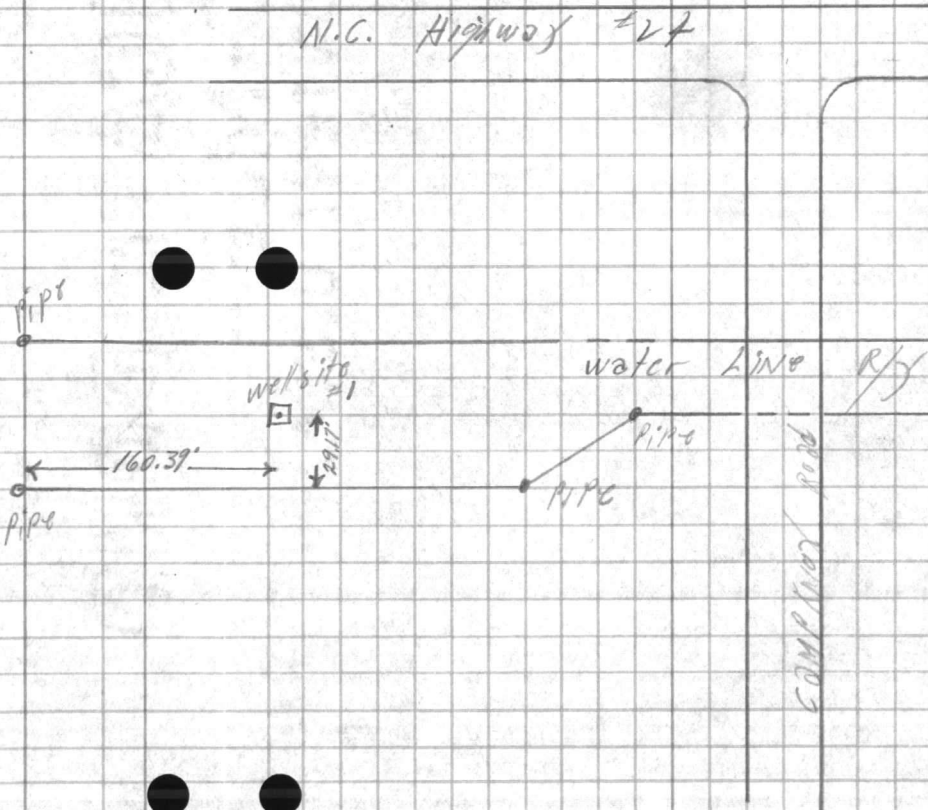





















VALUABLE

SUBJECT Well #2 stake out
title VIII HOUSING

Return To
Public Works
Office
Camp Lejeune
North Carolina

FIELD PARTY

In Charge _____
Instrument _____
Notes _____
Tape Read _____
Tape or Rod _____
Tape or Rod _____
Instrument No. _____
Tape No. _____

WEATHER


Clear _____
Cloudy _____
Windy _____
Rain _____
Fair _____
Snow _____
Hot _____
Moderate _____
Cold _____
Fog _____
Figured By _____
Notes Checked By _____
Plotted By _____

FILE No. _____
Fldr. No. _____
Sheet 2 of 3
Date 4-13-1951

Quad. No. _____

Station Dist. ° Angle " + H. I. Ver: Ang. Elevation

title VIII Mortgage

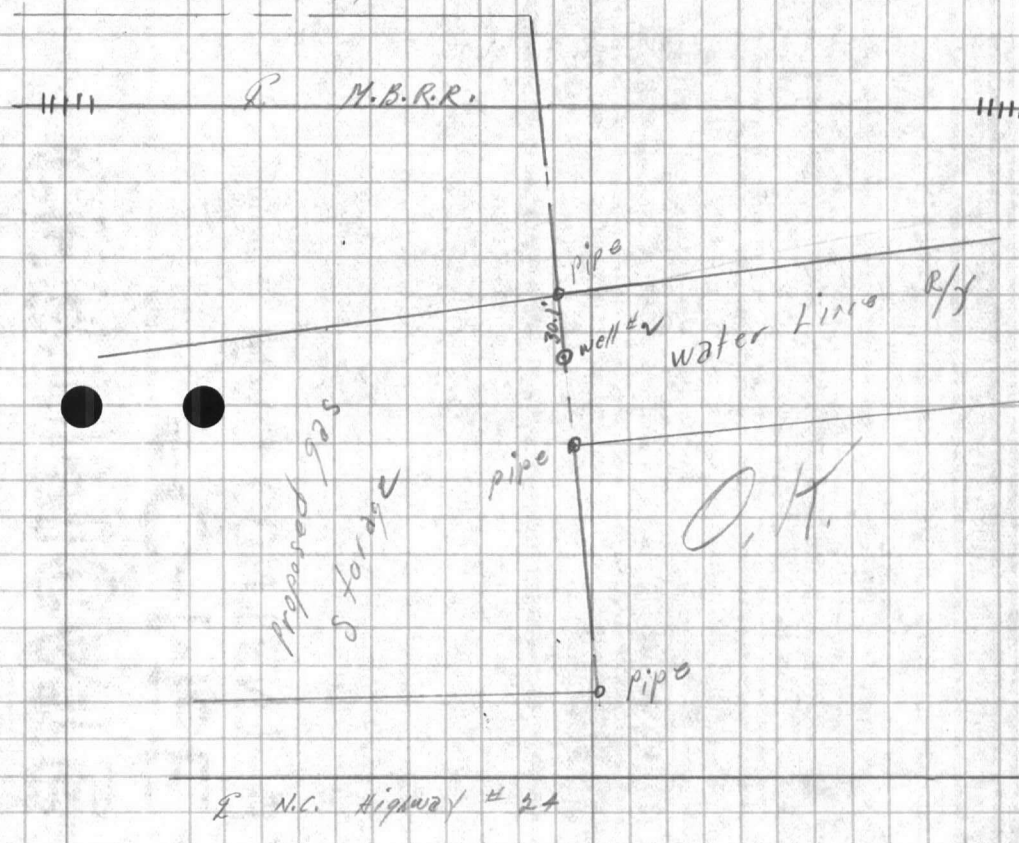

O.H.




















REPRODUCED FROM
ORIGINAL



VALUABLE

SUBJECT Well #3 stake out
Title VIII Housing

Return To
Public Works
Office
Camp Lejeune
North Carolina

FIELD PARTY
Kelown In Charge
Instrument _____
Notes _____
Tape Read _____
Tape or Rod _____
Tape or Rod _____
Instrument No. _____
Tape No. _____

WEATHER
Clear _____
Cloudy _____
Windy _____
Rain _____
Fair _____
Snow _____
Hot _____
Moderate _____
Cold _____
Fog _____
Figured By _____
Notes Checked By _____
Plotted By _____

FILE No. _____
Fldr. No. _____
Sheet 10 of 3
Date 4-13-57

Quad. No. _____

Station	Dist.	Angle ' "	+	H. I. Bearing	Ver: Ang. Diff.	Elevation
---------	-------	--------------	---	------------------	--------------------	-----------

OK



8. N.C. Highway 444

Entrance to Title VIII Housing
























REPRODUCED FROM
NATIONAL ARCHIVES

VALUABLE

SUBJECT Well #4 stake out
title VIII Housing

Return To
 Public Works
 Office
 Camp Lejeune
 North Carolina

FIELD PARTY

____ In Charge
 ____ Instrument
 ____ Notes
 ____ Tape Read
 ____ Tape or Rod
 ____ Tape or Rod
 ____ Instrument No.
 ____ Tape No.


WEATHER

Clear _____
 Cloudy _____
 Windy _____
 Rain _____
 Fair _____
 Snow _____
 Hot _____
 Moderate _____
 Cold _____
 Fog _____
 Figured By _____
 Notes Checked By _____
 Plotted By _____

FILE No. _____
 Fldr. No. _____
 Sheet 3 of 3
 Date 4-13-1957

Quad. No. _____

Station	Dist.	Angle	"	+	H. I. Bearing	Ver: Ang. Diff.	Elevation
---------	-------	-------	---	---	---------------	-----------------	-----------

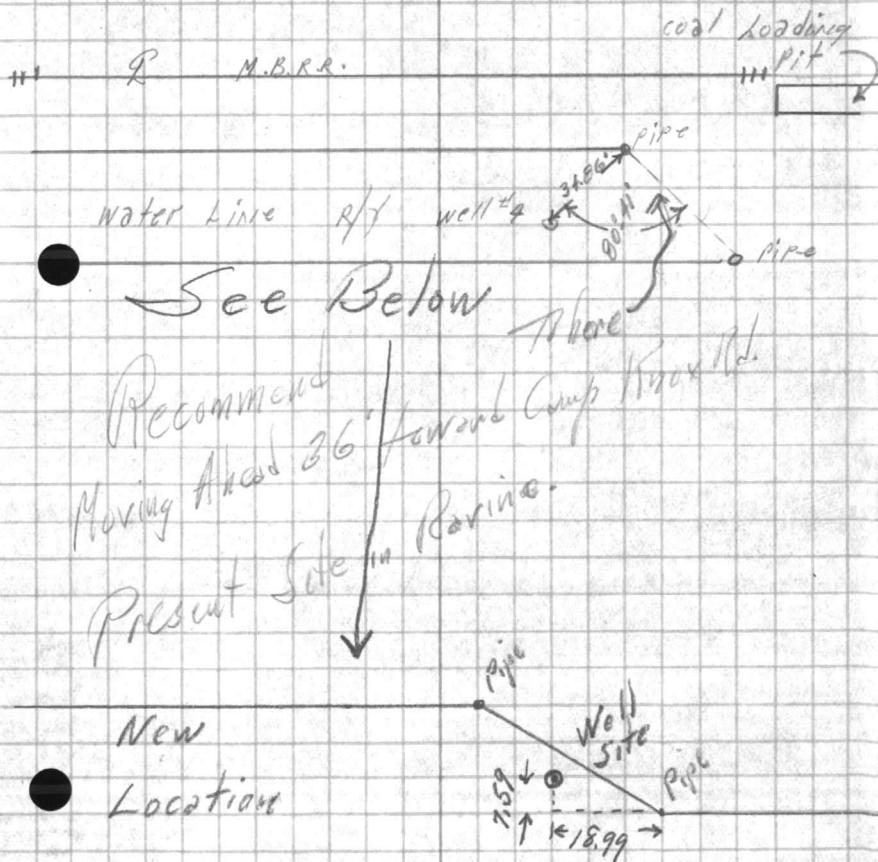

VALUABLE
Return To
Public Works
Office
Camp Lejeune
North Carolina

SUBJECT

Station _____ Dist. _____ Angle _____ + _____
Sighting _____
Var: Ang. _____
Dist. _____

FIELD PARTY

In Charge _____
Instruments _____
Notes _____
Time Read _____
Time on Rod _____
Time on Rod _____
Instrument No. _____
Type No. _____

WEATHER

Clear _____
Snow _____
Cloudy _____
Hot _____
Moderate _____
Windy _____
Rain _____
Fog _____
Faint _____
Fogged By _____
Fog Checked By _____
Fogged By _____
Date _____

FILE No.

Field No. _____
Sheet _____
Date _____

VALUABLE

SUBJECT Boundary survey
I.H.A. housing area, North
East Creek Area.

Return To
Public Works
Office
Camp Lejeune
North Carolina


FIELD PARTY
Kellom In Charge
Instrument _____
Notes _____
Tape Read _____
Tape or Rod _____
Tape or Rod _____
Instrument No. _____
Tape No. _____

WEATHER
Clear _____
Cloudy _____
Windy _____
Rain _____
Fair _____
Snow _____
Hot _____
Moderate _____
Cold _____
Fog _____
Figured By _____
Notes Checked By _____
Plotted By _____

FILE No. 996011
Fldr. No. _____
Sheet 1 of 1
Date 7-5-1950

Quad. No. _____

Station Dist. Angle " + H. I. Bearing Ver: Ang. Diff. Elevation

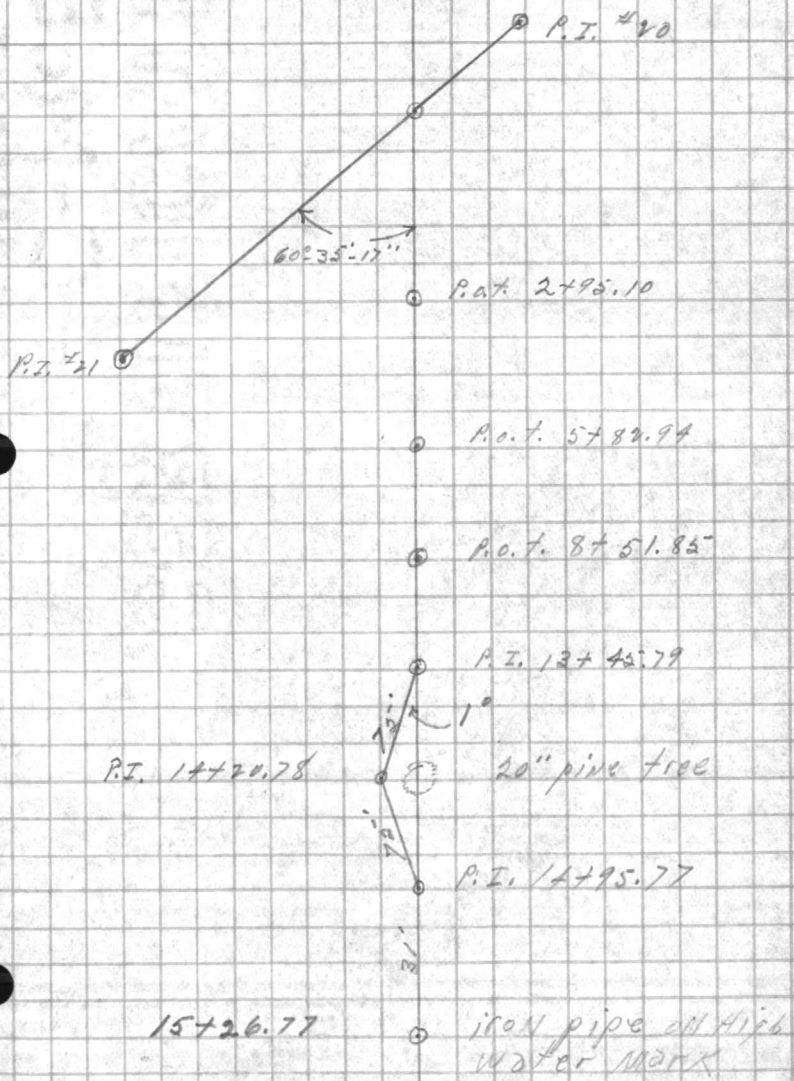

North East Creek

VALLEY HILL
Public Works
Office
Camp Lejeune
North Carolina

STATION

Station

Appr

H. W. Lanning

STATION

FIELD PARTY
In Charge
Instruments
Labels
Type of Rod
Type of Trip
Instrument No.
Station No.

WEATHER
Clear
Snow
Cloudy
Rain
Fog
Ice

FIELD PARTY

1000097
1948500
1948500
242500

VALUABLE

SUBJECT

Location of T.W.P. Co.
Proposed transmission Power
Line to Title III Housing
Area.

Return To
Public Works
Office
Camp Lejeune
North Carolina

FIELD PARTY

Kellom In Charge
Instrument
Notes
Tape Read
Tape or Rod
Tape or Rod
Instrument No.
Tape No.

WEATHER

Clear
Cloudy
Windy
Rain
Fair
Snow
Hot
Moderate
Cold
Fog
Figured By
Notes Checked By
Plotted By

FILE No. 99-6


Fldr. No.

Sheet 1-0 of 5

Date 4-13-19 51

Quad. No.

Station	Dist.	Angle	"	+	H. I. Bearing	Ver: Ang. Diff.	Elevation
---------	-------	-------	---	---	------------------	--------------------	-----------

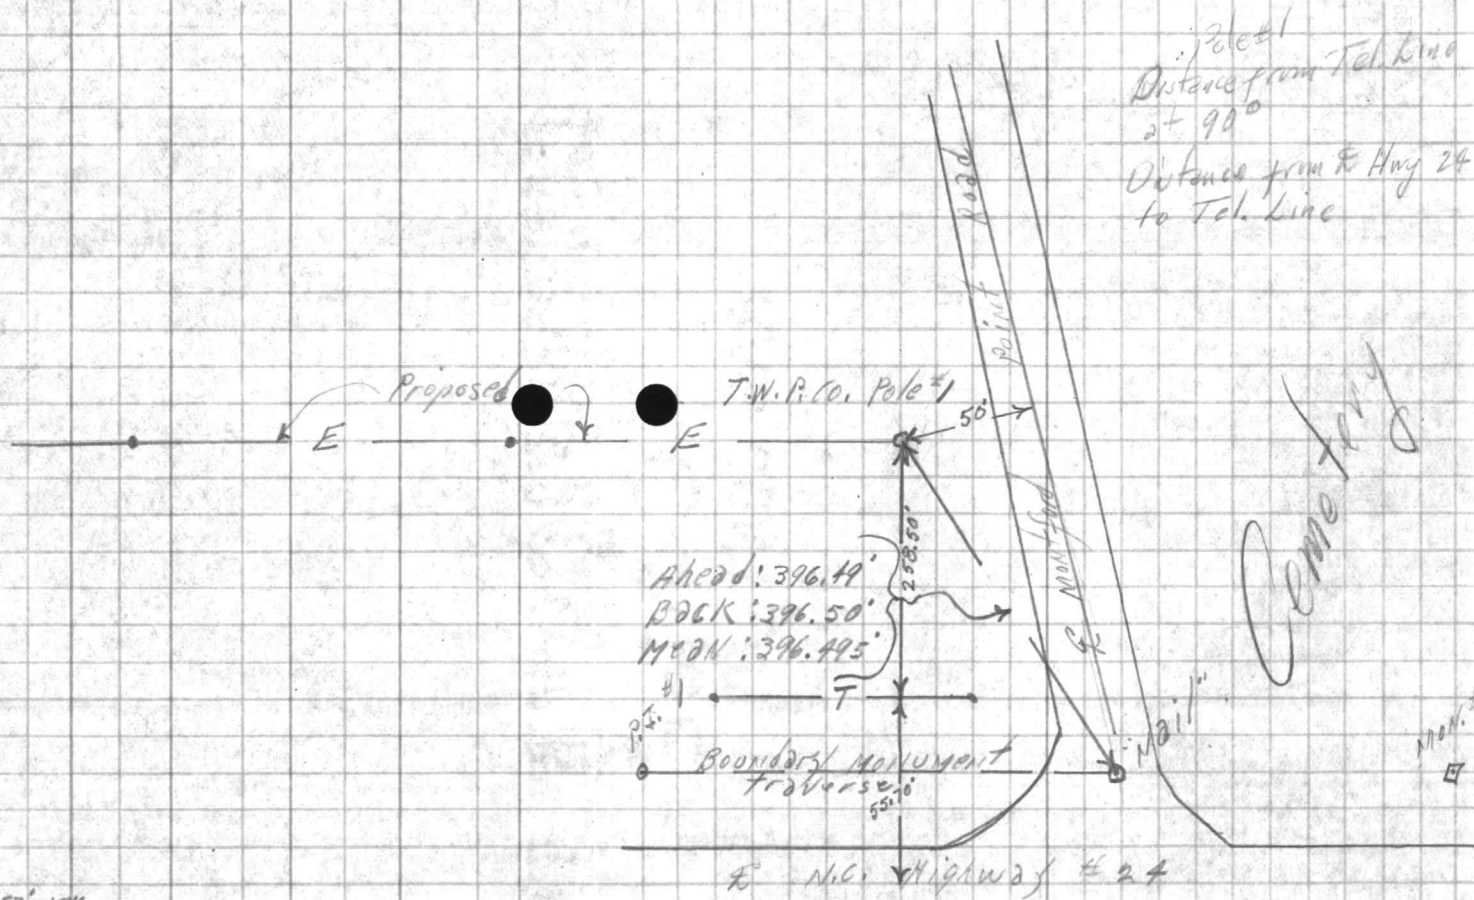

Pole #1
Distance from Tel. Line
at 90°
Distance from E Hwy 24
to Tel. Line

"Nail"
B.S.P.I. #1
Mean

1. 41° 53' 15"
2. 125° 40' 30"
Mean 41° 53' 30"

Mon. #66

Return to
Public Works
Office
Camp Lejeune
North Carolina

SUBJECT

Station
Dist
Angle
H. I.
Denial
Van Ang
Elevation

FIELD PARTY

In Charge
Instrument
Notes
Tape Read
Tape of Rod
Instrument No
Tape No

WEATHER

Clear
Cloudy
Windy
Rain
Fair
show
Hot
Moderate
Cold
Fog

FILE No.

Plot No.

Sheet

Date

Checked By

Notes Checked By

Plotted By

Return To
Public Works
Office
Camp Lejeune
North Carolina

Station

Date

Angle

+

Searing

Vert. Ang.
Dist.

Elevation

FIELD PARTY

In Charge

Instrument

Notes

Tape Measure

Type of Rod

Type of Rod

Instrument No.

Tape No.

WEATHER

Snow

Haze

Mist

Cloud

Fog

Clear

Notes Checked By

Plotted By

FIELD No.

Page No.

Sheet

Date

5920
16550
5570

VALUABLE

SUBJECT T.W.P. Co. Transmission
Line Location contd.

Return To
 Public Works
 Office
 Camp Lejeune
 North Carolina

FIELD PARTY

In Charge _____
 Instrument _____
 Notes _____
 Tape Read _____
 Tape or Rod _____
 Tape or Rod _____
 Instrument No. _____
 Tape No. _____

WEATHER

Clear _____
 Cloudy _____
 Windy _____
 Rain _____
 Fair _____
 Snow _____
 Hot _____
 Moderate _____
 Cold _____
 Fog _____

FILE No. _____

Fldr. No. _____

Sheet 3-0 of 5

Date 4-13-1951


Figured By _____

Notes Checked By _____

Plotted By _____

Quad. No. _____

Station	Dist.	Angle	"	+	H. I. Bearing	Ver: Ang. Diff.	Elevation
---------	-------	-------	---	---	------------------	--------------------	-----------

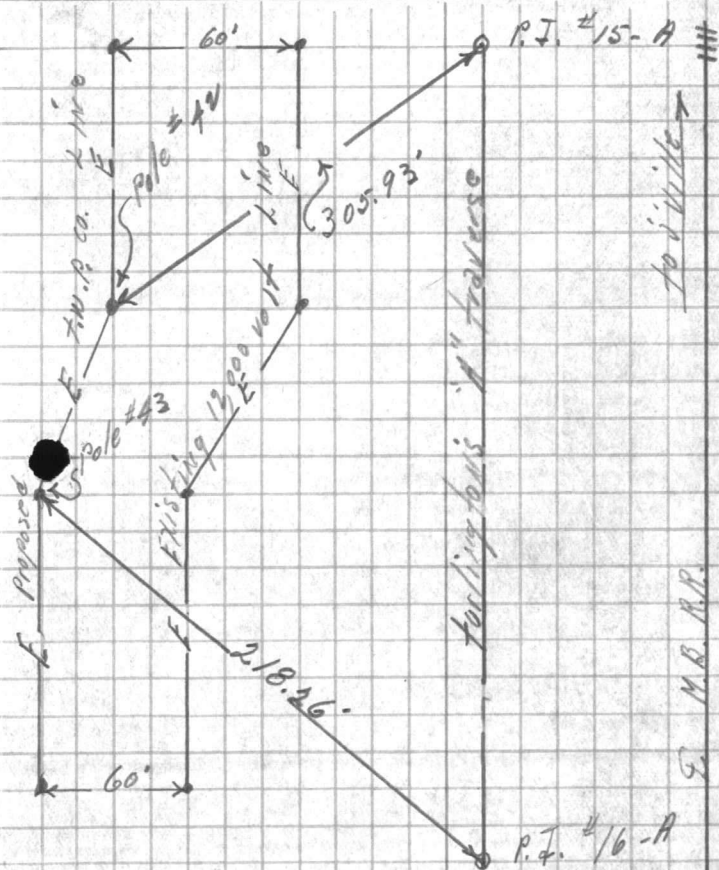

T - P.I. 15-A 1- $8^{\circ} 51' 45''$
 B.S. 16-A 3- $26^{\circ} 35' 15''$
 to Pole # Mean- $8^{\circ} 51' 45''$
 # 42

T - P.I. 16-A 1- $344^{\circ} 04' 30''$
 B.S. 15-A 3- $306^{\circ} 13' 30''$
 to Pole Mean- $344^{\circ} 04' 30''$
 # 43

AVAILABLE

SUBJECT


FIELD PARTY

In Charge _____
Treatment _____
Notes _____
Tape Head _____
Type of Roll _____
Tape or Roll _____
Instrument No. _____
Tape No. _____

WEATHER

Clear _____
Snow _____
Cloudy _____
Fog _____
Windy _____
Moderate _____
Cold _____
Rain _____
Foggy _____
Fog _____
Checked By _____
Printed By _____

FILE No.

FILE No.

Sheet

Date

N.I. V. and Elevation
Station

Area

Dist

Station

VALUABLE

SUBJECT T.W.P. CO. transmission
line location contd.

Return To
Public Works
Office
Camp Lejeune
North Carolina

FIELD PARTY

In Charge _____
Instrument _____
Notes _____
Tape Read _____
Tape or Rod _____
Tape or Rod _____
Instrument No. _____
Tape No. _____

WEATHER

Clear _____
Cloudy _____
Windy _____
Rain _____
Fair _____
Snow _____
Hot _____
Moderate _____
Cold _____
Fog _____

FILE No. _____

Fldr. No. _____

Sheet 1-075


Date 1-13-1951

Quad. No. _____

Station	Dist.	Angle	"	+	H. I. Bearing	Ver. Ang. Diff.	Elevation
---------	-------	-------	---	---	------------------	--------------------	-----------

T.P. 21-A 1-141°-31'-00"
B.S. 22-A 3-64°-33'-15"
to pole Mean 141°-31'-05"
56

T.P. 21-A 1-149°-31'-15"
B.S. 22-A 3-140°-33'-15"
to pole Mean 149°-31'-05"
57

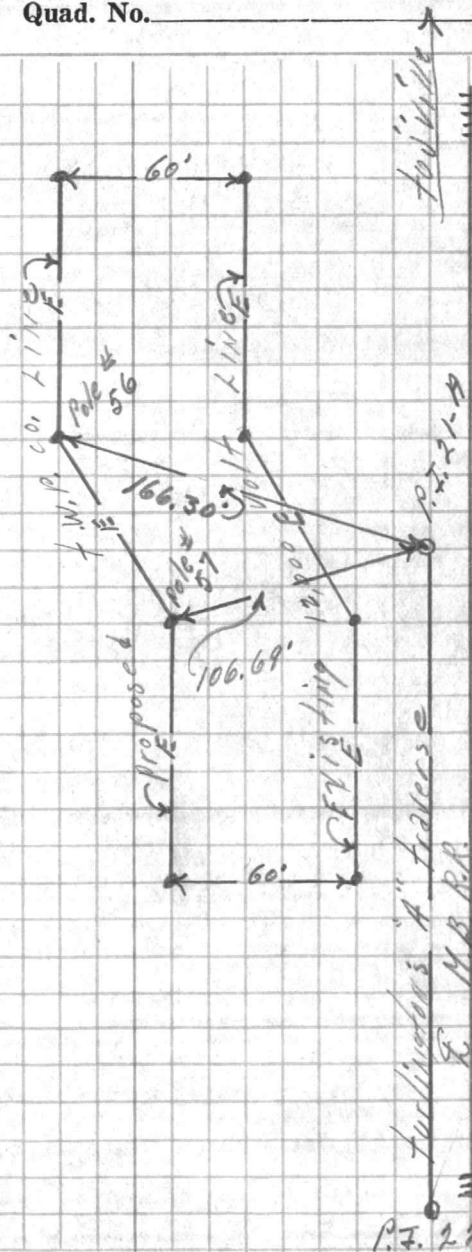

P.T. 22-A

VAI...

SUBJECT

Refer to
Public Works
OWB
Camp Lejeune
North Carolina

Station

Date

Routing

Vol. and E. Division

FIELD PARTY

In. Charge

Instrument

Notes

Time used

Time on Rod

Time on Rod

Amount No.

Time No.

WEATHER

Clear

Windy

Fair

Cloudy

Light

Drizzle

Other

Remarks

FILE NO.

Right No.

Sheet

Date

Grid No.

VALUABLE

SUBJECT Proposed T.W.P. Co.
Transmission Line Location
cont'd.

Return To
 Public Works
 Office
 Camp Lejeune
 North Carolina

FIELD PARTY

____ In Charge
 ____ Instrument
 ____ Notes
 ____ Tape Read
 ____ Tape or Rod
 ____ Tape or Rod
 ____ Instrument No.
 ____ Tape No.

WEATHER

Clear
 Cloudy
 Windy
 Rain
 Fair

Snow
 Hot
 Moderate
 Cold
 Fog

FILE No. _____

Fldr. No. _____

Sheet 5 of 5


Date 4-13-1951

Figured By _____
 Notes Checked By _____
 Plotted By _____
 Quad. No. _____

Station	Dist.	Angle	"	+	H. I. Bearing	Ver: Ang. Diff.	Elevation
---------	-------	-------	---	---	------------------	--------------------	-----------

T- P.I. # 24-A 1-330°21'00"
 B.S. 23-A Mean-330°21'00"
 to Pole # 63

T- P.I. 23-A 1-181°09'00"
 B.S. 22-A 3-183°26'45"
 to Pole # 62

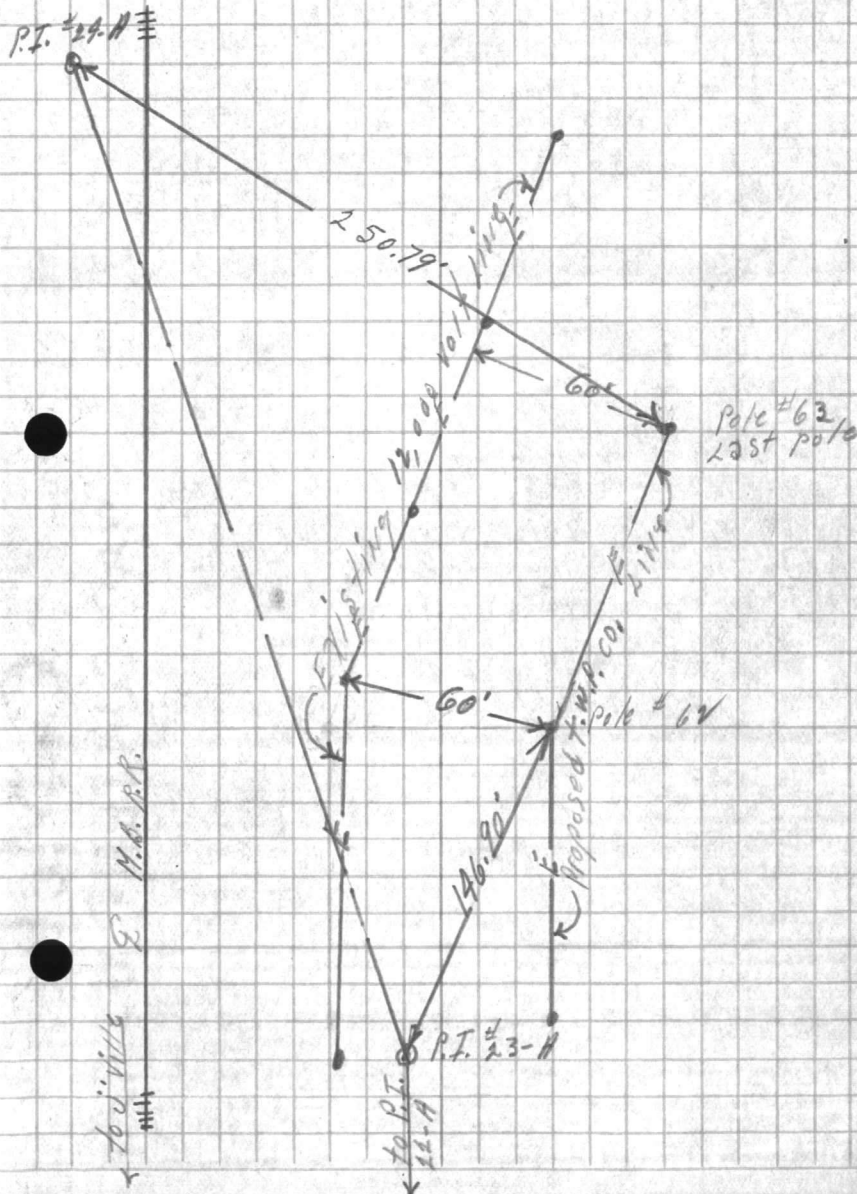

VALUABLE

SUBJECT

Public Works
Office
North Carolina

Station & Dist.

Angle

H. I.
Searing

Vertical Elevation
DIP

FIELD PARTY

In Charge

Instrument

Notes

Time Read

Type of Rod

Type of Rod

Instrument No.

Time No.

WEATHER

Clear

Cloudy

Windy

Light

Notes

Placed by

Checked by

FILE No.

Field No.

Sheet

Date

Checked by

PUBLIC WORKS DEPARTMENT
Camp Lejeune, North Carolina
Survey Department

File 99-600
Quadrangle _____
Date 4/16/51
Sheet _____ of _____

Traverse Computation
Description

Proposed Tide Water Electric Main to Title VIII Housing

Station	Distance	Bearing	Cosine	Sine	Latitude	Departure	Y Coordinate North	X Coordinate East
<i>Naib in E Montford Pt. Rd. to P.I. #1</i>		<i>S80-33-20 E</i>					<i>367,079.08</i>	<i>2,475,740.23</i>
<i>Pole #1</i>	<i>396.50</i>	<i>S38-39-50 E</i>	<i>780.824</i>	<i>624.751</i>	<i>309.60</i>	<i>247.71</i>	<i>366,769.48</i>	<i>2,475,988.00</i>
<i>P.I. #7 to Mon. # 39 U.S.N.</i>		<i>S65-12-05 E</i>					<i>365,790.63</i>	<i>2,483,597.67</i>
<i>Pole #30</i>	<i>577.59</i>	<i>S69-53-40 W</i>	<i>343.751</i>	<i>939.061</i>	<i>198.55</i>	<i>542.39</i>	<i>365,592.08</i>	<i>2,483,055.28</i>
<i>Pole #32</i>	<i>442.54</i>	<i>S12-59-05 E</i>	<i>974.430</i>	<i>224.691</i>	<i>431.22</i>	<i>99.43</i>	<i>365,359.41</i>	<i>2,483,697.10</i>
<i>P.I. #15A to P.I. #16A</i>		<i>S80-18-09 E</i>					<i>365,036.61</i>	<i>2,485,908.80</i>
<i>Pole #42</i>	<i>305.93</i>	<i>S71-26-24 E</i>	<i>318.298</i>	<i>947.991</i>	<i>97.38</i>	<i>290.02</i>	<i>364,939.23</i>	<i>2,486,198.82</i>
<i>P.I. #16A from P.I. #15A</i>		<i>S80-18-09 E</i>					<i>364,917.43</i>	<i>2,486,606.03</i>
<i>Pole #43</i>	<i>218.26</i>	<i>S81-46-20 W</i>	<i>143.109</i>	<i>989.707</i>	<i>31.23</i>	<i>216.01</i>	<i>364,886.20</i>	<i>2,486,390.02</i>
<i>P.I. #21A to P.I. #22A</i>		<i>S80-30-22 E</i>					<i>364,441.07</i>	<i>2,489,695.65</i>
<i>Pole #56</i>	<i>166.30</i>	<i>S61-00-45 W</i>	<i>484.619</i>	<i>874.725</i>	<i>80.59</i>	<i>145.47</i>	<i>364,360.48</i>	<i>2,489,550.18</i>
<i>Pole #57</i>	<i>106.69</i>	<i>S30-59-15 E</i>	<i>857.280</i>	<i>514.851</i>	<i>91.46</i>	<i>54.93</i>	<i>364,349.61</i>	<i>2,489,750.58</i>
<i>P.I. #23A from P.I. #22A</i>		<i>S73-31-24 E</i>					<i>364,209.39</i>	<i>2,490,719.64</i>
<i>Pole #62</i>	<i>146.90</i>	<i>S72-22-30 E</i>	<i>302.786</i>	<i>953.059</i>	<i>44.48</i>	<i>140.00</i>	<i>364,164.91</i>	<i>2,490,859.64</i>
<i>P.I. #24A to P.I. #23A</i>		<i>N88-23-57 W</i>					<i>364,192.85</i>	<i>2,491,311.62</i>
<i>Pole #63</i>	<i>250.79</i>	<i>S61-57 W</i>	<i>470.242</i>	<i>882.538</i>	<i>117.93</i>	<i>221.33</i>	<i>364,074.92</i>	<i>2,491,090.29</i>

7164.7
 482.7
 2536.7
 195.4
 3208.6
 2007
 1124.34
 1297.62

Office Memorandum • UNITED STATES GOVERNMENT

TO :


DATE:

March 1951

FROM :

SUBJECT:

Revised Title VIII Housing Boundary.

 

PUBLIC WORKS DEPARTMENT
Camp Lejeune, North Carolina
Survey Department

File 99-604
Quadrangle _____
Date 3/12/51
Sheet #/ of _____

Traverse Computation
Description

Title VIII Housing Area Boundary - Access Area change from Original

Station	Distance	Bearing	Cosine	Sine	Latitude	Departure	Y Coordinate North	X Coordinate East
<i>P.I. # 24A</i>		<i>N4°29'13"W</i>	<i>To Mon. # 442</i>				<i>362,804.74</i>	<i>2,491,952.45</i>
Corner A-1	244.74	N37-04-37E	797827	602887	195.26	147.55	363,000.00	2,492,100.00
" A-2	275.39	N60-38-00W	490397	871499	135.05	240.00	363,135.85	2,491,860.00
" A-3	638.97	N65-41-00W	411779	911284	263.11	582.28	363,398.78	2,491,277.72
" A-10	199.78	N67-04-29W	389530	921014	77.82	184.00	363,475.98	2,491,093.72
" A-9	808.00	N23-05-00E	919936	392070	743.31	316.79	364,219.29	2,491,410.51
<i>P.I. # 24A</i>	102.48	S75-09-31W	256144	966639	26.25	99.06	364,193.04	2,491,311.45
							364,192.85	2,491,311.62
<i>To P.I. # 28A</i>		<i>N88-23-57W</i>			<i>+1414.55</i> <i>- 26.25</i> <i>+ 1388.30</i>	<i>+ 464.34</i> <i>- 1105.35</i> <i>- 641.00</i>	364,193.04	2,491,311.45
							+0.19	- 0.17
Corner A-9		N23-05-00E	<i>from A9</i>				364,219.29	2,491,410.51
" A-8	50.00	N66-55W	392070	919936	19.60	46.00	364,238.89	2,491,364.51
" A-7	50.00	N23-05E	919936	392070	46.00	19.60	364,284.89	2,491,384.11
" A-6	50.00	S66-55E	392070	919936	19.60	46.00	364,265.29	2,491,430.11
" A-5	89.95	N23-05E	919936	392070	82.75	35.27	364,348.04	2,491,465.38
" A-4	199.78	S68-25-15E	367786	929910	73.48	185.78	364,274.56	2,491,651.16
" A-3	952.65	S23-05W	919936	392070	826.36 784.38	37.35 334.30	363,398.19	2,491,277.65
							363,398.13	2,491,277.72
		<i>N65-41-00EW</i>					363,398.19	2,491,277.65
		<i>N65-41-25E</i>						
							+ 0.06	- 0.07

+ 148.35 + 286.65
- 969.45 - 419.51
- 821.10 - 132.86

Not Adj.

PUBLIC WORKS DEPARTMENT
Camp Lejeune, North Carolina
Survey Department

File 99-Gen.
Quadrangle _____
Date _____
Sheet # 2 of 3

Traverse Computation
Description

Title VIII Housing - Additional Area for Gas Plant & Well Site Locations

Station	Distance	Bearing	Cosine	Sine	Latitude	Departure	Y Coordinate North	X Coordinate East
P.I. #20 A		N80°24'25"W					364,542.59	2,489,095.20
Corner West Boundary and Access Lease	641.69	58-31-54 W	988934	148356	634.59	95.20	*363,908.00	2,489,000.00*
Corner Gas Plant & Water Lease	712.27	North	—	—	712.27	—	364,620.27	2,489,000.00
" Water Lease	60.82	"	—	—	60.82	—	364,681.09	2,489,000.00
" Gas Plant + N.C. Hwy R/W	185.69	"	—	—	185.69	—	364,866.78	2,489,000.00
" " " " "	493.70	S80-34-10 E	163852	986485	80.89	487.03	364,785.89	2,489,487.03
" " " R.R. R/W	246.51	South	—	—	246.51	—	364,539.38	2,489,487.03
" North Boundary Access Lease	713.07	"	—	—	713.07	—	363,826.31	2,489,487.03
" West Boundary " " "	493.70	N80-28 W	165621	986189	81.77	486.88	*363,908.08	2,489,000.15*
Mon. #405	34.18	N82-35-06 W	129055	991637	4.41	33.89	363,912.49	2,488,966.26
							363,912.39	2,488,966.07
							+ 0.10	+ 0.19
							Not Adj.	
Corner Gas Plant Area & Water Equipment Lease		N80°34'10"W					364,620.27	2,489,000.00
Corner for Ext. R.R. R/W 50' from R.R.	2800.00'	"	163852	986485	458.14 458.79 +.35	2762.76 +.53	365,079.41	2,486,237.31
" " " " 85' " "	49.50	N35-34-10 W	813411	581689	40.26 +.03	28.79	365,119.70	2,486,208.52
P.O.T.	1266.08	N80-34-10 W	163852	986485	207.45 +.16	1248.21 +.24	365,327.31	2,484,959.31
Mon. #39 U.S.N.	176.67	S55-37-55 W	564507	825428	99.73 +.07	145.83 +.08	365,227.65	2,484,813.45 ✓
							365,227.65	2,484,813.45 ✓
To Mon. #339 U.S.M.C.		S83-19-55 E ✓					365,227.04	2,484,814.25
		S83-20-10 E					+ .61	+ 0.80

Err. +00'00'15"
Not Adj.

+ 706.50
- 99.73
606.77

- 4185.75

Adj.



























VALUABLE

SUBJECT

Title III Boundary Survey

Return To
Public Works
Office
Camp Lejeune
North Carolina

FIELD PARTY

In Charge _____
Instrument _____
Notes _____
Tape Read _____
Tape or Rod _____
Tape or Rod _____
Instrument No. _____
Tape No. _____

WEATHER

Clear _____
Cloudy _____
Windy _____
Rain _____
Fair _____
Snow _____
Hot _____
Moderate _____
Cold _____
Fog _____
Figured By _____
Notes Checked By _____
Plotted By _____

FILE No. _____


Fldr. No. _____

Sheet _____

Date *3-12-1951*

Quad. No. _____

Station	Dist.	Angle " "	+	H. I. Bearing	Ver: Ang. Diff.	Elevation
---------	-------	--------------	---	------------------	--------------------	-----------

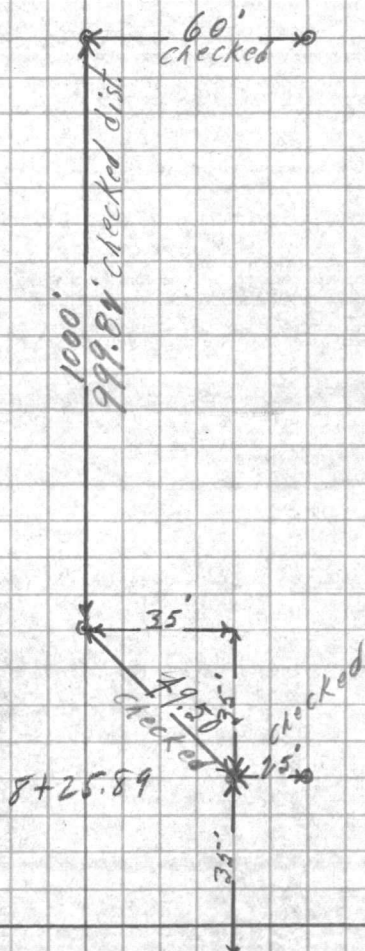

CAMP KALOY Rd.

NC. Highway 494















VALUABLE

SUBJECT Title VIII Boundary Survey

Return To
Public Works
Office
Camp Lejeune
North Carolina

FIELD PARTY

_____ In Charge
_____ Instrument
_____ Notes
_____ Tape Read
_____ Tape or Rod
_____ Instrument No.
_____ Tape No.

WEATHER

Clear _____
Cloudy _____
Windy _____
Rain _____
Fair _____
Snow _____
Hot _____
Moderate _____
Cold _____
Fog _____

FILE No. _____
Fldr. No. _____
Sheet _____
Date 3-11-57

Figured By _____
Notes Checked By _____
Plotted By _____

Quad. No. _____

Station	Dist.	Angle	"	+	H. I. Bearing	Ver: Ang. Diff.	Elevation
---------	-------	-------	---	---	------------------	--------------------	-----------

Camp Knox
Road

6+77.78

8+25.89

5+79.89

8+25.89'

N.C. Highway #44

85'

P.O.T. 17+66.08

E. N.C. R.R.

35'















VALUABLE

SUBJECT

Title & Boundary surveys

Return To
Public Works
Office
Camp Lejeune
North Carolina

FIELD PARTY

____ In Charge
____ Instrument
____ Notes
____ Tape Read
____ Tape or Rod
____ Tape or Rod
____ Instrument No.
____ Tape No.

WEATHER

Clear
Cloudy
Windy
Rain
Fair

Snow
Hot
Moderate
Cold
Fog

FILE No. _____

Fldr. No. _____


Sheet _____

Date *3-12-1951*

Figured By _____
Notes Checked By _____
Plotted By _____

Quad. No. _____

Station	Dist.	Angle	H. I. Bearing	Ver. Ang. Diff.	Elevation
---------	-------	-------	---------------	-----------------	-----------

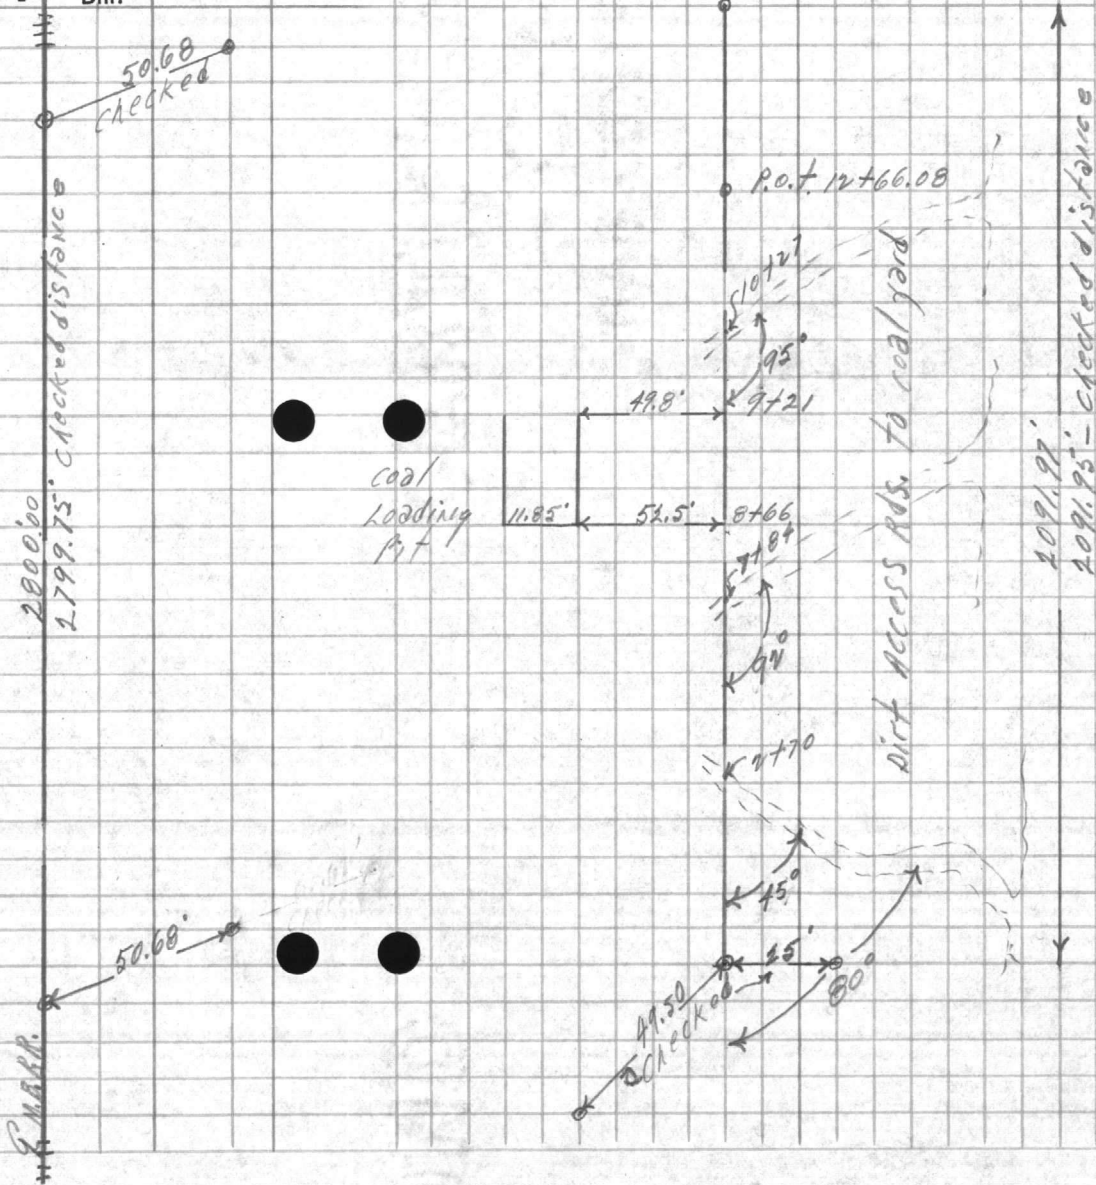





























VALUABLE

SUBJECT Title VIII Boundary Survey

Return To
Public Works
Office
Camp Lejeune
North Carolina

FIELD PARTY

____ In Charge
____ Instrument
____ Notes
____ Tape Read
____ Tape or Rod
____ Tape or Rod
____ Instrument No.
____ Tape No.

WEATHER

Clear
Cloudy
Windy
Rain
Fair

Snow
Hot
Moderate
Cold
Fog

FILE No. _____

Fldr. No. _____

Figured By _____ Sheet _____

Notes Checked By _____

Plotted By _____ Date 3-10-1951


Quad. No. _____

Station	Dist.	Angle	+	H. I. Bearing	Ver: Ang. Diff.	Elevation
---------	-------	-------	---	---------------	-----------------	-----------

$$\begin{array}{r} 1266.08 \\ 825.89 \\ \hline 2091.97 \end{array}$$

Mon. #39
 1- $41^{\circ} 02' 00''$
 3- $123^{\circ} 05' 45''$
 MEAN $41^{\circ} 01' 55''$

P.O.T.
 1266.08
 1- $136^{\circ} 14' 15''$
 3- $18^{\circ} 36' 15''$
 MEAN $136^{\circ} 12' 05''$

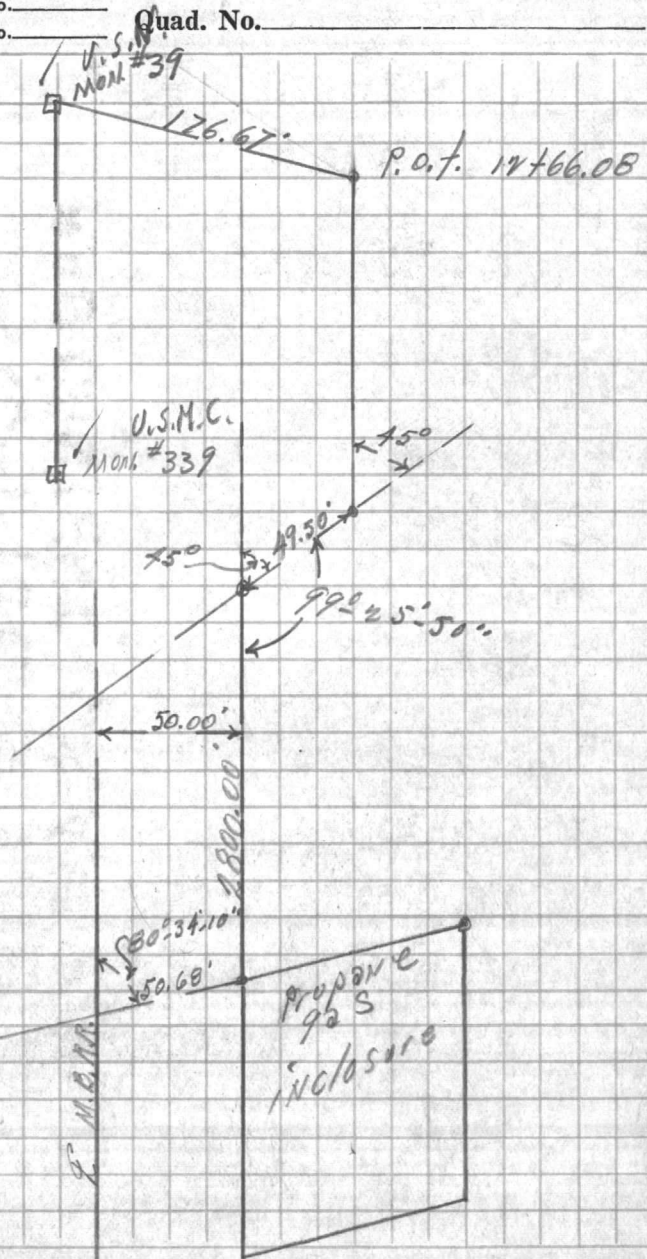



















VALUABLE

SUBJECT Title #111 Boundary Survey

Return To
Public Works
Office
Camp Lejeune
North Carolina

FIELD PARTY
Kellom In Charge
Instrument _____
Notes _____
Tape Read _____
Tape or Rod _____
Tape or Rod _____
Instrument No. _____
Tape No. _____


WEATHER
Clear _____
Cloudy _____
Windy _____
Rain _____
Fair _____
Snow _____
Hot _____
Moderate _____
Cold _____
Fog _____
Figured By _____
Notes Checked By _____
Plotted By _____

FILE No. _____
Fldr. No. _____
Sheet _____
Date 3-12-1951

Quad. No. _____

Station	Dist.	Angle	+	H. I. Bearing	Ver: Ang. Diff.	Elevation
---------	-------	-------	---	---------------	-----------------	-----------

662.34
50.68
246.51
469.15

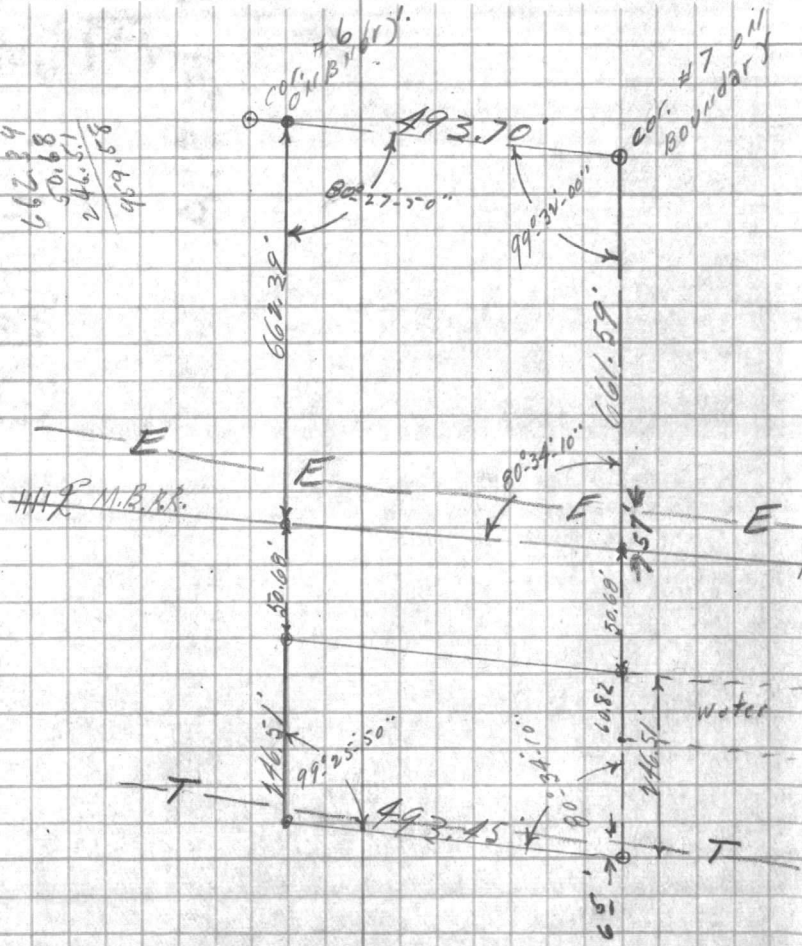













VALUABLE

SUBJECT Boundary Line Relocation
Title VIII Housing Area.

Return To
 Public Works
 Office
 Camp Lejeune
 North Carolina

FIELD PARTY
Kellum In Charge
 _____ Instrument
 _____ Notes
 _____ Tape Read
 _____ Tape or Rod
 _____ Instrument No.
 _____ Tape No.

WEATHER
 Clear _____
 Cloudy _____
 Windy _____
 Rain _____
 Fair _____
 Snow _____
 Hot _____
 Moderate _____
 Cold _____
 Fog _____
 Figured By _____
 Notes Checked By _____
 Plotted By _____

FILE No. _____
 Fldr. No. _____
 Sheet 1-0 f
 Date 3-5-1951


Quad. No. _____

Station	Dist.	Angle "	+	H. I. Bearing	Ver: Ang. Diff.	Elevation
---------	-------	---------	---	---------------	-----------------	-----------

Boundary #2
 1-174° 57' 00"
 2-164° 54' 00"
 MEAN-174° 57' 00"

Boundary #1
 1-84° 17' 23"
 2-246° 59' 09"
 MEAN-84° 17' 23"

P.I. #6
 1-41° 33' 50"
 2-144° 41' 30"
 MEAN-41° 33' 50"

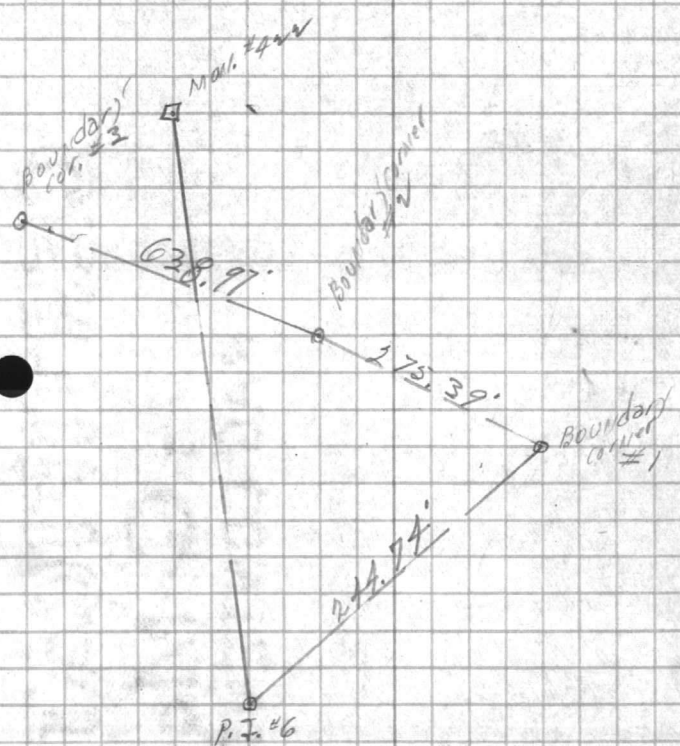

253
 332
 342
 164


242.5
 28.90
 51.32

















 

VALUABLE

SUBJECT title VII Housing Boundary
stake out

Return To
Public Works
Office
Camp Lejeune
North Carolina


FIELD PARTY
Kellou In Charge
____ Instrument
____ Notes
____ Tape Read
____ Tape or Rod
____ Tape or Rod
____ Instrument No.
____ Tape No.

WEATHER
Clear _____
Cloudy _____
Windy _____
Rain _____
Fair _____
Snow _____
Hot _____
Moderate _____
Cold _____
Fog _____
Figured By _____
Notes Checked By _____
Plotted By _____

FILE No. _____
Fldr. No. _____
Sheet 3 of 4
Date 3-9-51

Quad. No. _____

Station	Dist.	Angle	"	+	H. I. Bearing	Ver: Ang. Diff.	Elevation
Bdry. cor. #6	1-177°22'00"						
#6	3-172°06'00"						
MEAN	177°22'00"						
Bdry. cor. #5	1-177°10'00"						
#5	3-162°30'00"						
MEAN	177°10'00"						
Bdry. cor. #4	1-175°04'29"						
#4	3-165°13'27"						
MEAN	175°04'29"						
Bdry. cor. #3	1-178°36'36"						
#3	3-175°49'48"						
MEAN	178°36'36"						

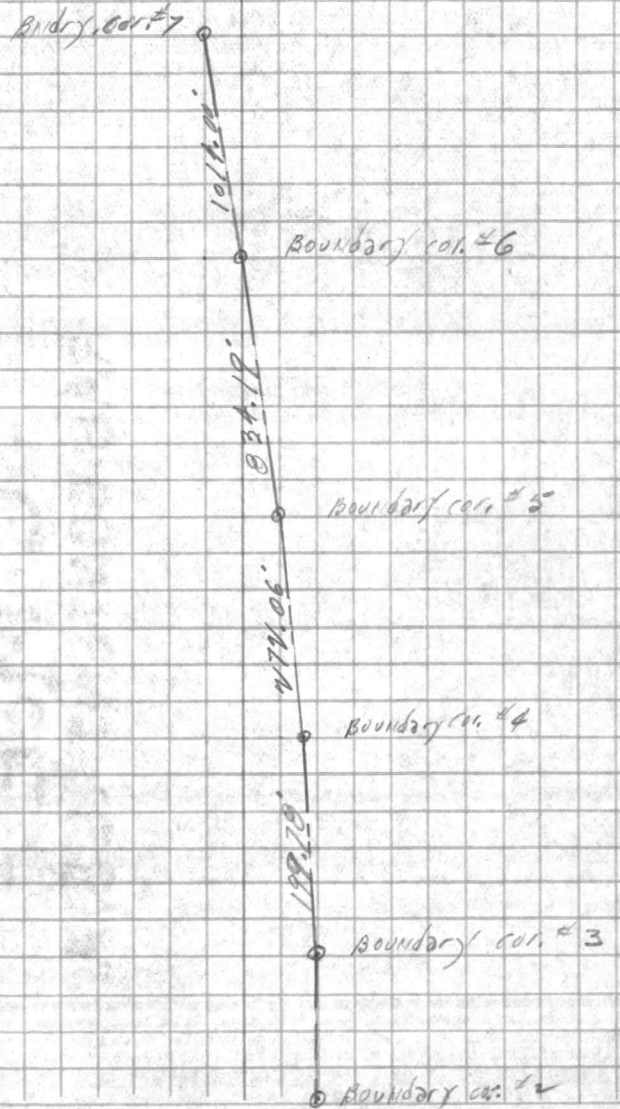

































VALUABLE

SUBJECT title VIII boundary stake
out.

Return To
 Public Works
 Office
 Camp Lejeune
 North Carolina

FIELD PARTY
 _____ In Charge
 _____ Instrument
 _____ Notes
 _____ Tape Read
 _____ Tape or Rod
 _____ Instrument No.
 _____ Tape No.

WEATHER
 Clear _____
 Cloudy _____
 Windy _____
 Rain _____
 Fair _____
 Snow _____
 Hot _____
 Moderate _____
 Cold _____
 Fog _____
 Figured By _____
 Notes Checked By _____
 Plotted By _____
 Quad. No. _____

FILE No. _____
 Fldr. No. _____
 Sheet 40 f 4
 Date 3-9-1951


Station	Dist.	Angle ' "	+	H. I. Bearing	Ver: Ang. Diff.	Elevation
---------	-------	--------------	---	------------------	--------------------	-----------

Boundary cor. #7
 1- 91° 00' 06" } Left
 3- 273° 00' 18" }
 MEAN. 91° 00' 06"

268° 59' 54" - Right -

P.I. 20-A
 1- 88° 56' 19" } Left
 3- 266° 48' 57" }
 MEAN. 88° 56' 19"

271° 03' 41" - Right -

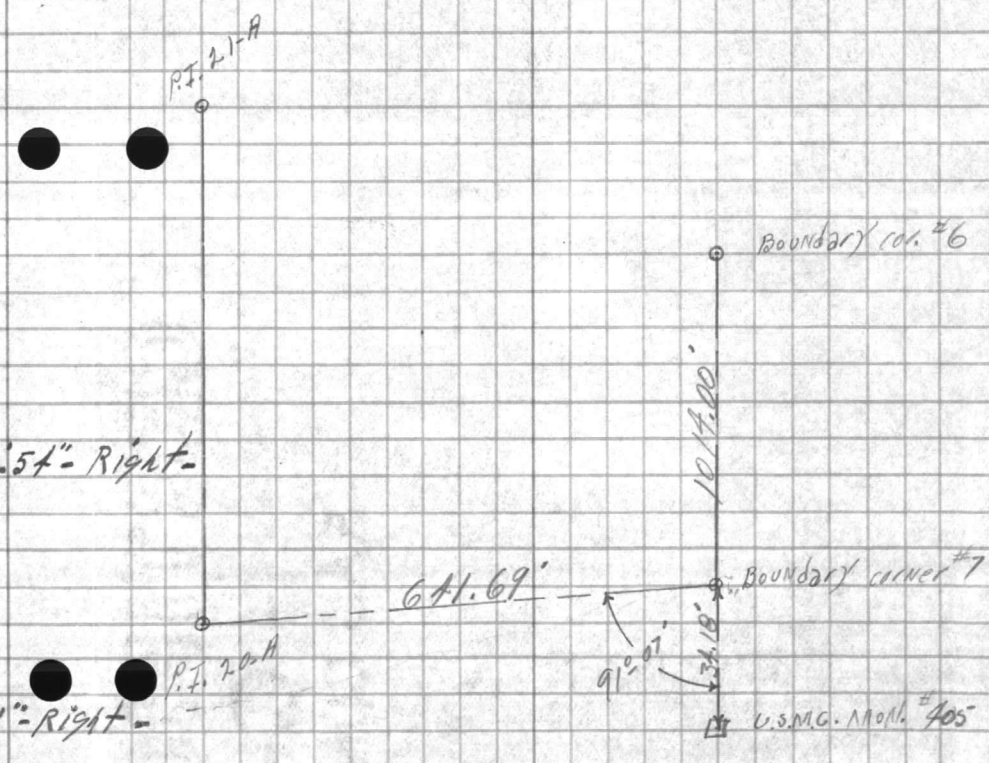

U.S.M.G. Mon. #405

VALUABLE

SUBJECT

Reprising tie for
TARONZ HORRACE
Traverse

RETURN TO
PUBLIC WORKS
OFFICE
CAMP LEJEUNE
NORTH CAROLINA

FIELD PARTY

IN CHARGE _____
INSTRUMENT _____
NOTES _____
TAPE READ _____
TAPE OR ROD _____
TAPE OR ROD _____
INSTRUMENT No. _____
TAPE No. _____

WEATHER

CLEAR _____ SNOW _____
CLOUDY _____ HOT _____
WINDY _____ MODERATE _____
RAIN _____ COLD _____
FAIR _____ FOG _____

FILE No. _____

FLDR. No. _____

SHEET

DATE


1 of 1
9-24 1958

Quad. No. _____

STATION	DIST.	ANGLE ° ' "	+	H. I. BEARING	VER. ANG. DIFF.	ELEVATION
---------	-------	----------------	---	------------------	--------------------	-----------

1	112	23	30			
3	337	10	15			
m	112	23	25			

1	208	56	15			
3	266	48	45			
m	208	56	15			

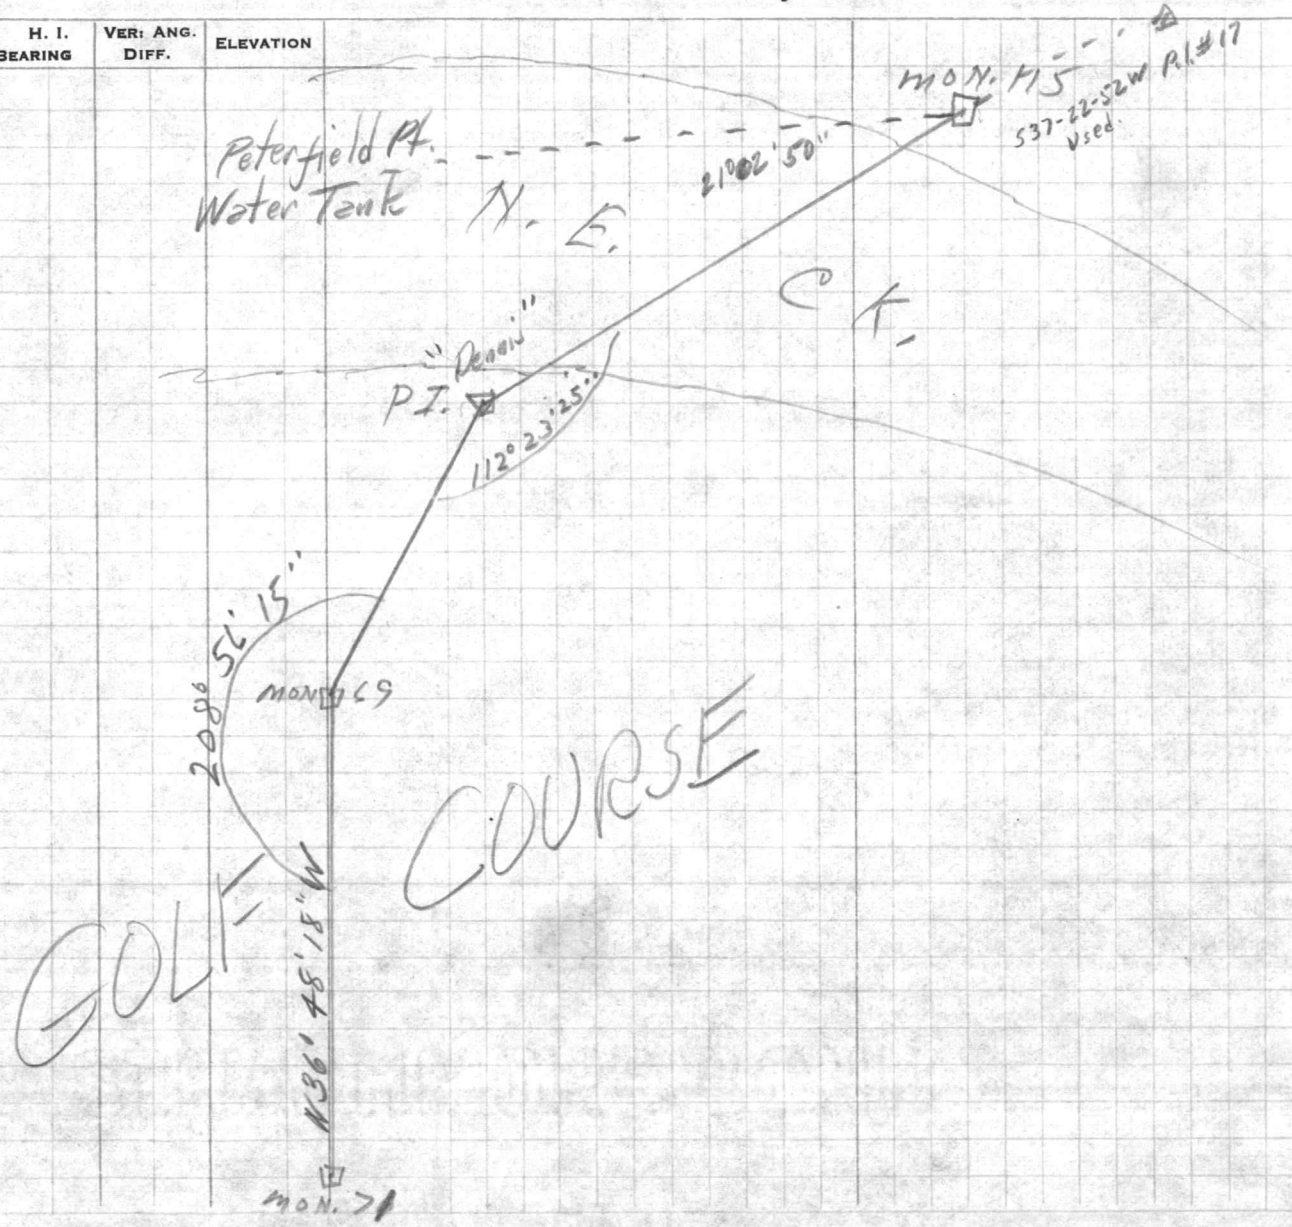



































SUBJECT Booring check from
MON. # 93 & 129 in E of Holc.
Blvd. to MON. # 162 & 163 Along
110,000 KV TRANS. Line from
C.L. to C.P.

RETURN TO
 PUBLIC WORKS
 OFFICE
 CAMP LEJEUNE
 NORTH CAROLINA

FIELD PARTY

Hollum IN CHARGE
 _____ INSTRUMENT
 _____ NOTES
 _____ TAPE READ
 _____ TAPE OR ROD
 _____ TAPE OR ROD
 _____ INSTRUMENT No.
 _____ TAPE No.

WEATHER

CLEAR _____ SNOW _____
 CLOUDY _____ HOT _____
 WINDY _____ MODERATE _____
 RAIN _____ COLD _____
 FAIR _____ FOG _____
 FIGURED BY _____
 NOTES CHECKED BY _____
 PLOTTED BY _____

FILE No. _____
 FLDR. No. _____
 SHEET 1-07
 DATE 9-24 1958

Quad. No. _____


STATION	DIST.	ANGLE ° ' "	+	H. I. BEARING	VER: ANG. DIFF.	ELEVATION
---------	-------	----------------	---	------------------	--------------------	-----------

P.I. #3
 1-155° 57' 15"
 3-107° 52' 15"
 MEAN-155° 57' 25"

P.I. #4
 1-158° 30' 15"
 3-115° 31' 00"
 MEAN-158° 30' 20"

P.I. #1
 1-197° 44' 15"
 3-233° 12' 15"
 MEAN-197° 44' 05"

MON #93
 1-180° 46' 45"
 3-182° 20' 45"
 MEAN-180° 46' 55"

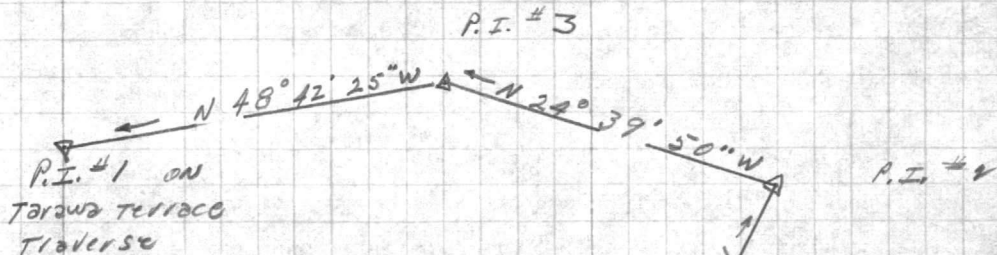

Holcomb Blvd.

Brewster Blvd.

MON. #93

MON. #129

"Truesdale"



VALLEY





































SUBJECT: Checks

RETURN TO
PUBLIC WORKS
OFFICE
CAMP LEJEUNE
NORTH CAROLINA

FIELD PARTY
Denno IN CHARGE
INSTRUMENT
NOTES
TAPE READ
TAPE OR ROD
TAPE OR ROD
INSTRUMENT NO.
TAPE NO.

WEATHER
CLEAR
CLOUDY
WINDY
RAIN
FAIR
SNOW
HOT
MODERATE
COLD
FOG
FIGURED BY
NOTES CHECKED BY
PLOTTED BY

FILE No. _____
FLDR. No. _____
SHEET 1
DATE 10/10/1958

Quad. No. _____

STATION	DIST.	ANGLE ° ' "	+	H. I. BEARING	VER. ANG. DIFF.	ELEVATION
AT 39	1	6 45 30				
414	3	20 16 30				
323	m	6 45 30	✓			
AT 414	1	145 03 15				
9C	3	75 09 45				
39	m	145 03 15	+			
AT 9C	1	205 14 30				
9B	3	255 43 30				
MON. 414	m	205 14 30	✓			
AT 9B	1	104 57 45				
9A	3	314 53 15				
9C	m	104 57 45	-			
AT 9A	1	178 31 30				
9	3	175 34 15				
TO 9B	m	178 31 25	✓			
AT 9	1	251 10 15				
8	3	33 30 45				
TO 9A	m	251 10 15	+			

NOT used
Approx. 36" worse than one used.

414 7
3 41
—
36

(279)

① $251^{\circ} 10' 15''$
 $\frac{253^{\circ} 30' 3''}{3}$

③ $33^{\circ} 30' 45''$

① $128^{\circ} 31' 30''$
 $\frac{533^{\circ} 50' 30''}{175}$
 $353^{\circ} 59' 15''$
 $\frac{178^{\circ} 31' 25''}{3}$

① $104^{\circ} 57' 45''$
 ③ $314^{\circ} 53' 15''$



VALUABLE

SUBJECT _____

RETURN TO
 PUBLIC WORKS
 OFFICE
 CAMP LEJEUNE
 NORTH CAROLINA

FIELD PARTY

 IN CHARGE

 INSTRUMENT

 NOTES

 TAPE READ

 TAPE OR ROD

 TAPE OR ROD

 INSTRUMENT NO. _____
 TAPE NO. _____

WEATHER

CLEAR
 CLOUDY
 WINDY
 RAIN
 FAIR
 SNOW
 HOT
 MODERATE
 COLD
 FOG

FILE No. _____
 FLDR. No. _____
 SHEET 2
 DATE _____ 19__

FIGURED BY _____
 NOTES CHECKED BY _____
 PLOTTED BY _____
 Quad. No. _____

STATION	DIST.	ANGLE ° ' "	+	H. I. BEARING	VER. ANG. DIFF.	ELEVATION
AT 4	1	267 56 15				
3	3	83 49 15				
5	m	267 56 25			-10"	
AT 3	1	157 26 45				
2	3	112 20 45				
4	m	157 26 55			+05"	
AT 2	1	201 45 45				
1	3	245 17 15				
3	m	201 45 45			+10"	
AT 1	1	188 55 45				
503	3	206 47 30				
2	m	188 55 40			+25"	
AT 503	1	146 37 15				
339	3	79 51 30				
P.I.	1	m 146 37 10			-1'55"	
AT 339	1	261 43 00				
39	3	65 09 30				
503	m	261 43 10			+45"	










VALUABLE

 SUBJECT _____

 RETURN TO
 PUBLIC WORKS
 OFFICE
 CAMP LEJEUNE
 NORTH CAROLINA

FIELD PARTY

 _____ IN CHARGE
 _____ INSTRUMENT
 _____ NOTES
 _____ TAPE READ
 _____ TAPE OR ROD
 _____ TAPE OR ROD
 _____ INSTRUMENT NO.
 _____ TAPE NO.

WEATHER

 CLEAR
 CLOUDY
 WINDY
 RAIN
 FAIR
 SNOW
 HOT
 MODERATE
 COLD
 FOG

FILE No. _____

FLDR. No. _____

 SHEET **3**

DATE _____

19____

 FIGURED BY _____
 NOTES CHECKED BY _____
 PLOTTED BY _____

Quad. No. _____

STATION	DIST.	ANGLE ° ' "	+	H. I. BEARING	VER: ANG. DIFF.	ELEVATION
AT 512	1	252 10 45				
8	3	36 32 45	-10"			
10	m	252 10 55				
AT 8	1	137 44 30				
7	3	53 13 15	+05"			
512	m	137 44 25				
AT 7	1	184 34 00				
514	3	193 42 15	-10"			
8	m	184 34 05				
AT 51A	1	92 12 45				
5	3	276 38 15				
7	m	92 12 45				
AT 5	1	171 12 00				
4	3	153 36 00	-10"			
514	m	171 12 00				

P.I. 9

P.I. 9

= P.I. 6

= P.I. 6

P.I. 6

























VALUABLE

SUBJECT _____

RETURN TO
 PUBLIC WORKS
 OFFICE
 CAMP LEJEUNE
 NORTH CAROLINA

FIELD PARTY

 IN CHARGE

 INSTRUMENT

 NOTES

 TAPE READ

 TAPE OR ROD

 TAPE OR ROD

 INSTRUMENT No. _____
 TAPE No. _____

WEATHER

CLEAR
 CLOUDY
 WINDY
 RAIN
 FAIR
 SNOW
 HOT
 MODERATE
 COLD
 FOG
 FIGURED BY _____
 NOTES CHECKED BY _____
 PLOTTED BY _____

FILE No. _____
 FLDR. No. _____
 SHEET 4
 DATE _____ 19____

Quad. No. _____

STATION	DIST.	ANGLE		+	H. I. BEARING	VER: ANG. DIFF.	ELEVATION	
		°	' "					
AT 1A	1	75	31 30					
	12	3	226 34 30					
	13	m	75 31 30	✓				
						MON. 97		ON FIRST TRAVERSE
								ON FIRST TRAVERSE
AT 12	1	214	28 15					
	500	3	283 25 15					
P.I. 1A	m	214	28 35	+15"		MON. 97		ON FIRST TRAVERSE
AT 500	1	100	45 45					
	9	3	302 17 45					
	12	m	100 45 55	+10"				
								= P.I. 11
AT 10	1	162	03 45					
	512	3	126 11 45					
	500	m	162 03 55	+05"				

VALUABLE

RETURN TO
PUBLIC WORKS
OFFICE
CAMP LEJEUNE
NORTH CAROLINA

SUBJECT

*Location & Elev. of Tie of
Last 8" Water Line to Old Line
at Water Treatment Plant*

FIELD PARTY

IN CHARGE

INSTRUMENT

NOTES

TAPE READ

TAPE OR ROD

TAPE OR ROD

INSTRUMENT NO.

TAPE NO.

WEATHER

CLEAR
CLOUDY
WINDY
RAIN
FAIR
SNOW
HOT
MODERATE
COLD
FOG


FILE No. 99-Gen
FLDR. No. _____
SHEET _____
DATE _____ 19__

Quad. No. _____

STATION	DIST.	ANGLE ° ' "	+	H. I. BEARING	VER: ANG. DIFF.	ELEVATION
				3.09 27.40		24.31
<i>Top of New 10" x 8" Tee</i>				7.92		19.48

Fl. Elev. of W

*4.68
6.24
7.92*

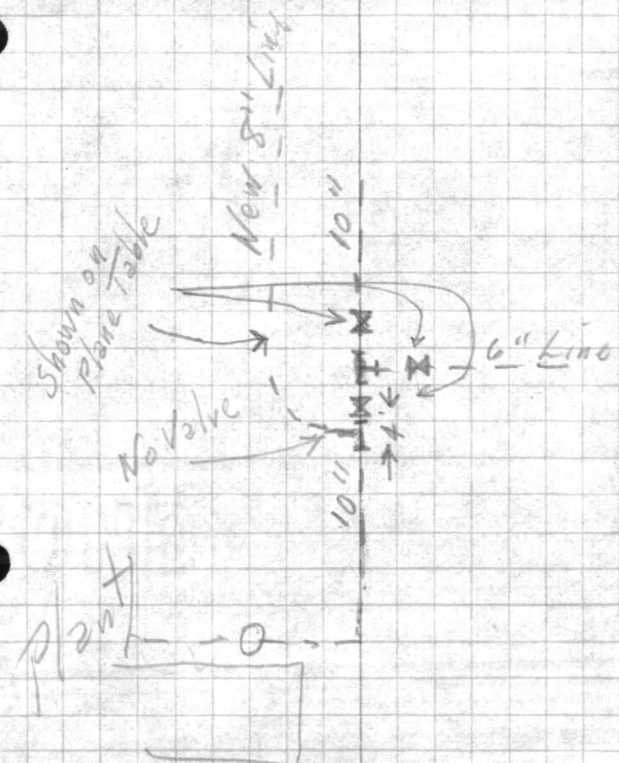































VALUABLE

SUBJECT

Reference MON. # 416

RETURN TO
PUBLIC WORKS
OFFICE
CAMP LEJEUNE
NORTH CAROLINA

FIELD PARTY

IN CHARGE _____
INSTRUMENT _____
NOTES _____
TAPE READ _____
TAPE OR ROD _____
TAPE OR ROD _____
INSTRUMENT No. _____
TAPE No. _____

WEATHER

CLEAR _____ SNOW _____
CLOUDY _____ HOT _____
WINDY _____ MODERATE _____
RAIN _____ COLD _____
FAIR _____ FOG _____
FIGURED BY _____
NOTES CHECKED BY _____
PLOTTED BY _____

FILE No. _____

FLDR. No. _____

SHEET

1 of 5

DATE

10-14-58

Quad. No. _____

STATION	DIST.	ANGLE ° ' "	+	H. I. BEARING	VER. ANG. DIFF.	ELEVATION
---------	-------	----------------	---	------------------	--------------------	-----------

Animal Hospital

AMACO Gas Sta.

Monument Location for 416 (USMC)

North Lane

To J'ville

N.C. Highway # 29

To swansboro

South Lane

Edge of Road

94.5'

Small Pine Growth

83'

11'

MON. # 416

M.B. R.R.

File 1.22

8.54
































VALUABLE

SUBJECT

Reference Mon. # 39

RETURN TO
PUBLIC WORKS
OFFICE
CAMP LEJEUNE
NORTH CAROLINA

FIELD PARTY

____ IN CHARGE
____ INSTRUMENT
____ NOTES
____ TAPE READ
____ TAPE OR ROD
____ TAPE OR ROD
____ INSTRUMENT No.
____ TAPE No.

WEATHER

CLEAR
CLOUDY
WINDY
RAIN
FAIR
SNOW
HOT
MODERATE
COLD
FOG

FILE No. _____

FLDR. No. _____

SHEET

2 of 5


DATE

10-14 1958

Quad. No. _____

STATION	DIST.	ANGLE ° ' "	+	H. I. BEARING	VER. ANG. DIFF.	ELEVATION
---------	-------	----------------	---	------------------	--------------------	-----------

Henderson
+
Hayes
Elec. Appliances

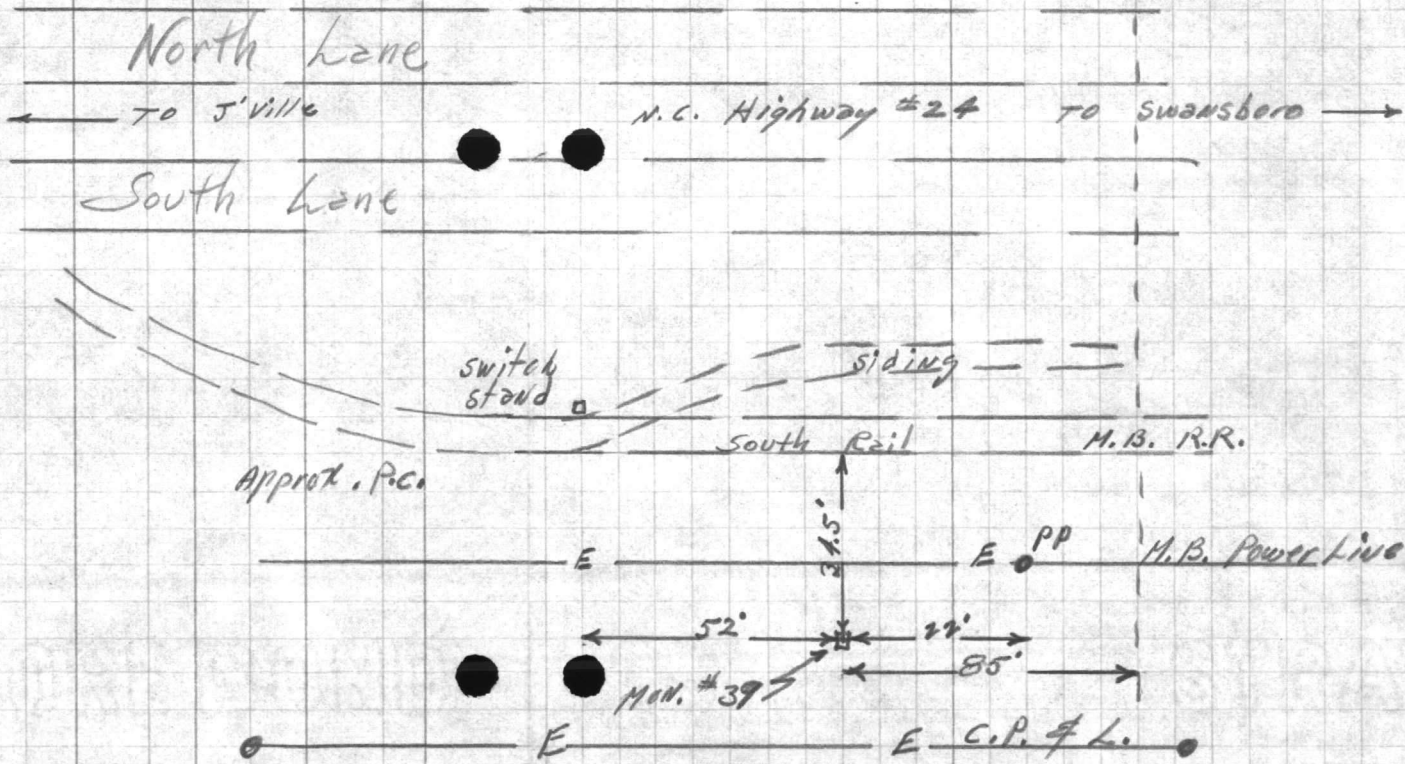

Camp Knox Rd.




























VALUABLE

SUBJECT Reference MON. # 512

RETURN TO
PUBLIC WORKS
OFFICE
CAMP LEJEUNE
NORTH CAROLINA

FIELD PARTY

____ IN CHARGE
____ INSTRUMENT
____ NOTES
____ TAPE READ
____ TAPE OR ROD
____ TAPE OR ROD
____ INSTRUMENT NO.
____ TAPE NO.

WEATHER

____ CLEAR
____ CLOUDY
____ WINDY
____ RAIN
____ FAIR
____ SNOW
____ HOT
____ MODERATE
____ COLD
____ FOG
FIGURED BY _____
NOTES CHECKED BY _____
PLOTTED BY _____

FILE No. _____

FLDR. No. _____

SHEET

4-075

DATE

10-14-58

Quad. No. _____

Hagaru Drive

STATION	DIST.	ANGLE ° ' "	H. I. BEARING	VER: ANG. DIFF.	ELEVATION
---------	-------	----------------	------------------	--------------------	-----------

House # 3405	# 3403
-----------------	-----------

3401

16.5'

5'

MON. # 512

PINE

GROWTH

open Area

89'

old Rd.

Rd.


Rd.

JE

GREEN HOUSE

TO CAMP KINGS RD.

Earth

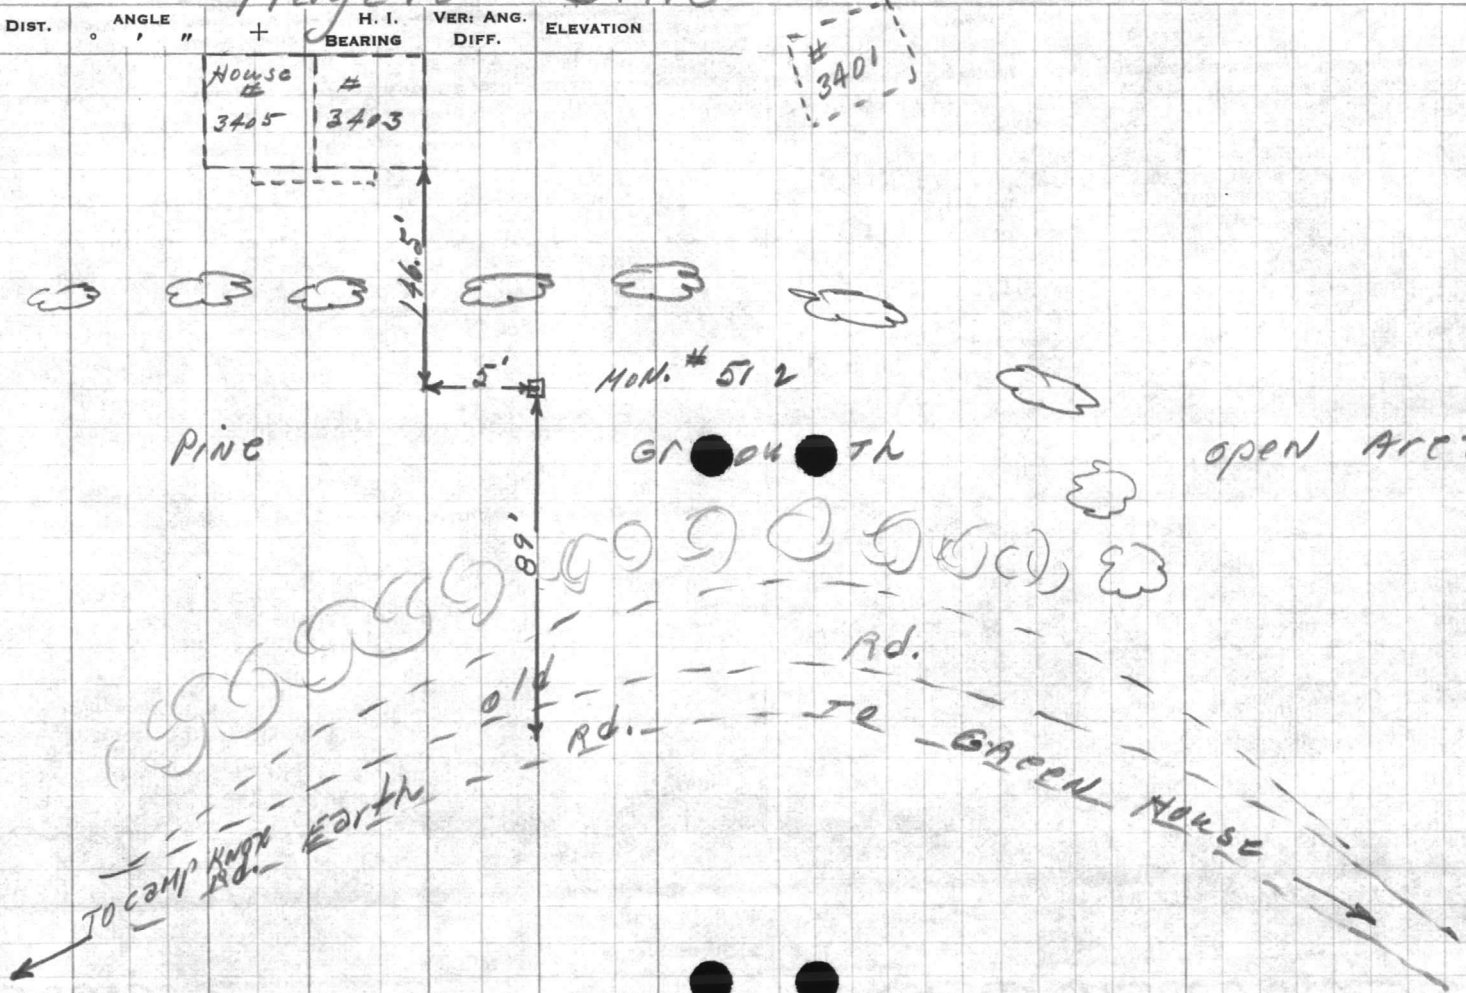

VALUABLE

SUBJECT Reference Mon. # 500

RETURN TO
PUBLIC WORKS
OFFICE
CAMP LEJEUNE
NORTH CAROLINA

FIELD PARTY

IN CHARGE

INSTRUMENT

NOTES

TAPE READ

TAPE OR ROD

TAPE OR ROD

INSTRUMENT No.

TAPE No.






WEATHER

CLEAR _____ SNOW _____
CLOUDY _____ HOT _____
WINDY _____ MODERATE _____
RAIN _____ COLD _____
FAIR _____ FOG _____
FIGURED BY _____
NOTES CHECKED BY _____
PLOTTED BY _____

FILE No. _____
FLDR. No. _____
SHEET 5-075
DATE 10-14 1958

Quad. No. _____

STATION	DIST.	ANGLE			H. I. BEARING	VER. ANG. DIFF.	ELEVATION
		°	'	"			

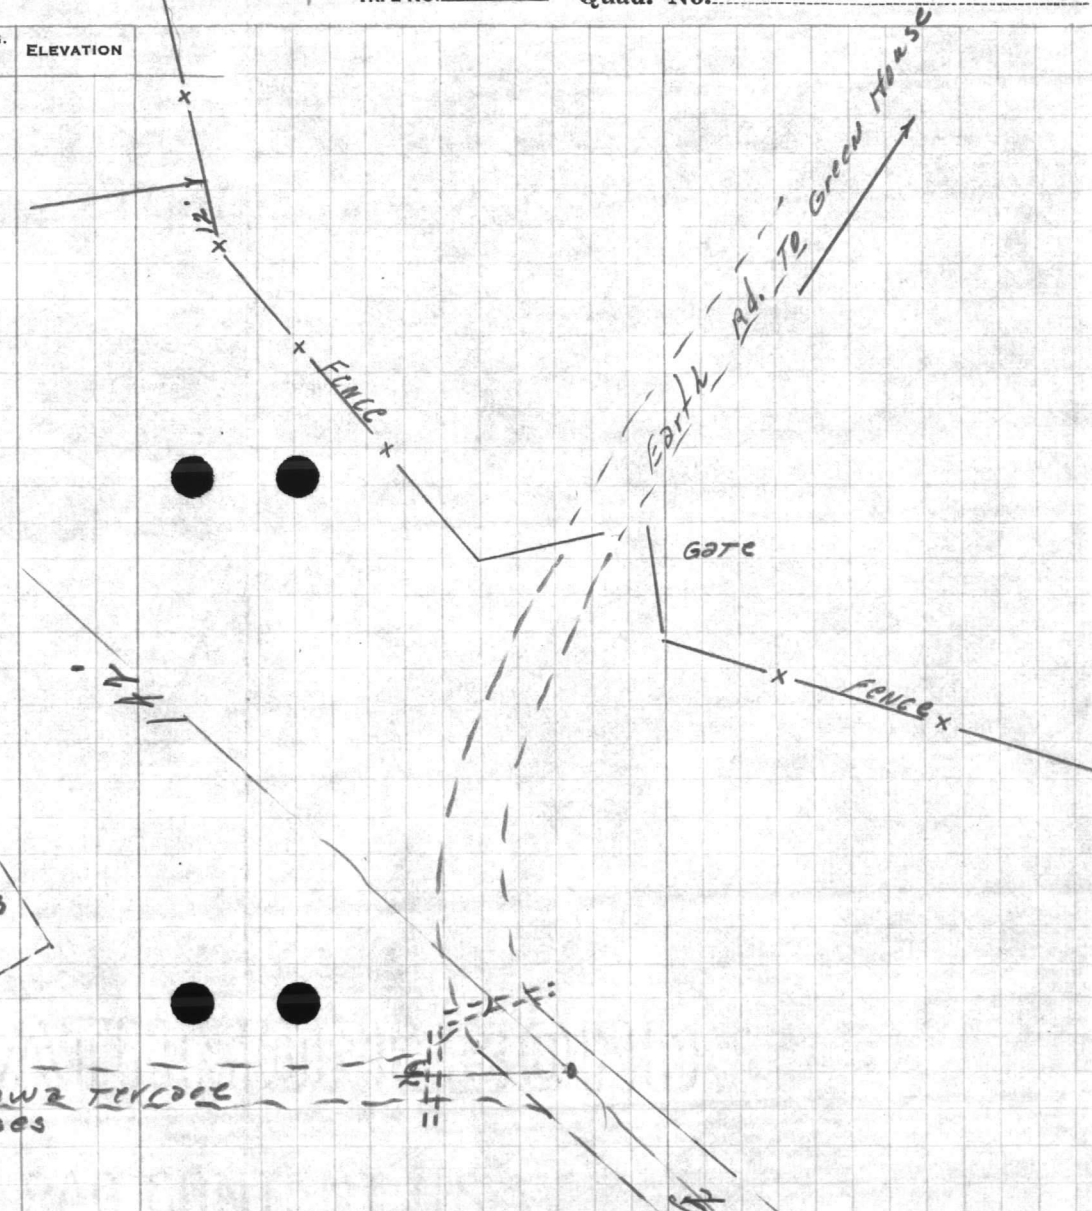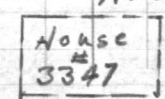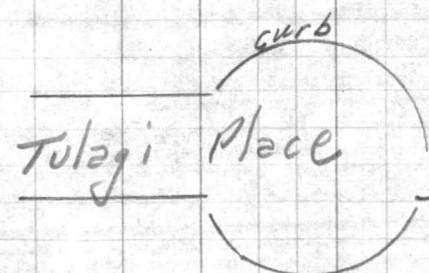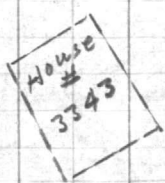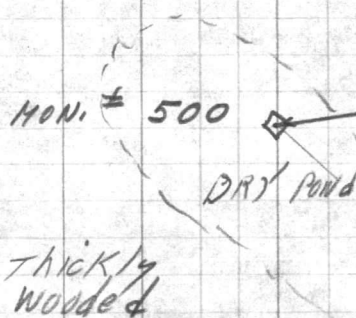

VALUABLE
RETURN TO
NORTH CAROLINA

SUBJECT

STATION

Dist.

DATE TIME
+








VALUABLE

RETURN TO
PUBLIC WORKS
OFFICE
CAMP LEJEUNE
NORTH CAROLINA

SUBJECT REF. MON. # 97 & 98
NEAR SEWAGE PLANT
TARAWA TERRACE

50.62' 24.91'

FIELD PARTY

DENNIS IN CHARGE
INSTRUMENT _____
NOTES _____
TAPE READ _____
TAPE OR ROD _____
TAPE OR ROD _____
INSTRUMENT NO. _____
TAPE NO. _____

WEATHER

CLEAR SNOW
CLOUDY HOT
WINDY MODERATE
RAIN COLD
FAIR FOG
FIGURED BY _____
NOTES CHECKED BY _____
PLOTTED BY _____

FILE No. _____
FLDR. No. _____
SHEET 1 of 1
DATE 10-9-58

Quad. No. _____

STATION	DIST.	ANGLE		+	H. I. BEARING	VER. ANG. DIFF.	ELEVATION
		°	' "				

63.89
1.22
62.67

Northeast Creek



NAIL IN BOTTLE CAP

MON. # 97 USMC


SEWAGE DISPOSAL AREA

DITCH

BLDG.

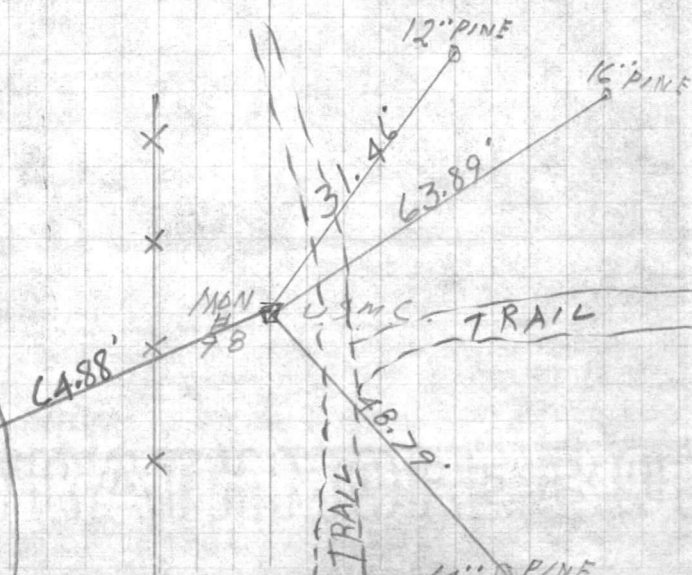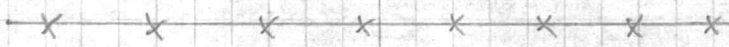

31.46
1.22
30.24 1.22

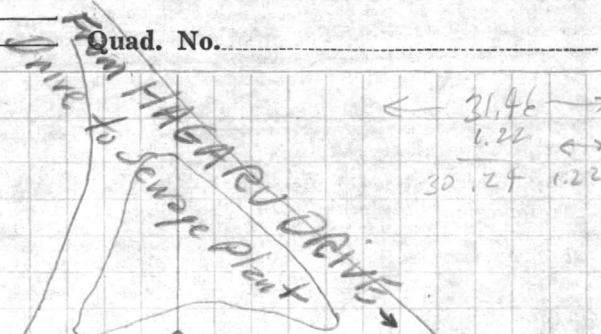

MON. # 98 USMC TRAIL

64.88'

31.46'
63.89'
48.72'

14\"/>

VALUABLE

STATION NO.
PUBLIC WORKS
OFFICE
NORTH CAROLINA

SUBJECT

STATION DIST

BEARING DIST
H. T. YER. AN
ELEVATION

TAB NO.
INSTRUMENT NO.

TAB OR ROD

TAB OR P.O.

TAB OR S.O.

NOTES

IN CHARGE

WEATHER

DATE

NOTES

BY

DATE

SHEET

PLAN NO.

FILE NO.