

VALUABLE

RETURN TO
PUBLIC WORKS
OFFICE
CAMP LEJEUNE
NORTH CAROLINA

SUBJECT LOCATION & ELEV. NEW
WELL HOUSE ON NEW
WATER LINE BETWEEN CAMP
KNOX & TARAWA TERRACE

FIELD PARTY
DENNIS IN CHARGE
INSTRUMENT
NOTES
TAPE READ
TAPE OR ROD
TAPE OR ROD
INSTRUMENT No.
TAPE No.


WEATHER
CLEAR
CLOUDY
WINDY
RAIN
FAIR
SNOW
HOT
MODERATE
COLD
FOG
FIGURED BY
NOTES CHECKED BY
PLOTTED BY

FILE No. 99-R
FLDR. No.
SHEET 1 of 1
DATE 5-8-59

Quad. No.

STATION	DIST.	ANGLE			+	H. I. BEARING	VER. ANG. DIFF.	ELEVATION
		°	'	"				
B.M.						3 95 24 64	20 69	
FLOOR NEW WELL HOUSE						4.75 19 89		

SPIKE IN ROOT GUM NEAR NEW WELL HOUSE

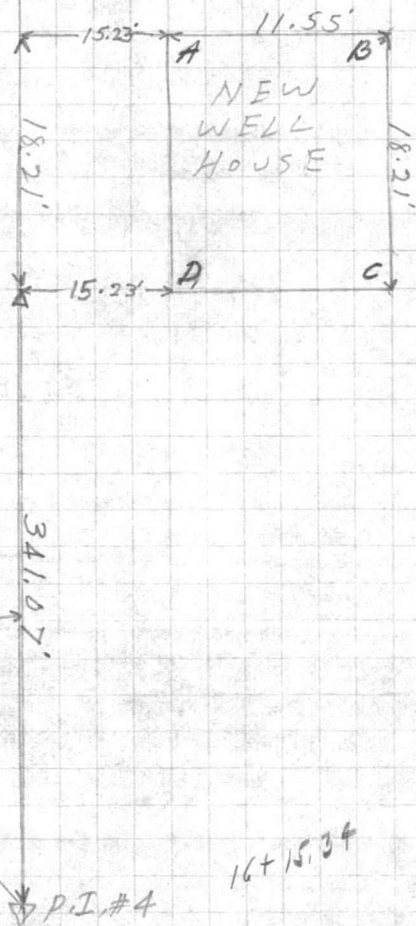

VALUABLE SUBJECT

STATION
DIR.
DIST.




VALUABLE

RETURN TO
PUBLIC WORKS
OFFICE
CAMP LEJEUNE
NORTH CAROLINA

SUBJECT B.M. FOR PROPOSED
WATER LINE MONTFORD
PT. TO TARAWA TERRACE

FIELD PARTY
DENNIS IN CHARGE

INSTRUMENT

NOTES

TAPE READ

TAPE OR ROD

TAPE OR ROD

INSTRUMENT NO. _____
TAPE NO. _____

WEATHER
CLEAR _____ SNOW _____
CLOUDY _____ HOT _____
WINDY _____ MODERATE _____
RAIN _____ COLD _____
FAIR _____ FOG _____
FIGURED BY _____
NOTES CHECKED BY _____
PLOTTED BY _____

FILE No. 99-R
FLDR. No. _____
SHEET 1 of 2
DATE 12-8-58

Quad. No. _____

STATION	DIST.	ANGLE ° ' "	+	H. I. BEARING	VER: ANG. DIFF.	ELEVATION	
B.M.				4 11 25 82		21 71.5	MON. # 512
T.P.				5 77 28.05		3 54 22.28	
T.P.				4 03 27 94		4 14 23.91	
B.M.				3 31 27.99		3 26 24.68	ON BACK BOLT FIRE HYD. BETWEEN STREET AND HOUSE # 3220
T.P.				3 56 27.50		4 05 23.94	
T.P.				5 91 24.85		8 56 18.94	
B.M.				10 27 14.58	14.55	14.55	MON. 514

