

VALUABLE

SUBJECT Location of 11th Street Extended
from Church St. to Curtis Road for
Proposed Sewage & water service
Topo trailer Park

RETURN TO
 PUBLIC WORKS
 OFFICE
 CAMP LEJEUNE
 NORTH CAROLINA

FIELD PARTY

Caulk IN CHARGE
Ketchum INSTRUMENT
C. — NOTES
Smith TAPE READ
Davis TAPE OR ROD
Morris TAPE OR ROD

INSTRUMENT No. _____
 TAPE No. _____

WEATHER

CLEAR
 CLOUDY
 WINDY
 RAIN
 FAIR

SNOW
 HOT
 MODERATE
 COLD
 FOG

FILE No. 117-5

FLDR. No. _____


SHEET 1 of

NOTES CHECKED BY _____

PLOTTED BY _____ DATE 11-21 1952

Quad. No. _____

| STATION | DIST. | ANGLE ° ' " + | H. I. BEARING | VER: ANG. DIFF. | ELEVATION |
|----------|--------|------------------|------------------|--------------------|------------|
| 10+73.92 | | Pot #1 | | | |
| | 383.70 | | | | |
| 6+90.22 | | | | | |
| 3+45.13 | | | | | |
| 2+99.13 | | | | | |
| | | | | | 276.9' Rt. |
| 0+88 | | | | | 50' Rt. |
| 0+29 | | | | | 43' Rt. |
| 0+00 | | | | | |

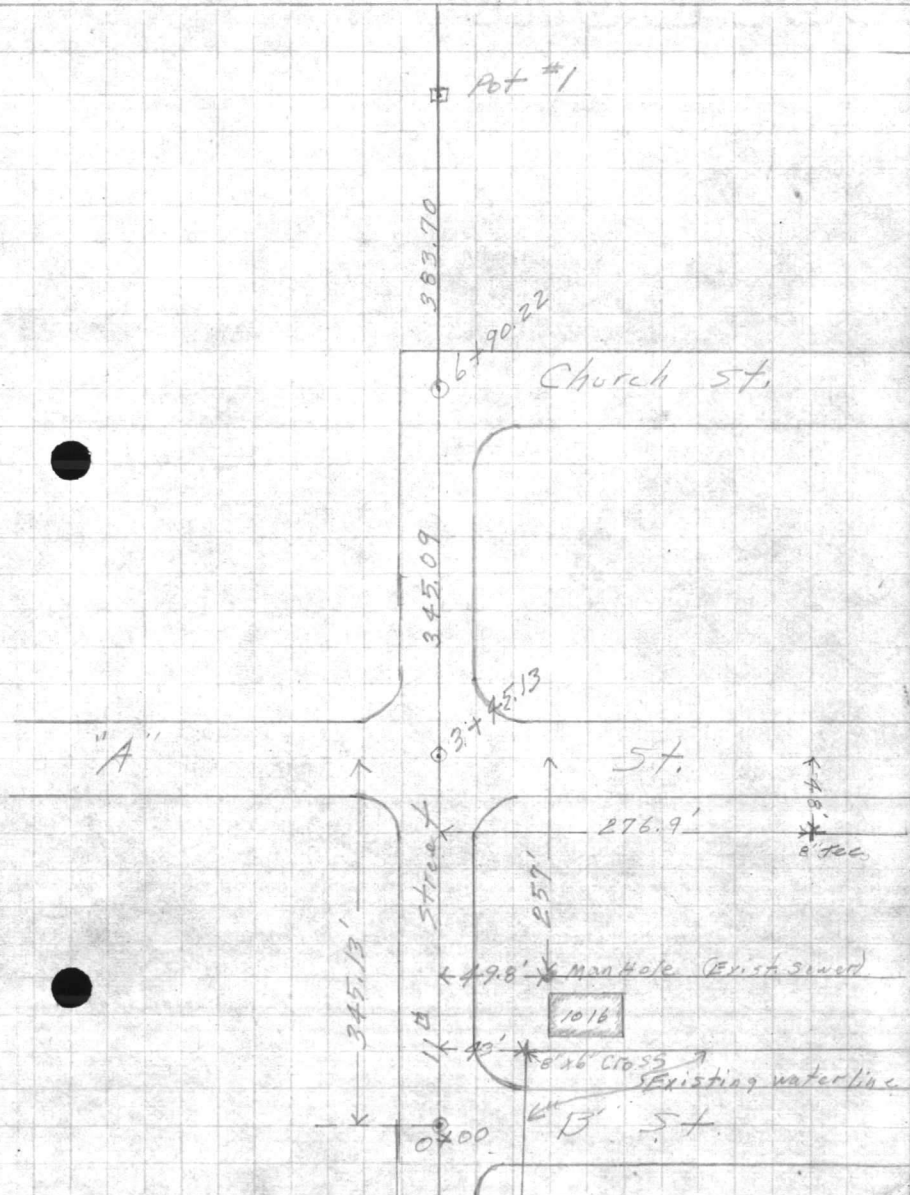

























VALUABLE

SUBJECT _____

 RETURN TO
 PUBLIC WORKS
 OFFICE
 CAMP LEJEUNE
 NORTH CAROLINA

FIELD PARTY

 _____ IN CHARGE
 _____ INSTRUMENT
 _____ NOTES
 _____ TAPE READ
 _____ TAPE OR ROD
 _____ TAPE OR ROD
 _____ INSTRUMENT NO.
 _____ TAPE NO.

WEATHER

 CLEAR SNOW
 CLOUDY HOT
 WINDY MODERATE
 RAIN COLD
 FAIR FOG

FILE No. _____

FLDR. No. _____

SHEET 2 of

FIGURED BY _____


NOTES CHECKED BY _____

PLOTTED BY _____

DATE 11-22 1952

Quad. No. _____

| STATION | DIST. | ANGLE | | | H. I. BEARING | VER: ANG. DIFF. | ELEVATION |
|----------|--------|-------|---|---|------------------|--------------------|------------|
| | | ° | ' | " | | | |
| 24+76.96 | | | | | | | PI #3 |
| | 299.95 | | | | | | (Computed) |
| 21+77.01 | | | | | | | PI #1 |
| | 259.06 | | | | | | |
| 19+17.95 | | | | | | | POt #3 |
| | 463.47 | | | | | | |
| 17+12 | | | | | | | |
| 14+54.48 | | | | | | | POt #2 |
| | 380.56 | | | | | | |

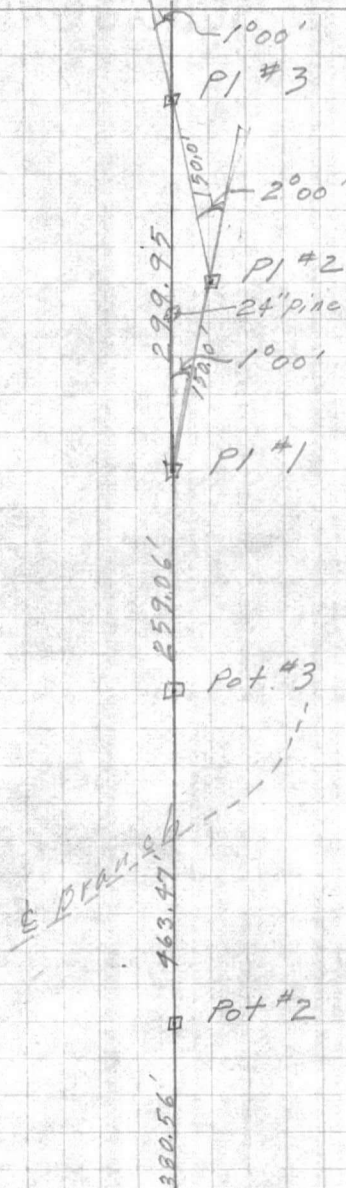










 

VALUABLE

SUBJECT _____

RETURN TO
PUBLIC WORKS
OFFICE
CAMP LEJEUNE
NORTH CAROLINA

FIELD PARTY

 _____ IN CHARGE
 _____ INSTRUMENT
 _____ NOTES
 _____ TAPE READ
 _____ TAPE OR ROD
 _____ TAPE OR ROD
 _____ INSTRUMENT No.
 _____ TAPE No.

WEATHER

 CLEAR _____ SNOW _____
 CLOUDY _____ HOT _____
 WINDY _____ MODERATE _____
 RAIN _____ COLD _____
 FAIR _____ FOG _____

FILE No. _____

FLDR. No. _____

FIGURED BY _____ SHEET 3 of

NOTES CHECKED BY _____

PLOTTED BY _____ DATE 11-22 1952

Quad. No. _____

| STATION | DIST. | ANGLE | | + | H. I. BEARING | VER: ANG. DIFF. | ELEVATION |
|----------|-------|-------|-----|---|------------------|--------------------|-----------|
| | | ° | ' " | | | | |
| 36+50.66 | | | | | | | |
| | | | | | | | |
| 4+79.52 | | | | | | | |
| | | | | | | | |
| 31+71.14 | | | | | | | |
| | | | | | | | |
| | | | | | | | |
| 29+71.16 | | | | | | | |
| | | | | | | | |

Pot #4

4+79.52

PI #6

199.98 (computed)

31+71.14

29+71.16

PI #4

494.20

318.43

Pot #4

479.52

0°50'00"

PI #6

100.01

1°40'00"

PI #5

24" pine

100.0

0°50'00"

PI #4

VALUABLE

SUBJECT _____

RETURN TO
 PUBLIC WORKS
 OFFICE
 CAMP LEJEUNE
 NORTH CAROLINA

FIELD PARTY

 IN CHARGE

 INSTRUMENT

 NOTES

 TAPE READ

 TAPE OR ROD

 TAPE OR ROD

 INSTRUMENT NO. _____
 TAPE NO. _____


WEATHER

CLEAR _____ SNOW _____
 CLOUDY _____ HOT _____
 WINDY _____ MODERATE _____
 RAIN _____ COLD _____
 FAIR ✓ _____ FOG _____
 FIGURED BY _____
 NOTES CHECKED BY _____
 PLOTTED BY _____

FILE No. _____
 FLDR. No. _____
 SHEET 4 of _____
 DATE 11-24 1952

Quad. No. _____

| STATION | DIST. | ANGLE | | | + | H. I. BEARING | VER: ANG. DIFF. | ELEVATION |
|----------|--|-------|---|---|---|-------------------------|--------------------|-----------|
| | | ° | ' | " | | | | |
| PI #2 | | | | | | | | |
| PI #1 | (1) 302 57 40 (3) 188 53 00 4+35.88 (mean) 302 57 40 | | | | | ↖ Curtis Rd. & Dirt Rd. | | |
| 39+69.09 | (1) 54 23 00 (3) 163 09 40 3+18.43 (mean) 54 23 13 | | | | | ↖ Curtis Road | | |
| 36+50.66 | | | | | | | | |
| 4+79.52 | | | | | | | | |

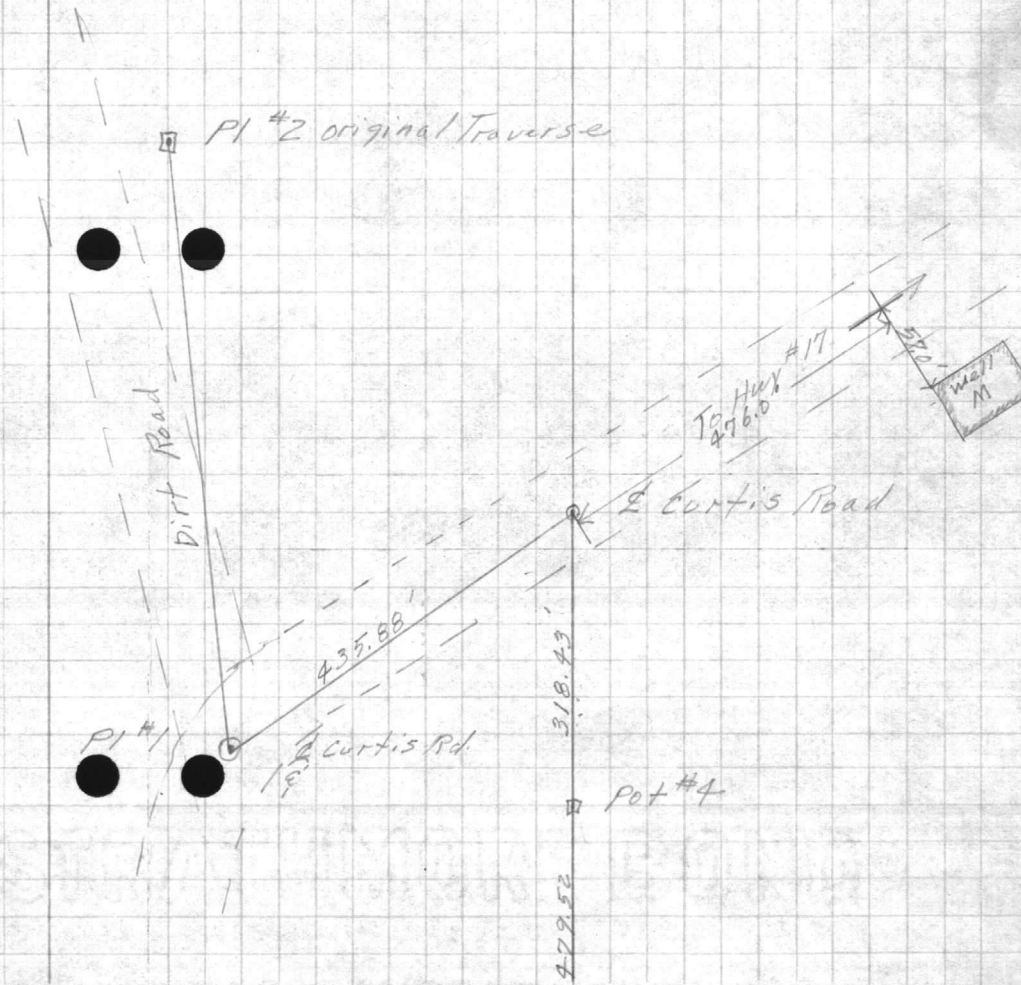








