

118-A

Steam

TC #2
49.68.

61.39
148.74
59.98
148.74

418.85-

203
84.90
33.77

51.13

5+30.30

~~5+40.00~~

1.48.30

~~6+89.04~~

VALUABLE

Return To
Public Works
Office
Camp Lejeune
North Carolina

SUBJECT Stake out of Proposed
Heating plant addition and
proposed steam outlet at tent
CAMP #2


FIELD PARTY
DeLora In Charge
Instrument _____
Notes _____
Tape Read _____
Tape or Rod _____
Tape or Rod _____
Instrument No. _____
Tape No. _____

WEATHER
Clear _____
Cloudy _____
Windy _____
Rain _____
Fair _____
Snow _____
Hot _____
Moderate _____
Cold _____
Fog _____
Figured By _____
Notes Checked By _____
Plotted By _____


FILE No. TB
Fldr. No. 45
Sheet 1-04
Date 4-30-1951

Quad. No. _____

Station	Dist.	Angle	H. I. Bearing	Ver: Ang. Diff.	Elevation
			<i>F</i>	<i>"D"</i>	<i>ST.</i>

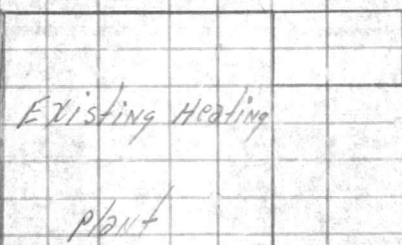

P.I. 3+33.77 = 1. 90°-01'45"
0+00 3. 270°-05'15"
Mean - 90°-01'45"

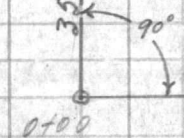

13+24.44 TRUNK "A" = }
0+00 BRANCH A-1


10+10.11 TRUNK "A" = }
0+00 BRANCH A-2

5+30.30 TRUNK "A" = }
0+00 BRANCH A-3

3+84.90 TRUNK "A" = }
0+00 BRANCH A-4

P.I. 3+33.77 TRUNK "A" = }
0+00 BRANCH A-5

STEAM TRUNK LINE "A"

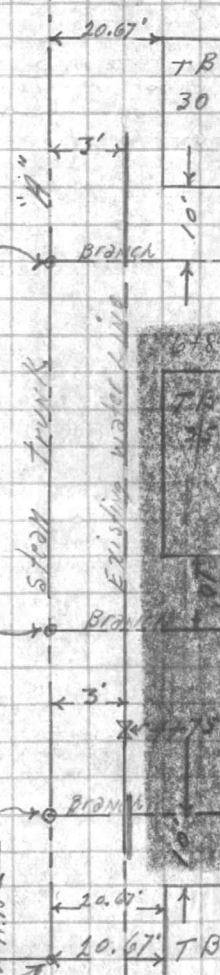




















VALUABLE

SUBJECT Proposed steam line
Stakeout at tent camp #2

Return To
Public Works
Office
Camp Lejeune
North Carolina

FIELD PARTY
In Charge _____
Instrument _____
Notes _____
Tape Read _____
Tape or Rod _____
Tape No. _____
Instrument No. _____
Tape No. _____

WEATHER
Clear _____
Cloudy _____
Windy _____
Rain _____
Fair _____
Snow _____
Hot _____
Moderate _____
Cold _____
Fog _____
Figured By _____
Notes Checked By _____
Plotted By _____

FILE No. _____



Fldr. No. _____

Sheet 2 of


Date 5-1-1951

Quad. No. _____

Station Dist. Angle " + H. I. Bearing Ver: Ang. Diff. Elevation

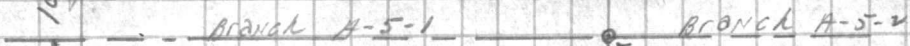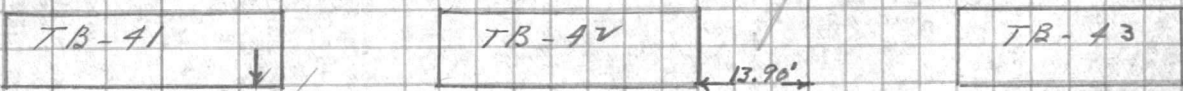

3+06.50 BRANCH A-5-1
0+00 BRANCH A-5-1 AND A-5-2

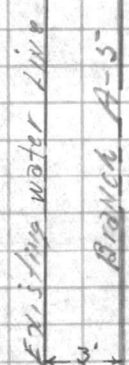

3+33.77 TRUNK #2
0+00 BRANCH A-5
"H" TO Plot ->

TRUNK

3 + 01.3
11.0

2.94.3


VALUABLE

SUBJECT Profile on steam Trunk
Line "A"Return To
Public Works
Office
Camp Lejeune
North CarolinaFIELD PARTY
Belton In Charge
Instrument _____
Notes _____
Tape Read _____
Tape or Rod _____
Tape or Rod _____
Instrument No. _____
Tape No. _____WEATHER
Clear _____
Cloudy _____
Windy _____
Rain _____
Fair _____
Snow _____
Hot _____
Moderate _____
Cold _____
Fog _____
Figured By _____
Notes Checked By _____
Plotted By _____FILE No. _____
Fldr. No. _____
Sheet 1 of _____
Date 5-1- 19 51

Quad. No. _____

Station	Dist.	Angle	"	+	H. I. Bearing	Ver: Ang. Diff.	Elevation
---------	-------	-------	---	---	------------------	--------------------	-----------

13. M.					✓		18.47
--------	--	--	--	--	---	--	-------

		2.67			21.14		
--	--	------	--	--	-------	--	--

0+00						6.7	14.4
------	--	--	--	--	--	-----	------

450						6.8	14.3
-----	--	--	--	--	--	-----	------

1+						6.7	14.4
----	--	--	--	--	--	-----	------

450						6.3	14.8
-----	--	--	--	--	--	-----	------

2+						6.2	14.9
----	--	--	--	--	--	-----	------

450						5.7	15.4
-----	--	--	--	--	--	-----	------

2+54.3						27.7	Right
--------	--	--	--	--	--	------	-------

2+67						5.7	15.4
------	--	--	--	--	--	-----	------

2+67						6.6	14.5
------	--	--	--	--	--	-----	------

Top of 18" R.O.P.

2+83.5						5.1	16.0
--------	--	--	--	--	--	-----	------

Edge of 9th St.

3+						5.0	16.1
----	--	--	--	--	--	-----	------

on street

405.3						5.1	16.0
-------	--	--	--	--	--	-----	------

Edge of 9th St.

410						4.7	16.4
-----	--	--	--	--	--	-----	------

Shoulder

421						7.1	14.0
-----	--	--	--	--	--	-----	------

E ditch

3+33.77						5.0	16.1
---------	--	--	--	--	--	-----	------

Trunk "A" = other Branch A-5
























 

VALUABLE

SUBJECT Profile on proposed steam
line contd.

Return To
Public Works
Office
Camp Lejeune
North Carolina

TRUNK LINE "A" contd.

FIELD PARTY
In Charge _____
Instrument _____
Notes _____
Tape Read _____
Tape or Rod _____
Instrument No. _____
Tape No. _____

WEATHER
Clear _____
Cloudy _____
Windy _____
Rain _____
Fair _____
Snow _____
Hot _____
Moderate _____
Cold _____
Fog _____
Figured By _____
Notes Checked By _____
Plotted By _____

FILE No. _____
Fldr. No. _____
Sheet 2-07
Date 5-1-1951

Quad. No. _____

Station	Dist.	Angle " "	+	H. I. Bearing	Ver: Ang. Diff.	Elevation	
				21.14	✓		
3+50				4.9	16.2	✓	
+74				4.7	16.4	✓	
3+84.90				5.5	15.6	✓	
0+00							BRANCH A-A
3+92				5.6	15.5	✓	
4+				4.8	16.3	✓	
+11				3.94	17.20	✓	Top of M.H.
+15.7				9.79	11.35	✓	Top of 18" T.C. sewer
+24				4.6	16.5	✓	10' Rt. CORN. 845
+43				4.3	16.8	✓	
+50				4.4	16.7	✓	
+64				4.8	16.3	✓	10' Rt. CORN. 845
+67							water valve 3.5' Rt.
+71.7							water valve 0.6' Left
+72				7.28	13.86	✓	top of water line
+75				4.1	17.0	✓	water valve 3.5' Rt.


































VALUABLE

SUBJECT

Profile on Trunk
like "A" cont'dReturn To
Public Works
Office
Camp Lejeune
North Carolina

FIELD PARTY

In Charge _____
Instrument _____
Notes _____
Tape Read _____
Tape or Rod _____
Tape or Rod _____
Instrument No. _____
Tape No. _____

WEATHER

Clear _____
Cloudy _____
Windy _____
Rain _____
Fair _____
Snow _____
Hot _____
Moderate _____
Cold _____
Fog _____

FILE No. _____

Fldr. No. _____

Sheet

3 of

Date

5-1-1951

Figured By _____

Notes Checked By _____

Plotted By _____

Quad. No. _____

Station	Dist.	Angle	"	+	H. I. Bearing	Ver: Ang. Diff.	Elevation	
					21.14 ✓			
+79					4.8	16.3	✓	
+86					4.1	17.0	✓	
+92					3.9	17.2	✓	Edge of stone "D" st.
+5					3.8	17.3	✓	on stone
+09					4.0	17.1	✓	Edge of stone "D" st.
+24.7					4.4	16.7	✓	over head power line no pole near
+30.30					4.7	16.4	✓	
+00								TRUNK "A" = BRANCH LINE A-3
+36					4.1	17.0	✓	
+50					3.7	17.4	✓	
+79								6' ht. 10" pecan tree
+6					3.0	18.1	✓	
+46								6' ht. 18" maple tree
+50					2.9	18.1	✓	
+93					6.93	14.41	✓	2' left water valve to Fire Hyd.
+7					3.4	17.7	✓	
T.P.					2.45	18.69	✓	





























VALUABLE

Return To
Public Works
Office
Camp Lejeune
North Carolina

SUBJECT TRUNK "A" profile
contd.

FIELD PARTY

In Charge _____
Instrument _____
Notes _____
Tape Read _____
Tape or Rod _____
Tape or Rod _____
Instrument No. _____
Tape No. _____

WEATHER

Clear _____
Cloudy _____
Windy _____
Rain _____
Fair _____
Snow _____
Hot _____
Moderate _____
Cold _____
Fog _____

FILE No. _____
Fldr. No. _____
Sheet 4 of
Date 5-1- 1951

Figured By _____
Notes Checked By _____
Plotted By _____
Quad. No. _____

Station	Dist.	Angle	"	+	H. I. Bearing	Ver: Ang. Diff.	Elevation	
						✓	18.69 ✓	
		3.39			22.08 22.1			
7705						4.2	17.9 ✓	
712						5.3	16.8 ✓	
720						4.3	17.8 ✓	
7724								10' Rt. cor. Bldg. # 835
748						4.8	17.3 ✓	10' Rt. cor. Bldg. # 835
755						5.1	17.0 ✓	
763						4.7	17.4 ✓	Edge of Drive
773						4.6	17.5 ✓	" " "
778						5.1	17.0 ✓	
781								10' Rt. to cor. Bldg. # 834
87						4.9	17.2 ✓	
705								10' Rt. cor. Bldg. # 834
714						5.1	17.0 ✓	
723						5.7	16.4 ✓	BANK



22

11
43
—
8-54



VALUABLE

SUBJECT

TRUNK 'A' Profile
cont'd.Return To
Public Works
Office
Camp Lejeune
North Carolina

FIELD PARTY

In Charge _____
Instrument _____
Notes _____
Tape Read _____
Tape or Rod _____
Tape or Rod _____
Instrument No. _____
Tape No. _____

WEATHER

Clear _____
Cloudy _____
Windy _____
Rain _____
Fair _____
Snow _____
Hot _____
Moderate _____
Cold _____
Fog _____

FILE No. _____

Fldr. No. _____

Sheet

5-0f

Date

5-1 19 51

Figured By _____

Notes Checked By _____

Plotted By _____

Quad. No. _____

Station	Dist.	Angle " "	+	H. I. Bearing	Ver: Ang. Diff.	Elevation	
827				12.08 22.1	7.9	14.2	✓ Ditch
+34					5.6	16.5	✓ BANK
+43					5.7	16.4	✓ Edge of "C" st.
+65					5.7	16.4	✓ Edge of "C" st.
+77					5.9	16.2	✓ Ditch BANK
+82					7.9	14.2	✓ Ditch
+86					5.7	16.4	✓ Ditch BANK
+97		Top of pipe			10.25	11.83	✓ Top of water Line 0.8' left valve
+97							9' Rt. to valve
910					5.1	17.0	✓
+04.5							10' Rt. to cor. Bldg # 825
+26					4.8	17.3	✓
+29							10' Rt. to cor. Bldg # 825
+30					5.3	16.8	✓
+35					4.7	17.4	✓ Edge of drive




















VALUABLE

Return To
Public Works
Office
Camp Lejeune
North Carolina

SUBJECT TRUNK "A" Profile contd.

FIELD PARTY

_____ In Charge
_____ Instrument
_____ Notes
_____ Tape Read
_____ Tape or Rod
_____ Tape or Rod
_____ Instrument No.
_____ Tape No.

WEATHER

Clear
Cloudy
Windy
Rain
Fair

Snow
Hot
Moderate
Cold
Fog

FILE No. _____

Fldr. No. _____

Sheet 6 of

Date 5-1- 19 51

Figured By _____
Notes Checked By _____
Plotted By _____


Quad. No. _____

Station	Dist.	Angle	"	+	H. I. Bearing	Ver: Ang. Diff.	Elevation	
					<u>22.08</u> <u>22.1</u>			
+52					4.5	17.6	✓	Edge of Drive
+56					4.9	17.2	✓	
+61					4.4	17.7	✓	10' At. cor. Bldg. # 824
+85					4.2	17.9	✓	10' At. cor. Bldg. # 824
+93					4.1	18.0	✓	BANK
+98					6.3	15.8	✓	ditch
10+					5.2	16.9	✓	
+04					3.8	18.3	✓	BANK
10+10.11 TRUNK "A" = 0+00 BRANCH A-2					3.5	18.6	✓	
10+11					7.90	14.18	✓	top of water line to Fire Hyd. valve 1' left
+50					3.0	19.1	✓	
11+					4.6	19.5	✓	
+50					4.3	19.8	✓	
+75					4.2	19.9	✓	ditch BANK
+85					4.2	17.9	✓	DITCH

7



 

VALUABLE

SUBJECT

TRUNK "A" profile

cont'd.

Return To
Public Works
Office
Camp Lejeune
North Carolina

FIELD PARTY

In Charge _____
Instrument _____
Notes _____
Tape Read _____
Tape or Rod _____
Tape or Rod _____
ument No. _____
Tape No. _____

WEATHER

Clear _____
Cloudy _____
Windy _____
Rain _____
Fair _____
Snow _____
Hot _____
Moderate _____
Cold _____
Fog _____

FILE No. _____

Fldr. No. _____

Sheet

7 of

Date

5-1-1951

Figured By _____

Notes Checked By _____

Plotted By _____

Quad. No. _____

Station	Dist.	Angle	"	+	H. I. Bearing	Ver: Ang. Diff.	Elevation	
11+93					14.08 12.1	4.2	19.9	Ditch BANK
12+						1.8	20.3	Edge of stone 15" st.
T.P.						0.80	21.28	
		4.27			25.55 25.6			
12+17						5.1	20.5	Edge of stone 8" st.
+29						5.8	19.8	Ditch
+33								2.7' Rt. to water valve
+37					top of pipe lateral to R.A.	8.54	17.91	1.5' Left to water valve
+38						5.2	20.4	
+41.5								3' Rt. to water valve
+44.5								10' Rt. cor. #815
+50						4.8	20.8	
+84.5						4.7	20.9	10' Rt. cor. #815
13+						4.6	21.0	
13+24.44					Trunk "A" =	4.8	20.8	END TRUNK "A"
0+00					Branch A-1			
B.M.						5.71	19.84	spike in 18" pine tree between 8 th and 9 th st.
							19.78	ON "A" st.








VALUABLE

Return To
Public Works
Office
Camp Lejeune
North Carolina

SUBJECT PROPOSED STEAM LINE
STAKE OUT AT TENT
CAMP # 2
BRANCH A-1

FIELD PARTY
Arllum In Charge
Instrument _____
Notes _____
Tape Read _____
Tape or Rod _____
Tape or Rod _____
ument No. _____
Tape No. _____

WEATHER
Clear _____
Cloudy _____
Windy _____
Rain _____
Fair _____
Snow _____
Hot _____
Moderate _____
Cold _____
Fog _____
Figured By _____
Notes Checked By _____
Plotted By _____

FILE No. _____
Fldr. No. _____
Sheet 1-07
Date 5/3 1951

Quad. No. _____

Station	Dist.	Angle	"	+	H. I. Bearing	Ver: Ang. Diff.	Elevation
							11+37.64
							END BRANCH 'A' 1
							BRANCH 'A' 1
							TRUNK 'A'
13+24.45 = 1		270 00 00					
0+00	3	90 00 45					13+24.45 TRUNK 'A' =
		MEAN 270 00 15					0+00 BRANCH 'A' 1








VALUABLE

Return To
Public Works
Office
Camp Lejeune
North Carolina

SUBJECT

Profile on Branch

A-1

Spear location at tent

Camp #2

FIELD PARTY

ACUM In Charge
 _____ Instrument
 _____ Notes
 _____ Tape Read
 _____ Tape or Rod
 _____ Tape or Rod
 _____ Instrument No.
 _____ Tape No.

WEATHER

Clear
 Cloudy
 Windy
 Rain
 Fair

Snow
 Hot
 Moderate
 Cold
 Fog

FILE No. _____

Fldr. No. _____

Sheet

1 of

Figured By _____

Notes Checked By _____

Plotted By _____

Date 5-3-1951

Quad. No. _____

Station	Dist.	Angle	"	+	H. I. Bearing	Ver: Ang. Diff.	Elevation
B.M.							19.78
	4.96	24.74					
0+03					7.85	16.89	
0+50					4.1	20.6	
1+					4.3	20.4	
+50					4.3	20.4	
2+					1.4	20.3	
+50					4.4	20.3	
3+					4.7	20.0	
+50					4.9	19.8	
4+					5.3	19.4	
+50					6.0	18.7	
5+					6.4	18.3	
+08					6.8	17.9	

Nail in root of 18" pine between 9th and 8th sts.
 on A St.

Note: due to construction grading
 operations, this profile is subject
 to change.

top of water line

BANK

$$\begin{array}{r} 497 \\ \underline{22} \\ 475 \end{array}$$
$$\begin{array}{r} 218 \\ \underline{53} \\ 165 \end{array}$$

1950
1951
1950
1951
VALUABLE

Return To
Public Works
Office
Camp Lejeune
North Carolina

SUBJECT Branch A-1 profile
contd.

FIELD PARTY

In Charge _____
Instrument _____
Notes _____
Tape Read _____
Tape or Rod _____
Tape or Rod _____
Instrument No. _____
Tape No. _____

WEATHER

Clear _____
Cloudy _____
Windy _____
Rain _____
Fair _____
Snow _____
Hot _____
Moderate _____
Cold _____
Fog _____

FILE No. _____

Fldr. No. _____

Figured By _____ Sheet 2-0f

Notes Checked By _____

Plotted By _____ Date 5-3-1951

Quad. No. _____

Station	Dist.	Angle	"	+	H. I. Bearing	Ver: Ang. Diff.	Elevation	
					24.74	✓		
5411					8.2	✓	16.5	Ditch
+20					6.2	✓	18.5	Shoulder
+27					6.0	✓	18.7	Edge of 8 th St.
+49					6.0	✓	18.7	" " " "
+57					6.5	✓	18.2	Shoulder
+65					8.0	✓	16.7	Ditch
+76					6.5	✓	18.2	BANK
6+					6.4	✓	18.3	
+50					7.0	✓	17.7	
7+					6.5	✓	18.2	
T.P.					5.49	✓	19.25	
					2.96	✓	12.21	

90' 01' 45"

270 05' 15"

493

525

3/29

557

3.94

5185

7.79

416
21
7.28

3.8

41

7.9

VALUABLE

SUBJECT

Branch A-1 profile
CONTINUED.Return To
Public Works
Office
Camp Lejeune
North Carolina

FIELD PARTY

_____ In Charge
 _____ Instrument
 _____ Notes
 _____ Tape Read
 _____ Tape or Rod
 _____ Tape or Rod
 _____ Instrument No.
 _____ Tape No.

WEATHER

Clear
 Cloudy
 Windy
 Rain
 Fair

Snow
 Hot
 Moderate
 Cold
 Fog

FILE No. _____

Fldr. No. _____

Figured By _____

Sheet

3-07

Notes Checked By _____

Date

5-3-51

Plotted By _____

Quad. No. _____

Station	Dist.	Angle " "	+	H. I. Bearing	Ver: Ang. Diff.	Elevation	
				22.21	✓		
+49				4.1	18.1	✓	
+56				5.2	17.0	✓	
+70				4.3	17.9	✓	
8+				4.1	18.1	✓	
+24				4.5	17.7	✓	
+28				5.0	17.2	✓	
+50				5.3	16.9	✓	BANK
+66				10.3	11.9	✓	DITCH
+75				8.4	13.8	✓	
+84				5.5	16.7	✓	BANK
9+				5.5	16.7	✓	
+50				5.0	17.2	✓	
10+				4.9	17.3	✓	
+50				4.5	17.7	✓	













VALUABLE

Return To
Public Works
Office
Camp Lejeune
North Carolina

SUBJECT Branch A-1 profile
continued.

FIELD PARTY

_____ In Charge
_____ Instrument
_____ Notes
_____ Tape Read
_____ Tape or Rod
_____ Tape or Rod
_____ Instrument No.
_____ Tape No.

WEATHER

Clear _____
Cloudy _____
Windy _____
Rain _____
Fair _____
Snow _____
Hot _____
Moderate _____
Cold _____
Fog _____

FILE No. _____

Fldr. No. _____

Figured By _____ Sheet 4 of

Notes Checked By _____

Plotted By _____ Date 5-3-1951

Quad. No. _____

Station	Dist.	Angle " +	H. I. Bearing	Ver: Ang. Diff.	Elevation	
			<u>26.21</u>			
<u>11+00</u>				<u>4.2</u>	<u>18.0</u>	✓
<u>11+37.64</u>				<u>3.7</u>	<u>18.5</u>	✓ <u>END BRANCH A-1</u>
<u>B.M.</u>				<u>4.94</u>	<u>17.37</u>	✓ <u>nail in root of sweet gum tree between 8th and 7th st. ON "H" st.</u>
				<u>(17.28)</u>		

Return To
Public Works
Office
Camp Lejeune

























VALUABLE

SUBJECT Steam Line Branch A-2
Stake out at tent camp #2


Return To
 Public Works
 Office
 Camp Lejeune
 North Carolina

FIELD PARTY
 _____ In Charge
 _____ Instrument
 _____ Notes
 _____ Tape Read
 _____ Tape or Rod
 _____ Tape or Rod
 _____ Instrument No.
 _____ Tape No.

WEATHER
 Clear _____
 Cloudy _____
 Windy _____
 Rain _____
 Fair _____
 Snow _____
 Hot _____
 Moderate _____
 Cold _____
 Fog _____
 Figured By _____
 Notes Checked By _____
 Plotted By _____

FILE No. _____
 Fldr. No. _____
 Sheet 2-0f
 Date 5-2-1951
 Quad. No. _____

Station	Dist.	Angle	"	+	H. I. Bearing	Ver: Ang. Diff.	Elevation
10+10.11	=	1-90°	00'-15"				
0+00		3-270°	01'-00"				
		MEAN-90°	00'-20"				

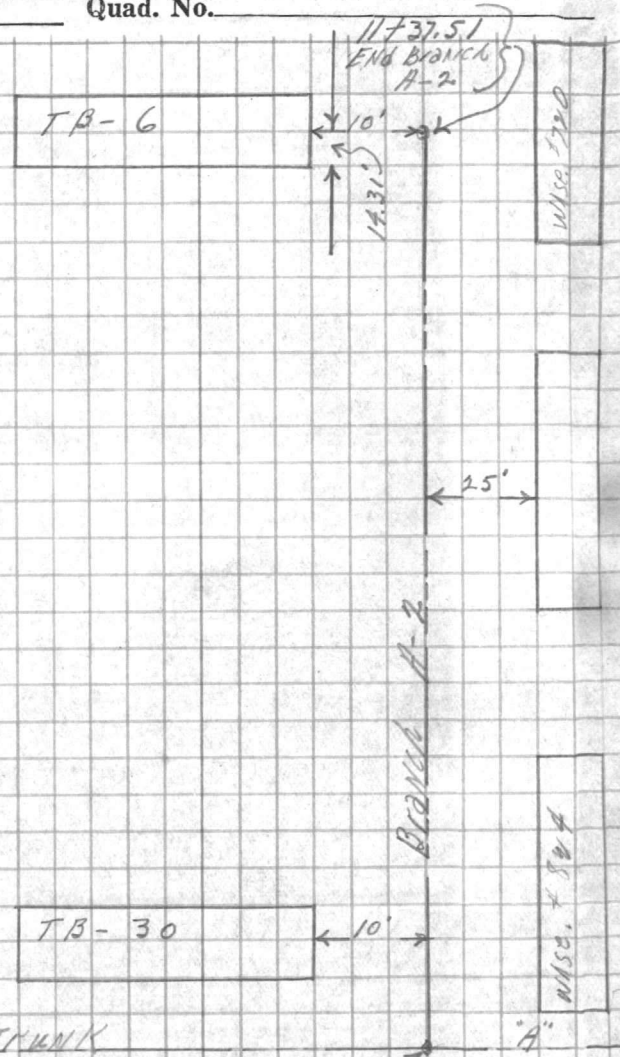

10+10.11 TRUNK "A"
 0+00 BRANCH A-2

VALUABLE

Return To
Public Works
Office
Camp Lejeune
North Carolina

SUBJECT Profile on steam line
Branch A-2

FIELD PARTY

_____ In Charge
_____ Instrument
_____ Notes
_____ Tape Read
_____ Tape or Rod
_____ Tape or Rod
_____ Instrument No.
_____ Tape No.

WEATHER

Clear
Cloudy
Windy
Rain
Fair

Snow
Hot
Moderate
Cold
Fog

FILE No. _____
Fldr. No. _____
Sheet 5-04
Date 5-2-1951

Figured By _____
Notes Checked By _____
Plotted By _____

Quad. No. _____

Station	Dist.	Angle	"	+	H. I. Bearing	Ver: Ang. Diff.	Elevation	
B.M.						✓	20.40	✓ spike in power pole at 9th and 11th S/S.
		2.90			23.30			
1040.11								trunk 'A' =
0+00								BRANCH A-2
0+03								Water Line
0+50						5.2	18.1	✓
1+						5.3	18.0	✓
+50						5.0	18.3	
2+						5.1	18.2	✓
+50						4.8	18.5	✓
3+						4.9	18.4	✓
+50						4.8	18.5	✓
4+						4.8	18.5	✓
+50						5.0	18.3	✓
5+						5.0	18.3	✓
+08						6.3	17.0	✓ BANK
+11						7.9	15.4	✓ ditch









VALUABLE

SUBJECT

Branch A-V profile
cont'd.Return To
Public Works
Office
Camp Lejeune
North Carolina

FIELD PARTY

In Charge _____
Instrument _____
Notes _____
Tape Read _____
Tape or Rod _____
Tape or Rod _____
ument No. _____
Tape No. _____

WEATHER

Clear _____
Cloudy _____
Windy _____
Rain _____
Fair _____
Snow _____
Hot _____
Moderate _____
Cold _____
Fog _____

FILE No. _____

Fldr. No. _____

Sheet

6 of

Date

5-2-19 51

Quad. No. _____

Station	Dist.	Angle	"	+	H. I. Bearing	Ver: Ang. Diff.	Elevation	
					13.30	✓		
5413					6.7	16.6	✓	
420					5.5	17.8	✓	Shoulder
427					5.3	18.0	✓	Edge of B th St.
449					5.5	17.8	✓	Edge of st.
458					5.7	17.6	✓	Shoulder
465					7.7	15.6	✓	Ditch
473					5.8	17.5	✓	bank
478								over head power line
400					6.2	17.1	✓	
450					6.3	17.0	✓	
74					6.8	16.5	✓	
T.P.					5.97	17.33	✓	
					3.58	20.91	✓	











VALUABLE

Return To
Public Works
Office
Camp Lejeune
North Carolina

SUBJECT Branch H-V profile
continued

FIELD PARTY

In Charge _____
Instrument _____
Notes _____
Tape Read _____
Tape or Rod _____
Tape or Rod _____
Instrument No. _____
Tape No. _____

WEATHER

Clear _____
Cloudy _____
Windy _____
Rain _____
Fair _____
Snow _____
Hot _____
Moderate _____
Cold _____
Fog _____

FILE No. _____
Fldr. No. _____
Sheet 7-0f
Date 5-2-51

Figured By _____
Notes Checked By _____
Plotted By _____

Quad. No. _____

Station	Dist.	Angle " "	+	H. I. Bearing	Ver: Ang. Diff.	Elevation	
				20.91	✓		
7450				4.9	16.0 ✓		
8400				5.5	15.4 ✓		
732				5.9	15.0 ✓		
753				7.0	13.9 ✓		BANK
760				9.7	11.4 ✓		DITCH
771				7.3	13.6 ✓		BANK
9400				6.4	14.5 ✓		
712				6.5	14.4 ✓		BANK
733				6.5	14.4 ✓		DITCH
748				6.0	14.9 ✓		
752				5.4	15.5 ✓		BANK
10400				4.7	16.2 ✓		
750				4.1	16.8 ✓		










VALUABLE

SUBJECT

Branch A-2 Profile
continuedReturn To
Public Works
Office
Camp Lejeune
North Carolina

FIELD PARTY

In Charge _____
Instrument _____
Notes _____
Tape Read _____
Tape or Rod _____
Tape or Rod _____
Instrument No. _____
Tape No. _____

WEATHER

Clear _____
Cloudy _____
Windy _____
Rain _____
Fair _____
Snow _____
Hot _____
Moderate _____
Cold _____
Fog _____

FILE No. _____

Fldr. No. _____

Sheet

8-0f

Figured By _____

Notes Checked By _____

Plotted By _____

Date

5-2-1951

Quad. No. _____

Station	Dist.	Angle " "	+	H. I. Bearing	Ver: Ang. Diff.	Elevation	
				20.91	✓		
N+00				3.9	17.0 ✓		
N+37.51				3.8	17.1 ✓		END BRANCH A-2
B.M.				0.54	20.37 ✓		spike in power pole at 7th + 8' S 15.
				20.70			

AT 8:15







 

VALUABLE

Return To
Public Works
Office
Camp Lejeune
North Carolina


SUBJECT Branch A-3 steam line
Stake out at tent camp #2

FIELD PARTY
Kelton In Charge
Instrument _____
Notes _____
Tape Read _____
Tape or Rod _____
Tape or Rod _____
Instrument No. _____
Tape No. _____

WEATHER
Clear _____
Cloudy _____
Windy very _____
Rain _____
Fair _____
Snow _____
Hot _____
Moderate _____
Cold _____
Fog _____

FILE No. _____
Fldr. No. _____
Sheet 1 of _____
Date 5-2-1951
Quad. No. _____

Station	Dist.	Angle " +	H. I. Bearing	Ver: Ang. Diff.	Elevation
P.I.		1- 89° 59' 45"			
5+30.30		3- 269° 59' 45"			
0+00		MEAN- 89° 59' 55"			

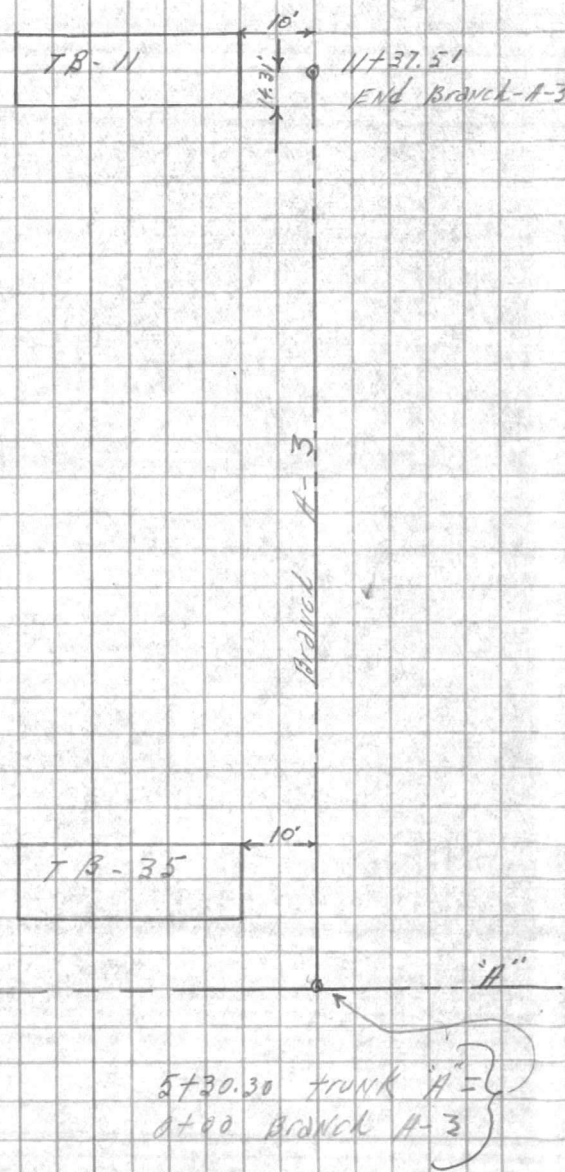





VALUABLE

SUBJECT Profile on Steam Line
Branch A-3

Return To
 Public Works
 Office
 Camp Lejeune
 North Carolina

FIELD PARTY

_____ In Charge
 _____ Instrument
 _____ Notes
 _____ Tape Read
 _____ Tape or Rod
 _____ Tape or Rod
 _____ Instrument No.
 _____ Tape No.

WEATHER

Clear
 Cloudy
 Windy
 Rain
 Fair

Snow
 Hot
 Moderate
 Cold
 Fog

FILE No. _____

Fldr. No. _____

Figured By _____ Sheet 1 of

Notes Checked By _____

Plotted By _____ Date 5-2-1951

Quad. No. _____

Station	Dist.	Angle	"	+	H. I. Bearing	Ver: Ang. Diff.	Elevation
B.M.							18.47 ✓
				3.71	22.18		
5+30.30 trunk A-3					22.2		
0+00 Branch A-3							
0+01.5						7.91	14.27 ✓
+25						4.9	17.3 ✓
+50						4.2	18.0 ✓
+57						5.1	17.1 ✓
+65						4.0	18.4 ✓
+72						4.2	18.0 ✓
+76						5.2	17.0 ✓
+79						4.2	18.0 ✓
+7						4.4	17.8 ✓
+50						4.3	17.9 ✓
+73						4.4	17.8 ✓
+78						5.6	16.6 ✓
+83						4.2	18.0 ✓
+7						4.1	18.1 ✓
+50						5.2	17.0 ✓
+3						5.0	17.2 ✓
+50						5.4	16.8 ✓

Mail in power pole at 7th and "D" St's.

Note: This profile is subject to change due to construction grading at this time.

top of water line

5.5' Rt. to power pole

5.5' Rt. to power pole








VALUABLE

Return To
Public Works
Office
Camp Lejeune
North Carolina

SUBJECT branch #3 profile
cont'd.

FIELD PARTY

____ In Charge
____ Instrument
____ Notes
____ Tape Read
____ Tape or Rod
____ Tape or Rod
____ Instrument No.
____ Tape No.

WEATHER

Clear
Cloudy
Windy
Rain
Fair

Snow
Hot
Moderate
Cold
Fog

FILE No. _____
Fldr. No. _____
Sheet 2-01
Date 5-2-51

Quad. No. _____

Station	Dist.	Angle ° ' "	+	H. I. Bearing	Ver: Ang. Diff.	Elevation	
+100				22.18 22.2	5.6	16.6	✓
+19		6' RT to power pole					
+42		6' RT to guy wire anchor					
+50					6.0	16.2	✓
5+					6.0	16.2	✓
+07					7.2	15.0	✓ BANK
+12					10.1	12.1	✓ DITCH
+16					7.0	15.2	✓ BANK
+27					6.8	15.4	✓ Edge of 8 th St
+49					6.9	15.3	✓ Edge of 8 th St
T.P.					7.69	14.49	✓
				5.64	20.13		✓
				20.1			✓
5+61					5.7	14.4	✓ BANK
+66					8.0	12.1	✓ DITCH
+72					5.3	14.8	✓ BANK

VALUABLE
Return to
Public Works
Office
Camp Lejeune
North Carolina






VALUABLE

Return To
Public Works
Office
Camp Lejeune
North Carolina

SUBJECT Branch A-3 profile
cont'd.

FIELD PARTY

_____ In Charge
_____ Instrument
_____ Notes
_____ Tape Read
_____ Tape or Rod
_____ Tape or Rod
_____ Instrument No.
_____ Tape No.

WEATHER

Clear
Cloudy
Windy
Rain
Fair

Snow
Hot
Moderate
Cold
Fog

FILE No. _____
Fldr. No. _____
Sheet 3-0f
Date 5-2- 1951

Figured By _____
Notes Checked By _____
Plotted By _____
Quad. No. _____

Station	Dist.	Angle " +	H. I. Bearing	Ver: Ang. Diff.	Elevation	
			20.13 20.1			
5+79			5.8	14.3	✓	5' Rt. to power pole 6' left to guy wire anchor
+90						4' Rt. to guy wire anchor
6+00			6.0	14.1	✓	
+32			6.0	14.1	✓	6' Rt. to guy wire anchor
+35			8.3	11.8	✓	
+39			5.8	14.3	✓	
+52			6.9	13.2	✓	5' Rt. to power pole
7+00			5.6	14.5	✓	
+10			6.4	13.5		BANK
+17			9.3	10.8	✓	
+22			12.4	7.7	✓	ditch 11' Rt. to head wall
+25			9.6	10.5	✓	
+38			7.0	13.1	✓	BANK
+50			6.1	14.0	✓	
772						5' Rt. to guy wire anchor












VALUABLE

 SUBJECT Branch A-3 profile
cont'd.

 Return To
 Public Works
 Office
 Camp Lejeune
 North Carolina

FIELD PARTY

 _____ In Charge
 _____ Instrument
 _____ Notes
 _____ Tape Read
 _____ Tape or Rod
 _____ Tape or Rod
 _____ Instrument No.
 _____ Tape No.

WEATHER

 Clear
 Cloudy
 Windy
 Rain
 Fair

 Snow
 Hot
 Moderate
 Cold
 Fog

FILE No. _____

Fldr. No. _____

Sheet 4-0fDate 5-2 1951

Figured By _____

Notes Checked By _____

Plotted By _____

Quad. No. _____

Station	Dist.	Angle " "	+	H. I. Bearing	Ver: Ang. Diff.	Elevation	
7+93				20.13 20.1	✓		5.5' Rt. to power pole
8+00					5.2	14.9	✓
+43					4.2	15.9	✓
+56					7.6	12.5	✓
+64					4.7	15.4	✓
+70					7.1	13.0	✓
+76					5.3	14.8	✓
9+00					4.9	15.2	✓
+47					4.3	15.8	✓ 6' Rt. to power pole
+68							6' Rt. to guy wire anchor
10+00					4.3	15.8	✓
+50					3.9	16.2	✓
+95							5.5' Rt. to power pole
11+00					3.7	16.4	✓
11+37.51 B.M.					4.0 2.34	16.1 17.79	✓ (17.78) End Branch A-3 spike in root of pine tree at 7th & 10th St.







Thunder
Wind
Windy
Mist
Hazy
Light
Dark

Baromet
Wind
Direction
Temperature
Relative
Humidity
Dew Point
Sea Level
Pressure

Figured on
Notes checked
Date

Time
Name
Title
Company

Sheet No.

Map No.

5.63
96
10.25

VALUABLE

Return To
Public Works
Office
Camp Lejeune
North Carolina

SUBJECT Branch A-4 steam
LINE location at tent camp
2

FIELD PARTY

_____. In Charge
_____. Instrument
_____. Notes
_____. Tape Read
_____. Tape or Rod
_____. Tape or Rod
_____. Instrument No.
_____. Tape No.


WEATHER

Clear
Cloudy
Windy
Rain
Fair

Snow
Hot
Moderate
Cold
Fog

FILE No. _____
Fldr. No. _____
Sheet 3-0f
Date 5-3-1951

Figured By _____
Notes Checked By _____
Plotted By _____
Quad. No. _____

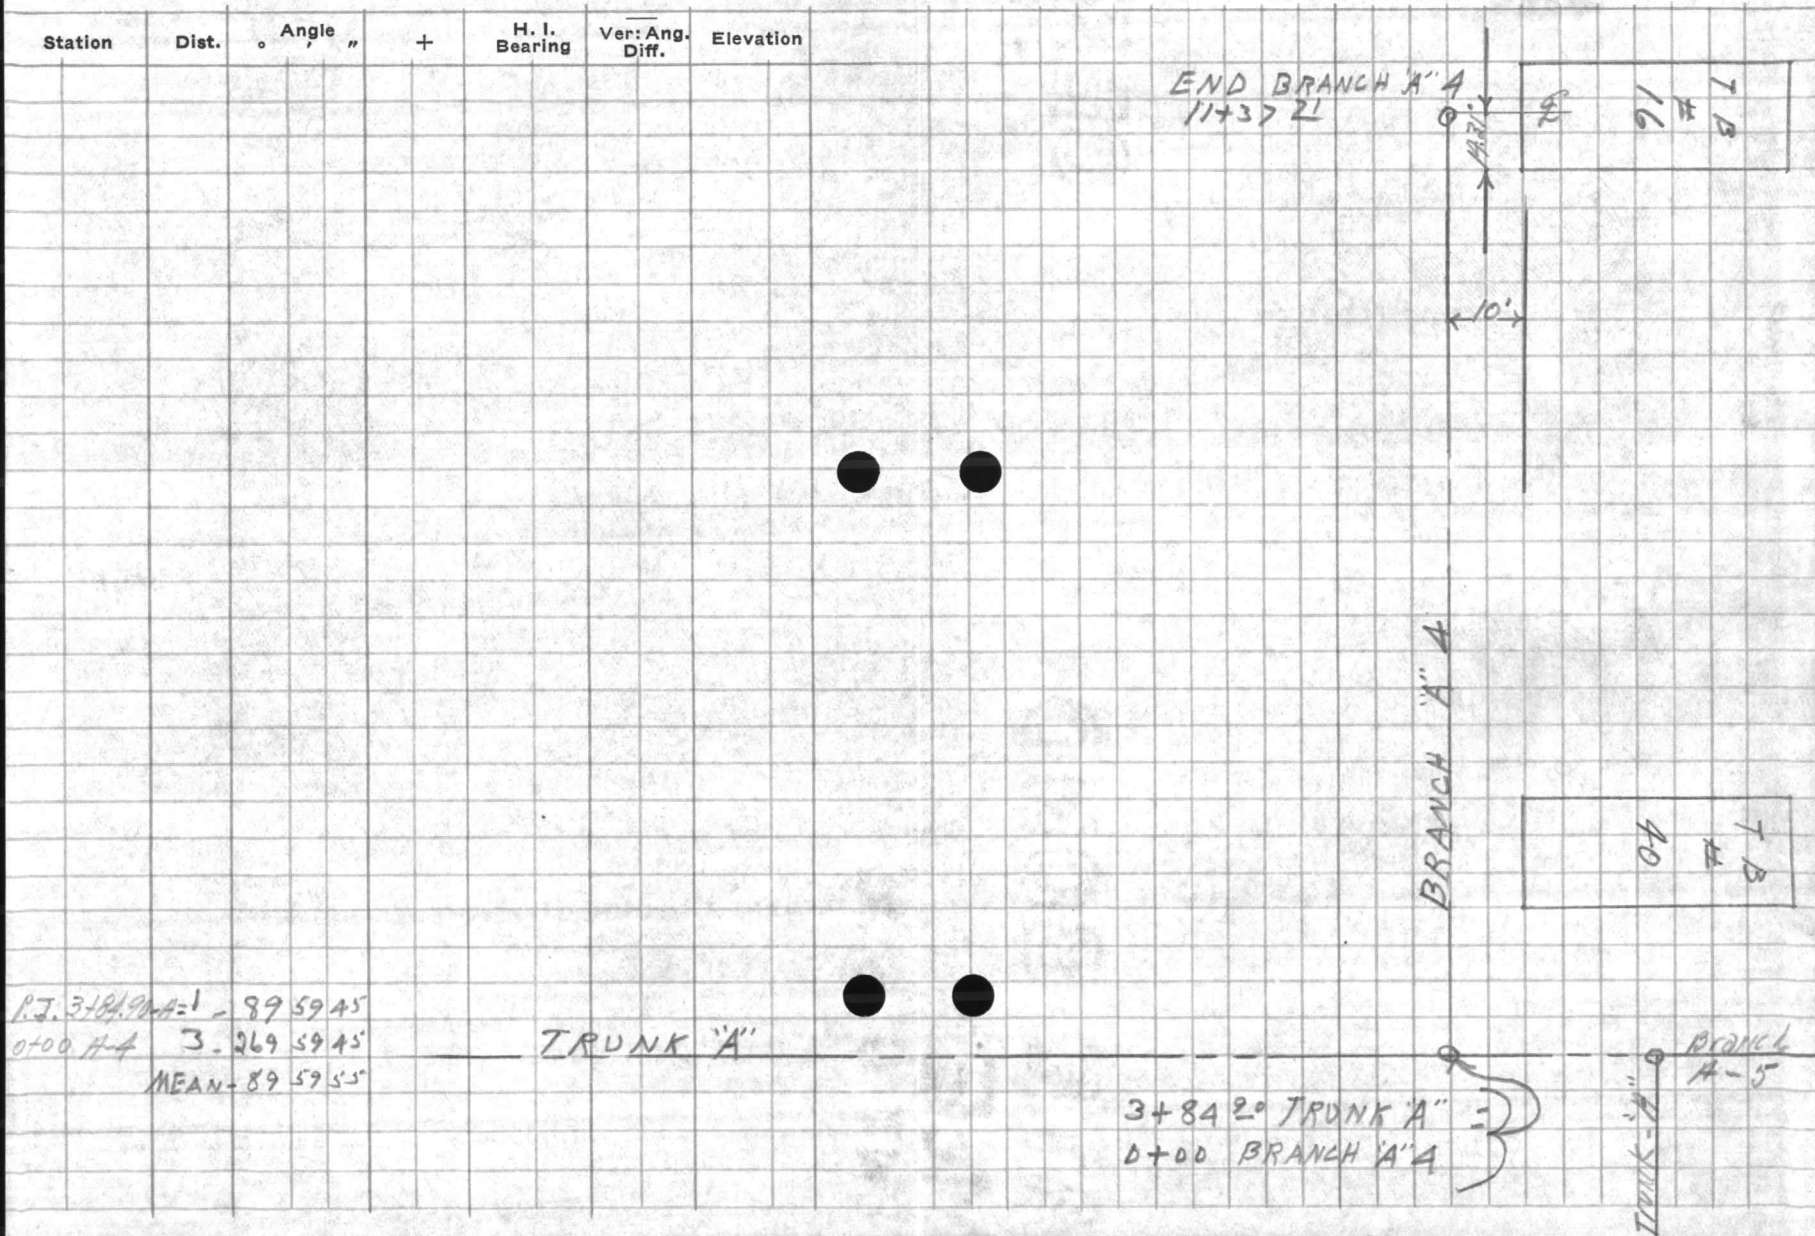

Public Works
Camp Lejeune
North Carolina

STATION

Station

Dist.

Asst. Insp.

Inspector
Div. of Public Works

WEATHER
Wind
Temp
Barom
Rel. Humid
Precip

FIELD ENTRY
Date
Time
Location

FILE NO.

Project Checked By
Date



VALUABLE

SUBJECT

Profile on Branch

A-4

Return To
Public Works
Office
Camp Lejeune
North Carolina

FIELD PARTY

____ In Charge
 ____ Instrument
 ____ Notes
 ____ Tape Read
 ____ Tape or Rod
 ____ Instrument No.
 ____ Tape No.

WEATHER

Clear
 Cloudy
 Windy
 Rain
 Fair

Snow
 Hot
 Moderate
 Cold
 Fog

FILE No. _____

Fldr. No. _____

Sheet

2-07

Date

5-3-1951

Figured By _____

Notes Checked By _____

Plotted By _____

Quad. No. _____

Station	Dist.	Angle " "	+	H. I. Bearing	Ver: Ang. Diff.	Elevation
B.M.						12.79 ✓
3+84.90	A = 0+100.44	2.28		20.77		✓
0+03	water line	20.8				
0+03					4.8	16.0 ✓
0+08					4.2	16.6 ✓
+50					3.8	17.0 ✓
1+					2.6	17.2 ✓
+50					3.7	17.1 ✓
2+					4.0	16.8 ✓
+50					3.7	17.1 ✓
3+					4.7	16.1 ✓
+10					10.00	10.80 ✓
+50					5.0	15.8 ✓
4+					5.2	15.6 ✓
+50					5.7	15.1 ✓
5+					6.4	14.4 ✓
+04					6.8	14.0 ✓

Nail in power pole at 8th + Eth St's.

Note:

profile subject to change due to grading operations.

top of sewer line



$$\begin{array}{r} 115 \\ \hline 2 \overline{) 23} \end{array}$$

$$\begin{array}{r} 20 \\ \hline 115 \\ \hline 37.5 \end{array}$$

5+




































VALUABLE

SUBJECT Branch A-4 profile
cont'd.

Return To
 Public Works
 Office
 Camp Lejeune
 North Carolina

FIELD PARTY

_____ In Charge
 _____ Instrument
 _____ Notes
 _____ Tape Read
 _____ Tape or Rod
 _____ Instrument No.
 _____ Tape No.

WEATHER

Clear _____
 Cloudy _____
 Windy _____
 Rain _____
 Fair _____
 Snow _____
 Hot _____
 Moderate _____
 Cold _____
 Fog _____
 Figured By _____
 Notes Checked By _____
 Plotted By _____

FILE No. _____
 Fldr. No. _____
 Sheet 6-0f
 Date 5-3-1951

Quad. No. _____

Station	Dist.	Angle "	+	H. I. Bearing	Ver: Ang. Diff.	Elevation	
				20.77 40-8	✓		
5709				8.1	12.7 ✓		BANK
711				9.6	11.2 ✓		Ditch
713				8.1	12.7 ✓		
718				6.7	14.1 ✓		Shoulder
726				6.8	14.0 ✓		Edge of 8th St.
749				6.8	14.0 ✓		" " " "
757				7.5	13.3 ✓		Shoulder
764				9.1	11.7 ✓		Ditch
773				8.2	12.6 ✓		BANK
779				8.0	12.8 ✓		over head power line pole 20' R.
6700				8.6	12.2 ✓		
750				9.0	11.8 ✓		
776				9.6	11.2 ✓		
782				10.7	10.1 ✓		BANK
784				13.1	7.6 ✓		Ditch








VALUABLE

SUBJECT Branch A-4
profile cont'd.

Return To
 Public Works
 Office
 Camp Lejeune
 North Carolina

FIELD PARTY
 _____ In Charge
 _____ Instrument
 _____ Notes
 _____ Tape Read
 _____ Tape or Rod
 _____ Instrument No.
 _____ Tape No.

WEATHER
 Clear _____
 Cloudy _____
 Windy _____
 Rain _____
 Fair _____
 Snow _____
 Hot _____
 Moderate _____
 Cold _____
 Fog _____
 Figured By _____
 Notes Checked By _____
 Plotted By _____

FILE No. _____
 Fldr. No. _____
 Sheet 7 of
 Date 5-3-51

Quad. No. _____

Station	Dist.	Angle " "	+	H. I. Bearing	Ver: Ang. Diff.	Elevation	
6+87				20.77 20.8	✓ 10.3	10.5 ✓	BANK
7+95					8.7	12.1 ✓	
7+00					8.3	12.5 ✓	
T.P.					7.27	13.50 ✓	
				6.36 19.9	19.86		
7+50					6.7	13.2 ✓	
8+					6.2	13.7 ✓	
7+50					5.6	14.3 ✓	
9+					5.3	14.6 ✓	
7+50					4.9	15.0 ✓	
10+					4.3	15.6 ✓	
7+50					4.1	15.8 ✓	
11+					3.4	16.5 ✓	
11+37.71					3.6	16.3 ✓	END BRANCH A-4
B.M.					2.08	17.78 ✓	nail in pine tree at 7th and 8th's.
					17.78		
















VALUABLE

Return To
Public Works
Office
Camp Lejeune
North Carolina

SUBJECT

Profile on steam line
Branch A-5

FIELD PARTY

_____ In Charge
_____ Instrument
_____ Notes
_____ Tape Read
_____ Tape or Rod
_____ Tape or Rod
_____ Instrument No.
_____ Tape No.

WEATHER

Clear _____
Cloudy _____
Windy _____
Rain _____
Fair _____

Snow _____
Hot _____
Moderate _____
Cold _____
Fog _____

FILE No. _____

Fldr. No. _____

Sheet

8 of

Date

5-1-1951


Quad. No. _____

Station	Dist.	Angle " "	+	H. I. Bearing	Ver: Ang. Diff.	Elevation	
B.M.					✓	15.23	nail in power pole at 9 th + 1/2" st's.
		1.25		19.48			
				19.5			
3+33.77						16.1	trunk 4" = of 00 Branch A-5
0+47.5					8.50	11.0	✓ top of pipe value on line - lateral to fire hydr.
0+50					3.7	15.8	✓
1+					4.3	15.7	✓
+36					4.7	14.8	✓ BANK
+38							over head power line NO pole near
+46					5.5	14.0	✓
+51					7.1	12.4	✓ ditch 9' at end of 18" R.C.P.
+58					4.9	14.6	✓ shoulder
+67.5					4.7	14.8	✓ Edge of "E" st.
+89					4.7	14.8	✓ " " " "
+98					5.1	14.4	✓ shoulder
W+					5.5	14.0	✓
+06					6.4	13.1	✓ ditch
+11					5.1	14.1	✓ BANK

WATER
1941
1942
1941
1942
Division

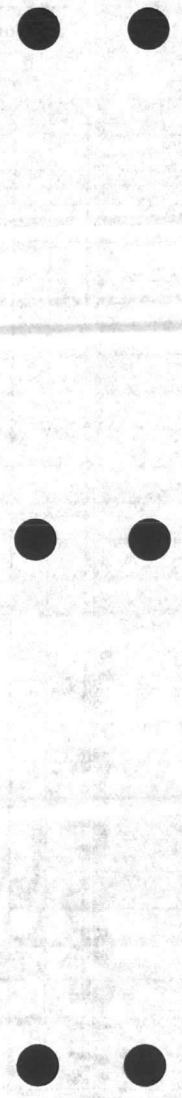

VALUABLE

Return To
Public Works
Office
Camp Lejeune
North Carolina

SUBJECT Branch A-5 profile
cont'd.

FIELD PARTY

____ In Charge
____ Instrument
____ Notes
____ Tape Read
____ Tape or Rod
____ Tape or Rod
____ Instrument No.
____ Tape No.

WEATHER

Clear
Cloudy
Windy
Rain
Fair

Snow
Hot
Moderate
Cold
Fog

FILE No. _____
Fldr. No. _____
Sheet 9 of
Date 5-1-1951

Figured By _____
Notes Checked By _____
Plotted By _____
Quad. No. _____

Station	Dist.	Angle " +	H. I. Bearing	Ver: Ang. Diff.	Elevation	
4+19			19.48 19.5			3' left water valve
4+22				8.00	11.48 ✓	1' left to water valve
4+50				5.8	13.7 ✓	
3+				6.7	12.8 ✓	
3+06.50	Branch A-5 =					
0+00	Branch A-5-1 and A-5-2			6.8	12.7 ✓	
B.M.				4.25	15.23	nail in power pole 9 th and 1 st st.










VALUABLE

 SUBJECT PROFILE BRANCH
A-5-14A-5-1 2

 Return To
 Public Works
 Office
 Camp Lejeune
 North Carolina

FIELD PARTY

 _____ In Charge
 _____ Instrument
 _____ Notes
 _____ Tape Read
 _____ Tape or Rod
 _____ Instrument No.
 _____ Tape No.

WEATHER

 Clear _____
 Cloudy _____
 Windy _____
 Rain _____
 Fair _____
 Snow _____
 Hot _____
 Moderate _____
 Cold _____
 Fog _____

FILE No. _____

Fldr. No. _____

Sheet 8-ofDate 5-3-1951

Figured By _____

Notes Checked By _____

Plotted By _____

Quad. No. _____

Station	Dist.	Angle " +	H. I. Bearing	Ver: Ang. Diff.	Elevation
B.M.		2 51	17 7A	✓	15.23
3+06.50	BRANCH A-5=	17.7			
0+00	BRANCH A-5-1				
0+50				5.3	12.4 ✓
1+				5.0	12.7 ✓
+50				5.1	12.6 ✓
1+				5.2	12.5 ✓
2+28.73				5.2	12.5 ✓
3+06.50	BRANCH A-5=				
0+00	BRANCH A-5-2				
0+50				4.7	13.0 ✓
+80				4.5	13.2 ✓
1+				4.8	12.9 ✓
+50				5.2	12.5 ✓
+66.17				5.3	12.4 ✓
B.M.				2.51	15.23 ✓

nail in power pole at 9th and E'st's.

Note:

 profile subject to change due to
 grading operations.

END BRANCH A-5-1

overhead telephone cable

END BRANCH A-5-2

SOME AS BEGINNING










VALUABLE

SUBJECT Existing water line
Location at tent camp #2

Return To
 Public Works
 Office
 Camp Lejeune
 North Carolina

FIELD PARTY
Reid In Charge
 _____ Instrument
 _____ Notes
 _____ Tape Read
 _____ Tape or Rod
 _____ Tape or Rod
 _____ Instrument No.
 _____ Tape No.

WEATHER
 Clear _____
 Cloudy _____
 Windy _____
 Rain _____
 Fair _____
 Snow _____
 Hot _____
 Moderate _____
 Cold _____
 Fog _____
 Figured By _____
 Notes Checked By _____
 Plotted By _____

FILE No. _____
 Fldr. No. _____
 Sheet 1 of 2
 Date 5-7-1951

Quad. No. _____

Station	Dist.	Angle "	+	H. I. Bearing	Ver: Ang. Diff.	Elevation	Notes
B.M.						13.05	nail in pole at 10 th and 15 th stks.
			6.74	19.79			
2+83 on steam line B-3					7.99	11.80	top of 4" C.I. water line
5+30 on steam line B-3					6.98	12.81	3' ht. top of 4" C.I. water line
7+56.30 on steam line B-3					6.74	13.05	3' ht. top of 4" C.I. water line
B.M.					6.74	13.05	

7+56.30
END B-3

BRANCH B-3

EXISTING 4" C.I. WATER LINE

P.I. 2+86.15 ~ Branch B-3

Proposed steam

WR 1054

WR 1053

WR 1052

WR 1051

WR 1050
















VALUABLE

Return To
Public Works
Office
Camp Lejeune
North Carolina

SUBJECT Existing water lineLocation at tent camp #2

FIELD PARTY

In Charge _____

Instrument _____

Notes _____

Tape Read _____

Tape or Rod _____

Tape or Rod _____

Instrument No. _____

Tape No. _____

WEATHER

Clear
Cloudy
Windy
Rain
Fair

Snow
Hot
Moderate
Cold
Fog

Figured By _____

Notes Checked By _____

Plotted By _____

FILE No. _____

Fldr. No. _____

Sheet 2 of 2Date 8-7-1957

Quad. No. _____

Station	Dist.	Angle "	+	H. I. Bearing	Ver: Ang. Diff.	Elevation
---------	-------	---------	---	------------------	--------------------	-----------

B.M.

2.39 24.44

22.05

Nail in pine tree at 10th and 14th st's.

2+29.45 steam trunk "C"

9.16 15.28

top of 6" C.I.
water line

9+70 steam branch C-2

11.30 13.14

top 6" C.I. water line 0.5' left

B.M.

2.39 22.05

VALUABLE

Return To
Public Works
Office
Camp Lejeune
North Carolina

SUBJECT

Location of Existing
Steam Line at Officers
Mess at Tent Comp #2

FIELD PARTY

In Charge
Instrument
Notes
Tape Read
Tape or Rod
Instrument No.
Tape No.

WEATHER

Clear
Cloudy
Windy
Rain
Fair
Snow
Hot
Moderate
Cold
Fog

Figured By
Notes Checked By
Plotted By

Quad. No.

FILE No.


Fldr. No.

Sheet 1 of

Date 5-3-1951

Bldg. # 910

Station Dist. ° Angle " + H. I. Bearing Ver: Ang. Diff. Elevation

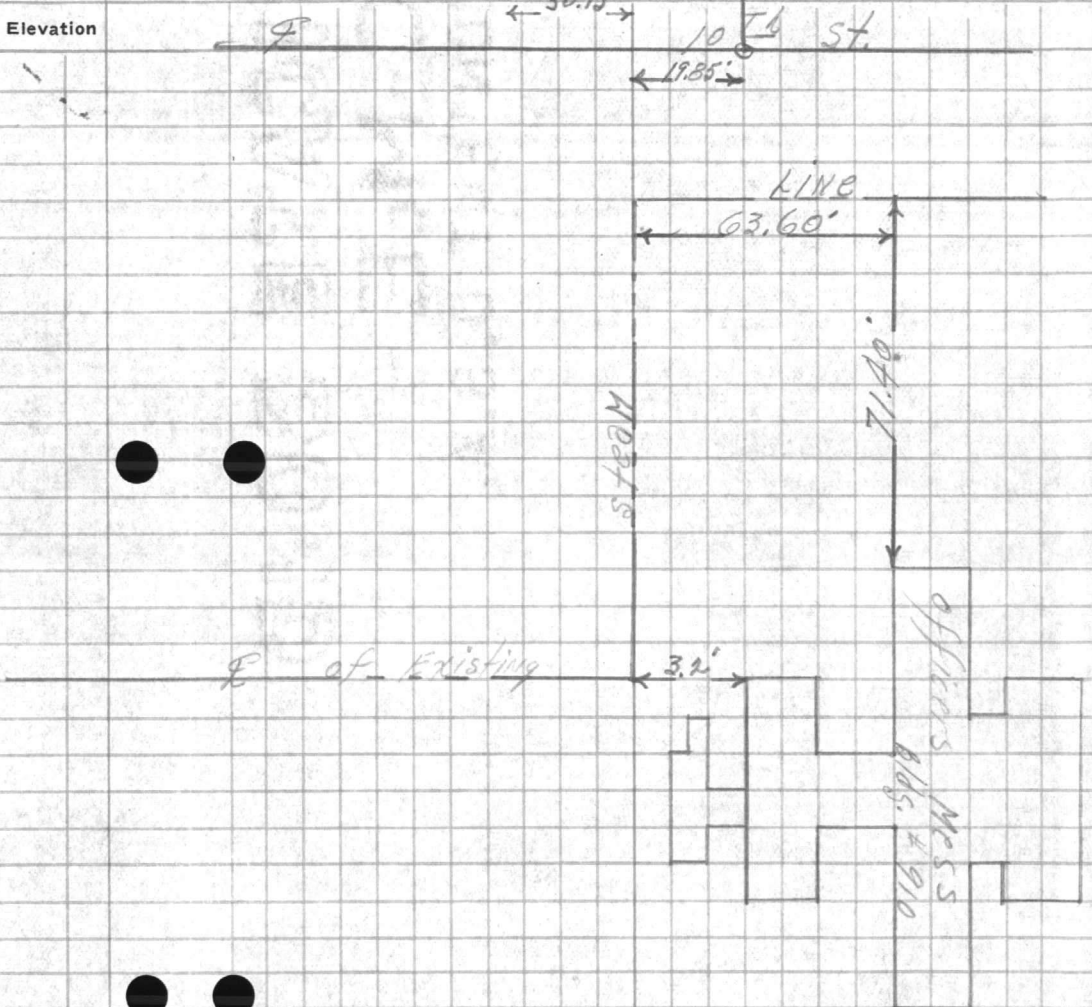































