






1953



VALUABLE

SUBJECT _____

RETURN TO
 PUBLIC WORKS
 OFFICE
 CAMP LEJEUNE
 NORTH CAROLINA

FIELD PARTY

 IN CHARGE

 INSTRUMENT

 NOTES

 TAPE READ

 TAPE OR ROD

 TAPE OR ROD

 INSTRUMENT No. _____
 TAPE No. _____

WEATHER

CLEAR
 CLOUDY
 WINDY
 RAIN
 FAIR

SNOW
 HOT
 MODERATE
 COLD
 FOG

FILE No. _____
 FLDR. No. _____
 SHEET 29f
 DATE _____ 19__

Quad. No. _____

STATION	DIST.	ANGLE " "	+	H. I. BEARING	VER: ANG. DIFF.	ELEVATION
---------	-------	--------------	---	------------------	--------------------	-----------

For Plotting Only


CONCORD
 32470

AT P.I.#2 1 211 54 00
 B.S. P.I.#1 3 275 42 00
 TO P.I.#3 11 211 54 00

13+40 — 36" R.C.P. 4.9' from Ground to Top of Pipe.
 12+25.54 = P.I.#2

12+11.08 EDGE ROAD.
 11+80.20 EDGE ROAD
 11+58 WOOD LINE
 10+34 WOOD LINE
 10+20 ± 12' EARTH RD.

11+72.54 TEL. CABLE
 -2.50'

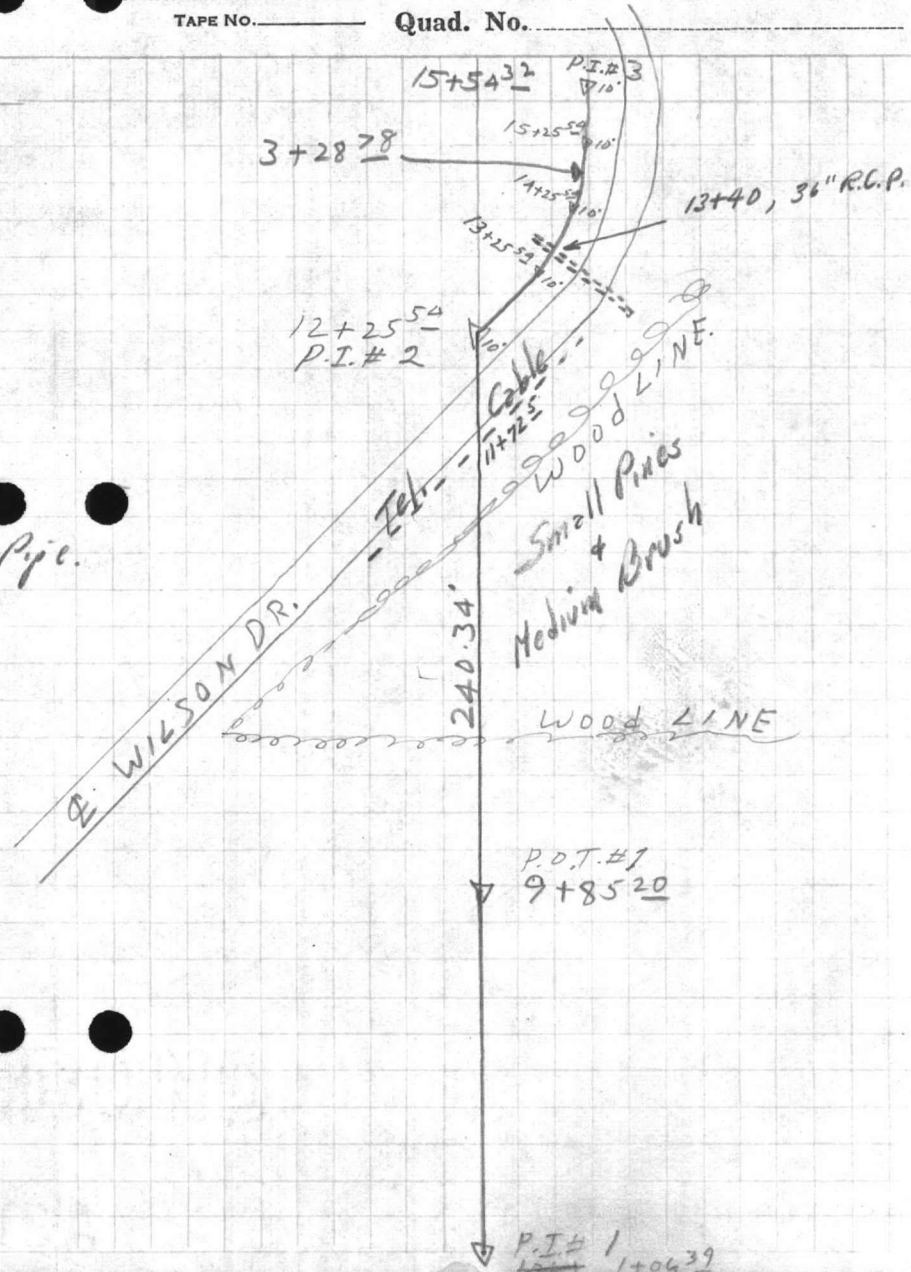

P.O.T.#1
 9+85.20

P.I.#1
 140439





VALUABLE

SUBJECT _____

RETURN TO
 PUBLIC WORKS
 OFFICE
 CAMP LEJEUNE
 NORTH CAROLINA

FIELD PARTY

 IN CHARGE

 INSTRUMENT

 NOTES

 TAPE READ

 TAPE OR ROD

 TAPE OR ROD

 INSTRUMENT NO. _____
 TAPE NO. _____

WEATHER


CLEAR
 CLOUDY
 WINDY
 RAIN
 FAIR

SNOW
 HOT
 MODERATE
 COLD
 FOG

FILE No. _____
 FLDR. No. _____
 SHEET 3043
 FIGURED BY _____
 NOTES CHECKED BY _____
 PLOTTED BY _____
 DATE _____ 19__

Quad. No. _____

STATION	DIST.	ANGLE	"	+	H. I. BEARING	VER. ANG. DIFF.	ELEVATION
Sta. 22+63.81		6"X6" Tee					Tie point.
AT P.I.#A	1	1334315					
B.S.P.I.#3	3	410945					
TO CXL'TEE	M	1334315					
22+27 ²¹							P.I.#4
22+15'							EDGE MARL.
21+62 ⁴⁵	43.10'						LT. N.E. COR. M-122
18+36 ⁵²	43.40'						LT. S.E. COR. M-121
17+38 ⁰⁰							EDGE MARL.
AT P.I.#3	1	1722700					
B.S.P.I.#2	3	1572130					
TO P.I.#4	M	1722710					

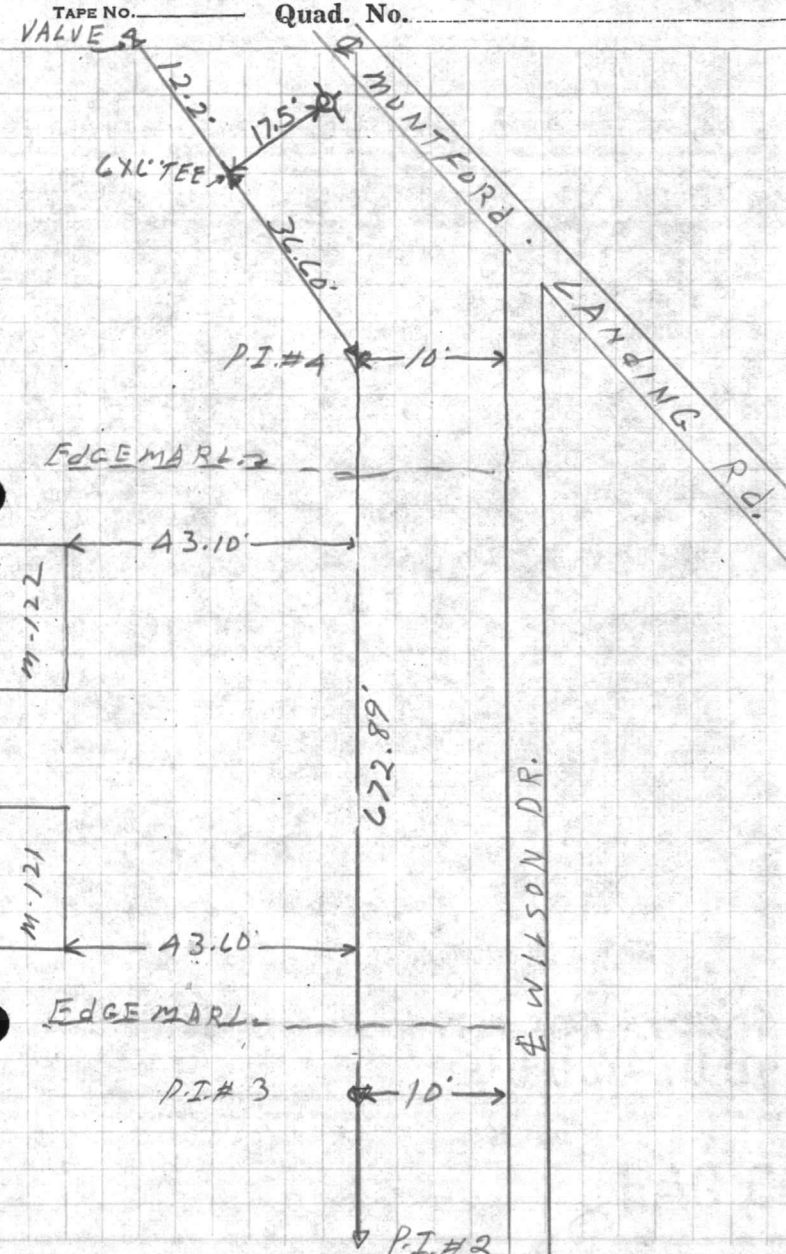



RETURN TO
 PUBLIC WORKS
 & OFFICE






