

VALUABLE

SUBJECT

Additional Bldgs.
Humphreys Point Camp 2-A

MONTFORD POINT No 2

RETURN TO
PUBLIC WORKS
OFFICE
CAMP LEJEUNE
NEW RIVER, N. C.

FIELD PARTY

Hamilton IN CHARGE

INSTRUMENT

NOTES

TAPE READ

TAPE OR ROD

TAPE OR ROD

INSTRUMENT No.

TAPE No.

WEATHER

CLEAR SNOW
CLOUDY HOT
WINDY MODERATE
RAIN COLD
FAIR FOG

FILE No. 118-2

FLDR. No.

SHEET #1 of 1

DATE 12/14 1945



Quad. No. 118

STATION	DIST.	ANGLE	+	H. I.	VER. ANG. DIFF.	ELEVATION
---------	-------	-------	---	-------	-----------------	-----------

Hayes St.

M 232

364.4'

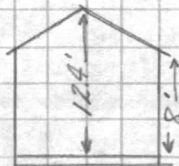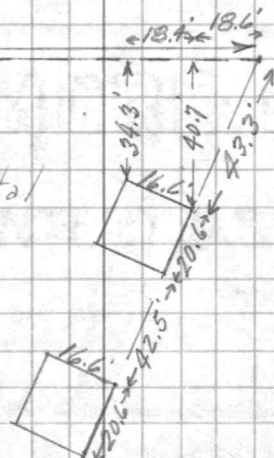1 Story Sheet Metal
Storage Bldg.
Concrete FloorPlotted By: BDB - 4-26-46
Checked By: VLT - 4-26-46

B.M. 4661 15.53

F.L. C.B. 27 18.2

" " 26 15.5

VALUABLE

Return To
Public Works
Office
Camp Lejeune
North Carolina


SUBJECT Location of Two Small
Bldg's Adjacent to Bldg
231 Montford Pl #2A

FIELD PARTY
Baldwin In Charge
____ Instrument
____ Notes
____ Tape Read
____ Tape or Rod
____ Tape or Rod
____ Instrument No.
____ Tape No.

WEATHER
Clear _____
Cloudy _____
Windy _____
Rain _____
Fair _____
Snow _____
Hot _____
Moderate _____
Cold _____
Fog _____
Figured By _____
Notes Checked By _____
Plotted By _____
Quad. No. 118

FILE No. 118-J
Fldr. No. _____
Sheet _____
Date 4-26 1946

Station Dist. Angle " + H. I. Bearing Ver: Ang. Diff. Elevation

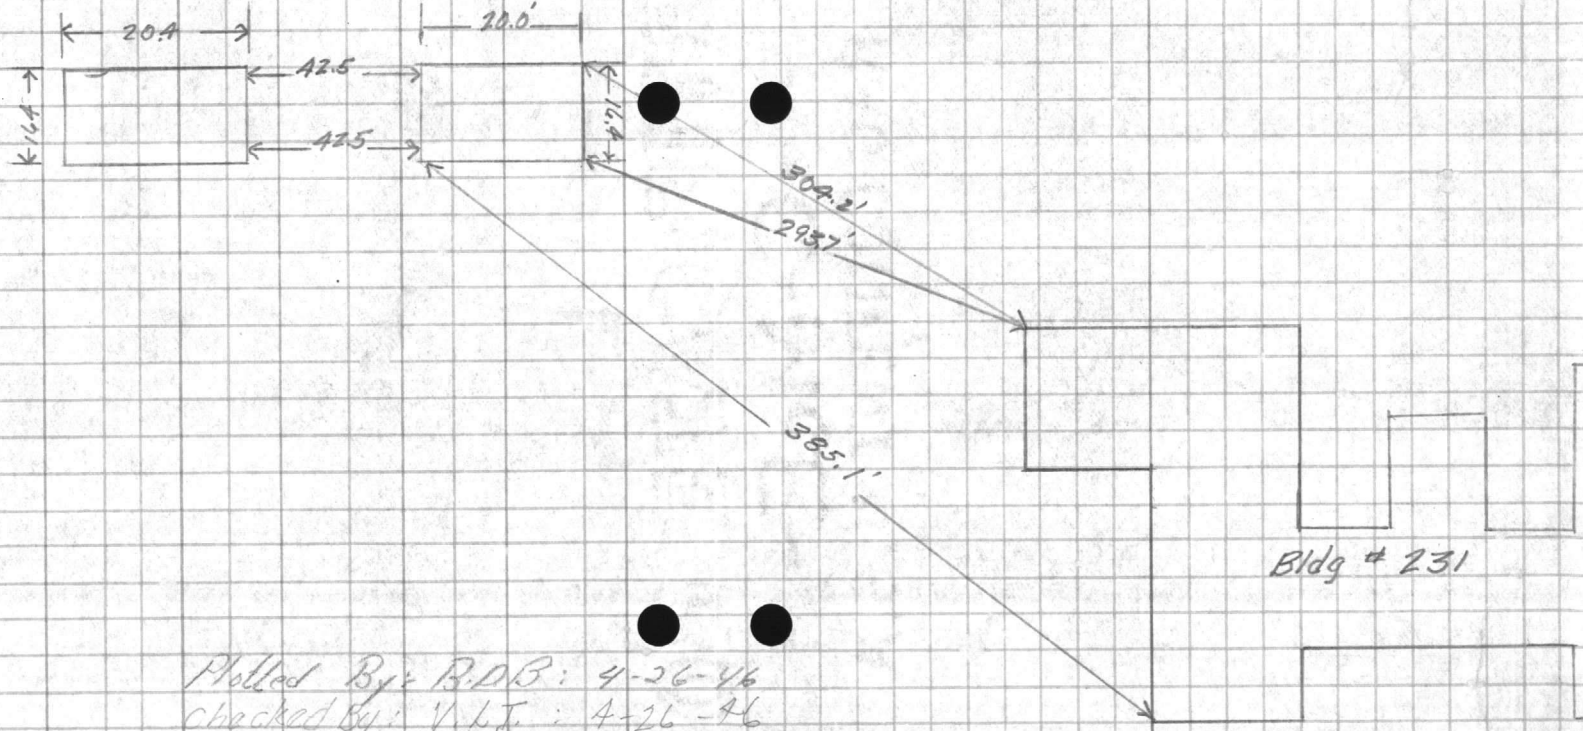

Plotted By: R.D.B. : 4-26-46
checked By: V.L.T. : 4-26-46



















VALUABLE

SUBJECT

Location of Stone
Drive at Bldg #231
Montford Pt 2A

RETURN TO
PUBLIC WORKS
OFFICE

CAMP LEJEUNE
NEW RIVER, N. C.

FIELD PARTY

Baldwin IN CHARGE

INSTRUMENT

NOTES

TAPE READ

TAPE OR ROD

TAPE OR ROD

INSTRUMENT No.

TAPE No.

WEATHER

CLEAR SNOW

CLOUDY HOT

WINDY MODERATE

RAIN COLD

FAIR FOG

FIGURED BY

NOTES CHECKED BY

PLOTTED BY

Quad. No.

FILE No. 115-d


FLDR. No.

SHEET

DATE 4-26-46

118

STATION	DIST.	ANGLE	+	H. I.	VER. ANG. DIFF.	ELEVATION
---------	-------	-------	---	-------	-----------------	-----------

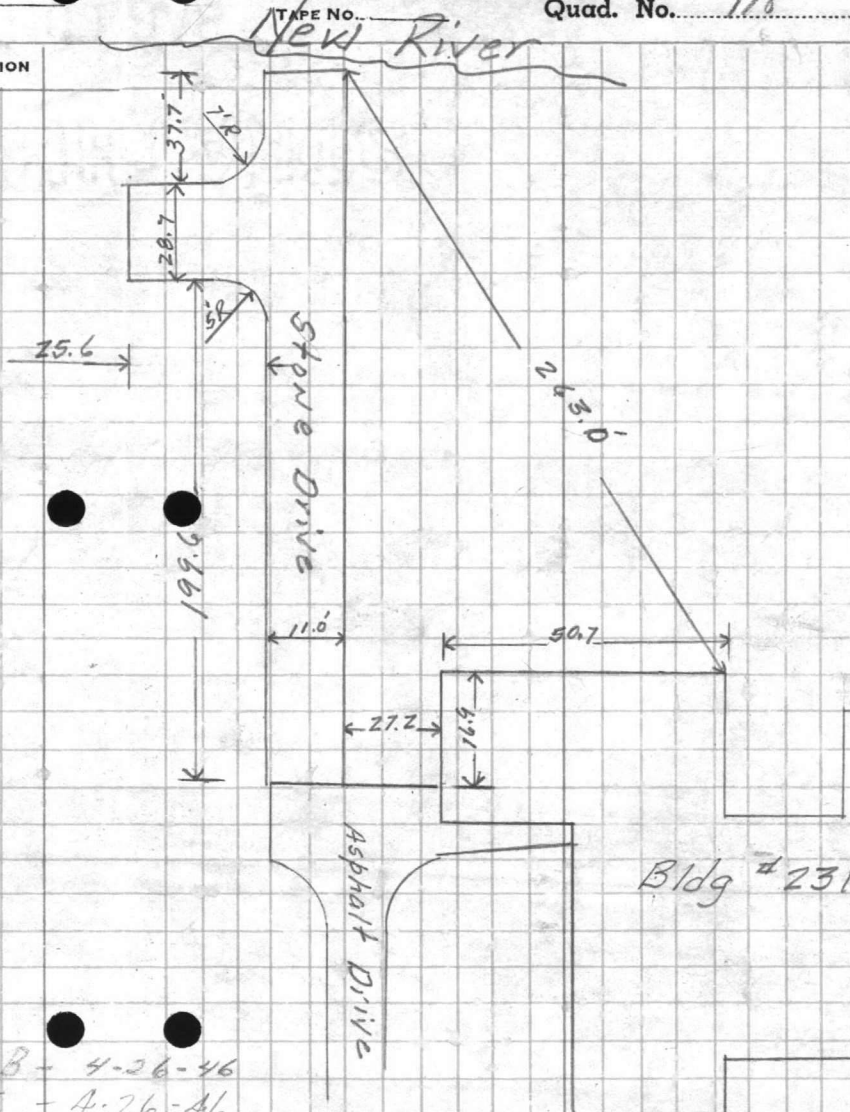

Plotted By: BDB - 4-26-46
Checked By: V.L.T. - 4-26-46

VALUABLE

SUBJECT MIDNFORD PT
DIMENSIONS OF BLDG. 202
MESS HALL

Return To
 Public Works
 Office
 Camp Lejeune
 North Carolina

FIELD PARTY
GARNER In Charge
 _____ Instrument
 _____ Notes
 _____ Tape Read
 _____ Tape or Rod
 _____ Tape or Rod
 _____ Instrument No.
 _____ Tape No.


WEATHER
 Clear _____
 Cloudy _____
 Windy _____
 Rain _____
 Fair _____
 Snow _____
 Hot _____
 Moderate _____
 Cold _____
 Fog _____
 Figured By _____
 Notes Checked By _____
 Plotted By _____

FILE No. _____
 Fldr. No. 93.81
 Sheet 66.5
 Date _____ 19__

Quad. No. _____

Station	Dist.	Angle	H. I.	Ver. Ang.	Elevation
		' "	Bearing	Diff.	

Width of Porch on Front of Theatre
Bldg. # 129 - - - 12.92'

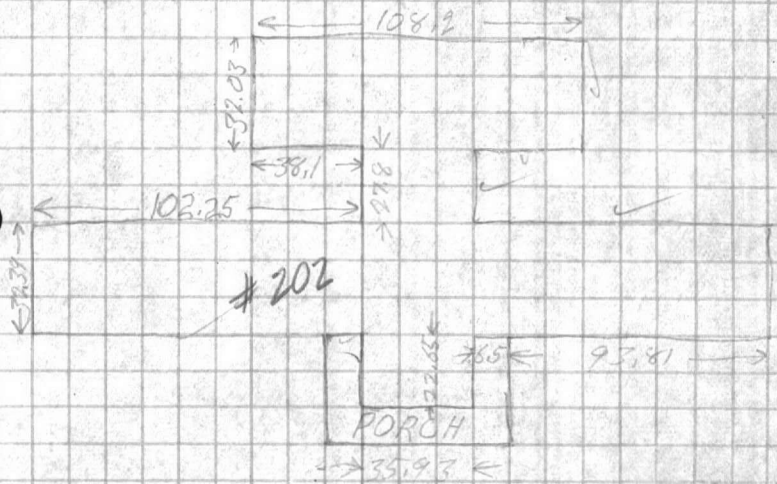

102.25
 38.10
 64.15
 2
 128.30
 105.2
 236.5

93.81
 93.81
 6.50
 6.50
 35.93
 236.55

Plotted By: TDR 4-21-46
 Checked By: J.F.M. 4-23-46















VALUABLE

SUBJECT Building Locations
Montford Pt. Camp #2
MONTFORD POINT
No. 2.

Return To
 Public Works
 Office
 Camp Lejeune
 North Carolina

FIELD PARTY

In Charge _____
 Instrument Hamilton
 Notes _____
 Tape Read _____
 Tape or Rod _____
 Tape or Rod _____
 Instrument No. _____
 Tape No. _____


WEATHER

Clear _____
 Cloudy _____
 Windy _____
 Rain _____
 Fair _____
 Snow _____
 Hot _____
 Moderate _____
 Cold _____
 Fog _____
 Figured By _____
 Notes Checked By _____
 Plotted By _____

FILE No. 118-1E
 Fldr. No. _____
 Sheet 41 of 4
 Date Feb 11 1946

Quad. No. _____

Station	Dist.	Angle "	+	H. I. Bearing	Ver. Ang. Diff.	Elevation
Bldg 203B	193	09 00 (1)				
0+43.75	219	26 45 (3)				
	193	08 55 (mean)				
0+00						
PI #1						
Bldg # 203						
Cor A	148	18 00 (1)				
0+53.95	24	30 00 (3)				
	148	10 00 (mean)				
0+00						
PI #1						
Bldg # 202						
Cor A	52	50 00 (1)				
0+46.96	158	30 00 (3)				
	52	50 00 (mean)				
0+00						
PI #1						
3+06.25	181	09 00 (3)				
	180	23 00 (mean)				
0+00						
T. Mon #91						
B.S. Mon #140						

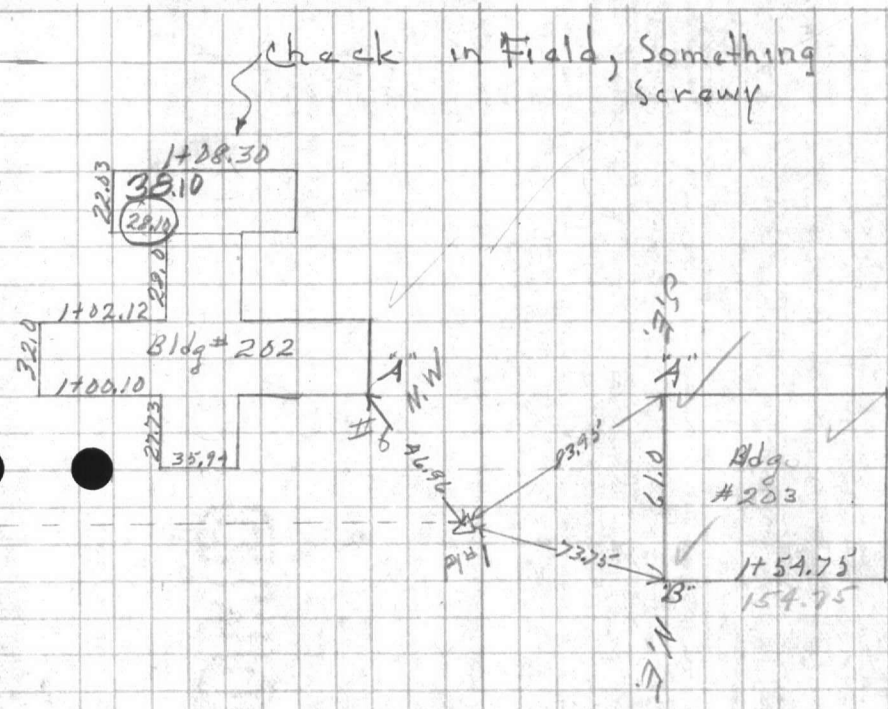

Plotted By: J.F.M. 3-29-46
 Checked By: T.D.R. 4-2-46

VALUABLE

SUBJECT Building Locations + distances
Mumford Pt. Camp # 2

Return To
 Public Works
 Office
 Camp Lejeune
 North Carolina

FIELD PARTY

In Charge _____
 Instrument _____
 Notes Hamilton
 Tape Read _____
 Tape or Rod _____
 Tape or Rod _____
 Instrument No. _____
 Tape No. _____


WEATHER

Clear _____
 Cloudy _____
 Windy _____
 Rain _____
 Fair _____
 Snow _____
 Hot _____
 Moderate _____
 Cold _____
 Fog _____
 Figured By _____
 Notes Checked By _____
 Plotted By _____

FILE No. 118-E
 Fldr. No. _____
 Sheet # 2 of 4
 Date Feb 11 1946

Quad. No. _____

Station	Dist.	Angle	"	+	H. I. Bearing	Ver. Ang. Diff.	Elevation
PT#3	156	58	00 (1)				
A 26.0	110	53	45 (2)				
	156	57	55 (mean)				
Brg. 3 93° W							
0+00							
P.I. # 2							
Bldg # 211	93	24	00 (1)				
0+83.30	280	12	15 (3)				
	93	24	25 (mean)				
0+00							
P.I. # 2							
Bldg # 205	18	19	30 (1)				
0+92.72	54	58	30 (3)				
	18	19	30 (mean)				
0+00							
P.I. # 2							
3+96.33	294	19	15 (3)				
	98	06	35 (mean)				
Brg. 5 31° 45' W							
0+00							
P.I. # 1							
BS Mon # 91							

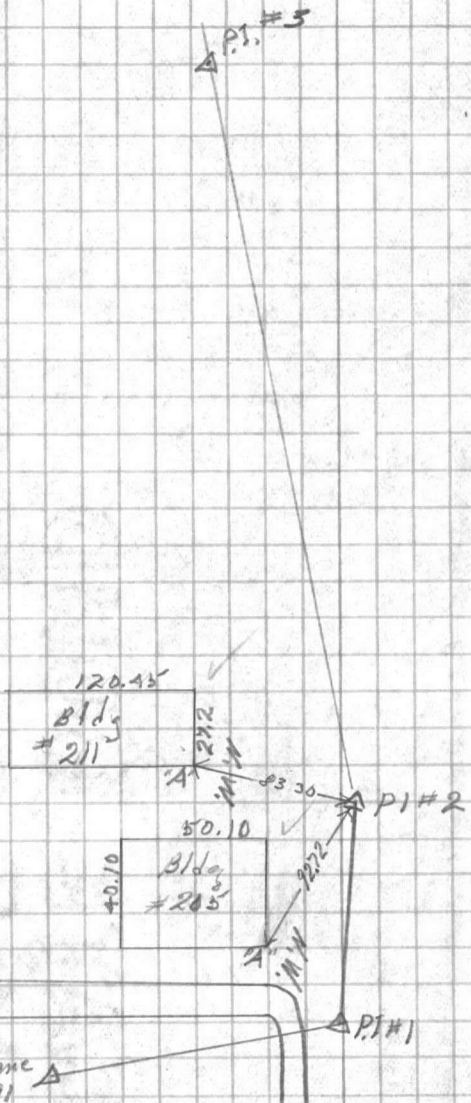













VALUABLE

SUBJECT Building Locations
Monford Pt. Camp # 2

Return To
 Public Works
 Office
 Camp Lejeune
 North Carolina

FIELD PARTY

In Charge _____
 Instrument _____
 Notes Hamilton
 Tape Read _____
 Tape or Rod _____
 Tape or Rod _____
 Instrument No. _____
 Tape No. _____


WEATHER

Clear _____
 Cloudy _____
 Windy _____
 Rain _____
 Fair _____
 Snow _____
 Hot _____
 Moderate _____
 Cold _____
 Fog _____
 Figured By _____
 Notes Checked By _____
 Plotted By _____

FILE No. 118-15
 Fldr. No. _____
 Sheet # 3 of 4
 Date Feb 11 19____

Quad. No. _____

Station	Dist.	Angle "	+	H. I. Bearing	Ver: Ang. Diff.	Elevation
PJ#1	118	57 00 (1)				
4+38+14	356	42 00 (3)				
	118	57 00 (mean)				
0+00						
PJ#3						
Bldg 219						
Cot A	98	42 00 (1)				
1+95.72	296	06 00 (3)				
	98	42 00 (mean)				
0+00						
PJ#3						
Bldg 214						
Cot A	01	03 00 (1)				
1+09.92	03	09 00 (3)				
	01	03 00 (mean)				
0+00						
PJ#3						
B3 PJ#2						

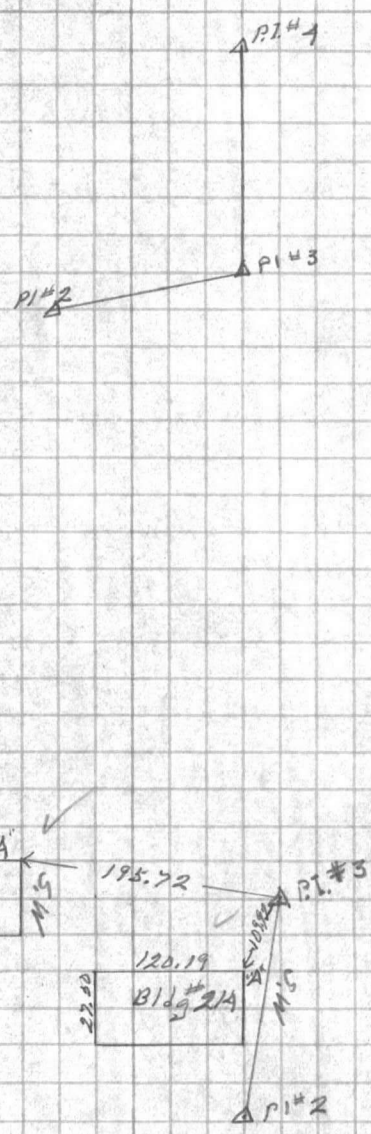













VALUABLE

SUBJECT Building Locations
Numbered Pt. Camp #2

Return To
 Public Works
 Office
 Camp Lejeune
 North Carolina

FIELD PARTY

In Charge _____
 Instrument _____
 Notes Hamilton
 Tape Read _____
 Tape or Rod _____
 Instrument No. _____
 Tape No. _____


WEATHER

Clear _____
 Cloudy _____
 Windy _____
 Rain _____
 Fair _____
 Snow _____
 Hot _____
 Moderate _____
 Cold _____
 Fog _____

FILE No. 118-E
 Fldr. No. _____
 Sheet #9 of 4
 Date Feb 11 19__

Quad. No. _____

Station	Dist.	Angle ' "	+	H. I. Bearing	Ver: Ang. Diff.	Elevation
Bldg COR A	106	25 00 (1)				
3+59.93	319	15 00 (3)				
	106	25 00 (mean)				
DTDD USMC #139						
B.S. P1 #4						
Bldg 229 COR A	141	96 00 (1)				
3+17.83	65	18 00 (3)				
	141	96 00 (mean)				
DTDD P1 #4						
USMC 170m #139	141	53 00 (1)				
3+67.63	65	38 45 (3)				
	141	52 55 (mean)				
DTDD P1 #4						
B.S. P1 #3						

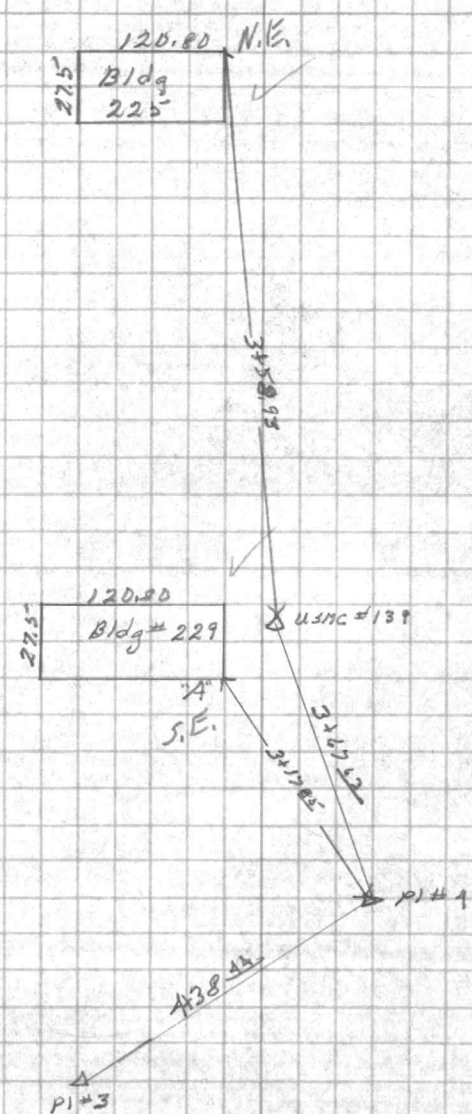






VALUABLE

SUBJECT

*Tie for Hamilton's**Traverses*Return To
Public Works
Office
Camp Lejeune
North Carolina

FIELD PARTY

____ In Charge
____ Instrument
____ Notes
____ Tape Read
____ Tape or Rod
____ Instrument No.
____ Tape No.

WEATHER

Clear _____ Snow _____
Cloudy _____ Hot _____
Windy _____ Moderate _____
Rain _____ Cold _____
Fair _____ Fog _____

FILE No. _____

Fldr. No. _____

Sheet *1-1*Date *2-15* 19 *46*

Figured By _____

Notes Checked By _____

Plotted By _____

Quad. No. _____

Station	Dist.	Angle ° ' "	+	H. I. Bearing	Ver: Ang. Diff.	Elevation
---------	-------	----------------	---	------------------	--------------------	-----------

*Mon
140**113 45 30**341 16 30**113 45 30**Mon
139**BS
PI 4*































TABLE

SUBJECT Building Locations
Mumbord Pt. Camp #2

Return To
 Public Works
 Office
 Camp Lejeune
 North Carolina

FIELD PARTY

In Charge _____
 Instrument Wemitter
 Notes _____
 Tape Read _____
 Tape or Rod _____
 Tape or Rod _____
 Instrument No. _____
 Tape No. _____

WEATHER

Clear _____
 Cloudy _____
 Windy _____
 Rain _____
 Fair _____
 Snow _____
 Hot _____
 Moderate _____
 Cold _____
 Fog _____

FILE No. 118-E
 Fldr. No. _____
 Figured By _____
 Notes Checked By _____
 Plotted By _____
 Date Feb 11 1946

Quad. No. _____

Station	Dist.	Angle "	+	H. I. Bearing	Ver: Ang. Diff.	Elevation									

Plotted By: J.F.M. 3-29-46
 Checked By: T.D.R. 4-2-46








QUABLE

SUBJECT Bldgs. Montford Pt. Camp #2

Return To
Public Works
Office
Camp Lejeune
North Carolina


FIELD PARTY
Hamilton In Charge
Instrument _____
Notes _____
Tape Read _____
Tape or Rod _____
Instrument No. _____
Tape No. _____

WEATHER
Clear _____
Cloudy _____
Windy _____
Rain _____
Fair _____
Snow _____
Hot _____
Moderate _____
Cold _____
Fog _____
Figured By _____
Notes Checked By _____
Plotted By _____

FILE No. 118-E
Fldr. No. _____
Sheet _____
Date _____ 19__

Quad. No. _____

Station	Dist.	Angle " "	+	H. I. Bearing	Ver: Ang. Diff.	Elevation
---------	-------	--------------	---	------------------	--------------------	-----------

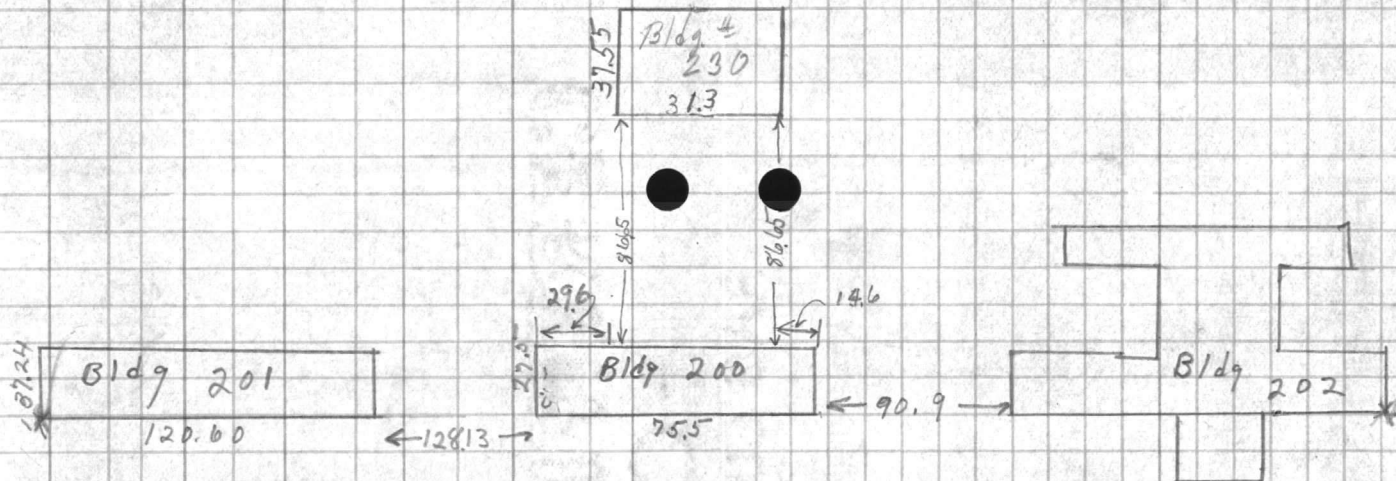

Plotted By: J.F.M. 3-29-46
Checked By: T.D.R. 4-2-46














TABLE

SUBJECT Building Location
Mumford Pt Camp #1

Return To
 Public Works
 Office
 Camp Lejeune
 North Carolina

FIELD PARTY

In Charge _____
 Instrument Hamilton
 Notes _____
 Tape Read _____
 Tape or Rod _____
 Tape or Rod _____
 Instrument No. _____
 Tape No. _____

WEATHER

Clear _____
 Cloudy _____
 Windy _____
 Rain _____
 Fair _____
 Snow _____
 Hot _____
 Moderate _____
 Cold _____
 Fog _____

FILE No. 118-E

Fldr. No. _____

Sheet _____

Figured By _____
 Notes Checked By _____
 Plotted By _____

Date Feb 11 1946

Quad. No. _____

Station	Dist.	Angle	"	+	H. I. Bearing	Ver: Ang. Diff.	Elevation
---------	-------	-------	---	---	---------------	-----------------	-----------


Bldg # 201
 Cor A 74 35 00 (1)
 1434.60 223 45 00 (2)
 74 35 00 (mean)

0450
 Mon # 140

Bldg 218
 Cor A 01 10 30 (1)
 3457.12 03 30 30 (5)
 01 10 30 (mean)

0400
 T. Don # 140

B.S. Wood # 139

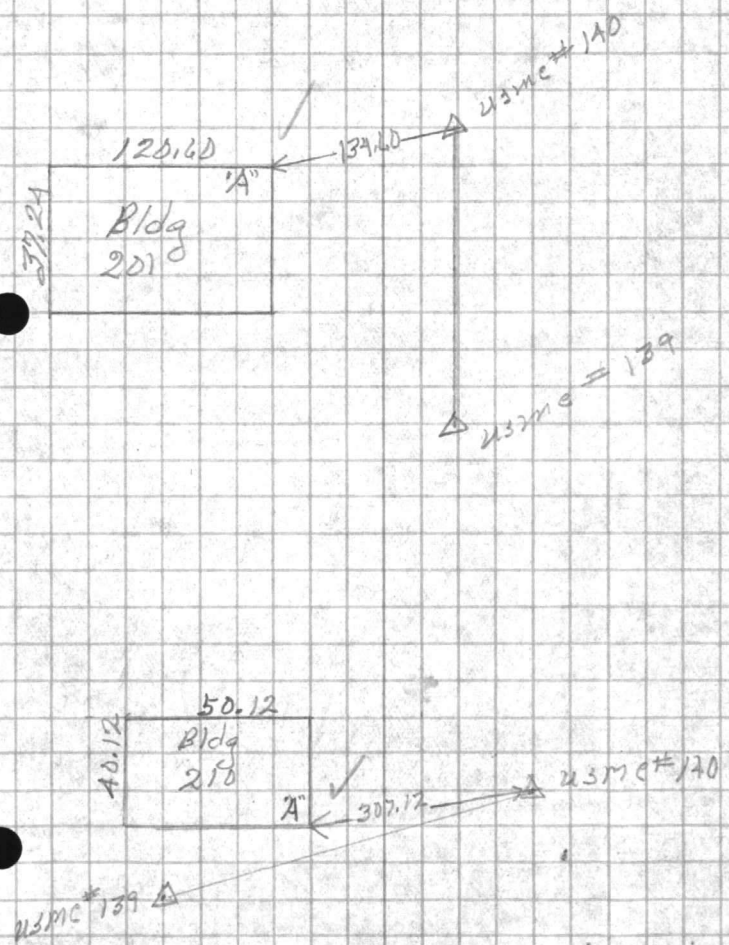

PUBLIC WORKS DEPARTMENT
Camp Lejeune, North Carolina
Survey Department

File 118-E
Quadrangle 118
Date 2/15/46
Sheet #1 of

Traverse Computation
Description

Co-ordinated Corners of Buildings at Montford Pt. Camp # 2

Station	Distance	Bearing	Cosine	Sine	Latitude	Departure	Y Coordinate North	X Coordinate East
U.S.M.C. Mon. # 140 from Mon. # 139		N17°50'40"E					358,437.40	2,477,733.80
N.E. Cor. of Washroom Bldg. # 210	307.12	S14°01'W	94552	32557	290.39	99.99	358,147.01	2,477,133.81
N.E. Cor. of School Bldg. # 201	134.60	N87°39'20W	0423633	9991033	5.70	134.48	358,443.10	2,477,099.32
U.S.M.C. Mon. # 91 from Mon. # 140		N72°09'W					358,571.70	2,476,754.66
P.I. # 1 3+06.25	-306.25	N71°46'W	31289	94979	95.82	290.87	358,687.52	2,476,463.79
N.W. Cor. Mess Hall Bldg. # 202	46.96	S21°46'E	9287	37083	43.61	17.41	358,643.91	2,476,481.20
S.E. " Warehouse Bldg. # 203	83.95	S76°24'W	23514	97196	19.74	81.60	358,667.78	2,476,382.19
N.E. " " " "	73.75	N58°37'W	52076	8537	38.41	62.96	358,725.93	2,476,400.83
P.I. # 2 3+96.33	-396.33	S26°20'25"W	8961542	4437417	355.19	175.87	358,332.35	2,476,287.92
N.W. Cor. Washroom Bldg. # 205	92.72	N45°50'30"E	696645	71742	64.59	66.52	358,396.94	2,476,354.40
N.W. " Barracks " # 211	83.30	S60°15'30"E	49609	86827	41.32	72.33	358,291.03	2,476,360.25
P.I. # 3 4+26.00	-426.00	S30°18'30"W	998335	057705	425.29	24.58	357,907.06	2,476,263.34
S.W. Cor. Barracks Bldg. # 214	109.92	N6°18'30"E	993945	109875	109.25	12.08	358,016.31	2,476,275.42
S.W. " " " # 219	195.72	S77°59'30"E	208085	97812	40.72	199.44	357,864.24	2,476,454.78
P.I. # 4 4+38.44	-438.44	S57°47'30"E	533	846115	233.69	370.97	357,673.37	2,476,634.31
S.E. Cor. Barracks Bldg. # 229	317.85	N83°58'30"E	104965	994475	33.36	316.09	357,706.73	2,476,950.40
U.S.M.C. Mon. # 139	-367.63	N84°05'25"E	1028592	9946825	37.81	365.67	357,711.18 357,711.10	2,476,999.98 2,476,999.98
N.E. Cor. Barracks Bldg. # 225	358.93	N10°30'25"E			353.91	65.79	358,065.09	2,477,065.77
To Mon. # 140		N17°50'55"E						
		N17°50'40"E						

1934.65

Cor. not Adj.

1934.65 ÷ .05 = 11,291.83

Plotted By: J.F.M. 3-23-46
Checked By: T.D.R. 4-2-46

Err. 008

VALUABLE

Return To
Public Works
Office
Camp Lejeune
North Carolina


SUBJECT Location of Bldg
Monfort Point

FIELD PARTY
Turlington In Charge
Instrument
Notes
Mortor Tape Read
Katche Tape or Rod
Tape or Rod
Instrument No.
Tape No.

WEATHER
Clear
Cloudy
Windy
Rain
Fair
Snow
Hot
Moderate
Cold
Fog
Figured By
Notes Checked By
Plotted By

FILE No. _____
Fldr. No. _____
Sheet 1-3
Date 2-12 19__

Quad. No. _____

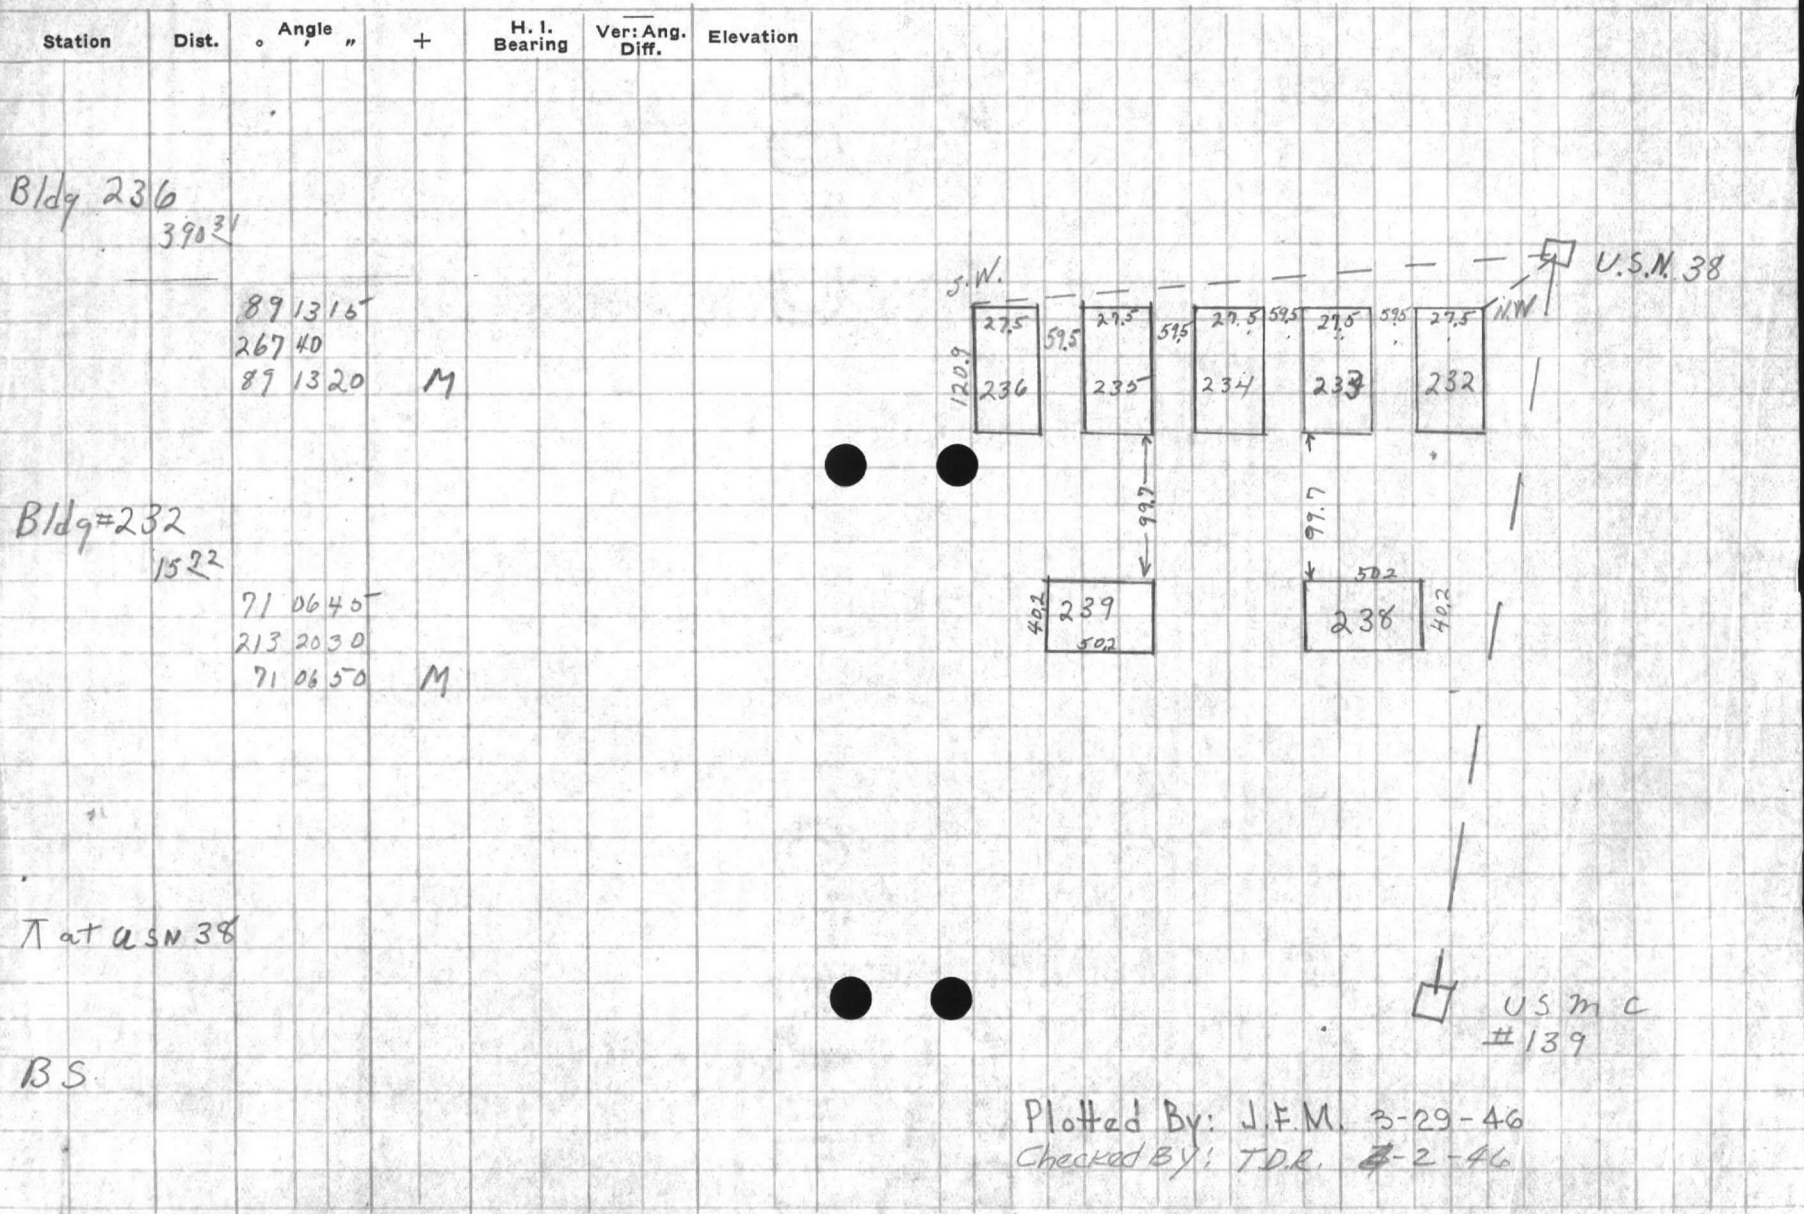

Plotted By: J.F.M. 3-29-46
Checked By: T.D.R. 4-2-46

North Carolina





































VALUABLE

SUBJECT _____

Return To
Public Works
Office
Camp Lejeune
North Carolina

FIELD PARTY

_____ In Charge
_____ Instrument
_____ Notes
_____ Tape Read
_____ Tape or Rod
_____ Instrument No.
_____ Tape No.

WEATHER

Clear
Cloudy
Windy
Rain
Fair

Snow
Hot
Moderate
Cold
Fog

FILE No. _____

Fldr. No. _____

Figured By _____ Sheet 2-3


Notes Checked By _____

Plotted By _____ Date 2-12 1946

Quad. No. _____

Station	Dist.	Angle	"	+	H. I. Bearing	Ver: Ang. Diff.	Elevation
Bldg							
Cor A	270.52	276.40	30				
		110.01	30				
		276.40	30	M			
Cor B	483.27	279.27					
		118.21					
		279.27		M			

USM^c
#139

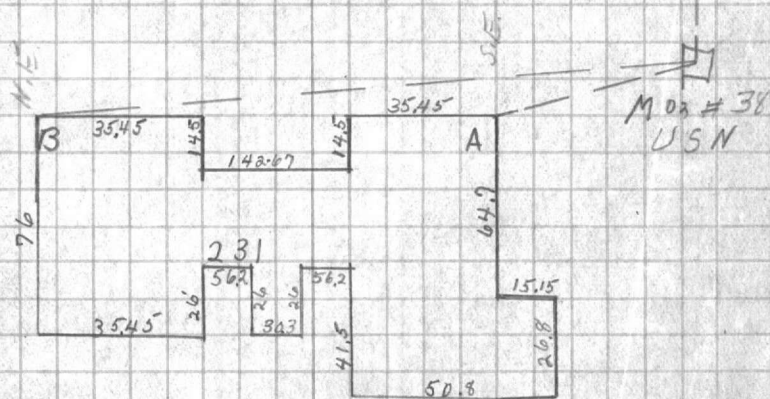

Plotted By: J.F.M. 3-29-46
Checked By: T.D.R. 4-2-46

VALUABLE

SUBJECT _____

Return To
 Public Works
 Office
 Camp LeJeune
 North Carolina

FIELD PARTY

_____ In Charge
 _____ Instrument
 _____ Notes
 _____ Tape Read
 _____ Tape or Rod
 _____ Tape or Rod
 _____ Instrument No.
 _____ Tape No.

WEATHER


Clear
 Cloudy
 Windy
 Rain
 Fair
 Snow
 Hot
 Moderate
 Cold
 Fog
 Figured By _____
 Notes Checked By _____
 Plotted By _____

FILE No. _____
 Fldr. No. _____
 Sheet 3-3
 Date _____ 19__

Quad. No. _____

Station	Dist.	Angle "	+	H. I. Bearing	Ver. Ang. Diff.	Elevation
Bldg 240 Cor A	150 ²⁵	30 42 15				
		92 07				
		30 42 20	M			
Cor B	352 ⁸¹	68 26 15				
		205 18 45				
		68 26 25	M			
Bldg 237 Cor A	106 ²⁵	272 17 45				
		96 53 30				
		272 17 50	M			
Cor B	111 ⁸⁷	251 22				
		34 06				
		251 22	M			
At P.O.T.						

A Mon USMC
 139

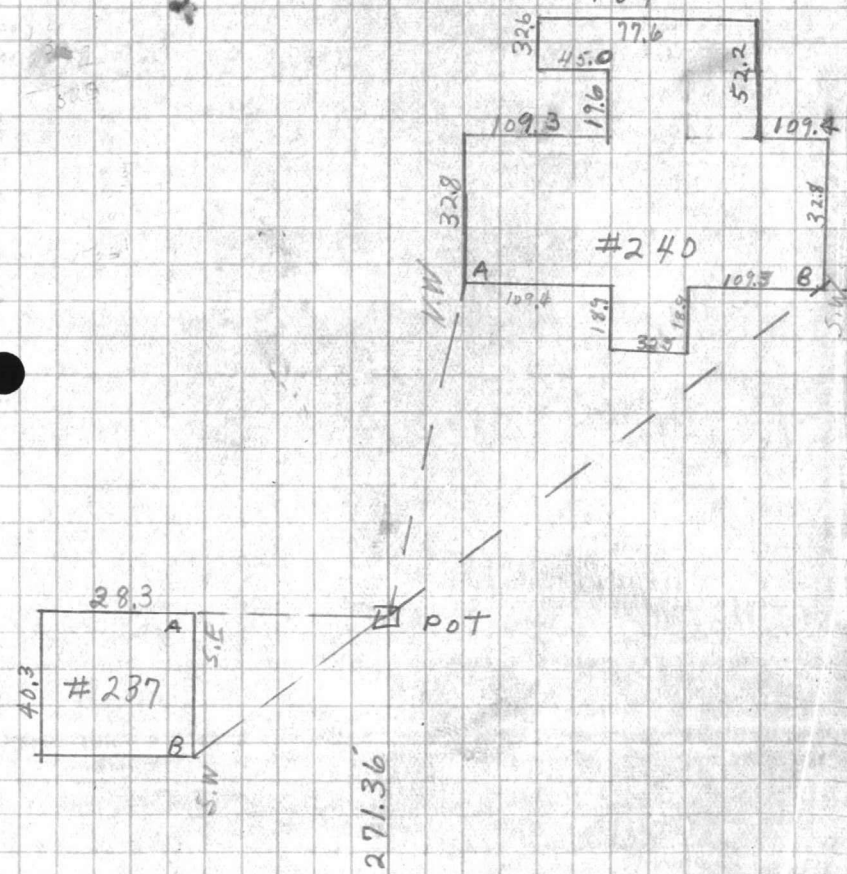

Plotted By: J.F.M. 3-29-46 A Mon USN
 Checked By: T.D.R. 4-2-46 38

B 5
 139

Weather
Return To
Public Works
Office
Camp Lejeune
North Carolina

SUBJECT

Station _____
Dist. _____
Bearing _____

FIELD PARTY

In Charge _____
Instrument _____
Notes _____
Tape Read _____
Type of Rod _____
Type of Rod _____
Instrument No. _____
Tape No. _____

WEATHER

Clear _____
Cloudy _____
Hot _____
Windy _____
Rain _____
Cold _____
Fog _____
Thunder By _____
Notes Checked By _____
Plotted By _____
Date _____

FILE NO.

Grid No.



PUBLIC WORKS DEPARTMENT
Camp Lejeune, North Carolina
Survey Department

File 118-J
Quadrangle 118
Date 2/15/46
Sheet #1 of 1

Traverse Computation
Description

Co-ordinated Corners of Buildings in Montford Point Camp R-A

Station	Distance	Bearing	Cosine	Sine	Latitude	Departure	Y Coordinate North	X Coordinate East
V.S.N. Mon. # 38 from Mon. # 139		$560^{\circ}52'40''W$					357,239.20	2476,152.92
N.W. Cor. of Barracks Bldg. # 232	15.72	$548^{\circ}00'30''E$	66902	74324	10.52	11.68	357,228.68	2476,164.60 ✓
SW " " " " # 236	390.31	$529^{\circ}54'E$	8669	49849	338.36	194.57	356,900.84	2476,347.49 ✓
N.E. Cor. of B.O.G. Bldg. # 231	483.27	$N19^{\circ}40'20''W$	9416367	33664	455.06	162.69	357,694.26	2475,990.23 ✓
SE " " " " " "	270.52	$N22^{\circ}26'50''W$	9242283	381565	250.02	103.22	357,489.22	2476,049.70 ✓
P.O.T.	271.36	$N60^{\circ}52'40''E$	4866733	8735823	132.06	237.06	357,371.26	2,476,389.98
N.W. Cor. of Mess Hall Bldg. # 240	150.75	$588^{\circ}25'E$	02763	99962	4.16	150.69	357,367.10	2,476,540.67 ✓
SW " " " " " "	352.81	$550^{\circ}41'05''E$	6335908	773675	223.54	272.96	357,147.72	2,476,662.94 ✓
S.W. Cor. of Heating Plant Bldg. # 237	111.87	$N47^{\circ}45'20''W$	6722967	7402833	75.21	82.82	357,446.47	2476,307.16 ✓
SE " " " " " "	106.05	$N26^{\circ}49'30''W$	892385	45127	94.64	47.86	357,465.90	2476,342.12 ✓

Plotted By: J.F.M. 3-29-46
Checked By: TDR 4-2-46






VALUABLE

SUBJECT BENCH MARK FOR
PROPOSED WELL SITE
NEAR BLDG # M-231
MONTFORD PT.

RETURN TO
 PUBLIC WORKS
 OFFICE
 CAMP LEJEUNE
 NORTH CAROLINA

FIELD PARTY
DENNIS IN CHARGE
 _____ INSTRUMENT
 _____ NOTES
 _____ TAPE READ
 _____ TAPE OR ROD
 _____ TAPE OR ROD
 INSTRUMENT NO. _____
 TAPE NO. _____

WEATHER
 CLEAR _____ SNOW _____
 CLOUDY _____ HOT _____
 WINDY _____ MODERATE _____
 RAIN _____ COLD _____
 FAIR _____ FOG _____
 FIGURED BY _____
 NOTES CHECKED BY _____
 PLOTTED BY _____

FILE No. 118-J
 FLDR. No. _____
 SHEET 1041
 DATE 11-13 1958

Quad. No. _____

STATION	DIST.	ANGLE ° ' "	+	H. I. BEARING	VER: ANG. DIFF.	ELEVATION	
B.m.				4.22 18.11	✓	13.87 ⁹⁹	SPIKE IN TRANSFORMER POLE NEAR m-240
T.P.				2.59 16.89	✓	3.81 14.30	
B.m. (NEW)				4.29 12.60	✓	12.60 ⁷⁰	SPIKE IN P.P.# 2M-35 N.E. COR. PARKING LOT BLDG. 231
				4.88 17.48	✓		
T.P.				4.06 17.58	✓	3.96 13.52	
B.m.					✓	3.26 14.32 [?]	MON.# 139
						14.42	








VALUABLE

RETURN TO
PUBLIC WORKS
OFFICE
CAMP LEJEUNE
NORTH CAROLINA

SUBJECT

LOCATION & ELEV.
6" C.I. WATER LINE BLDG.
240. MONTFORT PT.

FIELD PARTY
DENNIS IN CHARGE
____ INSTRUMENT
____ NOTES
____ TAPE READ
____ TAPE OR ROD
____ TAPE OR ROD
____ INSTRUMENT NO.
____ TAPE NO.

WEATHER
CLEAR _____
CLOUDY _____
WINDY _____
RAIN _____
FAIR _____
SNOW _____
HOT _____
MODERATE _____
COLD _____
FOG _____
FIGURED BY _____
NOTES CHECKED BY _____
PLOTTED BY _____

FILE No. 118-2
FLDR. No. _____
SHEET 1 of 1
DATE 4-25 1937


Quad. No. _____

STATION	DIST.	ANGLE " "	+	H. I. BEARING	VER: ANG. DIFF.	ELEVATION
Bm,				390 17 40		13 50 FL. BLDG. #240

A" TOP 6" C.I. WATER 8 40 9.00

B" TOP 5" C.I. 9 74 7.54

211
755
9.76

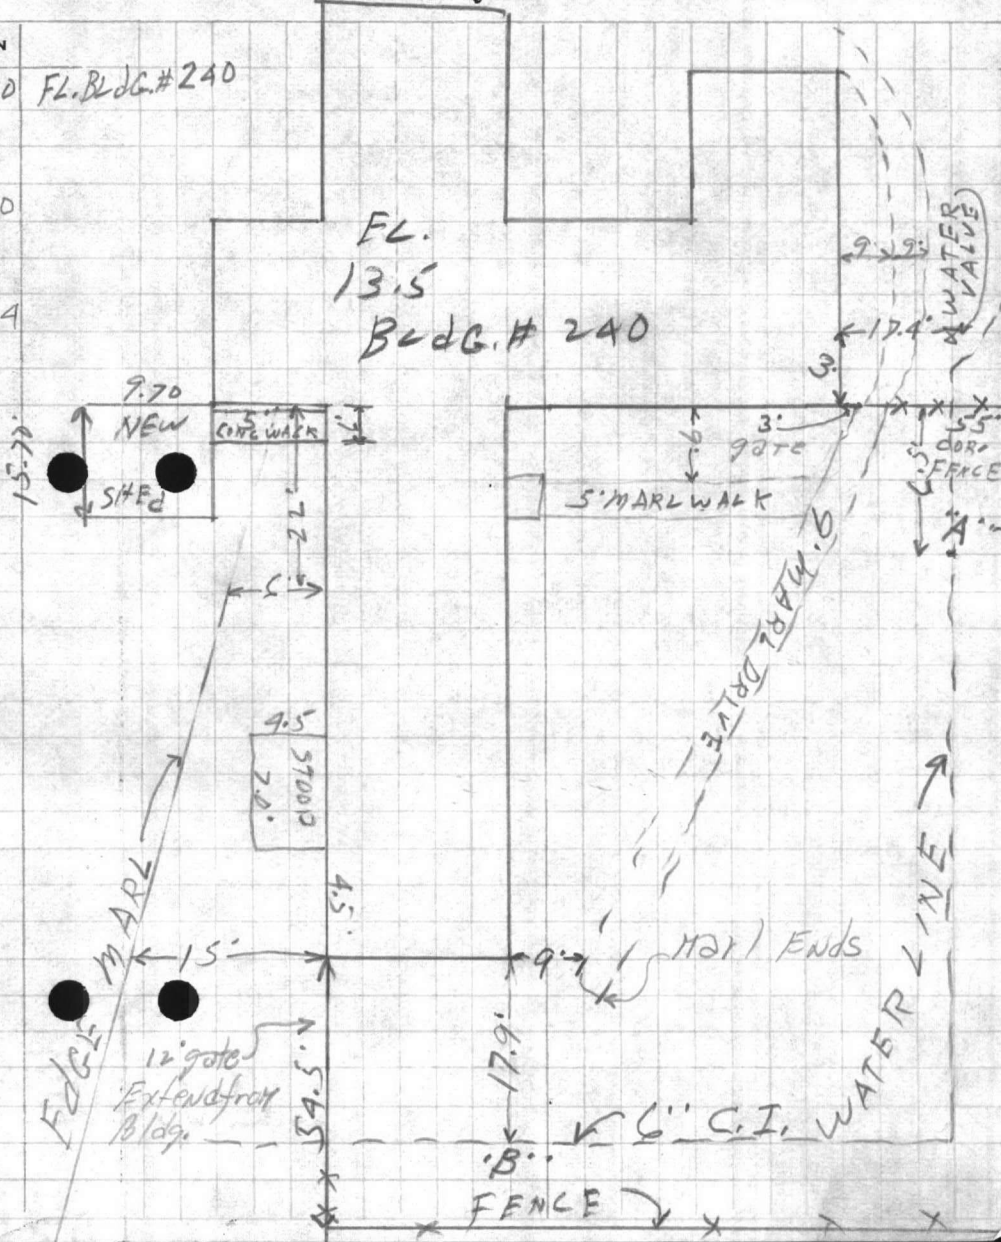

WEATHER
CLEAR
CLOUDY
WINDY
RAIN
FOG









