

CARR AND J. E. GREINER COMPANY

ARCHITECT-ENGINEERS

MARINE BARRACKS, NEW RIVER, N. C.

P-108-4  
MB-522

SUBJECT Stake Out - Waste Wash Water Tank - Water Plant

Area # 3  
SHEET OF

COMPUTED BY:

WCA


DATE

7-14-42

CHECKED BY:

DATE

OWEN G. DUNN CO. 35974-5M 12-41

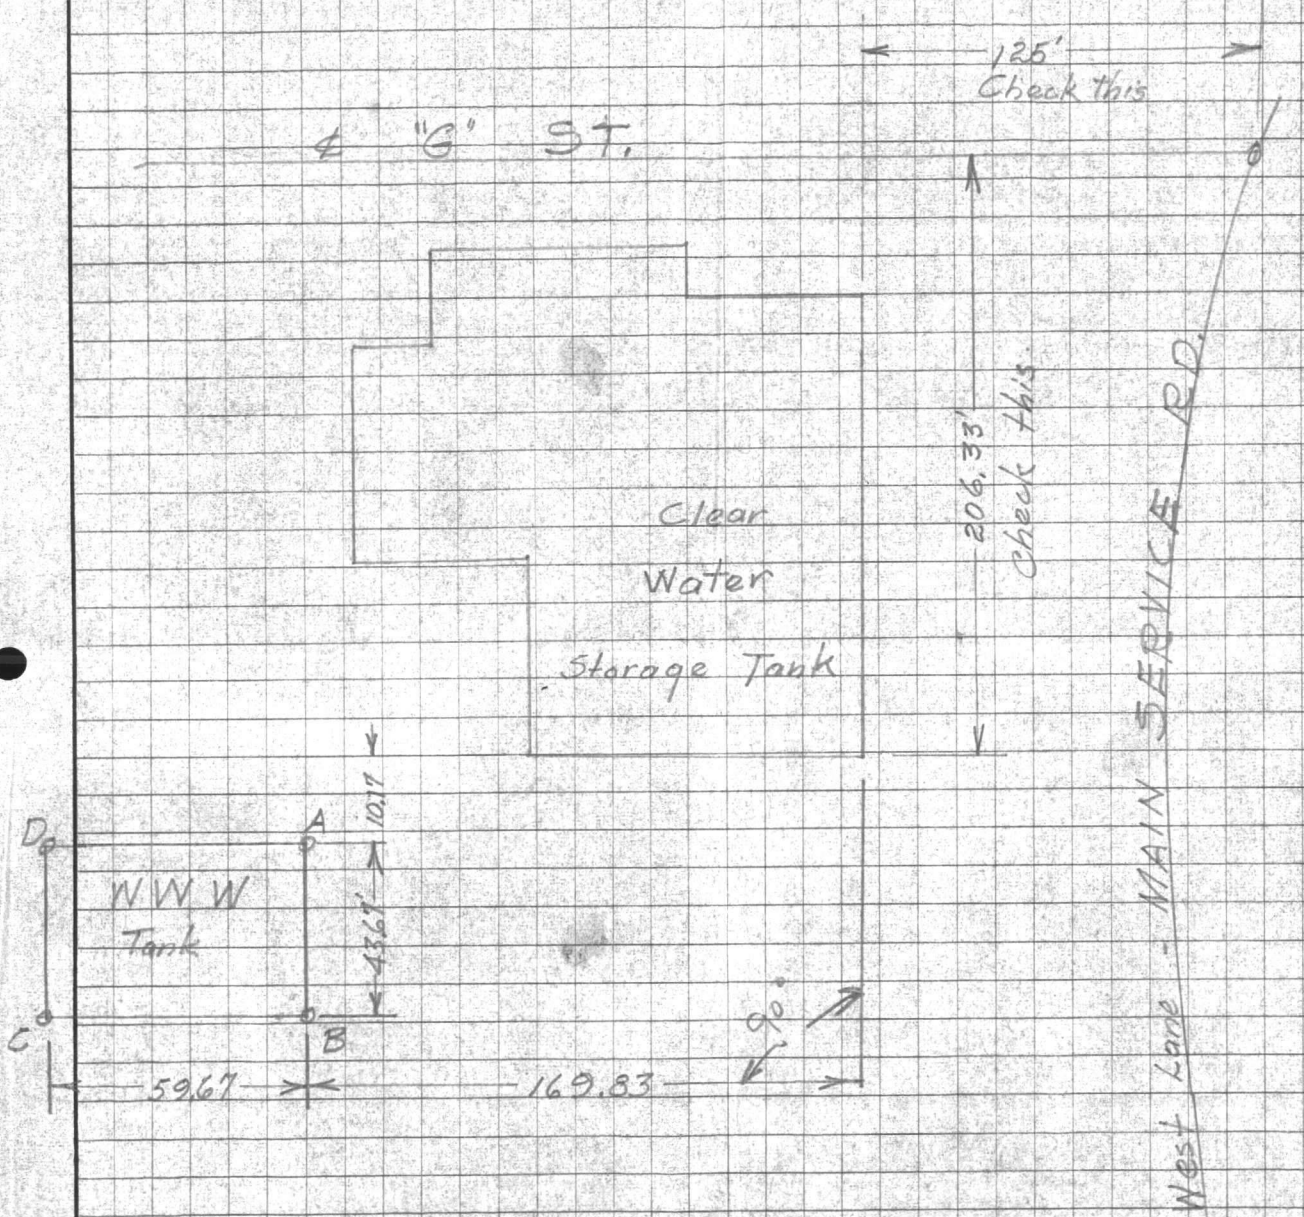

F. D. K.

MAIN ACCESS RD. Traffic Circle

CARR AND J. E. GREINER COMPANY

MARINE BARRACKS, NEW RIVER, N. C.

ARCHITECT-ENGINEERS

SUBJECT

COMPUTED BY

DATE

CHECKED BY

DATE

OF

SHEET

OWN BY: DUNN CO. 22014 - 12-41

Federal Union Bldg

**VALUABLE**
 RETURN TO  
 CARR & J. E.  
 GREINER CO.  
 JACKSONVILLE,  
 N. C.

SUBJECT

 Lay-out and Elevations  
 at Corners of Waste  
 Wash Water Tank

Reg #3

## FIELD PARTY

Powers IN CHARGE

Sondlin INSTRUMENT

NOTES

Gruzin TAPE READ

Maides TAPE OR ROD

TAPE OR ROD

INSTRUMENT NO.

TAPE NO.

## WEATHER

 CLEAR  
 CLOUDY  
 WINDY  
 RAIN  
 FAIR  
 SNOW  
 HOT  
 MODERATE  
 COLD  
 FOG

FIGURED BY

NOTES CHECKED BY

PLOTTED BY

FILE No.

FLDR. No.

SHEET 1 of 1

DATE 7-15 1942

STATION	DIST.	ANGLE " "	H. I.	VER. ANG. DIFF.	ELEVATION
---------	-------	--------------	-------	--------------------	-----------

BM# 119

0.04 25.82 25.78

A Corner (on Fill)

2.2

Half way Between A &amp; B

7.0

B "

9.5

C "

10.6

D "

8.5

BM# 119

0.04 25.78

 C 43.62'  
 W.W.W.  
 Tank

 B  
 A  
 29.83  
 73.67

216.50

90°

140'

125'

Clear Water  
Storage Tank

E.M.S. Rd

140'

VALUABLE

RECEIVED

NOV 19 1940







