

Over Size Form

Too Large
 Fragile


Bound Book
 Other _____

Sheet Number: 160

Drawing/NAVFAC Number: _____

Title

Map

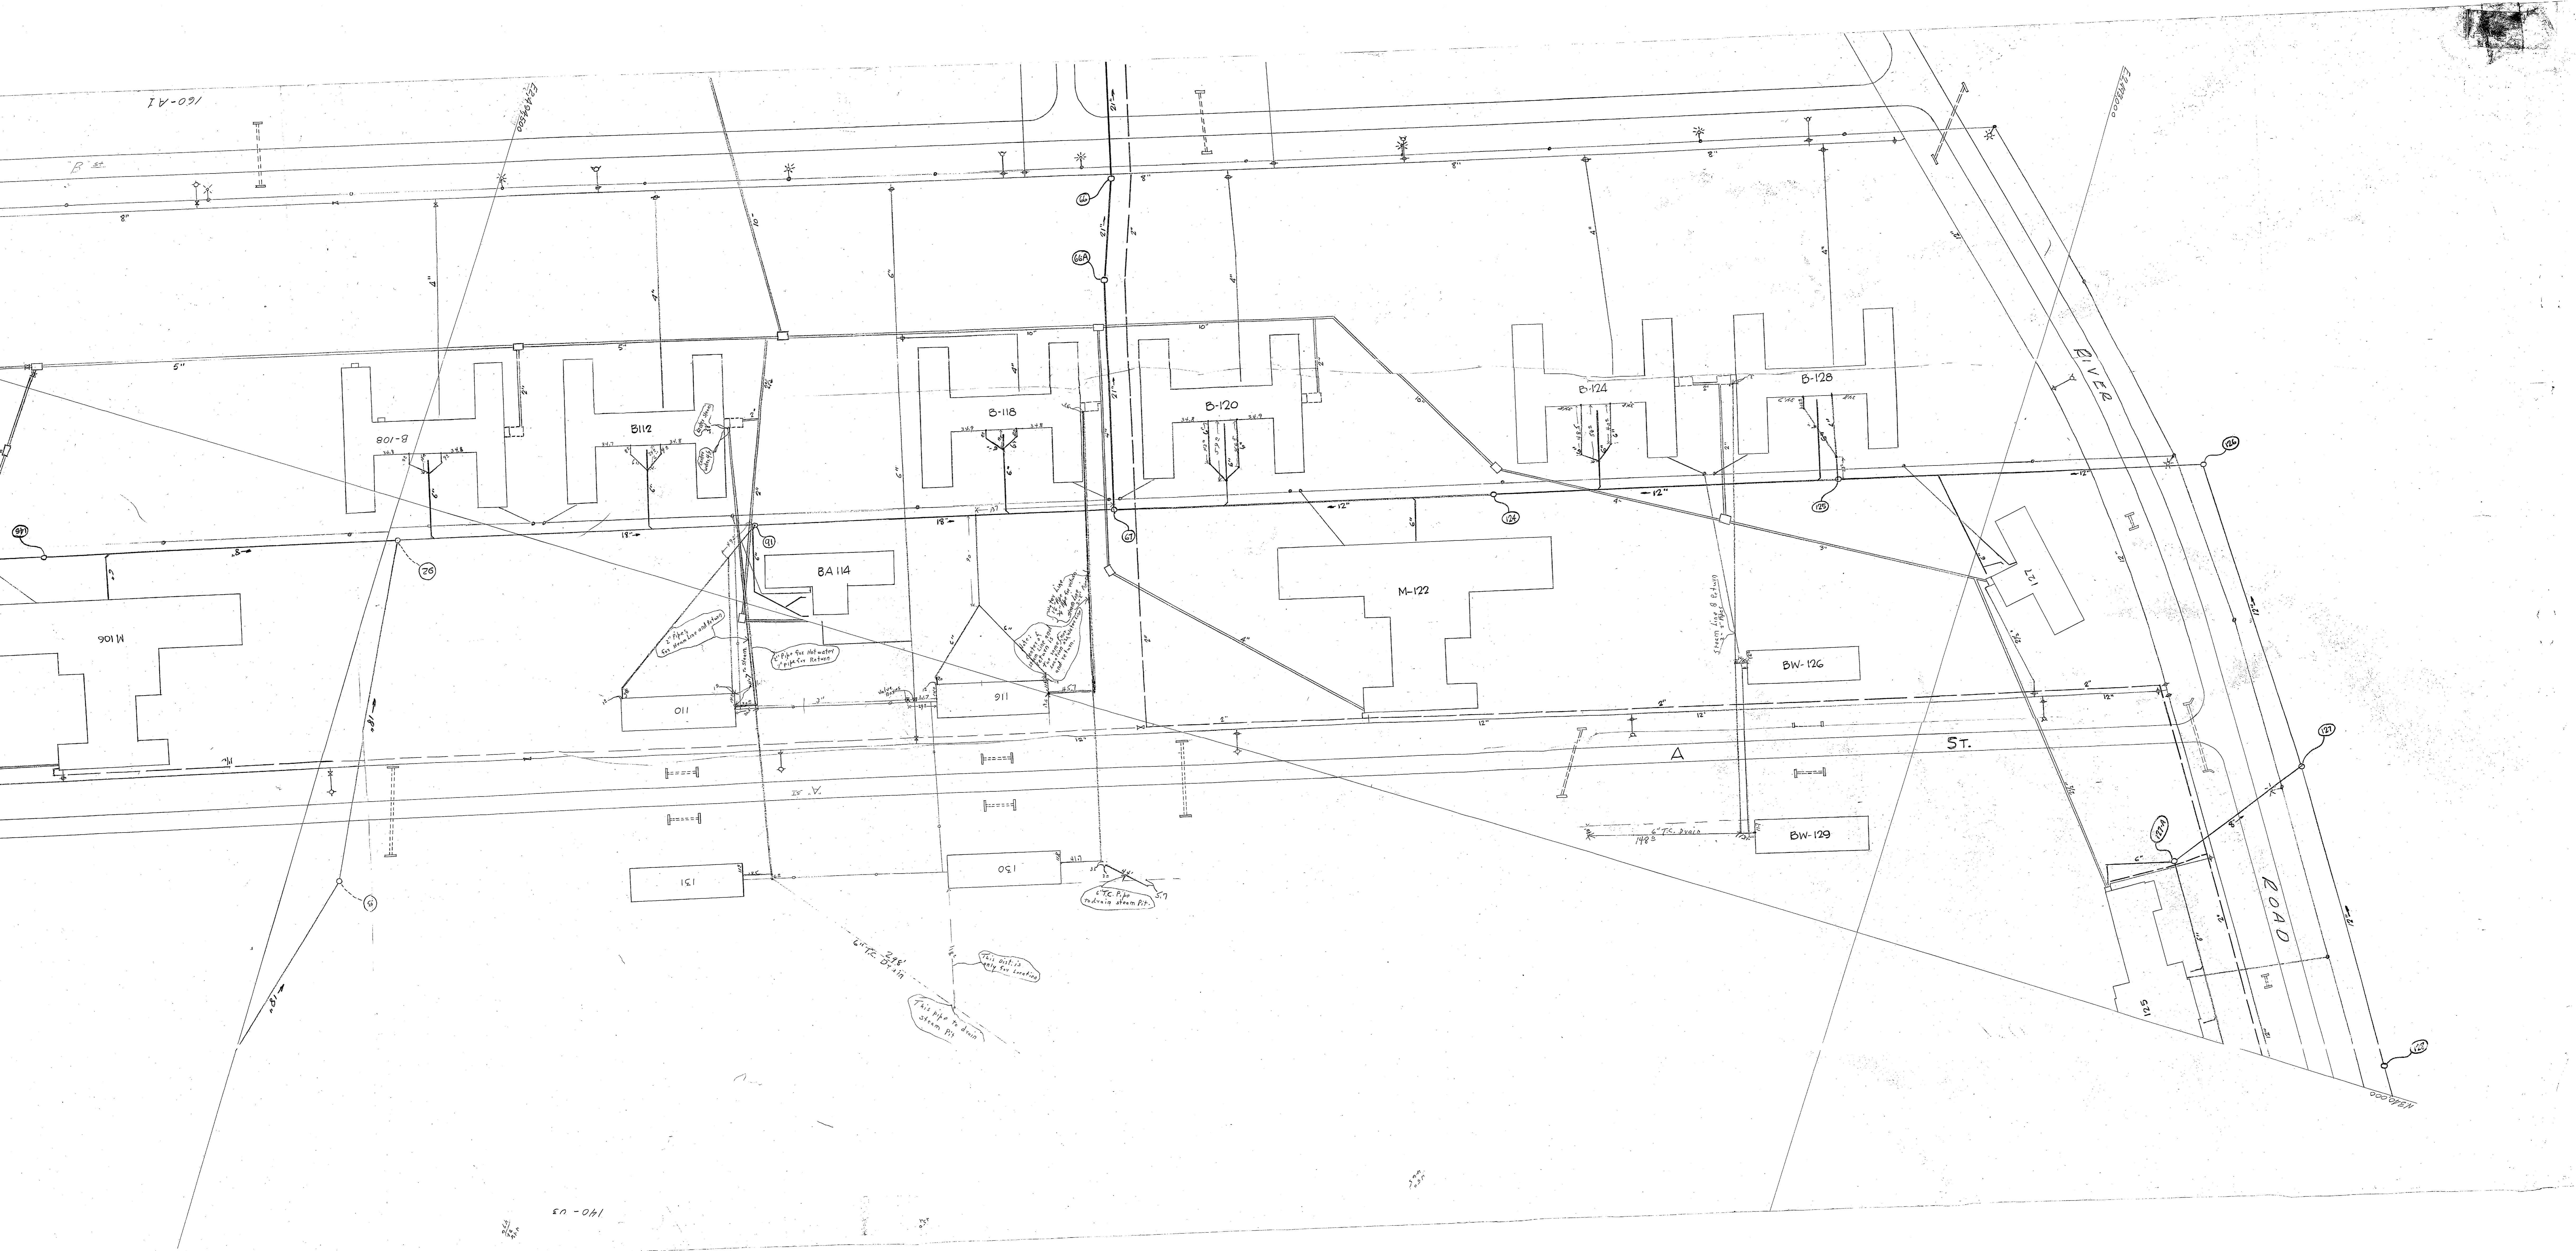

160-A1

140-03

RIVER


ST.


ROAD

This pipe is down stem pit

This pipe is up for location


This pipe for hot water (1/2 inch dia)

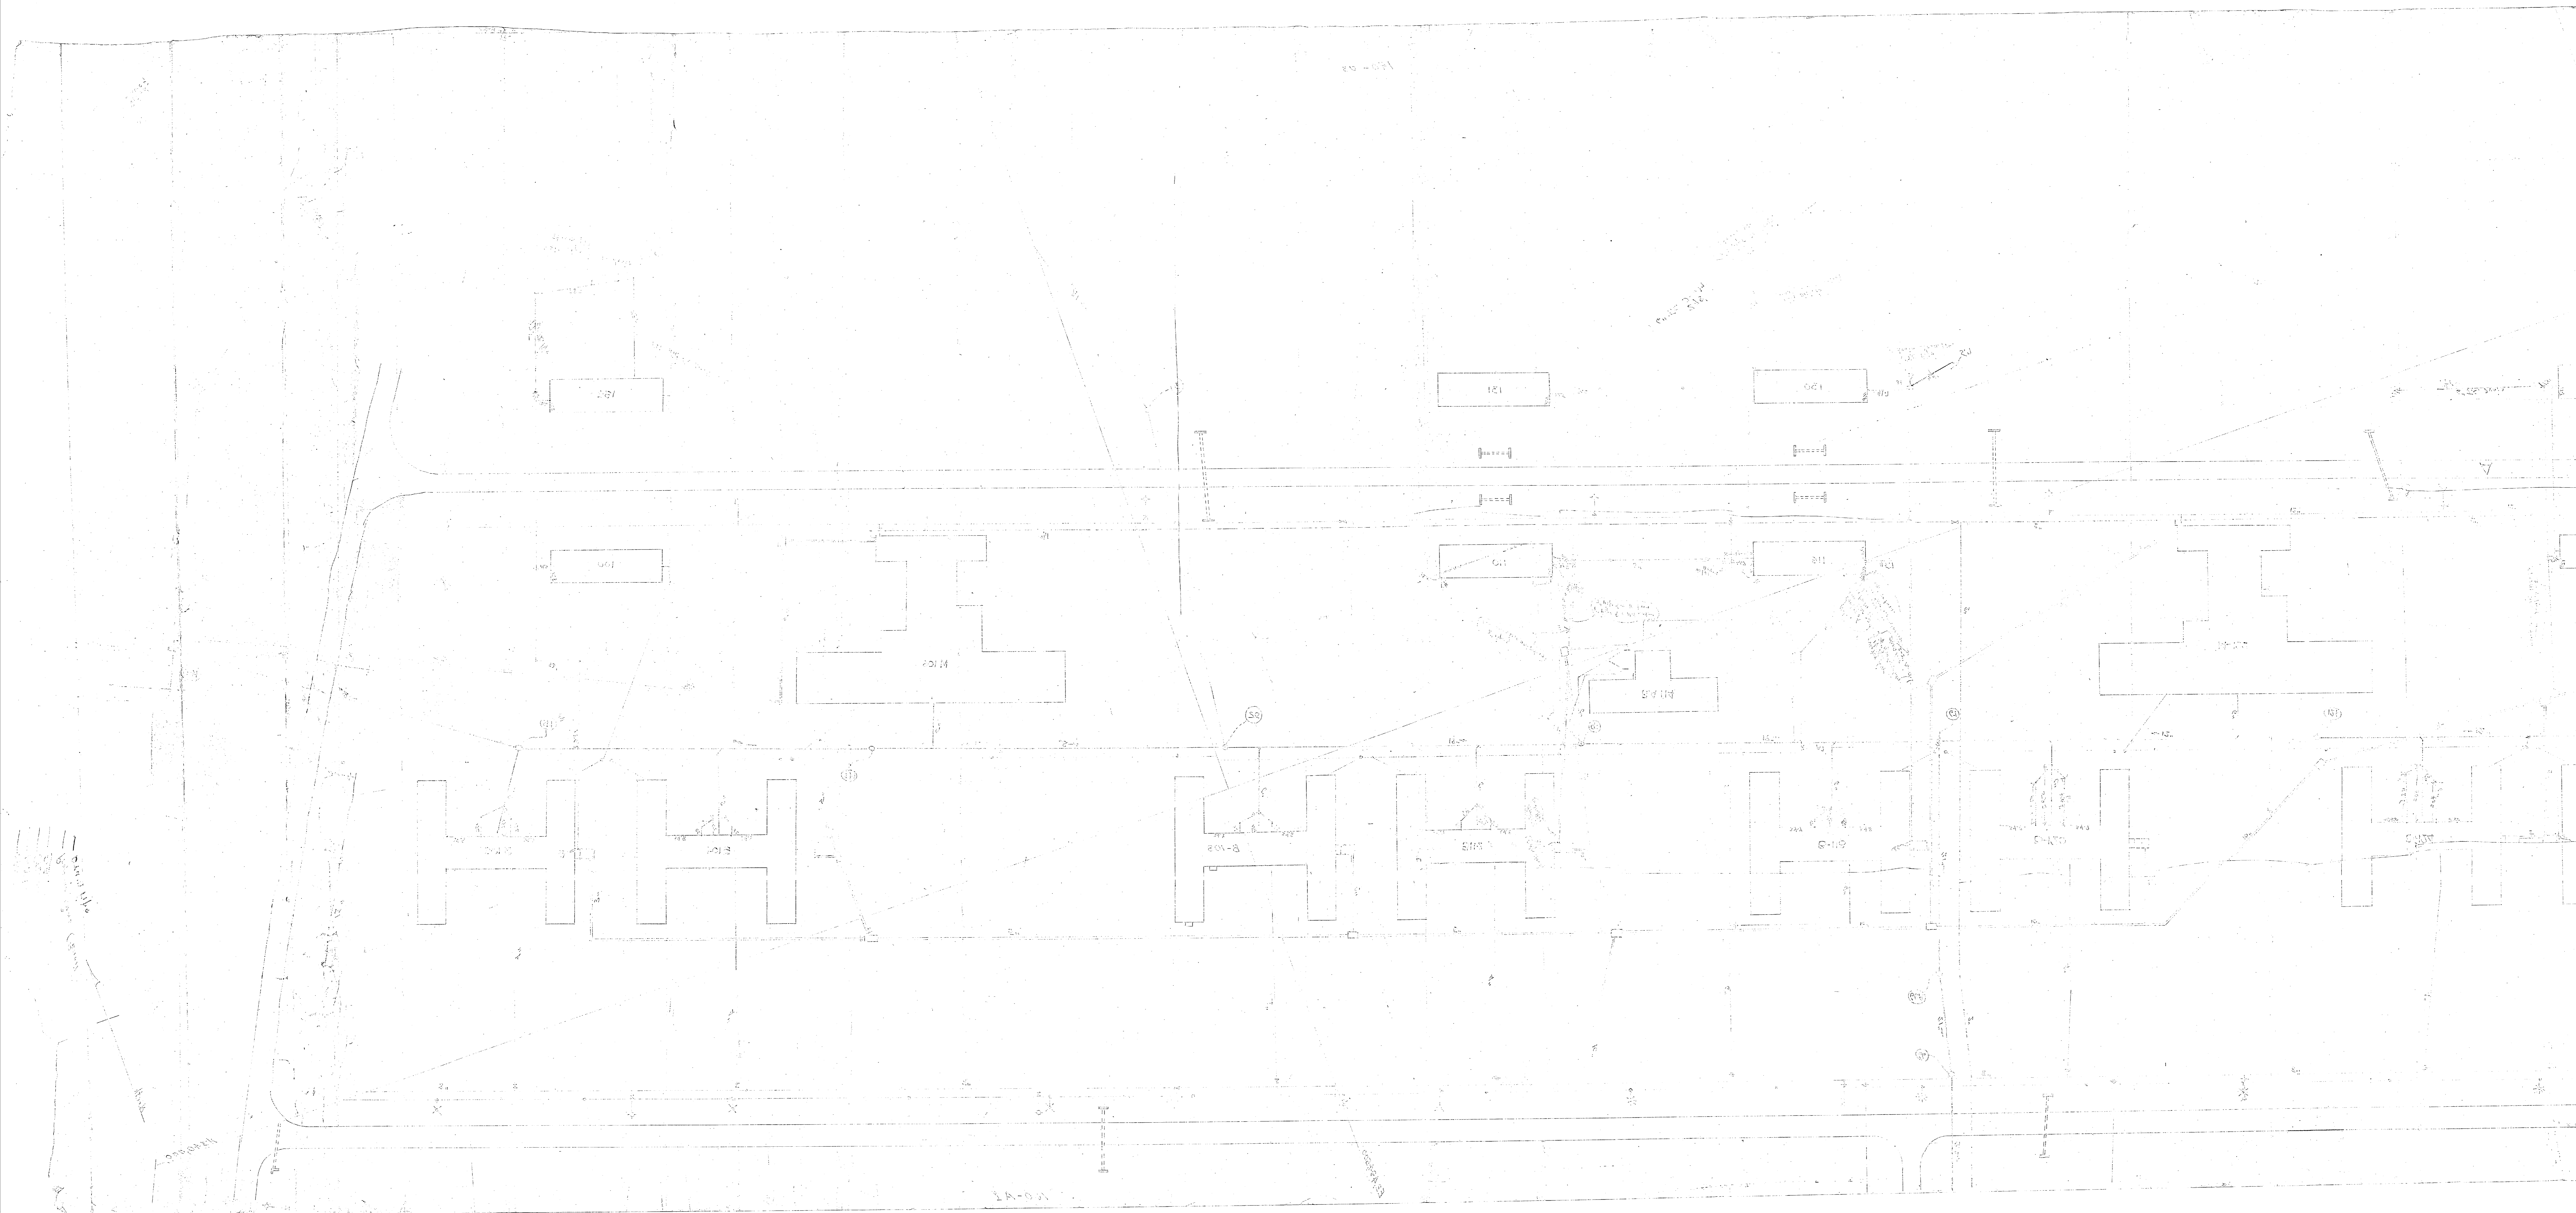







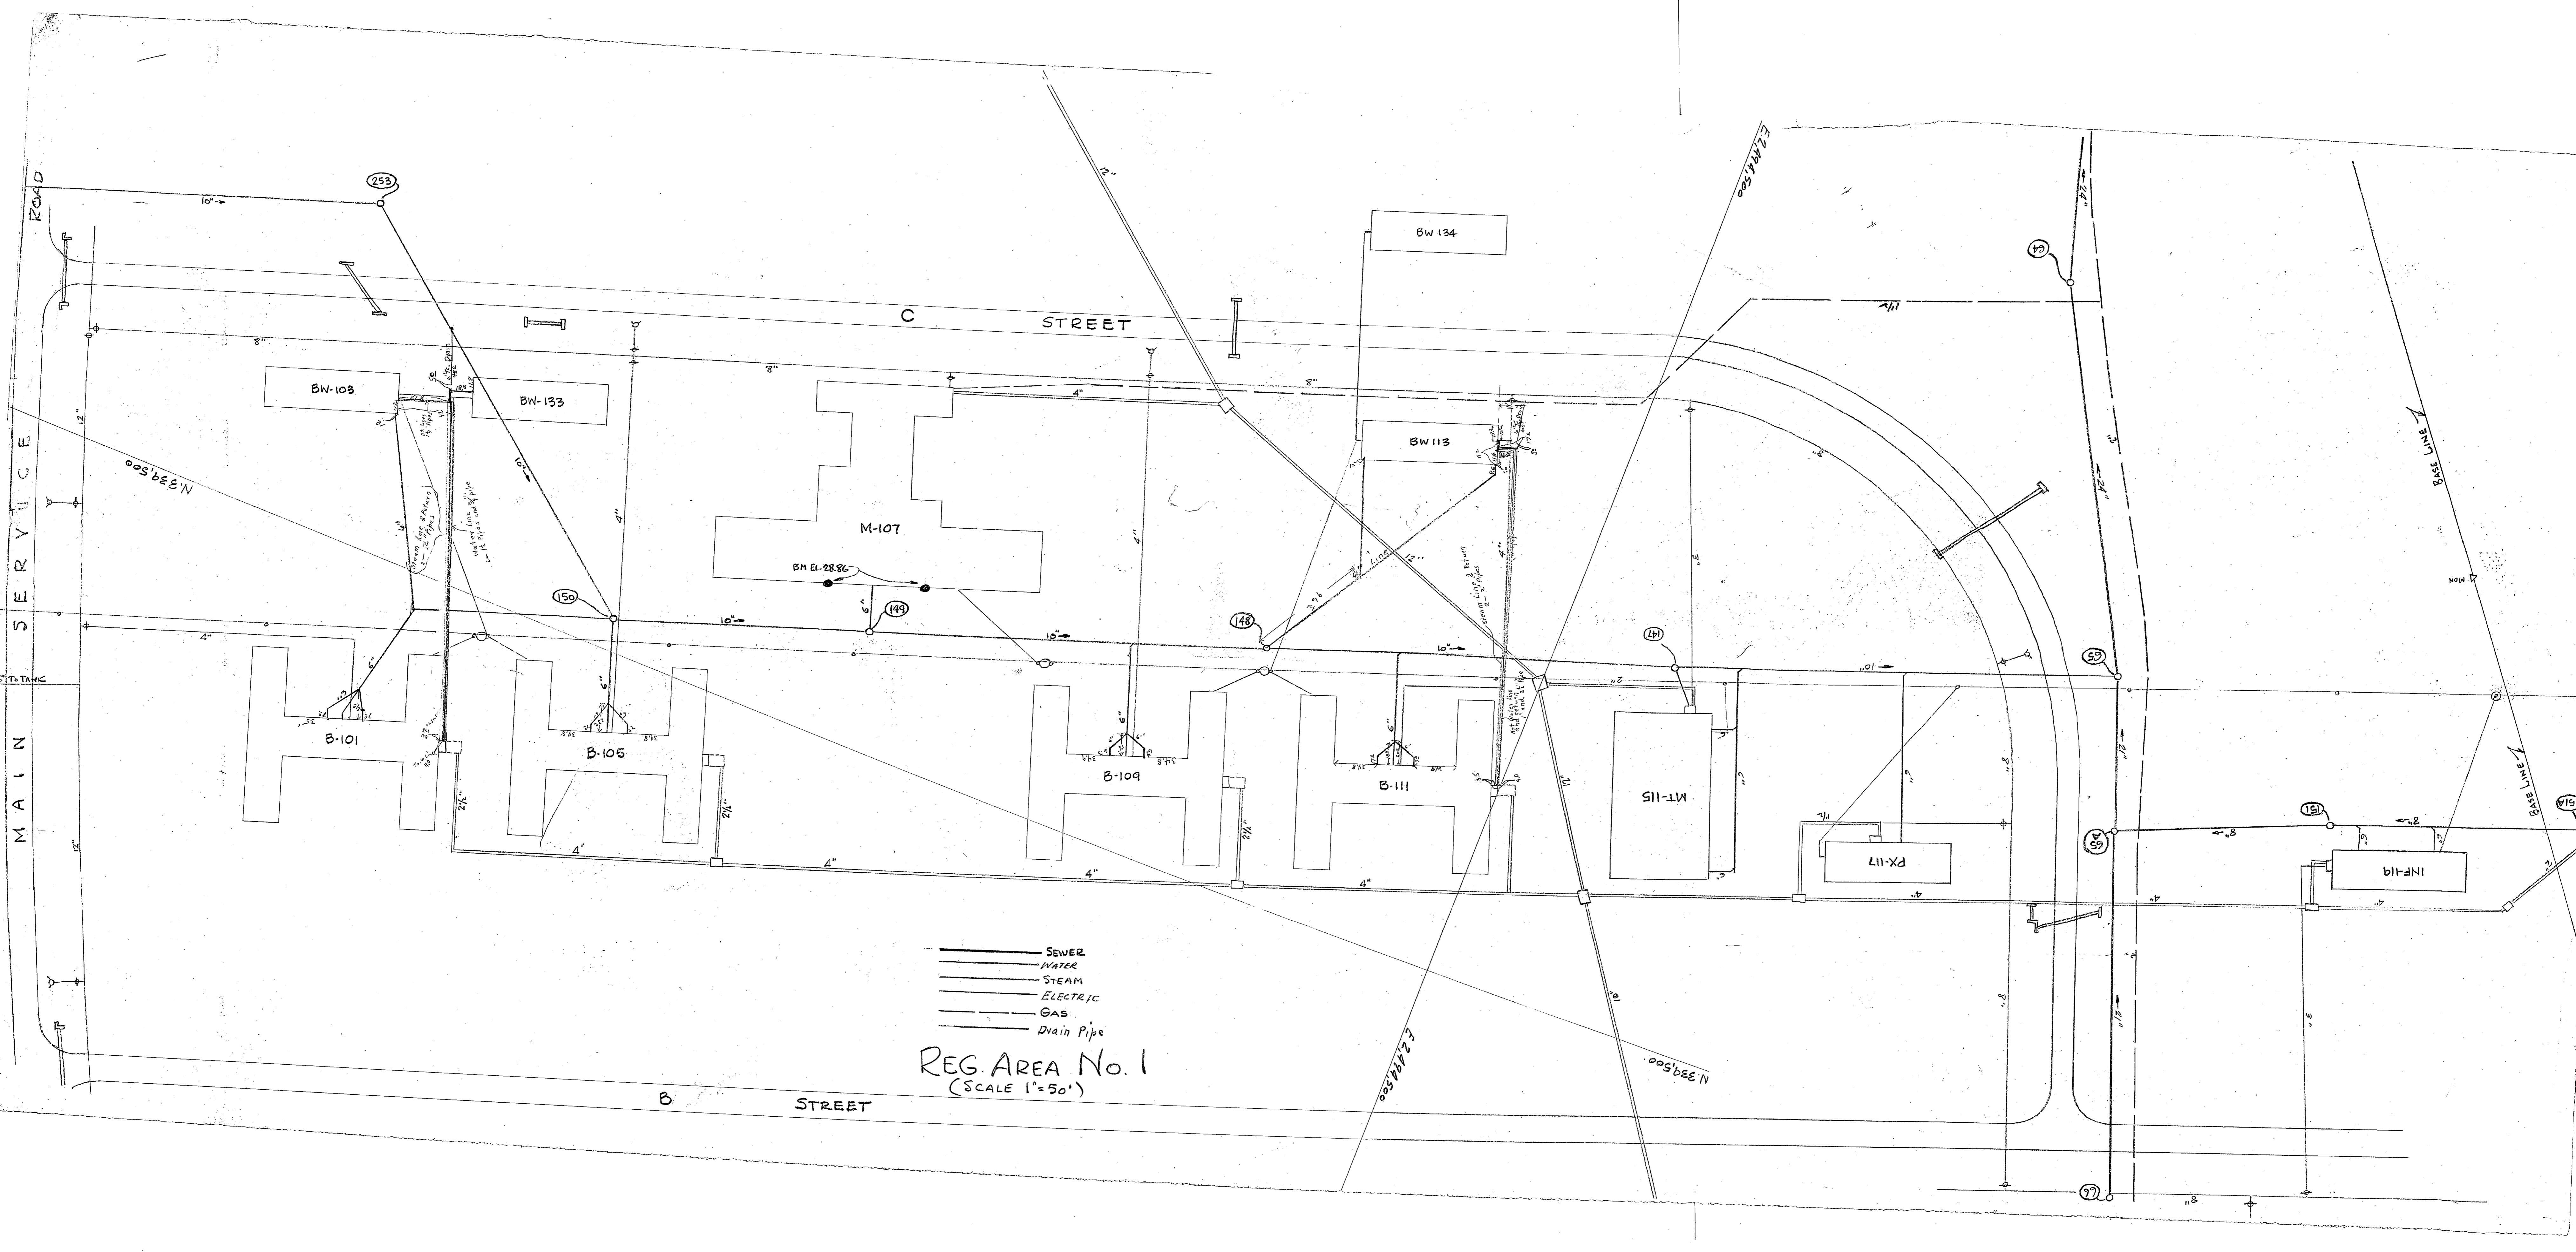


- SEWER
- WATER
- STEAM
- ELECTRIC
- GAS
- Drain Pipe

REG AREA No. 1
 (SCALE 1"=50')

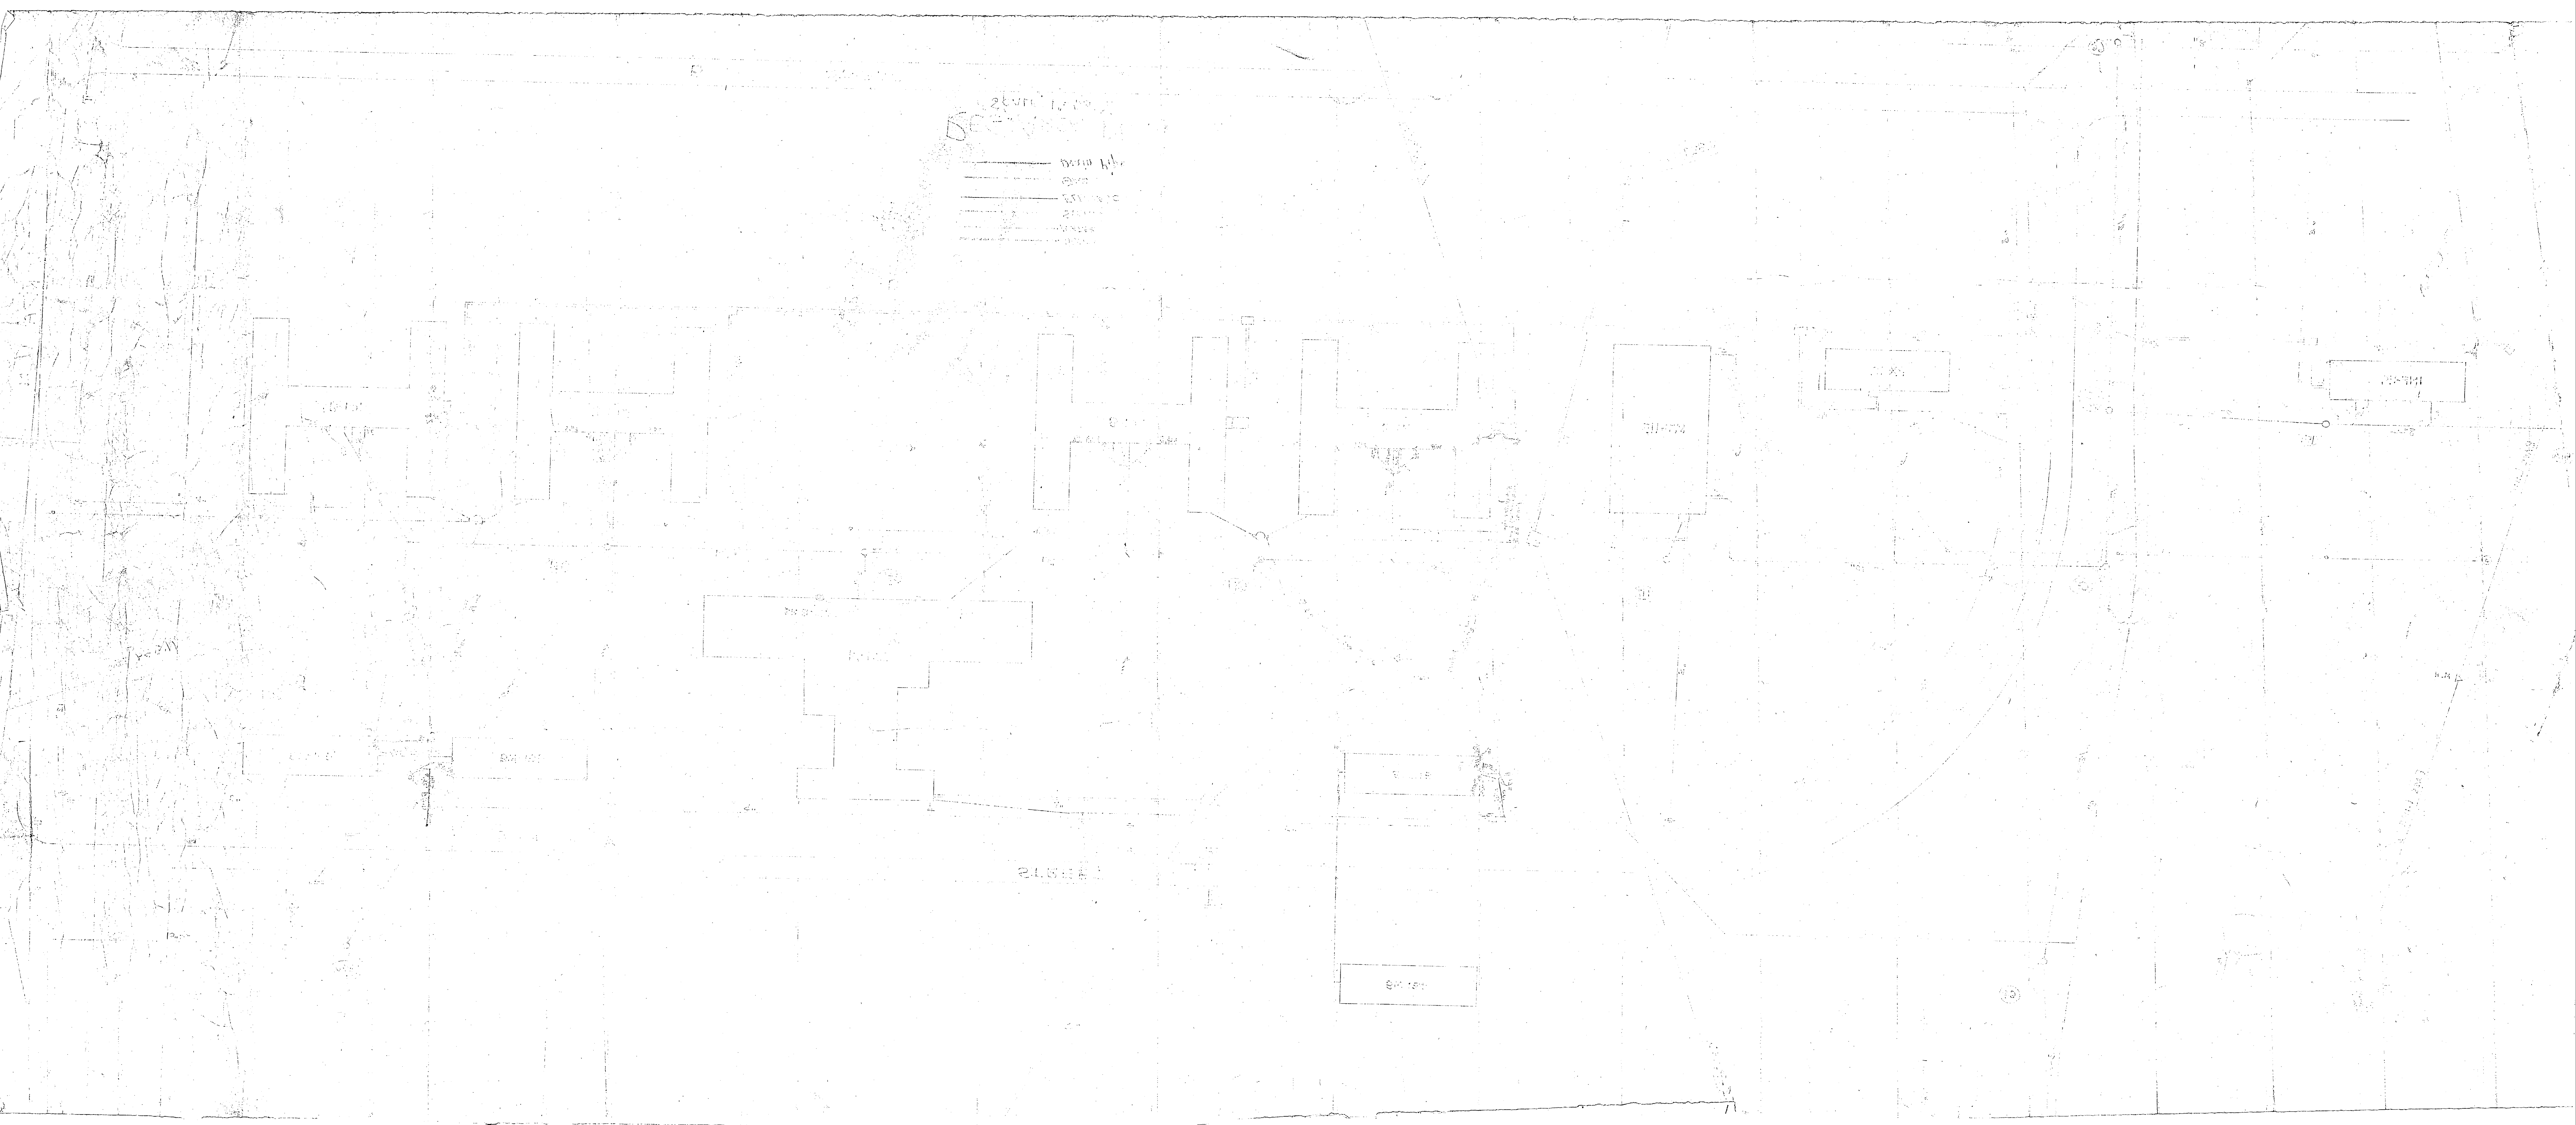

2000 1/2 1/2
500
1000
1500
2000

 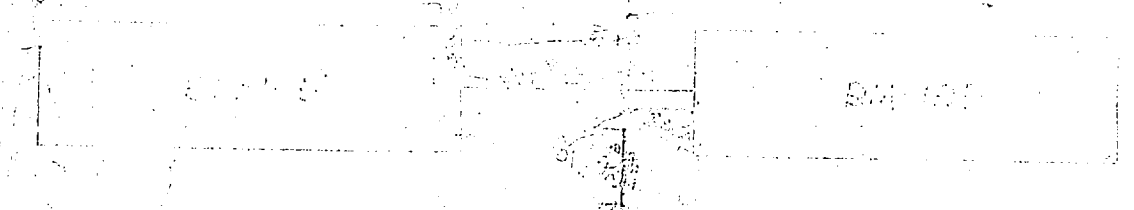     

1000

