

AVAILABLE

SUBJECT

FIELD PARTY

WARRANT

FILE NO.

STRATMORE HOLDING

AGENT WITH U.S.A.



VALUABLE















































 GREINER CO.
 JACKSONVILLE,
 N. C.

SUBJECT Profile of Water Line to
Wells # 8, # 7, etc.

FIELD PARTY

 IN CHARGE

 INSTRUMENT

 NOTES

 TAPE READ

 TAPE OR ROD

 TAPE OR ROD

 INSTRUMENT NO.

 TAPE NO.

WEATHER

CLEAR _____ SNOW _____
 CLOUDY _____ HOT _____
 WINDY _____ MODERATE _____
 RAIN _____ COLD _____
 FAIR _____ FOG _____
 FIGURED BY JFW
 NOTES CHECKED BY _____
 PLOTTED BY _____

FILE No. _____

FLDR. No. _____

SHEET # 2 of 8

DATE 2/22 1943

STATION	DIST.	ANGLE		H. I.	VER. ANG. DIFF.	ELEVATION
		o	"			
B.M. Monument #		3.79	32.46			28.67
0+00	Intersecting of Main at Post Land	9.27				23.19
2+56.5	41° Bend Left	9.90				22.56
5+00		7.95				24.51
T.P.		3.79				28.67
		4.64	33.31			
7+00		9.10				24.21
9+00		9.47				23.84
11+00		8.23				25.08
13+00		7.93				25.38
T.P.		3.61				29.70
		4.44	34.14			
15+00		9.63				24.51
17+00		8.97				25.17
19+00		9.20				24.94
T.P.		4.74				29.40
		4.99	34.39			

FILE NO

SEARCHED
INDEXED
SERIALIZED
FILED

FIELD PARTY

VALUABLE



RECEIVED
FAC CONTENTS

VALUABLE

SUBJECT Water Line Profile
From Well #8 to Well #7

RETURN TO
 CARR & J. E.
 GREINER CO.
 JACKSONVILLE,
 N. C.

FIELD PARTY

IN CHARGE _____
 INSTRUMENT _____
 NOTES _____
 TAPE READ _____
 TAPE OR ROD _____
 TAPE OR ROD _____
 INSTRUMENT NO. _____
 TAPE NO. _____

WEATHER

CLEAR _____ SNOW _____
 CLOUDY _____ HOT _____
 WINDY _____ MODERATE _____
 RAIN _____ COLD _____
 FAIR _____ FOG _____
 FIGURED BY _____
 NOTES CHECKED BY _____
 PLOTTED BY _____

FILE No. _____

FLDR. No. _____

SHEET # 3 of 8

DATE _____ 19____

STATION	DIST.	ANGLE ° ' "	+	H. I.	- VER. ANG. DIFF.	ELEVATION
				34.39		
21+00				9.21		2518
22+21.5	30°	Bend Left		9.16		2523
25+09.4	" X "	Tec		8.30		2609
Well #8				4.11		3028
B.M. Monument #				4.50		29.89
	4.50	34.36 ^s				(29.866
T.P.				4.07		30.29 ^s
	2.73	33.92 ^s				
27+73.00				10.27		2275
30+21				14.68		1834
T.P.				6.24		26.78 ^s
	8.36	35.14 ^s				
33+75				12.54		2260
T.P.				10.07		25.07 ^s
	2.58	27.63 ^s				
37+74				12.20		1545
40+00				8.90		1875
T.P.				1.72		25.93 ^s
	7.95	33.88 ^s				

FILE NO.

WEATHER

WIND

WIND

28.67
3.76
32.43
9.24
23.19

6.96
2.35
9.24

6.96
2.35
9.24

STRAITMONT'S BOND
PASSEMENT

✓

VALUABLE

RETURN TO
CARR & J. E.
GREINER CO.
JACKSONVILLE,
N. C.

SUBJECT Water Line Profile
From Well # 8 to Well # 7

FIELD PARTY

IN CHARGE _____
INSTRUMENT _____
NOTES _____
TAPE READ _____
TAPE OR ROD _____
TAPE OR ROD _____
INSTRUMENT NO. _____
TAPE NO. _____

WEATHER

CLEAR _____ SNOW _____
CLOUDY _____ HOT _____
WINDY _____ MODERATE _____
RAIN _____ COLD _____
FAIR _____ FOG _____
FIGURED BY _____
NOTES CHECKED BY _____
PLOTTED BY _____



FILE No. _____

FLDR. No. _____

SHEET # 4 of 8

DATE _____ 19____

STATION	DIST.	ANGLE		H. I.	ELEVATION		NOTES
		°	"		VER.	ANG. DIFF.	
				33.88 ^s			
42+00				12.66	21	22	
44+00				10.38	23	50	11' 5" 3rd Pole from Angle Pole
46+00				11.67	22	21	
T.P.				1.94	31	94 ^s	
				3.84	35	75 ^s	
48+17.4		26° Bend Right		9.09	26	69	
50+00				9.25	26	53	
51+72.4		"X" Tee		10.80	24	98	
51+82.8		Valve					
Well # 7				6.97	29	31	Floor Elev.
54+00				12.17	27	361	
T.P.				5.27	30	51 ^s	
				4.33	34	84 ^s	
56+00				9.85	24	99	55+95 50' of Exposed Pipe 56+45 in Drainage Ditch
59+00				10.42	24	42	
60+37.8		15° Bend Left		9.71	25	13	

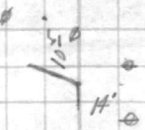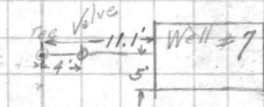

29.866
Monument #

6.90

2.20

9.16

34.39

4.50

29.89

R.M.

29+48

4.07

22+94

23+94

24+94

STEVATIMOR E BOND

PAGI COLTEM

VALUABLE
 RETURN TO
 CARR & J. E.
 GREINER CO.
 JACKSONVILLE,
 N. C.

SUBJECT

*Water Line Profile
 from Well # 7 to Well # 5*

FIELD PARTY

 _____ IN CHARGE
 _____ INSTRUMENT
 _____ NOTES
 _____ TAPE READ
 _____ TAPE OR ROD
 _____ TAPE OR ROD
 _____ INSTRUMENT NO.
 _____ TAPE NO.

WEATHER

 CLEAR _____
 CLOUDY _____
 WINDY _____
 RAIN _____
 FAIR _____
 SNOW _____
 HOT _____
 MODERATE _____
 COLD _____
 FOG _____
 FIGURED BY: _____
 NOTES CHECKED BY: _____
 PLOTTED BY: _____

FILE No. _____

FLDR. No. _____

SHEET


#5 of 8

DATE

19

STATION	DIST.	ANGLE		+	H. I.	-		ELEVATION
		o	r			"	VER: ANG.	

T.P.					34.845			
							9.52	25.825
	11.68				36.955			
63+00							8.69	28.26
65+00							9.09	27.86
T.P.							2.35	34.605
	2.39				36.995			
67+00							8.82	28.17
69+00							9.19	27.80
71+00							12.25	24.74
T.P.							3.06	33.935
	1.10				35.035			
73+00							8.00	27.03
75+00							8.91	26.12
76+75.5		" x "						
76+86.5		Valve					9.55	25.48
Well # 5							4.18	25.04
77+03.7		102° Bend Right.					9.99	24.04
T.P.							5.24	29.795
	4.94				34.735			

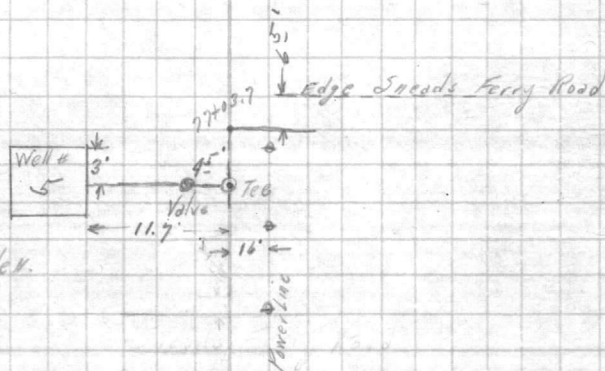

VALUABLE

SUBJECT

FILE NO.













VALUABLE

RETURN TO
CARR & J. E.
GREINER CO.
JACKSONVILLE,
N. C.

SUBJECT Water Line Profile
Paralleling Sneeds Ferry Road

FIELD PARTY

IN CHARGE

INSTRUMENT

NOTES

TAPE READ

TAPE OR ROD

TAPE OR ROD

INSTRUMENT NO.

TAPE NO.

WEATHER

CLEAR _____
CLOUDY _____
WINDY _____
RAIN _____
FAIR _____
SNOW _____
HOT _____
MODERATE _____
COLD _____
FOG _____
FIGURED BY _____
NOTES CHECKED BY _____
PLOTTED BY _____

FILE NO. _____
FLDR. No. _____
SHEET #6 of 8
DATE _____ 19__

STATION	DIST.	ANGLE ° ' "	+ H. I.	- VER. ANG. DIFF.	ELEVATION	
			34.73 ^s			
80+00				10.27	23.46	Edge of Road 7.2'
T.B.M.				3.33	31.40 ^s	
		1.98 ^s	33.39			
83+00				10.96	21.43	8.2'
86+00			Pipe	14.45	17.54	?
T.P.				5.28	28.11	
		4.37	32.48			Note: Could not locate water line at this sta. 86+00. Bottom of road culvert El. 17.54
89+00				10.30	22.18	8.5'
92+00				9.47	23.01	8.5'
T.P.				5.21	27.27	
		5.75	33.02			
95+00				11.68	21.34	7.5'
98+00				9.83	23.19	8'
T.P.				3.14	29.88	
		6.46	36.34			
101+54.2	"X" Tee			9.14	27.20	
Well #6				3.96	32.38	Floor Elev.

AVAILABLE

SUBJECT
























STRAIT MOIRE II 0110

HAS BEEN LEFT U.S.

2.15
6.96
9.14

2.87
6.96
9.83

4.72
6.96
11.68

3.34
6.96
10.30

2.51
6.96
9.47

MOORE BOND

VALUABLE

RETURN TO
CARR & J. E.
GREINER CO.
JACKSONVILLE,
N. C.

SUBJECT Water Line Profile
Paralleling Sneads Ferry Road

FIELD PARTY

IN CHARGE

INSTRUMENT

NOTES

TAPE READ

TAPE OR ROD

TAPE OR ROD

INSTRUMENT NO.

TAPE NO.

WEATHER

CLEAR
CLOUDY
WINDY
RAIN
FAIR

SNOW
HOT
MODERATE
COLD
FOG

FILE No. _____

FLDR. No. _____

SHEET # 8 of 8

FIGURED BY: _____
NOTES CHECKED BY: _____
PLOTTED BY: _____

DATE _____ 19 _____

STATION	DIST.	ANGLE		+	H. I.	- VER. ANG. DIFF.		ELEVATION	NOTES
		°	'			"			
T.B.M.					23.92				
					7.19	30.55		23.36	Nail on Top of 12" Pine stump 40' Left of E Road at Sta. 126+0 ^{Water}
125+40							0.56	23.36	
127+40							16.73	13.78	Edge Road 11'
129+86.3							12.03	18.52	13.2'
Well #9	90° Bend						7.20	23.35	9.5' Valve
T.P.							0.59	29.96	Floor Elev. 20.6' Well #9
							11.46	19.09	
					3.09	22.18			
							1.02	21.16	
					11.27	32.43			
							0.51	31.92	
					6.10	38.02			
							3.74	34.28	
					2.25	36.56			
B.M. #155							1.37	35.19	(35.192)

6.71
6.96
13.67
6.96
11.92

1.37
6.96
8.33

3.16
6.96
10.12

Plotted see -
Profile "G-G"

JFW 2/25/43

278

VALUABLE

SUBJECT Profile of Water Line
43' Left of 40' D St.

RETURN TO
 CARR & J. E.
 GREINER CO.
 JACKSONVILLE,
 N. C.

FIELD PARTY

IN CHARGE _____
 INSTRUMENT _____
 NOTES _____
 TAPE READ _____
 TAPE OR ROD _____
 TAPE OR ROD _____
 INSTRUMENT NO. _____
 TAPE NO. _____

WEATHER

CLEAR _____
 CLOUDY
 WINDY _____
 RAIN _____
 FAIR _____
 SNOW _____
 HOT _____
 MODERATE
 COLD _____
 FOG _____
 FIGURED BY _____
 NOTES CHECKED BY gpt
 PLOTTED BY _____

FILE No. 160
 FLDR. No. _____
 SHEET 1 of 6
 DATE 12/28 1941

STATION	DIST.	ANGLE ° ' "	+	H. I.	— VER: ANG. DIF.	ELEVATION
B.M. 572						8.085
			8.59	16.675		
					0.78	15.895
T. P.			4.78	20.675		
28+65					8.86	11.81
29+00					8.80	11.87
+40					8.44	12.23
+50					8.44	12.23
30+00					8.67	12.00
+18					8.61	12.06
+50					8.42	12.25
+80					8.90	11.77
+80					9.01	11.66
+80						
+93					9.14	11.53
31+00					9.22	11.45
+50					9.72	10.95

Notes started
 at wrong place

6" x 8" Tee 7th Street

6" x 4" Tee ✓

6" x 4" Tee ✓

6" x 6" Tee ✓

6" Valve 4' R.F.

Fire Hyd. (Not Placed)

6" x 4" Tee ✓

"D" ST. Profile
7th to 11th

Profile #50
Plotted

VALUABLE
 RETURN TO
 CARR & J. E.
 GREINER CO.
 JACKSONVILLE,
 N. C.

SUBJECT

 Profile of Water line
 45' left of D Street

FIELD PARTY

 IN CHARGE _____
 INSTRUMENT _____
 NOTES _____
 TAPE READ _____
 TAPE OR ROD _____
 TAPE OR ROD _____
 INSTRUMENT NO. _____
 TAPE NO. _____

WEATHER

 CLEAR SNOW _____
 CLOUDY HOT _____
 WINDY _____ MODERATE
 RAIN _____ COLD _____
 FAIR _____ FOG _____
 FIGURED BY _____
 NOTES CHECKED BY _____
 PLOTTED BY _____

FILE No. _____

FLDR. No. _____

SHEET

2 of

DATE 12-28 1944

STATION	DIST.	ANGLE		+	H. I.	VER. ANG. DIFF.	ELEVATION
		o	"				
					20.675		
31+68						10.11	10.56
32+00						10.75	9.92
+50						13.33	7.34
+84						13.80	6.97
+96						14.00	6.67
33+00						14.00	6.67
+50						14.55	6.12
+90						12.41	8.26
34+00						11.93	8.74
+02						11.93	8.74
+02							
+02							
+18						11.33	9.34
+22						11.06	9.61
+26						11.06	9.61

6"x4" Tee ✓

6"x4" Tee ✓

Ditch

6"x4" Tee ✓

6"x6" Tee ✓

6" Valve (not placed)

Hyd. ✓

6" Valve ✓

6"x8" Cross ✓

6" Valve



VALUABLE

RETURN TO
CARR & J. E.
GREINER CO.
JACKSONVILLE,
N. C.

SUBJECT Profile of water line
43' left of "D" Street

FIELD PARTY

IN CHARGE _____
INSTRUMENT _____
NOTES _____
TAPE READ _____
TAPE OR ROD _____
TAPE OR ROD _____
INSTRUMENT NO. _____
TAPE NO. _____

WEATHER

CLEAR ✓ SNOW
CLOUDY HOT
WINDY MODERATE ✓
RAIN COLD
FAIR FOG

FIGURED BY _____
NOTES CHECKED BY _____
PLOTTED BY _____

FILE No. _____


FLDR. No. _____

SHEET 3 of

DATE 12-28 1941

X

STATION	DIST.	ANGLE ° ' "	+	H. I.	VER: ANG. DIFF.	ELEVATION	
				20.675			
34+90					9.08	11.59	
35+00					8.81	11.86	
+40					8.70	11.97	6" x 4" Tee ✓
+50					8.67	12.00	
36+00					8.19	12.48	
+25					8.05	12.62	6" x 4" Tee ✓
+50					7.74	12.93	
37+00					7.39	13.28	
+11					7.37	13.30	6" x 4" Tee ✓
+50					7.45	13.22	6" x 6" Tee ✓
+50							6" Valve ← Not placed
+50							Fire Hyd. Lead
+97					7.41	13.26	6" x 4" Tee & Plug
38+00					7.40	13.27	
+50					7.06	13.61	

 

VALUABLE

RETURN TO

CARR & J. E.
GREINER CO.
JACKSONVILLE,
N. C.

SUBJECT

Profile of water line
43' left E "D" Street

FIELD PARTY

0 Shea IN CHARGE
INSTRUMENT
NOTES
TAPE READ
TAPE OR ROD
TAPE OR ROD
INSTRUMENT NO.
TAPE NO.

WEATHER

CLEAR
CLOUDY
WINDY
RAIN
FAIR
SNOW
HOT
MODERATE
COLD
FOG
FIGURED BY
NOTES CHECKED BY
PLOTTED BY

FILE NO. _____

FLDR. NO. _____

SHEET

DATE 12-28 1941

407

STATION DIST. ANGLE + H. I. VER. ANG. ELEVATION

o , "

-
DIFF.

38+82

7.16 13.51

6" x 4" Tee ✓

T.B.M.

1.10 19.575

(19.55)

1.375 20.925

39+00

7.56 13.36

+50

7.22 13.70

+68

7.05 13.87

6" x 4" Tee ✓

+99

6.88 14.04

6" x 6" Cross

9th ST.

40+83

7.01 13.91

6" V 4B

+50

7.42 13.50

41+00

7.62 13.30

+06'

7.59 13.33

6" x 6" Tee

+06

-

F.H. not placed.

+50

8.27 12.65

42+00

8.77 12.15


+51

9.17 11.75

6" x 4" Tee

43+00

10.33 10.59

 

VALUABLESUBJECT Profile of Water Line
43' 21' E D StreetRETURN TO
CARR & J. E.
GREINER CO.
JACKSONVILLE,
N. C.

FIELD PARTY

ASBPA IN CHARGE
 _____ INSTRUMENT
 _____ NOTES
 _____ TAPE READ
 _____ TAPE OR ROD
 _____ TAPE OR ROD
 _____ INSTRUMENT NO.
 _____ TAPE NO.

WEATHER

CLEAR _____ SNOW _____
 CLOUDY _____ HOT _____
 WINDY MODERATE _____
 RAIN _____ COLD
 FAIR _____ FOG _____
 FIGURED BY _____
 NOTES CHECKED BY _____
 PLOTTED BY _____


FILE No. _____

FLDR. No. _____

SHEET 5 ofDATE Dec. 29, 1941

X

STATION	DIST.	ANGLE ° ' "	+	H. I.	—	ELEVATION	
				<u>20.925</u>	VER: ANG. DIFF.		
43+50					10.40	10.52	
44+00					10.88	10.84	
+50					9.51	11.41	
T.P.					9.39	11.535	
			6.60	18.135			
+60					6.68	11.45	6" X 6" Tee
45+00					6.94	11.19	
+63					9.02	9.11	6" X 6" Tee
+67					9.24	9.89	6" V.L.B.
46+00					9.82	8.31	
+50					10.37	9.76	
+95					8.02	10.11	6" X 4" Tee
47+00					7.80	10.33	
+50					4.69	13.44	
+81					4.80	13.33	6" X 4" Tee

 

VALUABLE
 RETURN TO
 CARR & J. E.
 GREINER CO.
 JACKSONVILLE,
 N. C.

 SUBJECT Profile of Water Line
43' Lt. & D Street

FIELD PARTY

O Shea IN CHARGE
 _____ INSTRUMENT
 _____ NOTES
 _____ TAPE READ
 _____ TAPE OR ROD
 _____ TAPE OR ROD
 INSTRUMENT NO. _____
 TAPE NO. _____

WEATHER

 CLEAR _____ SNOW _____
 CLOUDY _____ HOT _____
 WINDY _____ MODERATE _____
 RAIN _____ COLD _____
 FAIR _____ FOG _____
 FIGURED BY _____
 NOTES CHECKED BY _____
 PLOTTED BY _____

FILE No. _____

FLDR. No. _____


SHEET 6 ofDATE 12-30-1941

STATION	DIST.	ANGLE ° ' "	+	H. I. <u>18.135</u>	VER: ANG. DIFF.	ELEVATION	
48+00					4.97	13.16	
+58					5.00	13.13	
+66					5.30	12.83	6" x 4" Tee
49+00					5.68	12.45	
49+10					5.76	12.37	6" x 6" Tee 6" Valve + Box + F.H.
BM#579					6.235	11.90	(11.915)
BM#584			362	2009		16.47	
49+55					8.33	11.76	6" x 4" Tee
50+00					8.54	11.55	
+40					9.13	10.96	6" x 4" Tee
51+00					8.96	11.73	
+27					9.01	11.08	6" x 4" Tee
+52					9.26	10.83	6" V&B
+56					9.34	10.75	8" x 6" Cross
BM#584					362	16.47	(16.47)

11TH ST

"D' ST

7th to 11th

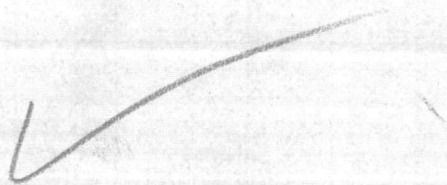

(107)

8/18/42



































VALUABLE

SUBJECT Water Line to Bldg.

RETURN TO
CARR & J. E.
GREINER Co.
JACKSONVILLE,
N. C.

FIELD PARTY

IN CHARGE
G. Summerlin
INSTRUMENT
NOTES
C. B. Farnell
TAPE READ
TAPE OR ROD
TAPE OR ROD
INSTRUMENT NO.
TAPE NO.

WEATHER

CLEAR
CLOUDY
WINDY
RAIN
FAIR
SNOW
HOT
MODERATE
COLD
FOG

FILE No. 160

FLDR. No. _____

SHEET _____

DATE 12/23 1942

FIGURED BY _____

NOTES CHECKED BY _____

PLOTTED BY _____

STATION	DIST.	ANGLE ° ' "	+	H. I.	— VER. ANG. DIFF.	ELEVATION
---------	-------	----------------	---	-------	-------------------------	-----------

Post Garage
B.M.

	<u>2.49</u>			<u>28.79</u>		<u>24.30</u>
					<u>4.90</u>	<u>23.89</u>



Plotted Reid Maps
JFW. (Ink)

Water Line for Div. Garage
is not in

221









VALUABLE

RETURN TO
CARR & J. E.
GREINER CO.
JACKSONVILLE,
N. C.

SUBJECT Location & Elev.
of Water Main & Water
Line opposite Well #1
Supply & Industrial Area

FIELD PARTY
C. Summerlin IN CHARGE

INSTRUMENT

NOTES

TAPE READ

TAPE OR ROD


TAPE OR ROD
INSTRUMENT NO. _____
TAPE NO. _____

WEATHER
CLEAR _____
CLOUDY _____
WINDY _____
RAIN _____
FAIR _____
SNOW _____
HOT _____
MODERATE _____
COLD _____
FOG _____
FIGURED BY _____
NOTES CHECKED BY _____
PLOTTED BY _____

FILE No. 160
FLDR. No. _____
SHEET _____
DATE 2/12/43

STATION	DIST.	ANGLE	H. I.	VER. ANG. DIFF.	ELEVATION
B.M.		2.96	28.38		25.42
Top of Water Line			9.70		18.48
Top of Water Main			11.05		17.33

3/9/43 Mr. Kramer:
Well no. 1 connected to
raw water line. 8" line plugged.
J.F.W.

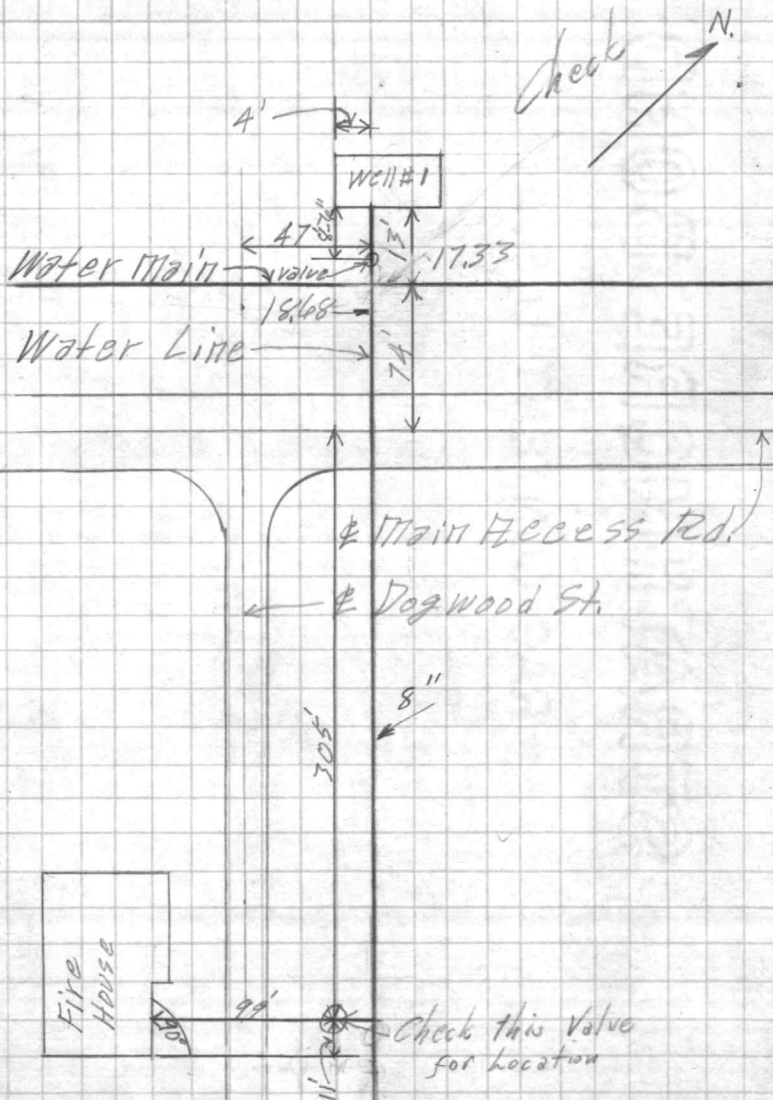

Check this Valve
for location










VALUABLE

RETURN TO
CARR & J. E.
GREINER CO.
JACKSONVILLE,
N. C.

SUBJECT Location of Air Valves
on Regimental Area Water Lines

FIELD PARTY
Moore IN CHARGE
INSTRUMENT _____
NOTES _____
TAPE READ _____
TAPE OR ROD _____
TAPE OR ROD _____
INSTRUMENT No. _____
TAPE No. _____

WEATHER
CLEAR _____ SNOW _____
CLOUDY _____ HOT _____
WINDY _____ MODERATE _____
RAIN _____ COLD _____
FAIR _____ FOG _____
FIGURED BY _____ SHEET 1
NOTES CHECKED BY _____
PLOTTED BY _____ DATE 5/10 19 _____


FILE No. 160

FLDR. No. _____

SHEET 1

DATE 5/10 19 _____

STATION	DIST.	ANGLE	H. I.	VER. ANG. DIFF.	ELEVATION
---------	-------	-------	-------	-----------------	-----------

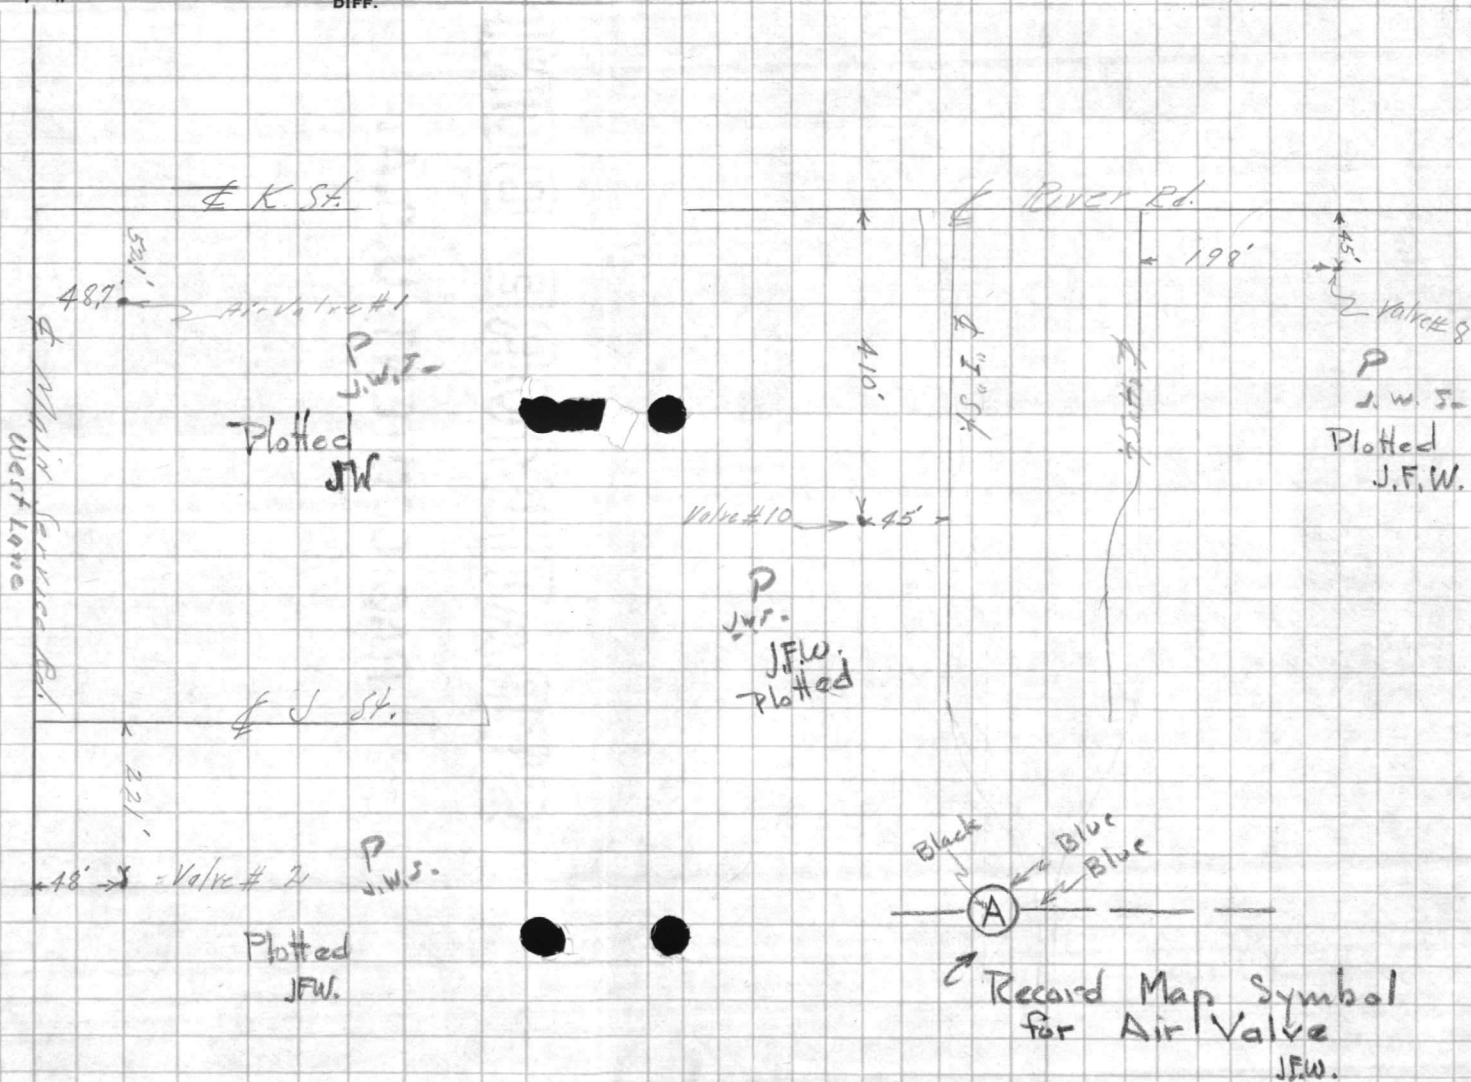

VALUABLE

RETURN TO
CARR & J. E.
GREINER CO.
JACKSONVILLE,
N. C.

SUBJECT Location air valves
Regimental Areas

FIELD PARTY

IN CHARGE

INSTRUMENT

NOTES

TAPE READ

TAPE OR ROD

TAPE OR ROD

INSTRUMENT NO.


TAPE NO.

WEATHER

CLEAR
CLOUDY
WINDY
RAIN
FAIR
SNOW
HOT
MODERATE
COLD
FOG
FIGURED BY _____
NOTES CHECKED BY _____
PLOTTED BY _____

FILE No. _____
FLDR. No. _____
SHEET 7
DATE 2-12-43 19

STATION	DIST.	ANGLE	+	H. I.	-	ELEVATION
		° ' "			VER: ANG. DIFF.	

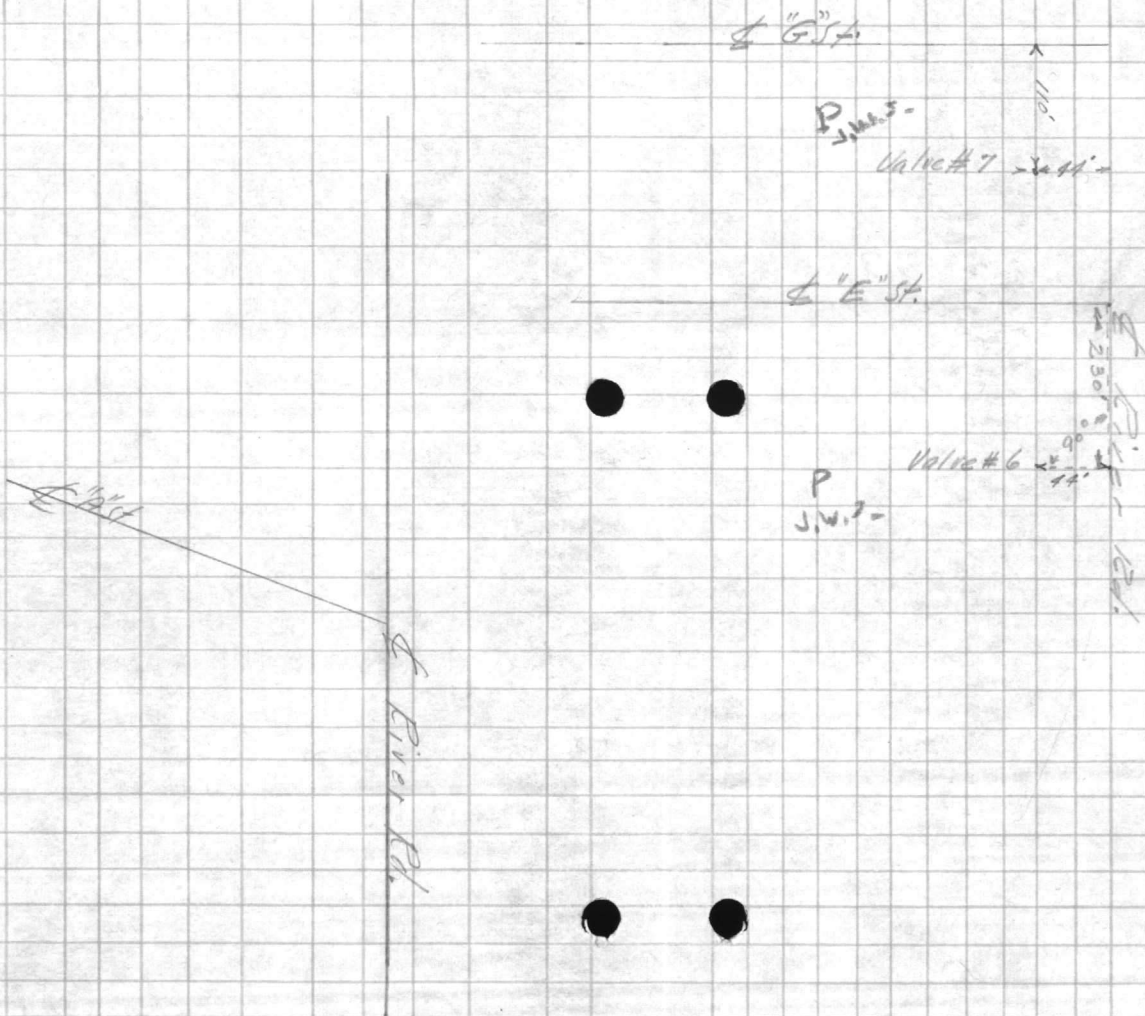







VALUABLE

SUBJECT _____

RETURN TO
CARR & J. E.
GREINER CO.
JACKSONVILLE,
N. C.

FIELD PARTY

IN CHARGE

INSTRUMENT

NOTES

TAPE READ

TAPE OR ROD

TAPE OR ROD

INSTRUMENT NO.

TAPE NO.

WEATHER

CLEAR
CLOUDY
WINDY
RAIN
FAIR

SNOW
HOT
MODERATE
COLD
FOG

FIGURED BY _____
NOTES CHECKED BY _____
PLOTTED BY _____


FILE No. _____

FLDR. No. _____

SHEET 3

DATE _____ 19 _____

STATION	DIST.	ANGLE	+	H. I.	—	ELEVATION
		0 1 "			VER: ANG. DIFF.	

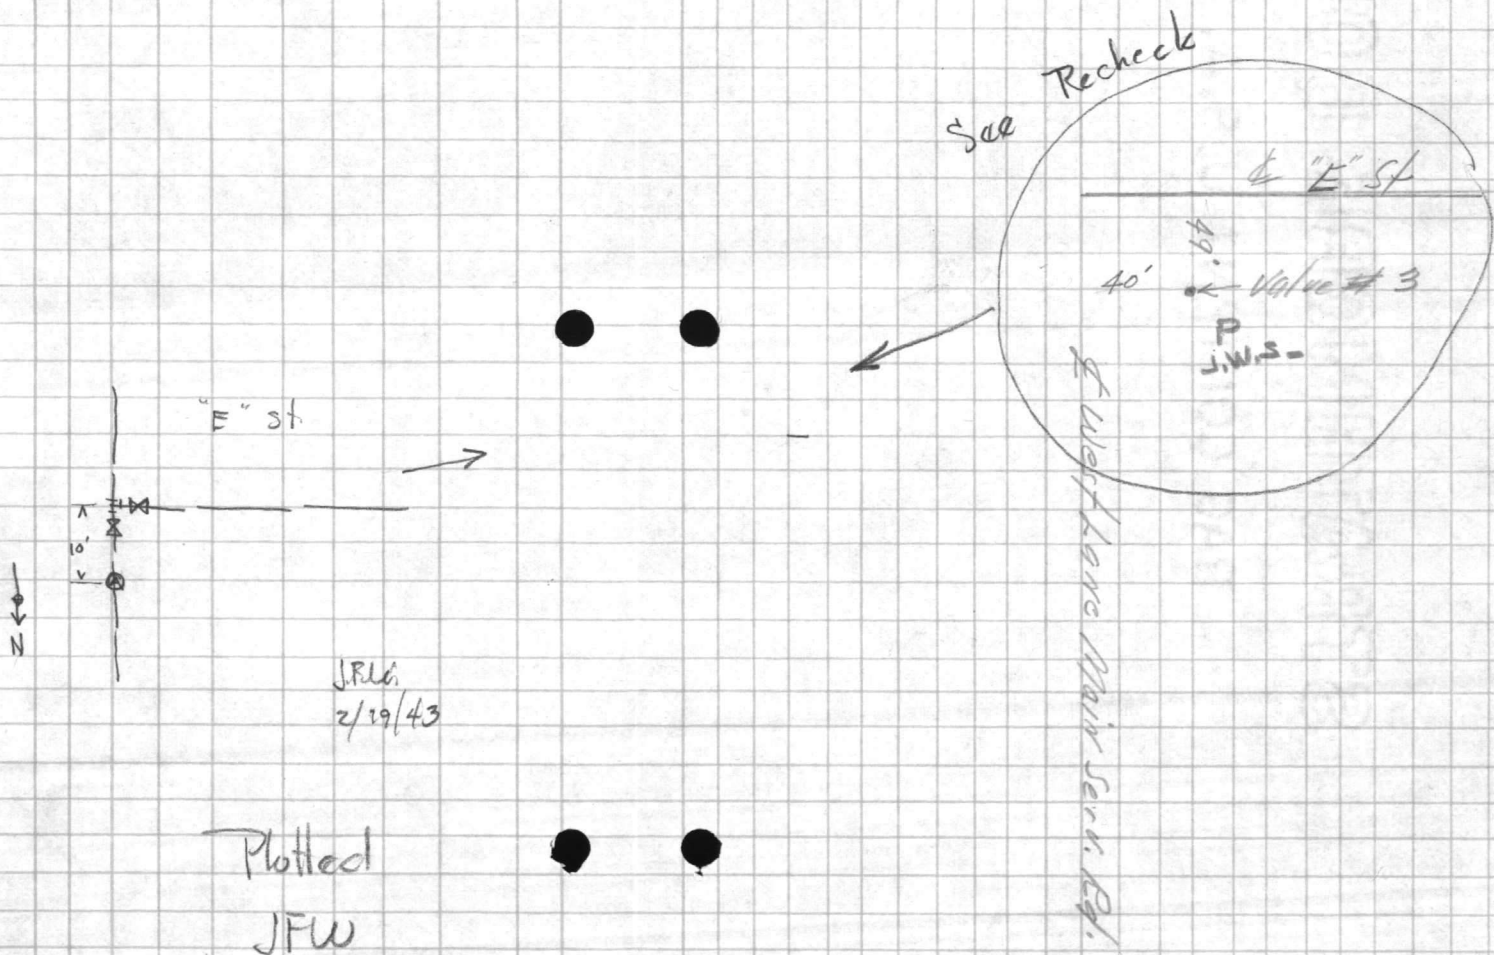







VALUABLE

SUBJECT _____

RETURN TO
CARR & J. E.
GREINER CO.
JACKSONVILLE,
N. C.

FIELD PARTY

IN CHARGE

INSTRUMENT

NOTES

TAPE READ

TAPE OR ROD

TAPE OR ROD

INSTRUMENT NO.

TAPE NO.

WEATHER

CLEAR _____
CLOUDY _____
WINDY _____
RAIN _____
FAIR _____
SNOW _____
HOT _____
MODERATE _____
COLD _____
FOG _____
FIGURED BY _____
NOTES CHECKED BY _____
PLOTTED BY _____

FILE No. _____


FLDR. No. _____

SHEET 9

DATE _____ 19____

STATION	DIST.	ANGLE	+	H. I.	— VER. ANG. DIFF.	ELEVATION
---------	-------	-------	---	-------	-------------------------	-----------

← to Circle

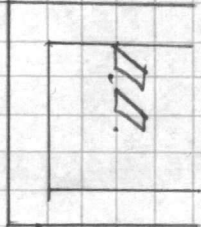

343'

Valve # 5
P. J. W. S.

Access Rd.

Plotted
J.F.W.

























VALUABLE

SUBJECT _____

RETURN TO
CARR & J. E.
GREINER CO.
JACKSONVILLE,
N. C.

FIELD PARTY

IN CHARGE

INSTRUMENT

NOTES

TAPE READ

TAPE OR ROD

TAPE OR ROD

INSTRUMENT NO.

TAPE NO.

WEATHER

CLEAR
CLOUDY
WINDY
RAIN
FAIR
SNOW
HOT
MODERATE
COLD
FOG
FIGURED BY _____
NOTES CHECKED BY _____
PLOTTED BY *gll*

FILE No. _____

FLDR. No. _____

SHEET 3-3

DATE 7/30 19 41

STATION	DIST.	ANGLE		H. I.	VER. ANG. DIFF.	ELEVATION
		°	"			

94°05' Lt

24+04.0 P.I.

Service

"I" St & Service Rd. intersection

94°05'

P.I.

Road

Line

18" Water Line

along Service Rd.

23+47.0

I. Street
Base

86.9 8" V.A.B








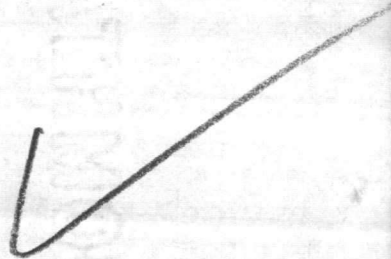

(114)



































VALUABLE

RETURN TO
CARR & J. E.
GREINER CO.
JACKSONVILLE,
N. C.


SUBJECT Valve & Hydrant Location
"As Built" along "L" Street.
Base Line Beginning at Plat on "M" St.
at Intersection & Running along
"L" St To Service Road Intersection

FIELD PARTY
McMillan IN CHARGE
Howell INSTRUMENT
McMillan NOTES
Coolter TAPE READ
Sutton TAPE OR ROD
Holland TAPE OR ROD
Craver INSTRUMENT NO.
TAPE NO.

WEATHER
CLEAR
CLOUDY
WINDY
RAIN
FAIR
SNOW
HOT
MODERATE
COLD
FOG
FIGURED BY _____
NOTES CHECKED BY gfl
PLOTTED BY gfl

FILE No. 160
FLDR. No. _____
SHEET 1-3
DATE 8/4 1942

STATION	DIST.	ANGLE	+	H. I.	VER. ANG. DIFF.	ELEVATION
		° ' "				

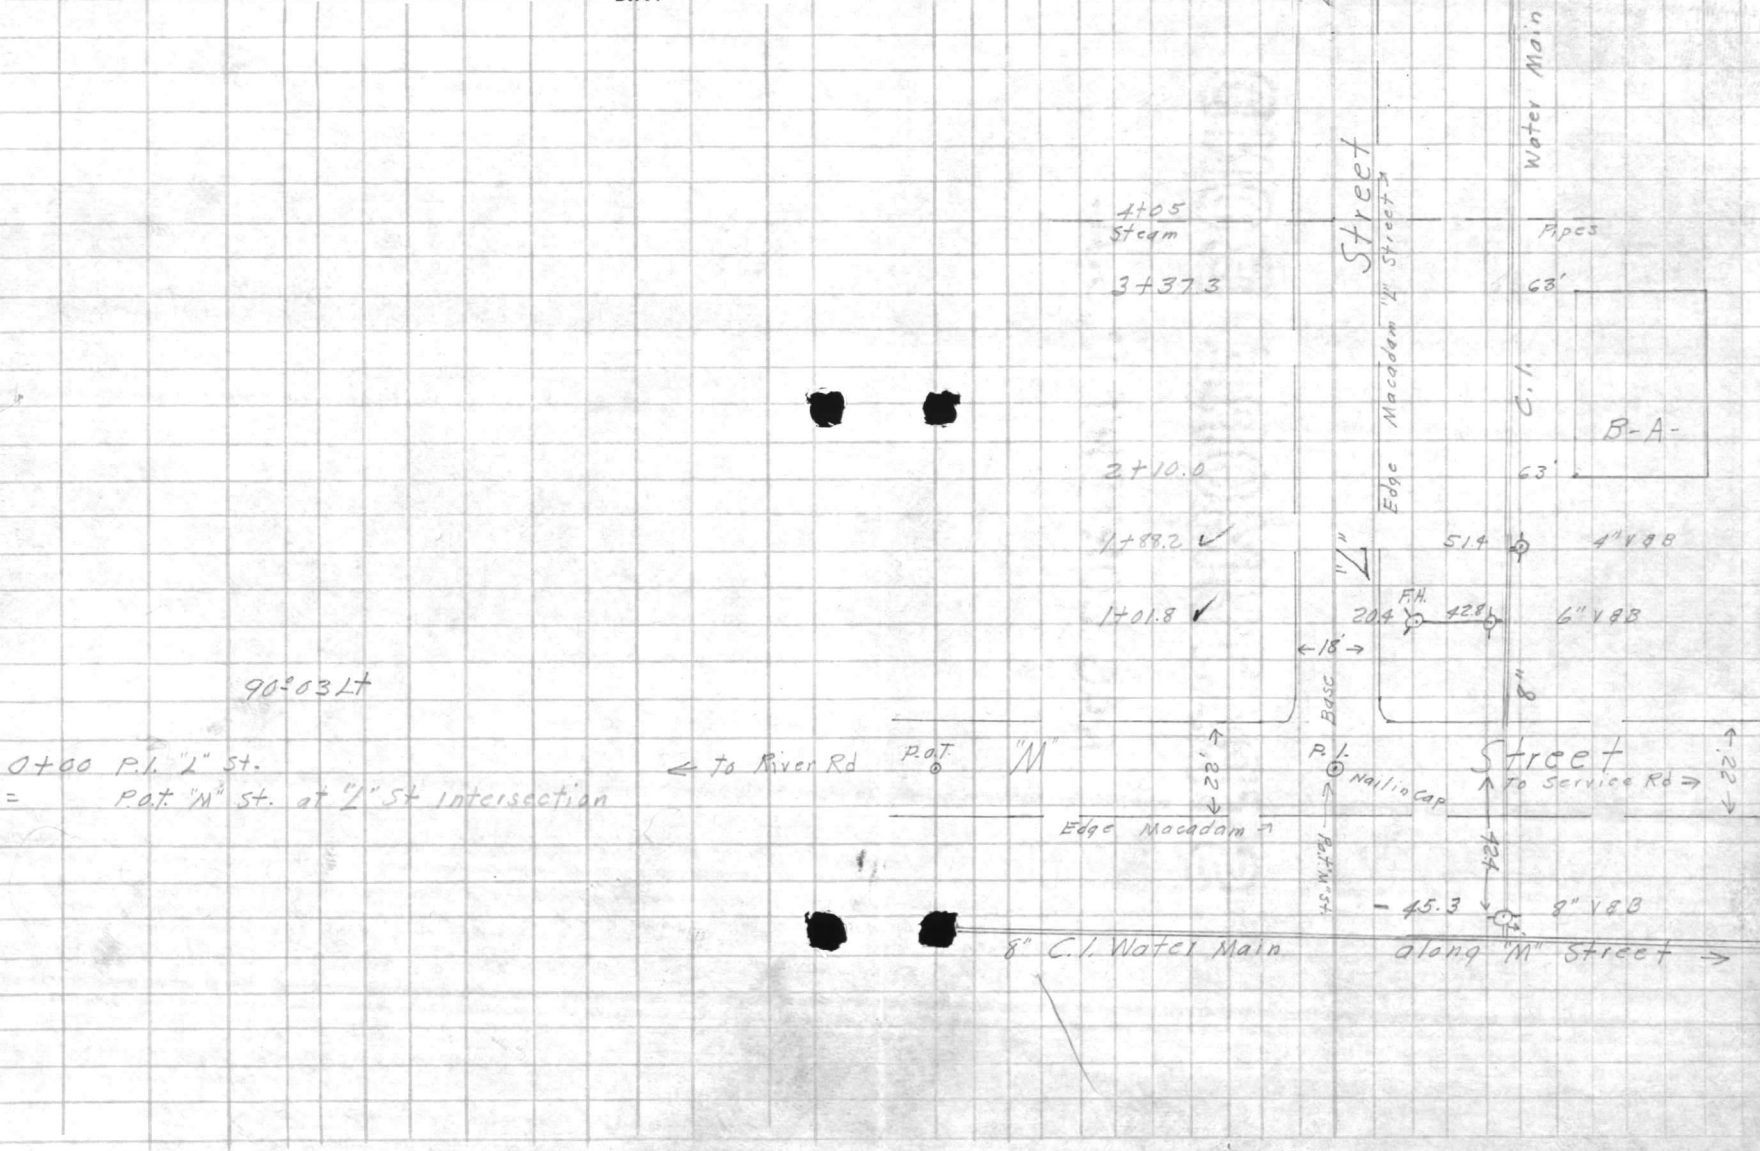









VALUABLE

SUBJECT _____

 RETURN TO
 CARR & J. E.
 GREINER CO.
 JACKSONVILLE,
 N. C.

FIELD PARTY

 _____ IN CHARGE
 _____ INSTRUMENT
 _____ NOTES
 _____ TAPE READ
 _____ TAPE OR ROD
 _____ TAPE OR ROD
 _____ INSTRUMENT NO.
 _____ TAPE NO.

WEATHER

 CLEAR
 CLOUDY
 WINDY
 RAIN
 FAIR
 SNOW
 HOT
 MODERATE
 COLD
 FOG

FILE No. _____

FLDR. No. _____

SHEET

3-3


DATE

19

STATION	DIST.	ANGLE	H. I.	VERI ANG. DIFF.	ELEVATION
---------	-------	-------	-------	-----------------	-----------

89° 52' Lt

20+65.0 P.I.

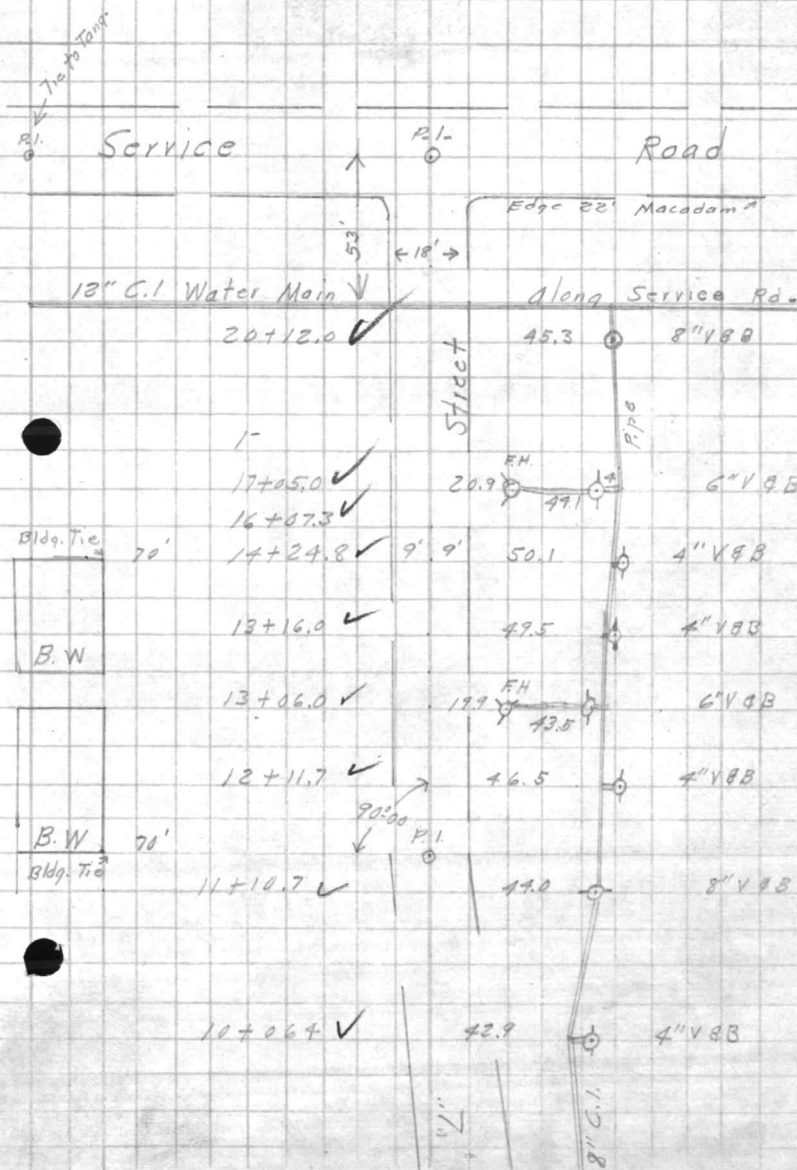


19° 39' Rt

11+09.5 P.I.

VALUABLE

CONFIDENTIAL

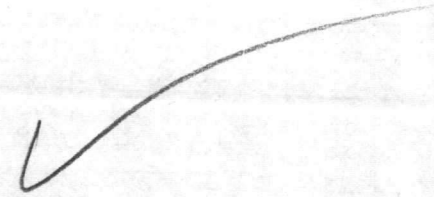

(76)
8/5/42

VALUABLE

SUBJECT: Profile of waterline on
N. St.

RETURN TO

CARR & J. E.
GREINER CO.
JACKSONVILLE,
N. C.

FIELD PARTY

IN CHARGE _____
INSTRUMENT _____
NOTES _____
TAPE READ _____
TAPE OR ROD _____
TAPE OR ROD _____
INSTRUMENT NO. _____
TAPE NO. _____

WEATHER

CLEAR _____ SNOW _____
CLOUDY _____ HOT _____
WINDY _____ MODERATE _____
RAIN _____ COLD _____
FAIR _____ FOG _____

FILE No. 160

FLDR. No. _____

FIGURED BY _____ SHEET 1


NOTES CHECKED BY _____

PLOTTED BY _____ DATE 8/3 1942

STATION	DIST.	ANGLE	H. I.	VER. ANG. DIFF.	ELEVATION
BM#78	1.00		17.557		16.557
0.00 on pipe			5.30		12.26
0+3 on valve			4.05		13.51
2+48 t. - p.			8.90		8.76
2+48 t. of v. 6ft. from c.p.			8.50		9.06
2+48 c.p. to h. 31ft.			7.40		10.16
5+15 t. of p.			5.55		12.01
5+15 t. of v.			5.80		11.76
6+30 t. of p.			10.15		7.41
6+30 t. of v.			9.70		7.86
7+00 t. of v. on M.L.			8.75		8.81
BM#78	0.90		17.457	1.00	16.557
9+46 t. of p.			11.00		6.46
9+46 t. of v. 4 1/2 from c.p.			9.45		8.01
T.P.	11.33		28.017	0.77	16.6877
12+19 t. of p.			15.20		12.82
12+19 t. of v.			14.00		14.02
13+00 t. of p.			13.45		14.57
13+00 t. of v.			13.10		14.92


From P to Fhd -21.F

1.00 17.557 16.557
0.90 16.767

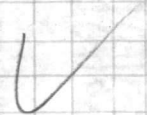



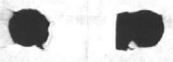

VALUABLERETURN TO
CARR & J. E.
GREINER CO.
JACKSONVILLE,
N. C.SUBJECT Profile of Water Line
on N. St. beginning on T. on
River Road water Line on Runing
along "N" St. Water Line To
Service Road water Line.

FIELD PARTY

IN CHARGE _____
INSTRUMENT _____
NOTES _____
TAPE READ _____
TAPE OR ROD _____
TAPE OR ROD _____
INSTRUMENT No. _____
TAPE No. _____

WEATHER

CLEAR _____ SNOW _____
CLOUDY _____ HOT _____
WINDY _____ MODERATE _____
RAIN _____ COLD _____
FAIR _____ FOG _____

FILE No. _____

FLDR. No. _____

SHEET 9

FIGURED BY _____

NOTES CHECKED BY _____

PLOTTED BY _____

DATE _____

19____

STATION DIST. ANGLE + H. I. VER: ANG. ELEVATION

o' ' "

28017

DIFF.

16.06 t. of N on M. Line 6.35 21.67

116+49 t. of p. 8.85 19.17

116+49 t. of v. 7.60 20.42

Fhd 29 ft. OFF LINE

17+84 t. of p. 9.10 19.12

T.P. 5.37 22.67

3.78 26.347 22.647

20+04 t. of p. 10.00 16.35

20+04 t. of v. 9.50 16.85

25 ft. to Fhd

24+00 t. of p. 11.25 15.10

24+00 t. of v. 9.25 17.10

25 ft. to Fhd.

26+84 t. of p. 8.60 17.75

26+84 t. of v. 6.60 19.75












VALUABLE

SUBJECT _____

RETURN TO
CARR & J. E.
GREINER CO.
JACKSONVILLE,
N. C.

FIELD PARTY

IN CHARGE

INSTRUMENT

NOTES

TAPE READ

TAPE OR ROD

TAPE OR ROD

INSTRUMENT No.

TAPE No.

WEATHER

CLEAR
CLOUDY
WINDY
RAIN
FAIR

SNOW
HOT
MODERATE
COLD
FOG

FILE No. _____

FLDR. No. _____

SHEET 3-3

FIGURED BY _____
NOTES CHECKED BY _____

PLOTTED BY _____ DATE _____ 19__

STATION	DIST.	ANGLE		+	H. I.	VER. ANG. DIFF.		ELEVATION
		o	"					

89°59'44"

19+23.0 P.I.

Edge Macadam on Michael Rd

Michael

P.O.

Road

Cypress Street

22' 7"

CYPRESS STREET

(113)

$$\begin{array}{r} 970 \\ 88 \\ \hline 798 \\ 178 \end{array}$$

$$\begin{array}{r} 1087 \\ 1925 \\ \hline 3012 \end{array}$$

$$\begin{array}{r} 25 \\ 68 \\ \hline 93 \end{array}$$

$$\begin{array}{r} 25 \\ 68 \\ \hline 93 \end{array}$$

OAK STREET





REPRODUCED FROM THE
NATIONAL ARCHIVES AT COLLEGE PARK, MARYLAND

VALUABLE

SUBJECT _____

RETURN TO
CARR & J. E.
GREINER CO.
JACKSONVILLE,
N. C.

FIELD PARTY

IN CHARGE

INSTRUMENT

NOTES

TAPE READ

TAPE OR ROD

TAPE OR ROD

INSTRUMENT NO.

TAPE NO.

WEATHER

CLEAR
CLOUDY
WINDY
RAIN
FAIR

SNOW
HOT
MODERATE
COLD
FOG

FILE No. _____

FLDR. No. _____

SHEET 4-4

NOTES CHECKED BY _____

FIGURED BY _____

PLOTTED BY _____


DATE _____ 19 _____

STATION	DIST.	ANGLE		H. I.	VER. ANG. DIFF.	ELEVATION
		o	"			

89°59' R+
19+27.5 P.I.


Michael P.I. Street

18+62.5
18+34.3
55'
55'

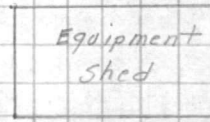

18+14.6
17+42

Oak Street

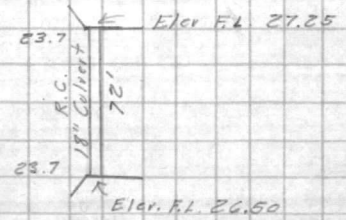

VALUABLE

RETURN TO
CARR & J. E.
GREINER CO.
JACKSONVILLE,
N. C.

SUBJECT Base Line along Michael
Road Showing Bldg. Location & Culvert
Elevations - No water Line Built.
Base Line Beginning at Cypress St.
& Running To Oak St.

FIELD PARTY

McMillan IN CHARGE
Howell INSTRUMENT
McMillan NOTES
Caulter TAPE READ
Jackson TAPE OR ROD
Kallum TAPE OR ROD
INSTRUMENT NO. _____
TAPE NO. _____

WEATHER

CLEAR
CLOUDY
WINDY
RAIN
FAIR

SNOW
HOT
MODERATE
COLD
FOG

FILE No. 160

FLDR. No. _____


SHEET 1-5

FIGURED BY _____
NOTES CHECKED BY _____
PLOTTED BY JBS DATE 8/18 1942

STATION	DIST.	ANGLE	H. I.	VER. ANG. DIFF.	ELEVATION
---------	-------	-------	-------	-----------------	-----------

Checked & Plotted
Aug 28 - 42
JBS - BM

4+70.0 P.O.T.

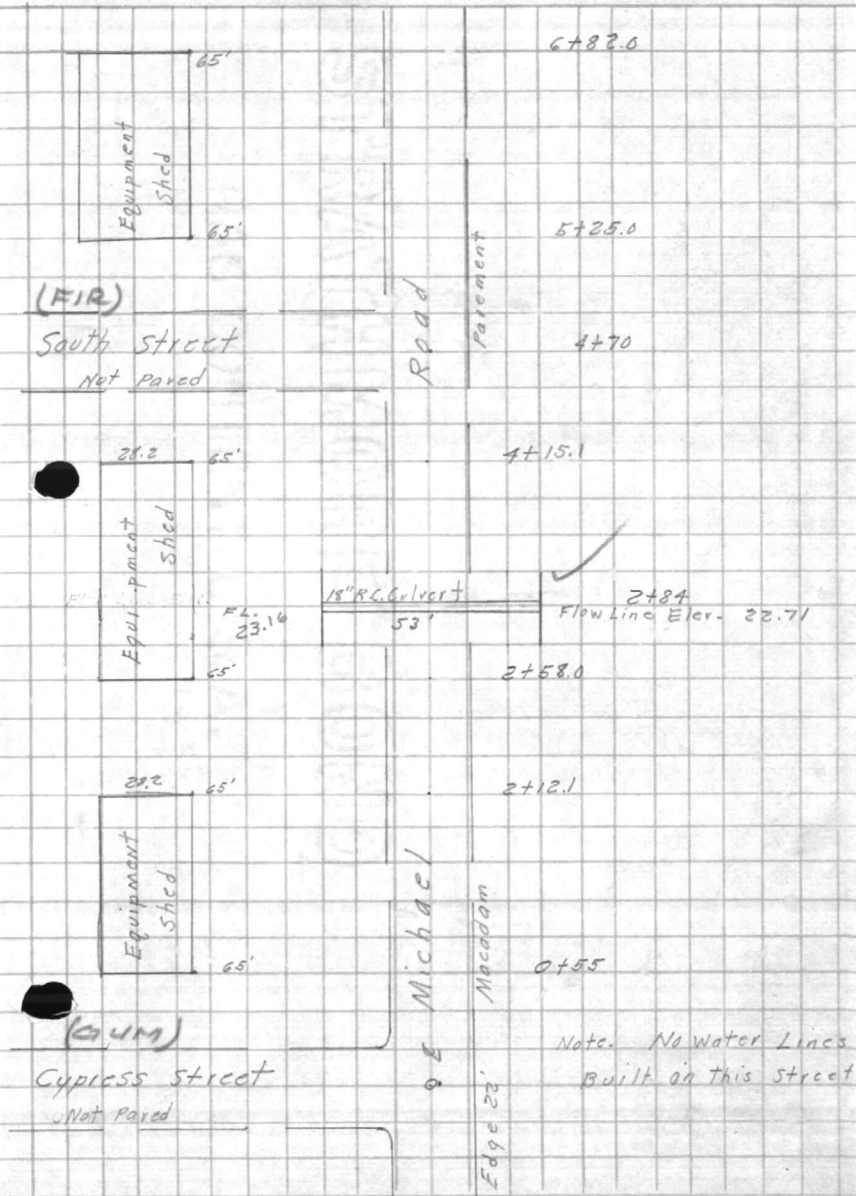

89°59'14"

0+00 P.I.

(QUM)
Cypress street
Not Paved

Edge 22'













VALUABLE

SUBJECT _____

RETURN TO
CARR & J. E.
GREINER CO.
JACKSONVILLE,
N. C.

FIELD PARTY

IN CHARGE _____
INSTRUMENT _____
NOTES _____
TAPE READ _____
TAPE OR ROD _____
TAPE OR ROD _____
INSTRUMENT NO. _____
TAPE NO. _____

WEATHER

CLEAR _____ SNOW _____
CLOUDY _____ HOT _____
WINDY _____ MODERATE _____
RAIN _____ COLD _____
FAIR _____ FOG _____

FILE No. _____

FLDR. No. _____

FIGURED BY _____ SHEET 3.5

NOTES CHECKED BY _____

PLOTTED BY JFW DATE _____ 19____

STATION	DIST.	ANGLE	+	H. I.	VER. ANG. DIFF.	ELEVATION
		° ' "				

18+80 Pot

∩ Gum Street
(CEDAR)



14+10.0 Pot

∩ Cedar Street
(DOGWOOD)





























Michael Road

VALUABLE


1927
13489
15416
17749
3353
29216
2118.3

(123)