

VALUABLE
 RETURN TO
 CARR & J. E.
 GREINER CO.
 JACKSONVILLE,
 N. C.

 SUBJECT Location of Water Main
from Access Road To Well #15
819

 FIELD PARTY
Mc Millan IN CHARGE
Howell INSTRUMENT
Marc NOTES
Holland TAPE READ
Austin TAPE OR ROD
 TAPE OR ROD
 INSTRUMENT NO.
 TAPE NO.

 WEATHER
 CLEAR SNOW
 CLOUDY HOT
 WINDY MODERATE
 RAIN COLD
 FAIR FOG
 FIGURED BY _____ SHEET 1-5
 NOTES CHECKED BY _____ DATE 12/30 1942
 PLOTTED BY _____
FILE No. 120

FLDR. No. _____

STATION	DIST.	ANGLE	+	H. I.	VER. ANG. DIFF.	ELEVATION
---------	-------	-------	---	-------	-----------------	-----------

= 0+00	T. Line Ahead					
332+28.5	Access Rd					
12.5						
41.0						

 1st 500' From
 Sta 0+74 is 12" Transite

 Sta. 0+74 = 332+46
 Holcomb Blvd.

Prop BB. Well Toward 16
 1st 603 14" Transite
 Remaining is 12" " Well 16

104°55' (209°49'30')

 = 317+38 Main Access Rd. ahead.
 1+00 Sta. Paradise Rd.

Does Not Affect Record Map

East Lane Access Rd.

P.I.

①

1202.8

174°34'

1202.8

174°34'

 Transite Line To Well #15-#14
 576'W →

Main Access Rd. N175°W

N175°W

104°55'







West Lane Main Access Road

 To Paradise Point
 Sight

To Jacksonville

VALUABLE























VALUABLE

SUBJECT _____

RETURN TO
 CARR & J. E.
 GREINER CO.
 JACKSONVILLE,
 N. C.

FIELD PARTY

 IN CHARGE

 INSTRUMENT

 NOTES

 TAPE READ

 TAPE OR ROD

 TAPE OR ROD

 INSTRUMENT NO.

 TAPE NO.

WEATHER

CLEAR _____
 CLOUDY _____
 WINDY _____
 RAIN _____
 FAIR _____
 SNOW _____
 HOT _____
 MODERATE _____
 COLD _____
 FOG _____
 FIGURED BY _____
 NOTES CHECKED BY _____
 PLOTTED BY _____

FILE No. _____

FLDR. No. _____

SHEET 2-5

DATE _____ 19____

STATION	DIST.	ANGLE	+	H. I.	VER: ANG. DIFF.	ELEVATION
---------	-------	-------	---	-------	--------------------	-----------

14+00

12+00

10+00

8+00

5+00

3+00

0+74

10" Transite Water

10.0'

9.0'

10.0'

10.0'

10.0'

9.0'

12.5'

Lins

Transite

10x10 Tee



VALUABLE

SUBJECT _____

RETURN TO
 CARR & J. E.
 GREINER CO.
 JACKSONVILLE,
 N. C.

FIELD PARTY

 IN CHARGE

 INSTRUMENT

 NOTES

 TAPE READ

 TAPE OR ROD

 TAPE OR ROD

 INSTRUMENT NO.

 TAPE NO.

WEATHER

CLEAR _____
 CLOUDY _____
 WINDY _____
 RAIN _____
 FAIR _____
 SNOW _____
 HOT _____
 MODERATE _____
 COLD _____
 FOG _____
 FIGURED BY _____
 NOTES CHECKED BY _____
 PLOTTED BY _____


FILE No. _____

FLDR. No. _____

SHEET 3-5

DATE _____ 19____

STATION	DIST.	ANGLE		+	H. I.	VER. ANG. DIFF.		ELEVATION
		°	"					
24+00					M.C. 576°W.			8.0'
23+74.6								23+90 at valve
23+70.8								10" x 8" Tee
23+64.1								9' x 5'
23+45.10	2.180				Left (Double 4°36')			9.0' P.I. deflection to left
22+50								10.0'
20+50								10.0'
19+00								10.0'
18+00								10.0'
16+60								10.0'

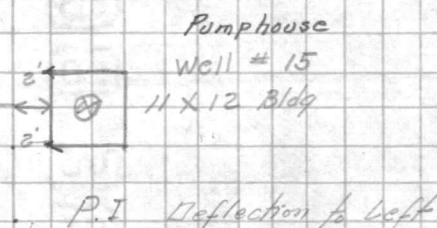

VALUABLE










VALUABLE

SUBJECT _____

RETURN TO

CARR & J. E.
GREINER CO.JACKSONVILLE,
N. C.**FIELD PARTY**_____
IN CHARGE_____
INSTRUMENT_____
NOTES_____
TAPE READ_____
TAPE OR ROD_____
TAPE OR ROD_____
INSTRUMENT NO._____
TAPE NO.**WEATHER**_____
CLEAR_____
CLOUDY_____
WINDY_____
RAIN_____
FAIR_____
SNOW_____
HOT_____
MODERATE_____
COLD_____
FOG

FIGURED BY _____

NOTES CHECKED BY _____

PLOTTED BY _____

FILE No. _____

FLDR. No. _____

SHEET 4-5

DATE _____ 19__

STATION	DIST.	ANGLE ° ' "	+	H. I.	— VER. ANG. DIFF.	ELEVATION
40+00						9.0'
38+00						8.0'
36+00						9.0'
33+00						8.0'
30+00						8.0'
28+00						8.0'
26+00						9.0'
25+00						8.5'

T

VALUABLE








VALUABLE
 SUBJECT _____

 RETURN TO
 CARR & J. E.
 GREINER CO.
 JACKSONVILLE,
 N. C.
FIELD PARTY
 _____ IN CHARGE
 _____ INSTRUMENT
 _____ NOTES
 _____ TAPE READ
 _____ TAPE OR ROD
 _____ TAPE OR ROD
 _____ INSTRUMENT NO.
 _____ TAPE NO.
WEATHER
 CLEAR
 CLOUDY
 WINDY
 RAIN
 FAIR
 SNOW
 HOT
 MODERATE
 COLD
 FOG

FILE No. _____

FLDR. No. _____

SHEET 5-5

DATE _____ 19__

 FIGURED BY _____
 NOTES CHECKED BY _____
 PLOTTED BY _____

STATION	DIST.	ANGLE	+	H. I.	VER. ANG. DIFF.	ELEVATION
---------	-------	-------	---	-------	-----------------	-----------

See next sheet for Profile
 Notes - Pg. 1 of 3

46+57.3

46+30.5

46+26.5

46+20

45+00

43+00



8.0'

8.0'

VALUABLE











VALUABLE

RETURN TO
CARR & J. E.
GREINER CO.
JACKSONVILLE,
N. C.

SUBJECT Profile of Transit
Water Main from Well #16 on Tee
To Well #15 & #14
10" Pipe To Well #15 8" To Well #14
10" & 12" - WHO

FIELD PARTY
M. S. Millar IN CHARGE
Howell INSTRUMENT
NOTES
TAPES READ
Holland TAPE OR ROD
TAPE OR ROD
INSTRUMENT NO.
TAPE NO.

WEATHER
CLEAR SNOW
CLOUDY HOT
WINDY MODERATE
RAIN COLD
FAIR FOG
FIGURED BY
NOTES CHECKED BY
PLOTTED BY

FILE No. _____
FLDR. No. _____
SHEET 1-3
DATE 12/30 1942

STATION	DIST.	ANGLE + o ' "	H. I.	VER. ANG. DIFF.	ELEVATION	
J.B.M.			3.37	37.43	34.06	Nail in Power pole near Tee on pipe Line
0+74				8.3	29.1	on Tee leading from W Line along Access Rd To Well No. 15 & 14
3+00				8.6	29.8	
				7.5	29.9	
				7.5	29.9	
T.P.			2.46	37.83	2.06	35.37
10				7.9	29.9	
12				7.3	30.5	
14				8.6	29.2	
16+60				9.7	29.1	
T.P.			3.17	35.73	5.27	32.56
18				10.9	24.8	
19				10.5	25.2	
20+50				8.2	27.5	

First 500' is
of 12" Pipe














VALUABLE

SUBJECT _____

RETURN TO
CARR & J. E.
GREINER CO.
JACKSONVILLE,
N. C.

FIELD PARTY

IN CHARGE

INSTRUMENT

NOTES

TAPE READ

TAPE OR ROD

TAPE OR ROD

INSTRUMENT NO.

TAPE NO.

WEATHER

CLEAR
CLOUDY
WINDY
RAIN
FAIR
SNOW
HOT
MODERATE
COLD
FOG
FIGURED BY _____
NOTES CHECKED BY _____
PLOTTED BY _____

FILE No. _____

FLDR. No. _____

SHEET 2-3

DATE _____ 19__

STATION	DIST.	ANGLE + "	H. I.	VER. ANG. DIFF.	ELEVATION	
			35.73			
22+50				11.3	24.4	
23+45.1				9.3	26.4	
B.M. #687	4.05		35.45	4.33	31.20	spike in Root 12" pine
24				8.9	26.6	
25				10.2	25.3	
26				8.6	26.9	
28				8.5	27.0	
30				8.0	27.5	
33				7.9	27.6	
TP	4.10		35.90	3.65	31.80	
36				8.3	27.6	
38				8.1	27.5	
40				8.1	27.8	
42				8.5	27.4	

VALUABLE









STRATHELMORE ED
1943 COPIED U.S.A.

VALUABLE

SUBJECT _____

RETURN TO
 CARR & J. E.
 GREINER CO.
 JACKSONVILLE,
 N. C.

FIELD PARTY

 IN CHARGE

 INSTRUMENT

 NOTES

 TAPE READ

 TAPE OR ROD

 TAPE OR ROD

 INSTRUMENT NO.

 TAPE NO.

WEATHER

CLEAR
 CLOUDY
 WINDY
 RAIN
 FAIR
 SNOW
 HOT
 MODERATE
 COLD
 FOG
 FIGURED BY _____
 NOTES CHECKED BY _____
 PLOTTED BY _____

FILE No. _____

FLDR. No. _____

SHEET 3-3

DATE 12/30 1992

STATION	DIST.	ANGLE	+	H. I.	VER: ANG. DIFF.	ELEVATION	
				35.90			
45					8.3	27.6	
46+26.5					8.3	27.6	on Tee End Pipe
					6.8	29.1	on Valve
TP			3.80	35.55	4.15	31.75	
B.M. # 687					4.15	31.40	(31.354) Well # 15
						31.40	
						31.35	
						.05 Error	

VALUABLE










VALUABLE

RETURN TO
CARR & J. E.
GREINER CO.
JACKSONVILLE,
N. C.

SUBJECT Profile 10" Transit Water
Line Well # 13 To Well # 12
Profile 8" Transit Water Main
Well # 2 To Well # 11

FIELD PARTY
McNellie IN CHARGE
Howell INSTRUMENT
Howell NOTES
Holland TAPE READ
Austin TAPE OR ROD
INSTRUMENT NO. _____
TAPE NO. _____

WEATHER
CLEAR _____ SNOW _____
CLOUDY _____ HOT _____
WINDY _____ MODERATE _____
RAIN _____ COLD _____
FAIR _____ FOG _____
FIGURED BY _____
NOTES CHECKED BY _____
PLOTTED BY _____

FILE No. 120
FLDR. No. _____
SHEET 1-4
DATE 1/15 1943

STATION	DIST.	ANGLE		+ H. I.	- VER. ANG. DIFF.	ELEVATION	
		o	"				
B.M. # 29		1.02		31.31		30.29 (30.285)	
		10.64		33.14	8.81	22.50	
0+00					17.0	16.1	Tec on water Line along Main Access Road
1+00					11.9	21.2	on 10" water Line from Well # 13 To well # 12
2+00					8.5	24.6	
3+00					5.5	27.6	
4					4.9	28.2	
5					4.8	28.3	
TP		6.50		37.09	2.55	30.59	
6					8.3	28.8	
8					8.1	29.0	
10					7.7	29.4	
12					7.6	29.5	
12+70					7.6	29.5	12° Bend Lt.
HP		0.01		34.97	2.23	34.86	








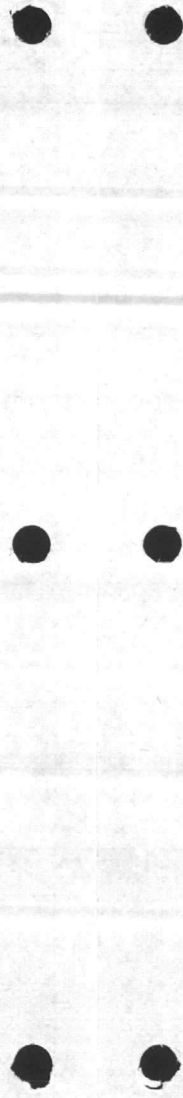

VALUABLE

SUBJECT _____

RETURN TO
 CARR & J. E.
 GREINER CO.
 JACKSONVILLE,
 N. C.

FIELD PARTY

 IN CHARGE

 INSTRUMENT

 NOTES

 TAPE READ

 TAPE OR ROD

 TAPE OR ROD

 INSTRUMENT NO.

 TAPE NO. _____

WEATHER

CLEAR _____
 CLOUDY _____
 WINDY _____
 RAIN _____
 FAIR _____
 SNOW _____
 HOT _____
 MODERATE _____
 COLD _____
 FOG _____
 FIGURED BY _____
 NOTES CHECKED BY _____
 PLOTTED BY _____

FILE No. _____
 FLDR. No. _____
 SHEET 2-4
 DATE _____ 19____

STATION	DIST.	ANGLE		+	H. I.	- VER. ANG. DIFF.		ELEVATION	
		o	f "						
					34.87				
1A						6.0		28.9	
15+20						9.7		25.2	
16						8.8		26.1	
18						8.2		26.7	
20						7.6		27.3	
21						11.2		23.7	
21+65						15.4		19.5	
22+33						11.6		23.3	20° Bend to Lt.
23						7.8		27.1	10" Transite Pipe
T.B.M.					3.74	35.57	3.04	31.83	
24+98						8.2		27.4	10x6 Tee
25+00						6.9		28.7	6" Valve, on top 1' Lt Tee (well 12' Lt Tee)
25+10						6.4		29.2	10x8 Reducer Cast iron top 8" Valve
27+00						9.0		26.6	8" Transite Pipe

VALUABLE






















VALUABLE

SUBJECT _____

RETURN TO
 CARR & J. E.
 GREINER CO.
 JACKSONVILLE,
 N. C.

FIELD PARTY

 IN CHARGE

 INSTRUMENT

 NOTES

 TAPE READ

 TAPE OR ROD

 TAPE OR ROD

 INSTRUMENT NO.

 TAPE NO.

WEATHER

CLEAR _____
 CLOUDY _____
 WINDY _____
 RAIN _____
 FAIR _____
 SNOW _____
 HOT _____
 MODERATE _____
 COLD _____
 FOG _____
 FIGURED BY _____
 NOTES CHECKED BY _____
 PLOTTED BY _____

FILE No. _____

FLDR. No. _____

SHEET 3-4

DATE _____ 19____

STATION	DIST.	ANGLE		+	H. I.	VER. ANG. DIFF.	ELEVATION	
		o	"					
					35.57			
30+00						7.7	27.9	
32						8.0	27.6	
34						8.3	27.3	
36						9.5	26.1	
37	3.46				34.82	4.21	31.36	
38						7.3	27.5	
40						9.0	26.8	
42						9.2	25.6	
43						10.9	23.9	
44						9.3	25.5	
45	5.53				34.96	5.39	29.43	
47						10.0	25.0	22 1/2° Bend to Rt.
47						8.0	27.0	
48+14						7.3	27.7	8x6" Tee

VALUABLE





VALUABLE

SUBJECT _____

RETURN TO
CARR & J. E.
GREINER CO.
JACKSONVILLE,
N. C.

FIELD PARTY

IN CHARGE

INSTRUMENT

NOTES

TAPE READ

TAPE OR ROD

TAPE OR ROD

INSTRUMENT NO.

TAPE NO.

WEATHER

CLEAR
CLOUDY
WINDY
RAIN
FAIR
SNOW
HOT
MODERATE
COLD
FOG
FIGURED BY _____
NOTES CHECKED BY _____
PLOTTED BY _____

FILE No. _____

FLDR. No. _____

SHEET 4-4

DATE 1/15 1943

STATION	DIST.	ANGLE		+	H. I.	- VER. ANG. DIFF.	ELEVATION
		o	f "				

34.96

48+1A

6.0 29.0 ✓

6" valve on top to well A'st.

End 8" Pipe

Well # 11

B.M. # 688

3.68 31.28 ✓

?

VALUABLE




































Plotted WHO,
1/18/43.

253

VALUABLERETURN TO
CARR & J. E.
GREINER CO.
JACKSONVILLE,
N. C.SUBJECT Profile on Transite
Water Main Beginning on Tee
at Well #13 & Running To Wells
17, 18 & 21FIELD PARTY
M. S. Millan IN CHARGE
H. Well INSTRUMENT
H. Well NOTES
M. S. Millan TAPE READ
Austin TAPE OR ROD
INSTRUMENT NO. _____
TAPE NO. _____WEATHER
CLEAR _____
CLOUDY _____
WINDY _____
RAIN _____
FAIR _____
SNOW _____
HOT _____
MODERATE _____
COLD _____
FOG _____
FIGURED BY _____
NOTES CHECKED BY _____
PLOTTED BY _____FILE No. 120
FLDR. No. _____
SHEET 1-
DATE 1/25 1993

STATION	DIST.	ANGLE		H. I.	ELEVATION	VER. ANG. DIFF.	+	-
		o	' "					
B.M. # 29		5.02		35.31	30.29			
		5.06		31.64	26.58	8.73		
132+31.0	Sta on Pipe along Access Rd.							
= 0+00	Tee 18" X 16"			15.5	16.1			
0+06				12.8	18.8			on top of valve (16")
0+75	@ Main access Rd.							
1+51				18.9	12.7			
3+00				9.7	21.9			
4+00	@ Railroad			9.5	22.1			
5+00				6.6	25.0			
7+00		5.96		36.47	30.51	1.13		
5+60				8.9	27.6			
7+00				8.1	28.4			
7+81				8.2	28.3			on tee (16" X 6")
7+81								valve 3' Lt Fire Hydrant 6' Lt.
7+81	Top Fire Hydrant			2.98	33.49			
		3.27		36.76				water main completed This for-

VALUABLE
PROPERTY
RECORDED
IN
BOOK
NO. 10
PAGE
NO. 10

Water Line Profile

from Well # 13
to Wells # 17, 18 & 21

WATER LINE
PROFILE

VALUABLE

RETURN TO
CARR & J. E.
GREINER CO.
JACKSONVILLE,
N. C.

SUBJECT Water Line Profile
Continued
To Wells # 17, 18, 21

FIELD PARTY
Dillon IN CHARGE
____ INSTRUMENT
____ NOTES
____ TAPE READ
____ TAPE OR ROD
____ TAPE OR ROD
INSTRUMENT NO. _____
TAPE NO. _____

WEATHER
CLEAR _____
CLOUDY _____
WINDY _____
RAIN _____
FAIR _____
SNOW _____
HOT _____
MODERATE _____
COLD _____
FOG _____
FIGURED BY _____
NOTES CHECKED BY _____
PLOTTED BY _____

FILE No. _____
FLDR. No. _____
SHEET #2
DATE 2/17 1943

STATION	DIST.	ANGLE		+	H. I.	- VER. ANG. DIFF.	ELEVATION
		°	"				
					36.46		
10+00						7.10	29.66
12+00						7.86	26.90
14+00						9.03	27.73
T.P.					4.63	4.62	32.14
					36.77		
16+00						8.04	28.73
18+00						7.66	29.11
20+00						7.05	29.72
T.P.					4.98	4.24	32.53
					37.51		
22+00						8.83	28.68
24+00						8.05	29.46
25+16.6						8.27	29.24
25+21.4 Valve							
26+00						7.97	29.54

F.P.
22'

14'

Tree (16" x ") • 13' • 420 Valve
{ 37.5 Ft. Pump House # 17
- 4.58 = 32.93 Floor Elev.

VALUABLE

























VALUABLE

SUBJECT Water Line Profile
To Wells # 17, 18, 21

RETURN TO
 CARR & J. E.
 GREINER CO.
 JACKSONVILLE,
 N. C.

FIELD PARTY

Oliver IN CHARGE
 _____ INSTRUMENT
 _____ NOTES
 _____ TAPE READ
 _____ TAPE OR ROD
 _____ TAPE OR ROD
 _____ INSTRUMENT NO.
 _____ TAPE NO.

WEATHER

CLEAR _____ SNOW _____
 CLOUDY _____ HOT _____
 WINDY _____ MODERATE _____
 RAIN _____ COLD _____
 FAIR _____ FOG _____
 FIGURED BY _____
 NOTES CHECKED BY _____
 PLOTTED BY _____

FILE No. _____
 FLDR. No. _____
 SHEET #3
 DATE 2/17 19 48

STATION	DIST.	ANGLE ° ' "	+	H. I.	VER. ANG. DIFF.	ELEVATION
T.P.				37.51		
					2.37	35.14
			213	37.27		
28+00					8.20	29.07
30+00					9.23	28.04
32+00					10.58	26.39
32+54					10.47	26.80
33+69					11.70	25.57
T.P.					9.69	32.58
			4.57	37.15		
34+73					10.12	27.03
36+00					8.56	28.59
37+00					8.53	28.62
38+00					9.56	27.59
38+73					11.20	25.95
39+73					11.88	25.27
41+00					16.23	20.92

14'








4.58

VALUABLE
 RETURN TO
 CARR & J. E.
 GREINER CO.
 JACKSONVILLE,
 N. C.

SUBJECT

 Water Line Profile
 to Wells # 17, 18 & 21

FIELD PARTY

 IN CHARGE _____
 INSTRUMENT _____
 NOTES _____
 TAPE READ _____
 TAPE OR ROD _____
 TAPE OR ROD _____
 INSTRUMENT NO. _____
 TAPE NO. _____

WEATHER

 CLEAR _____
 CLOUDY _____
 WINDY _____
 RAIN _____
 FAIR _____
 SNOW _____
 HOT _____
 MODERATE _____
 COLD _____
 FOG _____
 FIGURED BY _____
 NOTES CHECKED BY _____
 PLOTTED BY _____

FILE No. _____

FLDR. No. _____

SHEET # 4

DATE 2/17 1943

STATION	DIST.	ANGLE		H. I.	VER. ANG. DIFF.	ELEVATION
		°	' "			
T.P.				37.15		
				5.59	35.12	
42+00					14.90	20.22
42+43					18.65	16.47
43+00					17.15	17.94
45+00					5.26	26.86
T.P.					2.05	33.07
				7.96	41.03	
47+00					10.73	30.30
48+54						
48+90	Valve				8.66	32.37
49+55	("x " Tee)					
50+00	Water Line left to Well # 21				8.61	32.42
0+10	Line Ahead Not Constructed #20					
0+10	Line to Right Not Constructed #19				8.98	32.05
1+00	Band Right					
1+00					9.63	31.40
T.B.M.	Side Shot				4.75	36.28

Nail in Power Pole 10' Rt. of 40+50

18" x 6" Tee

4" Valve 43'

Pump House # 18
-5.11-35.89 Floor Elev.

Valve @ 4.5'

(36.305) Intersection of Road paralleling Water Line & Relocated Section of Old Hurst Beach Road

VALUABLE




















VALUABLE

RETURN TO
CARR & J. E.
GREINER Co.
JACKSONVILLE,
N. C.

SUBJECT Water line Profile of
Spur line kept to Piney Green
from Well # 18 to # 21

FIELD PARTY
Dillon IN CHARGE
INSTRUMENT
NOTES
TAPE READ
TAPE OR ROD
TAPE OR ROD
INSTRUMENT NO.
TAPE NO.

WEATHER
CLEAR
CLOUDY
WINDY
RAIN
FAIR
SNOW
HOT
MODERATE
COLD
FOG
FIGURED BY
NOTES CHECKED BY
PLOTTED BY

FILE No. _____
FLDR. No. _____
SHEET # 5
DATE 2/17 19 43

STATION	DIST.	ANGLE ° ' "	H. I.	VER. ANG. DIFF.	ELEVATION
			41.03		
34 ⁸⁰ 80				16.05	29.98
B.M. Side Shot T.P.				3.76 9.17 9.16	37.27 31.86 31.87
	7.98	39.84 37.55			
5+00				12.44	27.20
7+00				8.44	31.40
9+00				5.95	33.89
T.P.				1.64 1.03	38.20 38.82
	6.94	45.14 45.16			
11+00				9.58	35.56
13+00				8.60	36.54
15+00				10.18	35.02
T.B.M.				.55 2.54	.59 22.42
	3.12	45.71 44			
17+00				8.43	37.28
19+00				8.05	37.66
T.P.				.59 2.58	.12 41.16

Spike in Power Pole at Intersection of Power lines at Well # 18
Piney Green to Trailer Camp Road.

Nail in Top of Stump 12' W. of Water Line (27' Pkys. & Rd.
Sta. 14+50

E.
Pd.
.15'

E.
Pd.
.15'

E.
Pd.
.15'

VALUABLE





VALUABLE

RETURN TO
CARR & J. E.
GREINER CO.
JACKSONVILLE,
N. C.

SUBJECT Water Line Profile to
Well # 21 Piney Green

FIELD PARTY

D. L. ... IN CHARGE
INSTRUMENT
NOTES
TAPE READ
TAPE OR ROD
TAPE OR ROD
INSTRUMENT NO.
TAPE NO.

WEATHER

CLEAR
CLOUDY
WINDY
RAIN
FAIR
SNOW
HOT
MODERATE
COLD
FOG
FIGURED BY
NOTES CHECKED BY
PLOTTED BY

FILE NO. _____

FLDR. No. _____

SHEET # 6

DATE 2/15 1943

STATION	DIST.	ANGLE ° ' "	+	H. I.	VER. ANG. DIFF.	ELEVATION
---------	-------	----------------	---	-------	--------------------	-----------

						41.46 ¹²
				4.39	46.55	
21+00					8.25	37.26
23+00					8.44	37.07
24+13.3	" x "	" Tee			8.89	36.62
Pump House # 21					4.35	41.16
T.P.					5.00	40.55
				5.56	46.11	
				3.11	43.45	
				5.17	43.45	
				4.20	43.45	
R.M. # 346					6.77	36.59

Not Connected to Well # 21
Floor Elev. 15' - 40.5' - Well # 21

(36575) Spike in Root of 12" Pine 1000' West of Road Intersection at Piney Green

FILE NO. 277
STATION
DATE

VALUABLE

STATION NO.
CARTON NO.
CHECK NO.
M-D
STATION

Plotted - Profile "F-F"
J.F.W. 2/23/43

277

VALUABLE

RETURN TO
CARR & J. E.
GREINER CO.
JACKSONVILLE,
N. C.

SUBJECT Stakes set for
Future Air Valves on 18"
Transite Water Main along
Main Access Road Between
Wells # 10 & #16

FIELD PARTY
M. S. Miller IN CHARGE
INSTRUMENT _____
M. S. Miller NOTES _____
TAPE READ _____
TAPE OR ROD _____
TAPE OR ROD _____
INSTRUMENT NO. _____
TAPE NO. _____

WEATHER
CLEAR _____ SNOW _____
CLOUDY _____ HOT _____
WINDY _____ MODERATE _____
RAIN _____ COLD _____
FAIR _____ FOG _____
FIGURED BY _____
NOTES CHECKED BY _____
PLOTTED BY _____

FILE No. 120
FLDR. No. _____
SHEET 1-1
DATE 1/26 1943

STATION	DIST.	ANGLE		+	H. I.	— VER. ANG. DIFF.	ELEVATION
		o	f "				

Well # 13 To # 11

Sta. 60+00
Sta. 65+37
Sta. 70+00
Sta. 80+60
Sta. 101+00
Sta. 111+95
Sta. 115+92
Sta. 123+65
Sta. 127+60
Sta. 148+75

Sta. 11+00
Sta. 20+00
Sta. 30+00
Sta. 38+00

Well # 16 To # 14

Sta. 12+00
Sta. 20+40

VALUABLE





265

VALUABLE
 RETURN TO
 CARR & J. E.
 GREINER CO.
 JACKSONVILLE,
 N. C.

 SUBJECT Profile 18" Transite water
Main along Main Access Road
from Sta 123+63.4 on water Main's
To Sta. 132+31.

FIELD PARTY

McMillan IN CHARGE
Hawck INSTRUMENT
Hawck NOTES
Holland TAPE READ
Austin TAPE OR ROD
 TAPE OR ROD
 INSTRUMENT No. _____
 TAPE No. _____

WEATHER

 CLEAR _____
 CLOUDY _____
 WINDY _____
 RAIN _____
 FAIR _____
 SNOW _____
 HOT _____
 MODERATE _____
 COLD _____
 FOG _____
 FIGURED BY _____
 NOTES CHECKED BY _____
 PLOTTED BY _____
FILE No. 120

FLDR. No. _____

SHEET 1-2DATE 1/22 1943

STATION	DIST.	ANGLE		+	H. I.	-		ELEVATION	
		°	' "			VER.	ANG. DIFF.		
B.M.#29				5.38	35.67			30.29	
TP.				6.40	31.86	10.21		25.46	
123+63.4 ahead =						6.4		25.5	
123+63.4 Back						6.4		25.5	
124						10.3		21.6	
125						17.3		14.6	
126+1A						10.0		21.9	
127						7.9		24.0	
128						10.9		21.0	
129						19.7		12.2	
130				5.08	26.63	10.31		21.55	
TP.									
130+59.7						16.1		10.5	at 18" valve
						12.7		13.9	Top valve 18"
130+68						16.7		9.9	12x6" Tee

VALUABLE






















VALUABLE

SUBJECT _____

RETURN TO
CARR & J. E.
GREINER CO.
JACKSONVILLE,
N. C.

FIELD PARTY

IN CHARGE

INSTRUMENT

NOTES

TAPE READ

TAPE OR ROD

TAPE OR ROD

INSTRUMENT NO.

TAPE NO.

WEATHER

CLEAR _____ SNOW _____
CLOUDY _____ HOT _____
WINDY _____ MODERATE _____
RAIN _____ COLD _____
FAIR _____ FOG _____
FIGURED BY _____
NOTES CHECKED BY _____
PLOTTED BY _____

FILE No. _____

FLDR. No. _____

SHEET 2-2

DATE _____ 19____

STATION	DIST.	ANGLE		+	H. I.	- VER. ANG. DIFF.		ELEVATION
		°	' "					

26.63

131						16.1		10.5
-----	--	--	--	--	--	------	--	------

132						12.1		14.5
-----	--	--	--	--	--	------	--	------

132+31.0 Back =						10.5		16.1	TCC 18"X16"
-----------------	--	--	--	--	--	------	--	------	-------------

132+31.0 Ahead

T.P.		10.25			35.70	1.18		25.45
------	--	-------	--	--	-------	------	--	-------

B.M. #29						5.42		30.28
----------	--	--	--	--	--	------	--	-------










Water Line



260

Profile "E-E"
Plotted W.H.O.