

VALUABLE

Return To  
Public Works  
Office  
Camp Lejeune  
North Carolina

SUBJECT LOCATION OF WATER  
METERS BY PUMPING  
STATION.

FIELD PARTY

DENNIS in Charge  
\_\_\_\_ Instrument  
\_\_\_\_ Notes  
\_\_\_\_ Tape Read  
\_\_\_\_ Tape or Rod  
\_\_\_\_ Tape or Rod  
\_\_\_\_ Instrument No.  
\_\_\_\_ Tape No.

WEATHER

Clear \_\_\_\_\_  
Cloudy \_\_\_\_\_  
Windy \_\_\_\_\_  
Rain \_\_\_\_\_  
Fair \_\_\_\_\_  
Snow \_\_\_\_\_  
Hot \_\_\_\_\_  
Moderate \_\_\_\_\_  
Cold \_\_\_\_\_  
Fog \_\_\_\_\_

FILE No. 160-621

Fldr. No. \_\_\_\_\_

Figured By \_\_\_\_\_ Sheet 1 OF 4

Notes Checked By \_\_\_\_\_

Plotted By \_\_\_\_\_ Date 3/14 1947

Quad. No. \_\_\_\_\_

| Station | Dist. | Angle " | + | H. I.<br>Bearing | Ver: Ang.<br>Diff. | Elevation |
|---------|-------|---------|---|------------------|--------------------|-----------|
|---------|-------|---------|---|------------------|--------------------|-----------|

MICHAEL ROAD

WELL # 8

↑ 2.2  
← 0.3 →

WELL # 603

↑ 5.3  
← 3.8 →

HOLCOMB BLVD.

HOLCOMB BLVD.

WELL # 601

↑ 4.6  
← 4.6 →

HOLCOMB BLVD.

HOLCOMB BLVD.

WELL # 602

↑ 8.7  
← 6.5 →

HOLCOMB BLVD.

HOLCOMB BLVD.












VALUABLE

SUBJECT LOCATION OF WATER  
METERS BY PUMPING  
STATION

Return To  
 Public Works  
 Office  
 Camp Lejeune  
 North Carolina



FIELD PARTY  
DENNIS In Charge  
 \_\_\_\_\_ Instrument  
 \_\_\_\_\_ Notes  
 \_\_\_\_\_ Tape Read  
 \_\_\_\_\_ Tape or Rod  
 \_\_\_\_\_ Tape or Rod  
 \_\_\_\_\_ Instrument No.  
 \_\_\_\_\_ Tape No.

WEATHER  
 Clear \_\_\_\_\_  
 Cloudy \_\_\_\_\_  
 Windy \_\_\_\_\_  
 Rain \_\_\_\_\_  
 Fair \_\_\_\_\_  
 Snow \_\_\_\_\_  
 Hot \_\_\_\_\_  
 Moderate \_\_\_\_\_  
 Cold \_\_\_\_\_  
 Fog \_\_\_\_\_  
 Figured By \_\_\_\_\_  
 Notes Checked By \_\_\_\_\_  
 Plotted By \_\_\_\_\_

FILE No. \_\_\_\_\_  
 Fldr. No. \_\_\_\_\_  
 Sheet 2 OF 4  
 Date 3/14 1947

Quad. No. \_\_\_\_\_

| Station | Dist. | Angle<br>" " | + | H. I.<br>Bearing | Ver: Ang.<br>Diff. | Elevation |
|---------|-------|--------------|---|------------------|--------------------|-----------|
|---------|-------|--------------|---|------------------|--------------------|-----------|

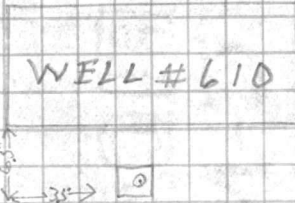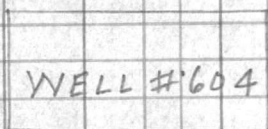


HOLCOMB BLVD.

HOLCOMB BLVD.

HOLCOMB BLVD.

HOLCOMB BLVD.

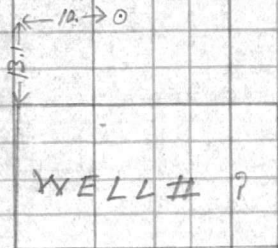

WELL# ?













VALUABLE

Return To  
Public Works  
Office  
Camp Lejeune  
North Carolina

SUBJECT LOCATION OF WATER  
METERS BY PUMPING  
STATION.


FIELD PARTY  
DENNIS In Charge  
Instrument \_\_\_\_\_  
Notes \_\_\_\_\_  
Tape Read \_\_\_\_\_  
Tape or Rod \_\_\_\_\_  
Tape or Rod \_\_\_\_\_  
Instrument No. \_\_\_\_\_  
Tape No. \_\_\_\_\_

WEATHER  
Clear \_\_\_\_\_  
Cloudy \_\_\_\_\_  
Windy \_\_\_\_\_  
Rain \_\_\_\_\_  
Fair \_\_\_\_\_  
Snow \_\_\_\_\_  
Hot \_\_\_\_\_  
Moderate \_\_\_\_\_  
Cold \_\_\_\_\_  
Fog \_\_\_\_\_  
Figured By \_\_\_\_\_  
Notes Checked By \_\_\_\_\_  
Plotted By \_\_\_\_\_

FILE No. \_\_\_\_\_  
Fldr. No. \_\_\_\_\_  
Sheet 4 D F 4  
Date 3/14 1947


Quad. No. \_\_\_\_\_

Station    Dist.    ° Angle "    +    H. I. Bearing    Ver: Ang. Diff.    Elevation

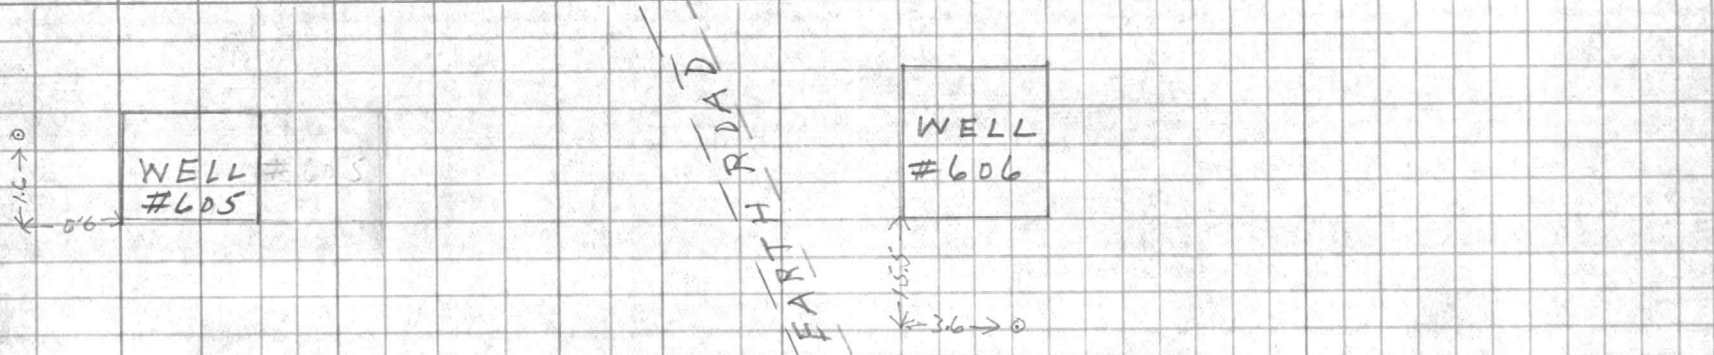

SNEADS FERRY ROAD

SNEADS FERRY ROAD

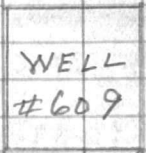

SNEADS FERRY ROAD

AVAILABLE  
Return To  
Public Works  
Office  
Camp Lejeune  

SUBJECT

\_\_\_\_\_  
\_\_\_\_\_  
\_\_\_\_\_

Station - Dist.





FIELD PARTY

IN Charge \_\_\_\_\_

Assistant \_\_\_\_\_

\_\_\_\_\_

\_\_\_\_\_

\_\_\_\_\_

\_\_\_\_\_

\_\_\_\_\_

\_\_\_\_\_

WEATHER

Clear \_\_\_\_\_

Cloudy \_\_\_\_\_

\_\_\_\_\_

\_\_\_\_\_

\_\_\_\_\_

\_\_\_\_\_

\_\_\_\_\_

\_\_\_\_\_

FILE NO

\_\_\_\_\_

\_\_\_\_\_

\_\_\_\_\_

\_\_\_\_\_

\_\_\_\_\_

\_\_\_\_\_

\_\_\_\_\_

\_\_\_\_\_