

VALUABLE

SUBJECT LOCATION BUTLER
BLDG. TANK PARK
AREA.
Bldg. # 816


RETURN TO
 PUBLIC WORKS
 OFFICE
 CAMP LEJEUNE
 NORTH CAROLINA

FIELD PARTY
DENNIS IN CHARGE
MORTON INSTRUMENT
DENNIS NOTES
PADRICK TAPE READ
DENNIS TAPE OR ROD
 TAPE OR ROD
 INSTRUMENT No. _____
 TAPE No. _____

WEATHER
 CLEAR _____ SNOW _____
 CLOUDY _____ HOT _____
 WINDY _____ MODERATE _____
 RAIN _____ COLD _____
 FAIR _____ FOG _____
 FIGURED BY _____
 NOTES CHECKED BY _____
 PLOTTED BY _____

FILE No. _____
 FLDR. No. _____
 SHEET 1 of 1
 DATE 6-30 1958

Quad. No. _____

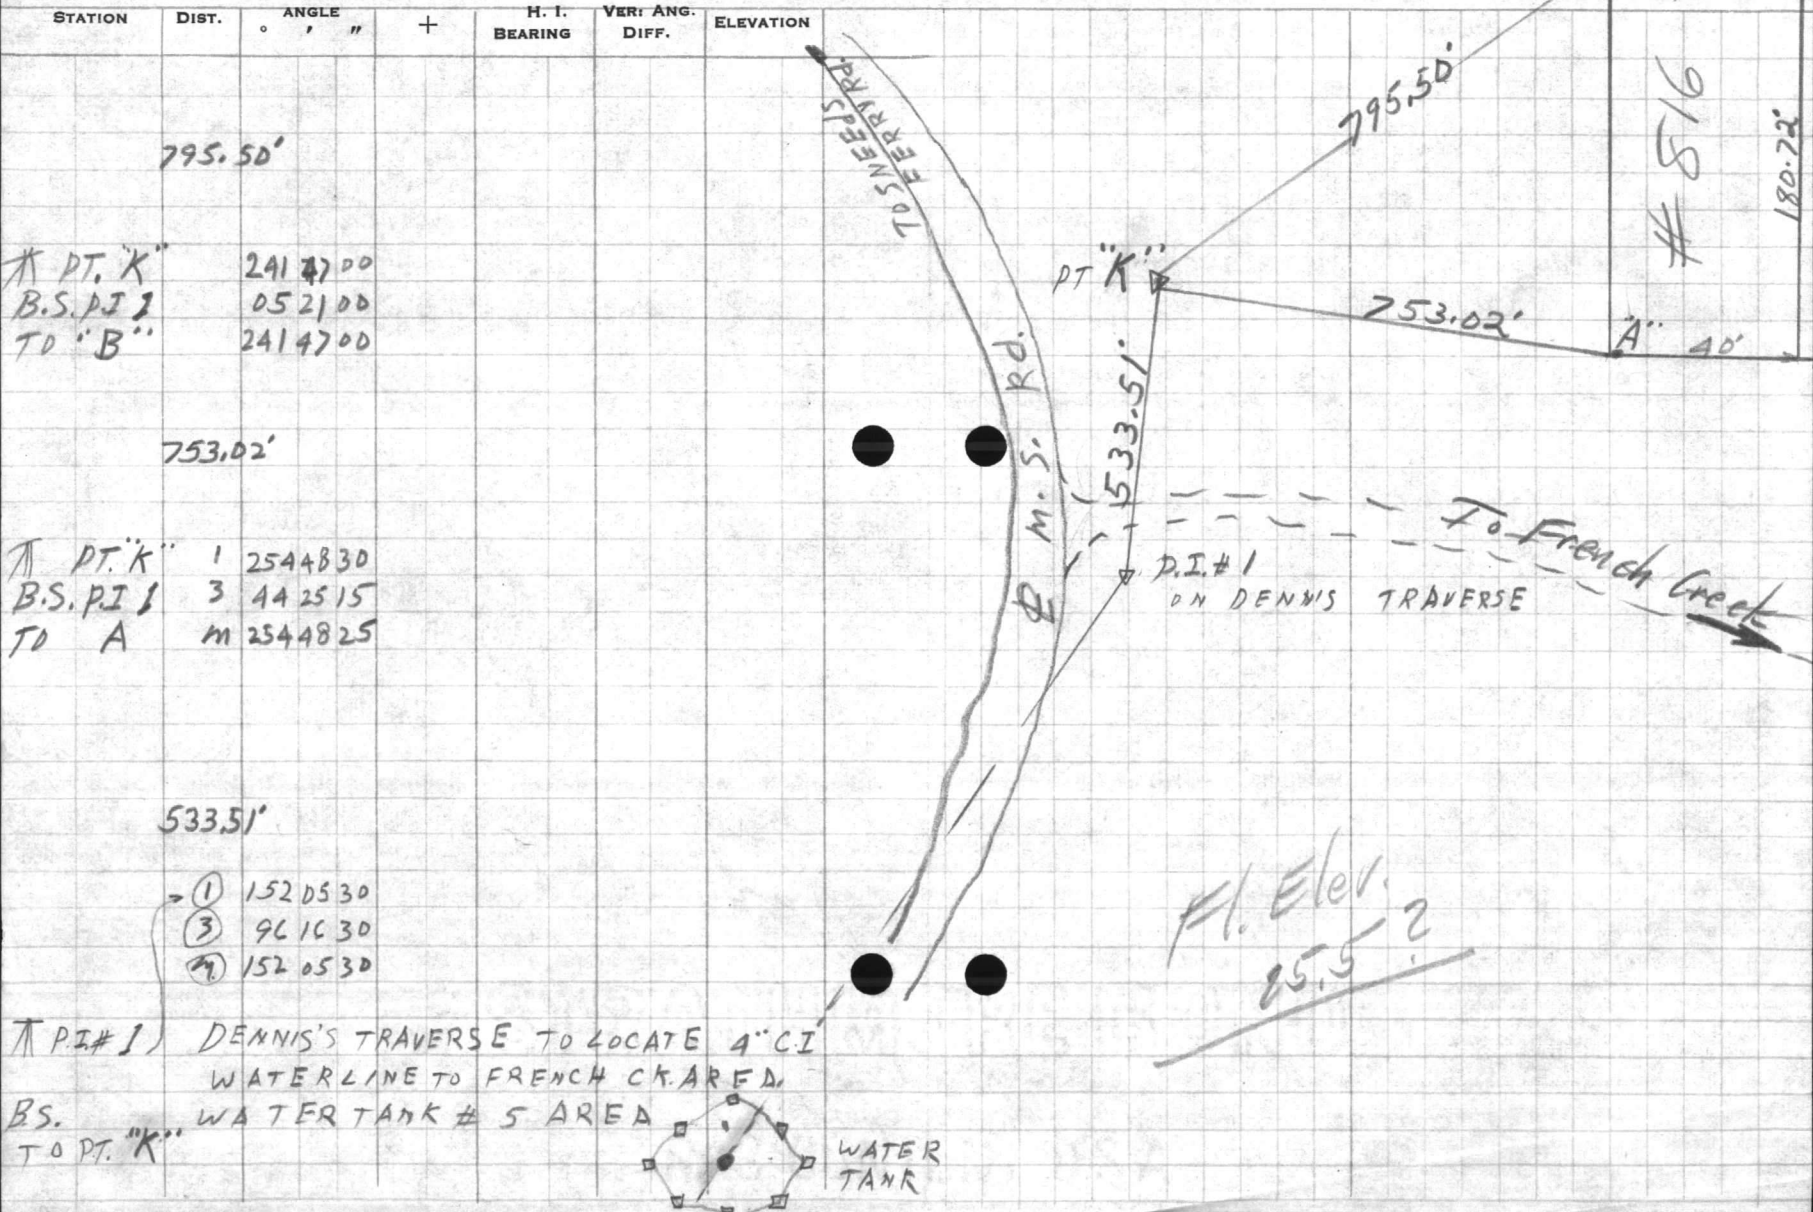

STATION	DIST.	ANGLE ° ' "	+	H. I. BEARING	VER. ANG. DIFF.	ELEVATION
* PT. "K"	241 47 00					
B.S. PI 1	05 21 00					
TO "B"	241 47 00					
	753.02'					
* PT. "K"	1 25 44 30					
B.S. PI 1	3 44 25 15					
TO A	m 25 44 25					
	533.51'					
①	152 05 30					
③	96 16 30					
④	152 05 30					
* PI # 1	DENNIS'S TRAVERSE TO LOCATE 4" CI WATERLINE TO FRENCH CREEK AREA.					
B.S.	WATER TANK # 5 AREA					
TO PT. "K"						

STATION
DATE
TIME
OFFICER
SERIAL NO.
REMARKS

FIELD PARTY
IN CHARGE
MEMBER
WEATHER
MILEAGE
TIME
FUEL
EQUIPMENT
OTHER







VALUABLE
 RETURN TO
 PUBLIC WORKS
 OFFICE
 CAMP LEJEUNE
 NORTH CAROLINA

SUBJECT

 Location Water Line from
 Main Service to Franckes
 Creek along Power Line

FIELD PARTY

 IN CHARGE
 INSTRUMENT
 NOTES
 TAPE READ
 TAPE OR ROD
 TAPE OR ROD
 INSTRUMENT No.
 TAPE No.

WEATHER

 CLEAR
 CLOUDY
 WINDY
 RAIN
 FAIR

 SNOW
 HOT
 MODERATE
 COLD
 FOG

FILE No. 160 B

FLDR. No.

SHEET 1 of 1

DATE 2/1 1953



FIGURED BY

NOTES CHECKED BY

PLOTTED BY

Quad. No.

STATION	DIST.	ANGLE ' "	+	H. I. BEARING	VER. ANG. DIFF.	ELEVATION
---------	-------	--------------	---	------------------	--------------------	-----------

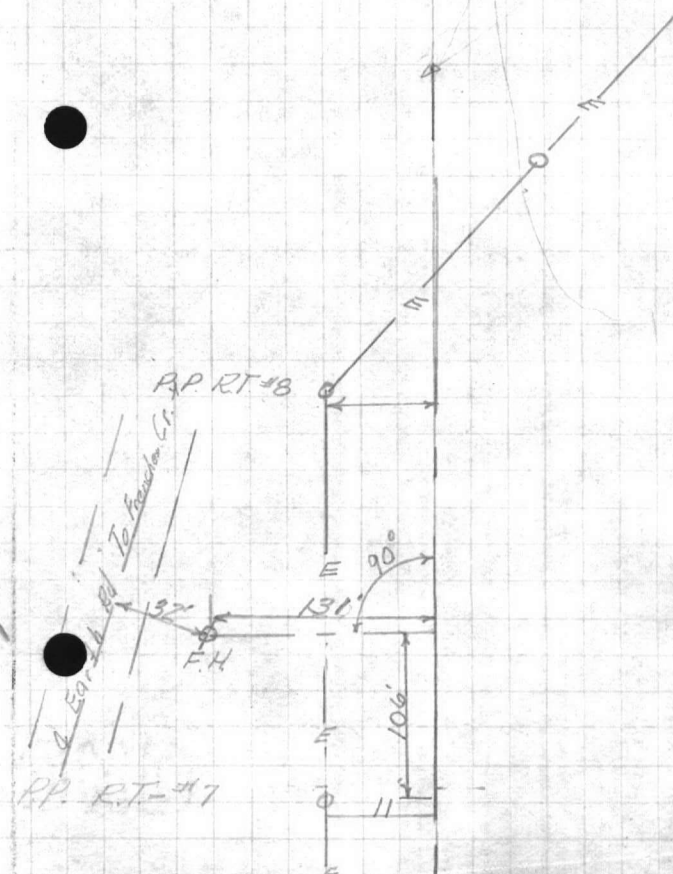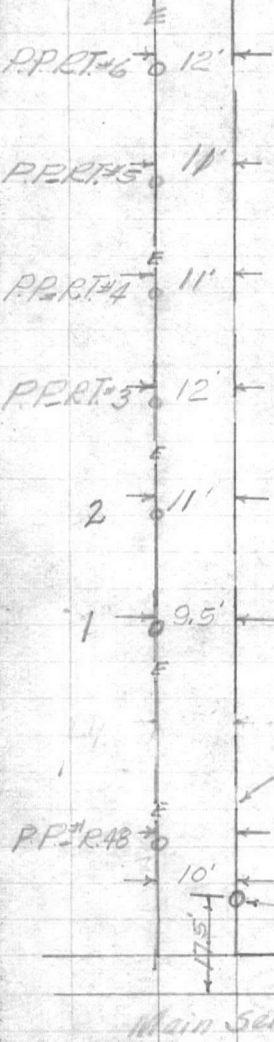























11
























VALUABLE

SUBJECT TRAVERSE TO LOCATE
6" WATER LINE TO FRENCH
CREEK

RETURN TO
PUBLIC WORKS
OFFICE
CAMP LEJEUNE
NORTH CAROLINA

FIELD PARTY
DENNIS IN CHARGE
MORTON INSTRUMENT
MORTON NOTES

WEATHER
CLEAR CLOUDY
WINDY MODERATE
RAIN COLD
FAIR FOG
FIGURED BY _____
NOTES CHECKED BY _____
PLOTTED BY _____

FILE No. _____
FLDR. No. _____
SHEET 1 of
DATE 2/13 1955

TAPE READ _____
TAPE OR ROD _____
TAPE OR ROD _____
INSTRUMENT NO. _____
TAPE NO. _____

Quad. No. _____

STATION	DIST.	ANGLE		H. I.	VER. ANG.	ELEVATION
		' "	+	BEARING	DIFF.	


191027

K of P.I. #1 82 39 45 (1)
BS. P.T. 72+30³³ 247 58 30 (3)
Ahead P.I. #2 82 39 30 (M)

18826

K of P.T. 72+30³³ 349 28 15 (1)
BS. P.C. 65+14⁴³ 328 25 00 (3)
Ahead P.I. #1 349 28 20 (M)

STA. 16+82'
3" LT. WATER
VALVE

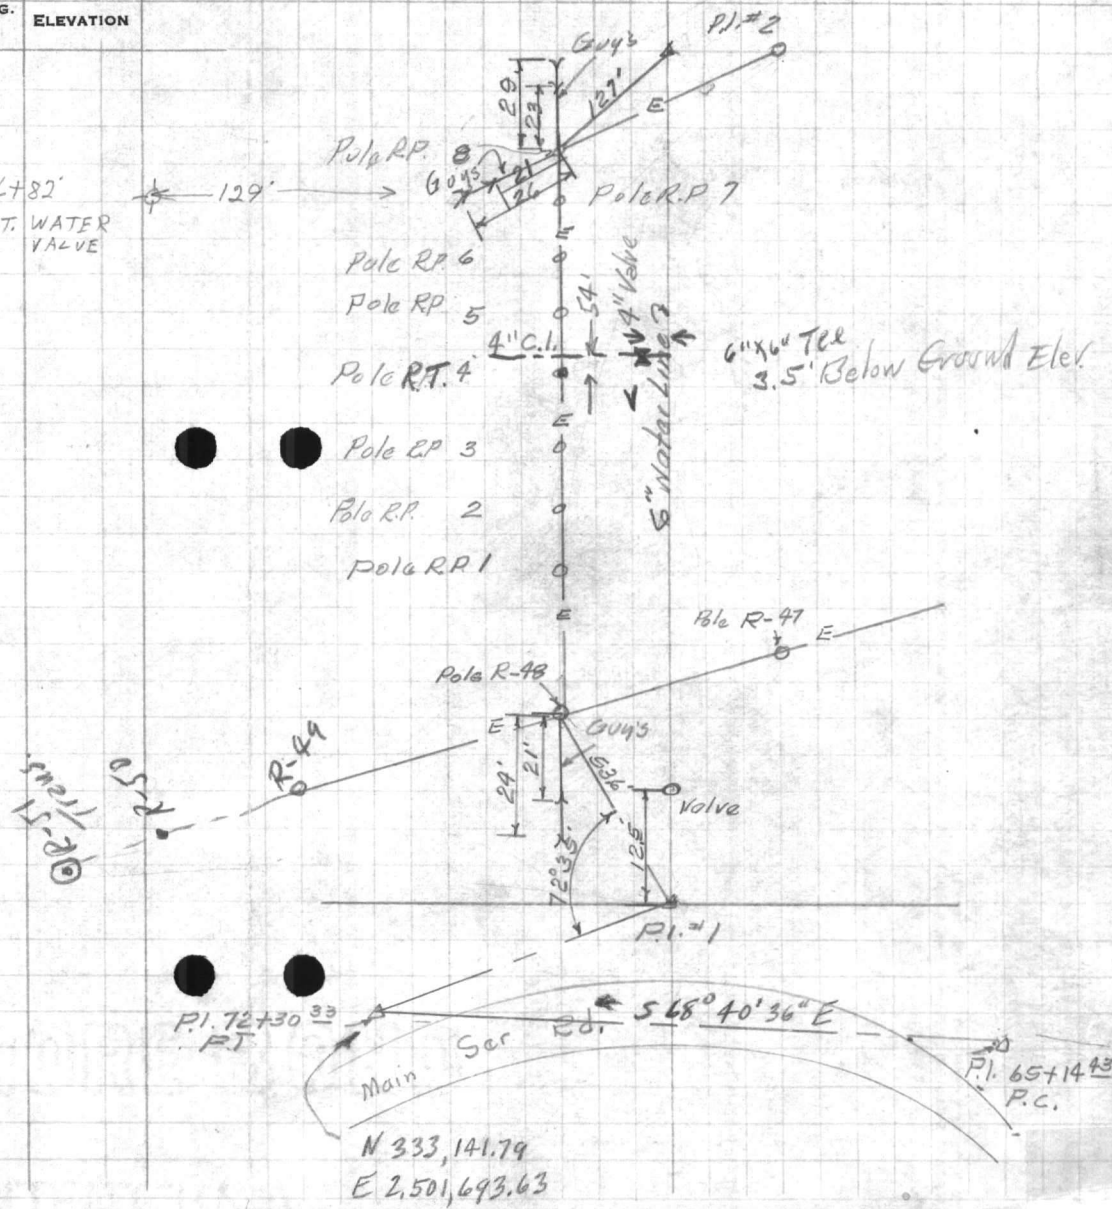






























VALUABLE

SUBJECT _____

RETURN TO
 PUBLIC WORKS
 OFFICE
 CAMP LEJEUNE
 NORTH CAROLINA

FIELD PARTY

 IN CHARGE

 INSTRUMENT

 NOTES

 TAPE READ

 TAPE OR ROD

 TAPE OR ROD

 INSTRUMENT NO. _____
 TAPE NO. _____

WEATHER

CLEAR _____ SNOW _____
 CLOUDY _____ HOT _____
 WINDY _____ MODERATE _____
 RAIN _____ COLD _____
 FAIR _____ FOG _____

FILE No. _____
 FLDR. No. _____
 FIGURED BY _____ SHEET 2 of
 NOTES CHECKED BY _____
 PLOTTED BY _____ DATE _____ 19__

Quad. No. _____

STATION	DIST.	ANGLE ° ' "	+	H. I. BEARING	VER. ANG. DIFF.	ELEVATION
	306 ⁸⁸					
Nat P.I. #4		188 46 45				
		206 20 30				
		188 46 50				
	2107 ⁴³					
Nat P.I. #3		187 32 00	①			
		202 36 00	③			
		187 32 00	④			
	573 ⁶¹					
Nat P.I. #2		203 31 00	①			
		250 33 00	③			
		203 31 00	④			



① 187 32 00

202
360

③ 202 36 00

$$\begin{array}{r}
 3 \overline{) 562} \quad 187 \\
 \underline{3} \\
 26 \\
 \underline{24} \\
 22 \\
 \underline{21} \\
 1
 \end{array}$$

$$\begin{array}{r}
 60 \\
 36 \\
 \hline
 3 \overline{) 96} \quad (32) \\
 \underline{9} \\
 6 \\
 \underline{6} \\
 0
 \end{array}$$

5 39 45 W

~~N-9945~~

① 188 46 45

③ 206 20 30

$$\begin{array}{r}
 3 \overline{) 566} \quad 188 \\
 \underline{3} \\
 26 \\
 \underline{24} \\
 26 \\
 \underline{24} \\
 2
 \end{array}$$

$$\begin{array}{r}
 01 \\
 \hline
 3 \overline{) 610} \quad 203 \\
 \underline{09} \\
 098 \\
 \underline{098} \\
 000
 \end{array}$$

$$\begin{array}{r}
 206 \\
 360 \\
 \hline
 3 \overline{) 566} \quad 188 \\
 \underline{3} \\
 26 \\
 \underline{24} \\
 26 \\
 \underline{24} \\
 2
 \end{array}$$

$$\begin{array}{r}
 120 \\
 20 \\
 \hline
 3 \overline{) 140} \quad 46 \\
 \underline{12} \\
 20 \\
 \underline{18} \\
 2
 \end{array}$$

$$\begin{array}{r}
 120 \\
 30 \\
 \hline
 3 \overline{) 150} \quad 50 \\
 \underline{15} \\
 00
 \end{array}$$

③ 250 33 00
① 203 31 00

VALUABLE
 SUBJECT _____

 RETURN TO
 PUBLIC WORKS
 OFFICE
 CAMP LEJEUNE
 NORTH CAROLINA

FIELD PARTY

 _____ IN CHARGE
 _____ INSTRUMENT
 _____ NOTES
 _____ TAPE READ
 _____ TAPE OR ROD
 _____ TAPE OR ROD
 _____ INSTRUMENT NO.
 _____ TAPE NO.

WEATHER

 CLEAR
 CLOUDY
 WINDY
 RAIN
 FAIR

 SNOW
 HOT
 MODERATE
 COLD
 FOG

 FILE No. _____
 FLDR. No. _____
 SHEET 3 of _____
 DATE _____ 19__

 FIGURED BY _____
 NOTES CHECKED BY _____
 PLOTTED BY _____
 Quad. No. _____

STATION	DIST.	ANGLE			H. I. BEARING	VER: ANG. DIFF.	ELEVATION
		°	'	"			

AT MDN#400	1	229	00	15			
B.S. PI#5	3	327	00	30			
TO CUPLO NAVAL HOSP.	M	229	00	10			

416.33

AT PI#5	1	228	05	00			
B.S. PI#5	3	324	14	15			
TO MDN#400	M	228	04	45			

 N 328,801.63
 E 2,499,312.90

 MDN.
 #400

PI#5

 N 39° 37' 42" W
 TO CUPLO
 NAVAL HOSP.




























VALUABLE

SUBJECT _____

RETURN TO
 PUBLIC WORKS
 OFFICE
 CAMP LEJEUNE
 NORTH CAROLINA

FIELD PARTY

 IN CHARGE

 INSTRUMENT

 NOTES

 TAPE READ

 TAPE OR ROD

 TAPE OR ROD

 INSTRUMENT No. _____
 TAPE No. _____


WEATHER

CLEAR _____
 CLOUDY _____
 WINDY _____
 RAIN _____
 FAIR _____
 SNOW _____
 HOT _____
 MODERATE _____
 COLD _____
 FOG _____

FILE No. _____
 FLDR. No. _____
 SHEET 1 of
 DATE 2/23 1950
 FIGURED BY _____
 NOTES CHECKED BY _____
 PLOTTED BY _____

Quad. No. _____

STATION	DIST.	ANGLE ° ' "	+	H. I. BEARING	VER: ANG. DIFF.	ELEVATION
---------	-------	----------------	---	------------------	--------------------	-----------

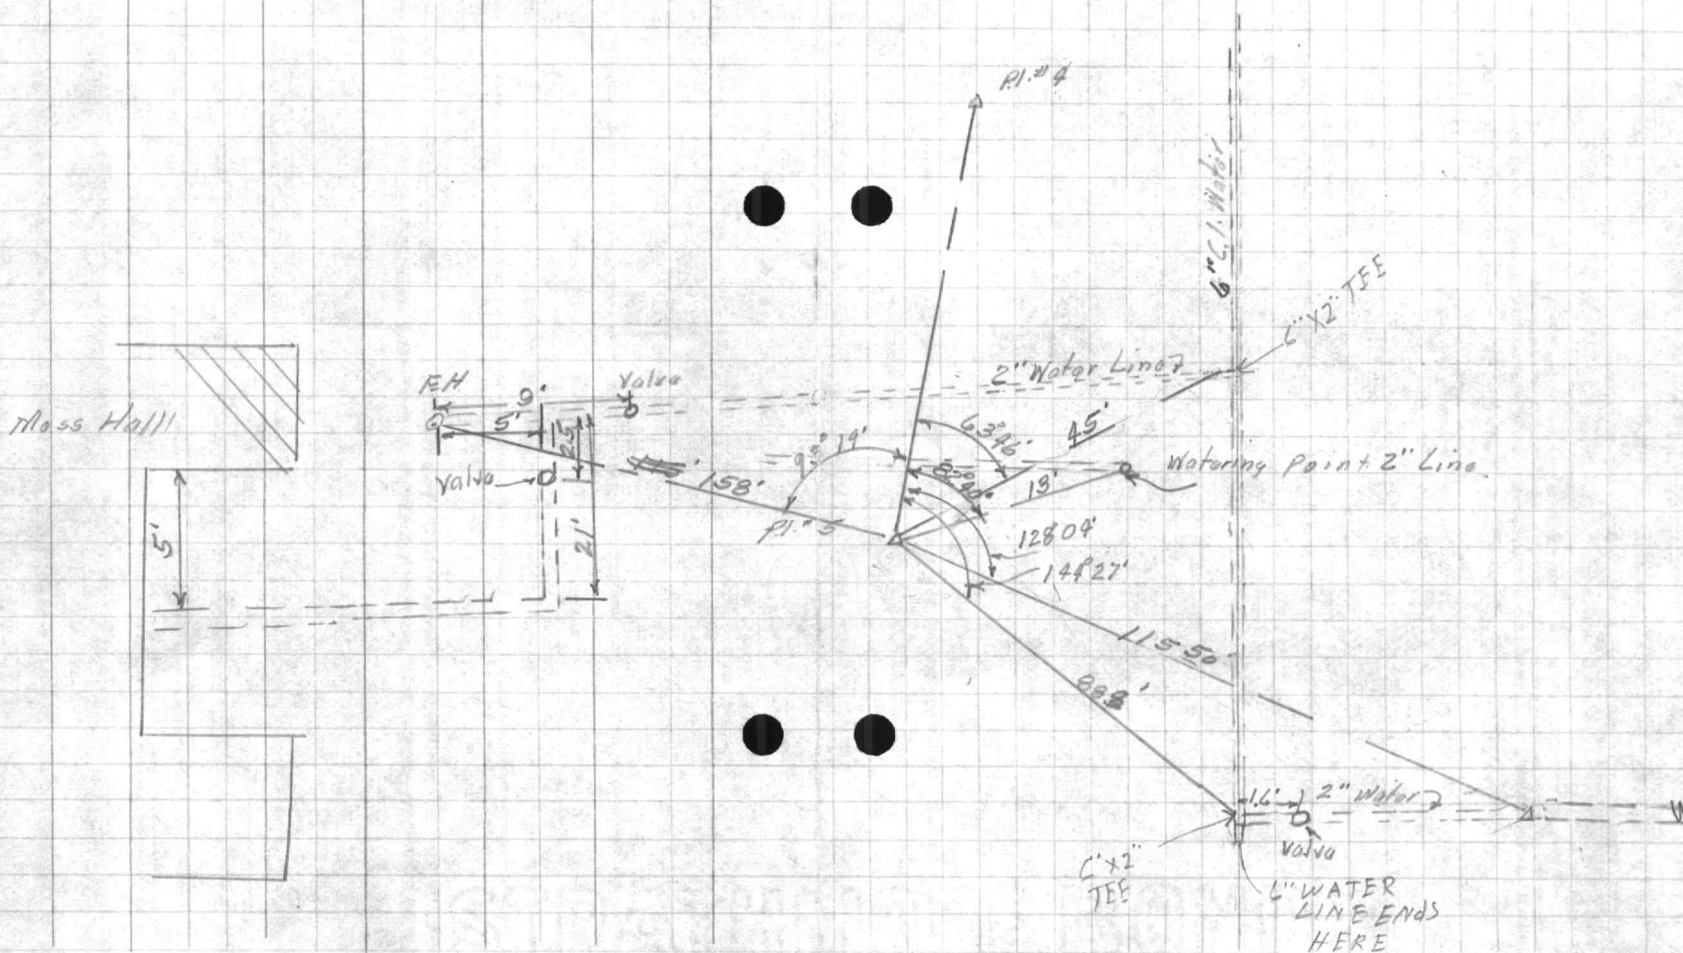

































VALUABLE

SUBJECT _____

RETURN TO
PUBLIC WORKS
OFFICE
CAMP LEJEUNE
NORTH CAROLINA

FIELD PARTY

IN CHARGE

INSTRUMENT

NOTES

TAPE READ

TAPE OR ROD

TAPE OR ROD

INSTRUMENT NO.

TAPE NO.

WEATHER


CLEAR
CLOUDY
WINDY
RAIN
FAIR

SNOW
HOT
MODERATE
COLD
FOG

FILE No. _____
FLDR. No. _____
SHEET _____
DATE _____ 19__

FIGURED BY _____
NOTES CHECKED BY _____
PLOTTED BY _____
Quad. No. _____


STATION	DIST.	ANGLE ° ' "	+	H. I. BEARING	VER: ANG. DIFF.	ELEVATION
---------	-------	----------------	---	------------------	--------------------	-----------

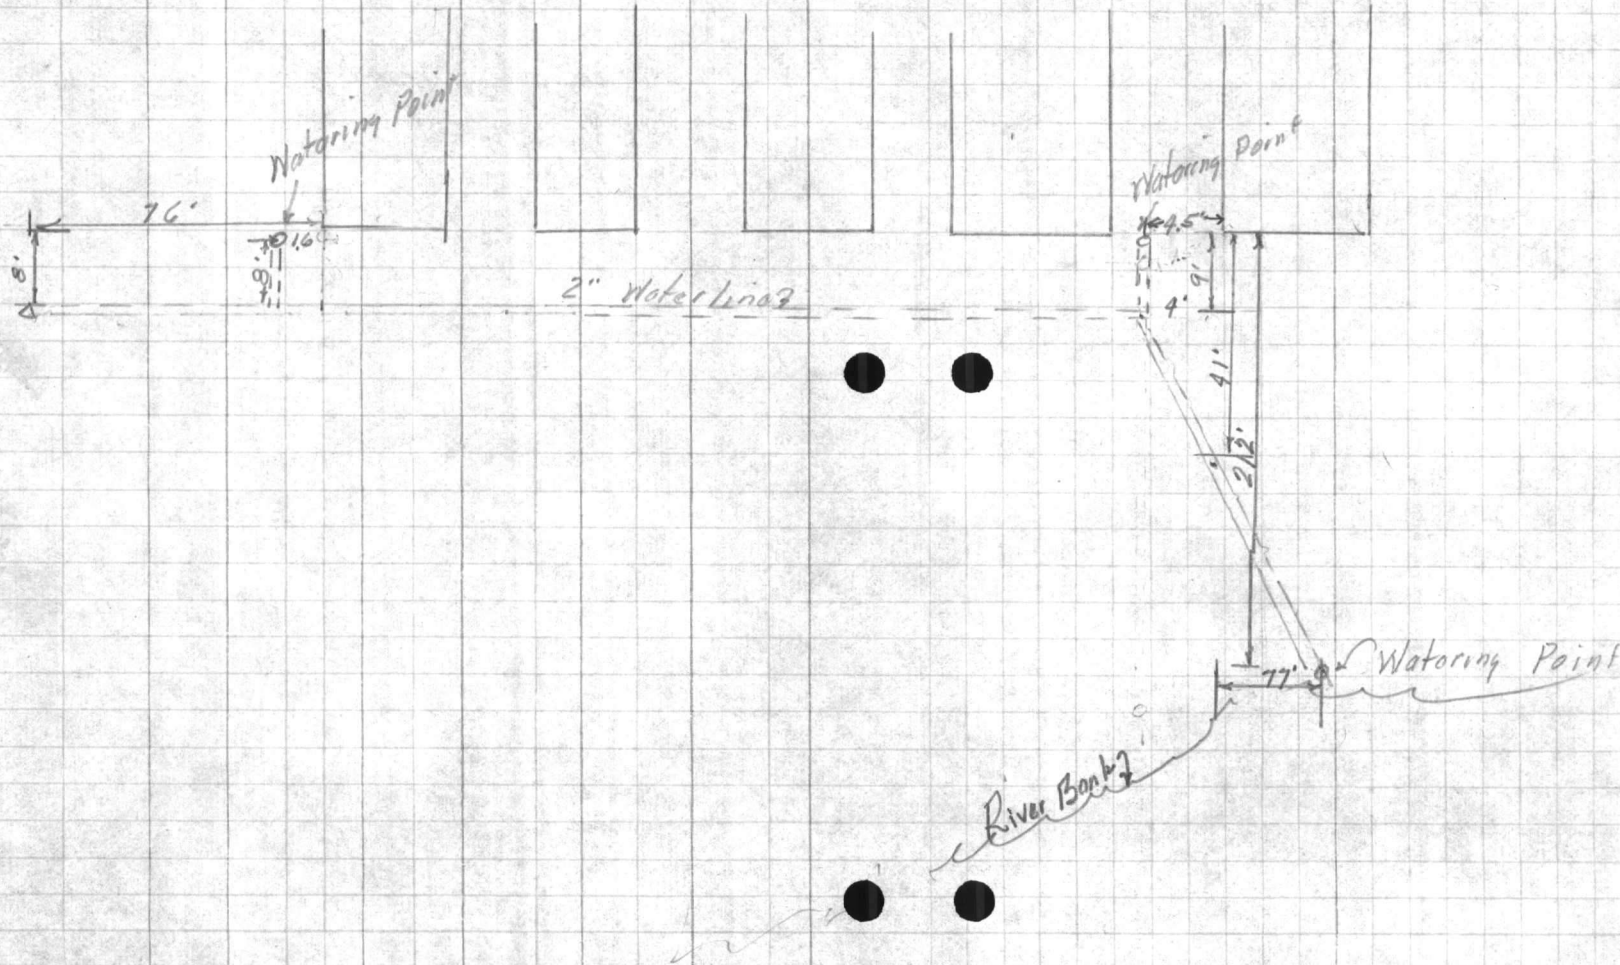




 

PUBLIC WORKS DEPARTMENT
Camp Lejeune, North Carolina
Survey Department

File
Quadrangle
Date 2-29-55
Sheet 2 of 2

Traverse Computation
Description

Station	Distance	Bearing	Cosine	Sine	Latitude	Departure	Y Coordinate North	X Coordinate East
P.I. #4							329,015.04	2,499,939.47
P.I. #5	306.88	S 43-17-04 W	7279589	6856207	223.32	210.40	328,791.72	2,499,729.08
6" x 2" TEE	45.00	S 72-56-56 E	2932247	9560436	13.20	43.02	328,778.52	2,499,772.10
WATERING POINT - 2" LINE	13.00	S 54-02-56 E	5870947	8095182	7.63	10.52	328,784.09	2,499,739.60
POINT ON 2" WATER LINE	115.50	S 8-38-56 E	9886284	1503790	114.19	17.37	328,677.53	2,499,746.45
V 6" x 2" TEE	88.8	S 7-44-04 W	9909025	1345819	87.99	11.95	328,703.73	2,499,717.13
V FIRE HYDRANT	158.00	N 50-01-56 W	6423567	7664058	101.49	121.09	328,893.21	2,499,607.99
MON. #400	416.32	N 88-38-11 W	0237973	9997168	9.91	416.2	328,801.63	2,499,312.90
							328,800.01	2,499,312.76
							- 1.62	- 0.14
							Adjusted	
TO CUPOLA AT MAIN BLDG. U.S.N. HOSPITAL		N 39-37-42 W						
		39-38-01						

+ 0' 19" Error
NOT Adjusted

PUBLIC WORKS DEPARTMENT
 Camp Lejeune, North Carolina
 Survey Department

Traverse Description
 Station

Distance	Bearing	Course	Latitude	Departure	Y Coordinate	X Coordinate

File

Station

Date

Sheet

of

X Coordinate

West

North

Y Coordinate

Departure

Latitude

Sign

Course

Bearing

Distance

Station

Traverse Description

VALUABLE

RETURN TO
PUBLIC WORKS
OFFICE
CAMP LEJEUNE
NORTH CAROLINA

SUBJECT BENCH. MARKS
FRENCH CREEK AREA
(MON.# 401) TO NORTH
MOST BOLT. NORTH MOST PILLAR
WATER TANK DIV. SHOP AREA

FIELD PARTY
DENNIS IN CHARGE
DENNIS INSTRUMENT
DENNIS NOTES
PATRICK TAPE READ
TAPE OR ROD
TAPE OR ROD
INSTRUMENT NO. _____
TAPE NO. _____

WEATHER
CLEAR _____
CLOUDY _____
WINDY _____
RAIN _____
FAIR _____
SNOW _____
HOT _____
MODERATE _____
COLD _____
FOG _____
FIGURED BY _____
NOTES CHECKED BY _____
PLOTTED BY _____

FILE No. 160-R
FLDR. No. _____
SHEET 1 of 3
DATE 5-10 1955

Quad. No. _____

STATION	DIST.	ANGLE ° ' "	+	H. I. BEARING	VER: ANG. DIFF.	ELEVATION
B.M.		467	30	23	✓	25.56
T.P.#1					8.56	21.67
		332	24	99	✓	
T.P.					3.73	21.26
		597	27	23	✓	
B.M.#1					3.31	23.92
		276	26	68	✓	
T.P.					3.46	23.22
		551	28	73	✓	
T.P.					3.25	25.48
		402	29	50	✓	
T.P.					3.98	25.52
		406	29	58	✓	
B.M.					4.17	25.41
		440	29	81	✓	
T.P.					7.34	22.47

MON.# 401

SPIKE IN 14" PINE LOG LT. & MARLRD TO FRENCH CREEK, APPROX. 75' NORTH FIRST MARL ROAD TO RIGHT.

SQUARE IN CONCRETE 15.2' FT. SOUTH OF N.W. COR. F.C. 9



































VALUABLE

SUBJECT _____

RETURN TO
PUBLIC WORKS
OFFICE
CAMP LEJEUNE
NORTH CAROLINA

FIELD PARTY

IN CHARGE

INSTRUMENT

NOTES

TAPE READ

TAPE OR ROD

TAPE OR ROD

INSTRUMENT NO.

TAPE NO.

WEATHER

CLEAR
CLOUDY
WINDY
RAIN
FAIR

SNOW
HOT
MODERATE
COLD
FOG

FILE No. _____

FLDR. No. _____

FIGURED BY _____ SHEET 2 of 3

NOTES CHECKED BY _____

PLOTTED BY _____ DATE _____ 19__

Quad. No. _____

STATION	DIST.	ANGLE ' "	+	H. I. BEARING	VER. ANG. DIFF.	ELEVATION	
				651 28 98	✓	22 47	✓
B.M.#3					3 76	25.22	(R.T. 8) SPIKE IN POWER POLE (ANGLE) EAST SIDE ✓
				340 28 62	✓		
T.P.					2 56	26 06	
				0 10 26 16	✓		
T.P.					8 52	17 64	
				5 31 22 95	✓		
T.P.					0 55	22 40	
				5 95 28 35	✓		
B.M.#4					2 54	25.81	Bldg. #746 Quonset Hut FLOOR & DOOR WEST END PIPE
					(25.62)		" " " " #746 #
				2 23 28 04	✓		" " " " " Butler Bldg. #739
T.P.					9 97	18.07	
				1 03 19 10	✓		
T.P.					8 04	11 19.06	
				2 28 13 12.34	✓		
B.M.#5					3 00	10 9.34	MAIN POWER POLE # R-42 NEAR END OF PIPES UNDER RD. Coddell Lk. SOUTH SIDE







VALUABLE

SUBJECT _____

RETURN TO
PUBLIC WORKS
OFFICE
CAMP LEJEUNE
NORTH CAROLINA

FIELD PARTY

IN CHARGE

INSTRUMENT

NOTES

TAPE READ

TAPE OR ROD

TAPE OR ROD

INSTRUMENT NO.

TAPE NO.

WEATHER

CLEAR
CLOUDY
WINDY
RAIN
FAIR
SNOW
HOT
MODERATE
COLD
FOG
FIGURED BY _____
NOTES CHECKED BY _____
PLOTTED BY _____

FILE No. _____

FLDR. No. _____

SHEET 3 of 3

DATE _____ 19__

Quad. No. _____

STATION	DIST.	ANGLE ° ' "	+	H. I. BEARING	VER. ANG. DIFF.	ELEVATION
B.M. #5			204	12 738	✓	10 9.34
T.P.					0 39	11 10 99 ✓
			635	18 734	✓	
T.P.					1 11	17 ✓ 16 23
			642	23 765	✓	
T.P.					2 79	20 ✓ 19 86
			7.08	27 26.94	✓	
T.P.					2 39	25 ✓ 24 55
			609	31 30.64	✓	
B.M.					2 79	28 ✓ 27 85

(28.85) MOST NORTHERN BOLT MOST NORTHERN
PILLOR WATER TANK DIV. SHOP AREA.










