

Conduit

Main

Serv.

Road








VALUABLE

RETURN TO
PUBLIC WORKS
OFFICE
CAMP LEJEUNE
NORTH CAROLINA

SUBJECT Elevs & profile on
cable & water line - tele.
conduit N.S.R. & S.F.R. int.

FIELD PARTY

IN CHARGE _____
INSTRUMENT _____
NOTES _____
TAPE READ _____
TAPE OR ROD _____
TAPE OR ROD _____
INSTRUMENT NO. _____
TAPE NO. _____

WEATHER

CLEAR _____ SNOW _____
CLOUDY _____ HOT _____
WINDY _____ MODERATE _____
RAIN _____ COLD _____
FAIR _____ FOG _____
FIGURED BY _____
NOTES CHECKED BY _____
PLOTTED BY _____

FILE No. _____

FLDR. No. _____

SHEET 1-04

DATE 12-4 1958

Quad. No. _____

STATION	DIST.	ANGLE ° ' "	+	H. I. BEARING	VER: ANG. DIFF.	ELEVATION	
B.M.						31.45	on oak tree 100' East of N.S.R. & S.F.R. int.
			2.00	34.45			
TOP of M.H. "B"					4.94	29.61	
					6.57	27.88	Top of cable outlet END M.H. "B"
					6.74	27.71	Bottom of conduit outlet END
					6.65	27.80	Bottom of conduit inlet END
3+68.59	On E				7.54	26.91	Top of water line
7+23.7	6' Left				5.88	28.57	Top of tele. cable
7+31	9' Left				8.24	26.21	Top of water line
P.I. 7+38.87	M.H. "C" E				5.96	28.49	Top of tele. cable
7+44	7.1 left				8.24	26.21	Top of water line
7+53.8	6.2 left				6.20	28.25	Top of tele. cable
<u>B.M.</u>					<u>3.00</u>	<u>31.45</u>	
7+28	19.1' ^{cor.} Rt. woods line						
7+63	10' Rt. Brush line						
	17' " Woods line						

VEICHAIE

1941

1941

VALUABLE

SUBJECT Topo. cont'd.

RETURN TO
PUBLIC WORKS
OFFICE
CAMP LEJEUNE
NORTH CAROLINA

FIELD PARTY

____ IN CHARGE
____ INSTRUMENT
____ NOTES
____ TAPE READ
____ TAPE OR ROD
____ TAPE OR ROD
____ INSTRUMENT NO.
____ TAPE NO.

WEATHER

CLEAR
CLOUDY
WINDY
RAIN
FAIR
SNOW
HOT
MODERATE
COLD
FOG
FIGURED BY _____
NOTES CHECKED BY _____
PLOTTED BY _____

FILE No. _____
FLDR. No. _____
SHEET 2-04
DATE 12-2 1958

Quad. No. _____

STATION	DIST.	ANGLE ° ' "	+	H. I. BEARING	VER: ANG. DIFF.	ELEVATION
7+84		5.5°	Rt.	Brush Line		
		15°	Rt.	Woods line		
8+05		6°	Rt.	con. Brush Line		
		14°	Rt.	Woods line		
8+17				Brush Line on E		
		5°	Lft.	Brush Line		
		16°	Rt.	Woods line		
				Pole is at edge of cut over brush		
				17' Rt. of pole edge of woods cut over brush between pole and woods line		
B.M.						31.45
				2.88	34.33	
7+38.87	M.H.C.				4.0	30.3
8+0					4.8	29.5
+15					4.6	29.7
+22					3.4	30.9
+5					2.7	31.6
B.M.					2.88	31.45

7+39
Road 10' wide
Woods Rd.
Has been cut over - stubbles approx 3' high

Ground at pole, pole

VALUABLE


































VALUABLE

SUBJECT

*stake out control
for Proposed Man Hole
"C"*

RETURN TO
PUBLIC WORKS
OFFICE
CAMP LEJEUNE
NORTH CAROLINA

FIELD PARTY

IN CHARGE _____
INSTRUMENT _____
NOTES _____
TAPE READ _____
TAPE OR ROD _____
TAPE OR ROD _____
INSTRUMENT No. _____
TAPE No. _____

WEATHER

CLEAR _____
CLOUDY _____
WINDY _____
RAIN _____
FAIR _____
SNOW _____
HOT _____
MODERATE _____
COLD _____
FOG _____

FILE No. _____

FLDR. No. _____

SHEET _____

FIGURED BY _____
NOTES CHECKED BY _____
PLOTTED BY _____

DATE *12-4* 19*58*

Quad. No. _____

STATION	DIST.	ANGLE		+	H. I. BEARING	VER: ANG. DIFF.	ELEVATION
		'	"				

TO Area "5"

*G
L*

M.S.R.

*Proposed
M.H. "C"*

TO Ind. Area

90°

48.17

"Nail"

Nail & cap

M.S.R.

R

10















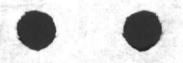


VALUABLE

SUBJECT

Location of New Tel. Cable
 Intersection of Main Service and
 Sneed's Ferry Roads

RETURN TO
 PUBLIC WORKS
 OFFICE
 CAMP LEJEUNE
 NORTH CAROLINA

See old Lync Notes for Ties
 Dated 5/28/57

FIELD PARTY

Dillon IN CHARGE

INSTRUMENT

NOTES

TAPE READ

TAPE OR ROD

TAPE OR ROD

INSTRUMENT No.

TAPE No.

WEATHER

CLEAR
 CLOUDY
 WINDY
 RAIN
 FAIR

SNOW
 HOT
 MODERATE
 COLD
 FOG

FIGURED BY

NOTES CHECKED BY

PLOTTED BY

FILE No.


FLDR. No.

SHEET

DATE 12/21 1958

Quad. No.

STATION	DIST.	ANGLE ° ' "	+	H. I. BEARING	VER. ANG. DIFF.	ELEVATION
R.M. on Oak Tree	3.28	34.73				31.45
Top of Cable at sta 7+35, 15' Lt.					6.1	28.6

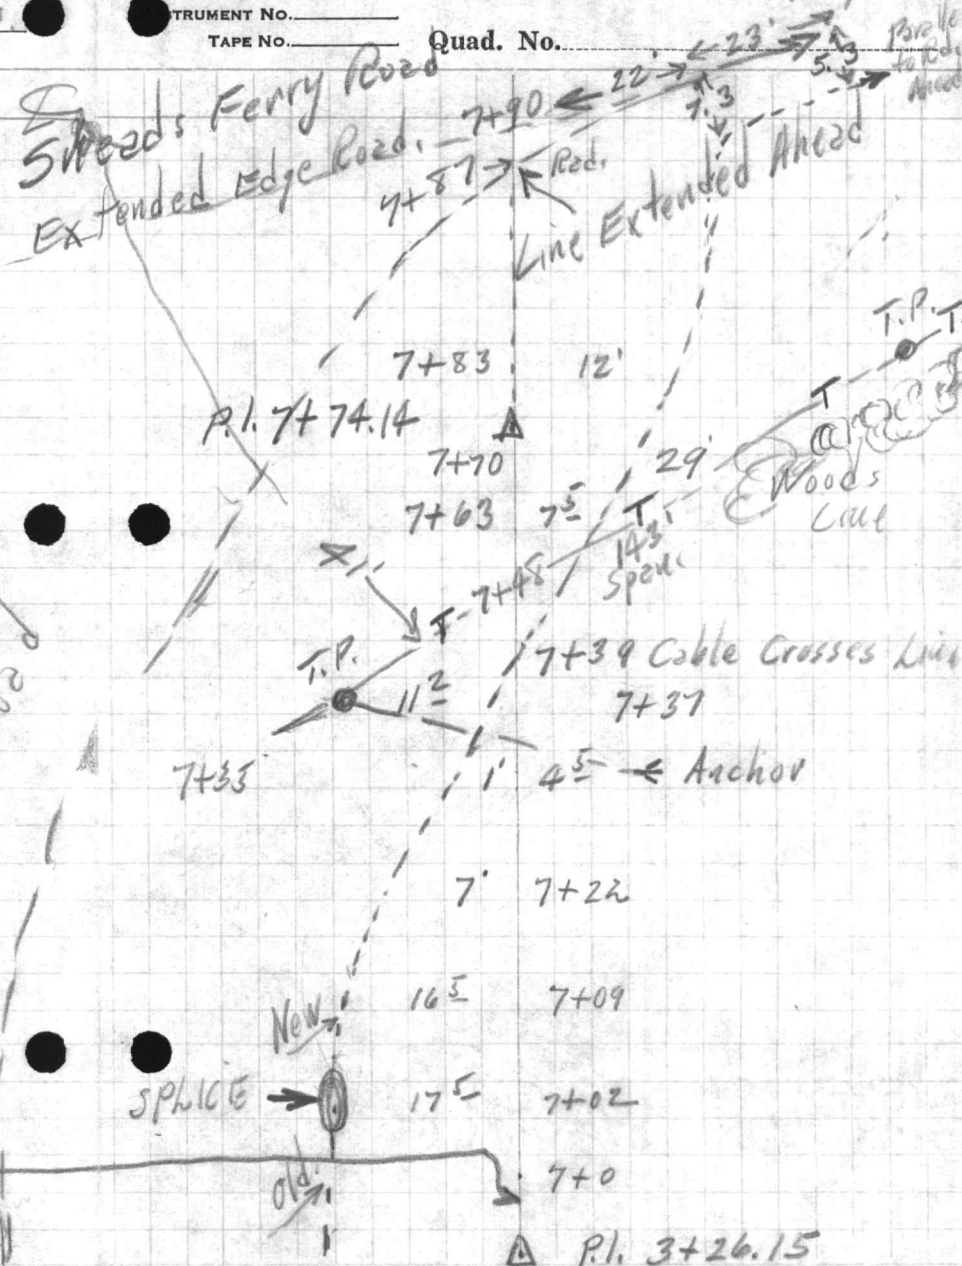

12" C.I. Water

Lt. ↑
 10' 7+31
 17' 7+15.5
 21' 6+92
 22' 6+59
 20' 6+33.5

Insert Main Service Road

SPlice

P.I. 3+26.15

VALUABLE

SUBJECT










VALUABLE

SUBJECT

Revised Loc. of
tele. conduit AT M.S.R.
& S.F.R. intersection

RETURN TO
PUBLIC WORKS
OFFICE
CAMP LEJEUNE
NORTH CAROLINA

FIELD PARTY
Kollar IN CHARGE
INSTRUMENT
NOTES
TAPE READ
TAPE OR ROD
TAPE OR ROD
INSTRUMENT No.
TAPE No.


WEATHER
CLEAR
CLOUDY
WINDY
RAIN
FAIR
SNOW
HOT
MODERATE
COLD
FOG
FIGURED BY
NOTES CHECKED BY
PLOTTED BY

FILE No. _____
FLDR. No. _____
SHEET 1-07
DATE 5-28-32

Quad. No. _____

STATION	DIST.	ANGLE ° ' "	+	H. I. BEARING	VER: ANG. DIFF.	ELEVATION
---------	-------	----------------	---	------------------	--------------------	-----------

3+26.15	1-186°50'00"
	3-200°30'30"
	MEAN. 186°50'10"

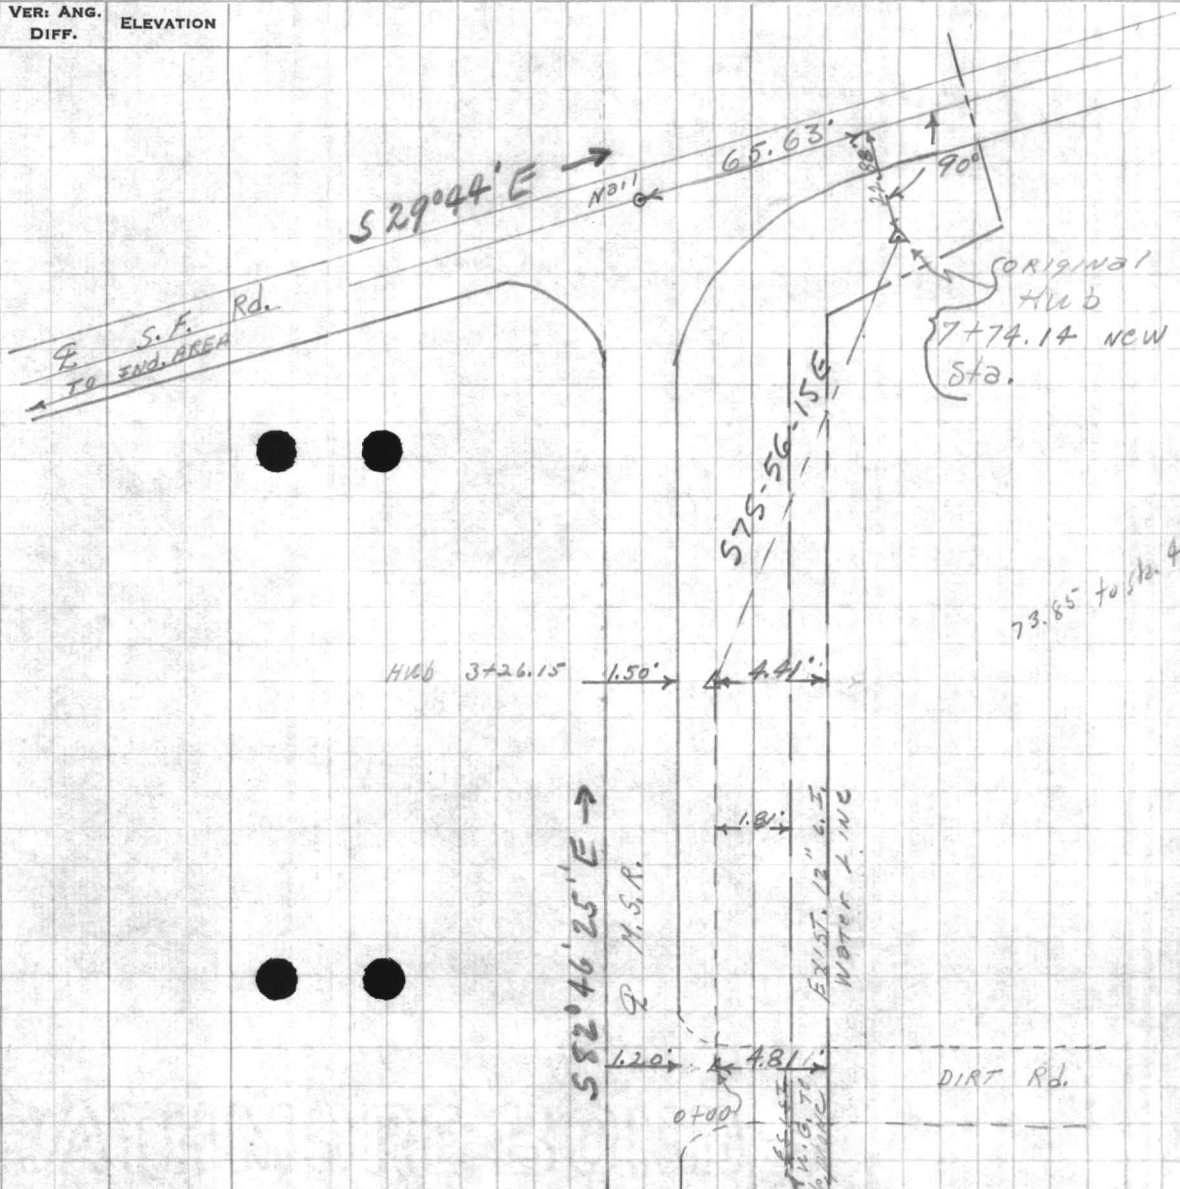

73.85 to sta. 4+0

10.4
4.5

5.9

186-50-00

3

560-30

300

200-30

VALUABLE

SUBJECT Revised Tele. conduit
Loc. contd.

RETURN TO
PUBLIC WORKS
OFFICE
CAMP LEJEUNE
NORTH CAROLINA

FIELD PARTY

_____ IN CHARGE
_____ INSTRUMENT
_____ NOTES
_____ TAPE READ
_____ TAPE OR ROD
_____ TAPE OR ROD
_____ INSTRUMENT NO.
_____ TAPE NO.

WEATHER

CLEAR _____
CLOUDY _____
WINDY _____
RAIN _____
FAIR _____

SNOW _____
HOT _____
MODERATE _____
COLD _____
FOG _____

FILE No. _____

FLDR. No. _____

SHEET 2 of

NOTES CHECKED BY _____

PLOTTED BY _____ DATE 5-28-57

Quad. No. _____

STATION	DIST.	ANGLE		+	H. I. BEARING	VER. ANG. DIFF.	ELEVATION
		°	"				

← TO IND. AREA SNEEDS FERRY RD.




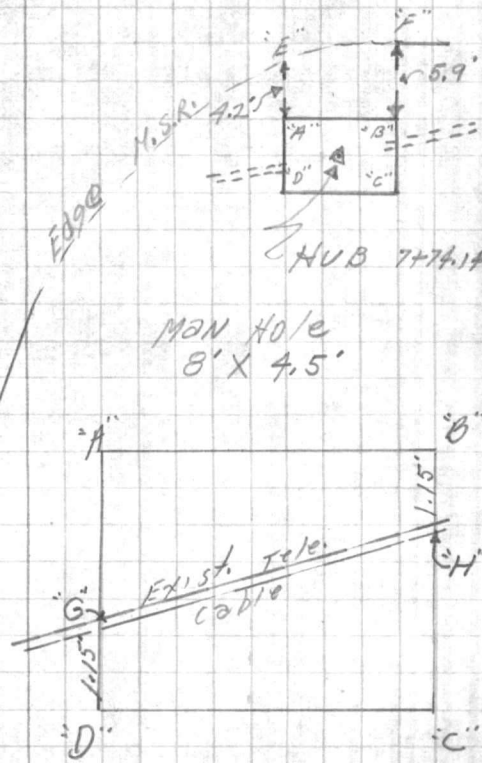



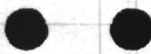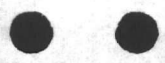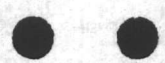

VALUABLE

SUBJECT

Profile ON Revised
Loc. of tele. conduitRETURN TO
PUBLIC WORKS
OFFICE
CAMP LEJEUNE
NORTH CAROLINA26.15
19.35
25.50
FIELD PARTY
63.70
IN CHARGE
INSTRUMENT
NOTES
TAPE READ
TAPE OR ROD
TAPE OR ROD
INSTRUMENT NO.
TAPE NO.

WEATHER

CLEAR
CLOUDY
WINDY
RAIN
FAIR
SNOW
HOT
MODERATE
COLD
FOG

FILE No. _____

FLDR. No. _____

SHEET

3-07

FIGURED BY _____

NOTES CHECKED BY _____

PLOTTED BY _____

DATE 5-28-57

Quad. No. _____

STATION	DIST.	ANGLE ° ' "	+	H. I. BEARING	VER. ANG. DIFF.	ELEVATION	
B.M.						31.82	SPIKE IN POWER POLE S.F.A 32' Pt. Sta. 2+00 1.5' Lt. Edge Rd. Rod Elev.
0+0		2.78		34.60 34.6	3.3	31.3	3.20 31.40
0+50					3.4	31.2	3.29 31.31
1+0					3.6	31.0	3.42 31.18
1+50					3.6	31.0	3.55 31.05
2+0					3.7	30.9	3.54 31.06
2+50					3.8	30.8	3.66 30.94
3+0					3.9	30.7	3.81 30.79
3+26.15 P.I.					4.0	30.6	3.90 30.70
3+45.5					4.1	30.5	ground
3+45.5					5.92	28.68	top of tele. cable
3+63.7					4.3	30.3	ground
3+63.7					7.69	26.91	top of 12" water line
4+0					4.7	29.9	
4+36					5.1	29.5	
4+54					5.3	29.3	




VALUABLE SUBJECT

Profile cont'd.

RETURN TO
PUBLIC WORKS
OFFICE
CAMP LEJEUNE
NORTH CAROLINA

FIELD PARTY

IN CHARGE
INSTRUMENT
NOTES
TAPE READ
TAPE OR ROD
TAPE OR ROD
INSTRUMENT NO.
TAPE NO.

WEATHER

CLEAR
CLOUDY
WINDY
RAIN
FAIR
SNOW
HOT
MODERATE
COLD
FOG
FIGURED BY
NOTES CHECKED BY
PLOTTED BY

FILE No.

FLDR. No.

SHEET 4 of

DATE 5-28 1957

Quad. No.

STATION	DIST.	ANGLE ° ' "	+	H. I. BEARING	VER. ANG. DIFF.	ELEVATION	
5+0				24.60 34.6	5.8	28.8	
5+19					5.8	28.8	
5+50					5.1	29.5	
6+0					4.3	30.3	
6+50					4.0	30.6	
7+0					4.0	30.6	37' left Edge Rd.
7+48					4.5	30.1	
7+52.3				ground	4.7	29.9	8.35 Rod top of 12" water line
7+74.14					4.6	30.0	26.25 El.
COR. "A"					4.4	30.2	
COR. "B"					4.55	30.05	
COR. "C"					4.7	29.9	
COR. "D"					4.7	29.9	
"E"					4.21	30.39	Edge P.M.T.
"F"					4.25	30.35	" "

VALUABLE

SUBJECT

Profile contd.

RETURN TO
PUBLIC WORKS
OFFICE
CAMP LEJEUNE
NORTH CAROLINA

FIELD PARTY

IN CHARGE

INSTRUMENT

NOTES

TAPE READ

TAPE OR ROD

TAPE OR ROD

INSTRUMENT NO.

TAPE NO.

WEATHER

CLEAR
CLOUDY
WINDY
RAIN
FAIR
SNOW
HOT
MODERATE
COLD
FOG

FILE No. _____

FLDR. No. _____

FIGURED BY _____

SHEET

5-04

NOTES CHECKED BY _____

PLOTTED BY _____

DATE

5-28 1957

Quad. No. _____

STATION	DIST.	ANGLE		+	H. I. BEARING	VER. ANG. DIFF.	ELEVATION	
		°	' "					
					<i>34.60</i>			
<i>"G"</i>						<i>6.51</i>	<i>28.09</i>	<i>Tap 'Tape cable</i>
<i>"H"</i>						<i>6.54</i>	<i>28.06</i>	<i>" " "</i>
<i>B.M.</i>						<i>2.78</i>	<i>31.82</i>	<i>SPike IN power pole S.F.A</i>






















































































































VALUABLE

RETURN TO
PUBLIC WORKS
OFFICE
CAMP LEJEUNE
NORTH CAROLINA


SUBJECT PROPOSED Tele. W. G.
CONDUIT AT M.S.R. & SNEADS
Ferry Rd. Intersection.

FIELD PARTY
Kellum IN CHARGE
INSTRUMENT
NOTES
TAPE READ
TAPE OR ROD
TAPE OR ROD
INSTRUMENT No.
TAPE No.

WEATHER
CLEAR. CLOUDY
HOT MODERATE
SNOW HOT MODERATE COLD FOG
FIGURED BY
NOTES CHECKED BY
PLOTTED BY
FILE No. _____
FLDR. No. _____
SHEET 1 of 4
DATE 6-21-1927

Quad. No. _____

STATION DIST. ANGLE + H. I. BEARING VER. ANG. DIFF. ELEVATION

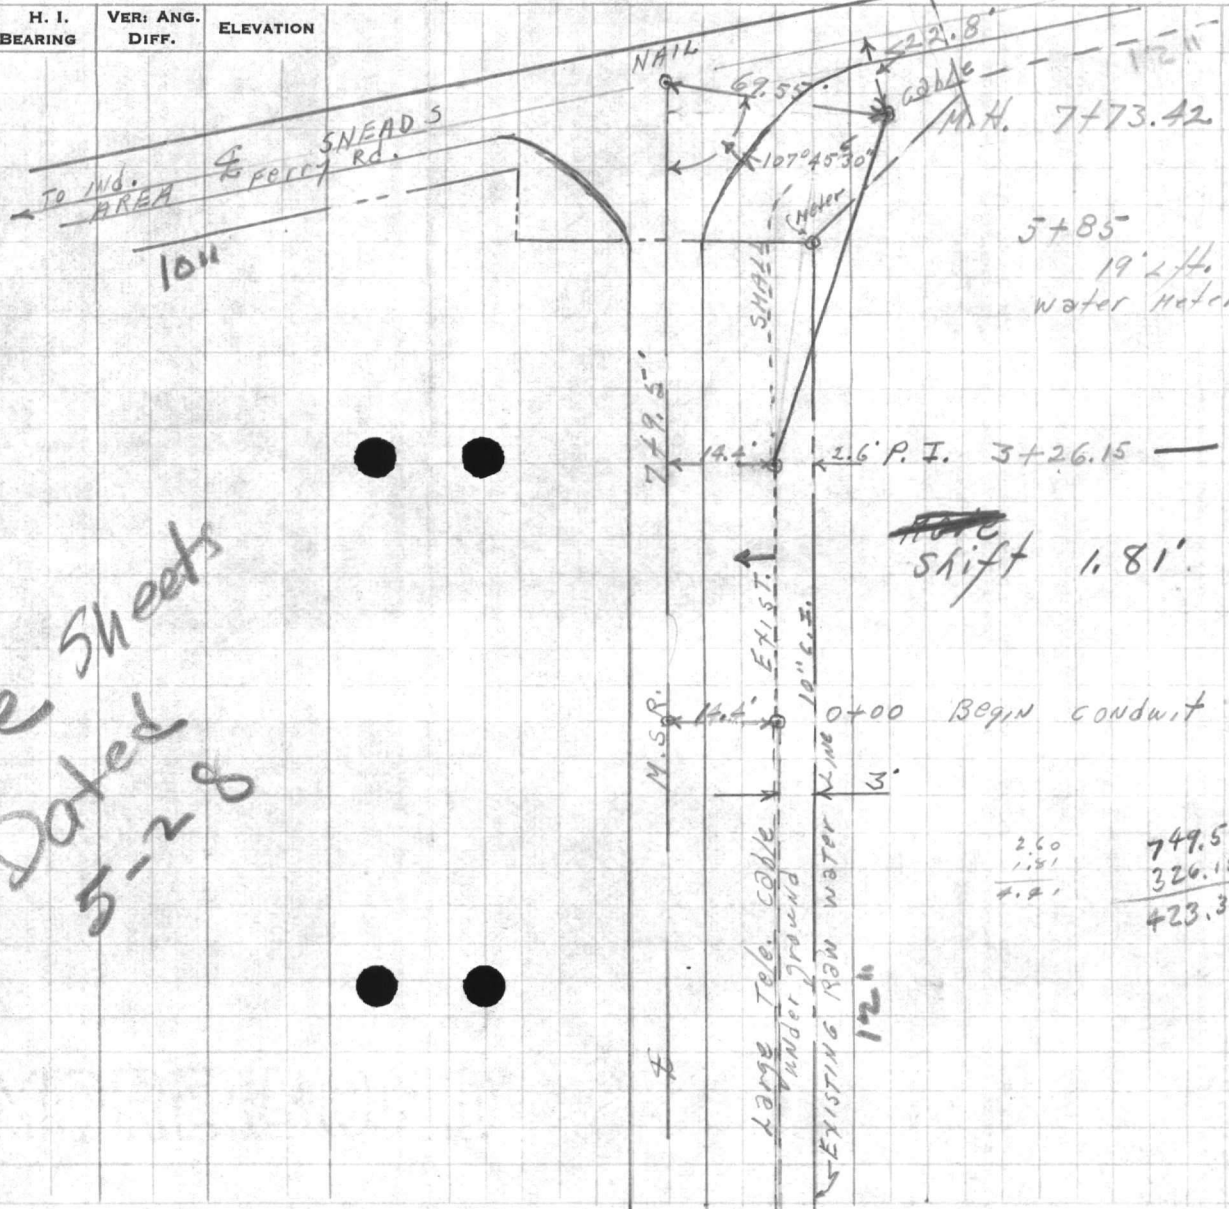

VOID
See Sheets
Dated
5-28

P.I. 1-186°37'30"
3+26.15 3-199°52'30"
MEAN. 186°37'30"

260
1.81
4.41
749.5
326.15
423.35













VALUABLE

SUBJECT Profile on Proposed
Tele. Conduit M.S.R. & Swards
Ferry Rd.

RETURN TO
 PUBLIC WORKS
 OFFICE
 CAMP LEJEUNE
 NORTH CAROLINA

FIELD PARTY

 IN CHARGE

 INSTRUMENT

 NOTES

 TAPE READ

 TAPE OR ROD

 TAPE OR ROD

 INSTRUMENT NO. _____
 TAPE NO. _____

WEATHER

CLEAR _____
 CLOUDY _____
 WINDY _____
 RAIN _____
 FAIR _____
 SNOW _____
 HOT _____
 MODERATE _____
 COLD _____
 FOG _____
 FIGURED BY _____
 NOTES CHECKED BY _____
 PLOTTED BY _____

FILE No. _____
 FLDR. No. _____
 SHEET 2 of 4
 DATE 5-21-1957

Quad. No. _____

STATION	DIST.	ANGLE ° ' "	+	H. I. BEARING	VER. ANG. DIFF.	ELEVATION	
B.M.						31.45	Spike in oak tree near M.S.R. & Swards Ferry Rd. intersection
T.P.			3.56	35.01	4.43	30.58	
B.M. (New)	T.P.		4.86	35.44	3.62	31.82	R.R. spike in power pole SF-4 30' Rt. Sta. 2+00
T.P.			3.42	35.24	4.65	30.59	
B.M.			4.57	35.16	3.72	31.44	on oak tree
						<u>31.45</u>	
B.M.			3.13	34.95		31.82	Spike in Power Pole SF-4
0+0	3' Lft.			34.9	3.6	31.3	Edge Rd.
0+0					3.7	31.2	ground
0+0					5.6	29.3	TOP of Existing Tele. cable
0+0					7.4	27.5	3' Rt. TOP of <u>10'</u> water line 1211
+25					3.7	31.2	Edge of dirt Rd. radius
+50					3.8	31.1	
+70					4.0	30.9	
+70	3' Lft.				3.8	31.1	Edge Rd.
+50					3.8	31.1	
+54	1.5' Rt.			Rd. Sign			
2+0					4.0	30.9	
2+0	3' Lft.				3.9	31.0	Edge Rd.






3 26.15
19.10

545.25

VALUABLE

SUBJECT

Profile contd.

RETURN TO
PUBLIC WORKS
OFFICE
CAMP LEJEUNE
NORTH CAROLINA

FIELD PARTY

IN CHARGE _____
INSTRUMENT _____
NOTES _____
TAPE READ _____
TAPE OR ROD _____
TAPE OR ROD _____
INSTRUMENT NO. _____
TAPE NO. _____

WEATHER

CLEAR _____ SNOW _____
CLOUDY _____ HOT _____
WINDY _____ MODERATE _____
RAIN _____ COLD _____
FAIR _____ FOG _____
FIGURED BY _____
NOTES CHECKED BY _____
PLOTTED BY _____

FILE No. _____

FLDR. No. _____

SHEET

3-07 4

DATE

5-22 19 58

Quad. No. _____

STATION	DIST.	ANGLE		+	H. I. BEARING	VER. ANG. DIFF.	ELEVATION	
		°	' "					
2+50					34.95 34.9	4.2	30.7	
3+0						4.3	30.6	
3+0	3' left.					4.1	30.8	Edge Rd.
3+26.15	proposed M.H.					4.4	30.5	ground
3+26.15						6.5	28.4	top of existing Tele. cable
3+26.15	2.6' Rt.					8.1	26.8	top of 10" water line 12"
3+26.15	3' left.					4.2	30.7	Edge of Rd.
3+45.25						7.9	27.0	top of 10" water line 12"
4+50						4.8	30.1	
4+0						5.2	29.7	24' Rt. Woods Line
4+34						5.6	29.3	
4+64						6.0	28.9	
5+0						6.1	28.8	13' Rt. Woods Line
4+18						5.9	29.0	8.5' Rt. Power Pole 5F-2
4+50						5.4	29.5	10' Rt. Woods Line
6+0						4.4	30.5	3' Rt. Woods Line
7+10						4.4	30.5	


VALUABLE

SUBJECT

Profile cont'd.

 RETURN TO
 PUBLIC WORKS
 OFFICE
 CAMP LEJEUNE
 NORTH CAROLINA

FIELD PARTY

 _____ IN CHARGE
 _____ INSTRUMENT
 _____ NOTES
 _____ TAPE READ
 _____ TAPE OR ROD
 _____ TAPE OR ROD
 _____ INSTRUMENT NO.
 _____ TAPE NO.

WEATHER

 CLEAR
 CLOUDY
 WINDY
 RAIN
 FAIR
 SNOW
 HOT
 MODERATE
 COLD
 FOG

FILE No. _____

FLDR. No. _____

FIGURED BY _____

SHEET

4-24

NOTES CHECKED BY _____

PLOTTED BY _____

DATE

5-22 1957

Quad. No. _____

STATION	DIST.	ANGLE			H. I. BEARING	VER. ANG. DIFF.	ELEVATION	
		°	'	"				
+25					34.95 34.9			7' Rt. Woods Line
+50						4.3 30.6		15' Rt. Woods Line
+74								10' Lft. Power Pole SF-1
7+0						4.3 30.6		20' Rt. Woods Line
+25								18' Rt. Woods Line
+33.5						4.4 30.5		4.5' Rt. guy anchor from tele. Pole
+33.5								14' Lft. Tele. Pole
+48						5.0 29.9		directly under next tele. Line parallel
+52						8.7 26.2		Top of 10" water Line 12"
+59						5.2 29.7		
7+69.1						8.5 26.4		7.2' Rt. Top of 10" water Line
M.H. 7+73.42						5.0 29.9		ground 12"
7+73.42						7.1 27.8		Top of Exist. Tele cable
						4.6 30.3		Edge of Sneads Ferry Rd. 7.2' from M.H.
B.M.						3.13 31.82		spike in pole # SF-9

STATION DISTANCE + CLEAR
ELEVATION
WIND DIRECTION
WIND VELOCITY
TEMPERATURE
RELATIVE HUMIDITY
WIND VELOCITY
WIND DIRECTION
WEATHER
TIME
DATE
FROM NO

1
2
VALUABLE

RETURN TO
PUBLIC WORKS
OFFICE
CAMP LEJEUNE
NORTH CAROLINA

SUBJECT Under ground telephone
Cable LOCATION ALONG
MAIN SERVICE ROAD
EXTENSION.


FIELD PARTY
Spill IN CHARGE
INSTRUMENT
NOTES
TAPE READ
TAPE OR ROD
TAPE OR ROD
INSTRUMENT NO.
TAPE NO.

WEATHER
CLEAR
CLOUDY
WINDY
RAIN
FAIR
SNOW
HOT
MODERATE
COLD
FOG
FIGURED BY
NOTES CHECKED BY
PLOTTED BY

FILE No. 160T
FLDR. No.
SHEET 1-0 of 1
DATE 5-17 19 57

Quad. No. _____

STATION	DIST.	ANGLE			H. I. BEARING	VER. ANG. DIFF.	ELEVATION
		°	'	"			

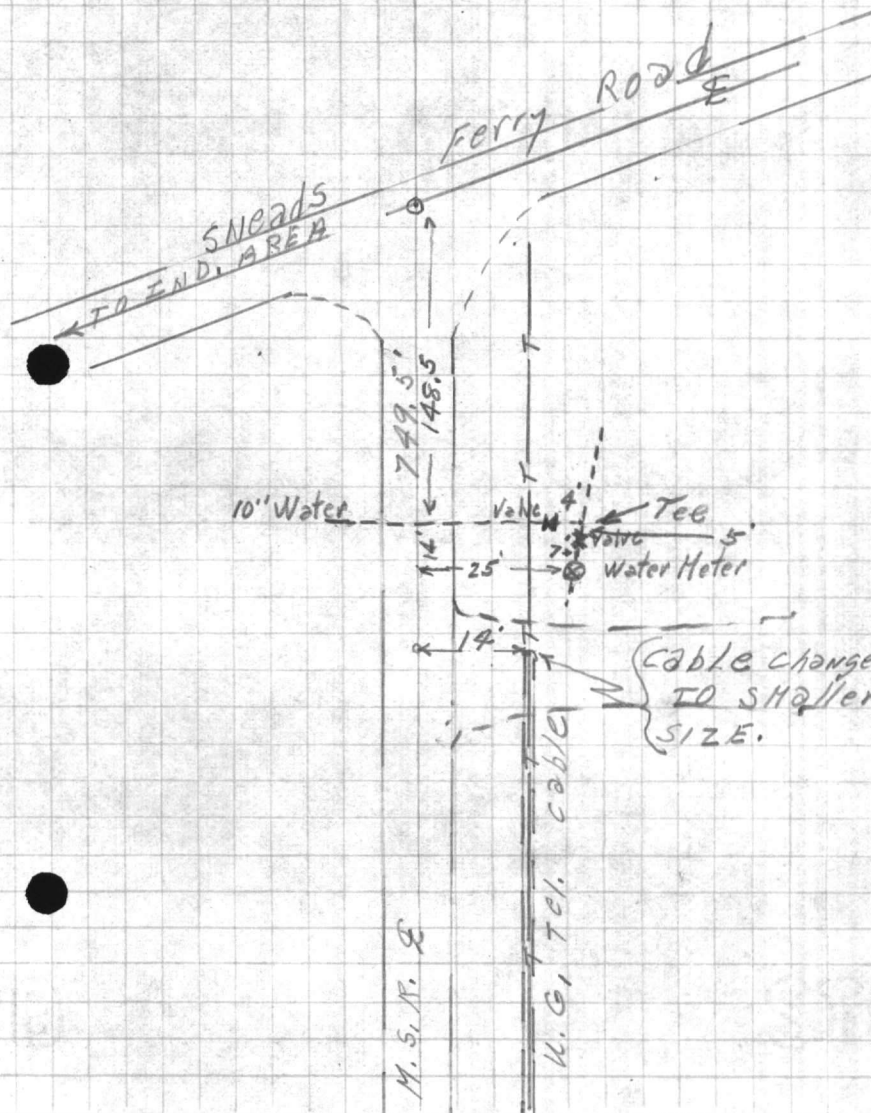

100.00
26.15

73.85

3726.15

100.00
26.15

73.85



