

FILE FOLDER

DESCRIPTION ON TAB:

WATER 100 HOUSES

Outside/inside of actual folder did not contain hand written information

Outside/inside of actual folder did contain hand written information

***Scanned as next image**

Confidential Records Management, Inc.

New Bern, NC

1-888-622-4425

9/08

AVAILABLE

Return to
Public Works
Office
Council House
New Orleans

SUBJECT

Station

Date

Section

Vert. and Elevation

EXPERIMENT PARTY

In Charge

Assignment

Name

Time

Type of Rod

Type of Soil

Remarks

Time

WEATHER

Clear

Cloudy

Light

Heavy

Checked by

Plotted by

Time

FILE NO.

DATE

BY

DATE

TIME

VALUABLE

SUBJECT WATER LINE PROFILE - CONTDReturn To
Public Works
Office
Camp Lejeune
North CarolinaFIELD PARTY
KILLUM In Charge
Instrument _____
Notes _____
Tape Read _____
Tape or Rod _____
Tape or Rod _____
Instrument No. _____
Tape No. _____WEATHER
Clear _____
Cloudy _____
Windy _____
Rain _____
Fair _____
Snow _____
Hot _____
Moderate _____
Cold _____
Fog _____
Figured By _____
Notes Checked By _____
Plotted By _____FILE No. 139-0
Fldr. No. _____
Sheet 2052
Date 10-25 19 46

Quad. No. _____

Station	Dist.	Angle " "	+	H. I. Bearing	Ver: Ang. Diff.	Elevation														
				28.38																
4+50					10.21															
5+00				2.00	9.00															
5+50					8.59															
6+00					8.83															
6+50					9.13															
7+00					9.28															
7+50.5	8" X 8" T.C.C.				10.22															
T.P.			2.72	25.01	6.09	22.39														
B.M.					1.89	23.12														
						23.16														
						.04														

NAIL IN ROOT OF PINE TREE NEAR 0+00 COOPER ST.

AVAILABLE

SUBJECT

Return To
Public Works
Office
Camp Lejeune
North Carolina

Station

Dist.

Appld

Station

Dir.

Elevation

FIELD PARTY

In Charge

Instrument

Notes

Tape Read

Type of Rod

Type of Rod

Instrument No.

Type No.

WEATHER

Clear

Cloudy

Fog

Light

Overcast

Other

Notes

Checked By

Date

FIELD NO.

FIELD NO.

Checked By

Date

Field No.

VALUABLE

SUBJECT PROFILE ON 8" WATER
MAIN BEGINNING AT COOPER AND
BEVIN ST.

Return To
 Public Works
 Office
 Camp Lejeune
 North Carolina

FIELD PARTY
KELLY In Charge
 _____ Instrument
 _____ Notes
 _____ Tape Read
 _____ Tape or Rod
 _____ Instrument No.
 _____ Tape No.

WEATHER
 Clear _____
 Cloudy _____
 Windy _____
 Rain _____
 Fair _____
 Snow _____
 Hot _____
 Moderate _____
 Cold _____
 Fog _____
 Figured By _____
 Notes Checked By _____
 Plotted By _____

FILE No. 139-0
 Fldr. No. _____
 Sheet 1-01
 Date 10-28 19 16


Quad. No. _____

Station	Dist.	Angle "	+	H. I. Bearing	Ver: Ang. Diff.	Elevation
B.M.			5.97	38.30		22.33
0+00					10.22	18.08
0+05	8" GATE VALVE				10.14	18.16
0+50					9.90	18.40
1+00					9.95	18.35
1+50					9.82	18.48
2+00					9.45	18.85
2+50					9.26	19.04
3+00					8.94	19.36
3+03	8" x 6" Tee				8.95	19.35
	5' RIGHT 6" GATE VALVE				9.11	19.19
	26' RIGHT HYD.				9.50	18.80
3+50					9.17	19.13
4+00					9.54	18.76
4+50					9.69	18.61
5+00					9.66	18.64

MON. #394

TOP OF 8" x 8" Tee

COOPER ST.

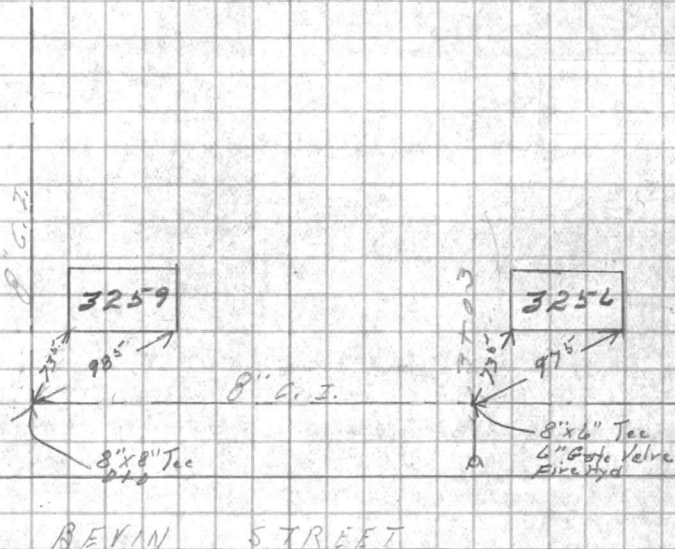

745

AVAILABLE

State of
Public Works
Office
Camp Lenoir
North Carolina

SUBJECT

Scale of
Dip
Reading
Dip
Vertical Elevation

FIELD PARTY

Lead
Instrument
Notes
Tape Base
Tape on Rod
Tape on Rod
Tape on Rod
Tape on Rod
Tape on Rod

WEATHER

Clear
Snow
Cloudy
Fog
Rain
Thunder
Checked by
Checked by
Checked by

FIELD NO.

DATE

TIME

LOCATION

FIELD NO.

VALUABLE

SUBJECT WATER LINE PROFILE CONTD.

Return To
Public Works
Office
Camp LeJeune
North Carolina

FIELD PARTY

REELMAN In Charge
____ Instrument
____ Notes
____ Tape Read
____ Tape or Rod
____ Tape or Rod
____ Instrument No.
____ Tape No.

WEATHER

Clear _____
Cloudy _____
Windy _____
Rain _____
Fair _____
Snow _____
Hot _____
Moderate _____
Cold _____
Fog _____

FILE No. 139-0

Fldr. No. _____

Figured By _____ Sheet 2-01

Notes Checked By _____

Plotted By _____ Date 10-29 1946

Quad. No. _____

Station	Dist.	Angle " "	+	H. I. Bearing	Ver: Ang. Diff.	Elevation	
				28.30			
5+50					9.44	18.86	
6+00					7.88	18.42	
6+50					10.48	17.82	
7+00					10.61	17.69	? OPPOSITE HEADWALL BETWEEN 7 TH AND 9 TH HOUSE.
B.M.					5.97	22.33	MON. #392

AVAILABLE

Return To
Public Works
Office
Camp Lejeune
North Carolina

SUBJECT

Station

Dist

Angle

Bearing

Vertical
Angle

Elevation

FIELD PARTY

In Charge _____
Instrument _____
Notes _____
Tape Read _____
Use of Rod _____
Tape or Rod _____
Station No. _____
Tape No. _____

WEATHER

Clear _____
Cloudy _____
Wind _____
Rain _____
Fog _____
Snow _____
Hail _____
Mist _____
Cold _____
Hot _____

FILE NO.

Tape No.

Sheet

Notes Checked By

Date

Quad No.

VALUABLE

SUBJECT Profile on 8" Water Line
on Basin Street
Eden
A.S. Built
100 HOUSES

Return To
 Public Works
 Office
 Camp Lejeune
 North Carolina

FIELD PARTY
Hamilton in Charge
 Instrument _____
 Notes _____
 Tape Read _____
 Tape or Rod _____
 Tape or Rod _____
 Instrument No. _____
 Tape No. _____


WEATHER
 Clear _____
 Cloudy _____
 Windy _____
 Rain _____
 Fair _____
 Snow _____
 Hot _____
 Moderate _____
 Cold _____
 Fog _____
 Figured By _____
 Notes Checked By _____
 Plotted By _____

FILE No. 139-0
 Fldr. No. _____
 Sheet #1 of 5
 Date Nov 8 1936

Quad. No. _____

Station	Dist.	Angle "	+	H. I. Bearing	Ver: Ang. Diff.	Elevation
BM			9 18	27 34		23 16
0+0	top 8"x8" Tee			10 12		17 22
+50				8 82		18 52
1+0				9 06		18 28
+50				9 38		17 96
2+0				9 05		18 29
+50				8 99		18 35
3+02	top 8"x6" Tee Fire Hyd			8 63		18 81
+50				8 50		18 84
4+0				8 34		19 00
+50				8 63		18 71
5+0				9 25		18 09
+50				9 26		18 88
6+0				8 67		18 67
+50				8 67		18 67

On pine tree near intersection of
 River Drive and Cooper Street

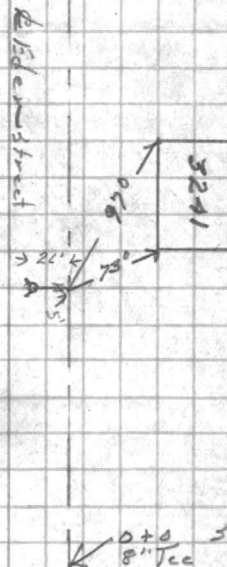

Cooper St













































VALUABLE

SUBJECT _____

Return To
 Public Works
 Office
 Camp Lejeune
 North Carolina

FIELD PARTY


_____ In Charge
 _____ Instrument
 _____ Notes
 _____ Tape Read
 _____ Tape or Rod
 _____ Tape or Rod
 _____ Instrument No.
 _____ Tape No.

WEATHER

Clear _____
 Cloudy _____
 Windy _____
 Rain _____
 Fair _____
 Snow _____
 Hot _____
 Moderate _____
 Cold _____
 Fog _____
 Figured By _____
 Notes Checked By _____
 Plotted By _____

FILE No. _____
 Fldr. No. _____
 Sheet #2 of 5
 Date Nov 8 19__

Quad. No. _____

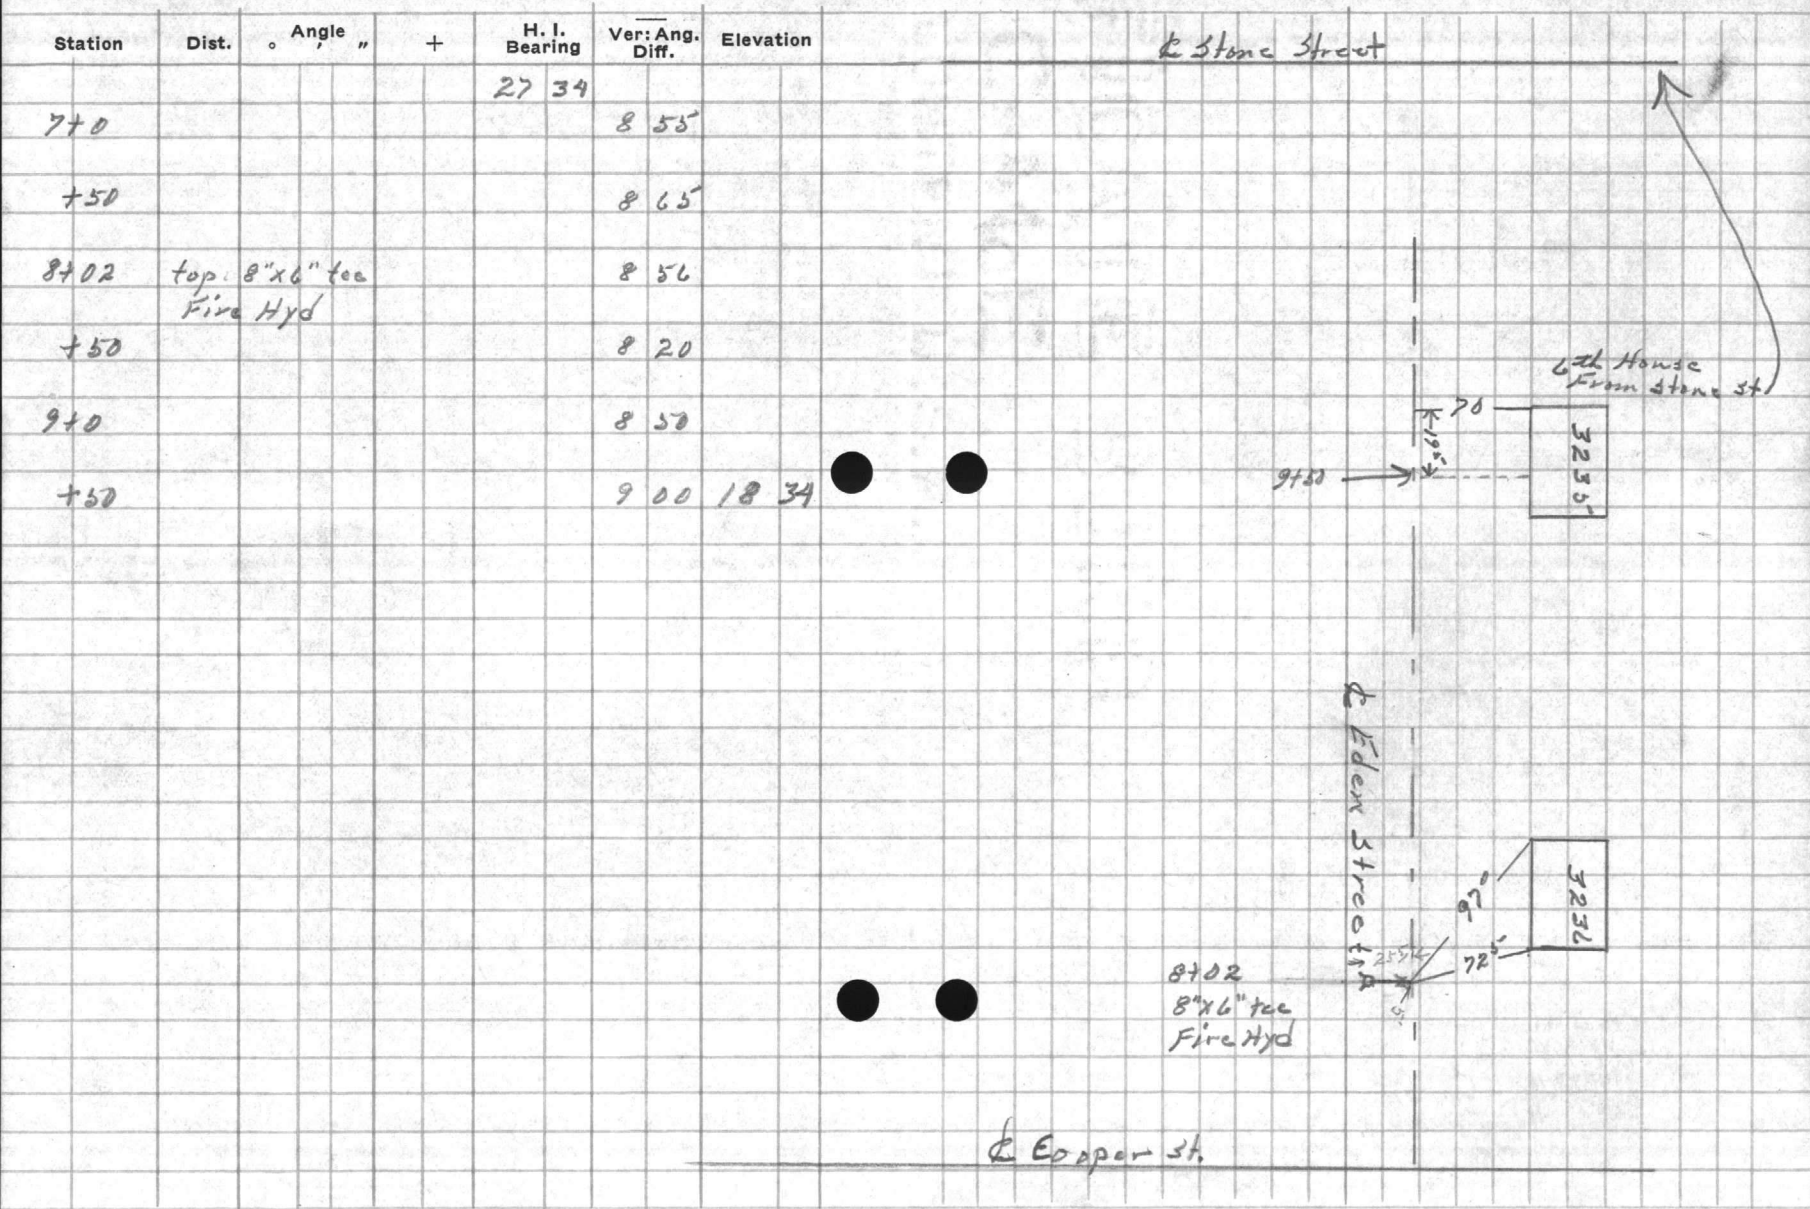

VALUABLE

SUBJECT Profile on 8" Water Line
Eden Street

Return To
Public Works
Office
Camp Lejeune
North Carolina

FIELD PARTY

Hamilton In Charge
Fragille Instrument
Notes
Tape Read
Batson Tape or Rod
Tape or Rod
Instrument No.
Tape No.

WEATHER

Clear
Cloudy
Windy
Rain
Fair
Snow
Hot
Moderate
Cold
Fog
Figured By
Notes Checked By
Plotted By

FILE No. _____
Fldr. No. _____
Sheet 3 of 5
Date Nov 14 1976


Quad. No. _____

Station	Dist.	Angle "	+	H. I. Bearing	Ver: Ang. Diff.	Elevation
BM			4 42			23 16
				27 58		
TP		3 08			2 85	24 73
				27 81		
9+50					9 56	18 25
10+0					9 77	
10+50					9 56	
11+0					9 36	
+50					9 58	
12+0					9 07	
+50					8 53	
13+04		8" x 6" Tee Fire Hyd			8 42	
+50					7 98	
14+0					7 35	
+50					6 68	
+71		Gate Valve			4 96	
15+0					6 68	
+65					6 82	

Nail in pine near intersection
of River Drive and Cooper Street

Eden

Stone St.

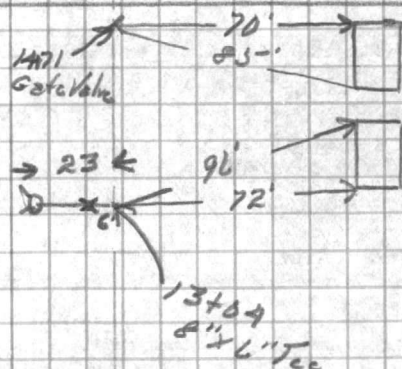




























VALUABLE

SUBJECT _____

Return To
Public Works
Office
Camp Lejeune
North Carolina

FIELD PARTY

_____ In Charge
_____ Instrument
_____ Notes
_____ Tape Read
_____ Tape or Rod
_____ Tape or Rod
_____ Instrument No.
_____ Tape No.

WEATHER

Clear
Cloudy
Windy
Rain
Fair

Snow
Hot
Moderate
Cold
Fog

FILE No. _____

Fldr. No. _____


Sheet 7 of 5

Date _____ 19__

Figured By _____
Notes Checked By _____
Plotted By _____

Quad. No. _____

Station	Dist.	Angle	"	+	H. I. Bearing	Ver: Ang. Diff.	Elevation
					27 81		
16+0						6 90	
TP		2 98				0 22	27 59
					30 57		
18+50						9 44	
17+0						9 02	
+50						8 78	
18+53	8"x6" Tee	6" Valve				8 89	
	Fire Hyd						
+50						8 82	
19+0						10 25	
+50						10 69	
20+0						11 65	
+50						12 10	
21+0						12 38	
+50						13 15	
22+0						14 98	16 09
							9
+50						15 68	19 89
TP						4 66	25 91

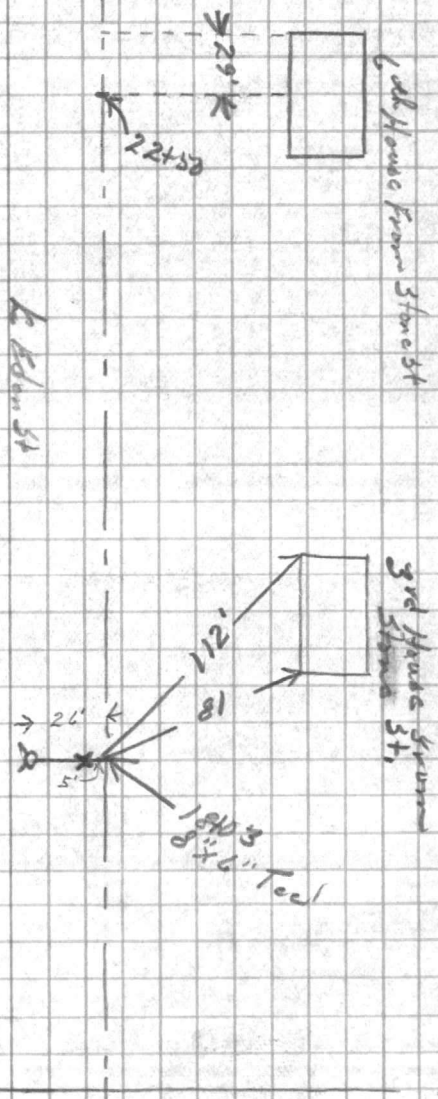

VALUABLE
Return to
Public Works
Office
Camp Lejeune
North Carolina

SUBJECT

Station _____
Dist. _____
M. J. _____
HARRIS _____
DIVISION _____

FIELD PARTY
By _____
Instrument _____
Date _____
Time of Day _____
Number _____
Tape No. _____

WEATHER
Class _____
Wind _____
Rain _____
Temp _____
Relative Hum. _____
Notes _____
Remarks _____

FIELD NO. _____
Sheet No. _____
Sheet _____
Date _____

VALUABLE

SUBJECT _____

Return To
Public Works
Office
Camp Lejeune
North Carolina

FIELD PARTY

_____ In Charge
_____ Instrument
_____ Notes
_____ Tape Read
_____ Tape or Rod
_____ Tape or Rod
_____ Instrument No.
_____ Tape No.

WEATHER

Clear
Cloudy
Windy
Rain
Fair

Snow
Hot
Moderate
Cold
Fog

FILE No. _____

Fldr. No. _____

Sheet 5 of 5

Date Nov 20 19 46


Figured By _____

Notes Checked By _____

Plotted By _____

Quad. No. _____

Station	Dist.	Angle " "	+	H. I. Bearing	Ver: Ang. Diff.	Elevation
			0 32			25 91
				26 23		
22+50					11 40	14 83
23+0					12 44	13 79
+95	8" x 6" Tee				12 94	13 29
	Fire Hyd - Valve					
TP			4 08		7 03	19 20
				23 28		
24+0					10 47	
+74					10 23	
25+0					10 26	
+42	Gate Valve					
+60	8" x 2" Tee				10 31	12 97
26+0					10 00	
+50					9 10	
27+0					8 03	
+50					7 95	
TP			9 39	30 99	1 73	21 55

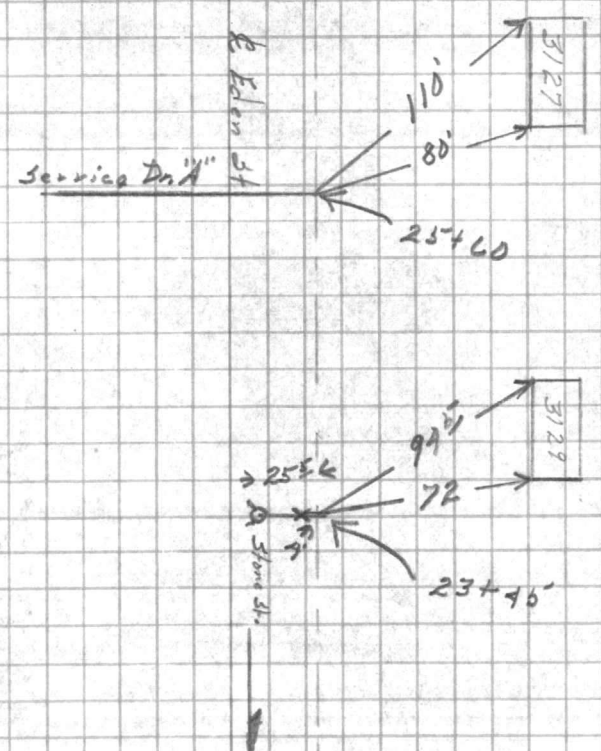

VALUABLE

Return To
Public Works
Office
Camp Johnson
North Carolina

SUBJECT

Station _____ Dist. _____
Date _____

FIELD PARTY

In Charge _____
Instrument _____
Notes _____
Tape Read _____
Type of Rod _____
Type of Rod _____
Instrument No. _____
Tape No. _____

WEATHER

Clear _____
Cloudy _____
Hot _____
Windy _____
Fog _____
Rain _____
Cold _____
Snow _____

FILE No.

Plot No. _____
Sheet _____
Date _____

Quad No.

24 24

100 HOUSES

VALUABLE

SUBJECT

Location + Elev

Return To
Public Works
Office
Camp Lejeune
North Carolina

Hyd on River Rd

Warrant Off Quarters

FIELD PARTY

_____ In Charge
 _____ Instrument
 _____ Notes
 _____ Tape Read
 _____ Tape or Rod
 _____ Instrument No.
 _____ Tape No.

WEATHER

Clear
 Cloudy
 Windy
 Rain
 Fair

Snow
 Hot
 Moderate
 Cold
 Fog

FILE No. 139-0

Fldr. No. _____

Figured By _____ Sheet 1-6


Notes Checked By _____

Plotted By _____ Date 10-10 19__

Quad. No. 139

Station	Dist.	Angle ' "	+	H. I. Bearing	Ver: Ang. Diff.	Elevation
B.M.			A 76			1201
① Main line #T"					1149	
② Top Valve					755	
③ AT Hyd					862	

A.T.

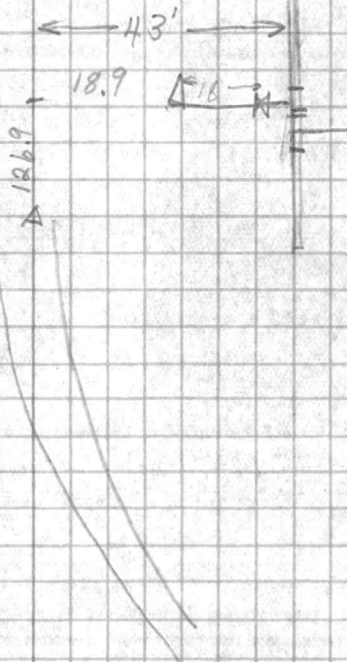
































VALUABLE

SUBJECT _____

Return To
 Public Works
 Office
 Camp Lejeune
 North Carolina

FIELD PARTY

_____ In Charge
 _____ Instrument
 _____ Notes
 _____ Tape Read
 _____ Tape or Rod
 _____ Tape or Rod
 _____ Instrument No.
 _____ Tape No.

WEATHER

Clear _____
 Cloudy _____
 Windy _____
 Rain _____
 Fair _____
 Snow _____
 Hot _____
 Moderate _____
 Cold _____
 Fog _____

FILE No. _____

Fldr. No. _____


Figured By _____ Sheet 2-6

Notes Checked By _____

Plotted By _____ Date _____ 19__

Quad. No. _____

Station	Dist.	Angle ° ' "	+	H. I. Bearing	Ver: Ang. Diff.	Elevation														
B M						17 88														
			392																	
1	On Top				9 70															
2	Top valve				8 40															
3	AT Hyd				9 50															

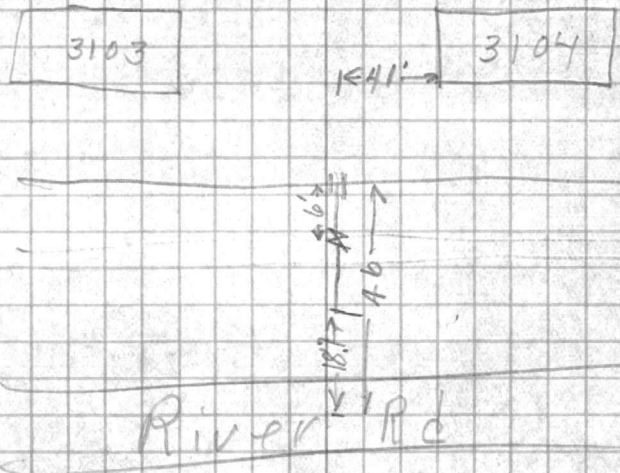





































VALUABLE

SUBJECT _____

Return To
 Public Works
 Office
 Camp Lejeune
 North Carolina

FIELD PARTY

_____ In Charge
 _____ Instrument
 _____ Notes
 _____ Tape Read
 _____ Tape or Rod
 _____ Tape or Rod
 _____ Instrument No.
 _____ Tape No.

WEATHER

Clear
 Cloudy
 Windy
 Rain
 Fair

Snow
 Hot
 Moderate
 Cold
 Fog

FILE No. _____

Fldr. No. _____

Sheet 3-6

Figured By _____

Notes Checked By _____

Plotted By _____ Date _____ 19____

Quad. No. _____

Station	Dist.	Angle " "	+	H. I. Bearing	Ver: Ang. Diff.	Elevation
B M			280			1788
① Tex					1048	
② water					931	
③ AT Hyd					927	

River

VALUABLE

SUBJECT

Return To
Public Works
Office
Care of
North Carolina

Station

Date

Angle

M. L.
Elevation

Vertical
Dist

Elevation

Type No.

Instrument

Type of Rod

Type of Rod

Face Read

Notes

Attachment

Instrument

TYPE OF PARTY

Quadr. No.

Plotted By

Notes Checked By

Plotted By

Sheet

Field No.

FILE No.

WEATHER

Snow

Fog

Moderate

Cold

Fog

Clear

Cloudy

Windy

Rain

Fair

VALUABLE

SUBJECT _____

Return To
 Public Works
 Office
 Camp Lejeune
 North Carolina

FIELD PARTY

_____ In Charge
 _____ Instrument
 _____ Notes
 _____ Tape Read
 _____ Tape or Rod
 _____ Instrument No.
 _____ Tape No.

WEATHER

Clear
 Cloudy
 Windy
 Rain
 Fair

Snow
 Hot
 Moderate
 Cold
 Fog

FILE No. _____

Fldr. No. _____

Sheet 4-6

Date _____ 19____

Figured By _____
 Notes Checked By _____
 Plotted By _____

Quad. No. _____

Station	Dist.	Angle " "	+	H. I. Bearing	Ver: Ang. Diff.	Elevation
B.M.						2820
			3	32		



Top Tee

6 32

AT Hyd

8 35

River Rd

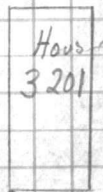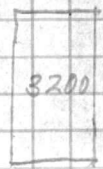

← 41.6' →

↑ 19.7' ↓

12' X 6' Tee
 6" Valve
 Hyd

STATION

SUBJECT

Station
Route
Office
Camp
North

Station

Dist.

Arch.

H. Bearing

Vol. Elev. Dist.

FIELD PARTY

In Charge

Instrument

Notes

Tape Read

Tape on Rod

Tape on Rod

Instrument No.

Tape No.

WEATHER

Clear

Cloudy

Windy

Fair

Rain

Snow

Hot

Moderate

Cold

Fog

Thunder

Lightning

FILE No.

Field No.

Sheet

Date

Grid No.

VALUABLE

SUBJECT _____

Return To
 Public Works
 Office
 Camp LeJeune
 North Carolina

FIELD PARTY

_____ In Charge
 _____ Instrument
 _____ Notes
 _____ Tape Read
 _____ Tape or Rod
 _____ Tape or Rod
 _____ Instrument No.
 _____ Tape No.

WEATHER

Clear
 Cloudy
 Windy
 Rain
 Fair

Snow
 Hot
 Moderate
 Cold
 Fog

FILE No. _____

Fldr. No. _____

Sheet 5-6

Date _____ 19__

Figured By _____

Notes Checked By _____

Plotted By _____

Quad. No. _____

Station	Dist.	Angle "	+	H. I. Bearing	Ver: Ang. Diff.	Elevation
BM						25 32
		3 20		28 52		
Top Top					9 23	
Top Valve					8 17	
Top Line at Hyd					9 74	

water line

AVAILABLE
Return To
Public Works
Office
Card & Plans
North Carolina

SUBJECT

3+25

FIELD PARTY

Lead
Date
Mileage
Notes
Remarks

Location
Time
Type Road
Notes
Remarks

FILE NO.

Checked by
Noted by
Plotted by






VALUABLE

SUBJECT _____

Return To
 Public Works
 Office
 Camp Lejeune
 North Carolina

FIELD PARTY
 _____ In Charge
 _____ Instrument
 _____ Notes
 _____ Tape Read
 _____ Tape or Rod
 _____ Tape or Rod
 _____ Instrument No.
 _____ Tape No.

WEATHER
 Clear _____
 Cloudy _____
 Windy _____
 Rain _____
 Fair _____
 Snow _____
 Hot _____
 Moderate _____
 Cold _____
 Fog _____
 Figured By _____
 Notes Checked By _____
 Plotted By _____

FILE No. _____
 Fldr. No. _____
 Sheet 6-6
 Date _____ 19__

Quad. No. _____

Station	Dist.	Angle "	+	H. I. Bearing	Ver: Ang. Diff.	Elevation
BM#9			4 00			23 16
① Top 12" line					7 97	
② Top valve					6 94	
③ Top 6" line at Hyd					8 90	

River Rd

VALUABLE

Return To
Public Works
Office
Camp Lejeune
North Carolina

SUBJECT

Station

Angle

H. I. V. S. A. B. S. E. V. S. I. O. N.

Direction

FIELD PARTY

In Charge _____
Instrument _____
Notes _____
Type Read _____
Type of Rod _____
Type of _____
Type of _____

WEATHER

Clear _____
Cloudy _____
Snow _____
Ice _____
Mist _____
Rain _____
Fog _____
Thunder _____
Lightning _____
Notes Checked By _____
Plotted By _____
Date _____

FILE NO.

Sheet No.

VALUABLE

SUBJECT Water Line
along Bevin St
100 HOUSES

Return To
 Public Works
 Office
 Camp Lejeune
 North Carolina


FIELD PARTY
Turley In Charge
 Instrument _____
 Notes _____
 Tape Read _____
 Tape or Rod _____
 Tape or Rod _____
 Instrument No. _____
 Tape No. _____

WEATHER
 Clear _____
 Cloudy _____
 Windy _____
 Rain _____
 Fair _____
 Snow _____
 Hot _____
 Moderate _____
 Cold _____
 Fog _____
 Figured By _____
 Notes Checked By _____
 Plotted By _____

FILE No. 139-0
 Fldr. No. _____
 Sheet _____
 Date _____ 19__

Quad. No. _____

Station	Dist.	Angle	H. I. Bearing	Ver: Ang. Diff.	Elevation
		501	29.34		22.33
+00			988	17.46	?
+50			990		
8			985		
+08	8" X 6" Tee		998		
	6' West to Valve		834		
	20' to Hud		972		
50			982		
9			984		
+50			971		
10			902		
+50			857		
11			878		
+50			894		
12			896		
+50			923		

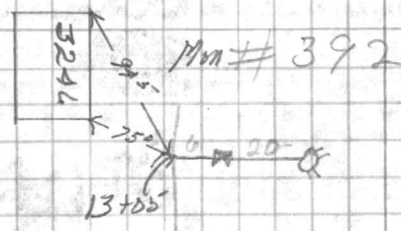

Bevin St

VALUABLE

SUBJECT _____

Return To
 Public Works
 Office
 Camp Lejeune
 North Carolina

FIELD PARTY

_____ In Charge
 _____ Instrument
 _____ Notes
 _____ Tape Read
 _____ Tape or Rod
 _____ Tape or Rod
 _____ Instrument No.
 _____ Tape No.

WEATHER


Clear _____
 Cloudy _____
 Windy _____
 Rain _____
 Fair _____

Snow _____
 Hot _____
 Moderate _____
 Cold _____
 Fog _____

FILE No. _____
 Fldr. No. _____
 Sheet _____
 Date _____ 19__

Figured By _____
 Notes Checked By _____
 Plotted By _____
 Quad. No. _____

Station	Dist.	Angle	"	+	H. I. Bearing	Ver: Ang. Diff.	Elevation
13						951	
+05		8'x6"	Tee			950	
		Top Valve				8.91	
		Hyd				9.06	
+30						8.82	
14						8.02	
+50						7.70	
+59.6		Top 8" Valve				6.06	
15						7.92	
TP						3.80	
					674		
+24		Stone	St				
+30						11.06	
16						10.76	
+50						9.90	

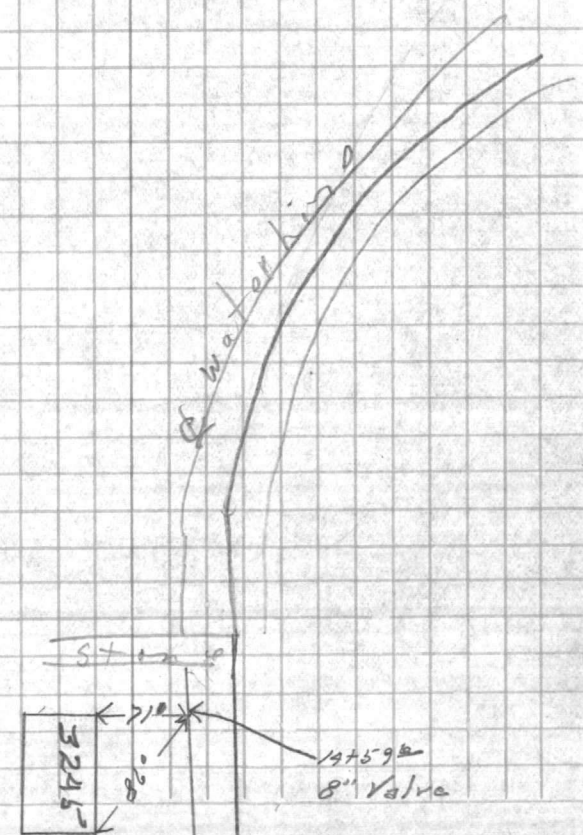

VALUABLE

Return To
Public Works
Office
Camp Lejeune
Fort Carolina

SUBJECT

Station _____ Date _____ Angle _____ Height _____ Mean Vertical Elevation _____





FILE NO.



VALUABLE

SUBJECT _____

Return To
Public Works
Office
Camp Lejeune
North Carolina

FIELD PARTY

_____ In Charge
_____ Instrument
_____ Notes
_____ Tape Read
_____ Tape or Rod
_____ Instrument No.
_____ Tape No.

WEATHER

Clear
Cloudy
Windy
Rain
Fair

Snow
Hot
Moderate
Cold
Fog

FILE No. _____

Fldr. No. _____


Figured By _____ Sheet _____

Notes Checked By _____

Plotted By _____ Date _____ 19__

Quad. No. _____

Station	Dist.	Angle	"	+	H. I. Bearing	Ver: Ang. Diff.	Elevation
17						909	
+50						892	
+84	8'x6" Tee					854	
	Top valve					716	
	Hyd					880	
18						864	
+50						892	
19						944	
+50						1002	
20						1042	
+50						1045	
21						1027	
+50						1036	
TP						683	

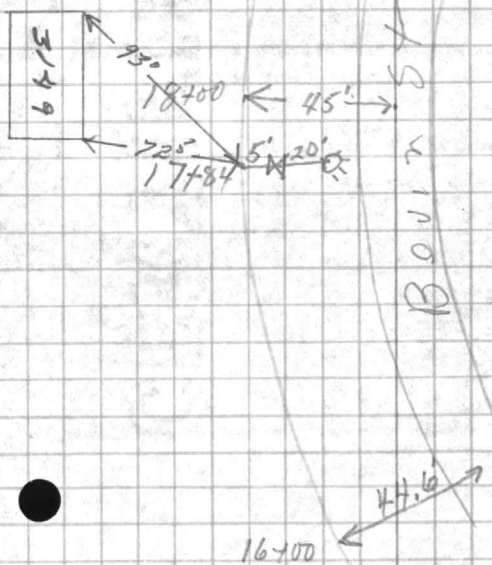

7 11

AVAILABLE

Return To
Public Works
Office
Camp Lejeune
North Carolina

SUBJECT

Station

H. T. BARRING

VECAL
DATA

Station

FIELD PARTY

In Charge _____
Team Number _____
Notes _____
Type of Work _____
Number of _____
Type of _____

WEATHER

Clear _____
Cloudy _____
Windy _____
Rain _____
Fog _____
Thunder _____
Lightning _____















VALUABLE

SUBJECT _____

Return To
 Public Works
 Office
 Camp Lejeune
 North Carolina

FIELD PARTY

_____ In Charge
 _____ Instrument
 _____ Notes
 _____ Tape Read
 _____ Tape or Rod
 _____ Tape or Rod
 _____ Instrument No.
 _____ Tape No.

WEATHER

Clear
 Cloudy
 Windy
 Rain
 Fair

Snow
 Hot
 Moderate
 Cold
 Fog

FILE No. _____

Fldr. No. _____

Sheet _____

Date _____ 19__


Figured By _____

Notes Checked By _____

Plotted By _____

Quad. No. _____

Station	Dist.	Angle	"	+	H. I. Bearing	Ver: Ang. Diff.	Elevation
22						1049	
+50						1060	
90		8'x6" Tee				1040	
		TOP VALVE				878	
		Hyd				1006	
23						1020	
+50						926	
24						865	
+50						854	
25						853	
+50						833	
+75		8" valve				696	
26+01		8x8 CROSS				924	
						496	
		5.88				677	

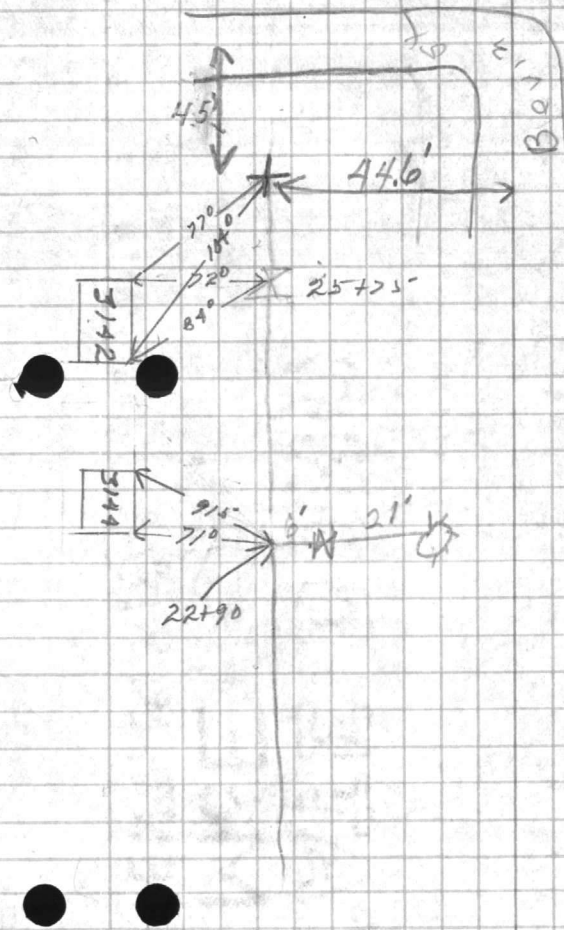

26+01
 22+90
 3'11"

VALUABLE

SUBJECT

Return to
Public Works
Office
Camp Johnson
North Carolina

Station





FIELD PARTY

In Charge

Instruments

Notes

Table Books

Table of Rod

Table of Rod

Instrument No.

Table No.

WEATHER

Clear

Cloudy

Wind

Temp

Barometer

Moisture

Other

FILE No.

Field No.

Sheet

Date

Checked By






V

VALUABLE

Return To
Public Works
Office
Camp Lejeune
North Carolina

SUBJECT As Built Profile
8" Water Line on Dewey St.
Add. 100 Houses - River Drive

FIELD PARTY
Homer How In Charge
Instrument _____
Notes _____
Tape Read _____
Tape or Rod _____
Tape or Rod _____
Instrument No. _____
Tape No. _____


WEATHER
Clear _____
Cloudy _____
Windy _____
Rain _____
Fair _____
Snow _____
Hot _____
Moderate _____
Cold _____
Fog _____
Figured By _____
Notes Checked By _____
Plotted By _____

FILE No. 139-0
Fldr. No. _____
Sheet 1051
Date 11/12/66 19 66

Quad. No. 139

Station	Dist.	Angle	"	+	H. I. Bearing	Ver: Ang. Diff.	Elevation
27+86	8"x8" Tee				30 94	14 17	
+50						12 60	
1+0						11 18	
+50						9 98	
2+0						8 69	
+50						8 10	
3+0						8 48	
+30	8"x8" Tee					9 15	
BM						8 68	22 26 2225

27+86 Eden St. = 0+0 Berlin St.

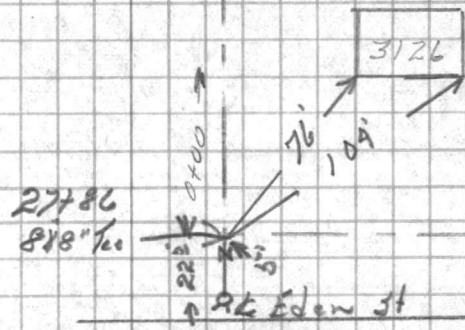

VALUABLE

Return To
Public Works
Office
Game Station
North Carolina

SUBJECT

Station

Angle

M. I.
Bearing

Dist.
Ver. Ang. Elevation

Instrument No.
Tape No.

Type of Rod
Type of Rod

Notes
In Charge

FIELD PARTY

Clear
Cloudy
Fog
Mist
Rain
Snow

Lighted By
Jacks Checked By
Pickled By

WEATHER

FILE No.

Field No.

Sheet

Date

Quadr. No.

100 HOUSES

VALUABLE

Return To
Public Works
Office
Camp Lejeune
North Carolina

SUBJECT As Built Profile
8" Water Line from Existing 12"
on River Drive to Eden St. at
North End of Add 100 Houses.


FIELD PARTY
Hamilton In Charge
Instrument _____
Notes _____
Tape Read _____
Tape or Rod _____
Tape or Rod _____
Instrument No. _____
Tape No. _____

WEATHER
Clear _____
Cloudy _____
Windy _____
Rain _____
Fair _____
Snow _____
Hot _____
Moderate _____
Cold _____
Fog _____
Figured By _____
Notes Checked By _____
Plotted By _____

FILE No. 139-0
Fldr. No. _____
Sheet #1 of 1
Date 11/20 19 46
Quad. No. 139

Station	Dist.	Angle "	+	H. I. Bearing	Ver: Ang. Diff.	Elevation
			5 65			15 79
			21 44			
0+0	12" x 8" Tee				15 80	
+08	Gate Valve					
+50					14 61	
1+0					12 20	
+50					10 79	
2+0					9 50	
+50					8 92	
3+0					9 00	
+50					9 09	
4+0					8 52	
+20	8" x 8" Tee				8 52	12 92
BM			5 65	15 79	15 79	

Bldg BM

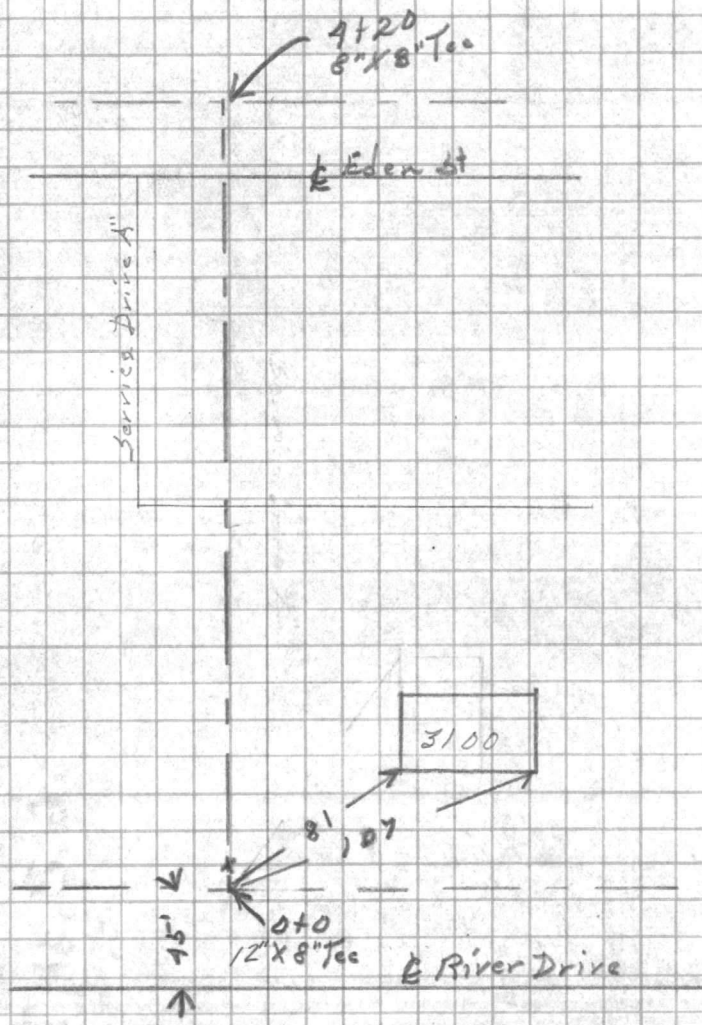

AVAILABLE
Return To
Public Works
Office
Camp Lejeune
North Carolina

SUBJECT

FIELD PARTY

Charge _____
Assignment _____
Notes _____
Type Book _____
Type w. Rod _____
Type w. Rod _____
Type No. _____
Type No. _____

WEATHER

Clear _____
Cloudy _____
Hot _____
Windy _____
Moderate _____
Cold _____
Rain _____
Fog _____
Type _____
Checked By _____
Checked By _____
Checked By _____
Date _____

File No.

Station _____ Dist. _____ Angle _____
H.C. _____ Vert. Ang. _____ Elevation _____
Reading _____ Dip _____