

FILE FOLDER

DESCRIPTION ON TAB:

WATER 67 HOUSES

Outside/inside of actual folder did not contain hand written information

Outside/inside of actual folder did contain hand written information

***Scanned as next image**

VALUABLE

SUBJECT LOCATION AND
PROFILE ON 2" WATER
LINE 67 Houses

Return To
 Public Works
 Office
 Camp Lejeune
 North Carolina

FIELD PARTY
Tullington In Charge
 Instrument _____
Cooper Notes
 Tape Read _____
 Tape or Rod _____
 Tape or Rod _____
 Instrument No. _____
 Tape No. _____

WEATHER
 Clear _____
 Cloudy _____
 Windy _____
 Rain _____
 Fair _____
 Snow _____
 Hot _____
 Moderate _____
 Cold _____
 Fog _____
 Figured By _____
 Notes Checked By _____
 Plotted By _____

FILE No. 139-0
 Fldr. No. _____
 Sheet 10 of 3
 Date ERL13 1948

Quad. No. _____

Station	Dist.	Angle "	+	H. I. Bearing	Ver: Ang. Diff.	Elevation	
		5.90		17.16		11.26	
0+00	= 0	Line B"			12.29		0+00 ON 8" X 2" Tee
0+82.5					9.92	7.24	90° bend. ← 65 3' 3344
1+92					7.77		← 61 3346
3+06					6.49		← 57 3348
4+16					5.20		← 42 3350
5+40					5.17		← 31 3352
T.P.		6.52		20.14	3.54	13.62	































VALUABLE

SUBJECT _____

Return To
 Public Works
 Office
 Camp Lejeune
 North Carolina

FIELD PARTY

_____ In Charge
 _____ Instrument
 _____ Notes
 _____ Tape Read
 _____ Tape or Rod
 _____ Tape or Rod
 _____ Instrument No.
 _____ Tape No.


WEATHER

Clear _____
 Cloudy _____
 Windy _____
 Rain _____
 Fair _____
 Snow _____
 Hot _____
 Moderate _____
 Cold _____
 Fog _____

FILE No. _____
 Fldr. No. _____
 Sheet 2 OF 3
 Date 13 1948

Figured By _____
 Notes Checked By _____
 Plotted By _____
 Quad. No. _____

Station	Dist.	Angle	+	H. I. Bearing	Ver: Ang. Diff.	Elevation
				20.14		
5+74				8 10		
6+64				8 32		
7+59				8 86		
7+98				9 65		
8+74				8 95		
9+71				9 63		
T.P.				3 47 18.21	5 40 14.74	

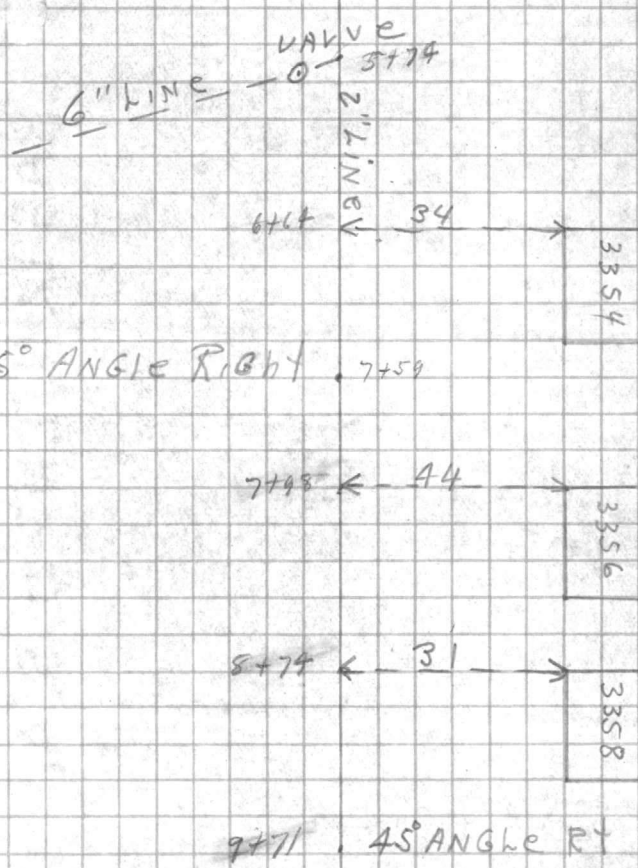

VALUABLE

Return To
Public Works
Office
Camp Lejeune
North Carolina












VALUABLE

SUBJECT _____

Return To
 Public Works
 Office
 Camp Lejeune
 North Carolina

FIELD PARTY

_____ In Charge
 _____ Instrument
 _____ Notes
 _____ Tape Read
 _____ Tape or Rod
 _____ Tape or Rod
 _____ Instrument No.
 _____ Tape No.

WEATHER

Clear
 Cloudy
 Windy
 Rain
 Fair

Snow
 Hot
 Moderate
 Cold
 Fog

FILE No. _____

Fldr. No. _____

Sheet 3 OF 3

Date 2-13 1947

Figured By _____

Notes Checked By _____

Plotted By _____

Quad. No. _____

Station	Dist.	Angle	+	H. I. Bearing	Ver: Ang. Diff.	Elevation
10+00				18.21	7.28	
11+35					7.52	
12+10	2			11.20 "C"		
B.M.					4.41	13.80

Diagram annotations:
 - Station 10+00 to 11+35: horizontal distance 43, vertical difference 33.60
 - Station 11+35 to 12+10: horizontal distance 57, vertical difference 33.42
 - Station 12+10: 8" TCE 2 IN LINE
 - Station B.M.: 13.80 B.M. ON PINE TREE

VALUABLE

Return To
Public Works
Division
Camp Lejeune
North Carolina

SUBJECT

Station

Angle

Bearing

Dist.

Elevation

FIELD PARTY

In Charge _____
Instrument _____
Notes _____
Tape Road _____
Tape or Rod _____
Tape or Rod _____
Instrument No. _____
Tape No. _____

WEATHER

Clear _____
Cloudy _____
Wind _____
Rain _____
Fog _____
Thunder By _____
Notes Checked By _____
Plotted By _____

Grid No.

FILE NO.

Plot No. _____
Sheet _____
Date _____

VALUABLE

SUBJECT LOCATION + Profile
ON 2" WATERLINE
67 Houses

Return To
 Public Works
 Office
 Camp Lejeune
 North Carolina

FIELD PARTY

_____ In Charge
 _____ Instrument
 _____ Notes
 _____ Tape Read
 _____ Tape or Rod
 _____ Tape or Rod
 _____ Instrument No.
 _____ Tape No.


WEATHER

Clear _____
 Cloudy _____
 Windy _____
 Rain _____
 Fair _____
 Snow _____
 Hot _____
 Moderate _____
 Cold _____
 Fog _____

FILE No. _____
 Fldr. No. _____
 Sheet 1052
 Date _____ 19__

Figured By _____
 Notes Checked By _____
 Plotted By _____
 Quad. No. _____

Station	Dist.	Angle "	+	H. I. Bearing	Ver: Ang. Diff.	Elevation	Notes
				5.29 19.47		14.23	BM ON PINE TREE
0+00					7.38 12.09		"T" on 8" line
0+75					6.80 12.67		
2+07							
2+81					11.0 8.5		45° ANGLE LEFT
T.P.					6.27 12.28	13.46 60.1	B.M. ON Gum Tree EL. 600

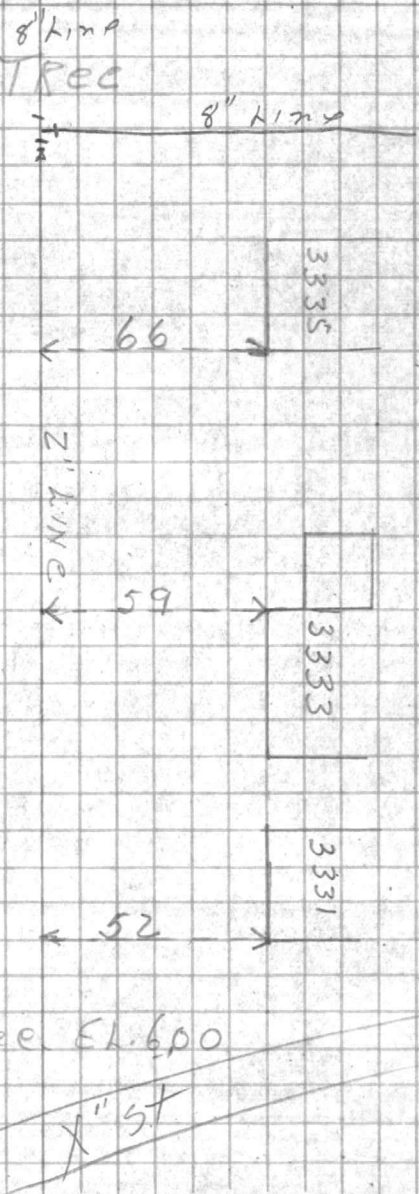

~~X" ST~~

VALUABLE

Return To
Public Works
Office
Camp Lejeune
North Carolina

SUBJECT

Station

Dist.

AT 218

+

Beating

Vol. 1 AND

Division

FIELD PARTY

IR. Charge

Instrument

Notes

Tap or Road

Type of Road

Location

Tap No.

WEATHER

Snow

Fog

Cloudy

Windy

Rain

Cold

Clear

Figured By

Checked By

Plotted By

Sheet No.

File No.

Field No.

Sheet

Checked

Plotted

Sheet

VALUABLE

SUBJECT _____

Return To
Public Works
Office
Camp Lejeune
North Carolina

FIELD PARTY

_____ In Charge
_____ Instrument
_____ Notes
_____ Tape Read
_____ Tape or Rod
_____ Tape or Rod
_____ Instrument No.
_____ Tape No.

WEATHER

Clear
Cloudy
Windy
Rain
Fair

Snow
Hot
Moderate
Cold
Fog

FILE No. _____

Fldr. No. _____

Sheet 2 OF 2

Figured By _____

Notes Checked By _____

Plotted By _____

Date _____ 19__

Quad. No. _____

Station	Dist.	Angle " "	+	H. I. Bearing	Ver: Ang. Diff.	Elevation
				12.28		
5+08						45° Bend
						32
						43
						3328
6+43				763		Tee with 6" line
				627		B.M.














VALUABLE

SUBJECT LOCATION & PROFILE
ON 2" WATER LINE

Return To
Public Works
Office
Camp Lejeune
North Carolina

FIELD PARTY

_____ In Charge
_____ Instrument
_____ Notes
_____ Tape Read
_____ Tape or Rod
_____ Tape or Rod
_____ Instrument No.
_____ Tape No.

WEATHER

Clear _____
Cloudy _____
Windy _____
Rain _____
Fair _____
Snow _____
Hot _____
Moderate _____
Cold _____
Fog _____

FILE No. _____

Fldr. No. _____

Figured By _____ Sheet 1 OF 2




Notes Checked By _____

Plotted By _____ Date FRI-13 1948


Quad. No. _____

Station	Dist.	Angle "	+	H. I. Bearing	Ver: Ang. Diff.	Elevation
			810	19.84		11.74
0400						
1432				9.61	10.23	
2419				7.30		
3436				3.20		
	906	27.62	128	18.56		
4467				10.57		
6406				9.95		

LINE B AT 45° BEND - Pt. OF CIRCLE

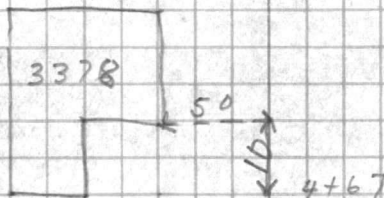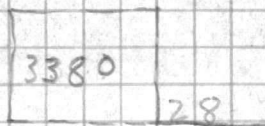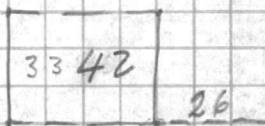

BEND LEFT

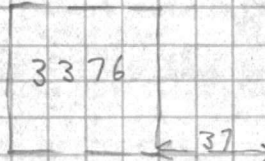

































VALUABLE

SUBJECT _____

Return To
 Public Works
 Office
 Camp Lejeune
 North Carolina

FIELD PARTY

_____ In Charge
 _____ Instrument
 _____ Notes
 _____ Tape Read
 _____ Tape or Rod
 _____ Tape or Rod
 _____ Instrument No.
 _____ Tape No.

WEATHER

Clear
 Cloudy
 Windy
 Rain
 Fair

Snow
 Hot
 Moderate
 Cold
 Fog

FILE No. _____
 Fldr. No. _____
 Sheet 20F2
 Date _____ 19__

Figured By _____
 Notes Checked By _____
 Plotted By _____
 Quad. No. _____

Station	Dist.	Angle "	+	H. I. Bearing	Ver: Ang. Diff.	Elevation	
				27.62			
7+29					12.75		
TP FP				062 20.05	8 19	19.43	
8+61					7.06		
10+22					11.49	8.58	<p>TIES INTO 8" TEE ON LINE TO MAIN SERVICE ROAD (100 HOUSES)</p> <p>B.M. # 4 SET BY SANDLIN.</p>
					7.07		

7+29
 20.05
 19.43

Return To -
Public Works
Office
Camp Lejeune
North Carolina

SUBJECT

Station Dist. Angle H. I. V. I. Elev. Date

FIELD PARTY


Name No. _____
Date No. _____
Instrument _____
Notes _____
Tape Read _____
Tape on Rod _____
Tape on RIB _____

WEATHER

Class _____
Cloudy _____
Wind _____
Rain _____
Fog _____
Notes Checked By _____
Plotted By _____

FIELD NO.

Sheet No. _____
Date _____

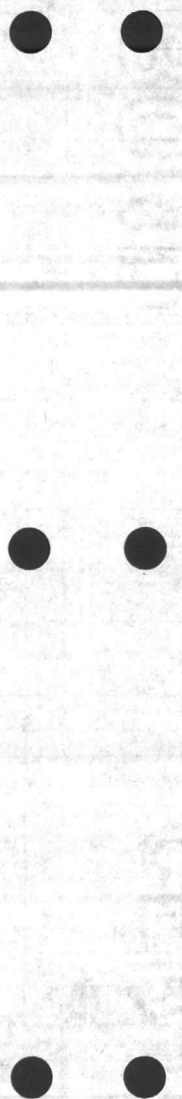

VALUABLE

SUBJECT NEW 8" WATER LINE
TAKE OFF LOCATION @ HOUSES

Return To
 Public Works
 Office
 Camp Lejeune
 North Carolina

FIELD PARTY
KELLY In Charge
 _____ Instrument
 _____ Notes
 _____ Tape Read
 _____ Tape or Rod
 _____ Tape or Rod
 _____ Instrument No.
 _____ Tape No.

WEATHER
 Clear _____
 Cloudy _____
 Windy _____
 Rain _____
 Fair _____
 Snow _____
 Hot _____
 Moderate _____
 Cold _____
 Fog _____
 Figured By _____
 Notes Checked By _____
 Plotted By _____

FILE No. 139-0
 Fldr. No. _____
 Sheet 1-0 F-
 Date 8-14 1977
 Quad. No. _____

Station	Dist.	Angle "	+	H. I. Bearing	Ver: Ang. Diff.	Elevation
B.M.		2.25		25.41		23.16
T.P.		2.69		20.18	7.92	17.49
0+00 12" X 8" TEE					9.20	10.98
0+04 8" GATE VALVE					9.44	10.74
0+34 EDGE OF ROAD					9.62	10.54



TABLE

Return to
Public Works
Office
Camp Lejeune
North Carolina

































VALUABLE

SUBJECT AS Built Water
Line in 67 Houses
8"

Return To
 Public Works
 Office
 Camp Lejeune
 North Carolina


FIELD PARTY
Turlington in Charge
 Instrument _____
 Notes _____
 Tape Read _____
 Tape or Rod _____
 Tape or Rod _____
 Instrument No. _____
 Tape No. _____

WEATHER
 Clear _____
 Cloudy _____
 Windy _____
 Rain _____
 Fair _____
 Snow _____
 Hot _____
 Moderate _____
 Cold _____
 Fog _____
 Figured By _____
 Notes Checked By _____
 Plotted By _____

FILE No. _____
 Fldr. No. _____
 Sheet _____
 Date _____ 19__

Quad. No. _____

Station	Dist.	Angle "	+	H. I. Bearing	Ver: Ang. Diff.	Elevation
BM						14.99
		320		1819"		
1+50					595	13.24
2+24	6" Tee + valve				615	12.04
		3300			667	12.52
3+70		3302			850	9.69
4+96		3304			859	9.60
5+82					592	12.27
6+02		3306			638	11.81
6+69	8"x6" tee + valve to Hyd				920	8.99
7+31		3308			1068	7.51
TP					575	12.44
		334		1598"		
8+69					844	
9+22					852	
9+81	8" Tee + valve				871	7.07
BM					406	11.92 (11.74)

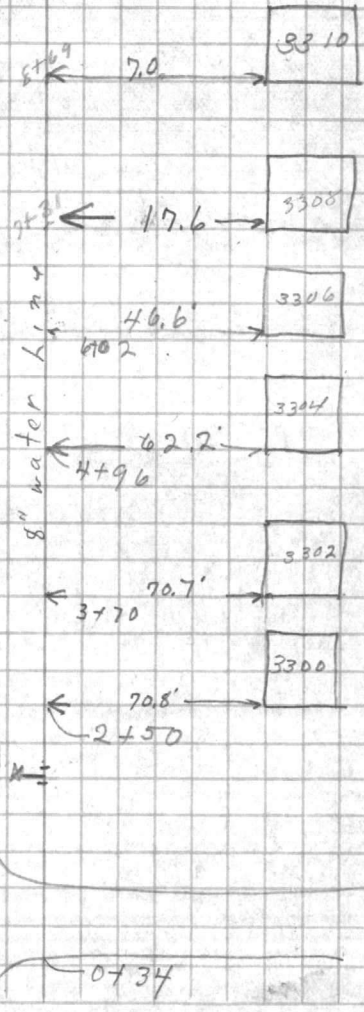













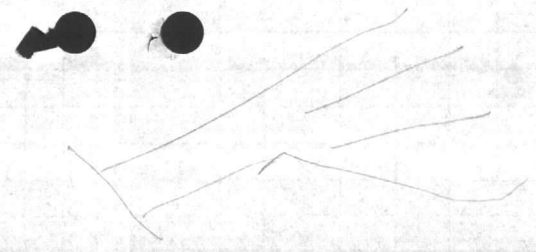

VALUABLE

SUBJECT _____

Return To
 Public Works
 Office
 Camp Lejeune
 North Carolina

FIELD PARTY

_____ In Charge
 _____ Instrument
 _____ Notes
 _____ Tape Read
 _____ Tape or Rod
 _____ Tape or Rod
 _____ Instrument No.
 _____ Tape No.

WEATHER

Clear
 Cloudy
 Windy
 Rain
 Fair



Snow
 Hot
 Moderate
 Cold
 Fog

FILE No. _____
 Fldr. No. _____
 Sheet _____
 Notes Checked By _____
 Plotted By _____ Date _____ 19____

Quad. No. _____

3.15

Station	Dist.	Angle	+	H. I. Bearing	Ver: Ang. Diff.	Elevation
				5.22 16 96		11.74
10+00					9 92	
10+71					9 65	
12.14					7 84	
12.74	= 0+00 h. i. v. "B"				7 72	
T.P.					9 78	
13.00					9 57	
13+60					9 14	
14.00					7 66	
14.91					4 39	
15.31					3 02	
T.P.					2 34	
B.M.					3 12	11.26

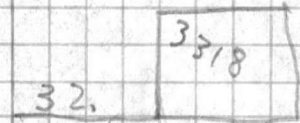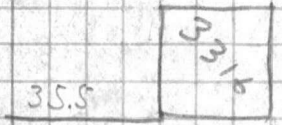

END OF LINE
































VALUABLE

SUBJECT _____

Return To
 Public Works
 Office
 Camp Lejeune
 North Carolina

FIELD PARTY

_____ In Charge
 _____ Instrument
 _____ Notes
 _____ Tape Read
 _____ Tape or Rod
 _____ Tape or Rod
 _____ Instrument No.
 _____ Tape No.

WEATHER


Clear
 Cloudy
 Windy
 Rain
 Fair

Snow
 Hot
 Moderate
 Cold
 Fog

FILE No. _____
 Fldr. No. _____
 Sheet _____
 Date _____ 19__

Quad. No. _____

Station	Dist.	Angle	+	H. I. Bearing	Ver: Ang. Diff.	Elevation
BM				241 1367		11 26
0+00 B = 12+74 'A'					4 30	9.37
1+25	8'x6" T#		Bend		7 63	6.04
4+00					9 25	
4+43	8'x6" T#		Bend		8 76	4.91
5+00					7 75	
TP				8 97 1878	3 86	9 81
6+09					9 46	
41					8 26	
7+47	8" T				6 96	
457					6 87	
8+67					6 66	
790					6 45	
TP				8 66 20 96	6 48	1230

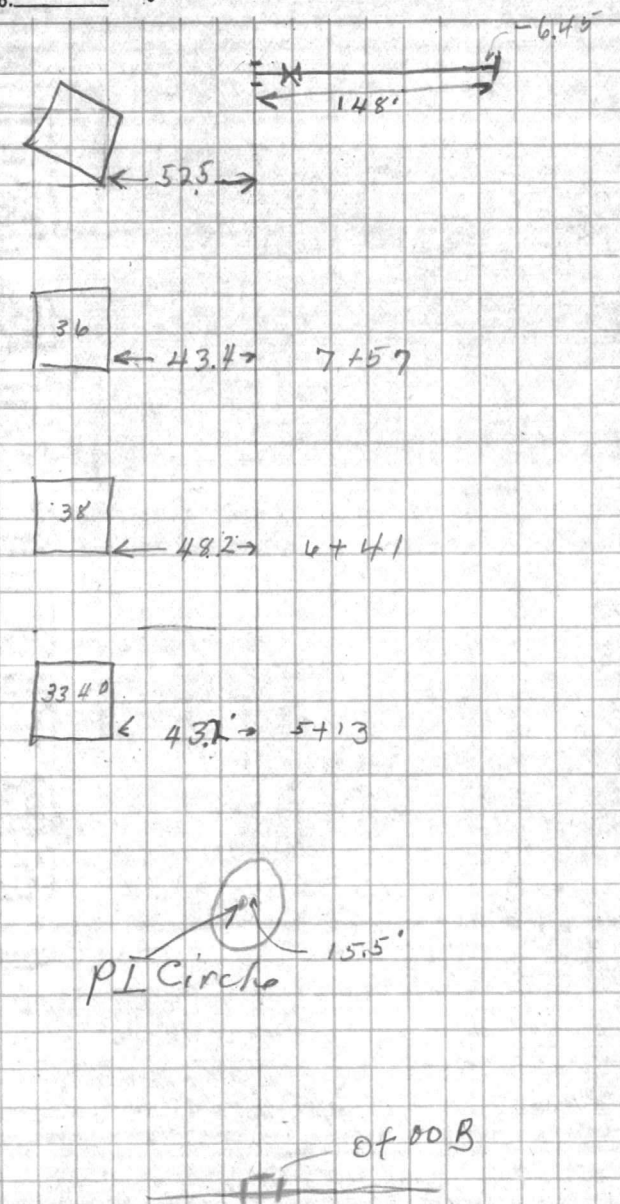

NAVY

RECEIVED
NAVY
OFFICE
WASHINGTON

SUBJECT

NAVY
OFFICE
WASHINGTON

HEAD LINE

IN CODE
INFORMATION
TYPE BOARD
TYPE OF RE
TYPE OF MOD
TYPE OF



FILE NO.

DATE
PAGE

CLASS.



VALUABLE

SUBJECT _____

Return To
 Public Works
 Office
 Camp Lejeune
 North Carolina

FIELD PARTY

_____ In Charge
 _____ Instrument
 _____ Notes
 _____ Tape Read
 _____ Tape or Rod
 _____ Tape or Rod
 _____ Instrument No.
 _____ Tape No.

WEATHER

Clear _____
 Cloudy _____
 Windy _____
 Rain _____
 Fair _____
 Snow _____
 Hot _____
 Moderate _____
 Cold _____
 Fog _____
 Figured By _____
 Notes Checked By _____
 Plotted By _____

FILE No. _____
 Fldr. No. _____
 Sheet _____
 Date _____ 19__

Quad. No. _____

Station	Dist.	Angle	+	H. I. Bearing	Ver: Ang. Diff.	Elevation	
10+00				20 96	8 10		47 ← 65' → 10+22
10+96	8" T				8 41	12.55	
11	Valve						45 ← 68.6 → 15+25
+44	8" T to Hyd				7 93	13 03	
75					7 41		43 ← 71.4 → 14+20
13+16					7 41		
14+20					8 54		41 ← 75.5 → 13+16
TP				340 16 73	7 63	13 33	
15+25					6 25		39 ← 75 → 11+75
16+22					8 02		
BM # 305					2 23	14 50	3237 ← 73.2 → 14+9

VALUABLE

SUBJECT

Warrant to
Public Works
Office
Civil Service
Vocational Training































VALUABLE

SUBJECT _____

Return To
 Public Works
 Office
 Camp Lejeune
 North Carolina

FIELD PARTY

_____ In Charge
 _____ Instrument
 _____ Notes
 _____ Tape Read
 _____ Tape or Rod
 _____ Tape or Rod
 _____ Instrument No.
 _____ Tape No.


WEATHER

Clear _____
 Cloudy _____
 Windy _____
 Rain _____
 Fair _____
 Snow _____
 Hot _____
 Moderate _____
 Cold _____
 Fog _____
 Figured By _____
 Notes Checked By _____
 Plotted By _____

FILE No. _____
 Fldr. No. _____
 Sheet _____
 Date _____ 19__

Quad. No. _____

Station	Dist.	Angle	+	H. I. Bearing	Ver: Ang. Diff.	Elevation
BM # 305			332			14 49
17+30					9 83	
17+84	8" T	0+00 Line "C"			9 75	
18+76					10 86	
BM # 305			332			
BM			130			10 34
18+83	8" T				4 99	
87	8" Valup				5 08	
88					5 08	
92					6 90	
19+41					7 30	
20					7 97	
48					7 15	
21					6 80	
21+58					8 04	
					1 30	

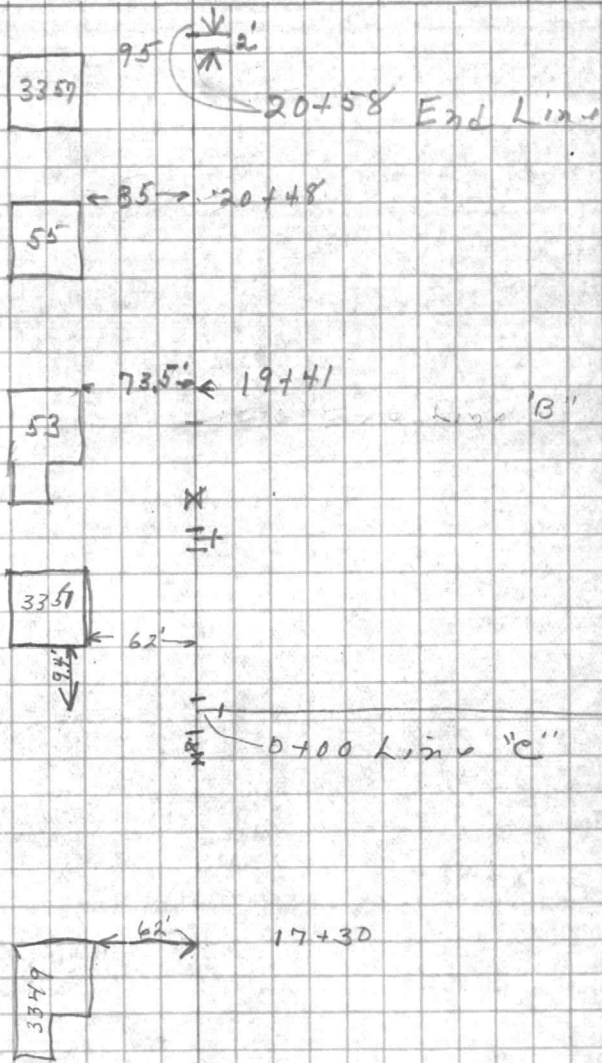













VALUABLE

SUBJECT _____

Return To
Public Works
Office
Camp Lejeune
North Carolina

FIELD PARTY

_____ In Charge
_____ Instrument
_____ Notes
_____ Tape Read
_____ Tape or Rod
_____ Tape or Rod
_____ Instrument No.
_____ Tape No.

WEATHER

Clear _____
Cloudy _____
Windy _____
Rain _____
Fair _____
Snow _____
Hot _____
Moderate _____
Cold _____
Fog _____

FILE No. _____

Fldr. No. _____

Figured By _____ Sheet _____

Notes Checked By _____

Plotted By _____ Date _____ 19__

Quad. No. _____

Station	Dist.	Angle " "	+	H. I. Bearing	Ver: Ang. Diff.	Elevation
---------	-------	--------------	---	------------------	--------------------	-----------

69 2230 RT

~~FSJ~~

12+50

12+80.97 PT F

12+70 ±

PI #1

146³⁸

250 52 30

32 52 30

250 52 30

T on PIT

S 87-16-50 E

B 502 P 16

From 6 to 7

VALUABLE

SUBJECT

Return To
Public Works
Office
Camp Lejeune
North Carolina

FIELD PARTY

IN Charge _____
Instrument _____
Level _____
Time _____
Time of Day _____
Time of Ret. _____
Remarks _____
Date _____

WEATHER

Clear _____
Snow _____
Cloudy _____
Fog _____
Rain _____
Wind _____
Mist _____
Cold _____
Light _____
Signed By _____
Notes Checked By _____
Checked By _____
Date _____

FILE No.

File No. _____
Sheet _____
Date _____

Quartz No.

Station _____ Dist. _____
M. & V. _____
Bar. _____
Elev. _____


VALUABLE

SUBJECT PROFILE ON LINE "C"

WATERLINE AT 67 houses

Return To
Public Works
Office
Camp Lejeune
North Carolina

FIELD PARTY

In Charge _____
Instrument _____
Notes _____
Tape Read _____
Tape or Rod _____
Instrument No. _____
Tape No. _____

WEATHER

Clear _____
Cloudy _____
Windy _____
Rain _____
Fair _____
Snow _____
Hot _____
Moderate _____
Cold _____
Fog _____

FILE No. _____

Fldr. No. _____

Sheet 1-3

Figured By _____

Notes Checked By _____

Plotted By _____

Date _____ 19__

Quad. No. _____

Station	Dist.	Angle " "	+	H. I. Bearing	Ver: Ang. Diff.	Elevation		
0+00 ON "C"	= 17+84 ON LINE B							
B.M.				3 09 17.58		14.49	B.M # 305	
0+50				10 08	7.50		8 X 6" TEE - 6" VALVE + HYD	
2+25				10 84	6.74		8" TEE	
3+42				12.45			← 37.1 → 3364	
T.P.				5 84 15 98	7 44	10.14		
3+97				10 58	5.40		1+1/2" 8 X 6 T + 45° bend	
(1+1/2" 6" LINE)				10 80	5.18		6" LINE - 112 FT	
5+08				10 05	5.93		← 27.1 → 3366	
6+27				8 53	7.45		← 20.5 → 3368	










VALUABLE

SUBJECT _____

Return To
 Public Works
 Office
 Camp Lejeune
 North Carolina

FIELD PARTY

_____ In Charge
 _____ Instrument
 _____ Notes
 _____ Tape Read
 _____ Tape or Rod
 _____ Tape or Rod
 _____ Instrument No.
 _____ Tape No.

WEATHER

Clear
 Cloudy
 Windy
 Rain
 Fair

Snow
 Hot
 Moderate
 Cold
 Fog

FILE No. _____

Fldr. No. _____

Sheet 2-3

Figured By _____
 Notes Checked By _____
 Plotted By _____

Date _____ 19__

Quad. No. _____

Station	Dist.	Angle " "	+	H. I. Bearing	Ver: Ang. Diff.	Elevation	
				15 98			
7418					6.80	9.18	← 287 6.0°
7460					7.50	8.48	8" TCC
7465					5.81	10.17	TOP 8" VALVE
9400					8.40	7.58	
9450					6.43	9.55	
T.P.		9 30		1990	5.38	10.60	
10400					7.56	12.34	
11400					6.23	13.67	
12400					8.00	11.90	
13400					9.54	10.36	
13464					9.88	10.02	
14400					10.00	9.90	
14484					11.05	8.85	

3370

~~2460~~
~~3491~~
~~341~~

7418
 3491
 341

P.T.
 12+80.97
 ON F" st

10. 12+70.97 = + ON F" st
 13+64 = w.r.
 4" K" st





















VALUABLE

SUBJECT _____

Return To
 Public Works
 Office
 Camp Lejeune
 North Carolina

FIELD PARTY

_____ In Charge
 _____ Instrument
 _____ Notes
 _____ Tape Read
 _____ Tape or Rod
 _____ Tape or Rod
 _____ Instrument No.
 _____ Tape No.

WEATHER

Clear _____
 Cloudy _____
 Windy _____
 Rain _____
 Fair _____
 Snow _____
 Hot _____
 Moderate _____
 Cold _____
 Fog _____

FILE No. _____
 Fldr. No. _____
 Sheet 3-3
 Date _____ 19__

Figured By _____
 Notes Checked By _____
 Plotted By _____

Quad. No. _____

Station	Dist.	Angle	"	+	H. I. Bearing	Ver: Ang. Diff.	Elevation	
15+00					19 90	10 86	9 04	
T. P.		12 27			21.42	10 75	9 15	
15+44						8 96	12 46	
15+79						4 84	16 58	
16+00						2 83	18 59	
T. P.		12 63			32 74	1 31	20.11	
16+35						11 68	21.06	
16+50						10.14	22.60	
T P		1 94			31.45	3 23	29 51	T.P. ON FIRE PLUG AT house # 3202 ON MAIN SERVICE DRIVE RIVER ROAD
17+25						6 91	25.54	
17+57.2								Q ROAD
						8.40	23 05	B.M. # 11 ELEV. 2308









VALUABLE

SUBJECT _____

Return To
 Public Works
 Office
 Camp Lejeune
 North Carolina

FIELD PARTY
 _____ In Charge
 _____ Instrument
 _____ Notes
 _____ Tape Read
 _____ Tape or Rod
 _____ Tape or Rod
 _____ Instrument No.
 _____ Tape No.

WEATHER
 Clear _____
 Cloudy _____
 Windy _____
 Rain _____
 Fair _____
 Snow _____
 Hot _____
 Moderate _____
 Cold _____
 Fog _____
 Figured By _____
 Notes Checked By _____
 Plotted By _____

FILE No. _____
 Fldr. No. _____
 Sheet _____
 Date _____ 19__

Quad. No. _____

Station	Dist.	Angle " "	+	H. I. Bearing	Ver: Ang. Diff.	Elevation	
TP				2 81 32 32		29 51	TOP Hyd
					7 18		ON "T" in 12" line
					8 31		ON 8" line AT valve






















VALUABLE

SUBJECT Location of 12" Valve Near House # 3211

Return To Public Works Office Camp Lejeune North Carolina

FIELD PARTY In Charge Instrument Notes Tape Read Tape or Rod Tape or Rod Instrument No. Tape No.

WEATHER Clear Cloudy Windy Rain Fair Snow Hot Moderate Cold Fog Figured By Notes Checked By Plotted By

FILE No. Fldr. No. Sheet 2-2 Date 19

Quad. No.

Survey grid with columns: Station, Dist., Angle, H. I. Bearing, Ver: Ang. Diff., Elevation. Includes handwritten sketches of points 3212, 3211, 3310, a 12 Valve, and River Road.









 

VALUABLE

SUBJECT

2" water line

"B" street

Return To
Public Works
Office
Camp Lejeune
North Carolina

FIELD PARTY

____ In Charge
____ Instrument
____ Notes
____ Tape Read
____ Tape or Rod
____ Instrument No.
____ Tape No.

WEATHER

Clear _____
Cloudy _____
Windy _____
Rain _____
Fair _____
Snow _____
Hot _____
Moderate _____
Cold _____
Fog _____

FILE No. 139-0

Fldr. No. _____

Figured By _____ Sheet 1-1

Notes Checked By _____

Plotted By _____ Date _____ 19__

Quad. No. _____

Station	Dist.	Angle ' "	+	H. I. Bearing	Ver: Ang. Diff.	Elevation	
						1442	B.M. 305
0+00		2 91		17 33		1070	6.63 ON 8" X 6" X 2" TEE
						1104	6.29
1+32							3361
							28
2+00						1132	
							3363
3+08						1032	7.01
							83
T.P.		3 54		12 04		883	8.50
							3365
3+86						632	
							80
4+06						732	1" COPPER LINE TO HOUSE
							3367
4+68						723	
							50
4+77						722	END 2" LINE
						3348	70 B.M. ON PINE TREE ELEV. 8.72



























VALUABLE

Return To
Public Works
Office
Camp Lejeune
North Carolina

SUBJECT

6" Line From 8"
on "A" st to Hyd on "X" st

FIELD PARTY

In Charge _____
Instrument _____
Notes _____
Tape Read _____
Tape or Rod _____
Tape or Rod _____
Instrument No. _____
Tape No. _____

WEATHER

Clear _____
Cloudy _____
Windy _____
Rain _____
Fair _____
Snow _____
Hot _____
Moderate _____
Cold _____
Fog _____

FILE No. 139-0

Fldr. No. _____


Figured By _____ Sheet _____

Notes Checked By _____

Plotted By _____ Date _____ 19__

Quad. No. _____

Station	Dist.	Angle	+	H. I. Bearing	Ver: Ang. Diff.	Elevation
BM						11 26
0+00	6" Line	689		1815	6 44	
0+46					6 75	
1+00					8 20	
2+00					8 45	
3+28	6" T				13 67	
3+78	Hyd					
BM					6 90	

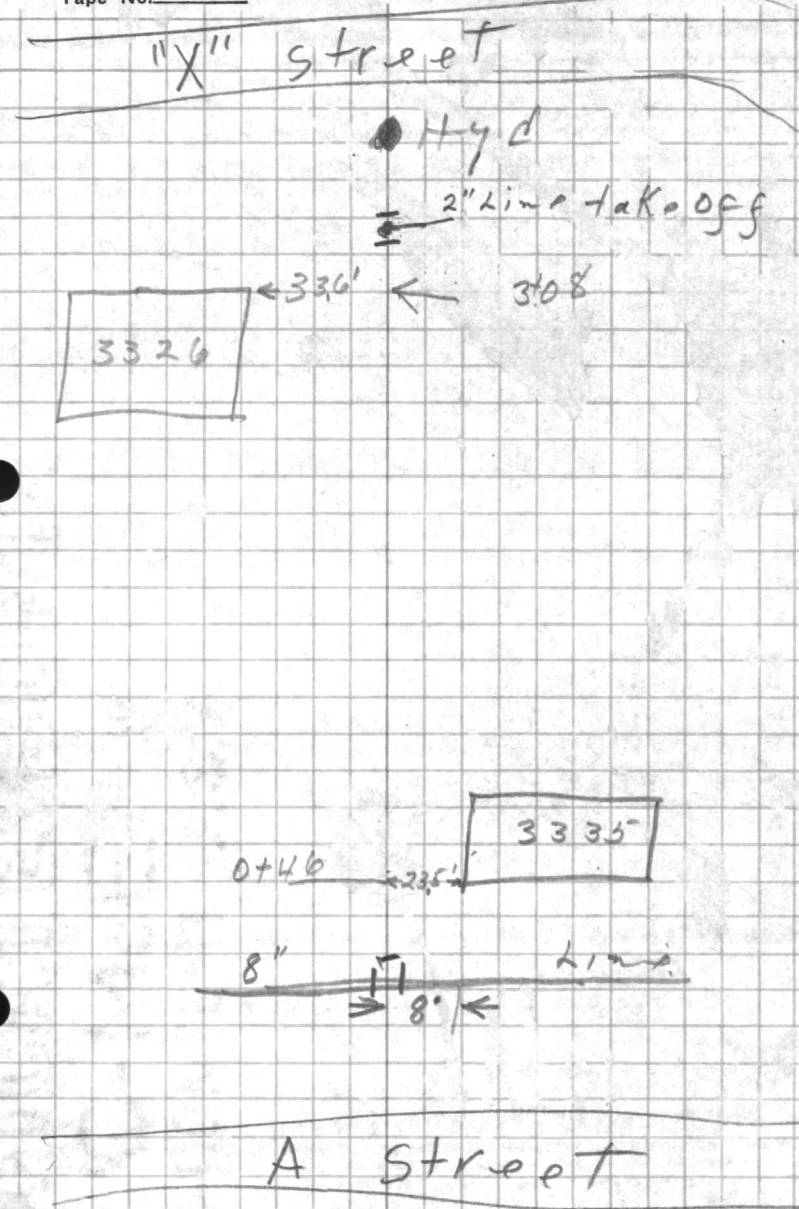

VALUABLE

SUBJECT 2" Line West
Side 'A' street

Return To
Public Works
Office
Camp Lejeune
North Carolina

FIELD PARTY

Turlington in Charge
Instrument _____
Notes _____
Tape Read _____
Tape or Rod _____
Tape or Rod _____
Instrument No. _____
Tape No. _____


WEATHER

Clear _____
Cloudy _____
Windy _____
Rain _____
Fair _____
Snow _____
Hot _____
Moderate _____
Cold _____
Fog _____
Figured By _____
Notes Checked By _____
Plotted By _____

FILE No. _____
Fldr. No. _____
Sheet _____
Date _____ 19__

Quad. No. _____

Station	Dist.	Angle	+	H. I. Bearing	Ver: Ang. Diff.	Elevation
BM						14 99
		321		1820		
0+00	End 2" line =			A	6.22	
+02	Valu				9.06	
1+47.4	E/BOW				6.89	
2+05					6.45	
3+00					7.90	
5+00					7.34	
754					8.80	940
6+78					4.93	1327
TP		168		1495		
700					5.64	
8+77					8.50	
10+09.5	Elbow				9.44	
+48	Valu				8.18	
11+50	=			A	3.21	1174
BM						

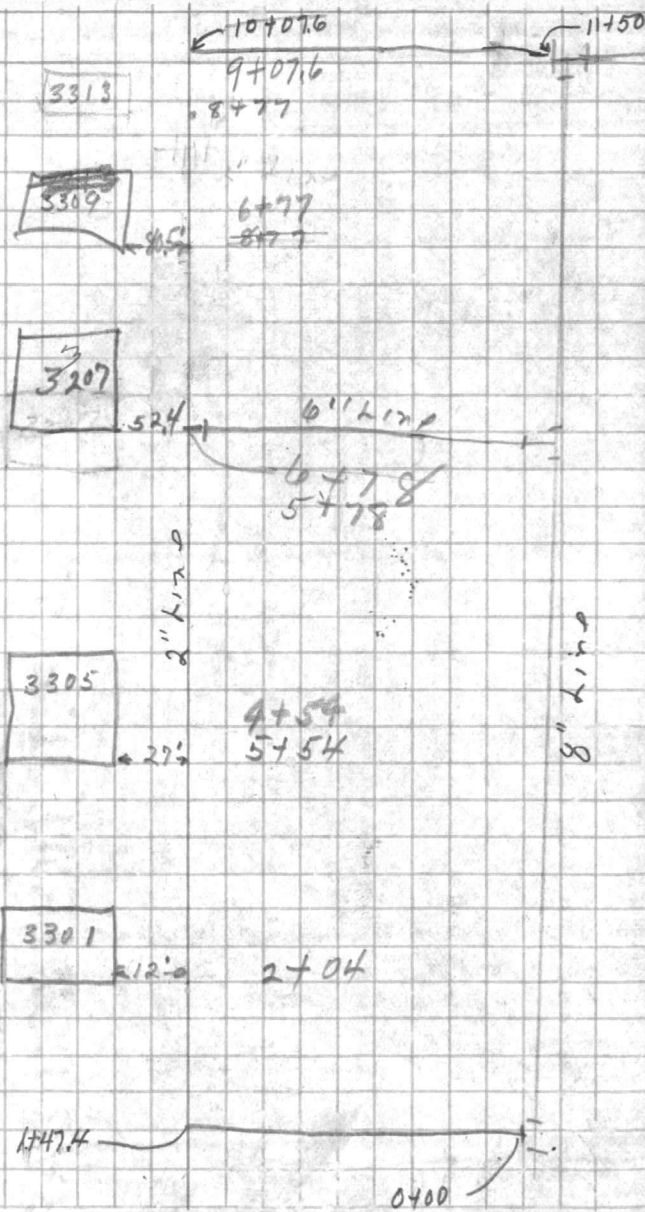







 

420894 + 85

VALUABLE

SUBJECT LOCATION OF WATER
LINES TO 67 HOUSES
1" Lines From Main
line to House

Return To
 Public Works
 Office
 Camp Lejeune
 North Carolina


FIELD PARTY
Turlington In Charge
 Instrument _____
Garnet Notes
Copper Tape Read
Ketchum Tape or Rod
Padgett Tape or Rod
 Instrument No. _____
 Tape No. _____

WEATHER
 Clear _____
 Cloudy _____
 Windy _____
 Rain _____
 Fair _____
 Snow _____
 Hot _____
 Moderate _____
 Cold _____
 Fog _____
 Figured By _____
 Notes Checked By _____
 Plotted By _____

FILE No. 139-0
 Fldr. No. _____
 Sheet 1 of 70
 Date 2/24 1944

Quad. No. _____

Station	Dist.	Angle " "	+	H. I. Bearing	Ver: Ang. Diff.	Elevation
---------	-------	--------------	---	------------------	--------------------	-----------

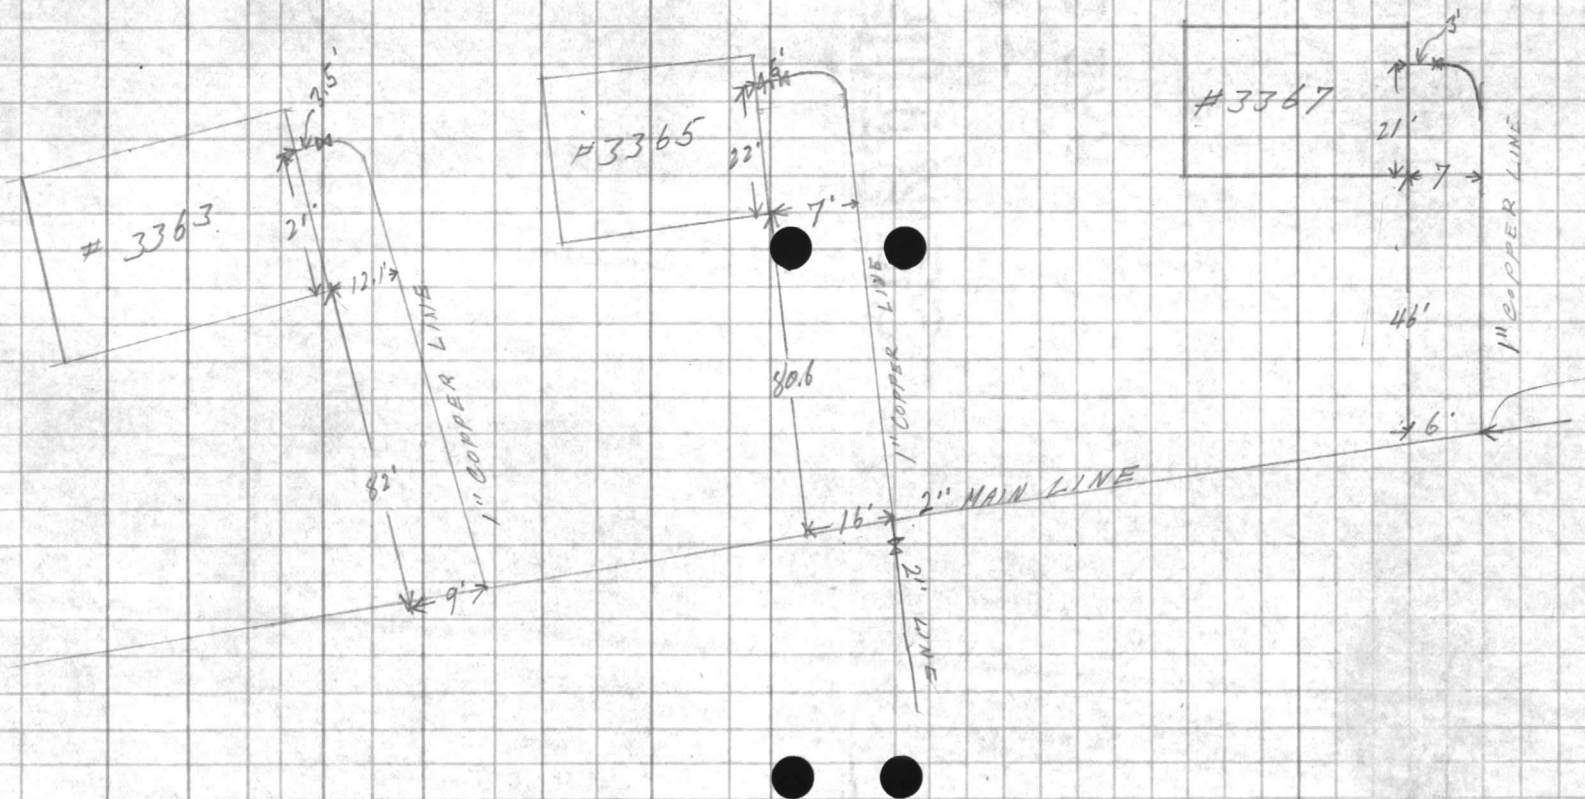










































VALUABLE

SUBJECT LOCATION OF WATER
LINES CONT.

Return To
 Public Works
 Office
 Camp Lejeune
 North Carolina

FIELD PARTY

_____ In Charge
 _____ Instrument
 _____ Notes
 _____ Tape Read
 _____ Tape or Rod
 _____ Tape or Rod
 _____ Instrument No.
 _____ Tape No.

WEATHER

Clear _____
 Cloudy _____
 Windy _____
 Rain _____
 Fair _____
 Snow _____
 Hot _____
 Moderate _____
 Cold _____
 Fog _____

FILE No. _____

Fldr. No. _____


Sheet 2 of 70

Date 2/24 1948

Figured By _____
 Notes Checked By _____
 Plotted By _____

Quad. No. _____

Station	Dist.	Angle	"	+	H. I. Bearing	Ver: Ang. Diff.	Elevation
---------	-------	-------	---	---	------------------	--------------------	-----------

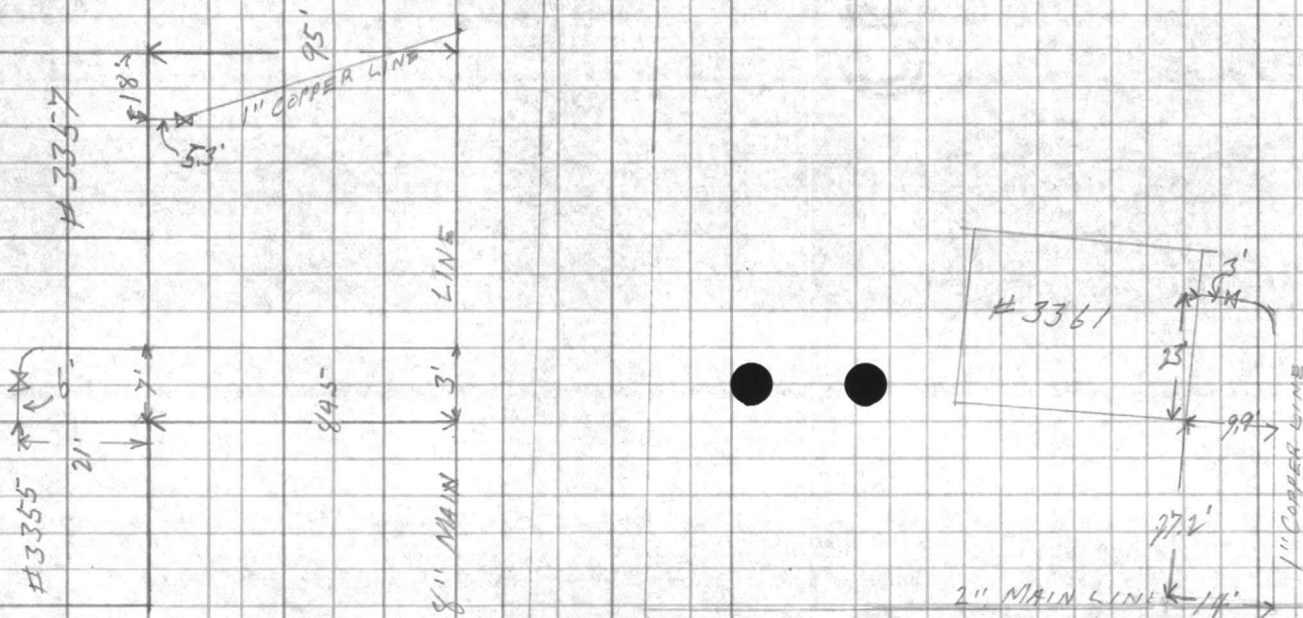




















VALUABLE

SUBJECT _____

Return To
 Public Works
 Office
 Camp Lejeune
 North Carolina

FIELD PARTY

_____ In Charge
 _____ Instrument
 _____ Notes
 _____ Tape Read
 _____ Tape or Rod
 _____ Tape or Rod
 _____ Instrument No.
 _____ Tape No.

WEATHER

Clear _____
 Cloudy _____
 Windy _____
 Rain _____
 Fair _____

Snow _____
 Hot _____
 Moderate _____
 Cold _____
 Fog _____

FILE No. _____

Fldr. No. _____

Sheet 3 of 10

Figured By _____


Notes Checked By _____

Plotted By _____

Date _____ 19__

Quad. No. _____

Station	Dist.	Angle	+	H. I. Bearing	Ver: Ang. Diff.	Elevation
---------	-------	-------	---	------------------	--------------------	-----------

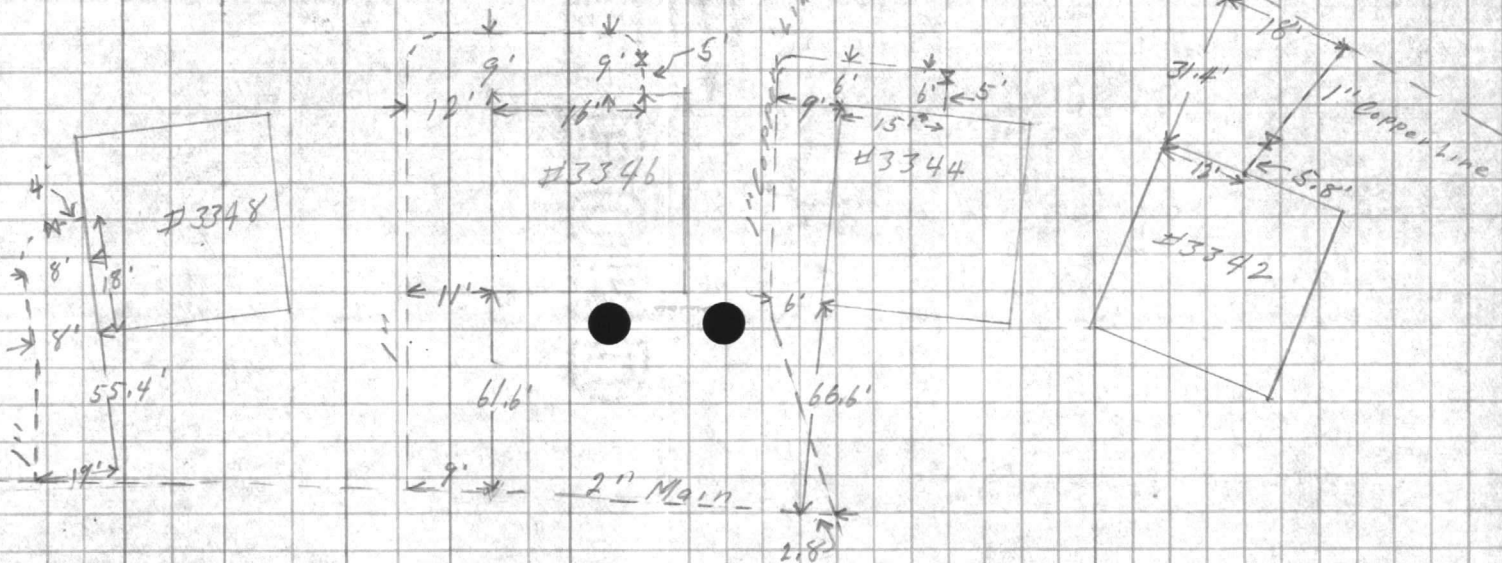















VALUABLE

SUBJECT _____

Return To
Public Works
Office
Camp Lejeune
North Carolina

FIELD PARTY

_____ In Charge
_____ Instrument
_____ Notes
_____ Tape Read
_____ Tape or Rod
_____ Instrument No.
_____ Tape No.

WEATHER

Clear _____
Cloudy _____
Windy _____
Rain _____
Fair _____
Snow _____
Hot _____
Moderate _____
Cold _____
Fog _____

FILE No. _____

Fldr. No. _____


Figured By _____ Sheet 4 of 40

Notes Checked By _____

Plotted By _____ Date 2/24 1945

Quad. No. _____

Station	Dist.	Angle	H. I. Bearing	Ver: Ang. Diff.	Elevation
---------	-------	-------	---------------	-----------------	-----------

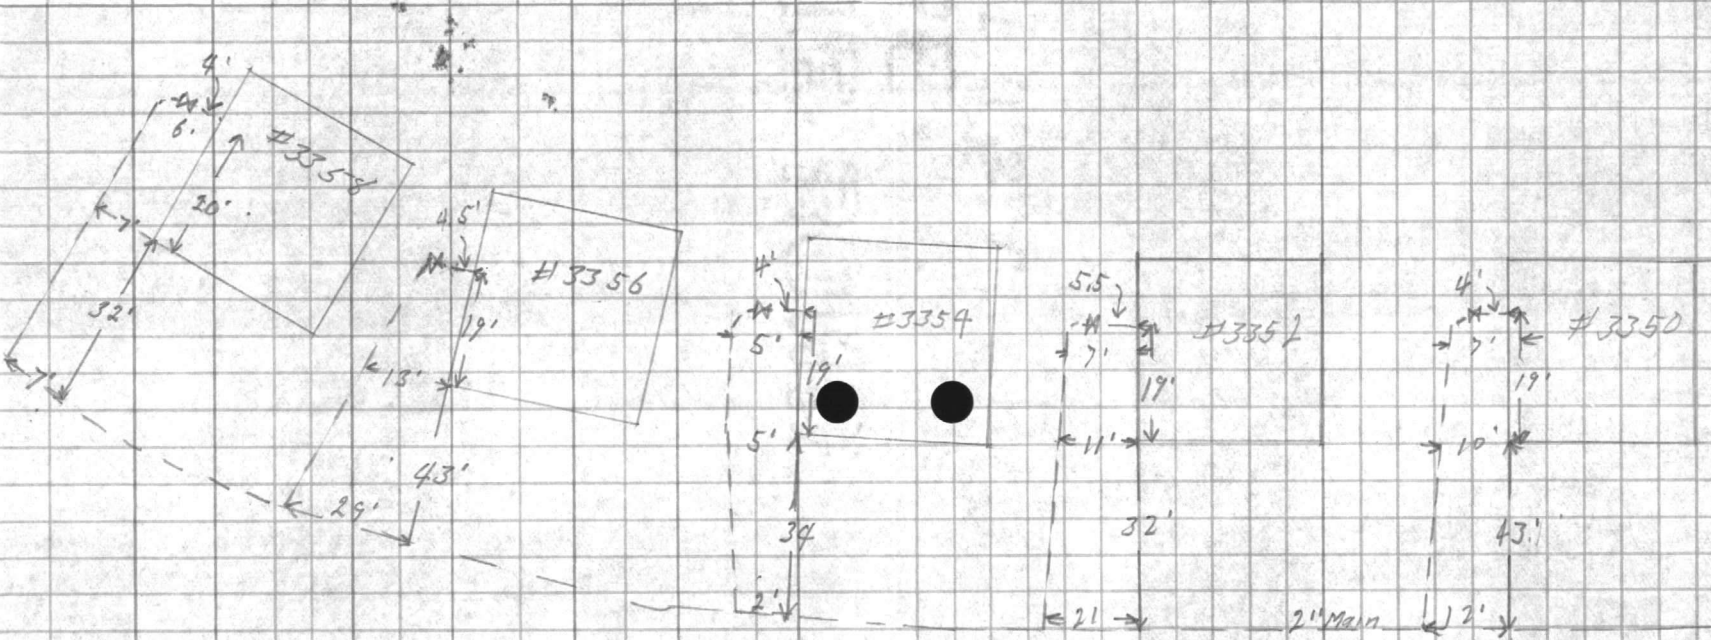













































VALUABLE

SUBJECT _____

Return To
 Public Works
 Office
 Camp Lejeune
 North Carolina

FIELD PARTY

_____ In Charge
 _____ Instrument
 _____ Notes
 _____ Tape Read
 _____ Tape or Rod
 _____ Instrument No.
 _____ Tape No.

WEATHER

Clear
 Cloudy
 Windy
 Rain
 Fair

Snow
 Hot
 Moderate
 Cold
 Fog

FILE No. _____

Fldr. No. _____

Sheet 6 of 10

Date 2/24 1948


Figured By _____

Notes Checked By _____

Plotted By _____

Quad. No. _____

Station	Dist.	Angle ' "	+	H. I. Bearing	Ver: Ang. Diff.	Elevation
---------	-------	--------------	---	------------------	--------------------	-----------

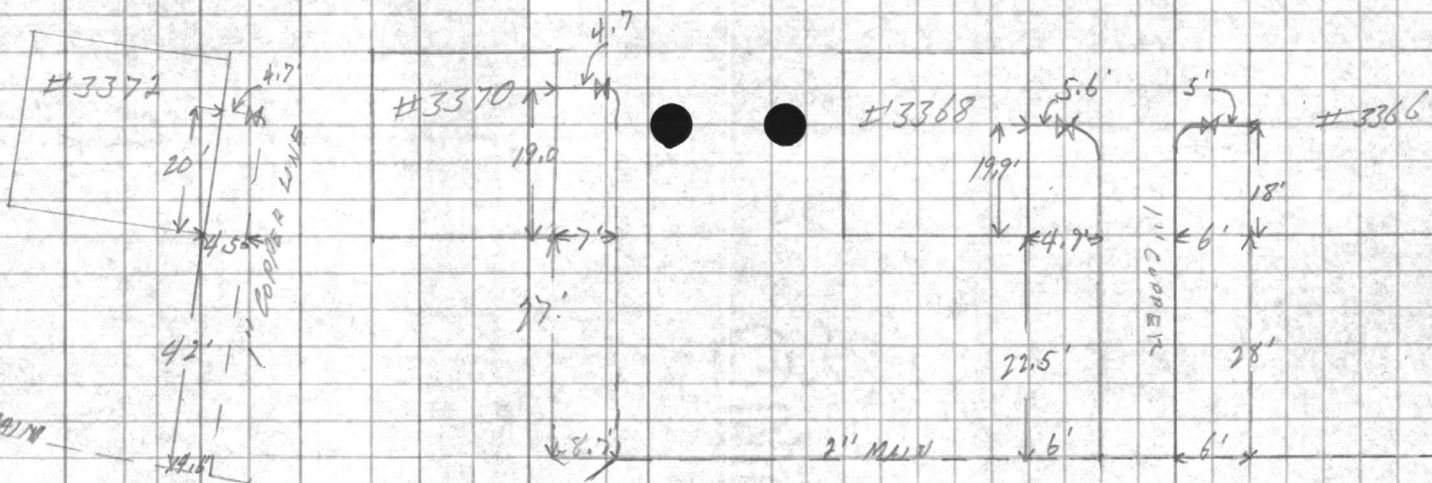








































































VALUABLE

SUBJECT Location of 1"
Water Lines to
Houses From
Main

Return To
 Public Works
 Office
 Camp Lejeune
 North Carolina


FIELD PARTY
Turkington Charge
 Instrument _____
 Notes _____
 Tape Read _____
 Tape or Rod _____
 Tape or Rod _____
 Instrument No. _____
 Tape No. _____

WEATHER
 Clear _____
 Cloudy _____
 Windy _____
 Rain _____
 Fair _____
 Snow _____
 Hot _____
 Moderate _____
 Cold _____
 Fog _____
 Figured By _____
 Notes Checked By _____
 Plotted By _____

FILE No. 139-0
 Fldr. No. _____
 Sheet 7-6
 Date 2-27 1948

Quad. No. _____

Station	Dist.	Angle "	+	H. I. Bearing	Ver: Ang. Diff.	Elevation
---------	-------	---------	---	---------------	-----------------	-----------

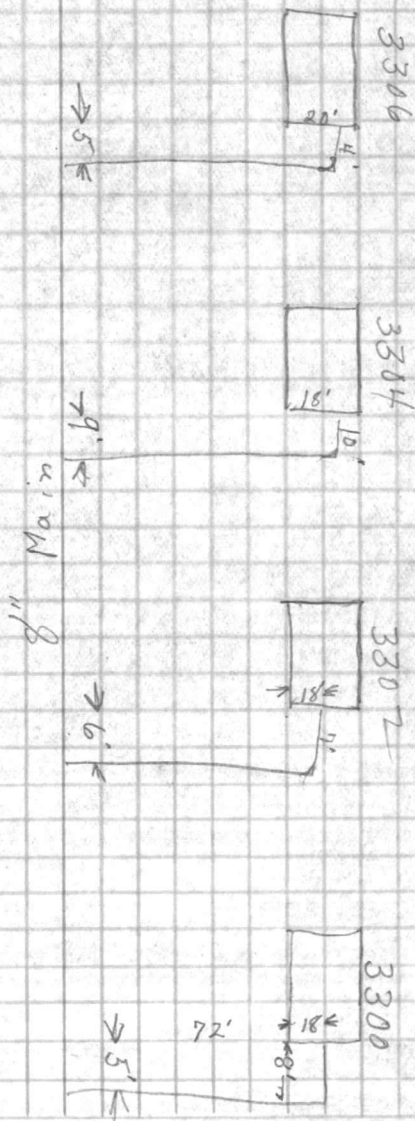

VALUABLE

SUBJECT LOCATION OF WATER PIPES
TO HOUSES AT 67 HOUSES

Return To
 Public Works
 Office
 Camp Lejeune
 North Carolina

FIELD PARTY

Yamer In Charge
 _____ Instrument
 _____ Notes
 _____ Tape Read
 _____ Tape or Rod
 _____ Instrument No.
 _____ Tape No.

WEATHER

Clear
 Cloudy
 Windy
 Rain
 Fair

Snow
 Hot
 Moderate
 Cold
 Fog

FILE No. _____

Fldr. No. _____


Figured By _____ Sheet 2 of 6

Notes Checked By _____

Plotted By _____ Date 2/27 1948

Quad. No. _____

Station	Dist.	Angle	H. I. Bearing	Ver. Ang. Diff.	Elevation
---------	-------	-------	---------------	-----------------	-----------

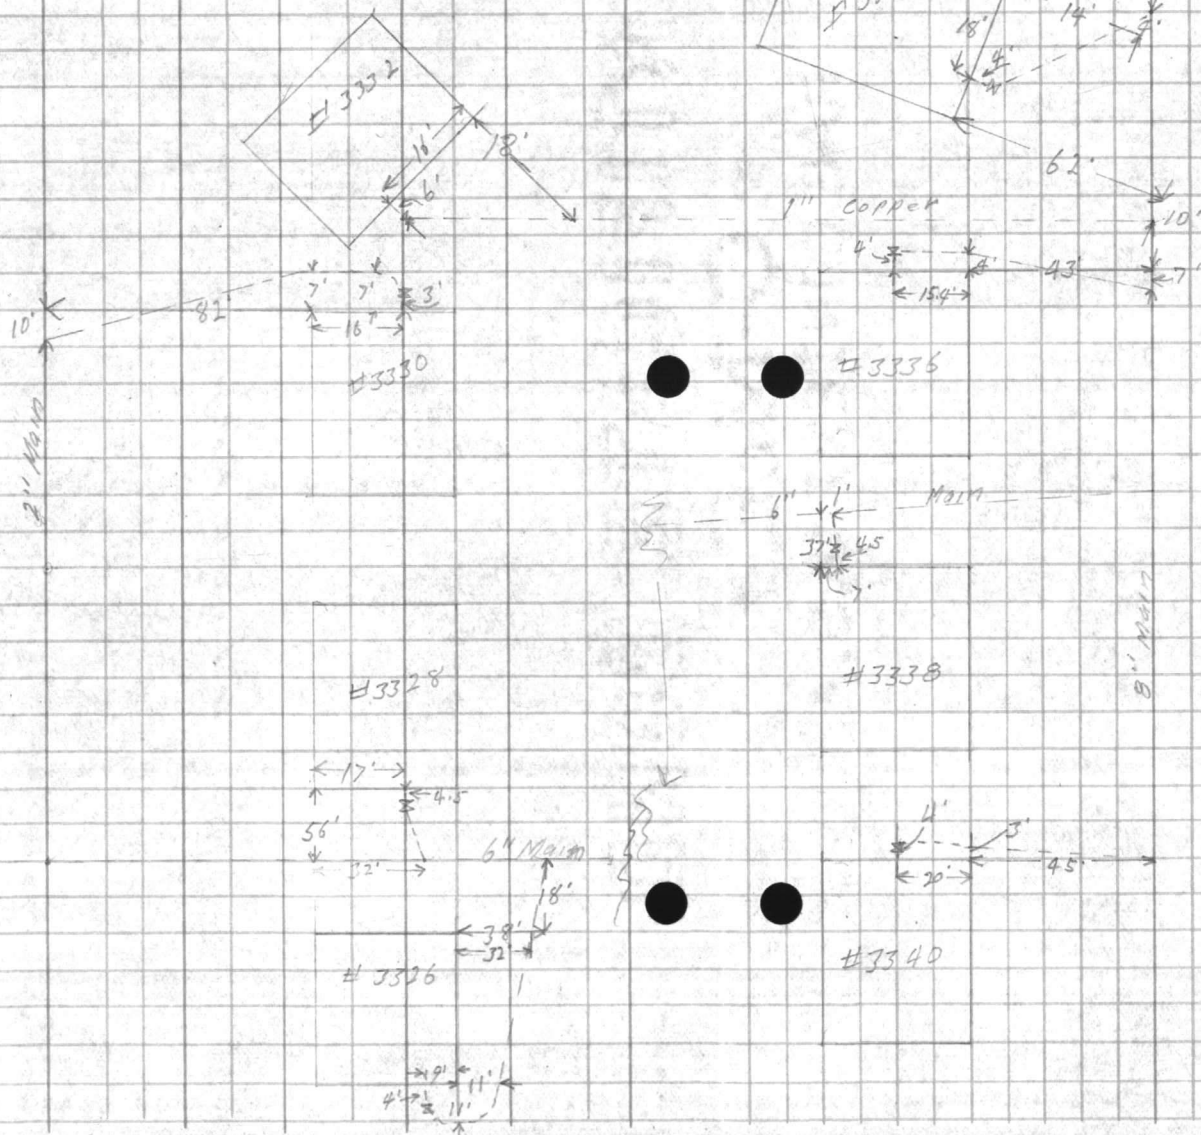






VALUABLE

SUBJECT WATER PIPES CONT.

Return To
Public Works
Office
Camp Lejeune
North Carolina

FIELD PARTY

____ In Charge
____ Instrument
____ Notes
____ Tape Read
____ Tape or Rod
____ Instrument No.
____ Tape No.

WEATHER

Clear
Cloudy
Windy
Rain
Fair

Snow
Hot
Moderate
Cold
Fog

FILE No. _____

Fldr. No. _____

Sheet 2 of 6

Figured By _____


Notes Checked By _____

Plotted By _____

Date 2/27 1948

Quad. No. _____

Station	Dist.	Angle	+	H. I. Bearing	Ver: Ang. Diff.	Elevation
---------	-------	-------	---	------------------	--------------------	-----------

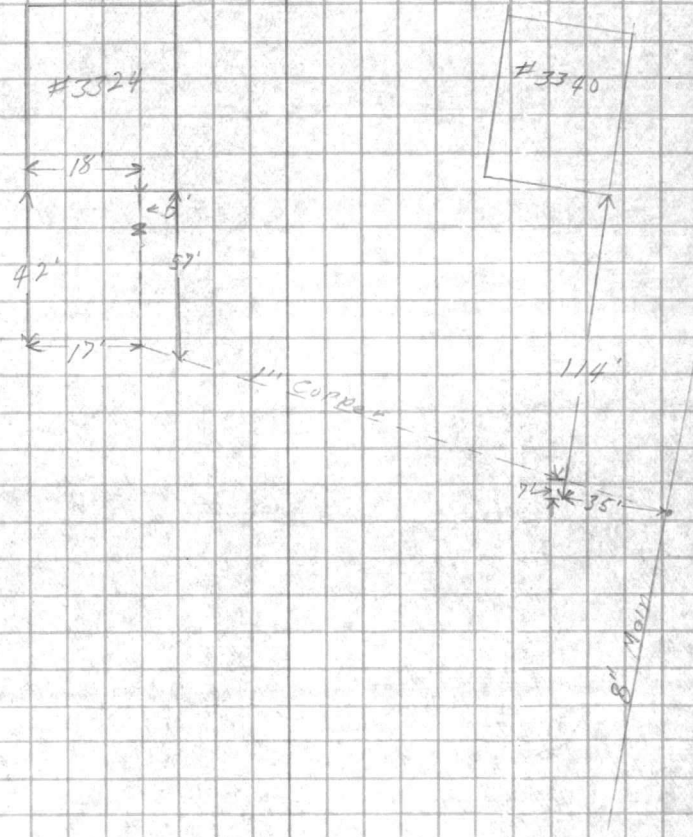
















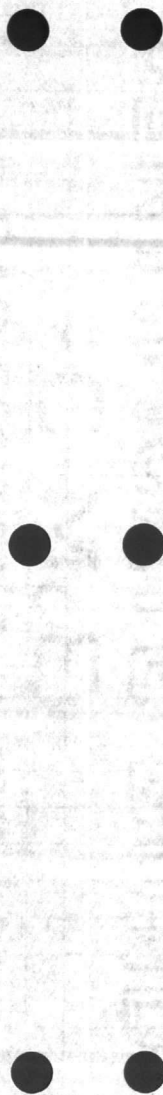

VALUABLE

SUBJECT _____

Return To
Public Works
Office
Camp Lejeune
North Carolina

FIELD PARTY

____ In Charge
____ Instrument
____ Notes
____ Tape Read
____ Tape or Rod
____ Instrument No.
____ Tape No.

WEATHER

Clear
Cloudy
Windy
Rain
Fair

Snow
Hot
Moderate
Cold
Fog

FILE No. _____

Fldr. No. _____

Figured By _____ Sheet 576

Notes Checked By _____

Plotted By _____ Date 2/27 1948

Quad. No. _____

Station	Dist.	Angle	+	H. I. Bearing	Ver: Ang. Diff.	Elevation
#3307	4.2	20	8'	50'	9'	
#3305	6.2	17	9'	26'	12'	
#3303	3.2	26	4'	14.5'	3.5'	
#3301	4.2	21.5	5'	12'	6'	

