

VALUABLE

SUBJECT Water Line LOC,
AT Pine Grove Trailer
Park

RETURN TO
PUBLIC WORKS
OFFICE
CAMP LEJEUNE
NORTH CAROLINA

FIELD PARTY
Kellum IN CHARGE
____ INSTRUMENT
____ NOTES
____ TAPE READ
____ TAPE OR ROD
____ TAPE OR ROD
____ INSTRUMENT No.
____ TAPE No.

WEATHER
CLEAR _____
CLOUDY _____
WINDY _____
RAIN _____
FAIR _____
SNOW _____
HOT _____
MODERATE _____
COLD _____
FOG _____
FIGURED BY _____
NOTES CHECKED BY _____
PLOTTED BY _____


FILE No. 140-5
FLDR. No. _____
SHEET 1 of
DATE 6-6 1957

Quad. No. _____

STATION	DIST.	ANGLE ° ' "	+	H. I. BEARING	VER: ANG. DIFF.	ELEVATION
---------	-------	----------------	---	------------------	--------------------	-----------

Top of 6" C.I. pipe AT tee 3.15
Below Pavement

~~Old #410
2nd 1958 moved
to Terrace~~

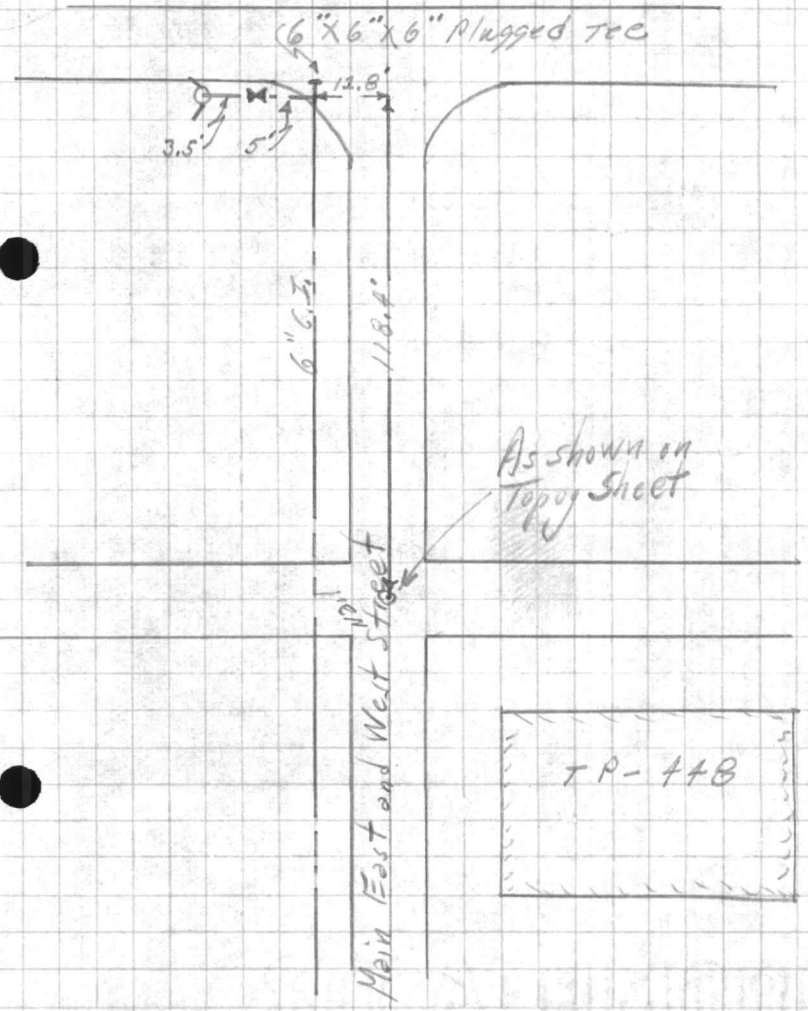






VALUABLE

SUBJECT Water Line Loc.
cont'd.

RETURN TO
PUBLIC WORKS
OFFICE
CAMP LEJEUNE
NORTH CAROLINA

FIELD PARTY

____ IN CHARGE
____ INSTRUMENT
____ NOTES
____ TAPE READ
____ TAPE OR ROD
____ TAPE OR ROD
____ INSTRUMENT No.
____ TAPE No.

WEATHER

CLEAR _____
CLOUDY _____
WINDY _____
RAIN _____
FAIR _____
SNOW _____
HOT _____
MODERATE _____
COLD _____
FOG _____

FILE No. _____

FLDR. No. _____

SHEET 2 of

FIGURED BY _____

NOTES CHECKED BY _____

PLOTTED BY _____


DATE 6-6-59

Quad. No. _____

STATION	DIST.	ANGLE		+	H. I. BEARING	VER. ANG. DIFF.	ELEVATION
		'	"				

TOP of 6" C.I. W.L. 2.9 Below ground at toe

TOP of C.I. W.L. 2.2' Below ground at toe
STAKE over toe

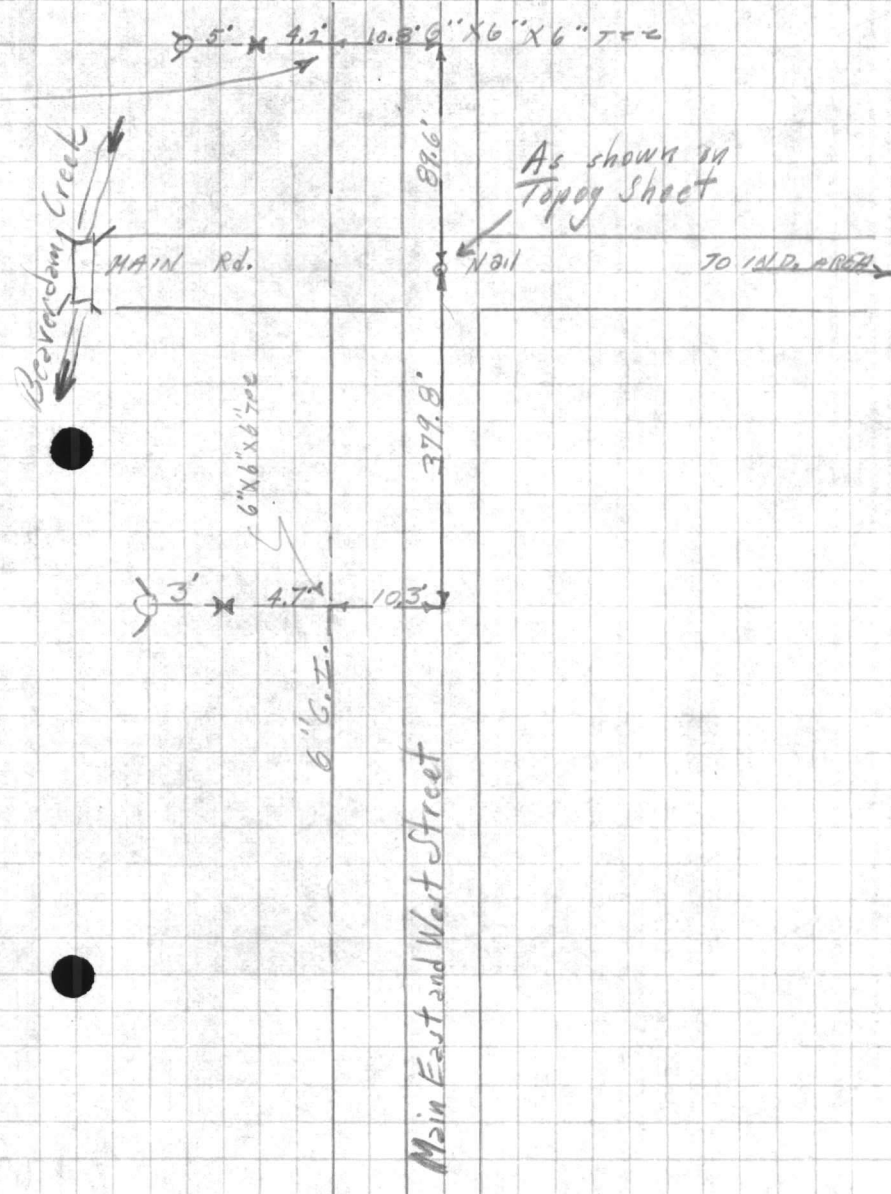






VALUABLE

SUBJECT Water Line Loop
AT Pine Grove Trailer
Park

RETURN TO
PUBLIC WORKS
OFFICE
CAMP LEJEUNE
NORTH CAROLINA

FIELD PARTY

Kellam IN CHARGE

INSTRUMENT

NOTES

TAPE READ

TAPE OR ROD

TAPE OR ROD

INSTRUMENT No.

TAPE No.

WEATHER

CLEAR
CLOUDY
WINDY
RAIN
FAIR

SNOW
HOT
MODERATE
COLD
FOG

FILE No. _____

FLDR. No. _____



FIGURED BY _____ SHEET 3-04

NOTES CHECKED BY _____

PLOTTED BY _____ DATE 6-11-1957

Quad. No. _____

STATION	DIST.	ANGLE	H. I. BEARING	VER. ANG. DIFF.	ELEVATION
---------	-------	-------	---------------	-----------------	-----------

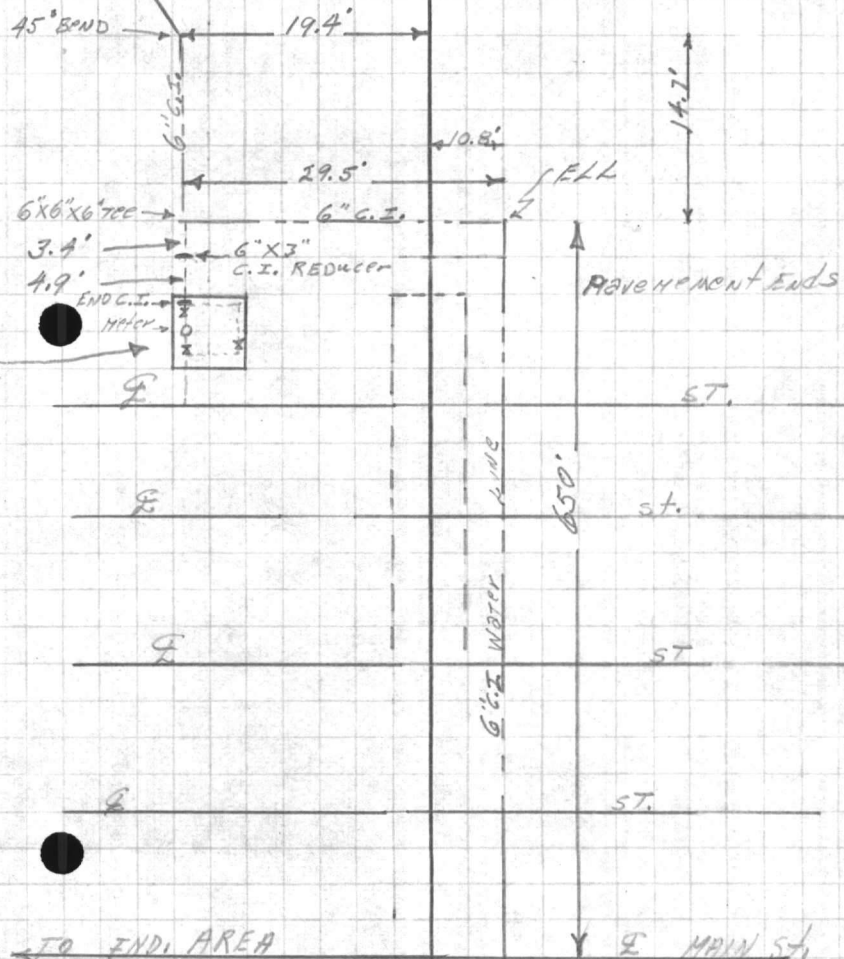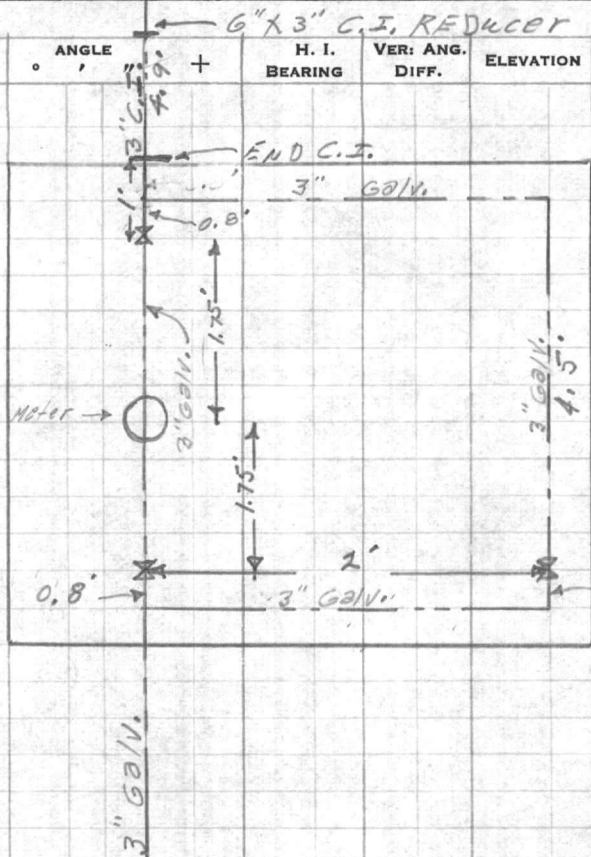

TO IND. AREA

MAIN ST.










VALUABLE

SUBJECT Water Line Loc.
CONTD.

RETURN TO
PUBLIC WORKS
OFFICE
CAMP LEJEUNE
NORTH CAROLINA

FIELD PARTY

IN CHARGE

INSTRUMENT

NOTES

TAPE READ

TAPE OR ROD

TAPE OR ROD

INSTRUMENT NO.

TAPE NO.

WEATHER


CLEAR
CLOUDY
WINDY
RAIN
FAIR

SNOW
HOT
MODERATE
COLD
FOG

FILE No. _____
FLDR. No. _____
SHEET 4 of _____
DATE 6-11 1957

Quad. No. _____

STATION	DIST.	ANGLE		+	H. I. BEARING	VER: ANG. DIFF.	ELEVATION
		°	"				

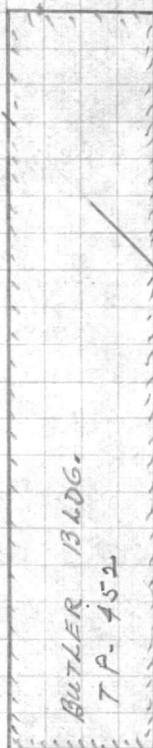

Measured and
Checked as being
6" G.I.
(0.55" outside dimen.)

45° BOND






VALUABLE

SUBJECT Water Line Loc.
contd.

RETURN TO
PUBLIC WORKS
OFFICE
CAMP LEJEUNE
NORTH CAROLINA

FIELD PARTY

____ IN CHARGE
____ INSTRUMENT
____ NOTES
____ TAPE READ
____ TAPE OR ROD
____ TAPE OR ROD
____ INSTRUMENT NO.
____ TAPE NO.

WEATHER

CLEAR
CLOUDY
WINDY
RAIN
FAIR
SNOW
HOT
MODERATE
COLD
FOG

FILE No. _____

FLDR. No. _____


SHEET 5 of

NOTES CHECKED BY _____

FIGURED BY _____ DATE 6-11 1927

Plotted By _____ Quad. No. _____

STATION	DIST.	ANGLE			+	H. I. BEARING	VER: ANG. DIFF.	ELEVATION
		°	'	"				

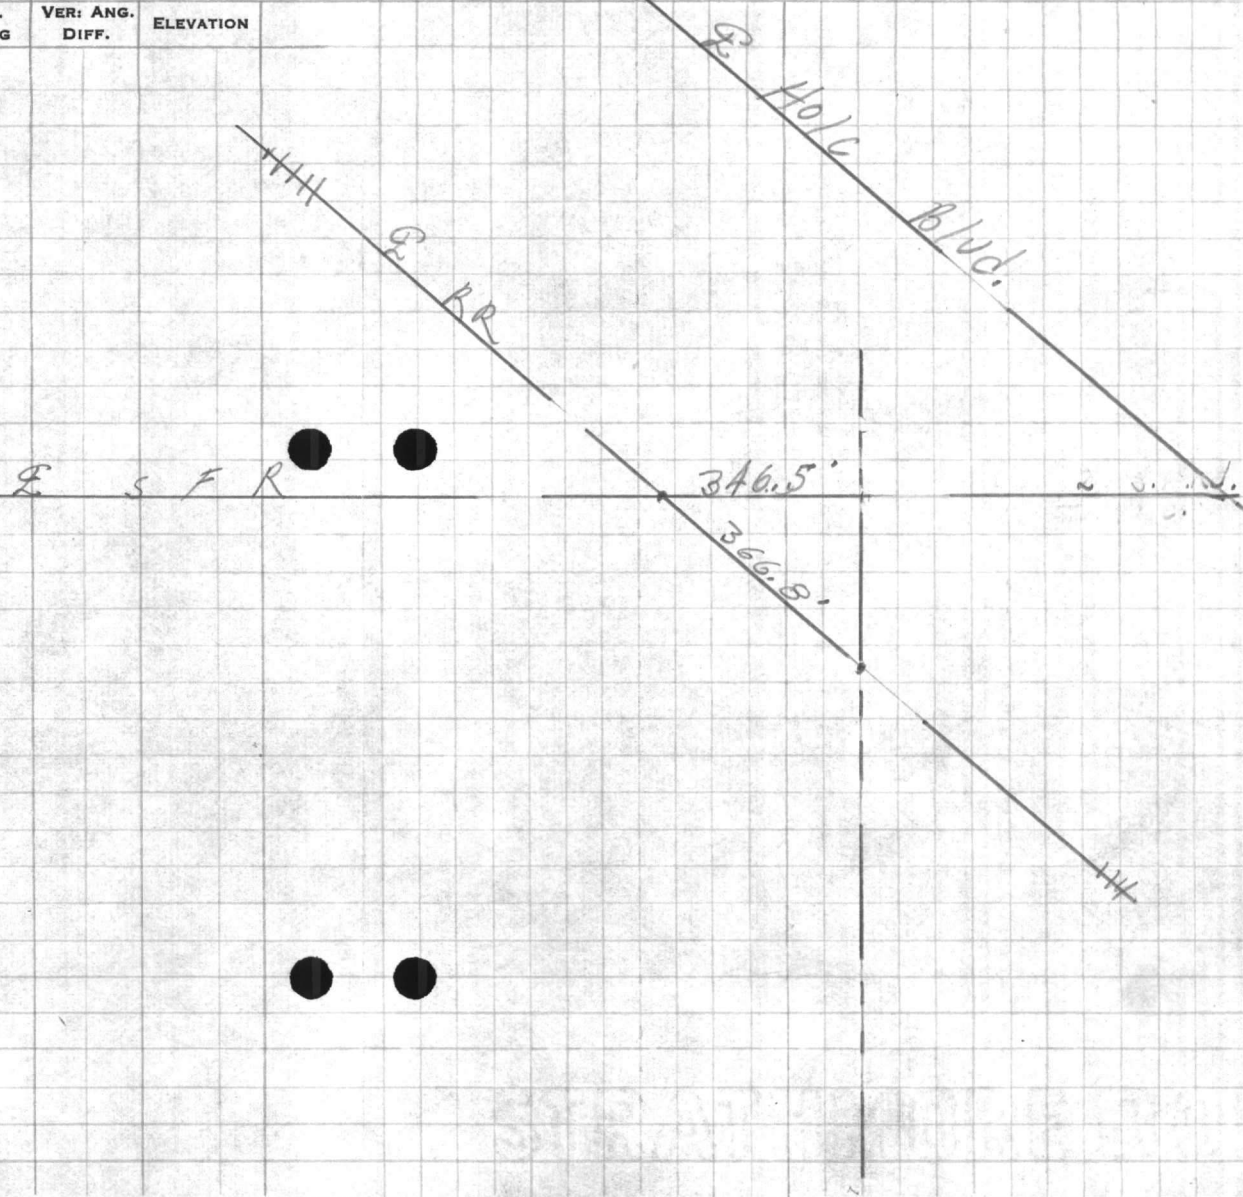










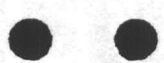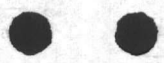


VALUABLE

SUBJECT Water AND sewer services
AT PINE GROVE TRAILER PARK

RETURN TO
 PUBLIC WORKS
 OFFICE
 CAMP LEJEUNE
 NORTH CAROLINA


FIELD PARTY
Kellum IN CHARGE
 _____ INSTRUMENT
 _____ NOTES
 _____ TAPE READ
 _____ TAPE OR ROD
 _____ TAPE OR ROD
 _____ INSTRUMENT NO.
 _____ TAPE NO.

WEATHER
 CLEAR _____ SNOW _____
 CLOUDY _____ HOT _____
 WINDY _____ MODERATE _____
 RAIN _____ COLD _____
 FAIR _____ FOG _____
 FIGURED BY _____
 NOTES CHECKED BY _____
 PLOTTED BY _____

FILE No. 140-5
 FLD. No. _____
 SHEET #1 of
 DATE 6-12 1957
 Quad. No. _____

STATION	DIST.	ANGLE ° ' " +	H. I. BEARING	VER: ANG. DIFF.	ELEVATION
B.M.					33.06
		4.60	37.66		
TOP of C.I. SEWER AT Bldg.				4.94	
TOP of T.C. SEWER AT Edge of Pavement				5.39	

Water Line Approx.
 1' Below ground.

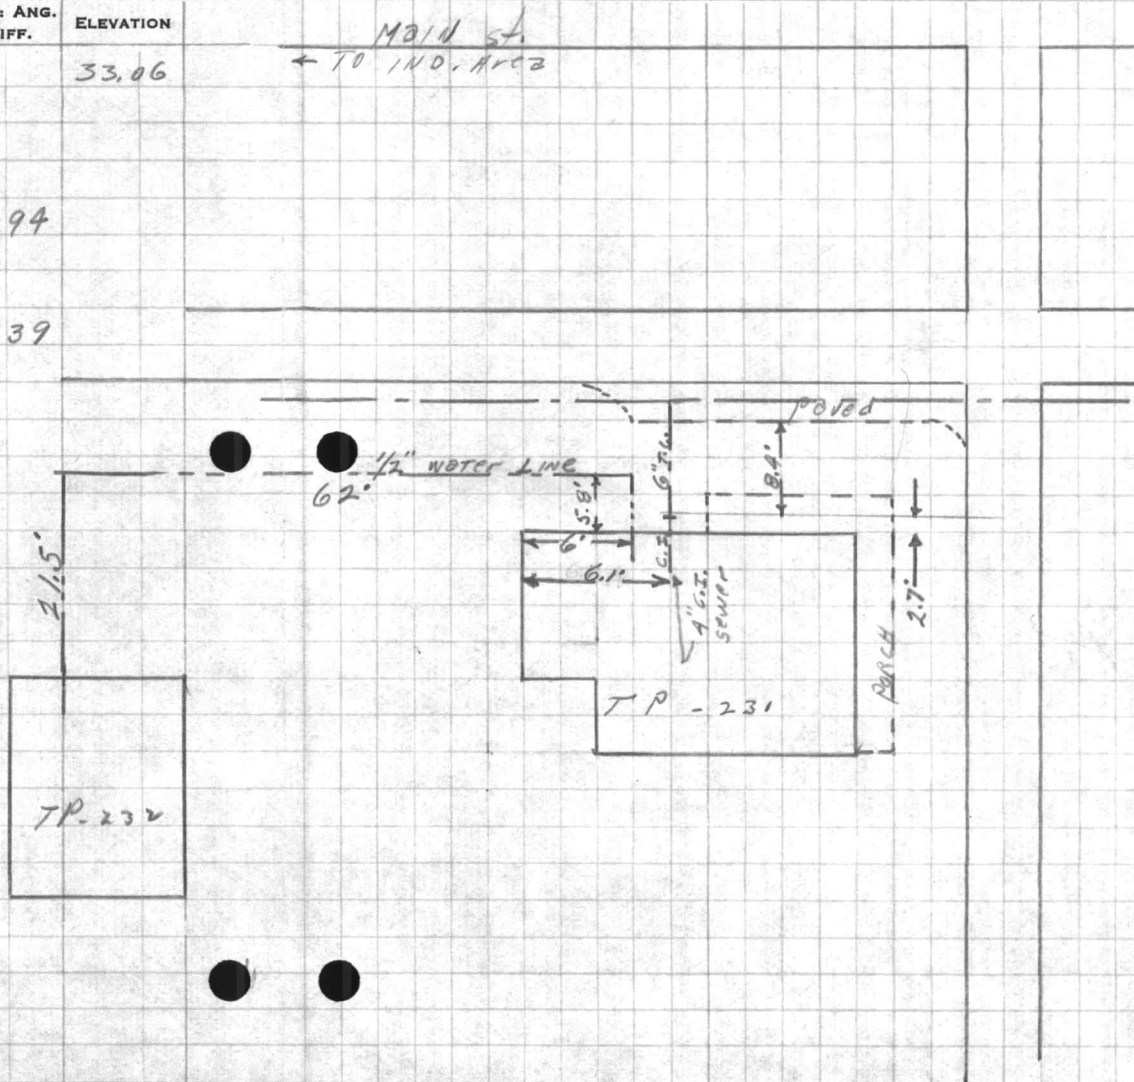




















































































































































VALUABLE

SUBJECT Water & Sewer services
to Bldg. Pine Grove trailer
park

RETURN TO
PUBLIC WORKS
OFFICE
CAMP LEJEUNE
NORTH CAROLINA

Sewer


FIELD PARTY
Kellum IN CHARGE
INSTRUMENT
NOTES
TAPE READ
TAPE OR ROD
TAPE OR ROD
INSTRUMENT NO.
TAPE NO.

WEATHER
CLEAR
CLOUDY
WINDY
RAIN
FAIR
SNOW
HOT
MODERATE
COLD
FOG
FIGURED BY
NOTES CHECKED BY
PLOTTED BY

FILE No. _____
FLDR. No. _____
SHEET 2 of
DATE 6-12-57
19

Quad. No. _____

STATION	DIST.	ANGLE ° ' "	+	H. I. BEARING	VER. ANG. DIFF.	ELEVATION
B.M.						33.00
		3.67		36.67	✓	
"A"		TOP of 4" C.I. sewer AT intersection with 3" C.I.		6.34		30.33
"B"		TOP of 4" C.I. AT intersection with 6" T.C.		6.54		30.13
T.P.		5.20		37.30	✓	1.57 31.10
"C"		TOP of 3" C.I. sewer		6.29		31.01
B.M.				4.29		33.01

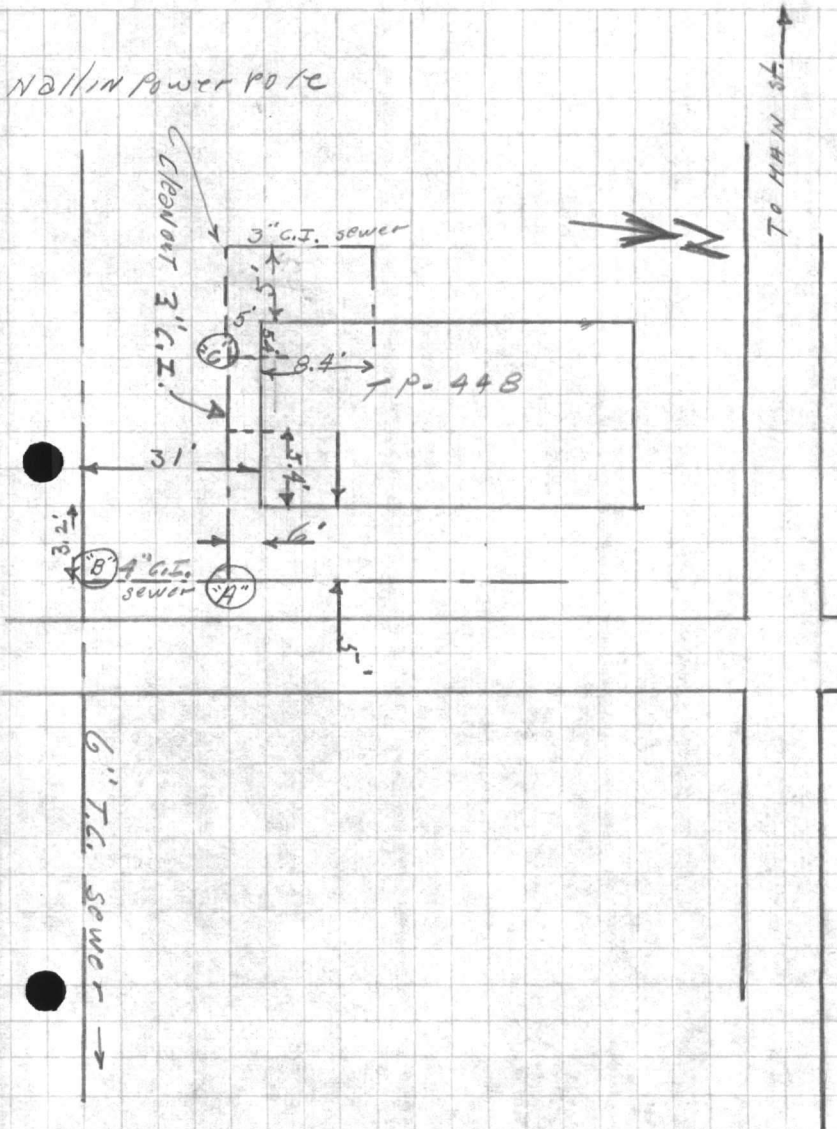

411
30.66

18.10
157.75

33.85



VALUABLE

SUBJECT Water & sewer loc.
Pine Grove Trailer Park

RETURN TO
PUBLIC WORKS
OFFICE
CAMP LEJEUNE
NORTH CAROLINA

Water

FIELD PARTY

____ IN CHARGE
____ INSTRUMENT
____ NOTES
____ TAPE READ
____ TAPE OR ROD
____ TAPE OR ROD
____ INSTRUMENT NO.
____ TAPE NO.

WEATHER


CLEAR
CLOUDY
WINDY
RAIN
FAIR
SNOW
HOT
MODERATE
COLD
FOG

FILE No. _____
FLDR. No. _____
SHEET 3-04
DATE 6-13 1957
FIGURED BY _____
NOTES CHECKED BY _____
PLOTTED BY _____

Quad. No. _____

STATION	DIST.	ANGLE ° ' "	+	H. I. BEARING	VER: ANG. DIFF.	ELEVATION
---------	-------	----------------	---	------------------	--------------------	-----------

water line
Approx. 1' under
ground

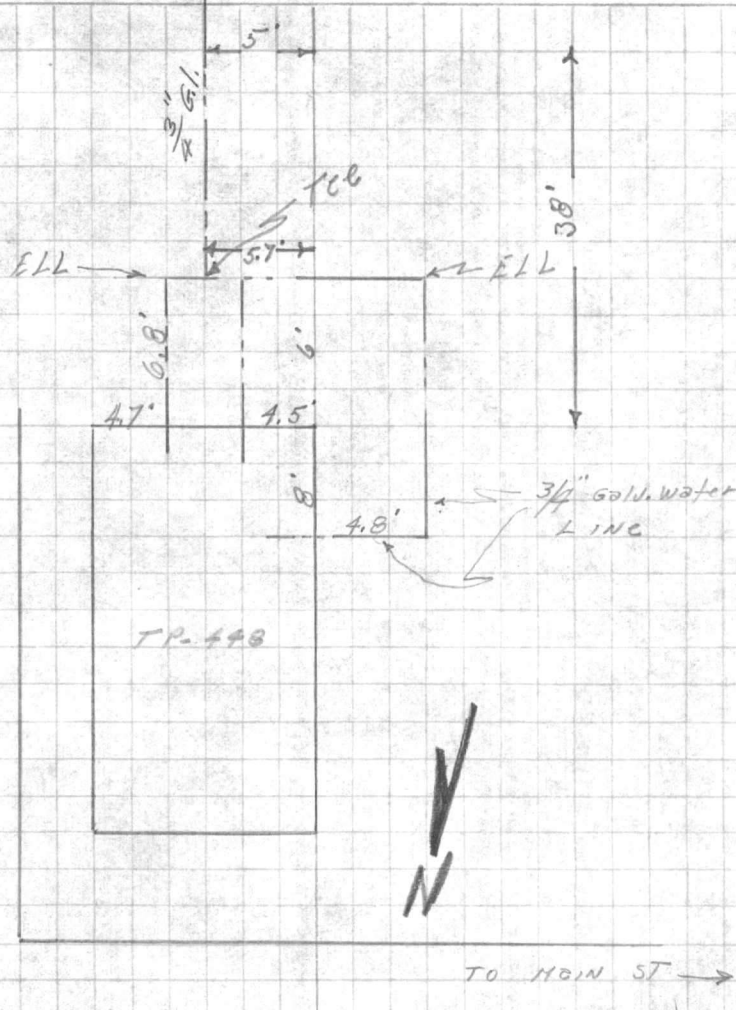

TO MAIN ST →

VALUABLE

RETURN TO
PUBLIC WORKS
OFFICE



VALUABLE

SUBJECT

Loc. Sewer and Water to
Bldg. #418
Pine Grove Trailer Park

RETURN TO
PUBLIC WORKS
OFFICE
CAMP LEJEUNE
NORTH CAROLINA

FIELD PARTY

Horton IN CHARGE
INSTRUMENT
NOTES
TAPE READ
TAPE OR ROD
TAPE OR ROD
TRUMENT No.
TAPE No.

WEATHER

CLEAR
CLOUDY
WINDY
RAIN
FAIR
SNOW
HOT
MODERATE
COLD
FOG

FILE No. 140-5

FLDR. No.

SHEET


FIGURED BY
NOTES CHECKED BY
PLOTTED BY

DATE 6/14/1957

Quad. No.

STATION	DIST.	ANGLE		+	H. I. BEARING	VER. ANG. DIFF.	ELEVATION
		°	"				
B.M.							
①				2.37	32.69		30.32
②						4.73	27.96
③						5.47	27.22
④						6.69	26.00
B.M.						2.37	30.32

POLE No A.T. 23
TOP 4" Sewer
" " "
" " "

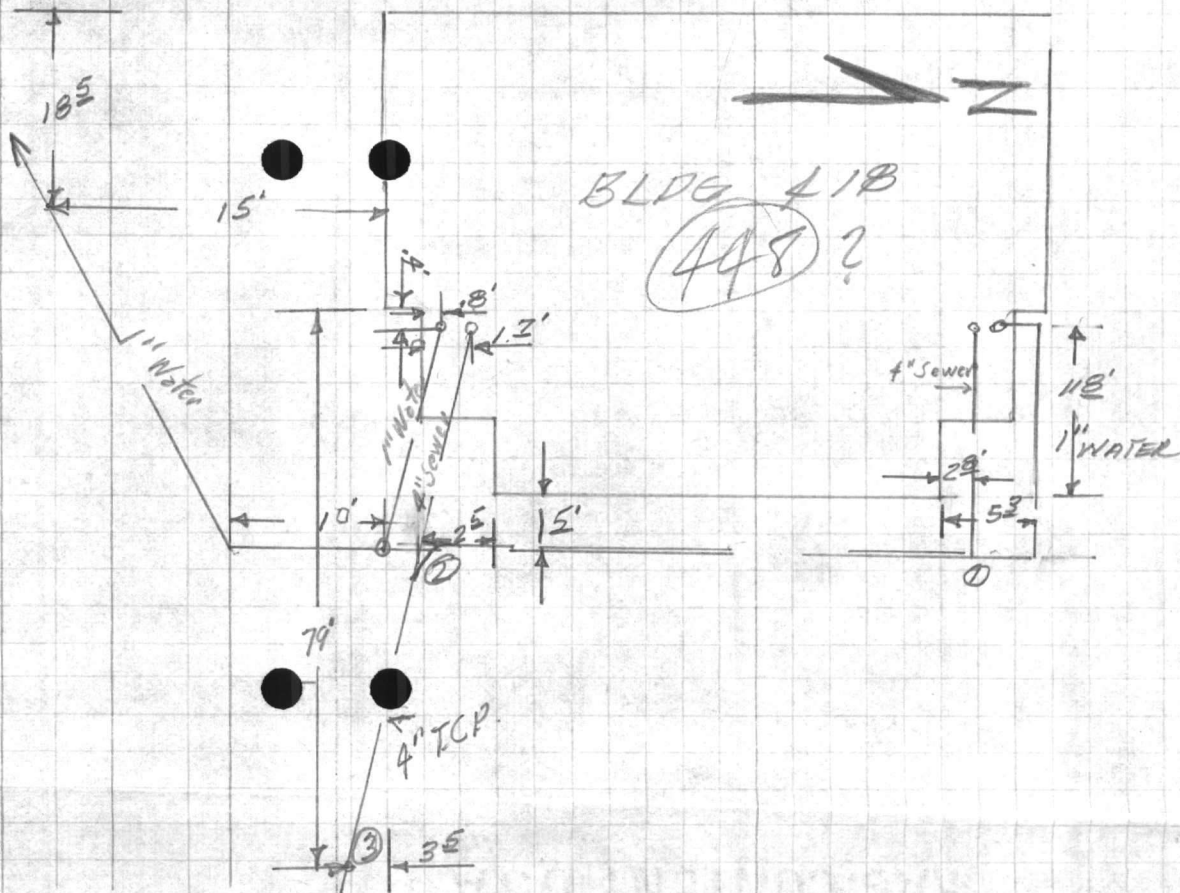





VALUABLE

SUBJECT Elevations on R.R.
AND HOIG. Blvd.
AT Bear Head Creek

RETURN TO
PUBLIC WORKS
OFFICE
CAMP LEJEUNE
NORTH CAROLINA

FIELD PARTY
Morton IN CHARGE
INSTRUMENT _____
NOTES _____
TAPE READ _____
TAPES OR ROD _____
TAPES OR ROD _____
INSTRUMENT NO. _____
TAPE NO. _____

WEATHER
CLEAR _____ SNOW _____
CLOUDY _____ HOT _____
WINDY _____ MODERATE _____
RAIN _____ COLD _____
FAIR _____ FOG _____

FILE No. 1405
FLDR. No. _____
FIGURED BY _____ SHEET 1 of
NOTES CHECKED BY _____ DATE 6-19-57
PLOTTED BY _____

Quad. No. _____

STATION	DIST.	ANGLE " "	+	H. I. BEARING	VER: ANG. DIFF.	ELEVATION	
B.M.						22.27	TACK
		198		29.25			
T.P.					8.75	15.50	
		2.36		17.76			
						12	Bridge
						4.93	10.83
						8.0	7.8
						12.70	5.06
TP						7.00	18.68
		3.81		14.49			
						5.6	8.9
						8.50	5.99
							9
TP					4.55	7.94	
						7.65	15.59
TP					1.58	16.01	
						8.45	2.46
B.M.						2.19	22.27

12.8
+ 3.0
+ 16.0
Elev. High Water
Hurricane 1955

Bear Head Creek Trailer Pk. Rd.
Creek bank at bridge Trailer Pk Rd.
TOP Water " " " " "
Opening under Bridge 16" wide
Creek Bank 500' East Trailer Pk Rd. Bridge.
TOP Water at Sta. Same as Above
CREEK 12" wide

NOTE: water 3' above deck
off bridge Trailer Pk
Rd. Bear Head C.R.
according to Mr. Crowson, Caretaker at Trailer Park
Not so - Dillon

VALUABLE
































11

VALUABLE

RETURN TO
PUBLIC WORKS
OFFICE
CAMP LEJEUNE
NORTH CAROLINA

SUBJECT LOC. of observation
Well OW-4

FIELD PARTY

____ IN CHARGE
____ INSTRUMENT
____ NOTES
____ TAPE READ
____ TAPE OR ROD
____ TAPE OR ROD
____ INSTRUMENT No.
____ TAPE No.


WEATHER

CLEAR
CLOUDY
WINDY
RAIN
FAIR

SNOW
HOT
MODERATE
COLD
FOG

FILE No. 1405
FLDR. No. _____
FIGURED BY _____ SHEET _____
NOTES CHECKED BY _____
PLOTTED BY _____ DATE 11-9-59

Quad. No. _____

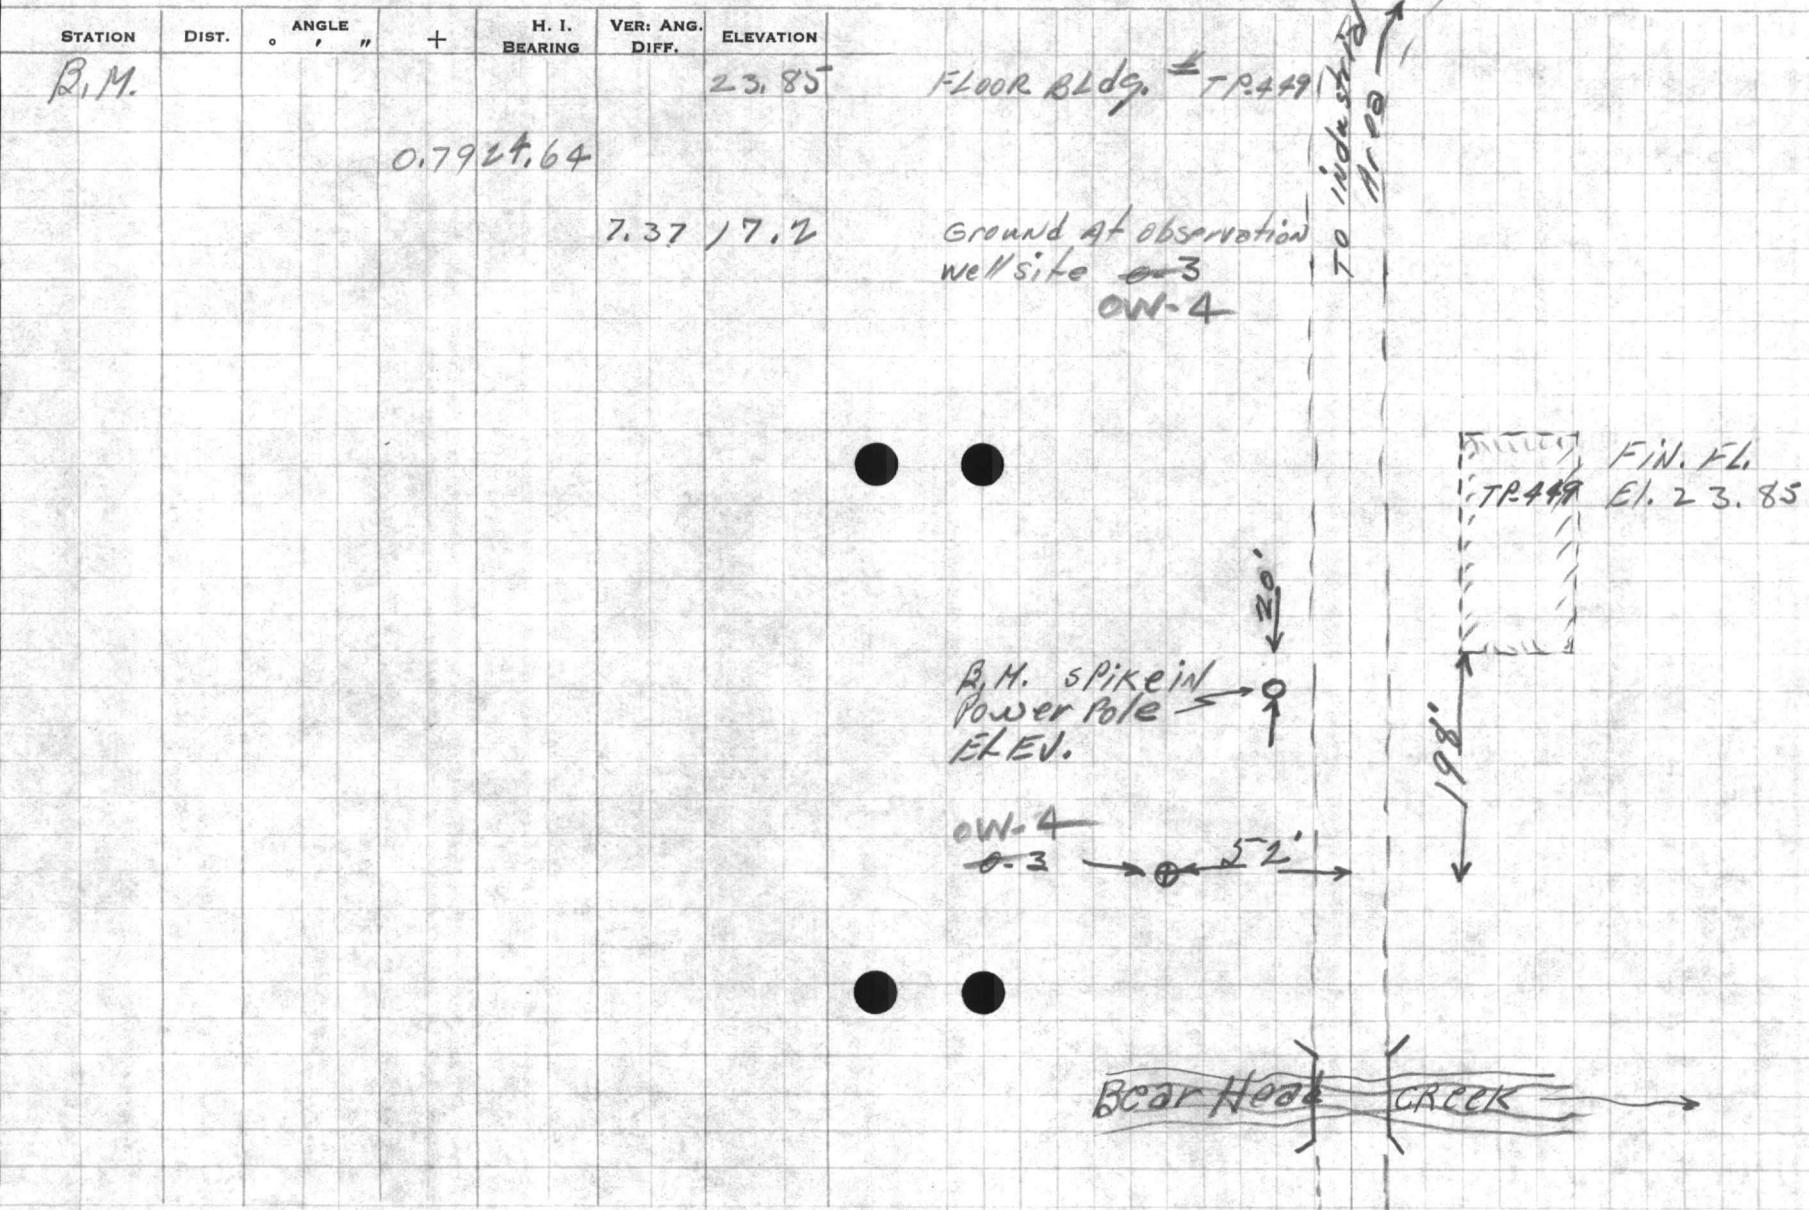












DESIGN DIVISION

PROJECT NO. A.O.P. SUBJECT Bldg # 448 - Old Trailer Camp Area

DESIGN BY _____ CHECK BY _____ DATE 12/3/59 SHEET 1 OF 5

Interior of Bldg

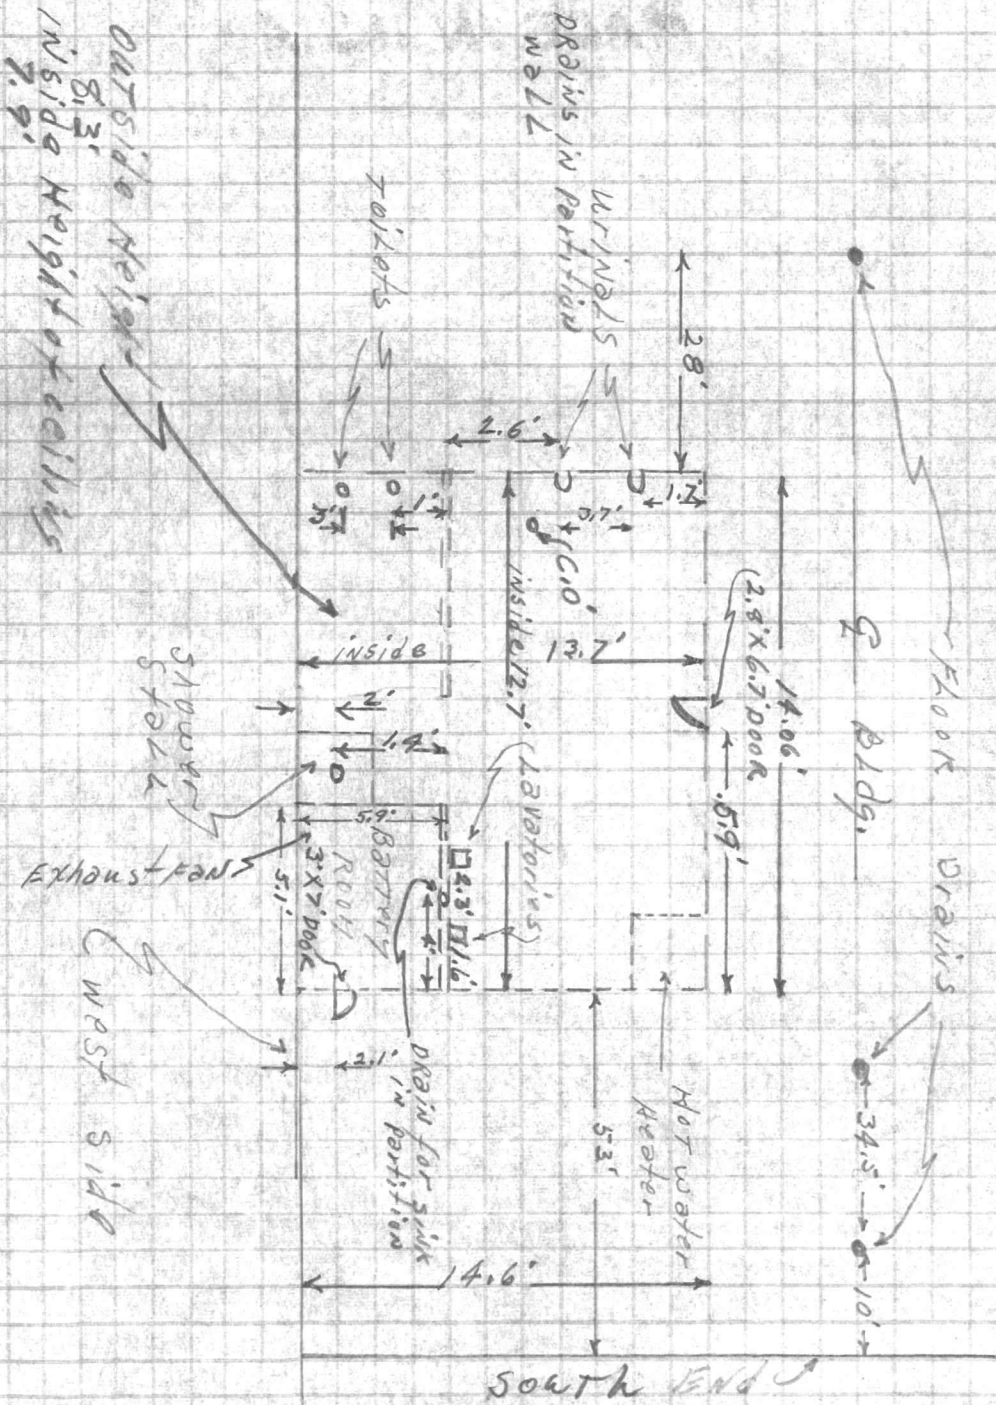

40.112.1

119

DESIGN DIVISION


PROJECT NO. _____ SUBJECT _____
 DESIGN BY _____ CHECK BY _____ DATE _____ SHEET _____ OF _____

Neerath Onionskin
1/20/21
1/20/21

DESIGN DIVISION

PROJECT NO. _____ SUBJECT _____

DESIGN BY _____ CHECK BY _____ DATE 12/3/59 SHEET #2 OF 5

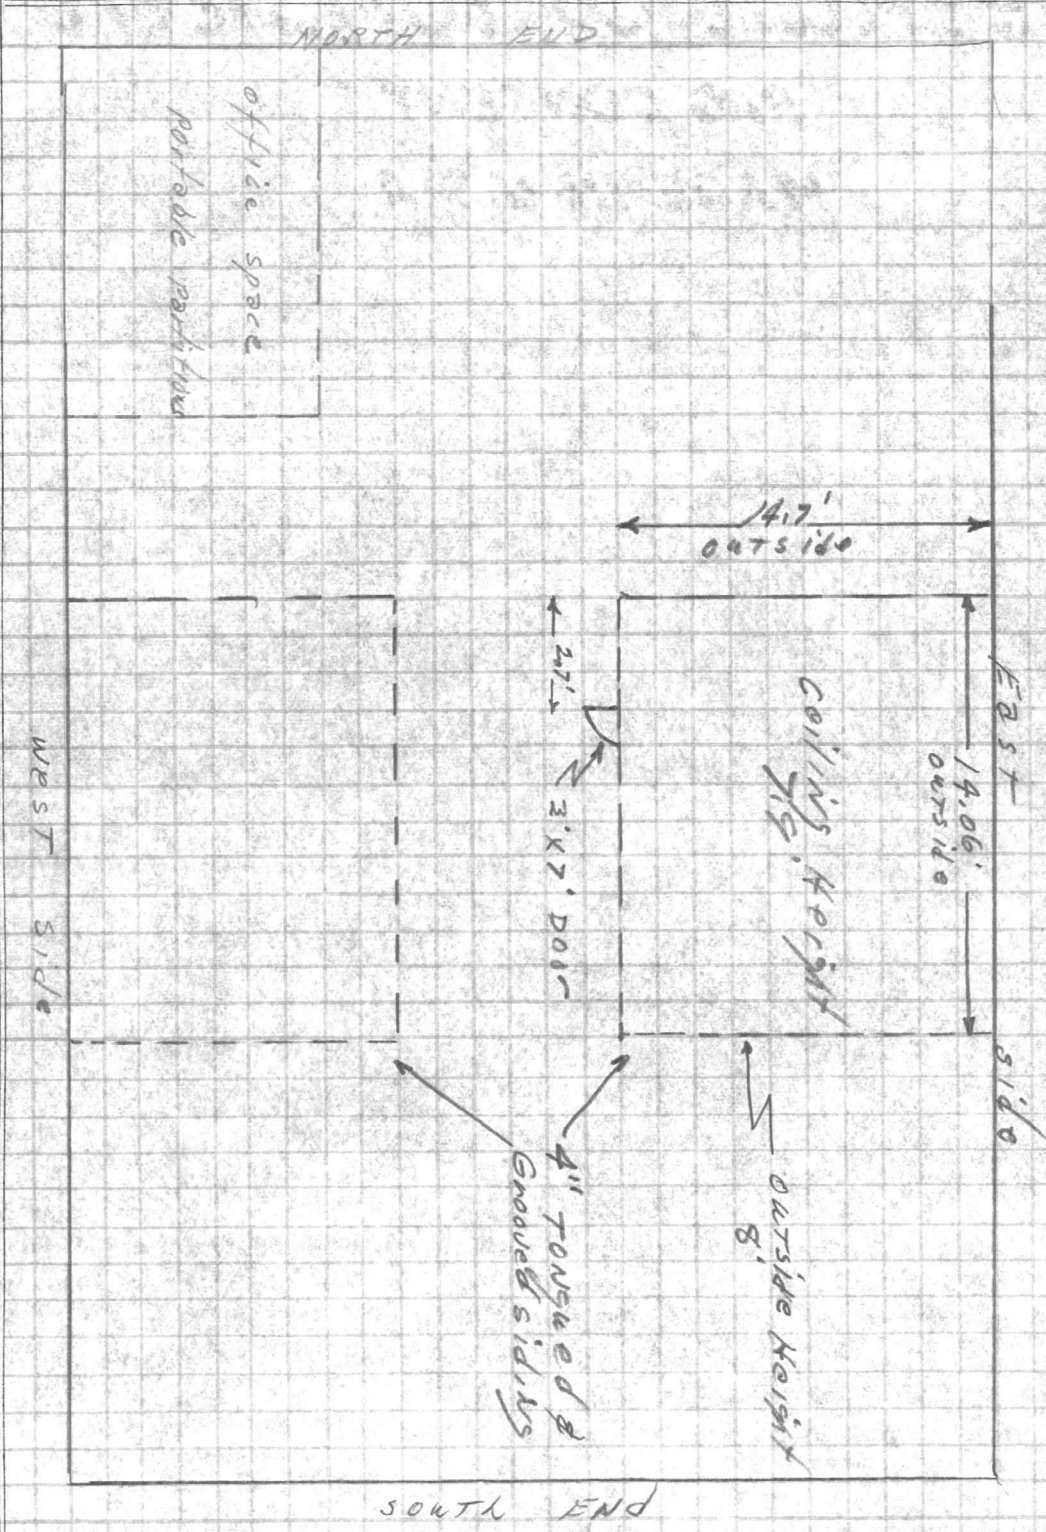

DESIGN DIVISION

PROJECT No. _____ SUBJECT _____

DESIGN BY _____ CHECK BY _____ DATE _____ SHEET _____ OF _____


DESIGN DIVISION

PROJECT NO. _____ SUBJECT _____

DESIGN BY _____ CHECK BY _____ DATE 12/3/59 SHEET #3 OF 5

Extension of Bldg.

SOME AS SOUTH END

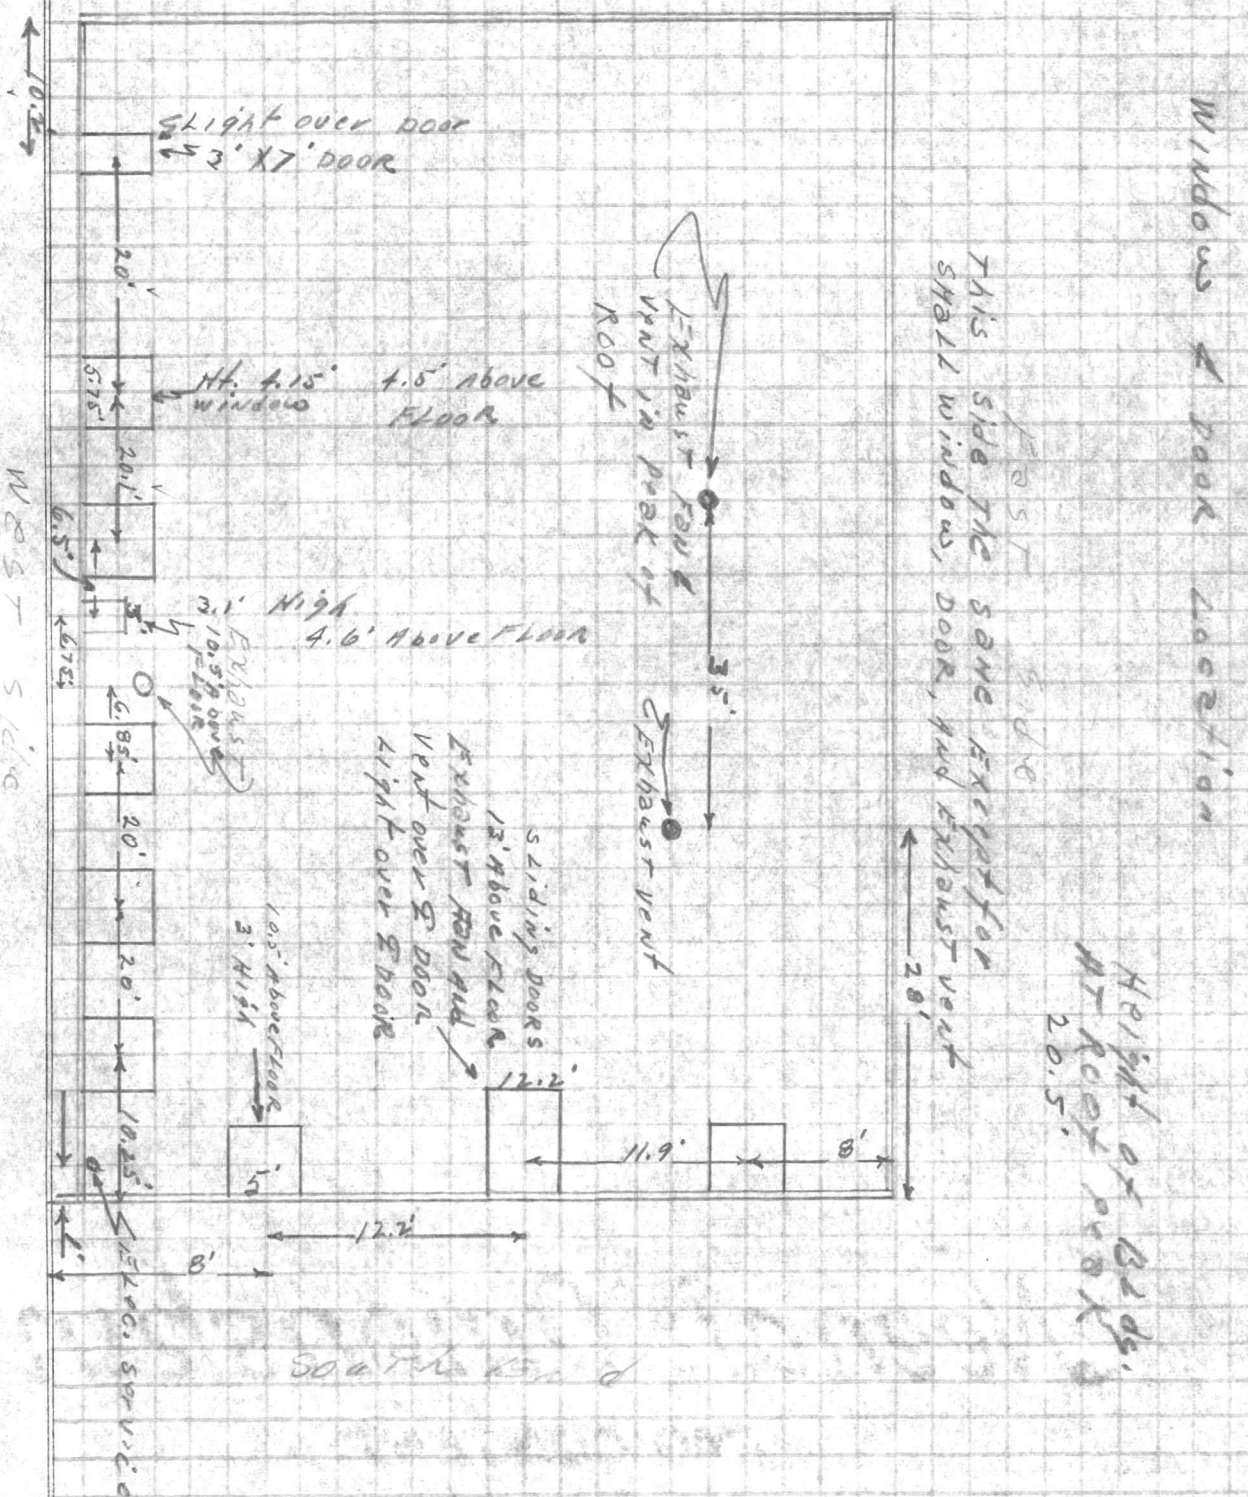

14' Height of Building AT 1st

HEIGHT OF BLDG. AT ROOF PEAK 20.5'

SOUTH END

DESIGN DIVISION


PROJECT NO. _____ SUBJECT _____
 DESIGN BY _____ CHECK BY _____ DATE _____ SHEET _____ OF _____

[The main body of the page contains faint, illegible text and markings, likely bleed-through from the reverse side of the sheet.]

DESIGN DIVISION

PROJECT No. _____ SUBJECT _____

DESIGN BY _____ CHECK BY _____ DATE 12/3/59 SHEET #4 OF 5

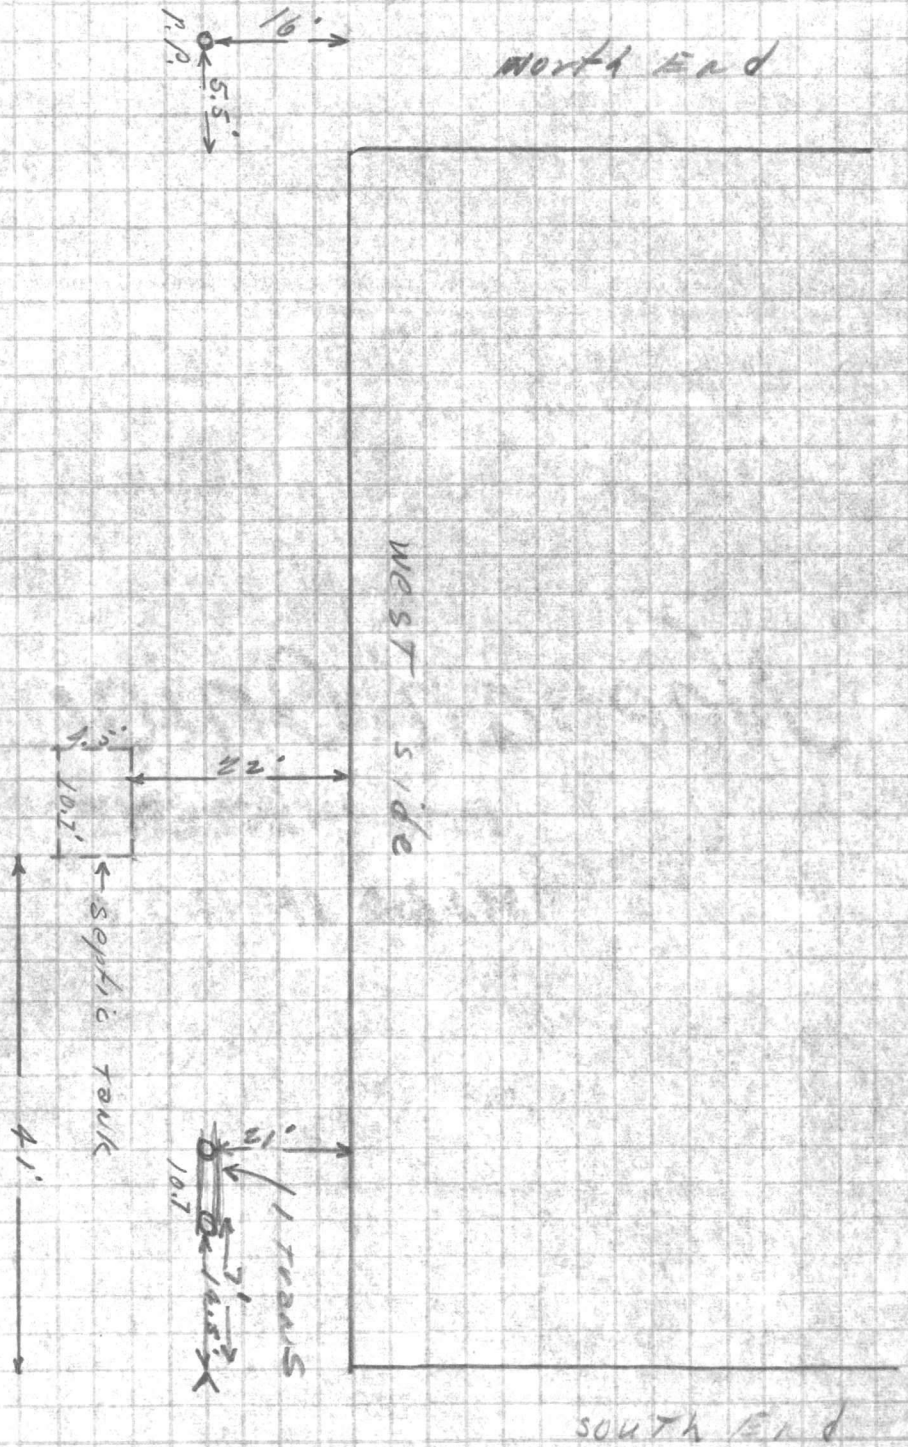

DESIGN DIVISION


PROJECT No. _____ SUBJECT _____
 DESIGN BY _____ CHECK BY _____ DATE _____ SHEET _____ OF _____

[Faint, illegible handwritten text, possibly a signature or project name]

DESIGN DIVISION

PROJECT No. _____ SUBJECT _____

DESIGN BY _____ CHECK BY _____ DATE 12/3/59 SHEET # 5 OF 5

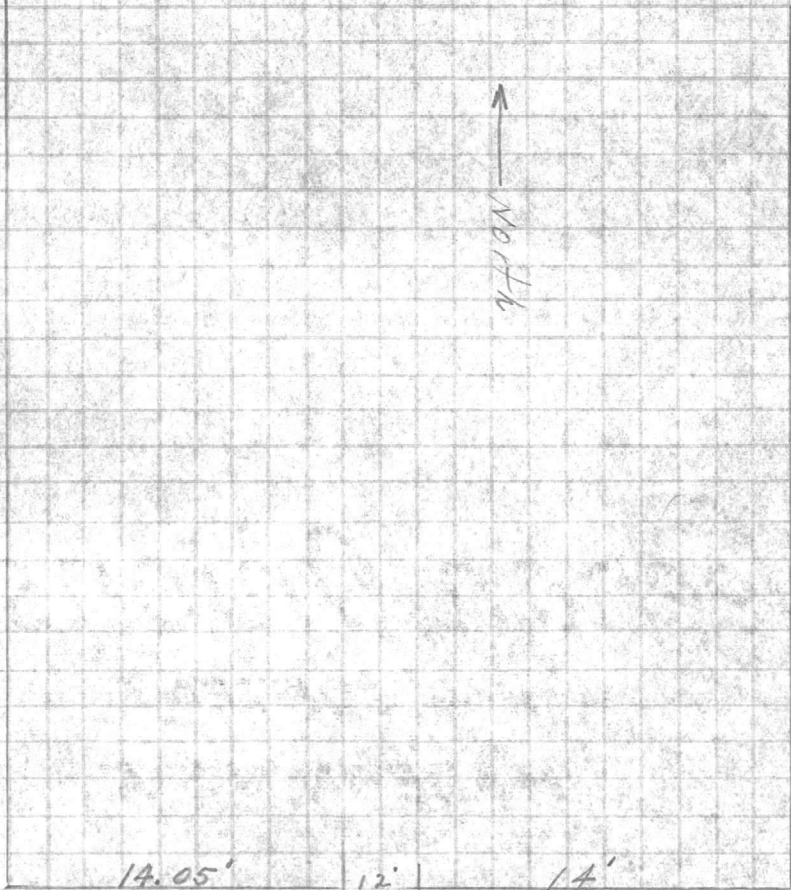

DESIGN DIVISION

PROJECT No. _____ SUBJECT _____
DESIGN BY _____ CHECK BY _____ DATE _____ OF _____ SHEET _____

[The main body of the page is a large, faint, and illegible watermark or bleed-through from the reverse side of the sheet. It appears to contain some text and possibly a diagram, but it is not readable.]