


# SPRAY WATER AND POLYMER FEED LINES e ROTARY DRUM THICKENERS

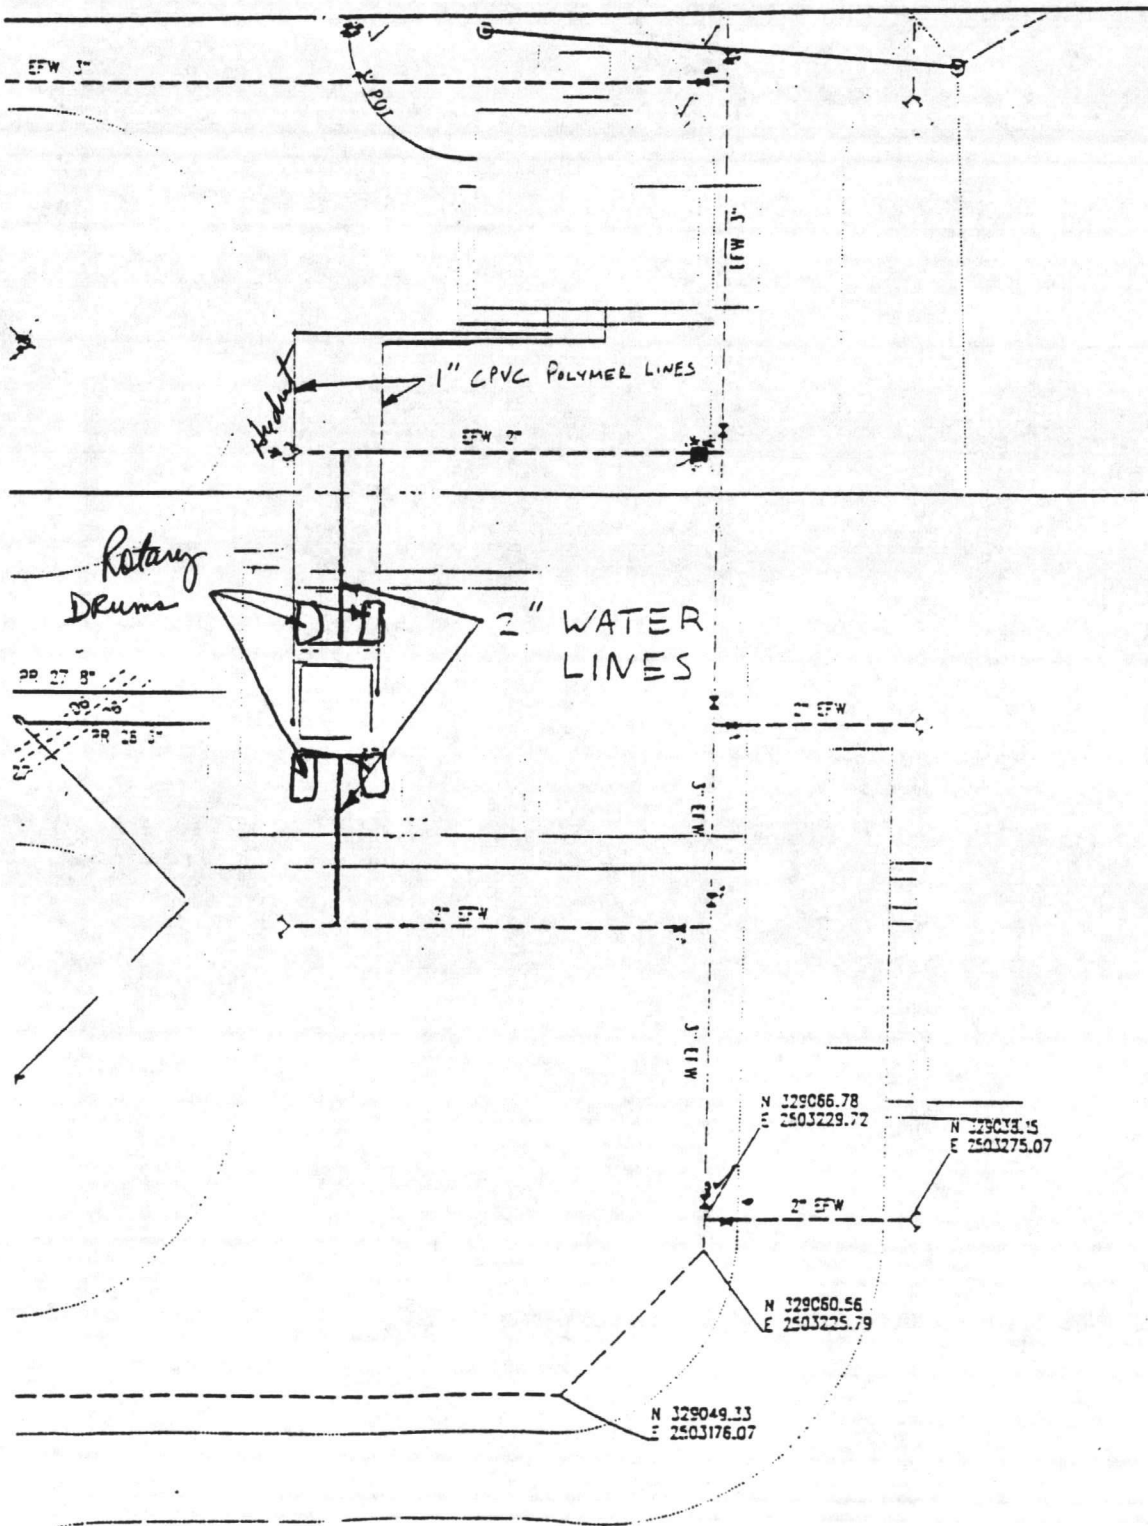

COPY