


OAK GROVE  
SHEET 24 OF 24

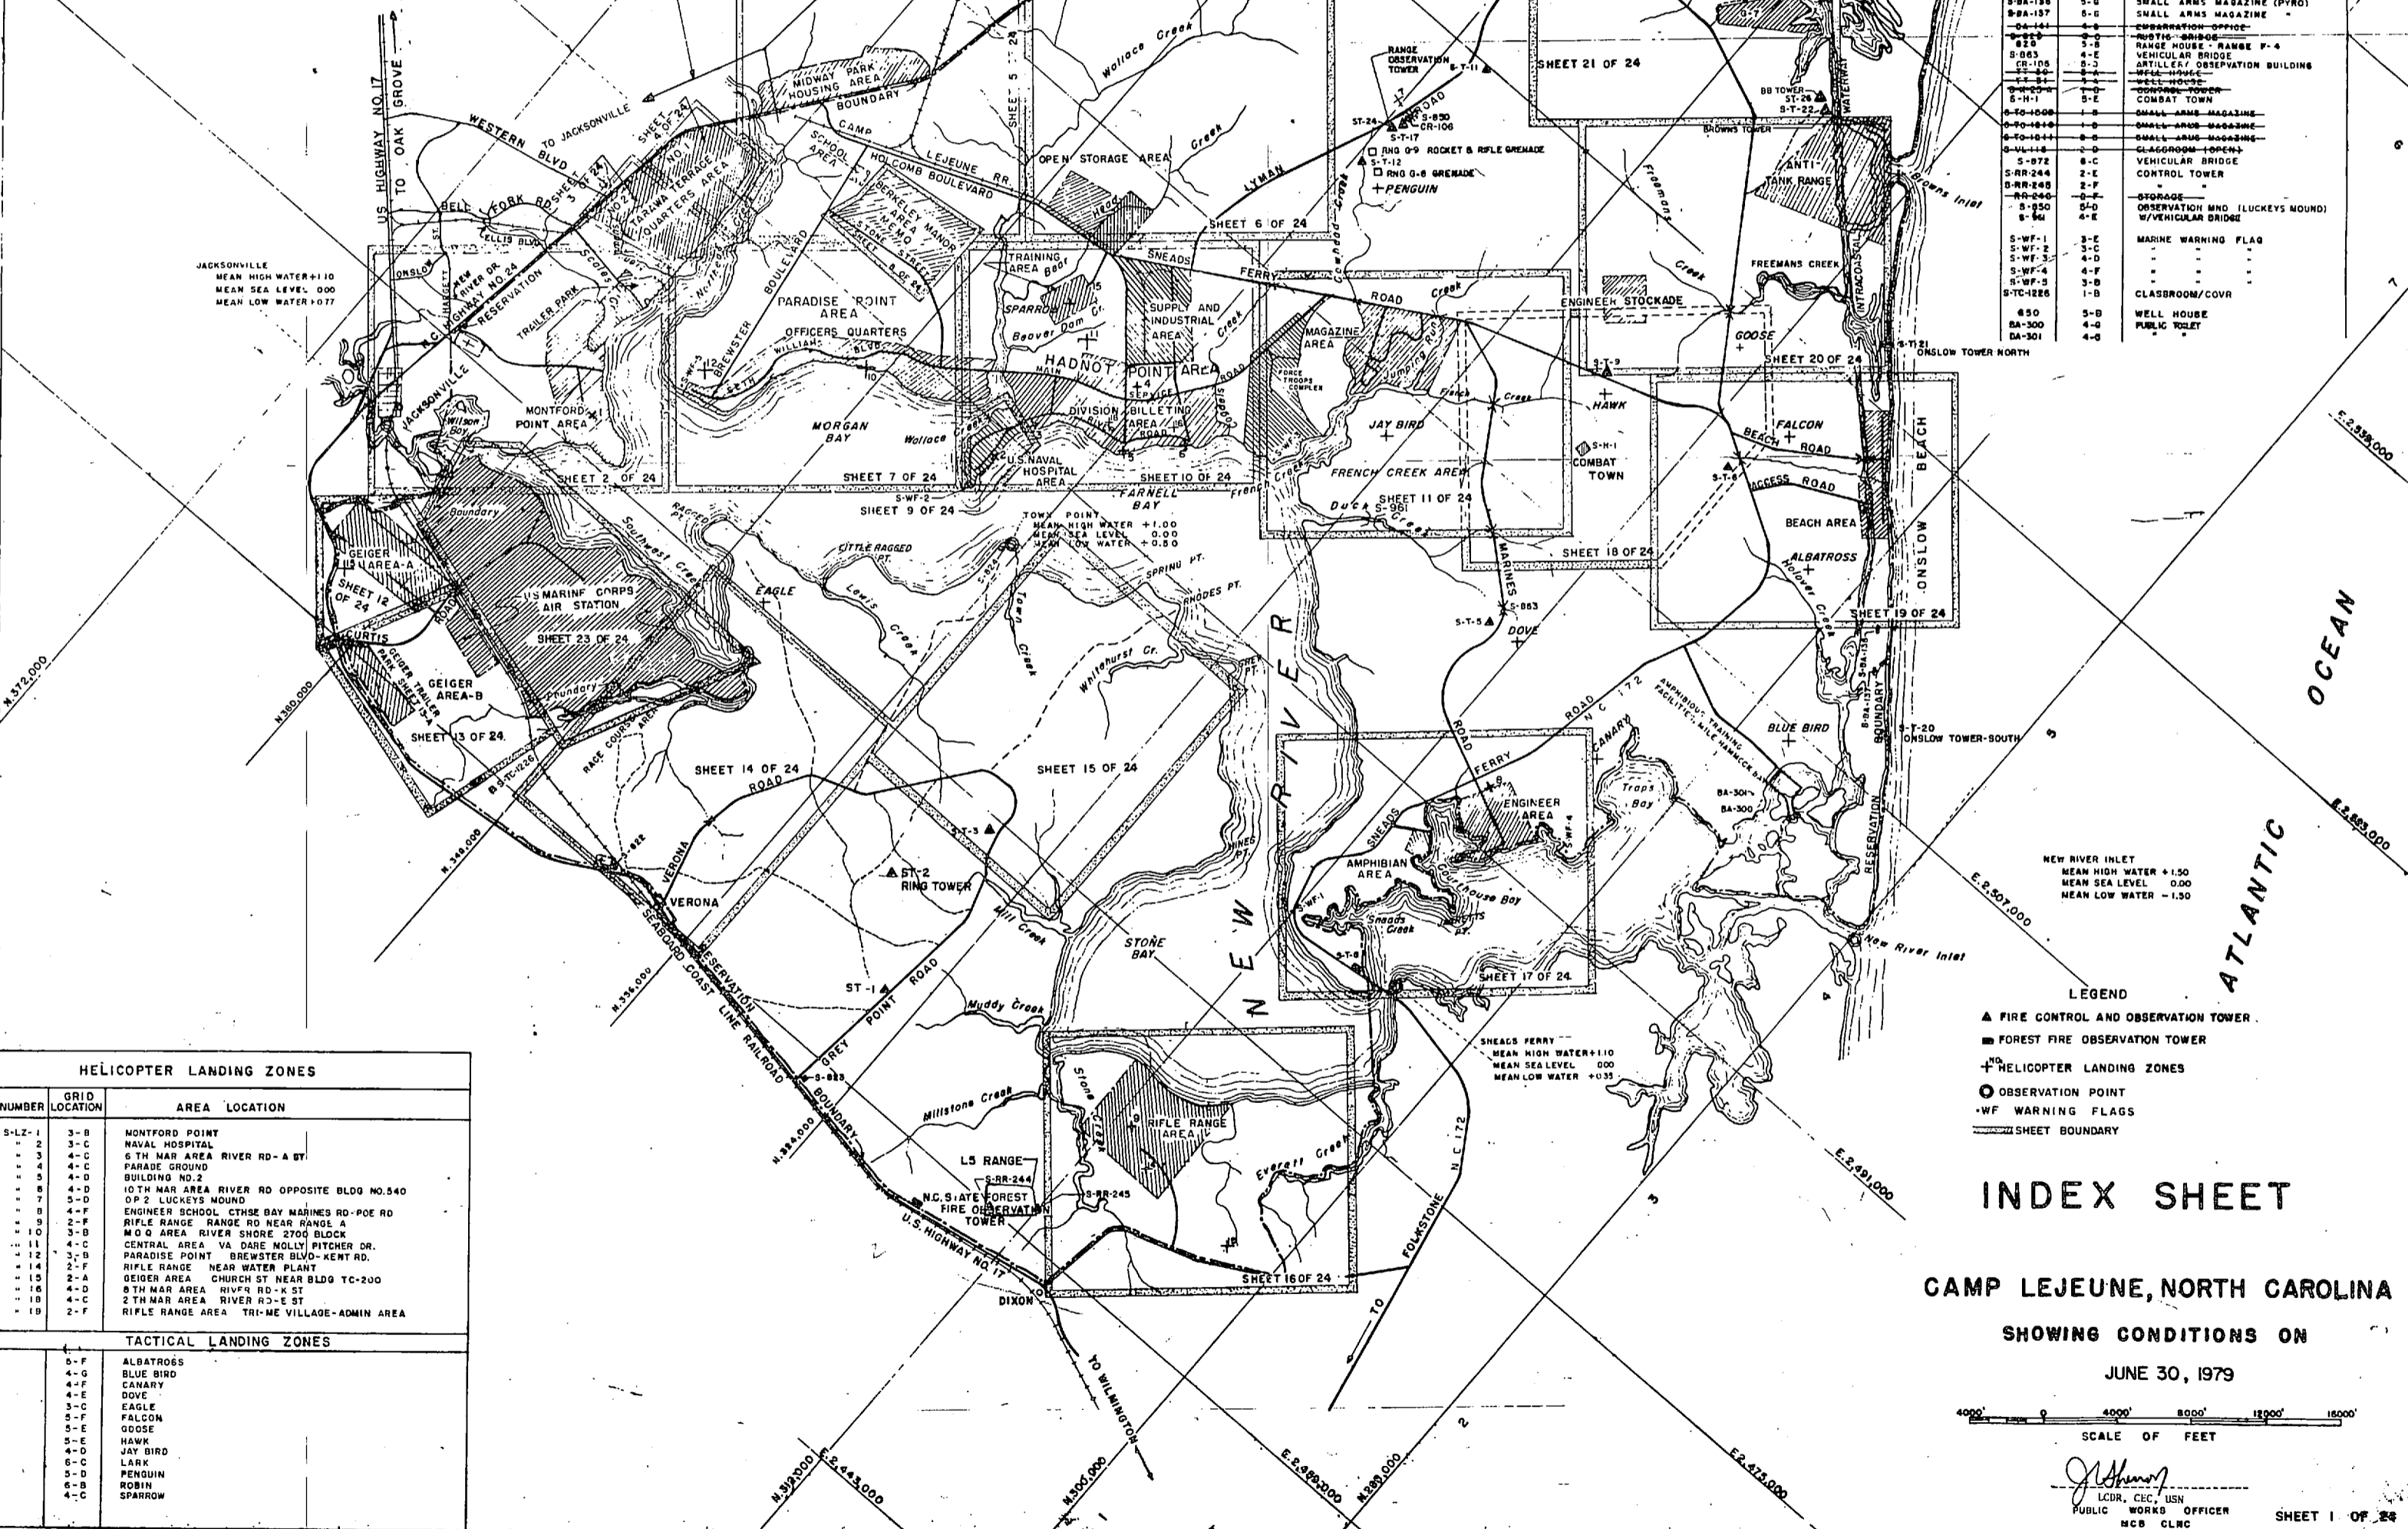

NUMBER	LOCATION	USE


HELICOPTER LANDING ZONES		
NUMBER	GRID LOCATION	AREA LOCATION
S-LZ-1	3-B	MONTFORD POINT
2	3-C	NAVAL HOSPITAL
3	4-C	6 TH MAR AREA RIVER RD - A ST
4	4-C	PARADE GROUND
5	4-D	BUILDING NO. 2
6	4-D	10 TH MAR AREA RIVER RD OPPOSITE BLDG NO. 240
7	3-D	OP 2 LUCKEYS MOUND
8	4-F	ENGINEER SCHOOL CHASE BAY MARINES RD - POC RD
9	2-F	RIFLE RANGE RANGE RD NEAR RANG. A
10	3-D	M/O AREA RIVER SHORE 2ND BLDG
11	4-C	CENTRAL AREA VA DARE MOLLY PITCHER DR.
12	3-B	PARADISE POINT BREWSTER BLVD - KENT RD.
13	2-F	RIFLE RANGE NEAR WATER PLANT
14	2-A	GEIGER AREA CHURCH ST NEAR BLDG TC-200
15	4-D	8 TH MAR AREA RIVER RD - C ST
16	4-C	2 TH MAR AREA RIVER RD - E ST
17	2-F	RIFLE RANGE AREA TRI-ME VILLAGE - ADMIN AREA

TACTICAL LANDING ZONES		
NUMBER	GRID LOCATION	AREA LOCATION


LEGEND  
 ▲ FIRE CONTROL AND OBSERVATION TOWER  
 ■ FOREST FIRE OBSERVATION TOWER  
 + HELICOPTER LANDING ZONES  
 ○ OBSERVATION POINT  
 -WF- WARNING FLAGS  
 --- SHEET BOUNDARY

**INDEX SHEET**  
**CAMP LEJEUNE, NORTH CAROLINA**  
 SHOWING CONDITIONS ON  
 JUNE 30, 1979

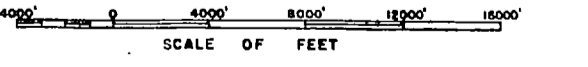


LCDR, USN  
 PUBLIC WORKS OFFICER  
 MCB CLMC



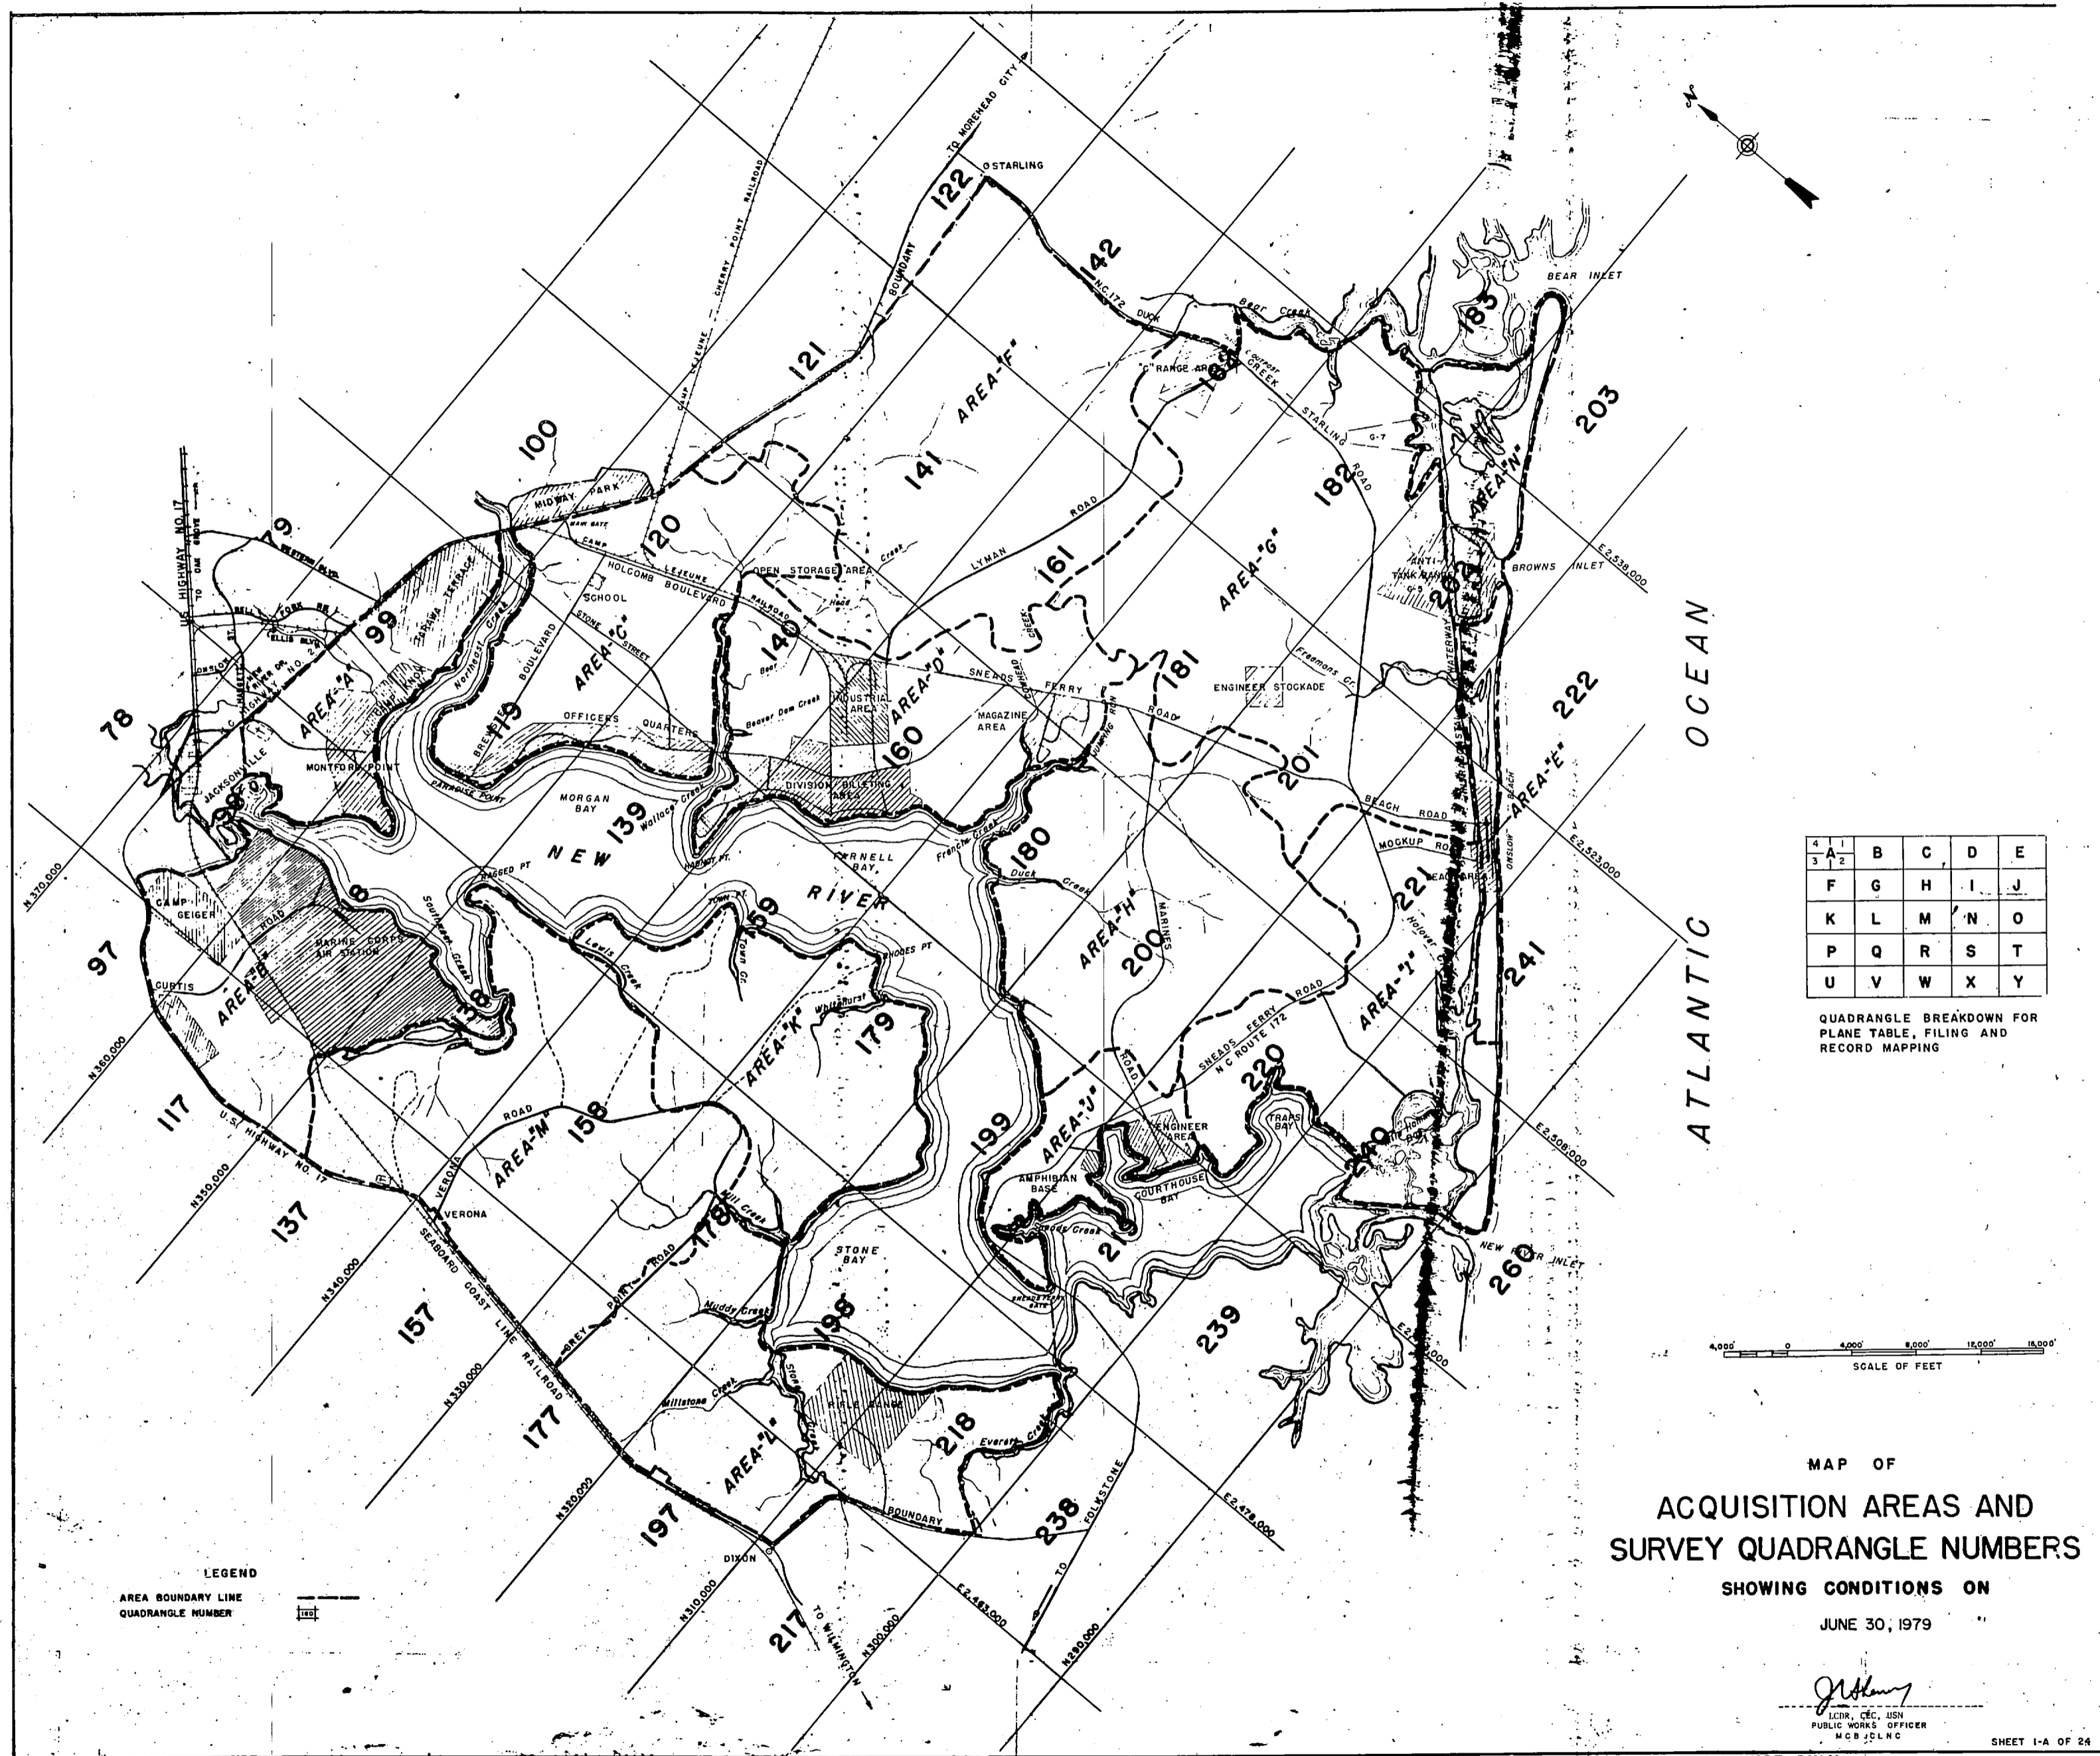



QUADRANGLE BREAKDOWN FOR PLANE TABLE, FILING AND RECORD MAPPING

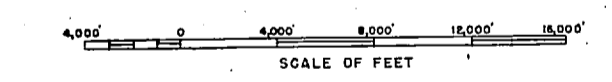

MAP OF  
**ACQUISITION AREAS AND  
 SURVEY QUADRANGLE NUMBERS**  
 SHOWING CONDITIONS ON  
 JUNE 30, 1979

*J. H. ...*  
 PUBLIC WORKS OFFICER  
 MCB JELNC



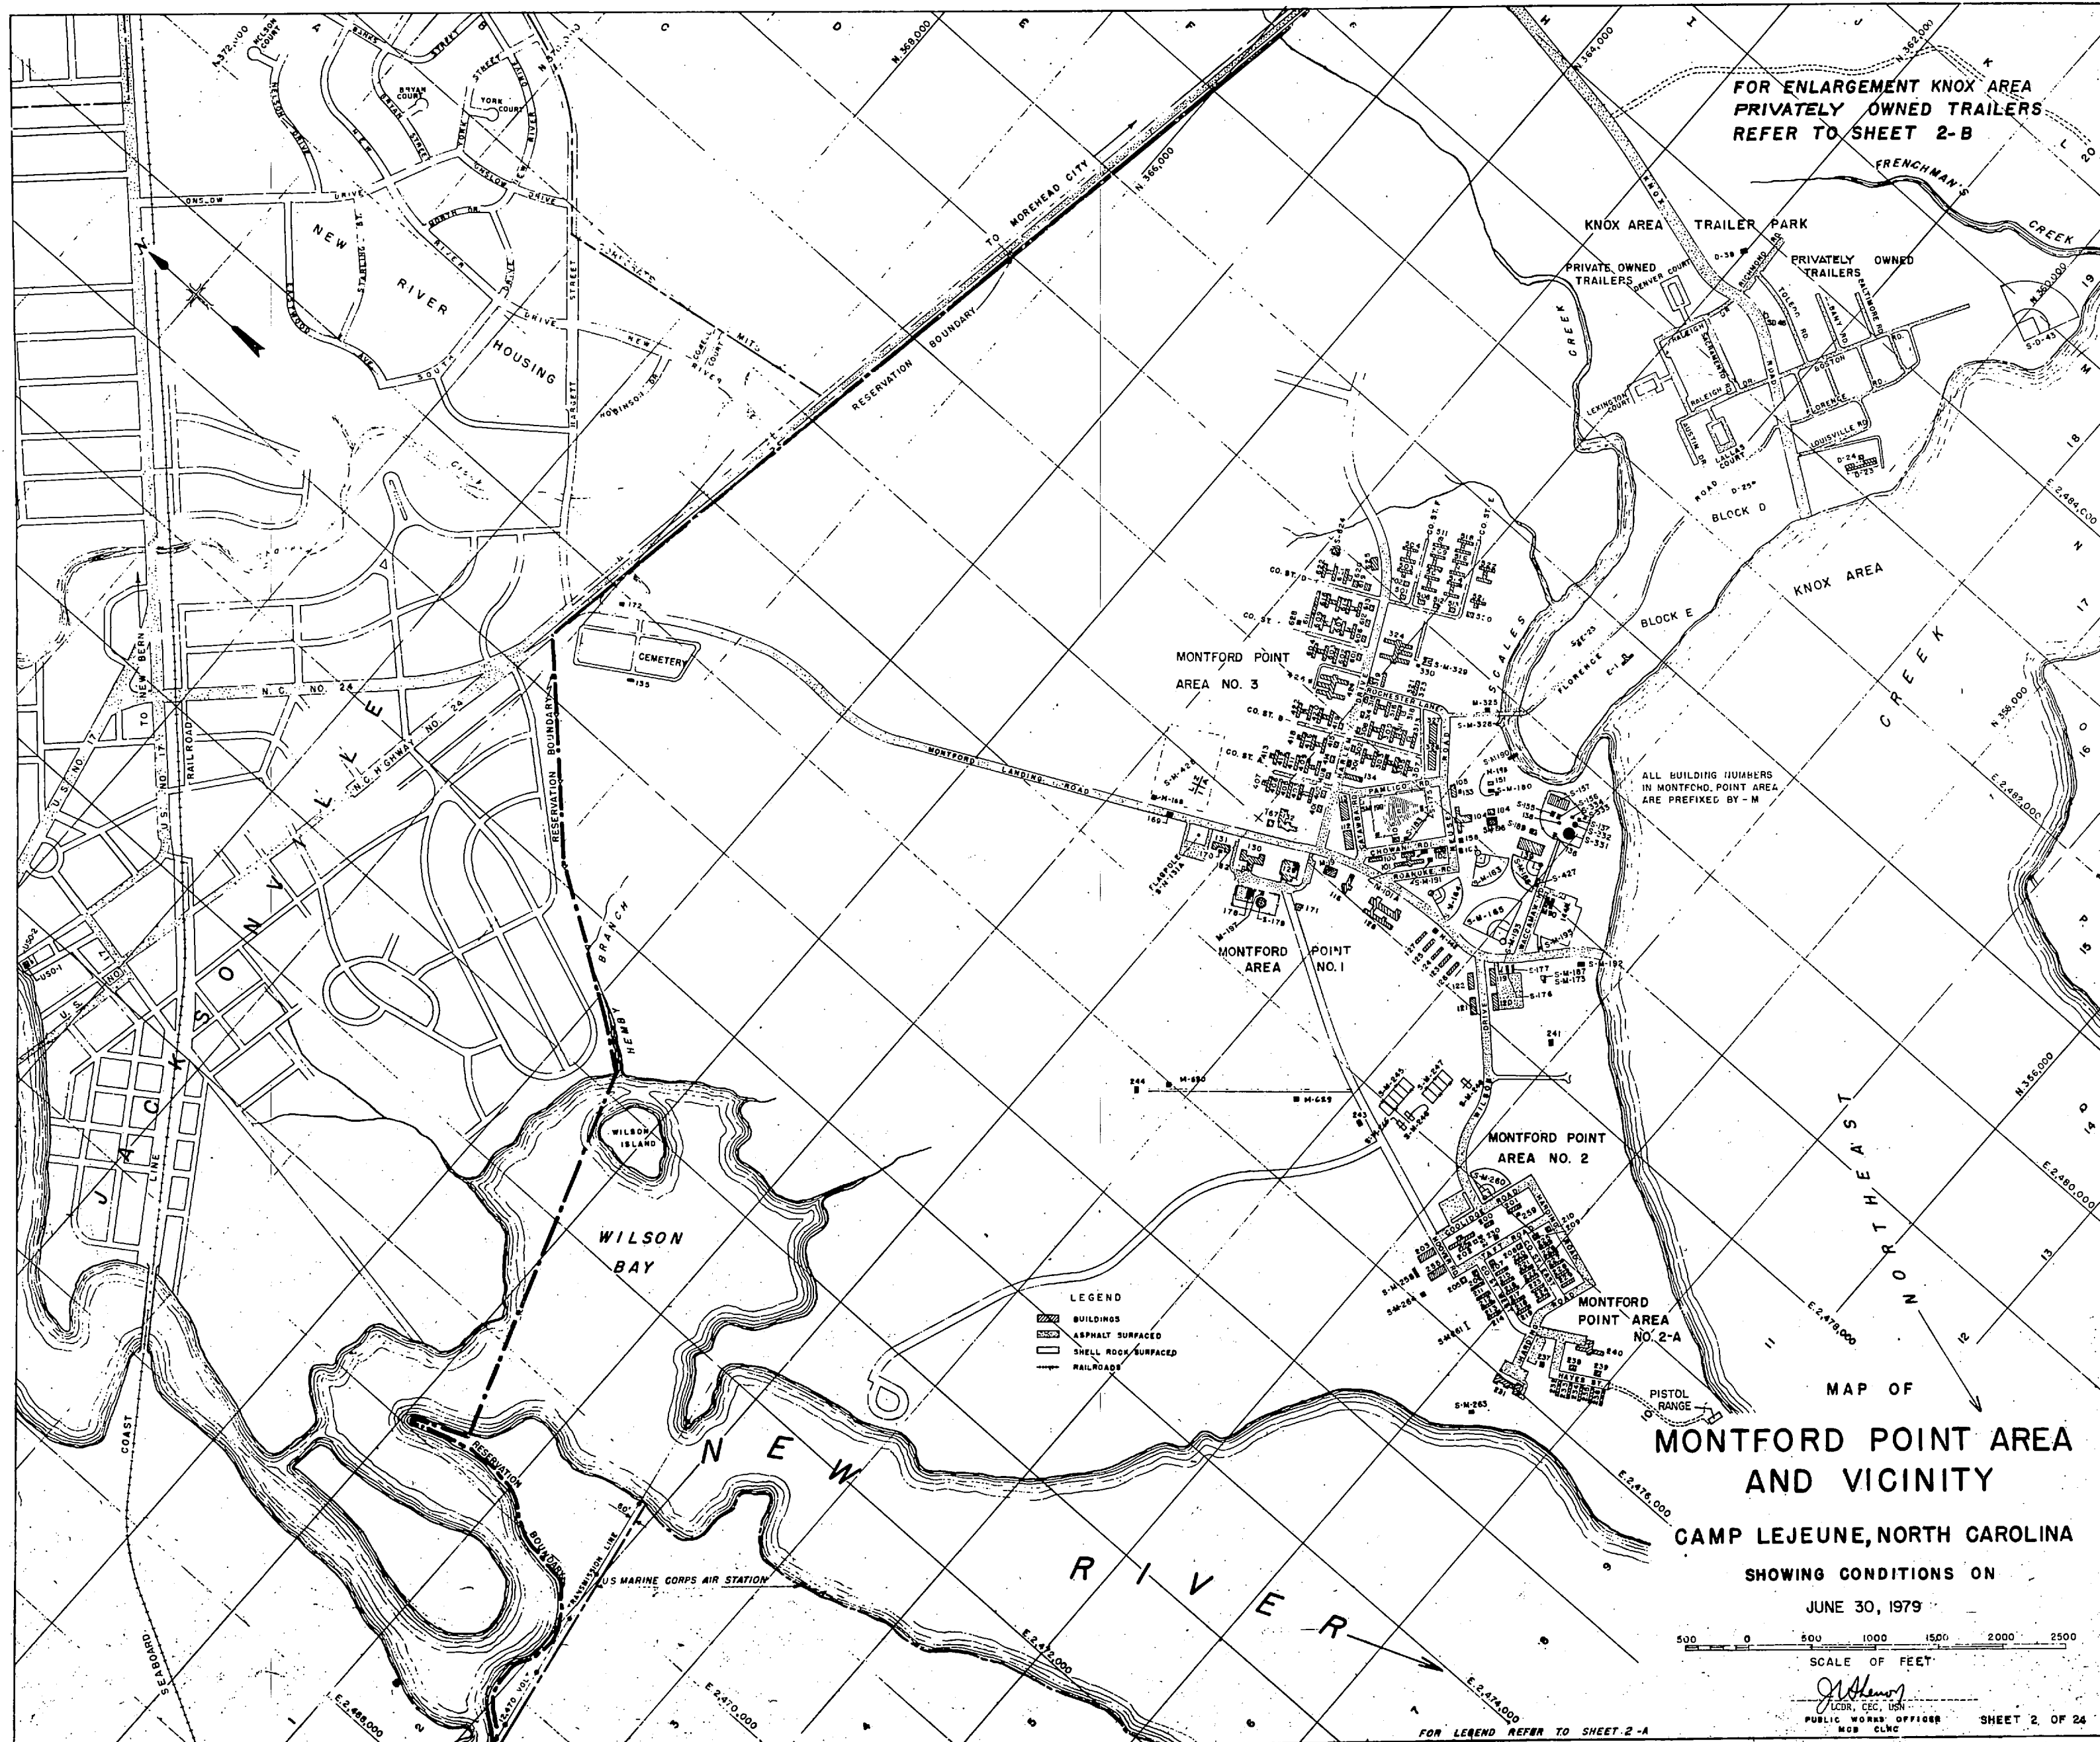

FOR ENLARGEMENT KNOX AREA  
PRIVATELY OWNED TRAILERS  
REFER TO SHEET 2-B

MAP OF  
**MONTFORD POINT AREA  
AND VICINITY**  
CAMP LEJEUNE, NORTH CAROLINA  
SHOWING CONDITIONS ON  
JUNE 30, 1979

SCALE OF FEET  
0 500 1000 1500 2000 2500

*J. A. Henry*  
PUBLIC WORKS OFFICER  
MOB CLMC

SHEET 2 OF 24

FOR OFFICIAL USE ONLY CAMP LEJEUNE, N.C.

LEGEND  
 [Symbol] BUILDINGS  
 [Symbol] ASPHALT SURFACED  
 [Symbol] SHELL ROAD SURFACED  
 [Symbol] RAILROADS


FOR LEGEND REFER TO SHEET 2-A









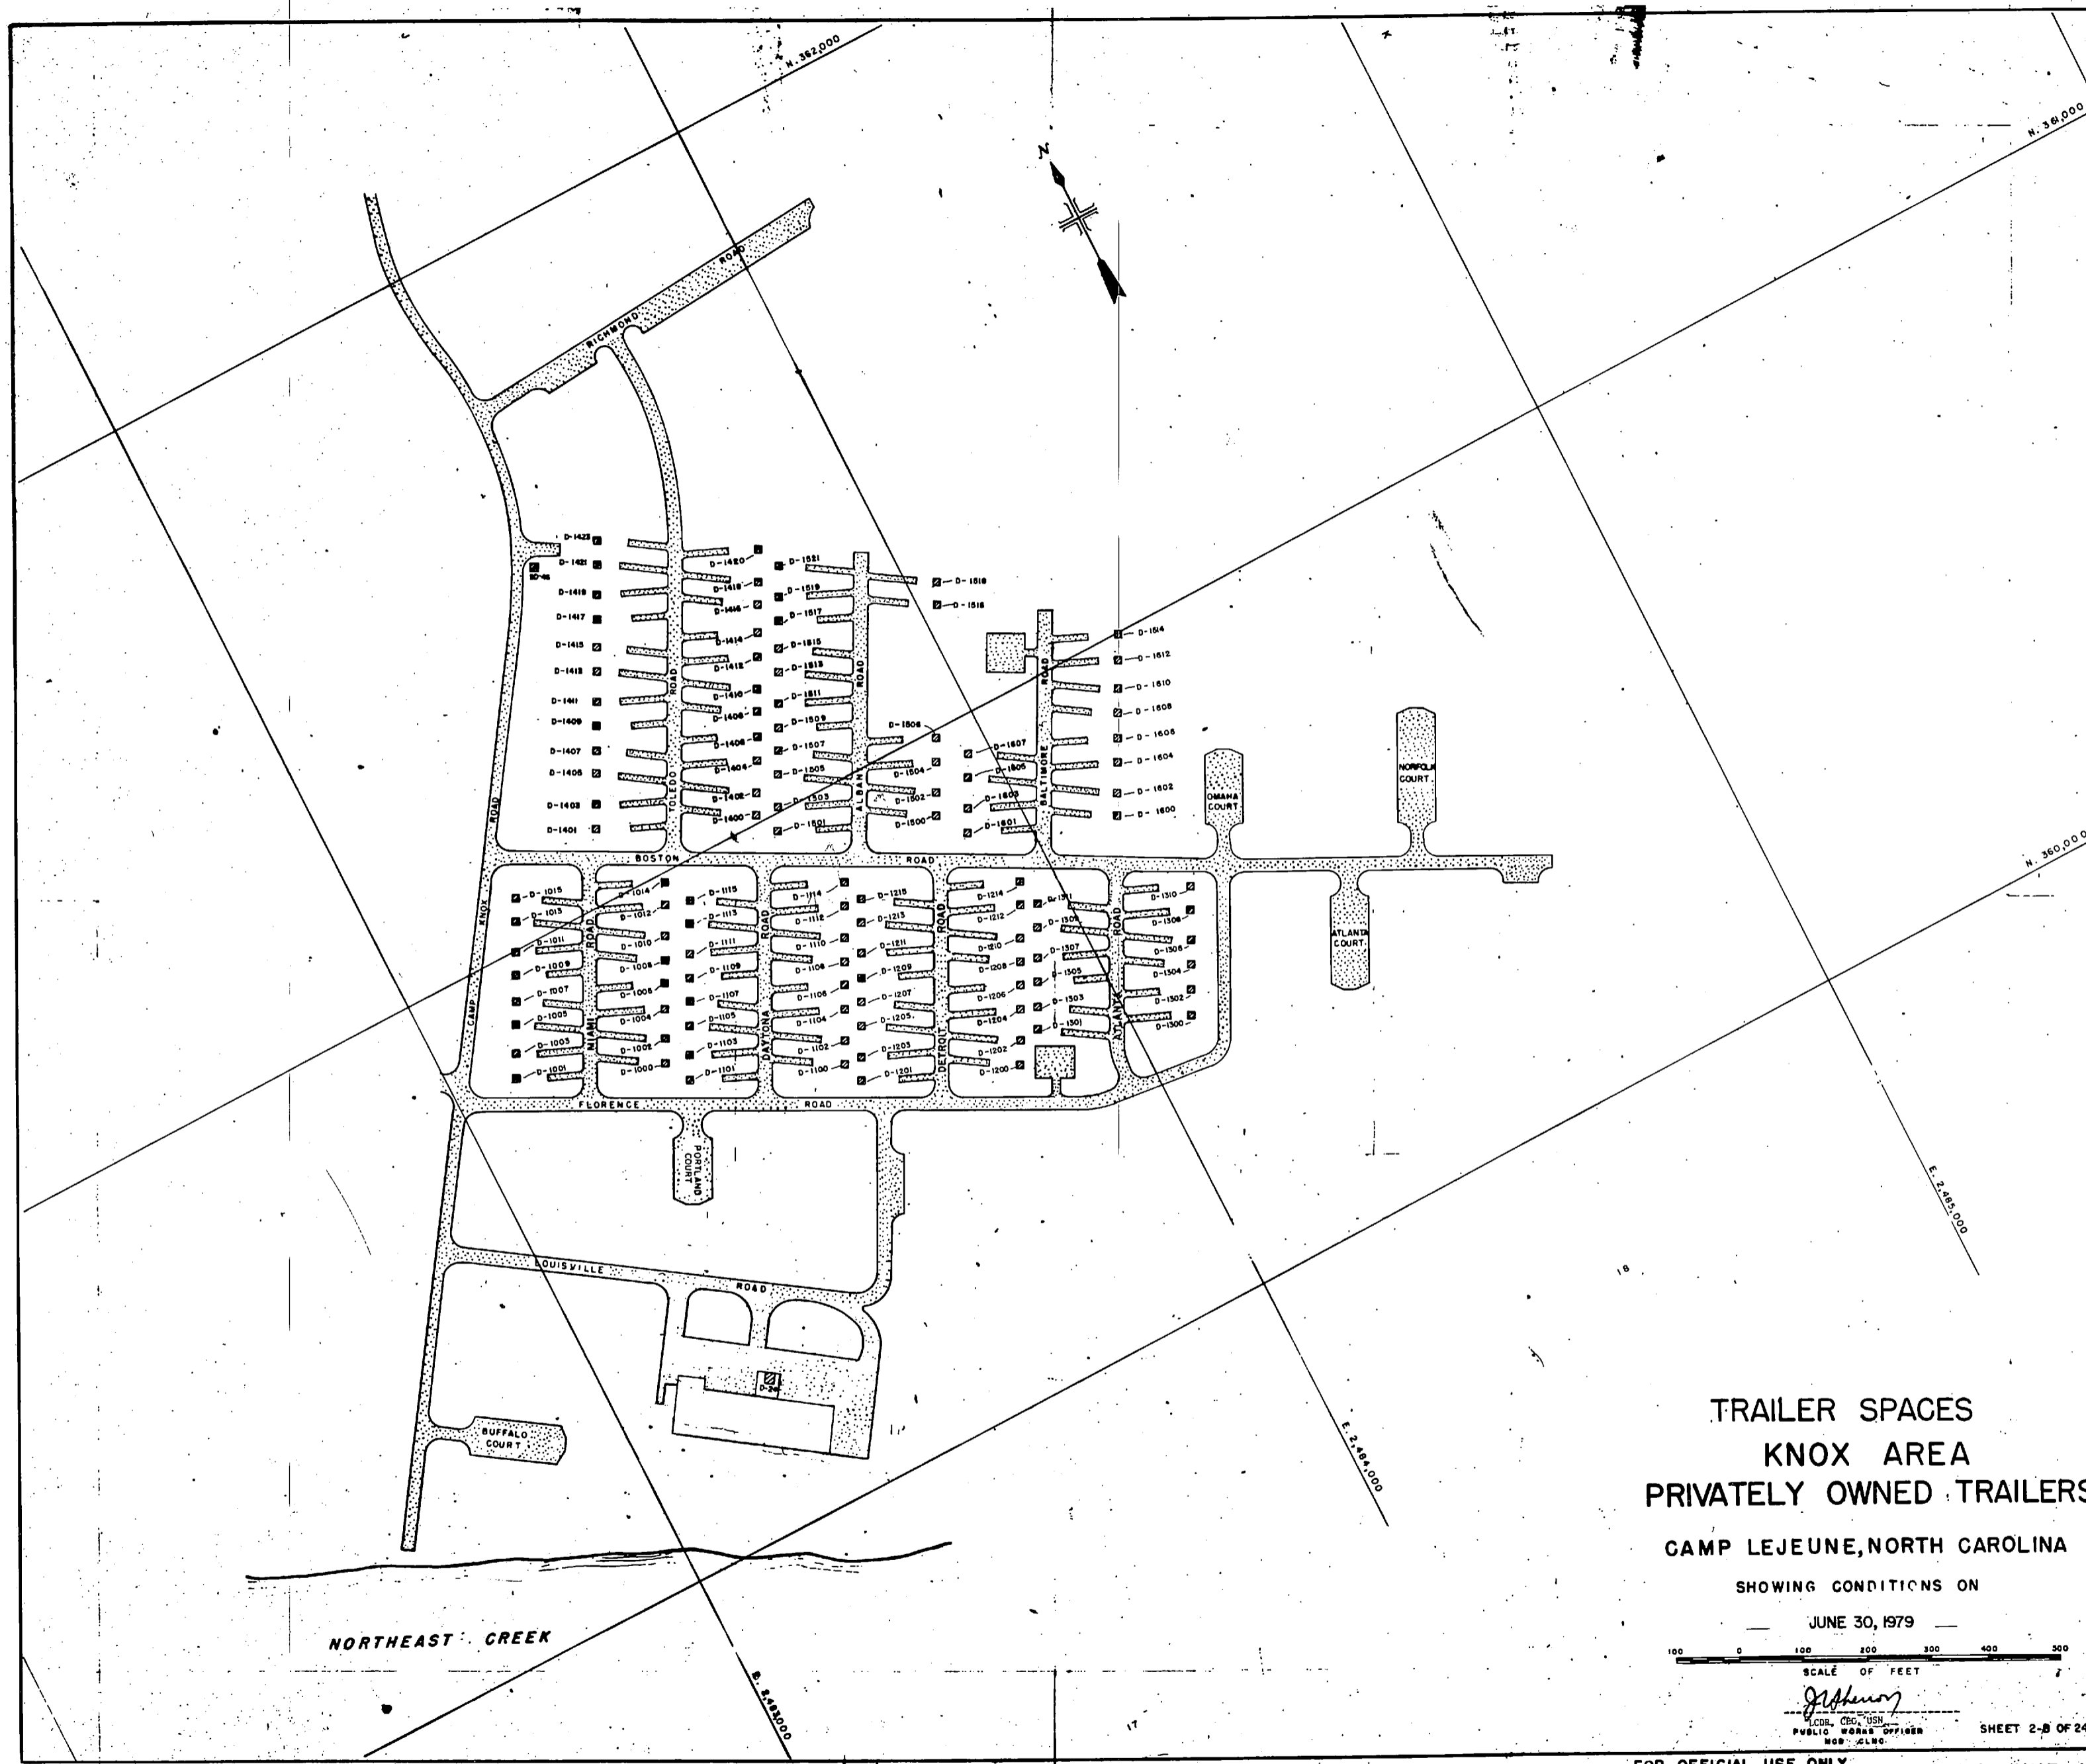

TRAILER SPACES  
 KNOX AREA  
 PRIVATELY OWNED TRAILERS  
 CAMP LEJEUNE, NORTH CAROLINA

SHOWING CONDITIONS ON  
 JUNE 30, 1979

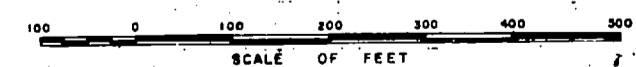

SCALE OF FEET


*J. Johnson*


SHEET 2-B OF 24

FOR OFFICIAL USE ONLY. CAMP LEJEUNE, N.C.




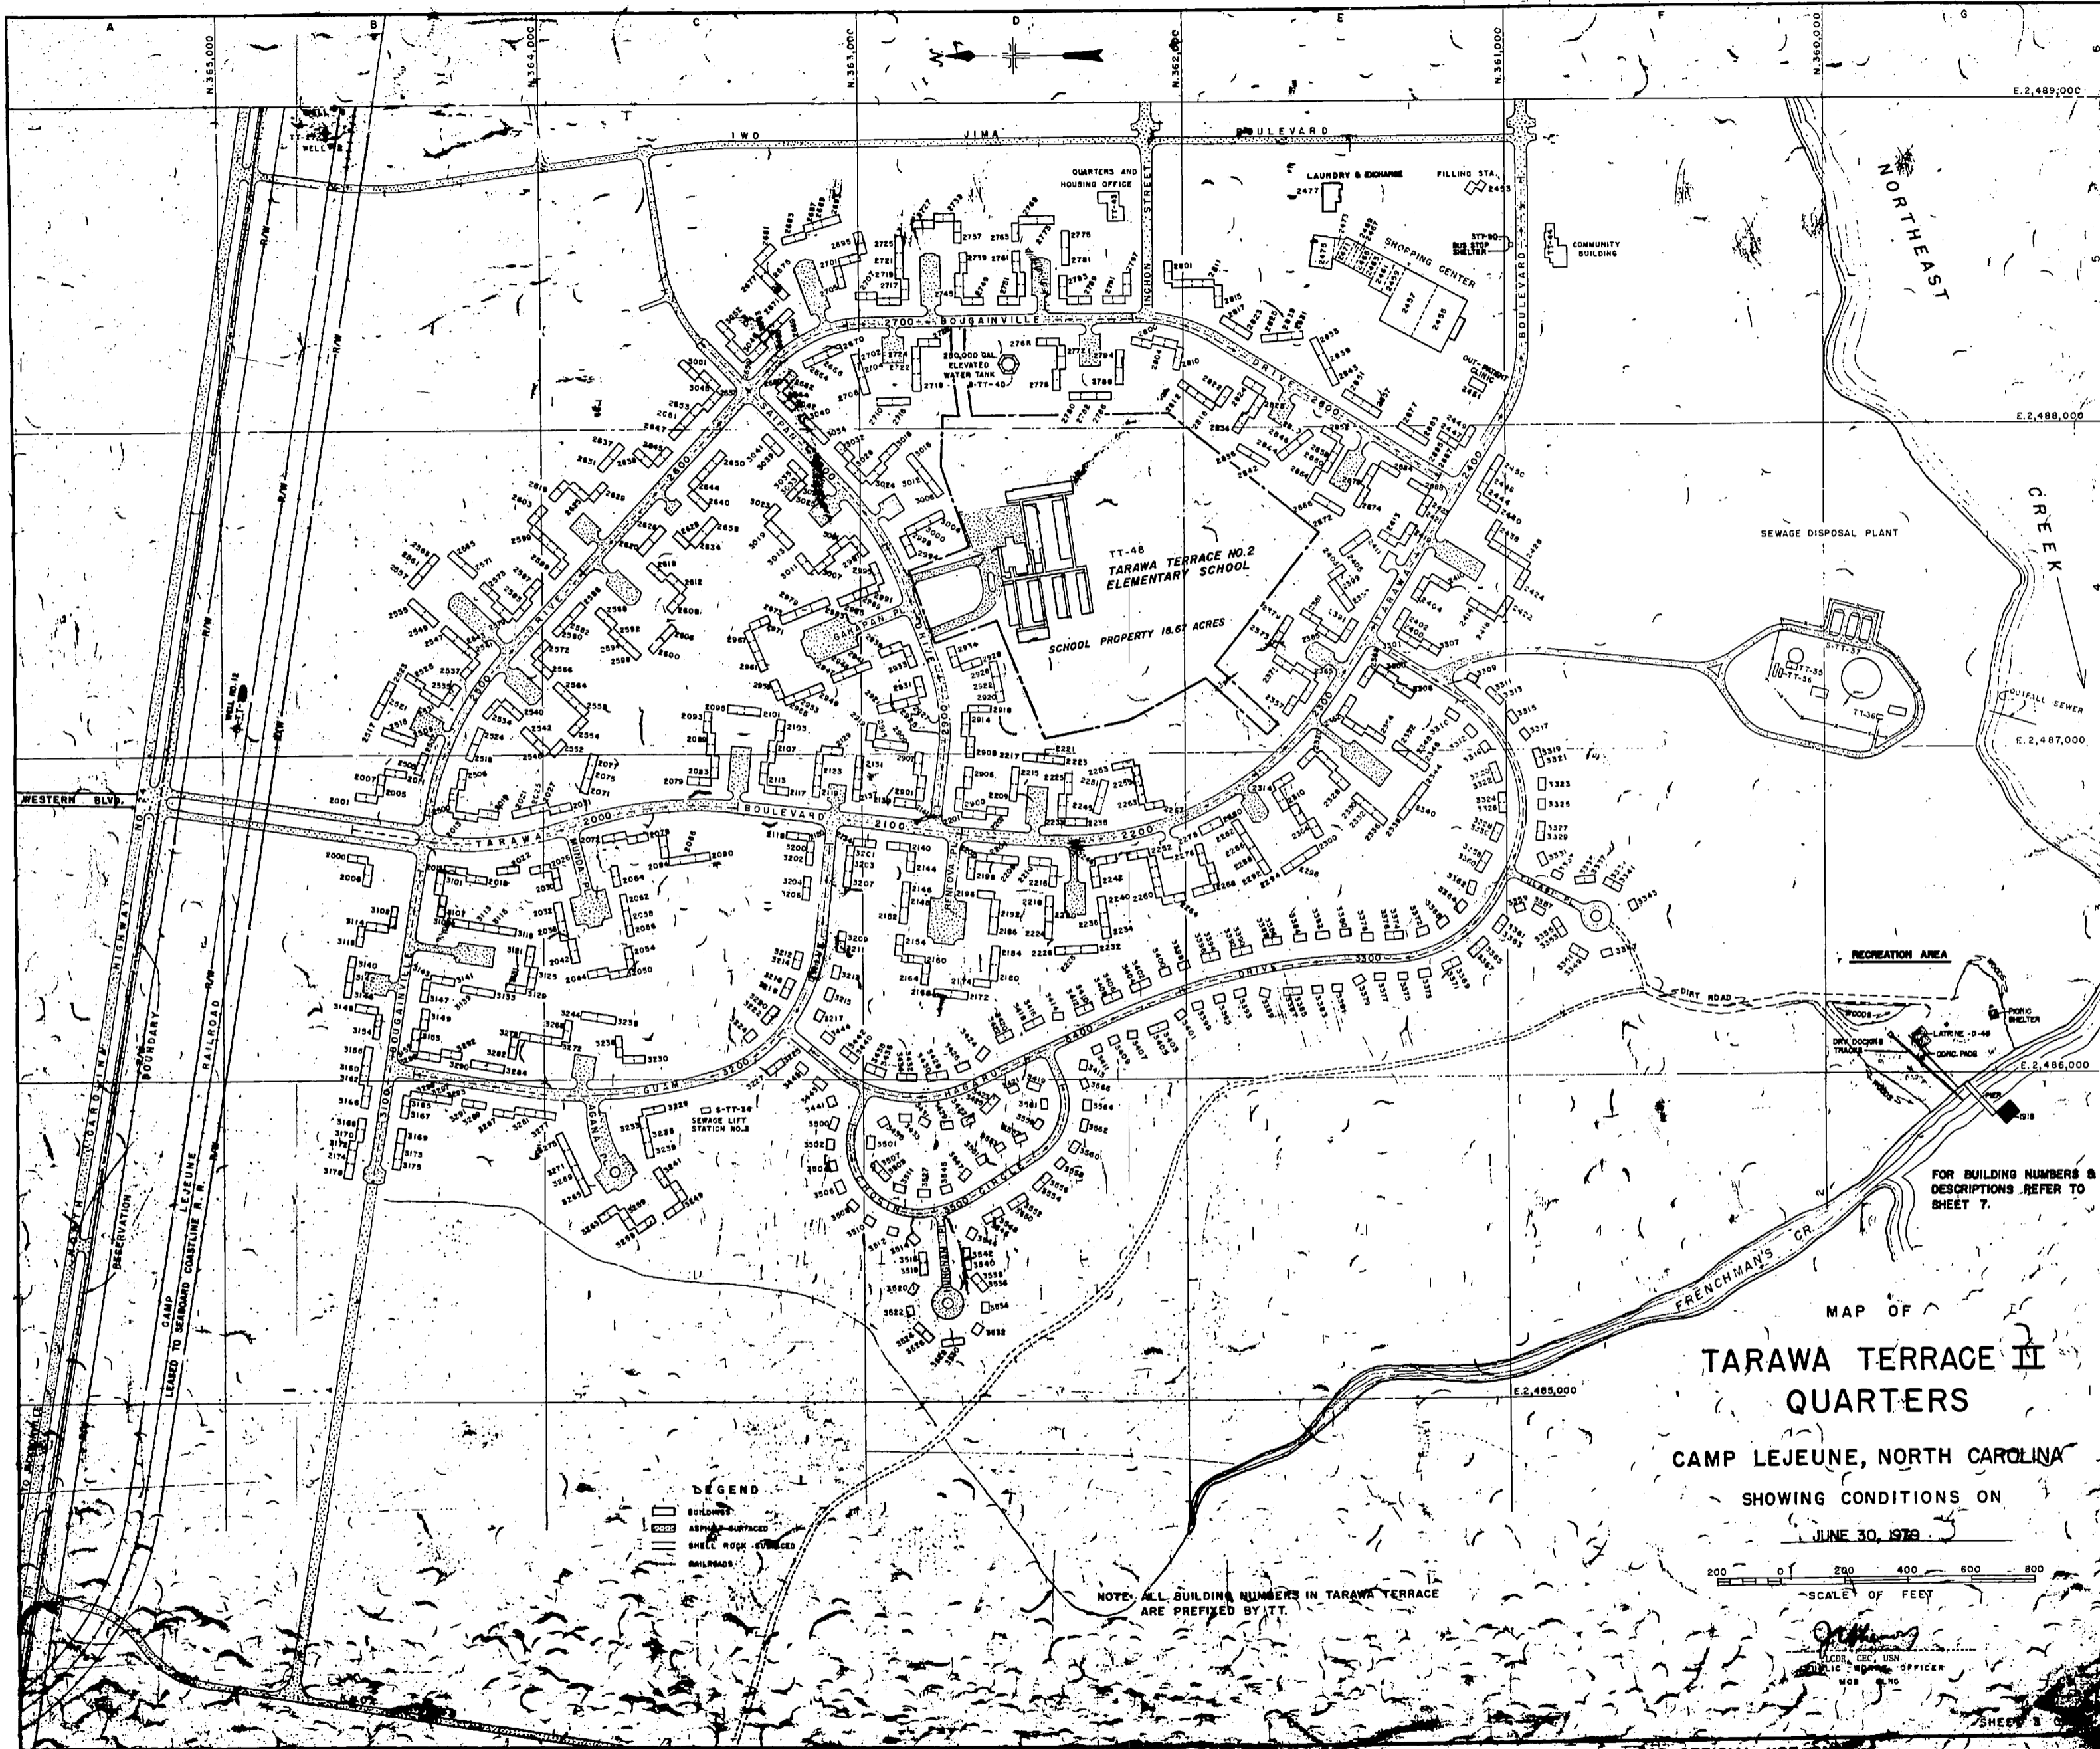

MAP OF  
**TARAWA TERRACE II  
 QUARTERS**

CAMP LEJEUNE, NORTH CAROLINA

SHOWING CONDITIONS ON  
 JUNE 30, 1979

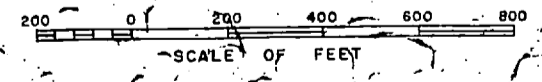


- LEGEND**
- BUILDING
  - ASPHALT SURFACE
  - SHELL ROCK SURFACE
  - RAILROAD


NOTE: ALL BUILDING NUMBERS IN TARAWA TERRACE  
 ARE PREFIXED BY 'TT'.

FOR BUILDING NUMBERS &  
 DESCRIPTIONS REFER TO  
 SHEET 7.



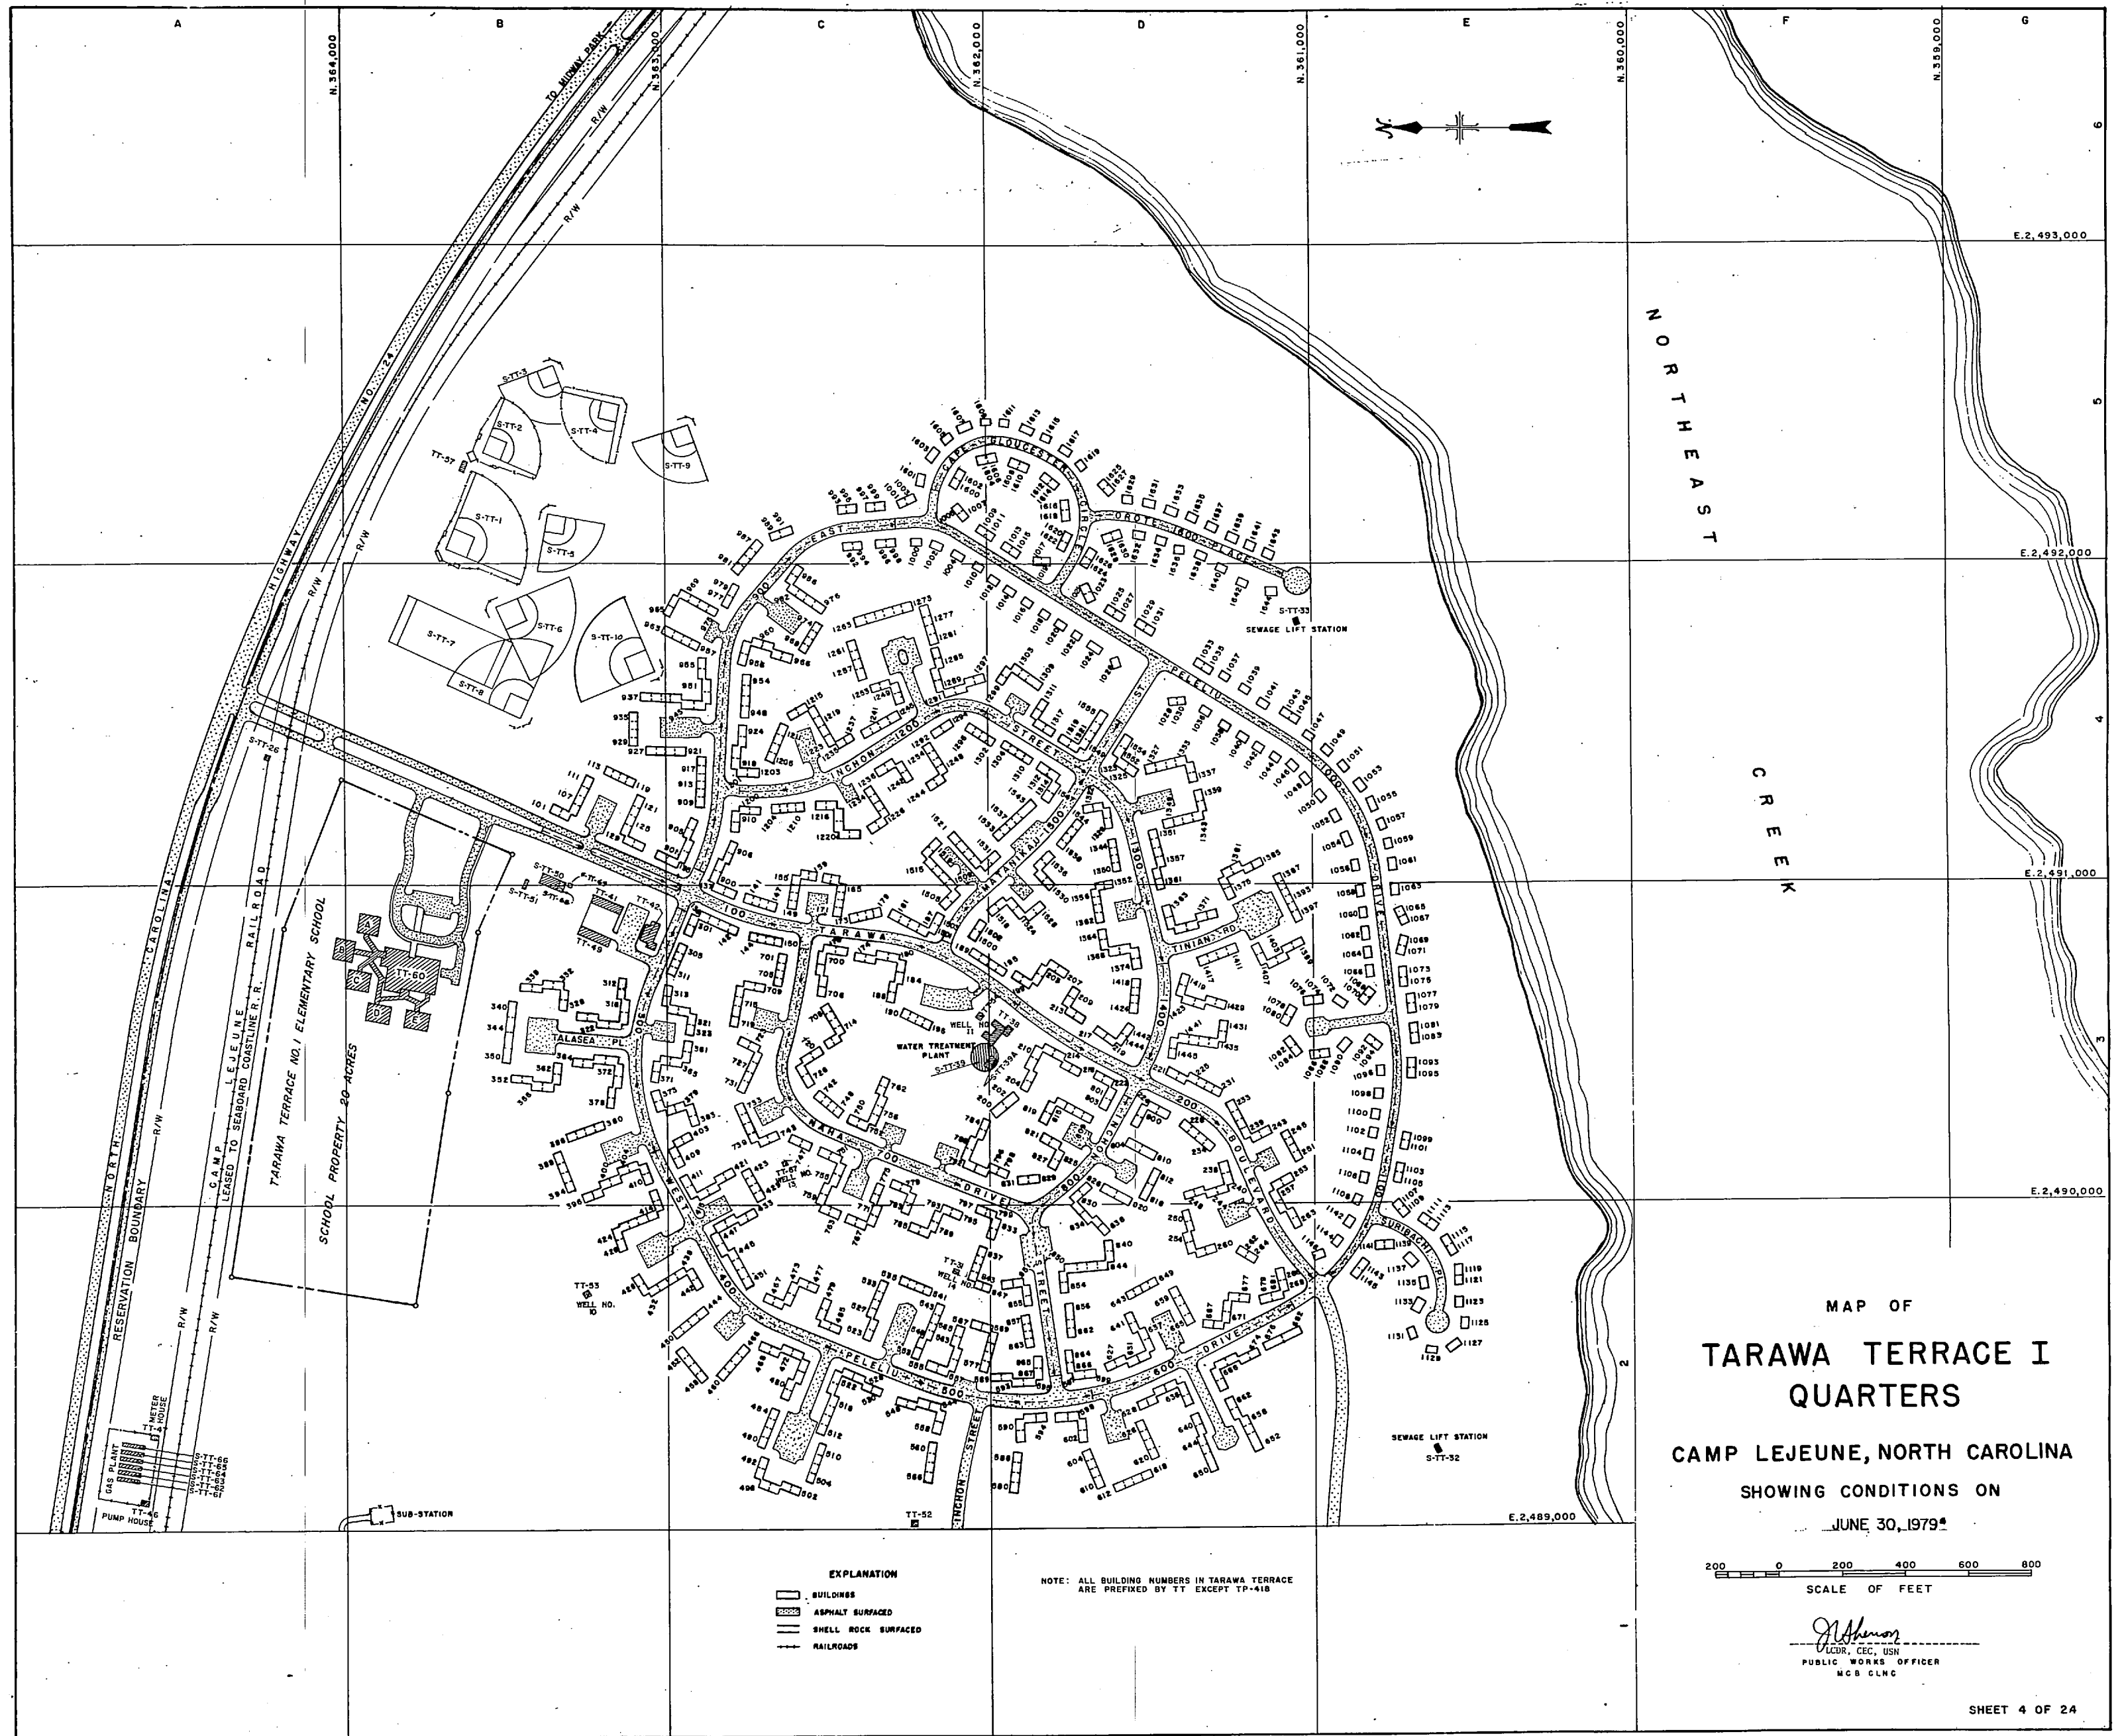

MAP OF  
**TARAWA TERRACE I  
 QUARTERS**  
 CAMP LEJEUNE, NORTH CAROLINA  
 SHOWING CONDITIONS ON  
 JUNE 30, 1979\*

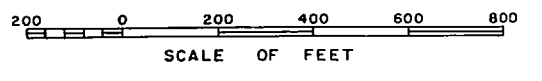

*J. Johnson*  
 LTJUR, CEC, USN  
 PUBLIC WORKS OFFICER  
 MCB CLNC


SHEET 4 OF 24









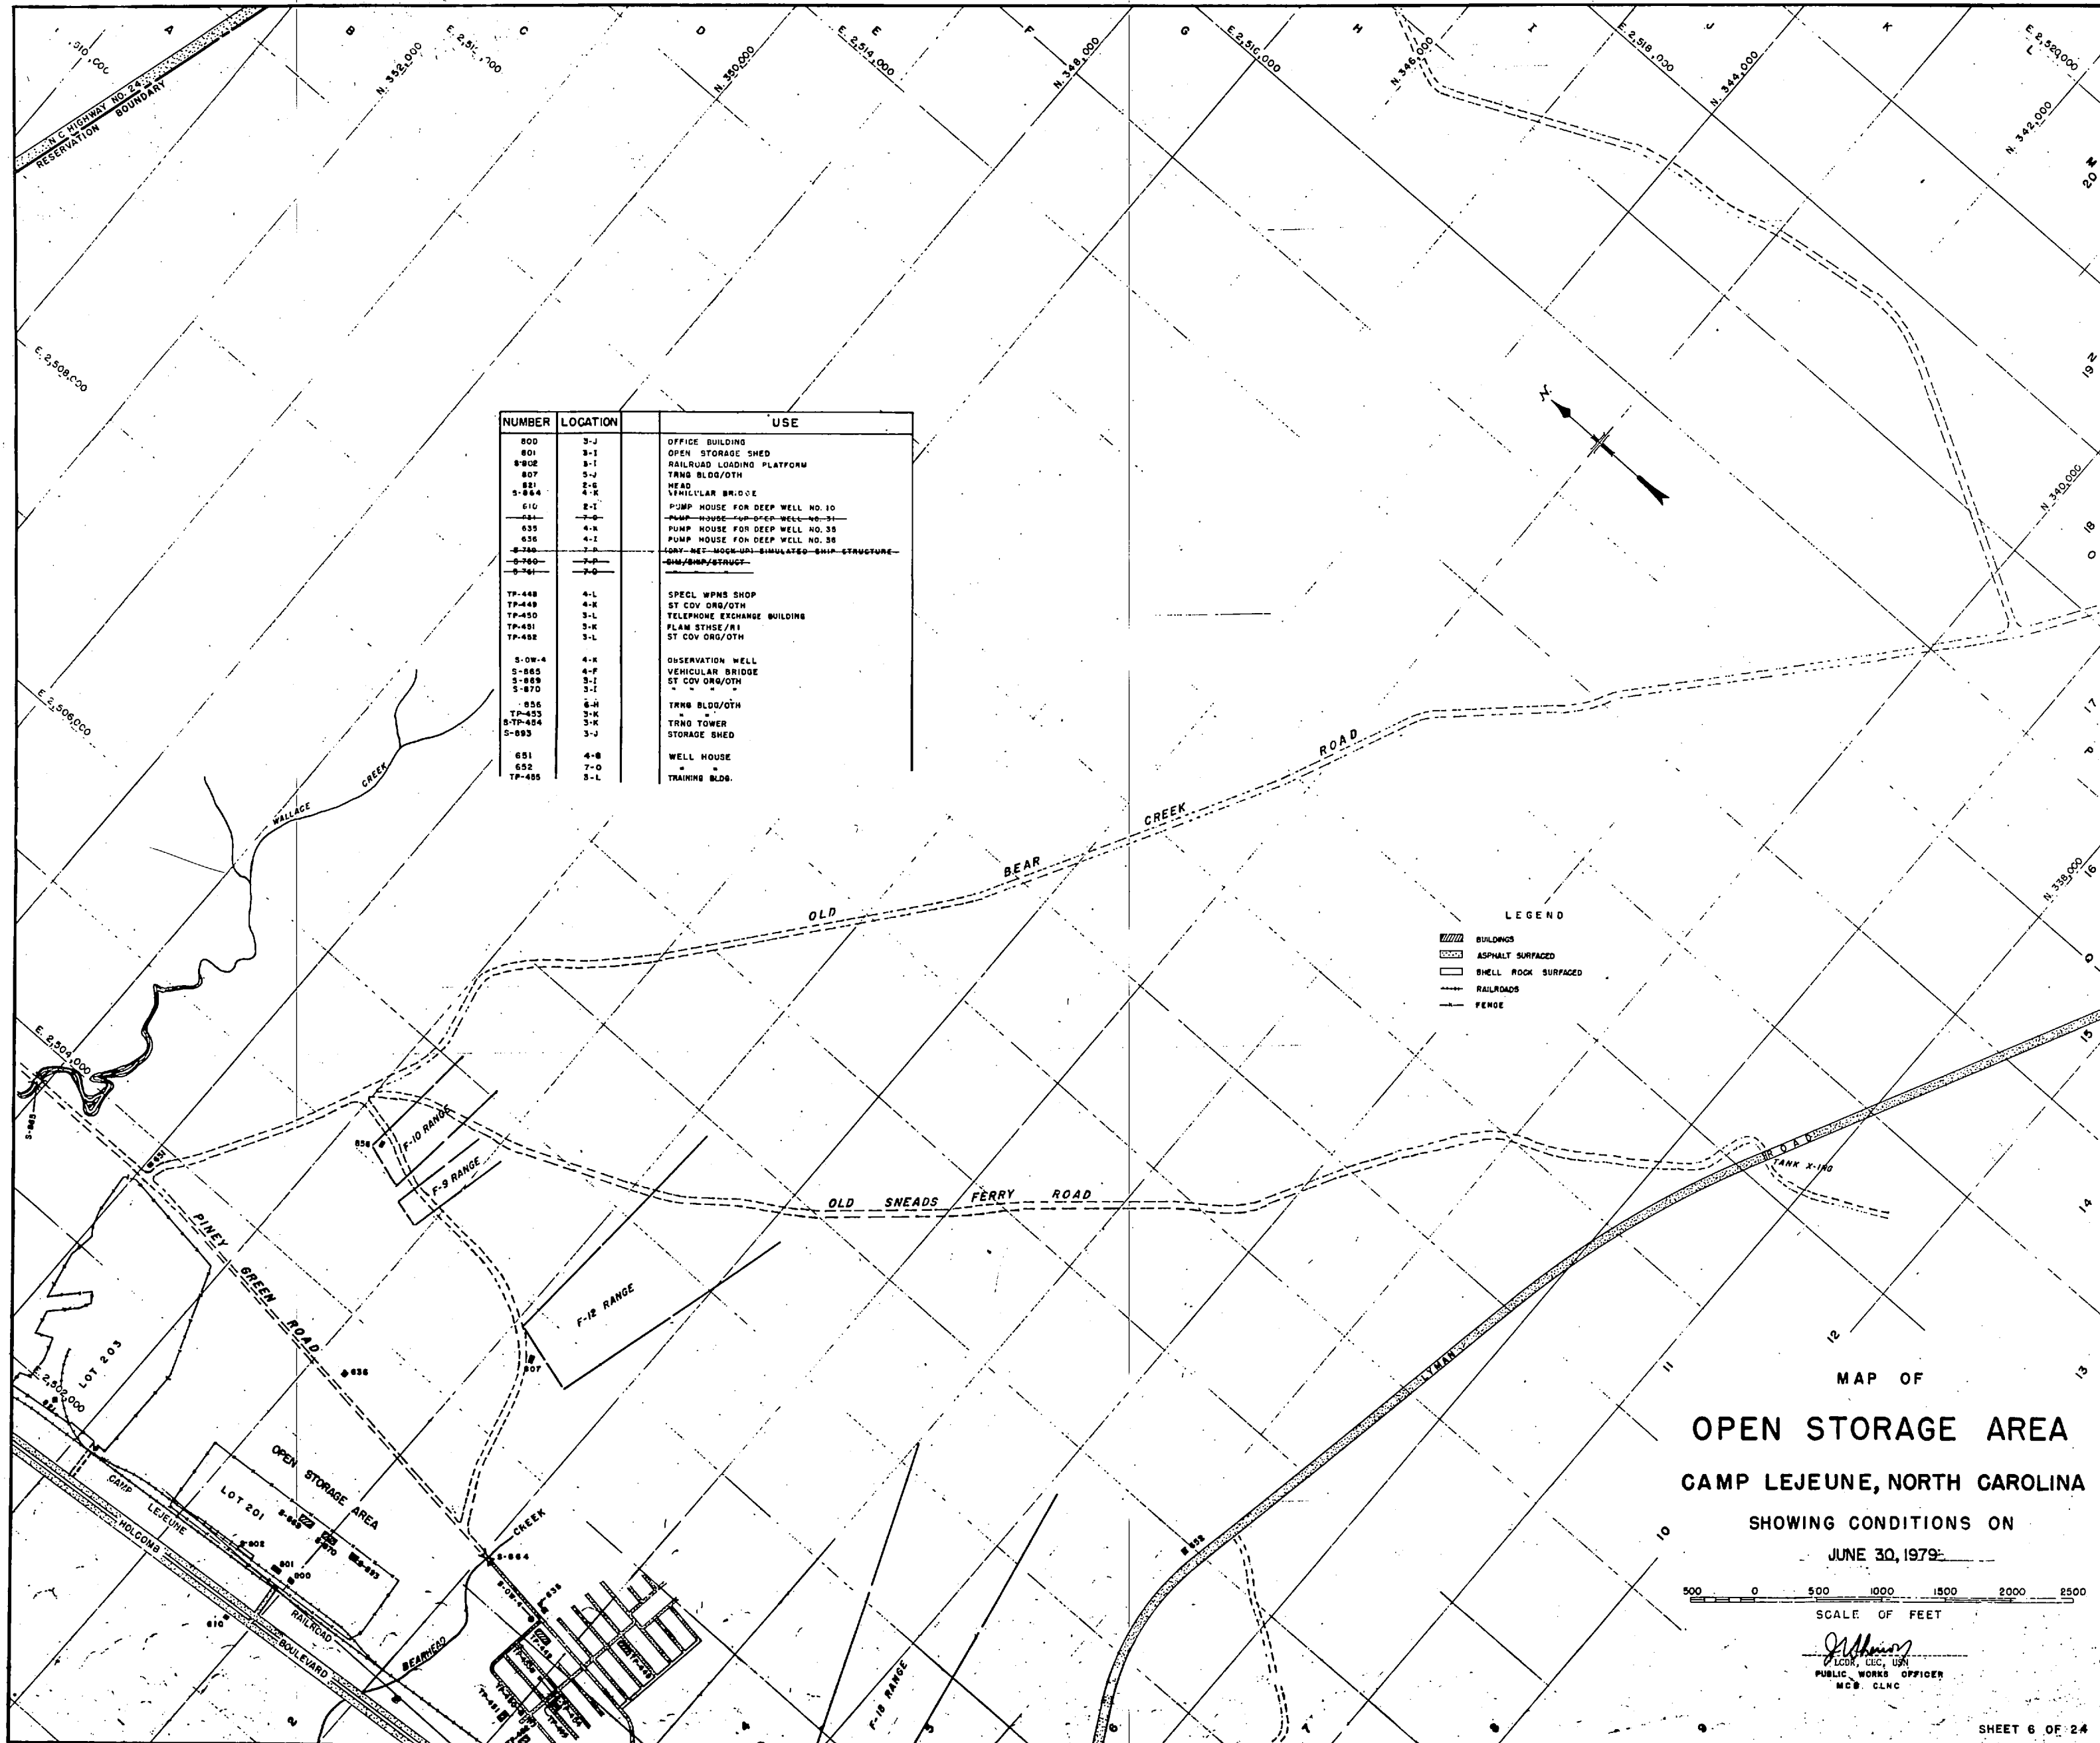

NUMBER	LOCATION	USE
800	3-J	OFFICE BUILDING
801	3-I	OPEN STORAGE SHED
802	3-I	RAILROAD LOADING PLATFORM
807	5-J	TRNS BLDG/OTH


LEGEND

- ▨ BUILDINGS
- ▤ ASPHALT SURFACED
- ▥ SHELL ROCK SURFACED
- RAILROADS
- - - FENCE

MAP OF  
**OPEN STORAGE AREA**  
**CAMP LEJEUNE, NORTH CAROLINA**  
 SHOWING CONDITIONS ON  
 JUNE 30, 1979

500 0 500 1000 1500 2000 2500  
 SCALE OF FEET

*J. H. Johnson*  
 PUBLIC WORKS OFFICER  
 M.C. CLNC

 







NUMBER	LOCATION	USE
811	3-F	PUMP HOUSE FOR WELL NO. 11
812	4-D	WATER TANK
813	2-C	WATER TANK
820	2-E	DEPT SCH/HIGH
820	3-D	WATER TANK
821	2-D	SUBSTATION
8248	1-E	PER SUP FAC/OTH
8249	1-F	BASEBALL FIELD
8250	1-F	FOOTBALL FIELD & TRACK
8251	1-F	SOFTBALL FIELD
8252	1-F	SOFTBALL FIELD
8253	1-F	SOFTBALL FIELD
8254	1-F	SOFTBALL FIELD
8255	1-F	SOFTBALL FIELD
8256	1-E	SCHOOL BLDG
8257	2-E	DEPT SCH/HIGH
8258	1-E	TENNIS COURTS
8259	1-E	TENNIS COURTS
LEGEND  
 [Symbol] BUILDINGS-STRUCTURES  
 [Symbol] ASPHALT SURFACE  
 [Symbol] BLOCK BOUNDARY

MAP OF  
**M E M Q**  
**BERKELEY MANOR AREA**  
**CAMP LEJEUNE, NORTH CAROLINA**  
 SHOWING CONDITIONS ON  
 JUNE 30 1979  
 SCALE OF FEET  
 0 200 400 600 800 1000










NUMBER	LOCAT.	USE	NUMBER	LOCAT.	USE
H-1	2-D	HOSPITAL	H-41	2-C	GARAGE
H-2	2-D	WARD AND CLINIC	H-42	2-C	GARAGE
H-3	3-D	WARD AND CLINIC	H-43	2-D	WARD
H-4	3-D	ADMINISTRATION BLDG.	H-44	2-D	WARD
H-5	3-D	WARD	H-45	3-D	WARD
H-6	3-D	WARD	H-46	3-D	WARD
H-7	3-D	WARD	H-47	3-D	PERSONNEL AND RECORDS BLDG.
H-8	3-D	WARD - RED CROSS	H-48	4-C	ANIMAL HOUSE
H-9	3-D	WARD	H-49	4-C	MEDICAL OFFICERS' QUARTERS
H-10	3-C	MESS HALL AND RECREATION BLDG.	H-50	5-C	MEDICAL OFFICERS' QUARTERS
H-11	3-D	WARD	H-51	5-C	MEDICAL OFFICERS' QUARTERS
H-12	3-D	WARD	H-52	5-C	MEDICAL OFFICERS' QUARTERS
H-13	3-D	WARD	H-53	5-C	MEDICAL OFFICERS' QUARTERS
H-14	4-D	BACHELOR OFFICERS' QUARTERS	H-54	5-C	MEDICAL OFFICERS' QUARTERS
H-15	4-C	FAMILY HOSPITAL	H-55	5-C	MEDICAL OFFICERS' QUARTERS
H-16	4-D	WAVE ENLISTED HQ'S CORPS BKS.	H-56	5-C	MEDICAL OFFICERS' QUARTERS
H-17	3-C	MEDICAL WAREHOUSE	H-57	5-C	MEDICAL OFFICERS' QUARTERS
H-18	3-C	GARAGE	H-58	5-C	MEDICAL OFFICERS' QUARTERS
H-19	3-C	SHOPS	H-59	5-C	MEDICAL OFFICERS' QUARTERS
H-20	4-C	POWER PLANT	H-60	5-C	MEDICAL OFFICERS' QUARTERS
H-21	4-C	LAUNDRY	H-61	5-C	MEDICAL OFFICERS' QUARTERS
H-22	4-C	WAREHOUSE	H-62	5-C	MEDICAL OFFICERS' QUARTERS
H-23	3-C	CORPSMENS' BARRACKS	H-63	5-C	MEDICAL OFFICERS' QUARTERS
H-24	3-C	CORPSMENS' BARRACKS			
H-25	2-C	MEDICAL OFFICERS' QUARTERS	H-65	5-C	MEDICAL OFFICERS' QUARTERS
H-26	2-C	MEDICAL OFFICERS' QUARTERS	H-66	5-C	MEDICAL OFFICERS' QUARTERS
H-27	2-C	MEDICAL OFFICERS' QUARTERS	H-67	5-C	MEDICAL OFFICERS' QUARTERS
H-28	4-C	MEDICAL OFFICERS' QUARTERS	H-68	4-C	MEDICAL OFFICERS' QUARTERS
H-29	4-D	SEWAGE PUMPING STATION NO. 2	H-69	4-C	MEDICAL OFFICERS' QUARTERS
H-30	5-C	NON-HOUSEKEEPING QUARTERS	H-70	5-C	TRANSFORMER HOUSE
H-31	5-C	NON-HOUSEKEEPING QUARTERS	H-N-72	4-D	BASKETBALL COURTS
H-32	5-D	BACHELOR OFFICERS' QUARTERS	H-N-73	4-C	TENNIS COURTS
H-33	4-C	TRANSFORMER HOUSE "A"	H-N-74	4-D	TENNIS COURTS
H-34	4-C	TRANSFORMER HOUSE "E"	H-N-75	3-C	TENNIS COURTS
H-35	2-C	TRANSFORMER HOUSE "D"	H-76	4-C	PANT & INFLAMMABLE STORAGE BLDG.
H-36	3-C	GARAGE	H-77	4-D	GENERATOR HOUSE
H-37	3-C	WELL-E-1	H-78	4-C	PATHOLOGICAL WASTE INCINER. BLDG.
H-38	5-D	TRANSFORMER HOUSE	H-79	3-C	BULK OXYGEN STORAGE SHED
H-39	3-C	NIGHT CORPSMENS' BARRACKS	S-H-80	3-D	FLAGPOLE
H-40	3-C	MEDICAL WAREHOUSE	S-H-81	1-D	PLAYING COURT
			H-82	1-D	PICNIC COOKOUT FACILITY
			H-83	2-D	STORAGE SHED
			H-84	3-C	GARDENERS' STORAGE BUILDING
			S-H-85	3-B	HELICOPTER LANDING PAD (CONC.)


NUMBER	LOCAT.	USE
H-86	4-C	STORAGE
H-87	4-C	"
H-88	5-C	"
H-89	5-C	"
H-90	5-C	"
H-91	5-C	"
H-92	5-C	"
H-93	5-C	"
H-94	5-C	"
H-95	5-C	"
H-96	5-C	"
H-97	5-C	"
H-98	5-C	"
H-99	5-C	"
H-100	5-C	"
H-101	5-C	"
H-102	5-C	"
H-103	5-C	"
H-104	5-C	"
S-H-105	3-C	PLATFORM, OXYGEN FACILITY
H-106	3-D	HELICOPTER LANDING PAD LZ-2
H-107	3-D	ELECT. SWITCHING STA.
H-108	4-C	SUB-STATION
H-109	4-C	TRANSFORMER PAD
H-110	4-C	VEHICLE WASH RACK
H-111	3-C	BAR-B-QUE PIT
H-112	3-C	GREASE RACK
H-113	3-C	READY VEH STORAGE TANK
H-114	3-C	FILLING STATION
H-115	3-C	DUST COLLECTOR SYSTEM
H-116	3-D	TRANSFORMER PAD
H-117	1-D	PICNIC SHELTER
H-118	3-C	HEATING OIL TANK
H-119	3-C	"
H-120	3-C	GENERATOR OIL TANK
H-121	3-C	HEATING OIL TANK
H-122	1-D	WOMENS' TOILET
H-123	1-D	MENS'
H-124	5-C	HEATING OIL TANK
H-125	5-C	"
H-126	5-C	SIGN
H-127	1-D	TOILET FACILITIES

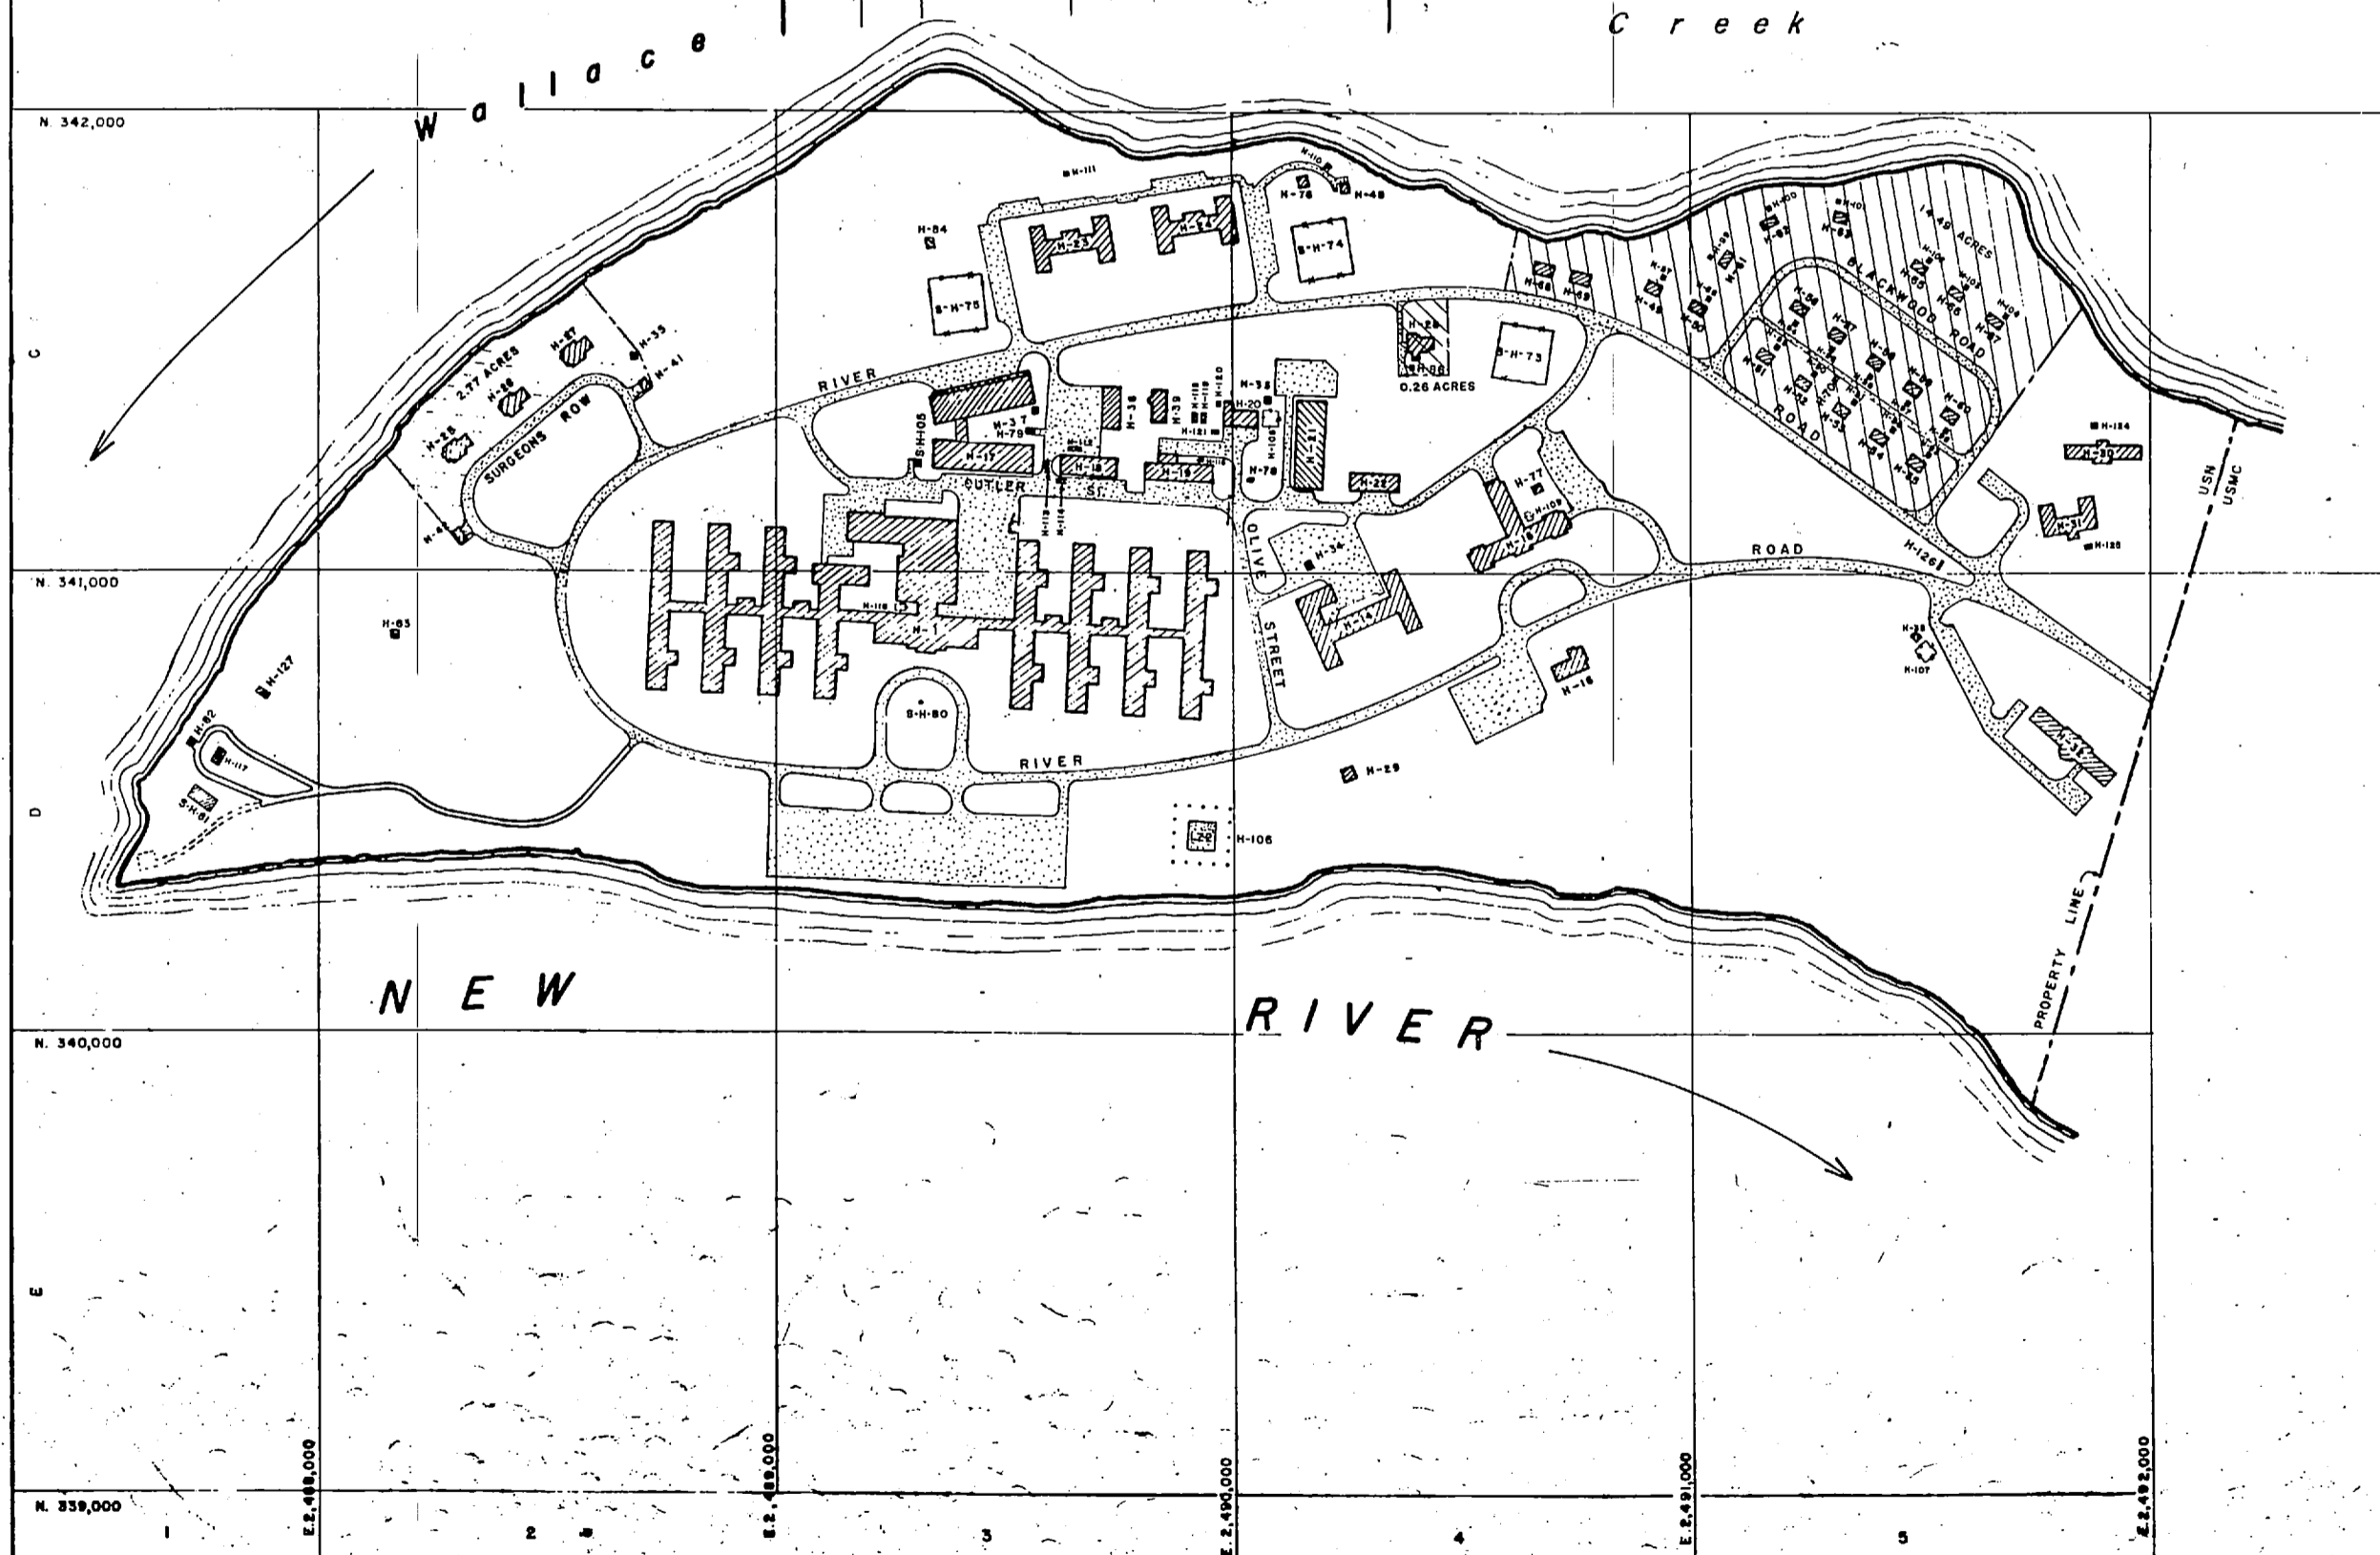

- LEGEND**
- BUILDINGS
  - ASPHALT SURFACED
  - SHORE LINE
  - LZ-2 HELICOPTER LANDING ZONE
  - STONE SURFACED ROAD
  - EARTH ROAD
  - MARINE CORPS BASE PROPERTY

REVISED PROPERTY DELINEATION  
 NAVAL HOSPITAL 127.1 ACRES  
 MARINE CORPS BASE 17.5 " "  
 TOTAL HOSPITAL AREA 144.6 "


MAP OF  
**NAVAL HOSPITAL AREA**  
**CAMP LEJEUNE, NORTH CAROLINA**  
 SHOWING CONDITIONS ON  
 JUNE 30, 1979

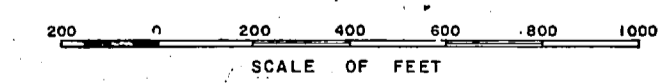


*J. J. [Signature]*  
 LTJG, CEC, USN  
 PUBLIC WORKS OFFICER  
 MOB. CLNC.

SHEET 9 OF 24



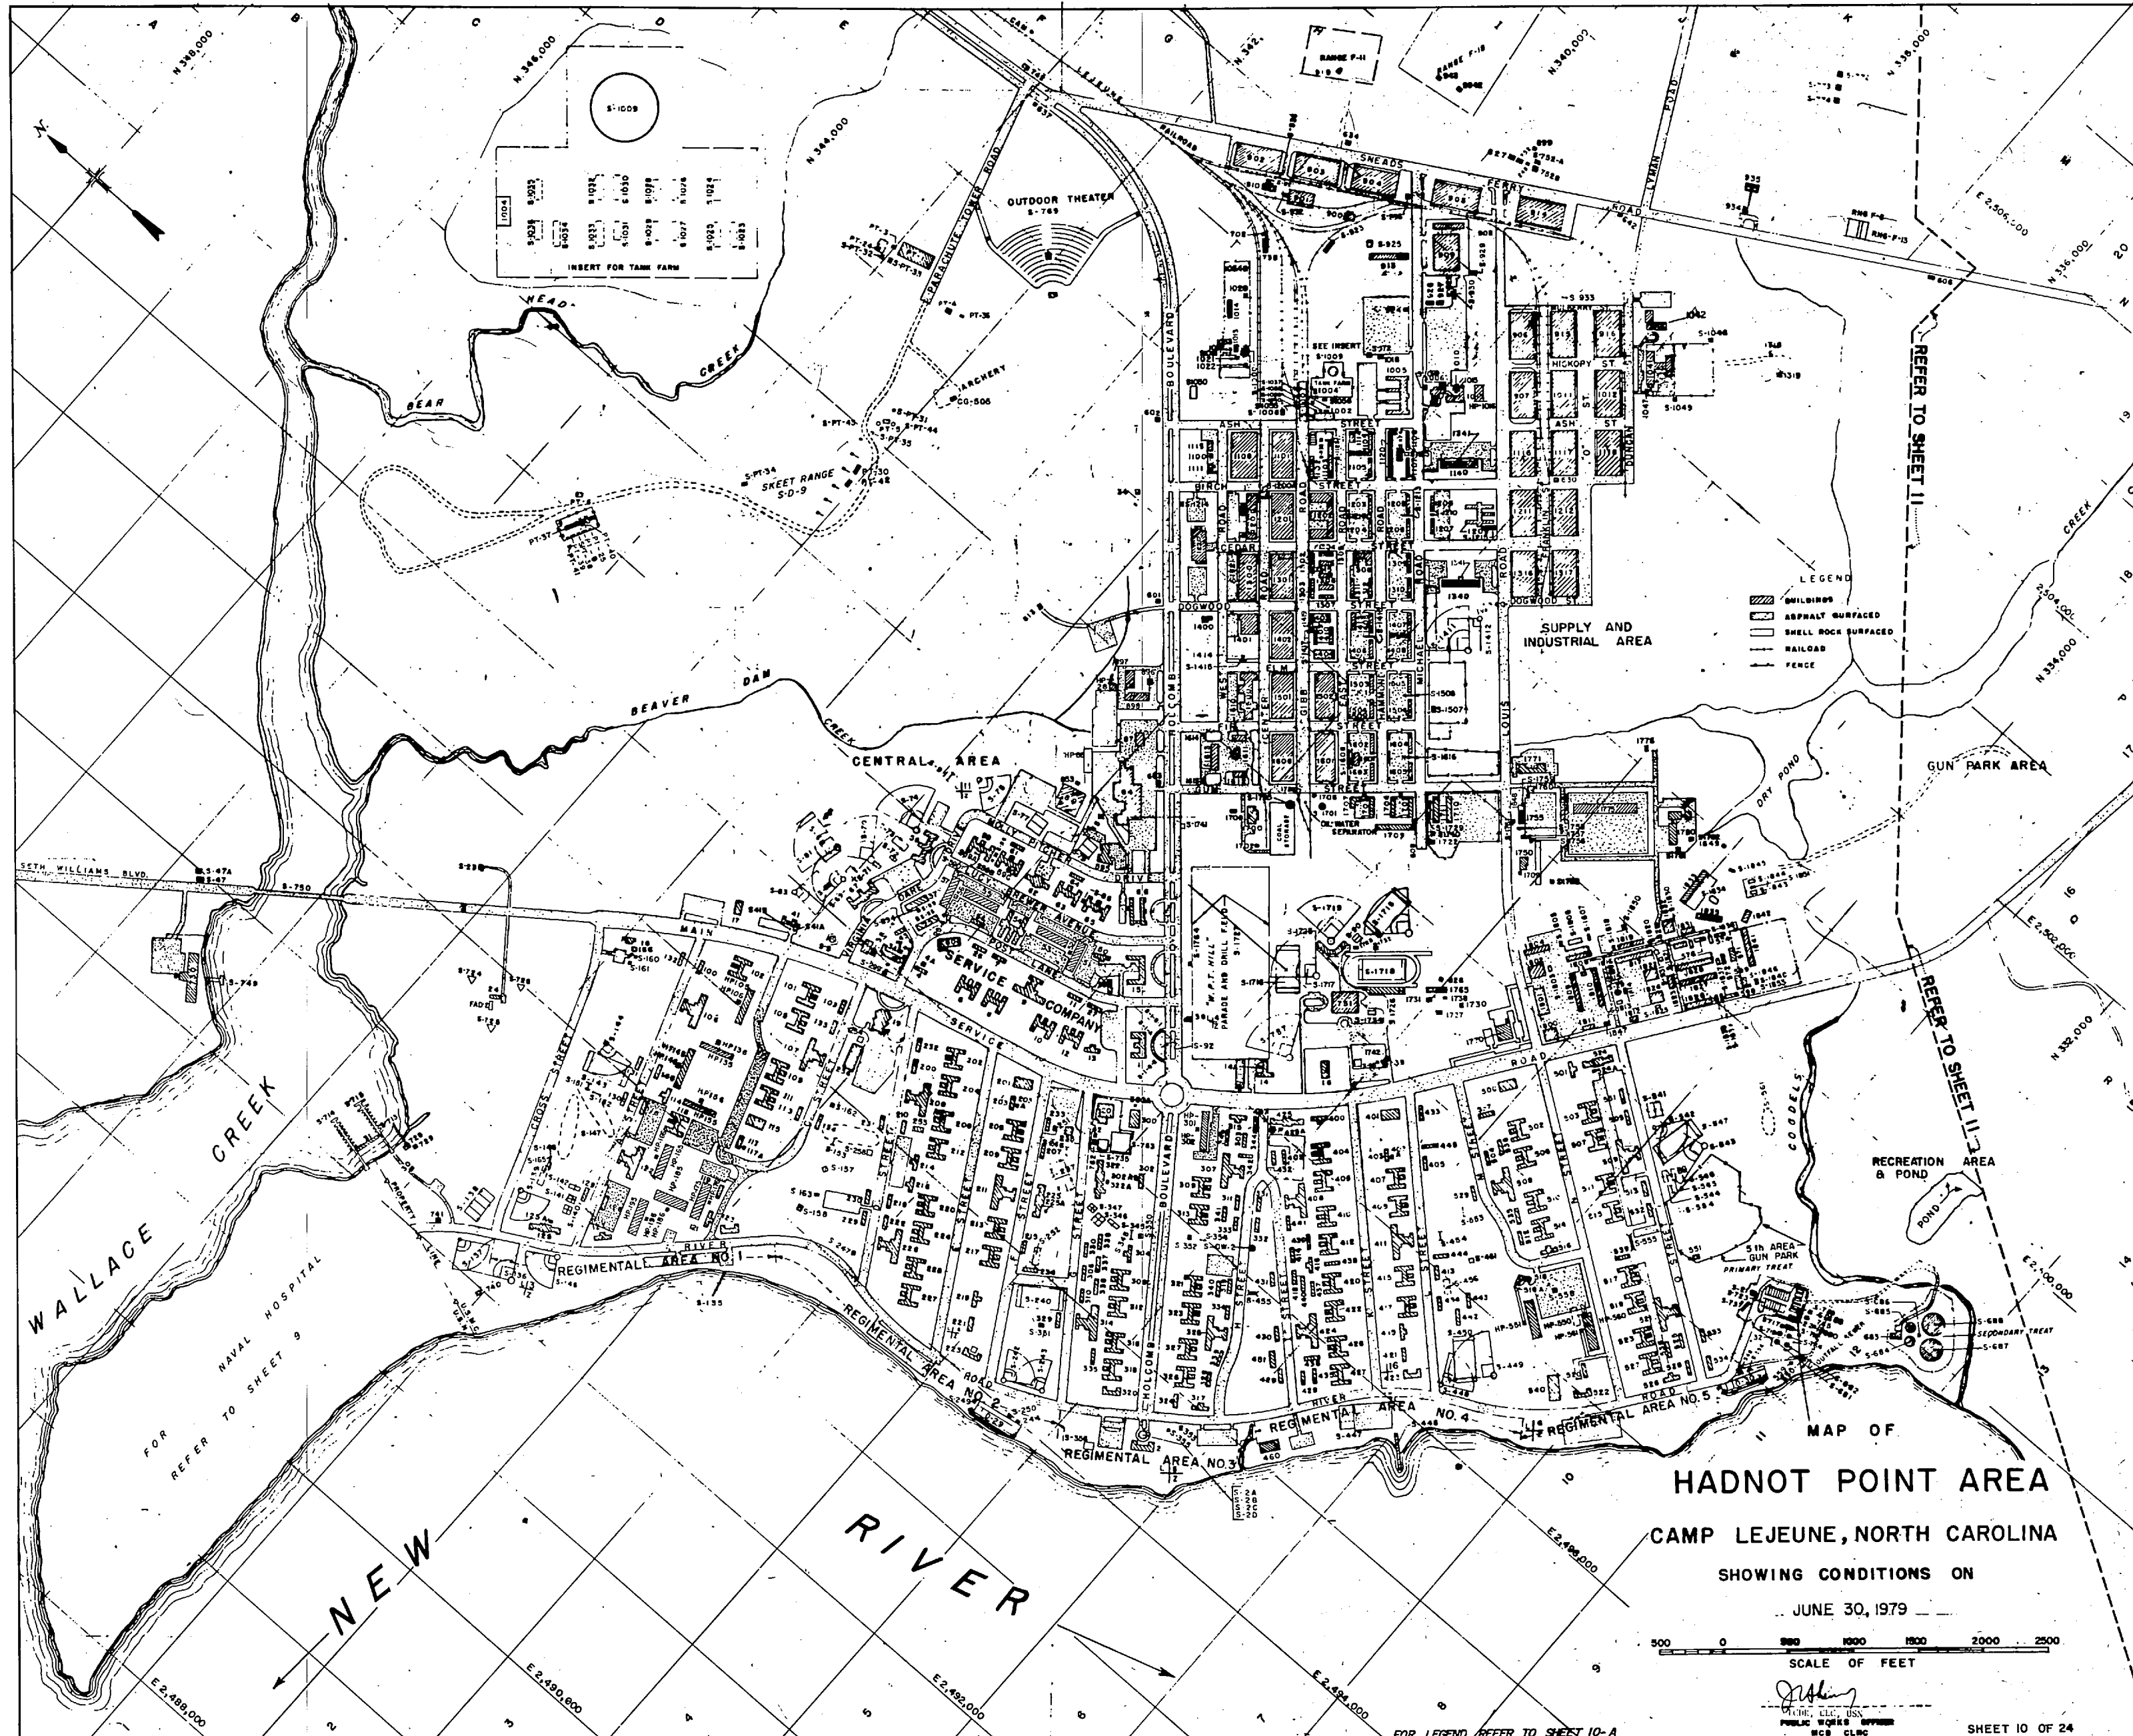



MAP OF  
**HADNOT POINT AREA**  
 CAMP LEJEUNE, NORTH CAROLINA  
 SHOWING CONDITIONS ON  
 JUNE 30, 1979

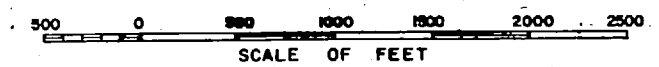





 

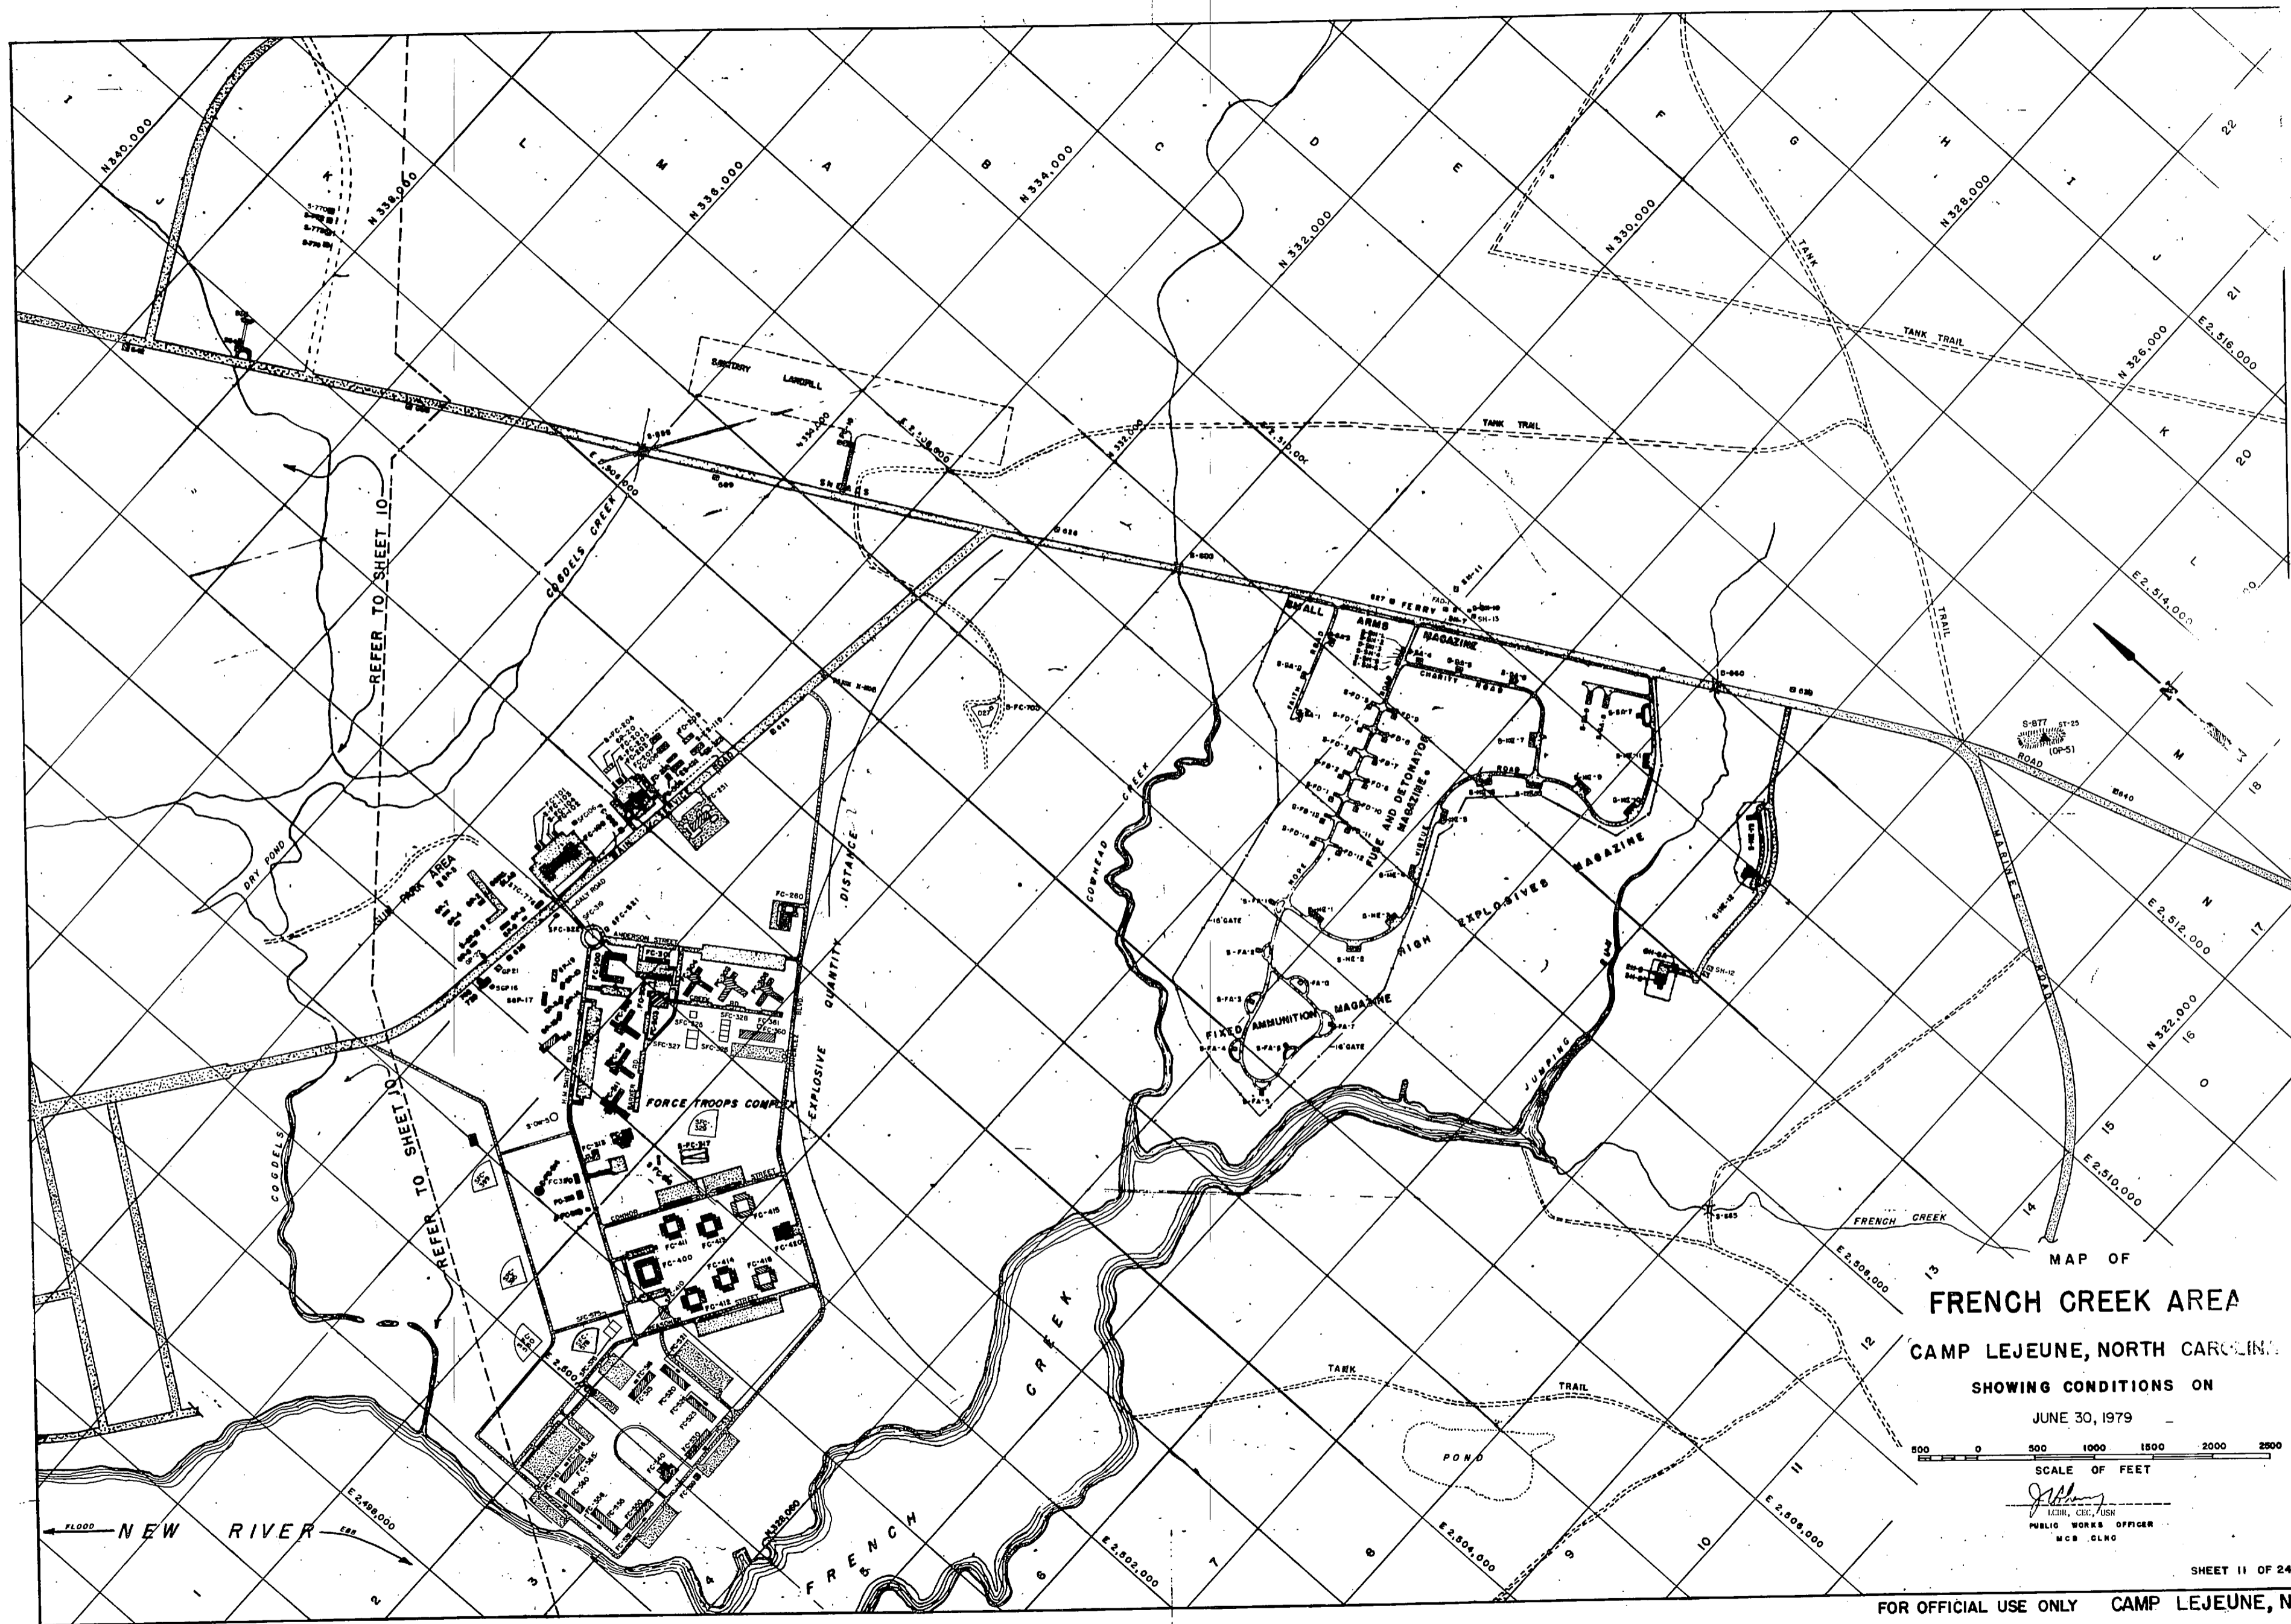











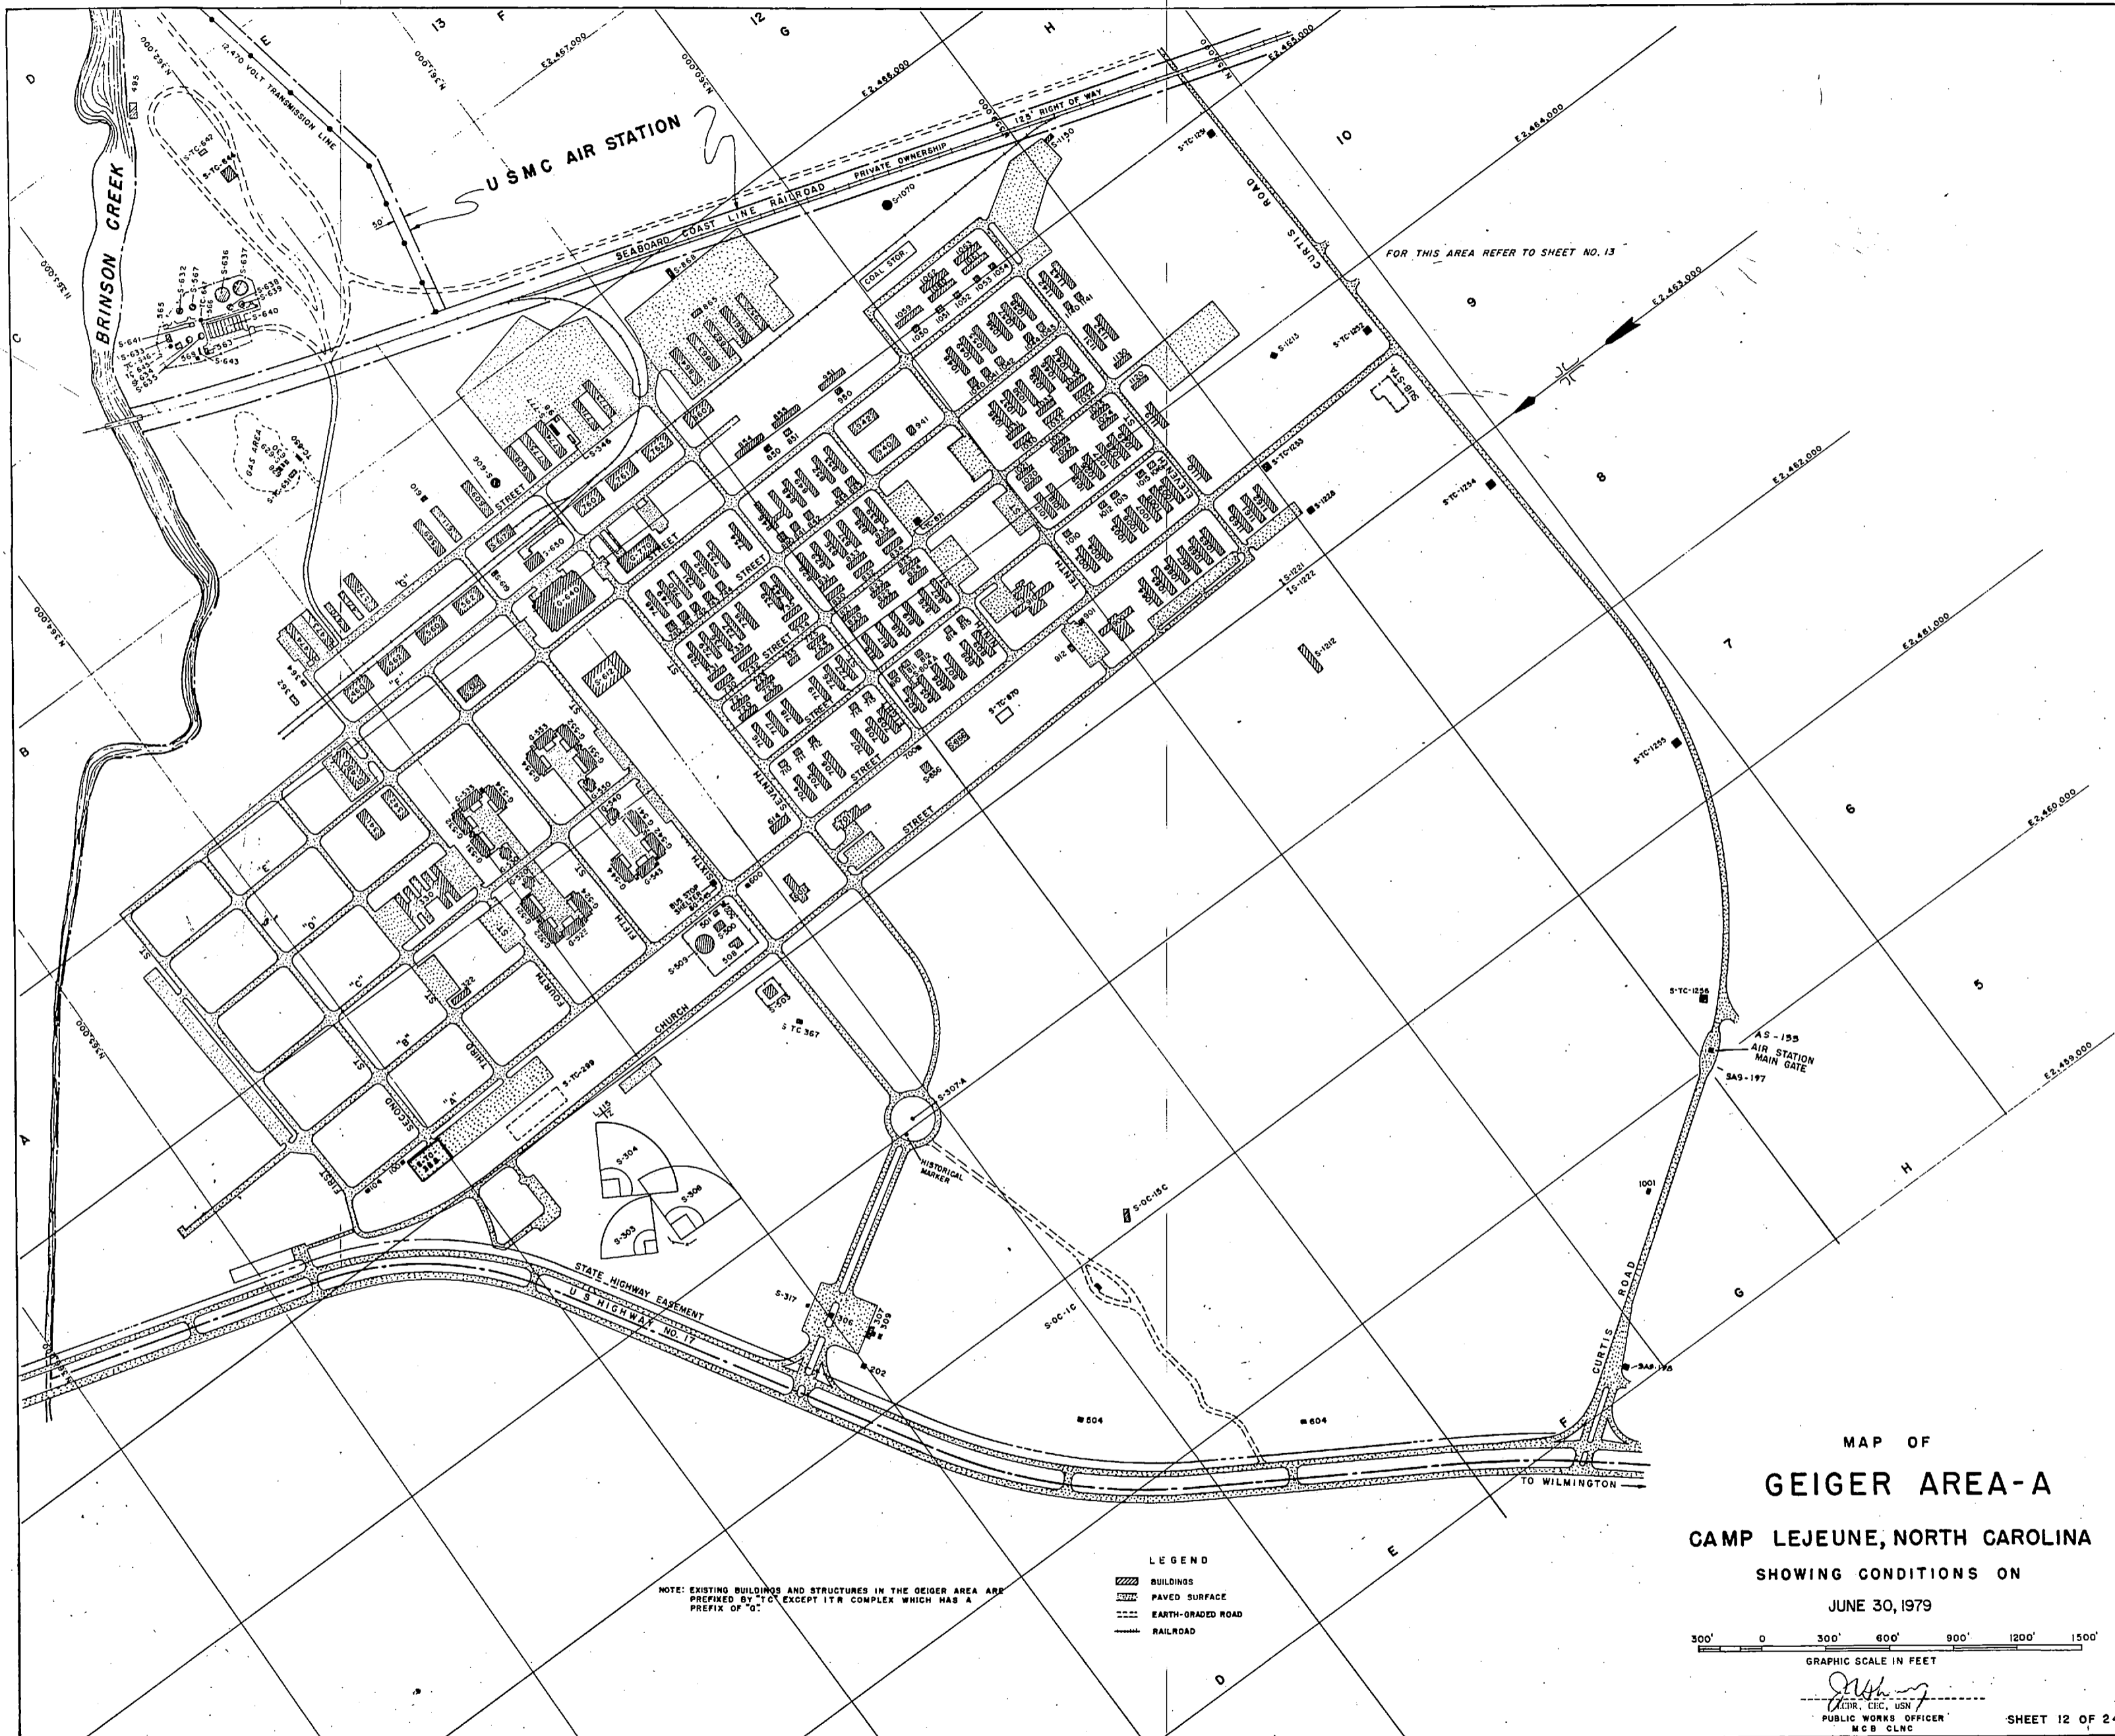

MAP OF  
**GEIGER AREA-A**  
 CAMP LEJEUNE, NORTH CAROLINA  
 SHOWING CONDITIONS ON  
 JUNE 30, 1979

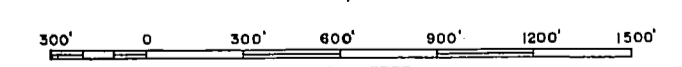


GRAPHIC SCALE IN FEET  
*[Signature]*  
 PUBLIC WORKS OFFICER  
 M.C. CLINE

SHEET 12 OF 24







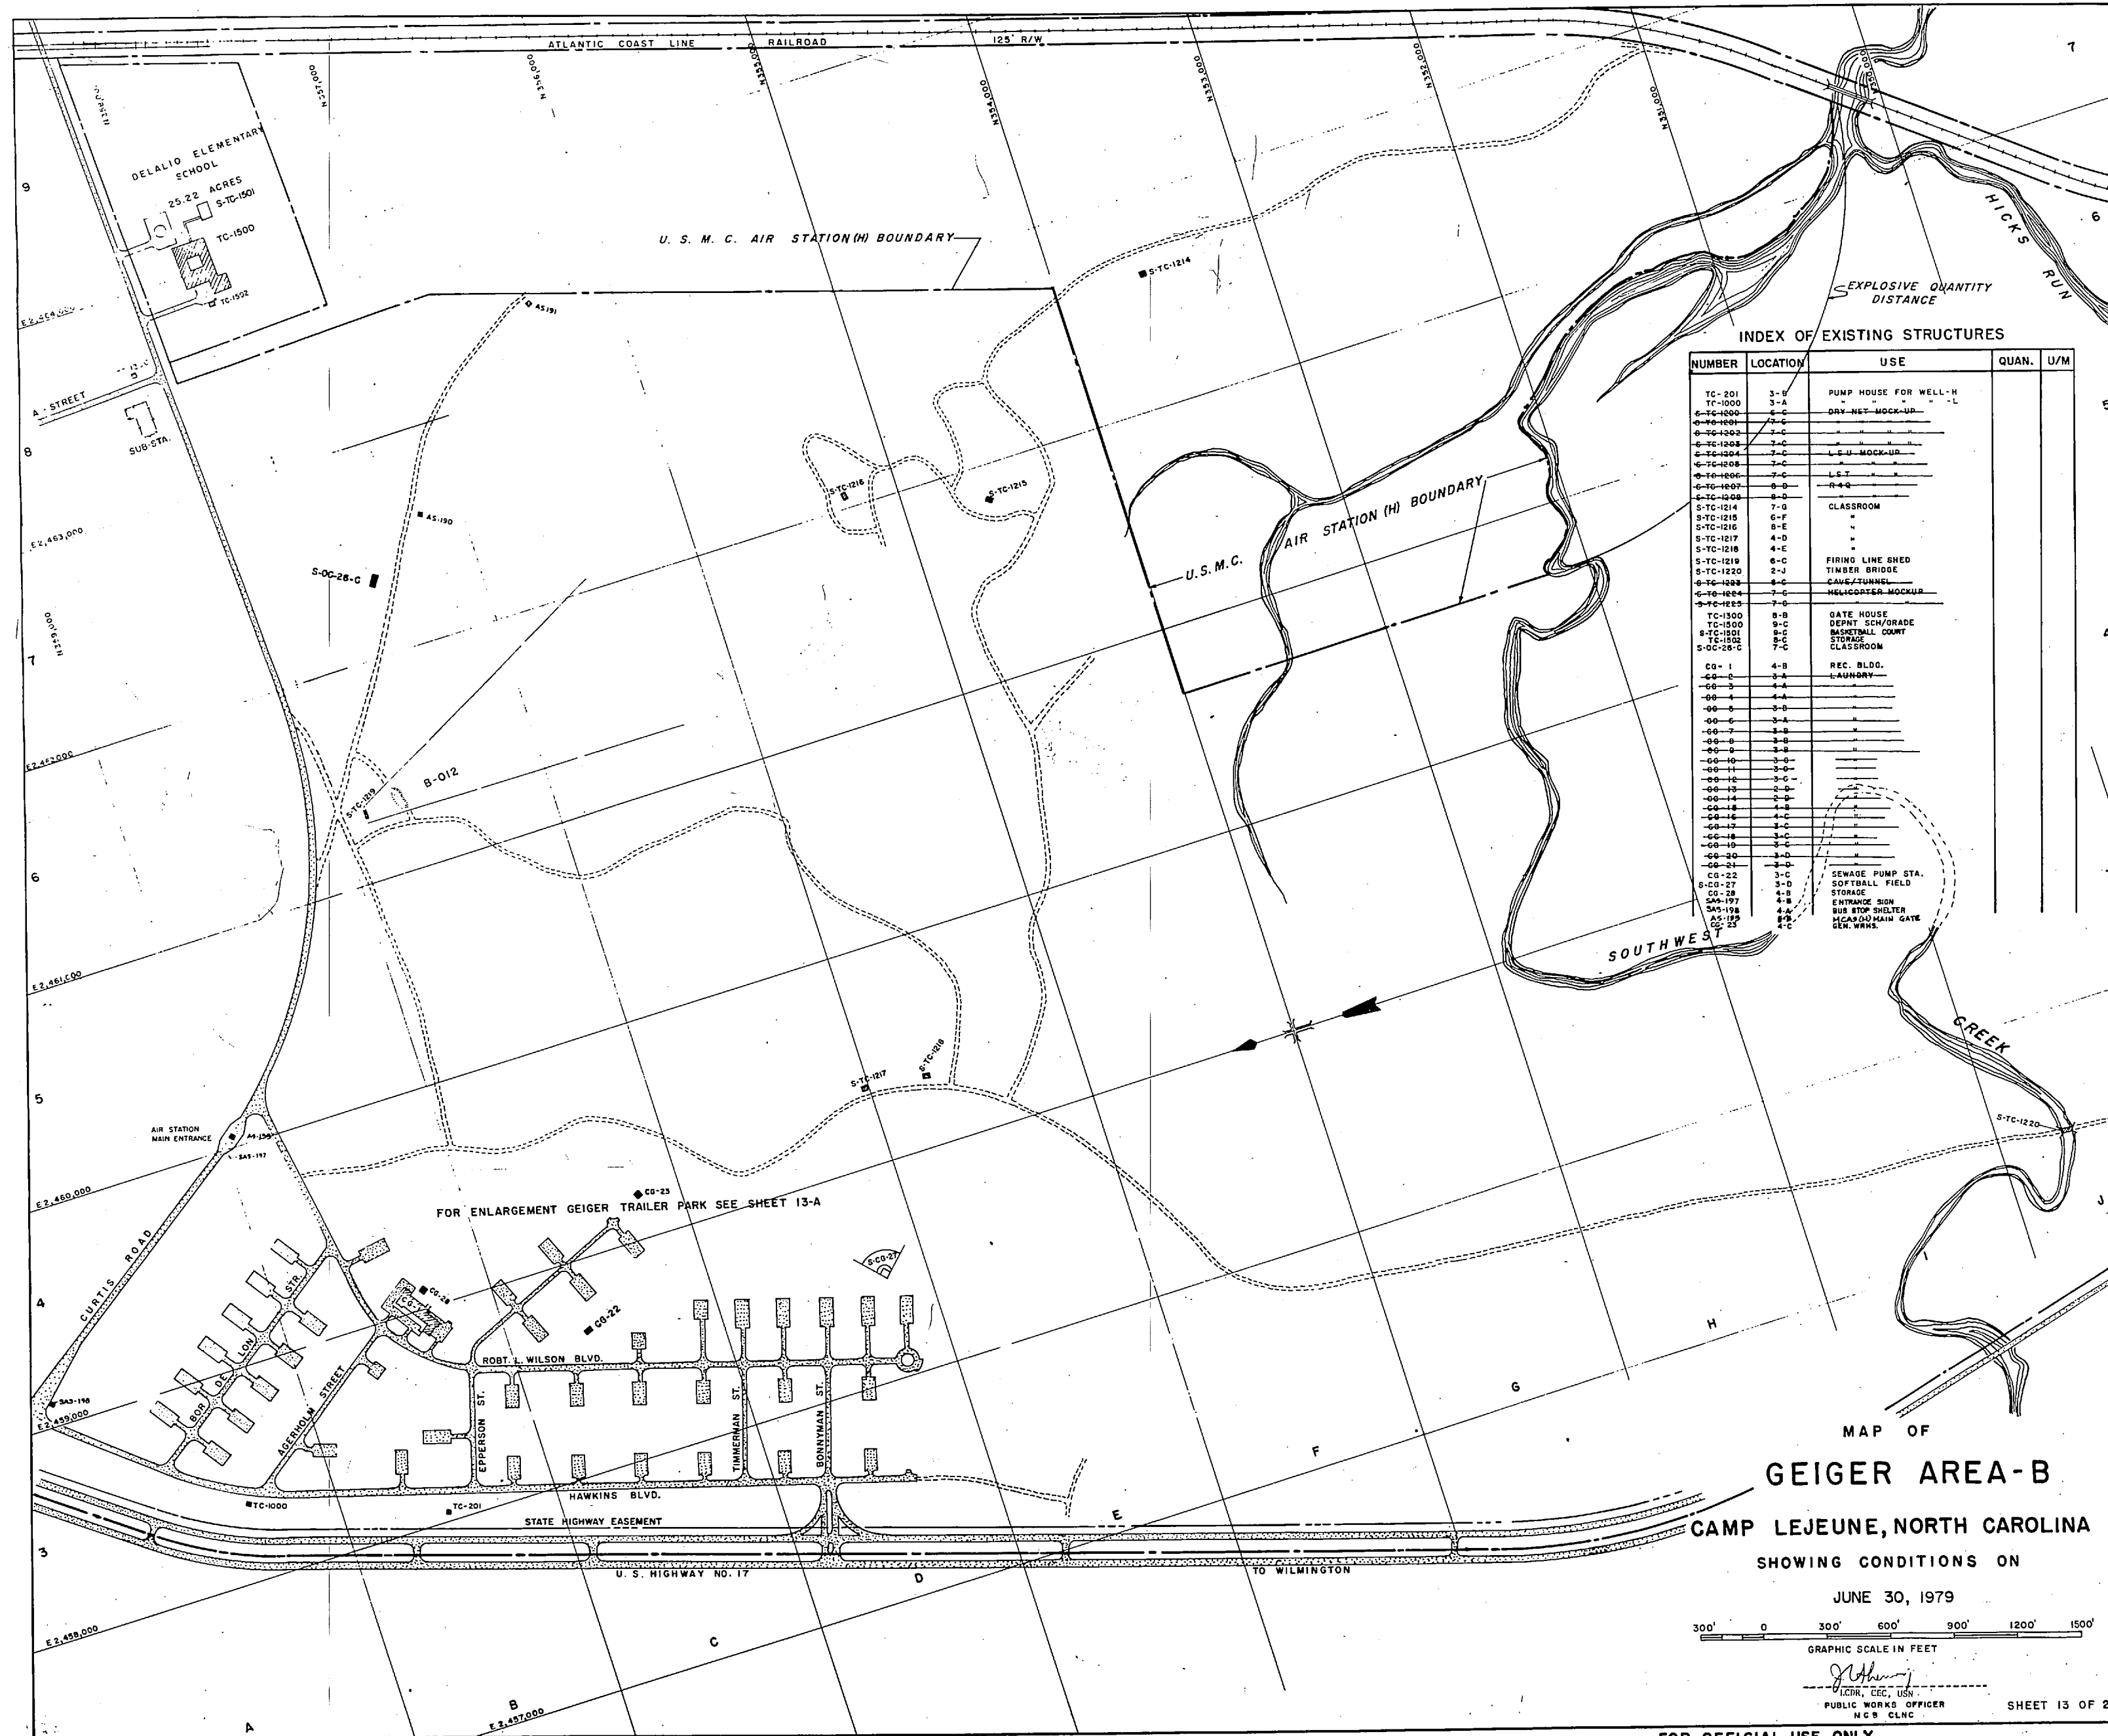

INDEX OF EXISTING STRUCTURES

NUMBER	LOCATION	USE	QUAN.	U/M
TC-201	3-H	PUMP HOUSE FOR WELL-H		
TC-1000	3-A	"		
TC-1214	7-9	CLASSROOM		
TC-1215	6-F	"		
TC-1216	8-E	"		
TC-1217	4-D	"		
TC-1218	4-E	"		
TC-1219	8-C	FIRING LINE SHED		
TC-1220	2-J	TIMBER BRIDGE		
TC-1300	8-B	GATE HOUSE		
TC-1500	9-C	DEPT. SCH/OBRD		
TC-1501	8-C	BASKETBALL COURT		
TC-1502	8-C	STORAGE		
S-OC-28-C	7-C	CLASSROOM		
CO-1	4-B	REC. BLDG.		
CO-2	8-B	LAUNDRY		
CO-3	4-A	"		
CO-4	4-A	"		
CO-5	3-B	"		
CO-6	3-A	"		
CO-7	3-B	"		
CO-8	3-B	"		
CO-9	3-B	"		
CO-10	3-D	"		
CO-11	3-D	"		
CO-12	3-D	"		
CO-13	3-D	"		
CO-14	2-D	"		
CO-15	2-D	"		
CO-16	4-C	"		
CO-17	3-C	"		
CO-18	3-C	"		
CO-19	3-C	"		
CO-20	3-D	"		
CO-21	3-D	"		
CO-22	3-C	SEWAGE PUMP STA.		
CO-23	3-D	SOFTBALL FIELD		
CO-24	4-B	STORAGE		
SA-177	4-B	ENTRANCE SIGN		
SA-178	4-A	BUS STOP SHELTER		
SA-179	4-B	MCAFARLAN GATE		
SA-180	4-C	GEN. WRRMS.		

MAP OF  
**GEIGER AREA-B**  
 CAMP LEJEUNE, NORTH CAROLINA  
 SHOWING CONDITIONS ON  
 JUNE 30, 1979

300' 0 300' 600' 900' 1200' 1500'  
 GRAPHIC SCALE IN FEET


*[Signature]*  
 PUBLIC WORKS OFFICER  
 N.C. CLNC

SHEET 13 OF 24


FOR OFFICIAL USE ONLY **CAMP LEJEUNE, N.C.**





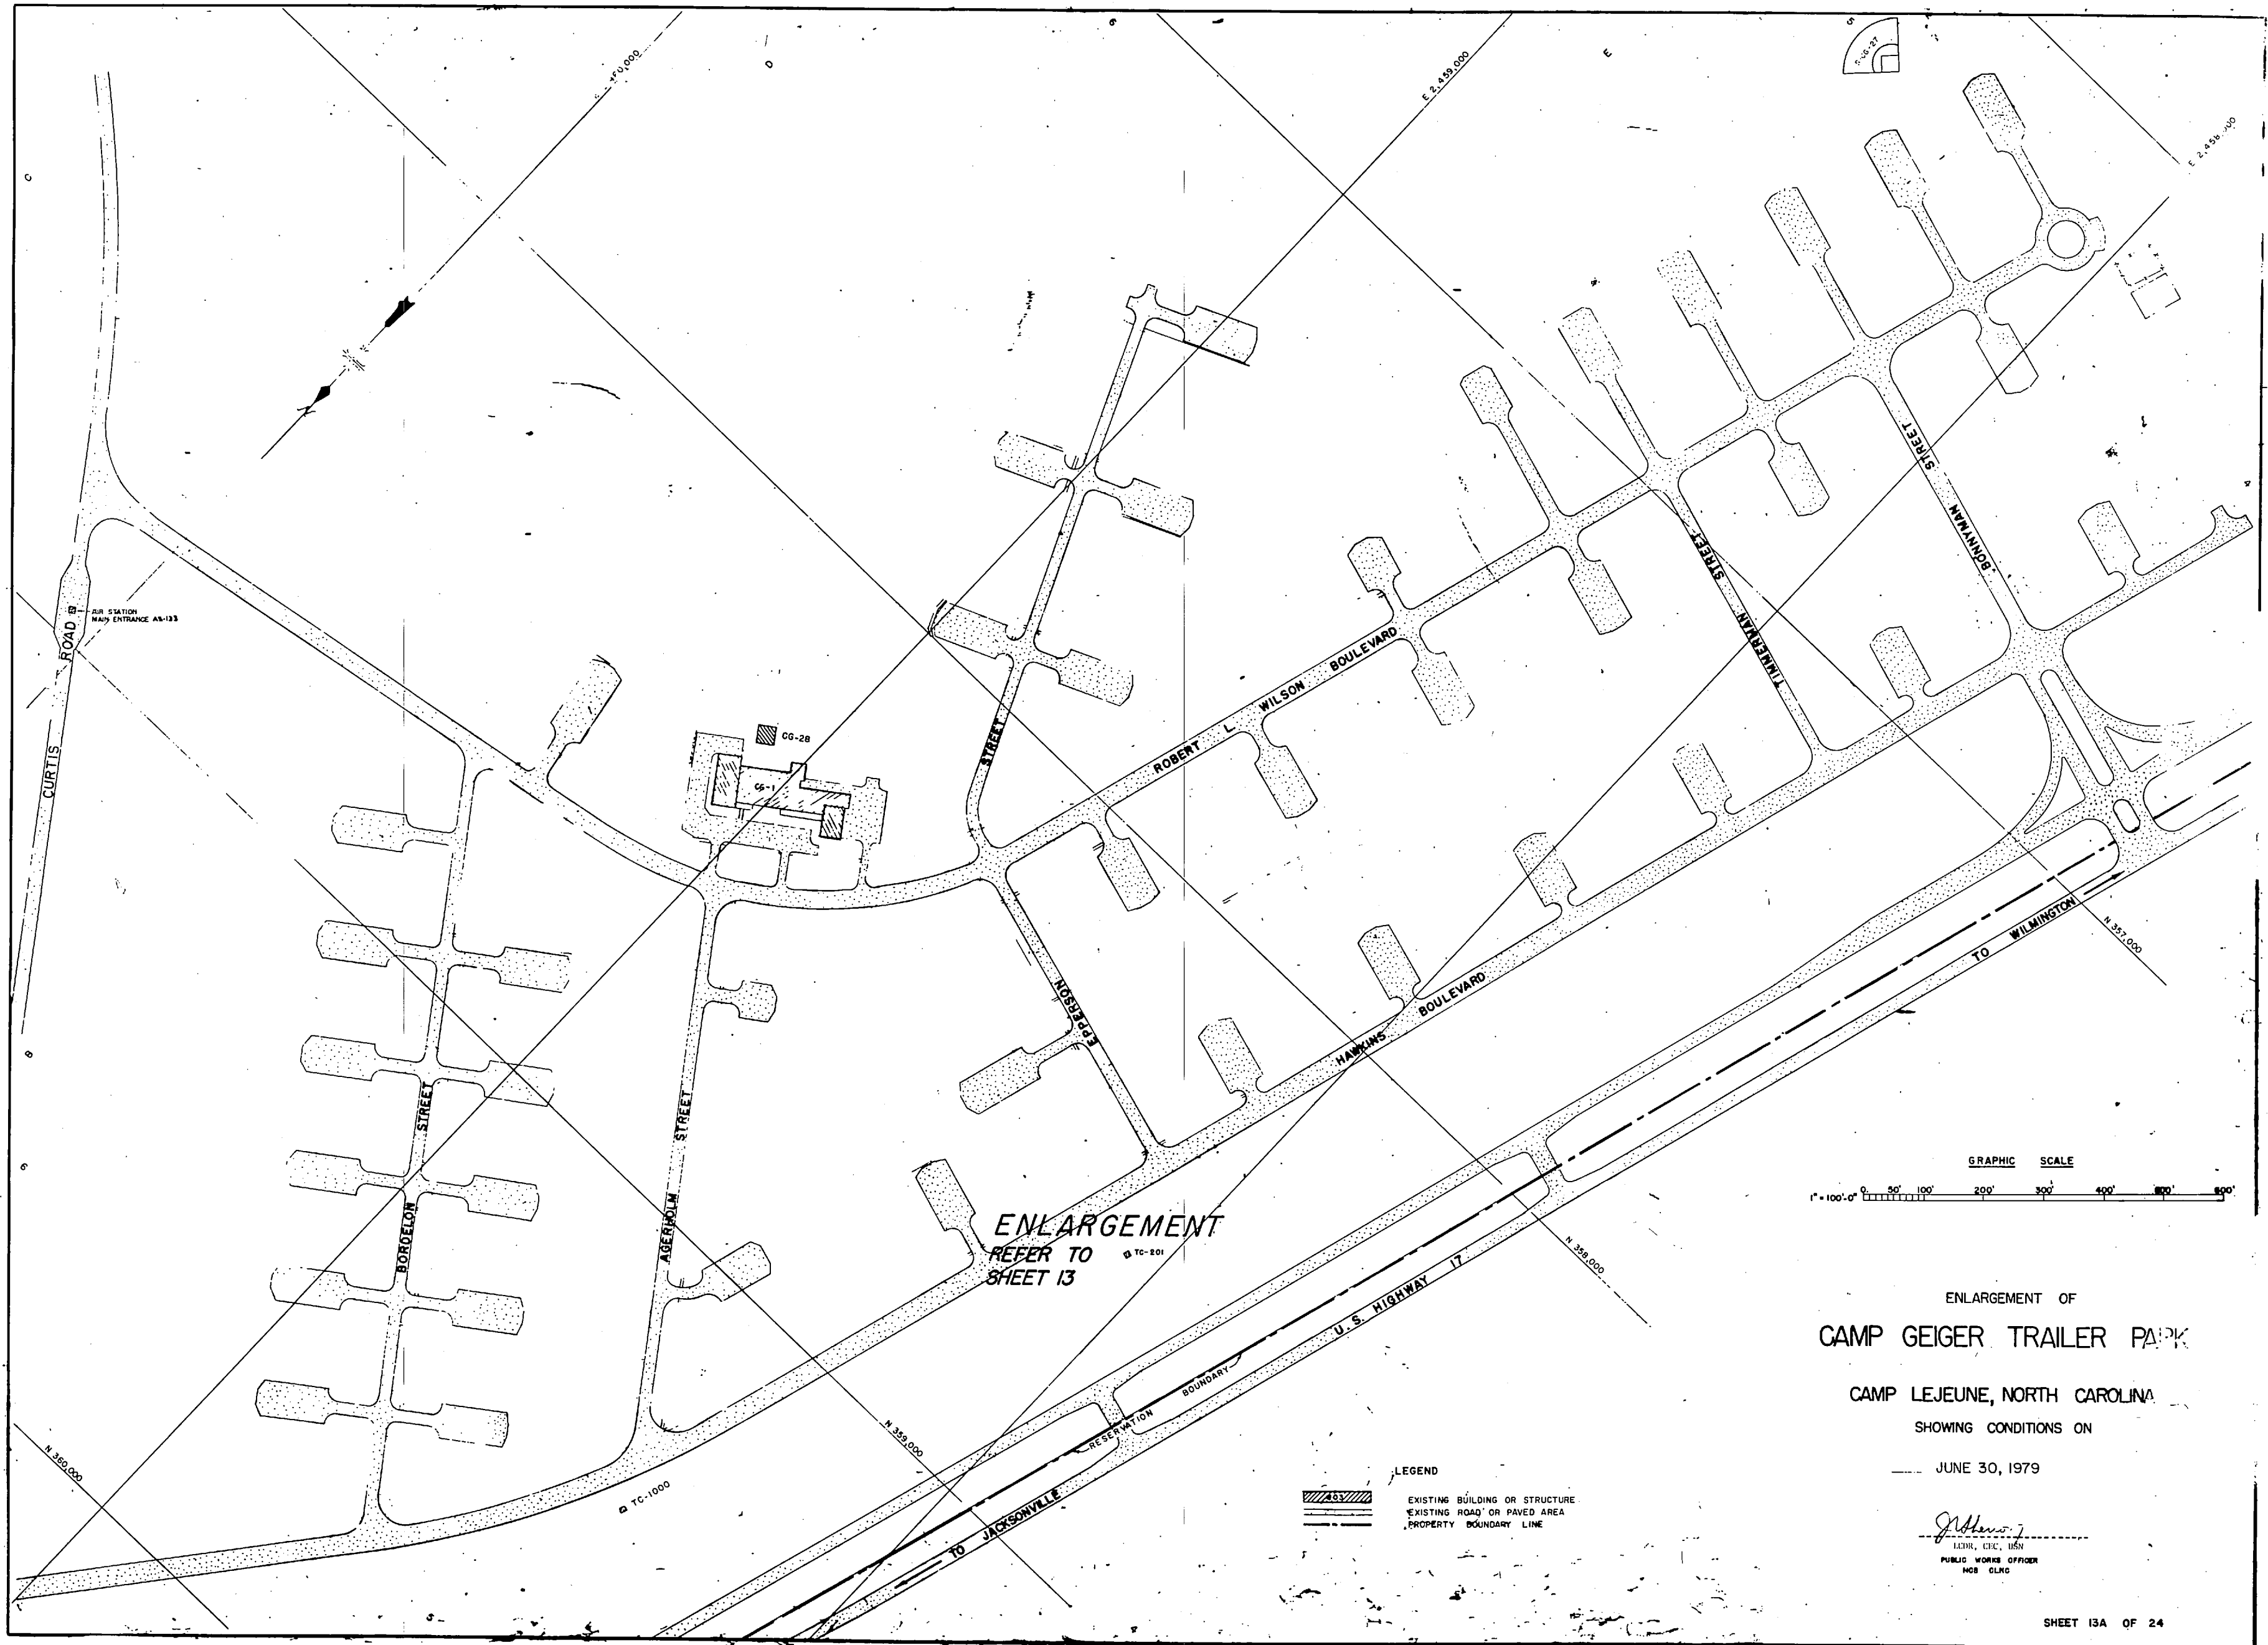

ENLARGEMENT  
REFER TO  
SHEET 13

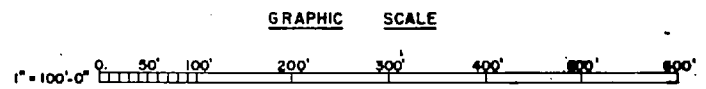

ENLARGEMENT OF  
CAMP GEIGER TRAILER PARK  
CAMP LEJEUNE, NORTH CAROLINA  
SHOWING CONDITIONS ON  
JUNE 30, 1979

LEGEND  
 [Symbol] EXISTING BUILDING OR STRUCTURE  
 [Symbol] EXISTING ROAD OR PAVED AREA  
 [Symbol] PROPERTY BOUNDARY LINE


*J. Allen*  
 LEON, C.E., I.S.W.  
 PUBLIC WORKS OFFICER  
 HCS - CLIC

SHEET 13A OF 24

-FOR OFFICIAL USE ONLY

CAMP LEJEUNE, N.C.




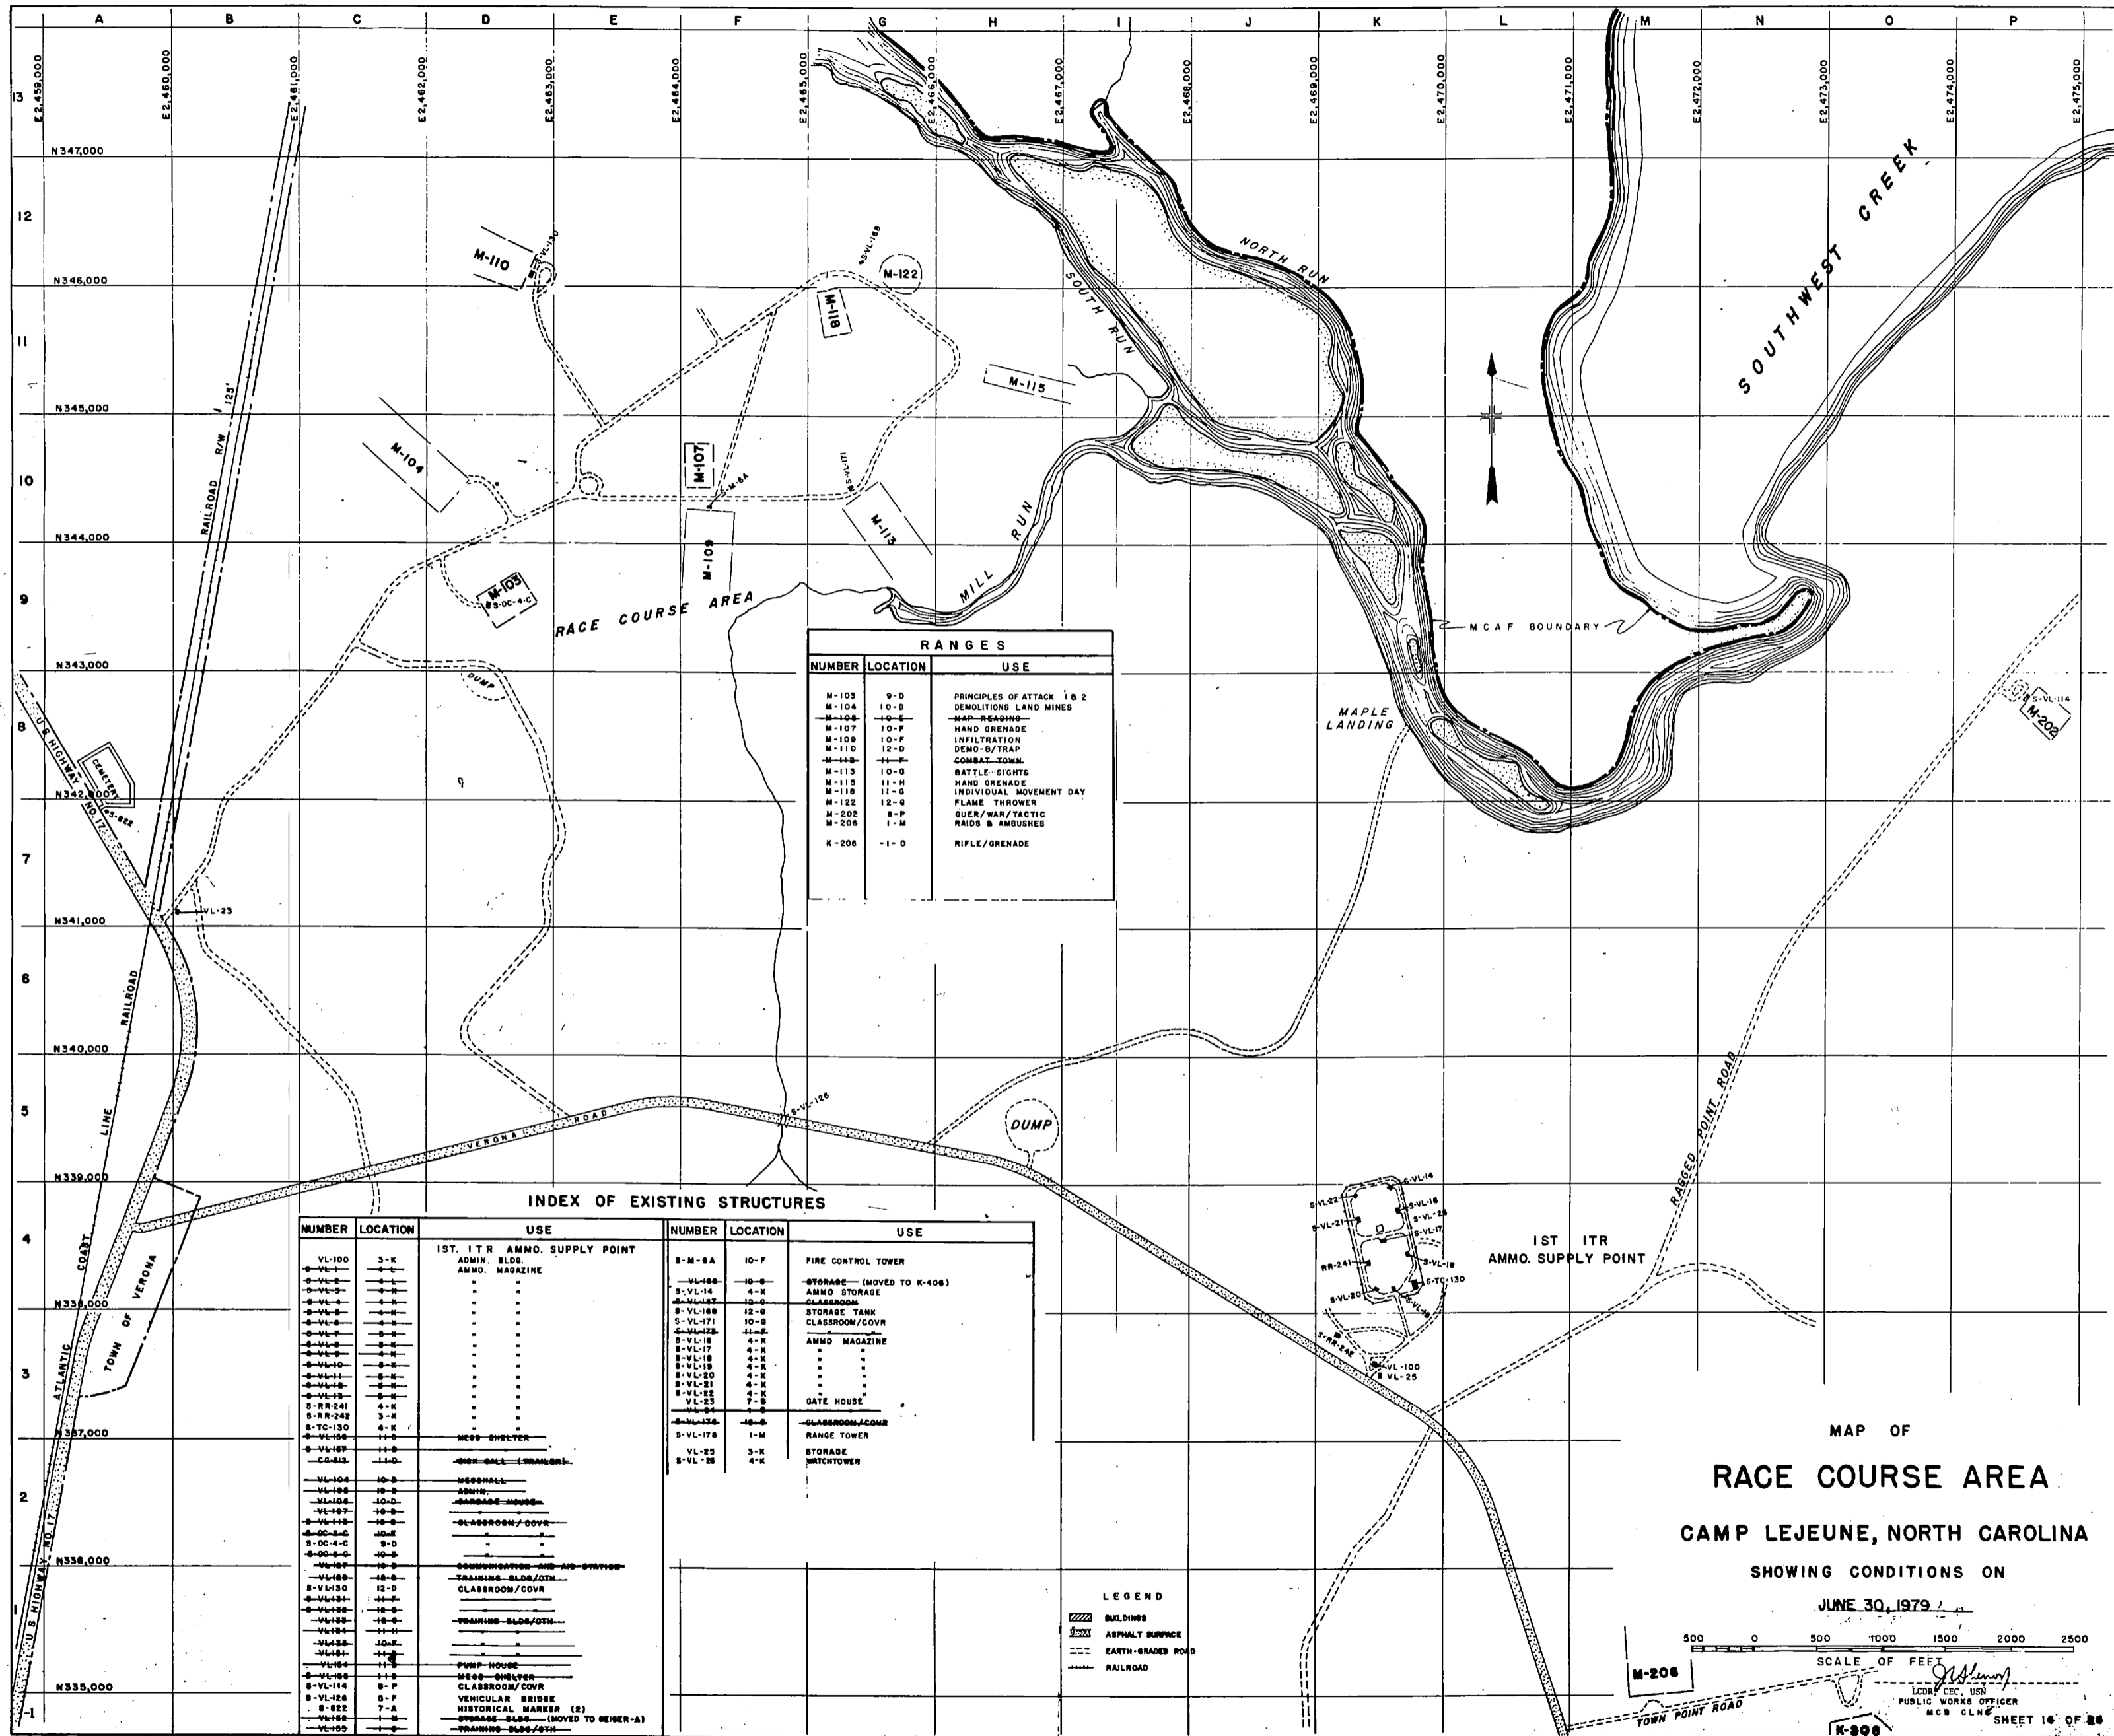

RANGES		
NUMBER	LOCATION	USE
M-103	9-D	PRINCIPLES OF ATTACK 1 & 2
M-104	10-D	DEMOLITIONS LAND MINES
M-202	8-P	OVER/WAR/TACTIC
M-206	1-M	RAIDS & AMBUSHES
K-206	1-O	RIFLE/GRENADE

INDEX OF EXISTING STRUCTURES		
NUMBER	LOCATION	USE
VL-100	3-K	1ST. ITR AMMO. SUPPLY POINT



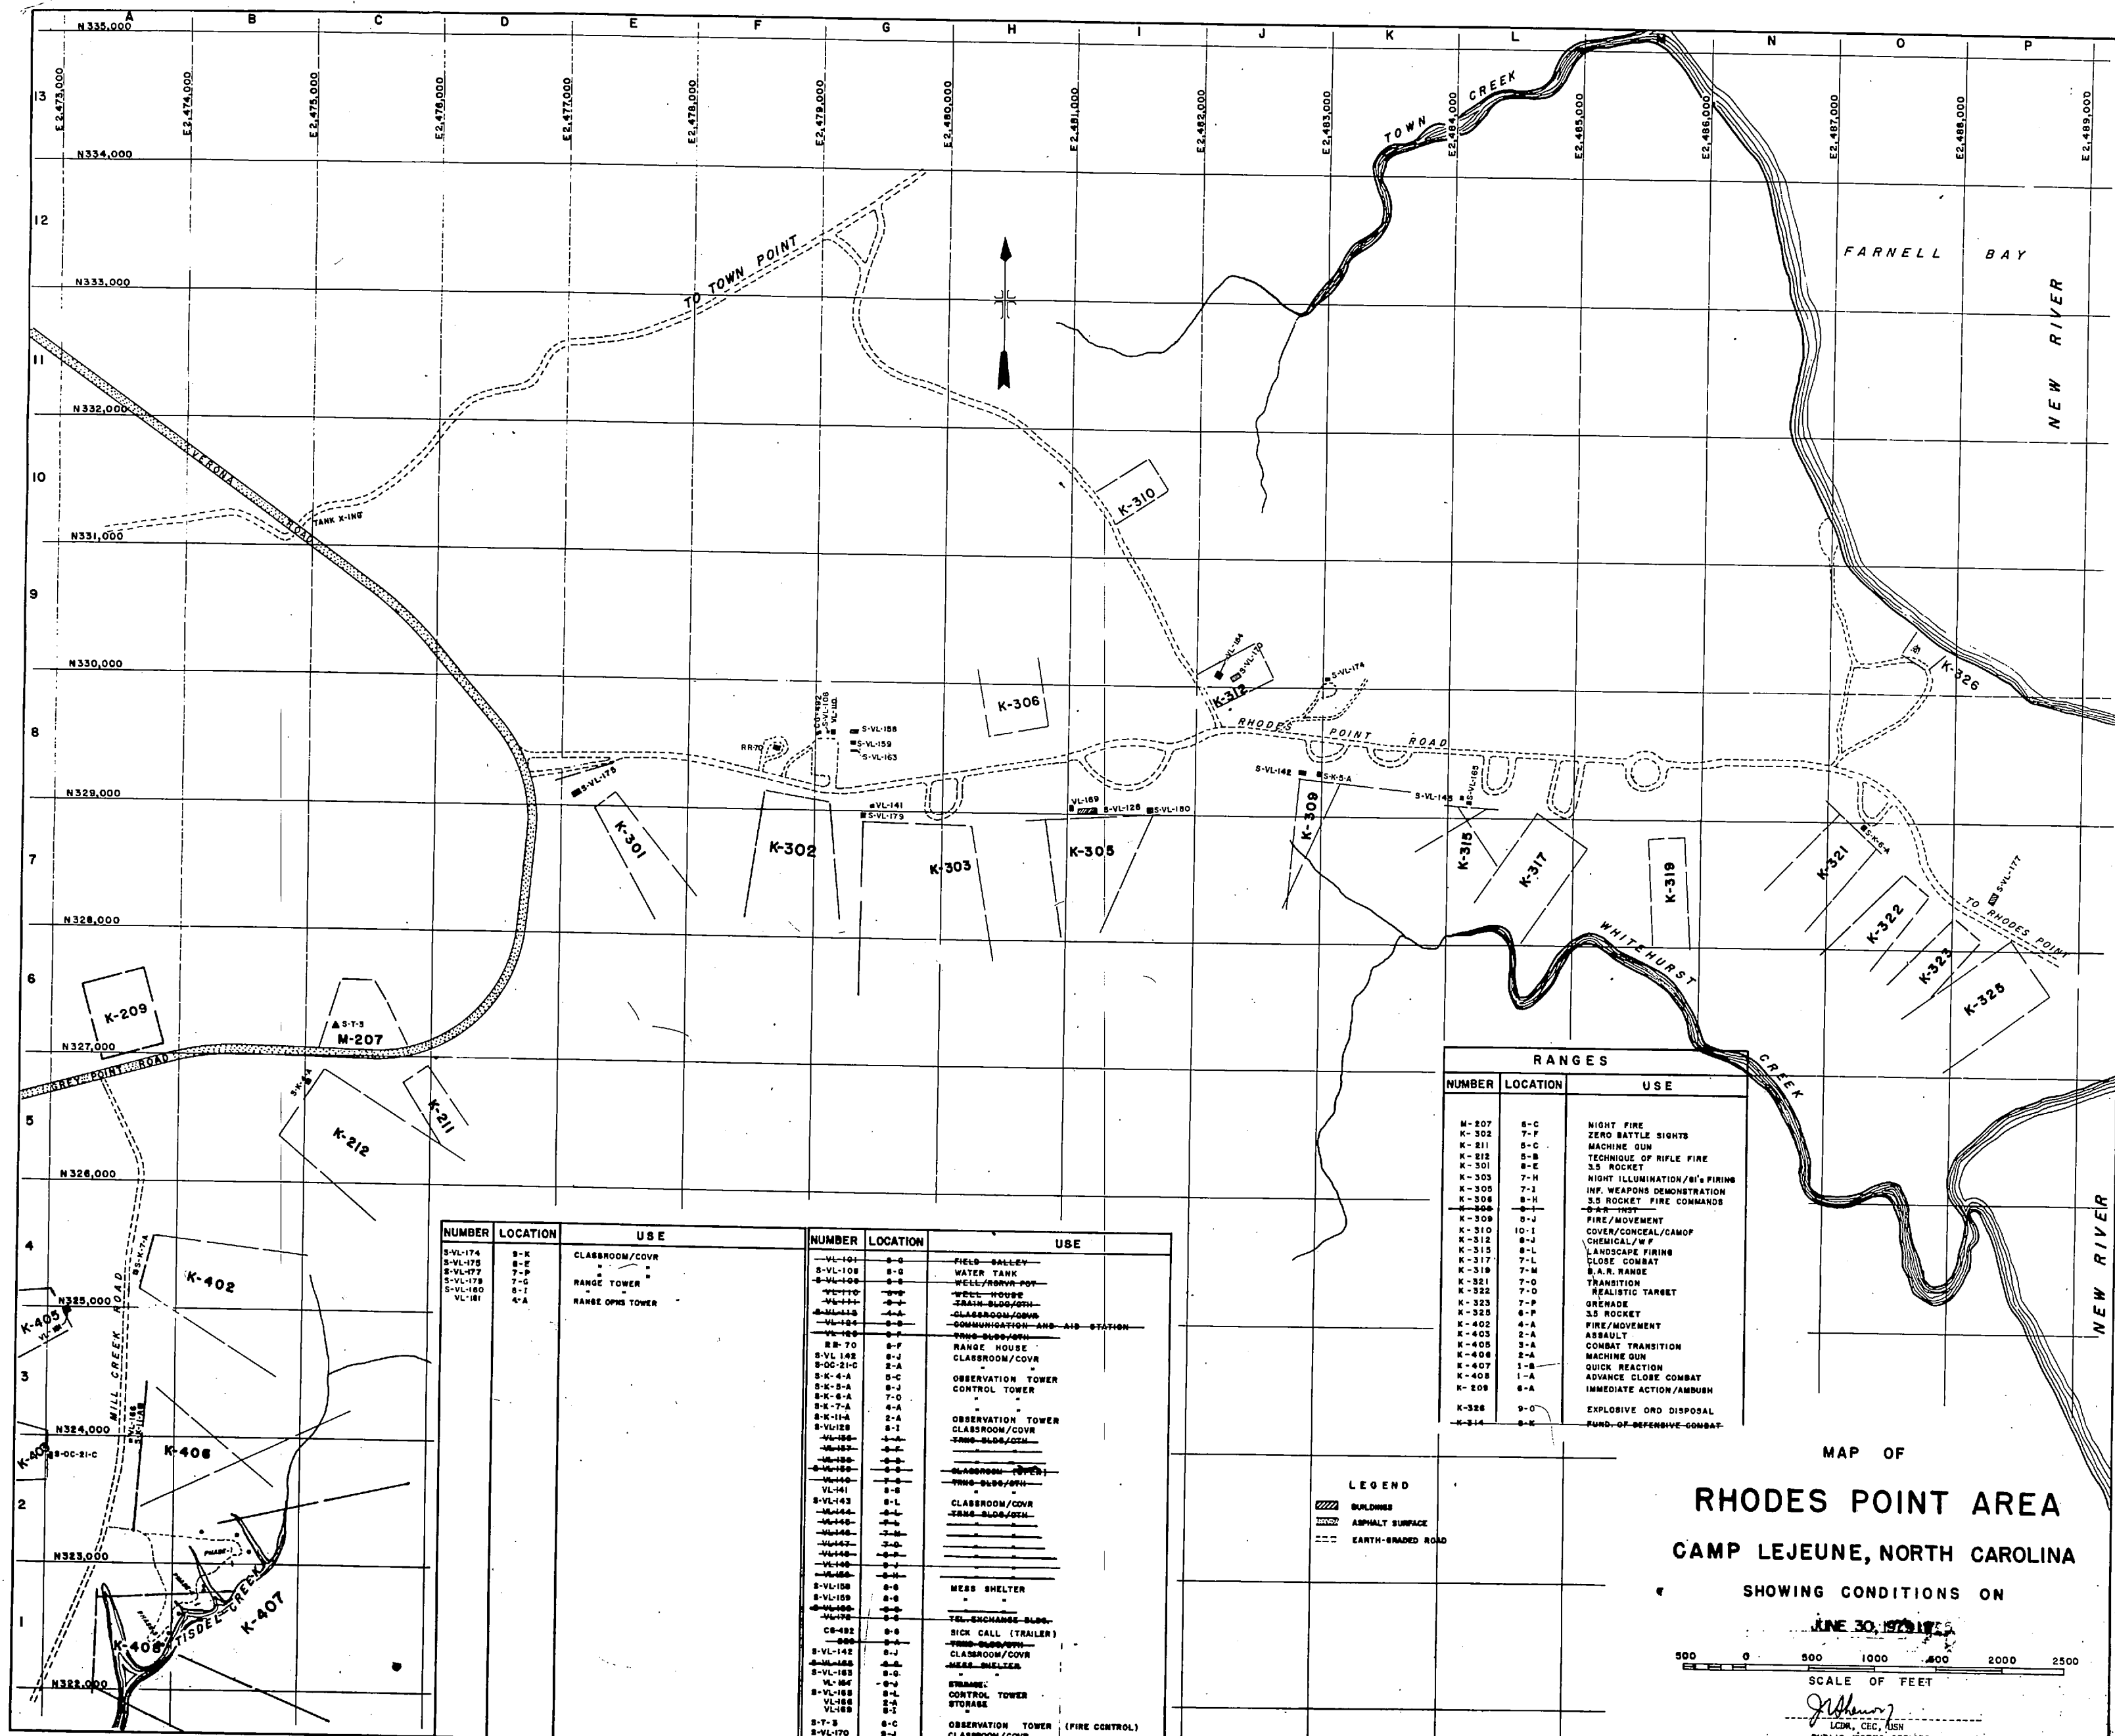

NUMBER	LOCATION	USE	NUMBER	LOCATION	USE
S-VL-174	S-K	CLASSROOM/COVER	S-VL-101	S-G	FIELD BATTERY
S-VL-175	S-F	"	S-VL-102	S-G	WATER TANK
S-VL-177	7-P	RANGE TOWER	S-VL-103	S-G	WELL/HOUSE-POY
S-VL-178	7-C	"	S-VL-104	S-G	WELL HOUSE
S-VL-180	6-T	RANGE OPS TOWER	S-VL-105	S-G	ZABAN-BLDG/OSM
S-VL-181	4-A	"	S-VL-106	S-G	CLASSROOM/COVER
RANGES		
NUMBER	LOCATION	USE
M-207	S-C	NIGHT FIRE

LEGEND  
 [Symbol] BUILDINGS  
 [Symbol] ASPHALT SURFACE  
 [Symbol] EARTH-GRADED ROAD

MAP OF  
**RHODES POINT AREA**  
**CAMP LEJEUNE, NORTH CAROLINA**  
 SHOWING CONDITIONS ON  
**JUNE 30, 1970**  
 SCALE OF FEET  
 500 0 500 1000 1500 2000 2500

 SHEET 16 OF 24  
 FOR OFFICIAL USE ONLY  
 CAMP LEJEUNE, N.C.



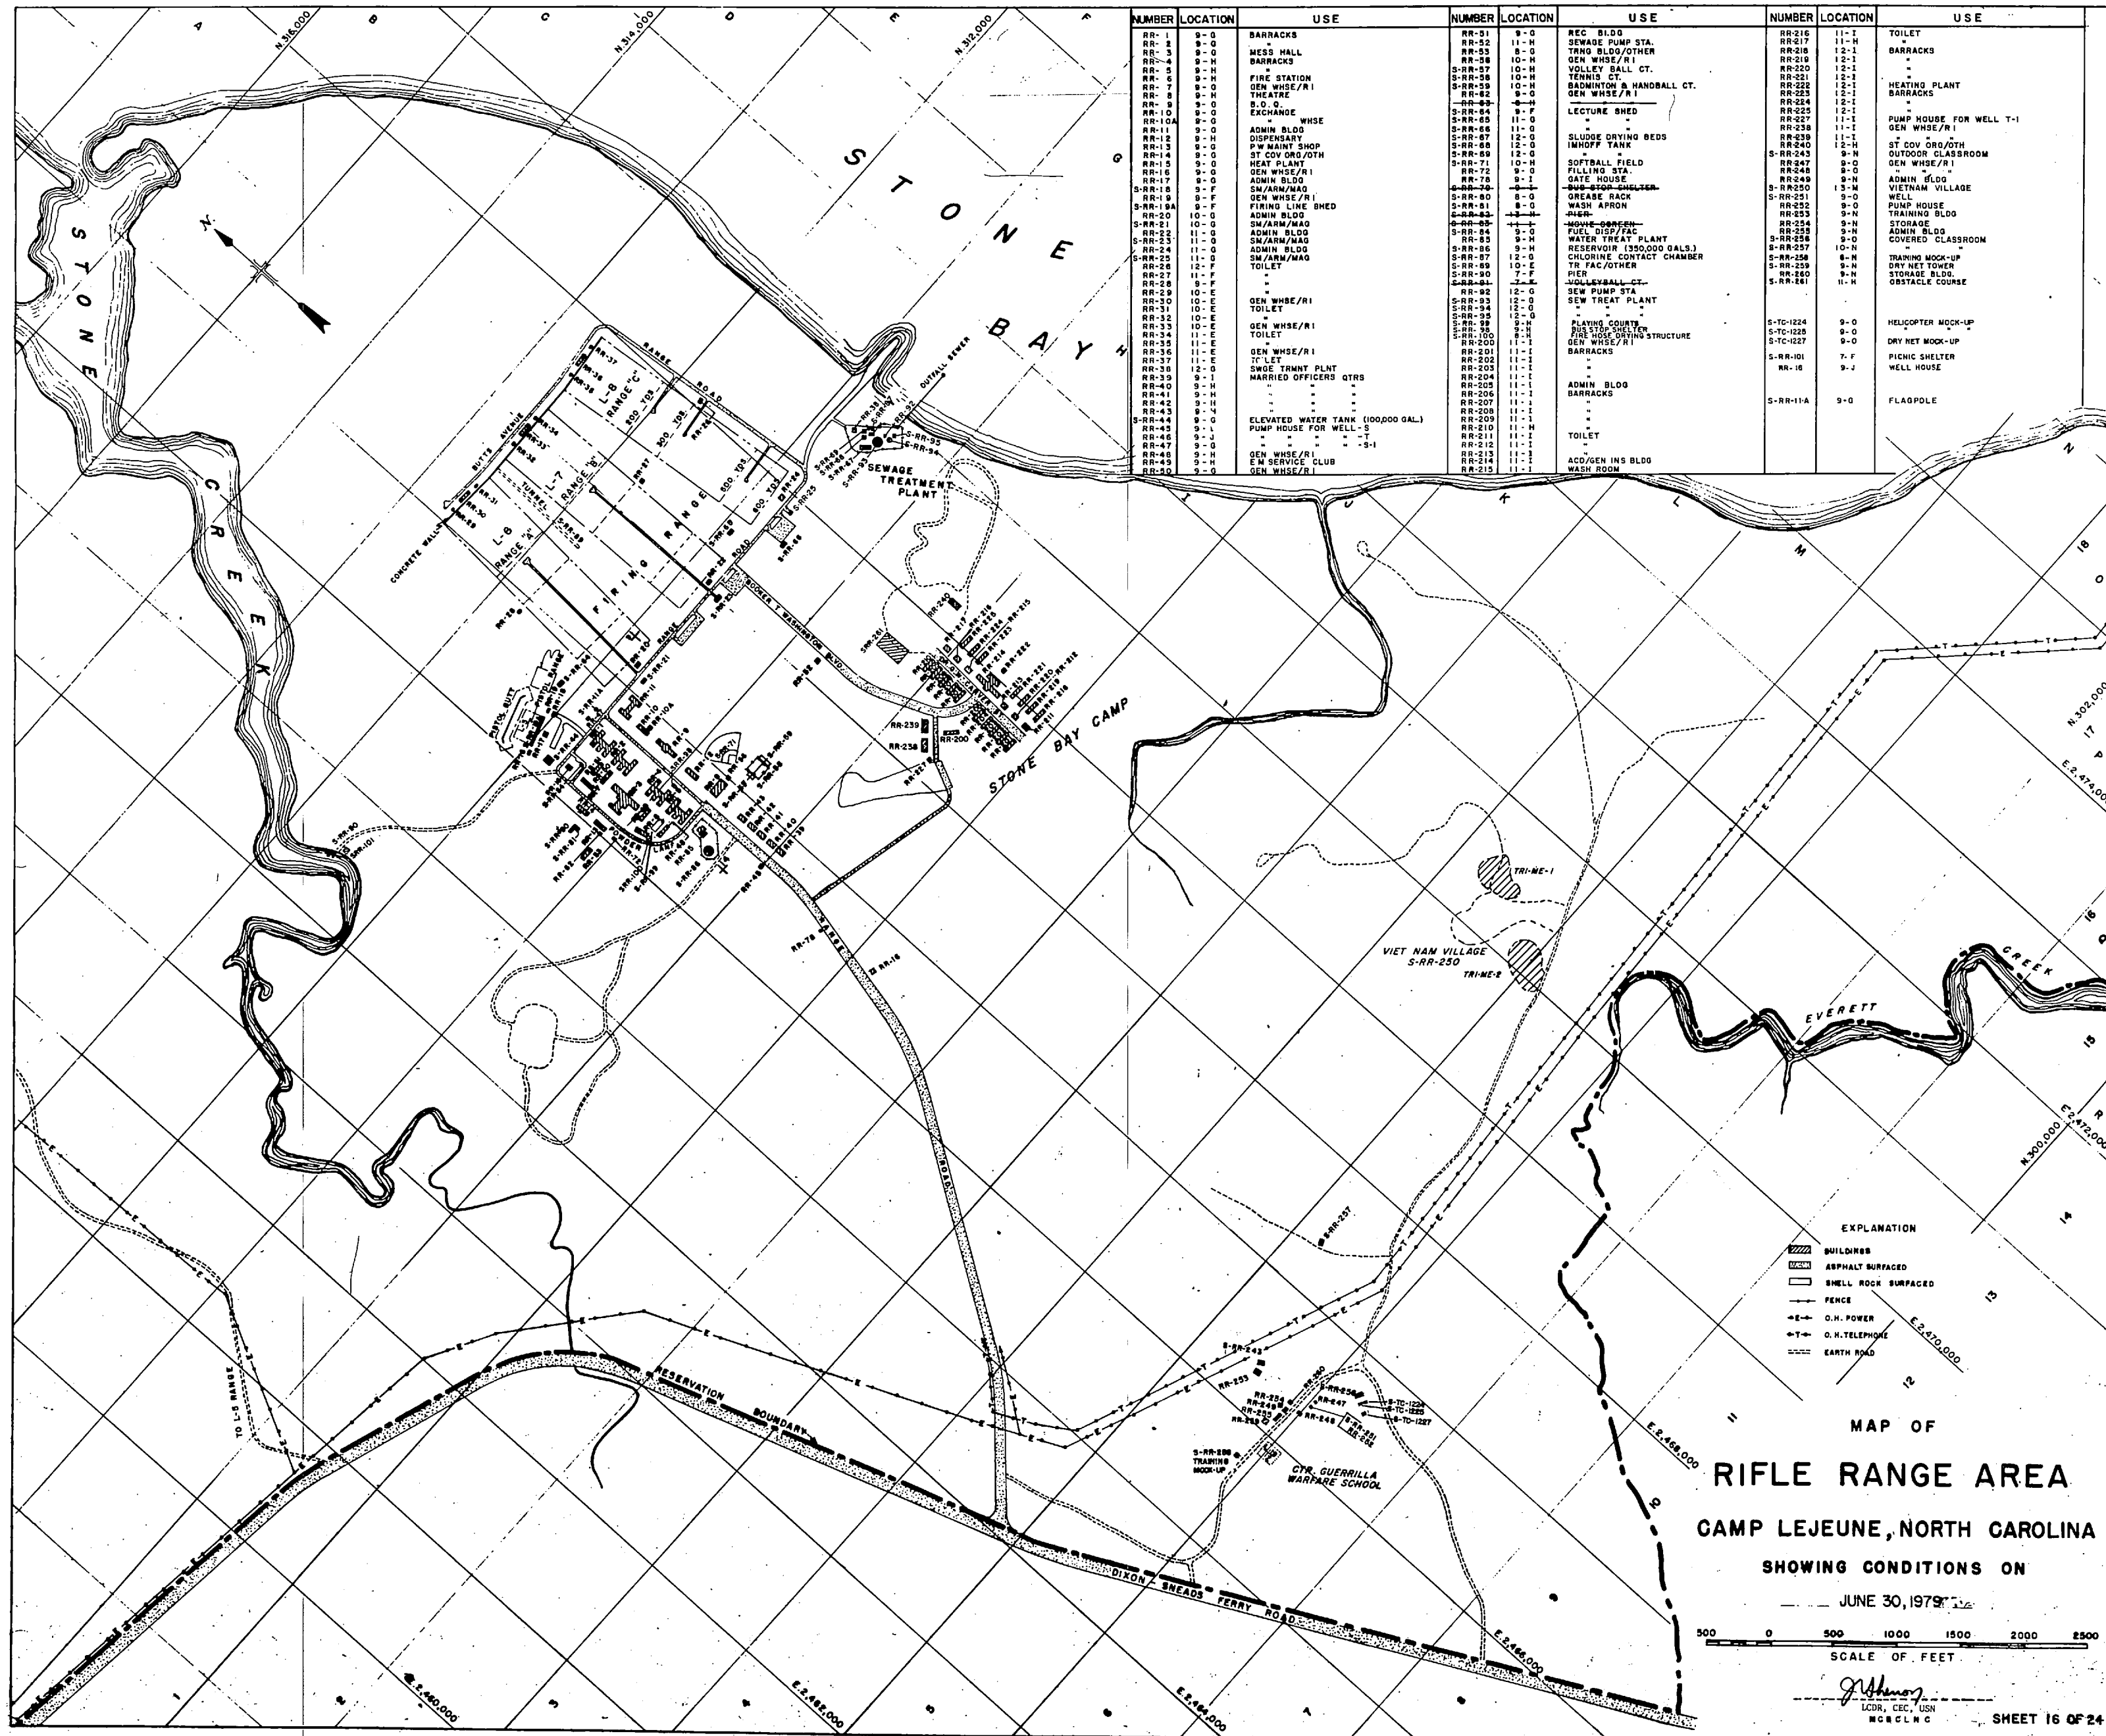


NUMBER	LOCATION	USE	NUMBER	LOCATION	USE	NUMBER	LOCATION	USE
RR-1	9-0	BARRACKS	RR-01	9-0	REC BLDG	RR-216	11-1	TOILET
RR-2	9-0	BARRACKS	RR-02	11-H	SEWAGE PUMP STA.	RR-217	11-H	BARRACKS
RR-3	9-0	MESS HALL	RR-03	9-0	TRNG BLDG/OTHER	RR-218	12-1	BARRACKS
RR-4	9-0	BARRACKS	RR-04	10-H	GEN WHS/R/I	RR-219	12-1	BARRACKS
RR-5	9-H	FIRE STATION	S-RR-05	10-H	VOLLEY BALL CT.	RR-220	12-1	BARRACKS
RR-6	9-H	GEN WHS/R/I	S-RR-06	10-H	YENNIS CT.	RR-221	12-1	BARRACKS
RR-7	9-0	THEATRE	S-RR-07	10-H	BADMINTON & HANDBALL CT.	RR-222	12-1	HEATING PLANT
RR-8	9-0	B.O.O.	S-RR-08	9-0	GEN WHS/R/I	RR-223	12-1	BARRACKS
RR-9	9-0	EXCHANGE	RR-09	9-0	LECTURE SHED	RR-224	12-1	BARRACKS
RR-10	9-0	ADMIN BLDG	S-RR-10	11-0	WASH. APRON	RR-225	11-1	PUMP HOUSE FOR WELL T-1
RR-11	9-0	DISPENSARY	S-RR-11	12-0	SLUDGE DRYING BEDS	RR-226	11-1	GEN WHS/R/I
RR-12	9-0	ST. COV ORG/OTH	S-RR-12	12-0	IMPROV TANK	RR-227	11-1	ST. COV ORG/OTH
RR-13	9-0	HEAT PLANT	S-RR-13	12-0	SOFTBALL FIELD	RR-228	9-0	OUTDOOR CLASSROOM
RR-14	9-0	GEN WHS/R/I	S-RR-14	10-H	FILLING STA.	RR-229	9-0	GEN WHS/R/I
RR-15	9-0	SW/ARM/MAG	RR-15	9-0	GEN WHS/R/I	RR-230	9-0	ADMIN BLDG
RR-16	9-0	GEN WHS/R/I	S-RR-16	9-0	GEN WHS/R/I	RR-231	13-H	VIETNAM VILLAGE
RR-17	9-0	GEN WHS/R/I	S-RR-17	9-0	GREASE RACK	S-RR-232	9-0	WELL
RR-18	9-0	GEN WHS/R/I	S-RR-18	9-0	WASH. APRON	RR-233	9-0	TRAINING BLDG
RR-19	9-0	GEN WHS/R/I	S-RR-19	9-0	WATER TREAT PLANT	RR-234	9-0	ADMIN BLDG
RR-20	10-0	ADMIN BLDG	S-RR-20	9-0	RESERVOIR (150,000 GAL.)	RR-235	9-0	COVERED CLASSROOM
RR-21	10-0	SW/ARM/MAG	S-RR-21	12-0	CHLORINE CONTACT CHAMBER	RR-236	9-0	TRAINING MOOK-UP
RR-22	11-0	ADMIN BLDG	S-RR-22	10-E	TR. FAC/OTHER	S-RR-237	9-0	DRY NET TOWER
RR-23	11-0	ADMIN BLDG	S-RR-23	7-F	PIER	RR-238	9-0	STORAGE BLDG
RR-24	11-0	ADMIN BLDG	S-RR-24	11-1	JOLLYBALL CT.	S-RR-239	11-H	OBSTACLE COURSE
RR-25	12-F	TOILET	S-RR-25	12-0	SEW PUMP STA.			
RR-26	11-F	TOILET	S-RR-26	12-0	SEW TREAT PLANT			










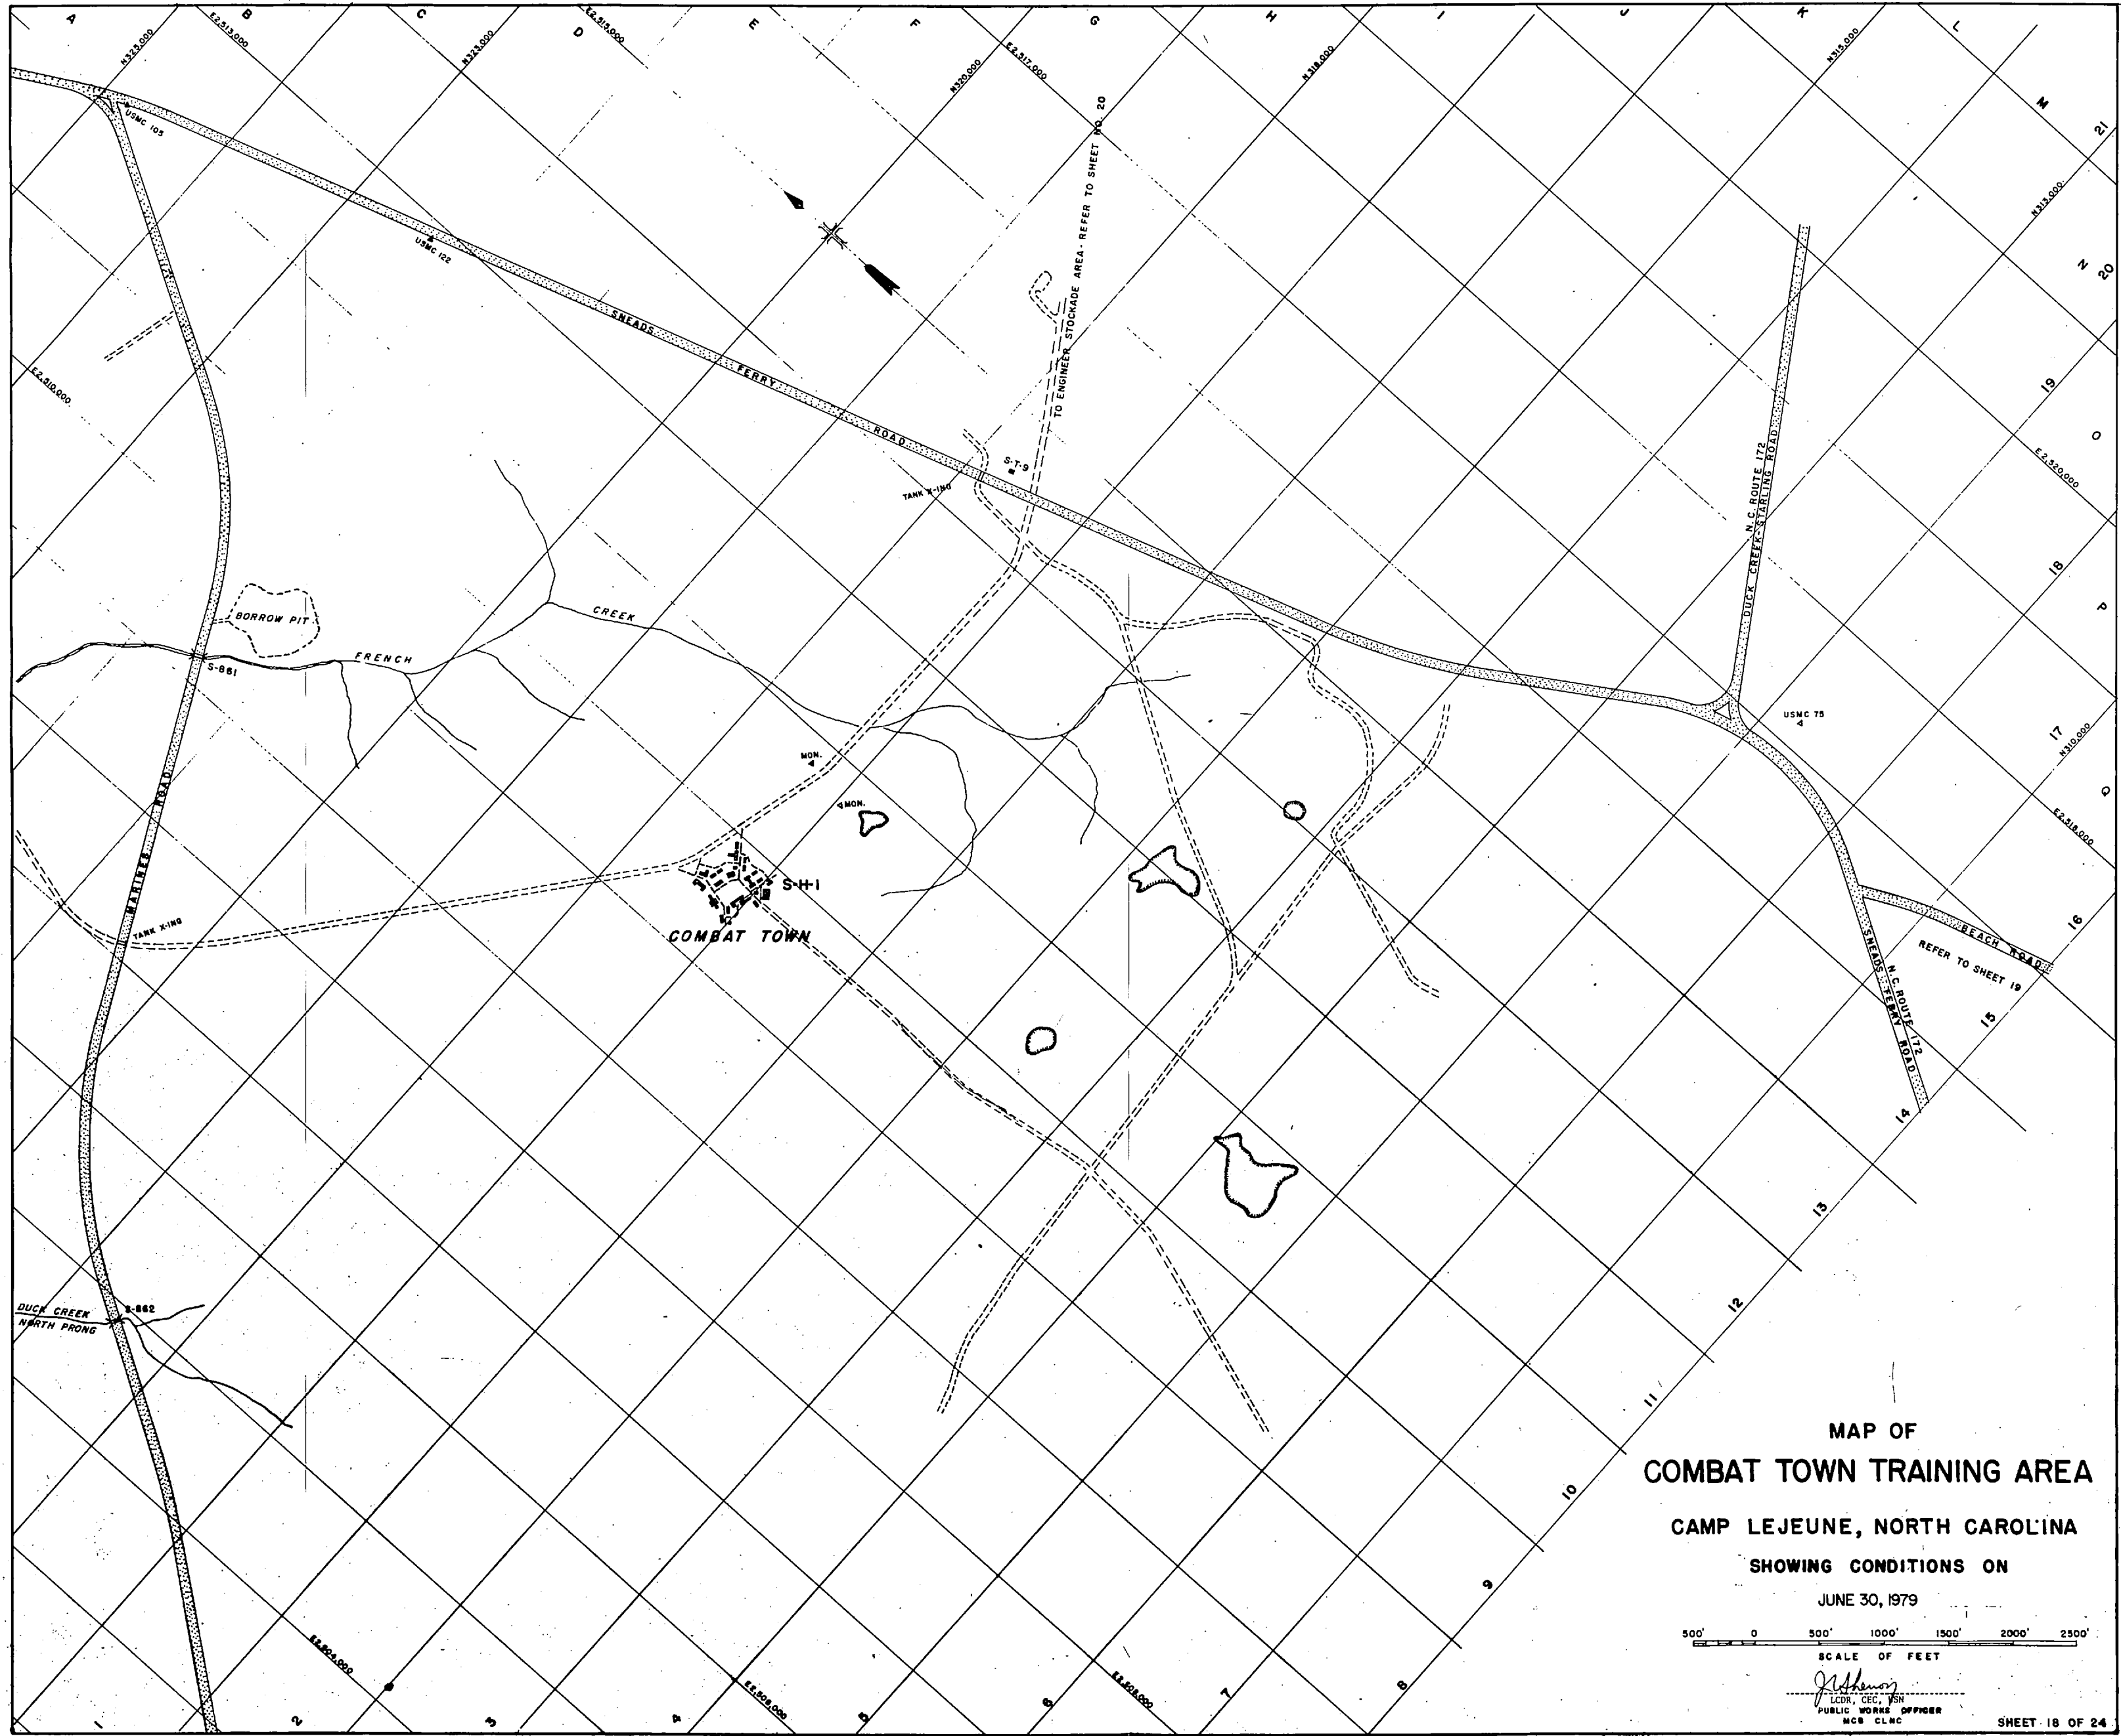

MAP OF  
**COMBAT TOWN TRAINING AREA**  
 CAMP LEJEUNE, NORTH CAROLINA  
 SHOWING CONDITIONS ON  
 JUNE 30, 1979

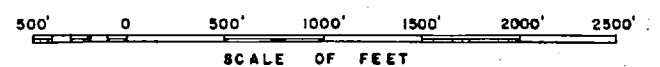

SCALE OF FEET  
 LORR. CEC. 758  
 PUBLIC WORKS OFFICER  
 MCB CLMC

SHEET 18 OF 24

FOR OFFICIAL USE ONLY **CAMP LEJEUNE, N.C.**














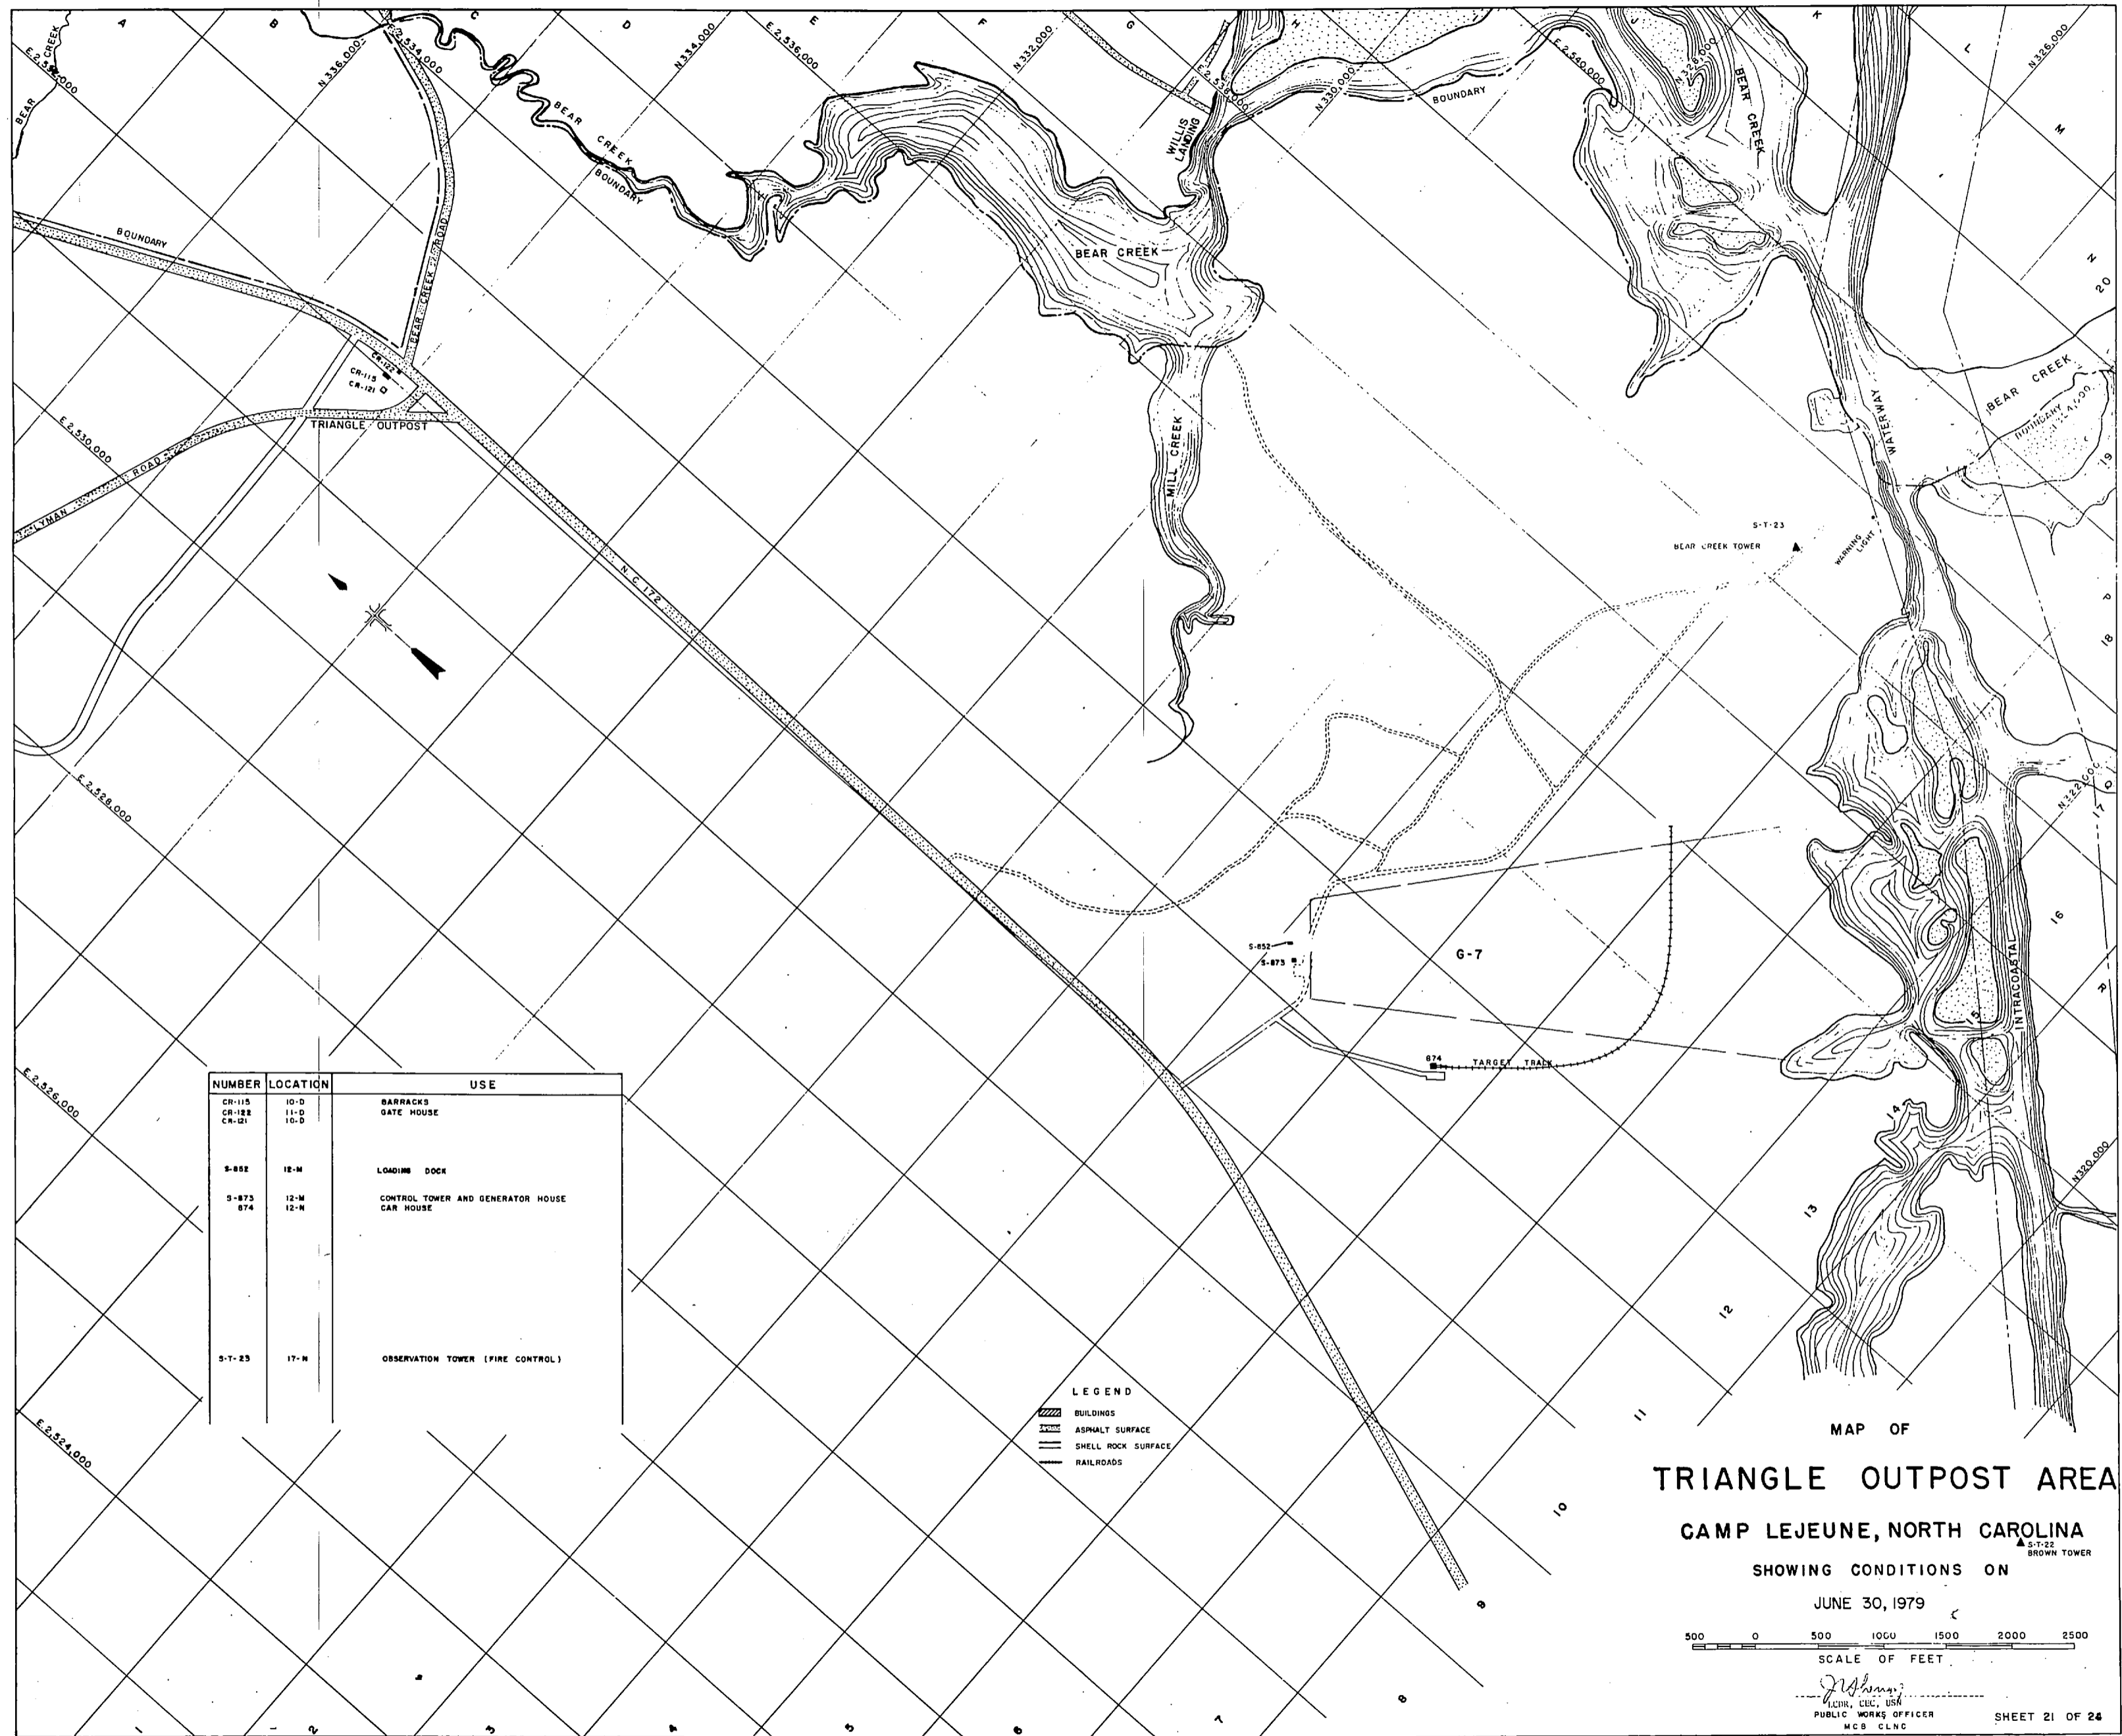


NUMBER	LOCATION	USE
CR-115	10-D	BARRACKS
CR-122	11-D	GATE HOUSE
CR-121	10-D	
S-852	12-M	LOADING DOCK
S-873	12-M	CONTROL TOWER AND GENERATOR HOUSE
874	12-M	CAR HOUSE
S-1-23	17-N	OBSERVATION TOWER (FIRE CONTROL)

LEGEND  
 [Symbol] BUILDINGS  
 [Symbol] ASPHALT SURFACE  
 [Symbol] SHELL ROCK SURFACE  
 [Symbol] RAILROADS



MAP OF  
**TRIANGLE OUTPOST AREA**  
 CAMP LEJEUNE, NORTH CAROLINA  
 SHOWING CONDITIONS ON  
 JUNE 30, 1979  
 SCALE OF FEET  
 0 500 1000 1500 2000 2500

FOR OFFICIAL USE ONLY  
 CAMP LEJEUNE, N.C.  
 SHEET 21 OF 24



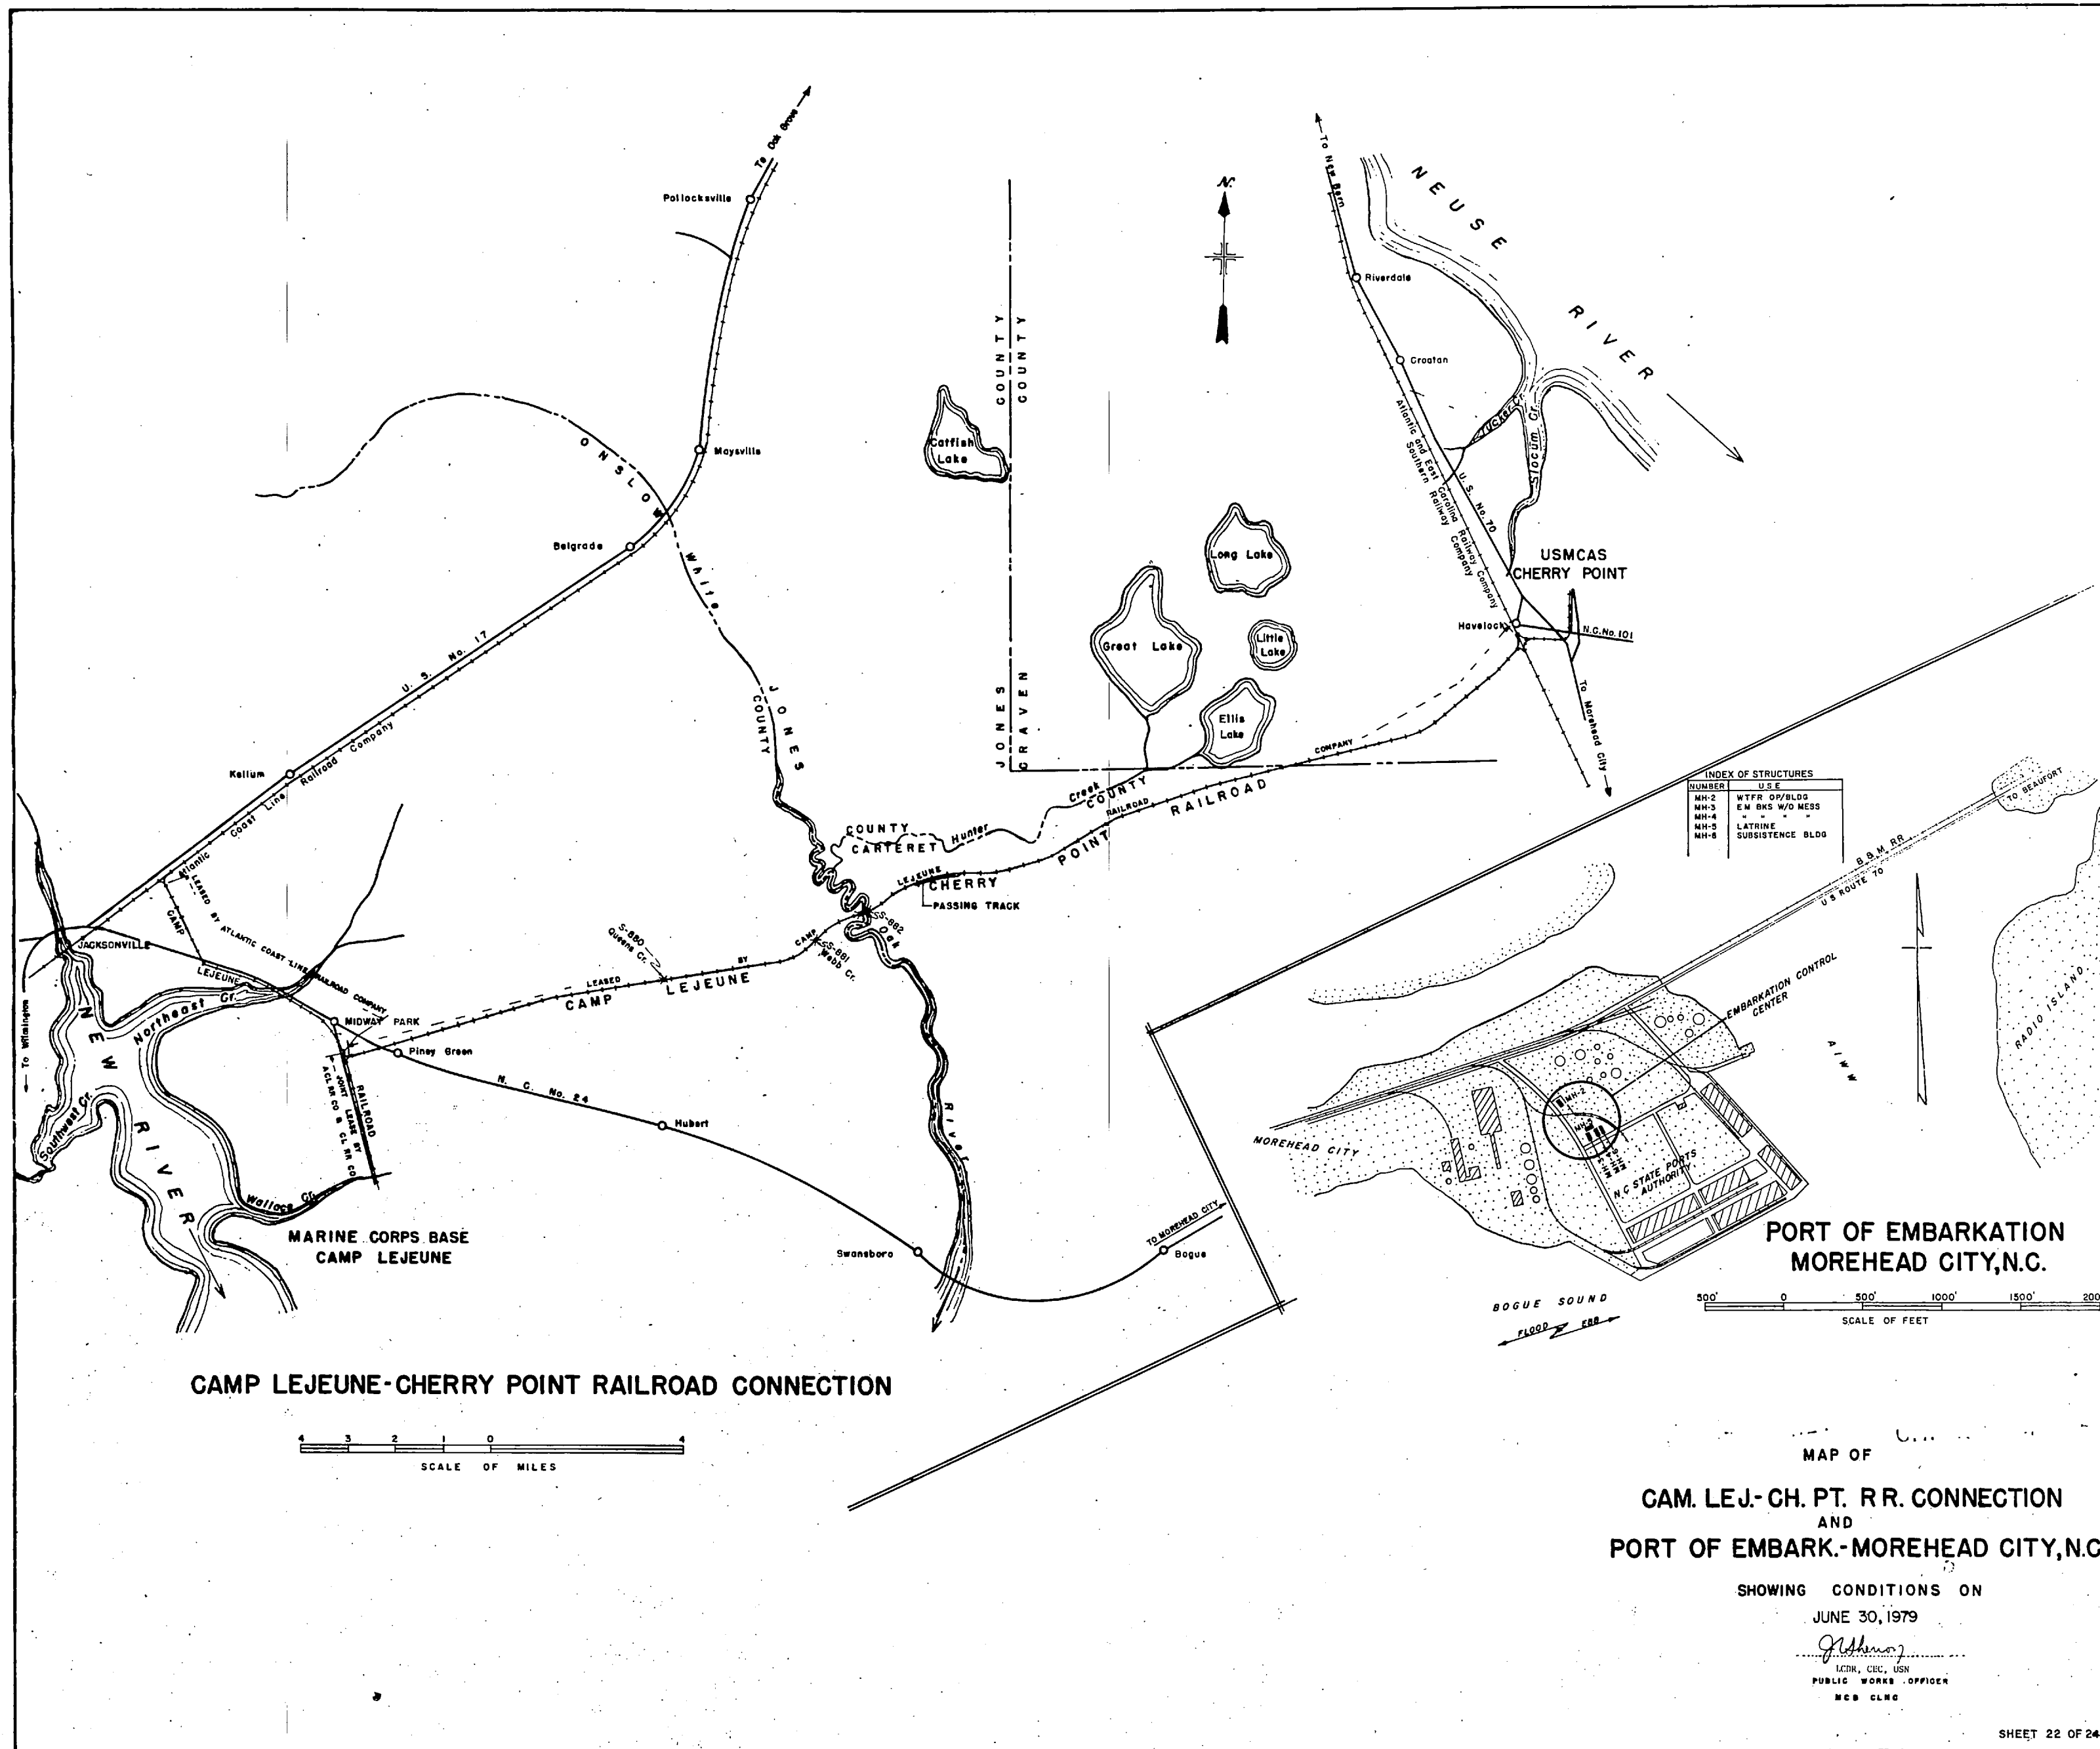

**CAMP LEJEUNE-CHERRY POINT RAILROAD CONNECTION**

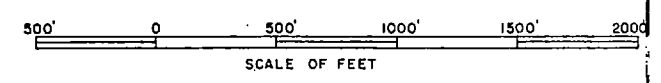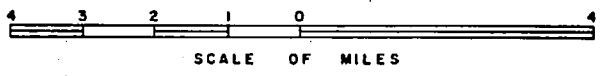


**MAP OF  
CAM. LEJ.-CH. PT. R.R. CONNECTION  
AND  
PORT OF EMBARK.-MOREHEAD CITY, N.C.**

SHOWING CONDITIONS ON  
JUNE 30, 1979

*[Signature]*  
LCRN, CEC, USN  
PUBLIC WORKS OFFICER  
MCD CLRG



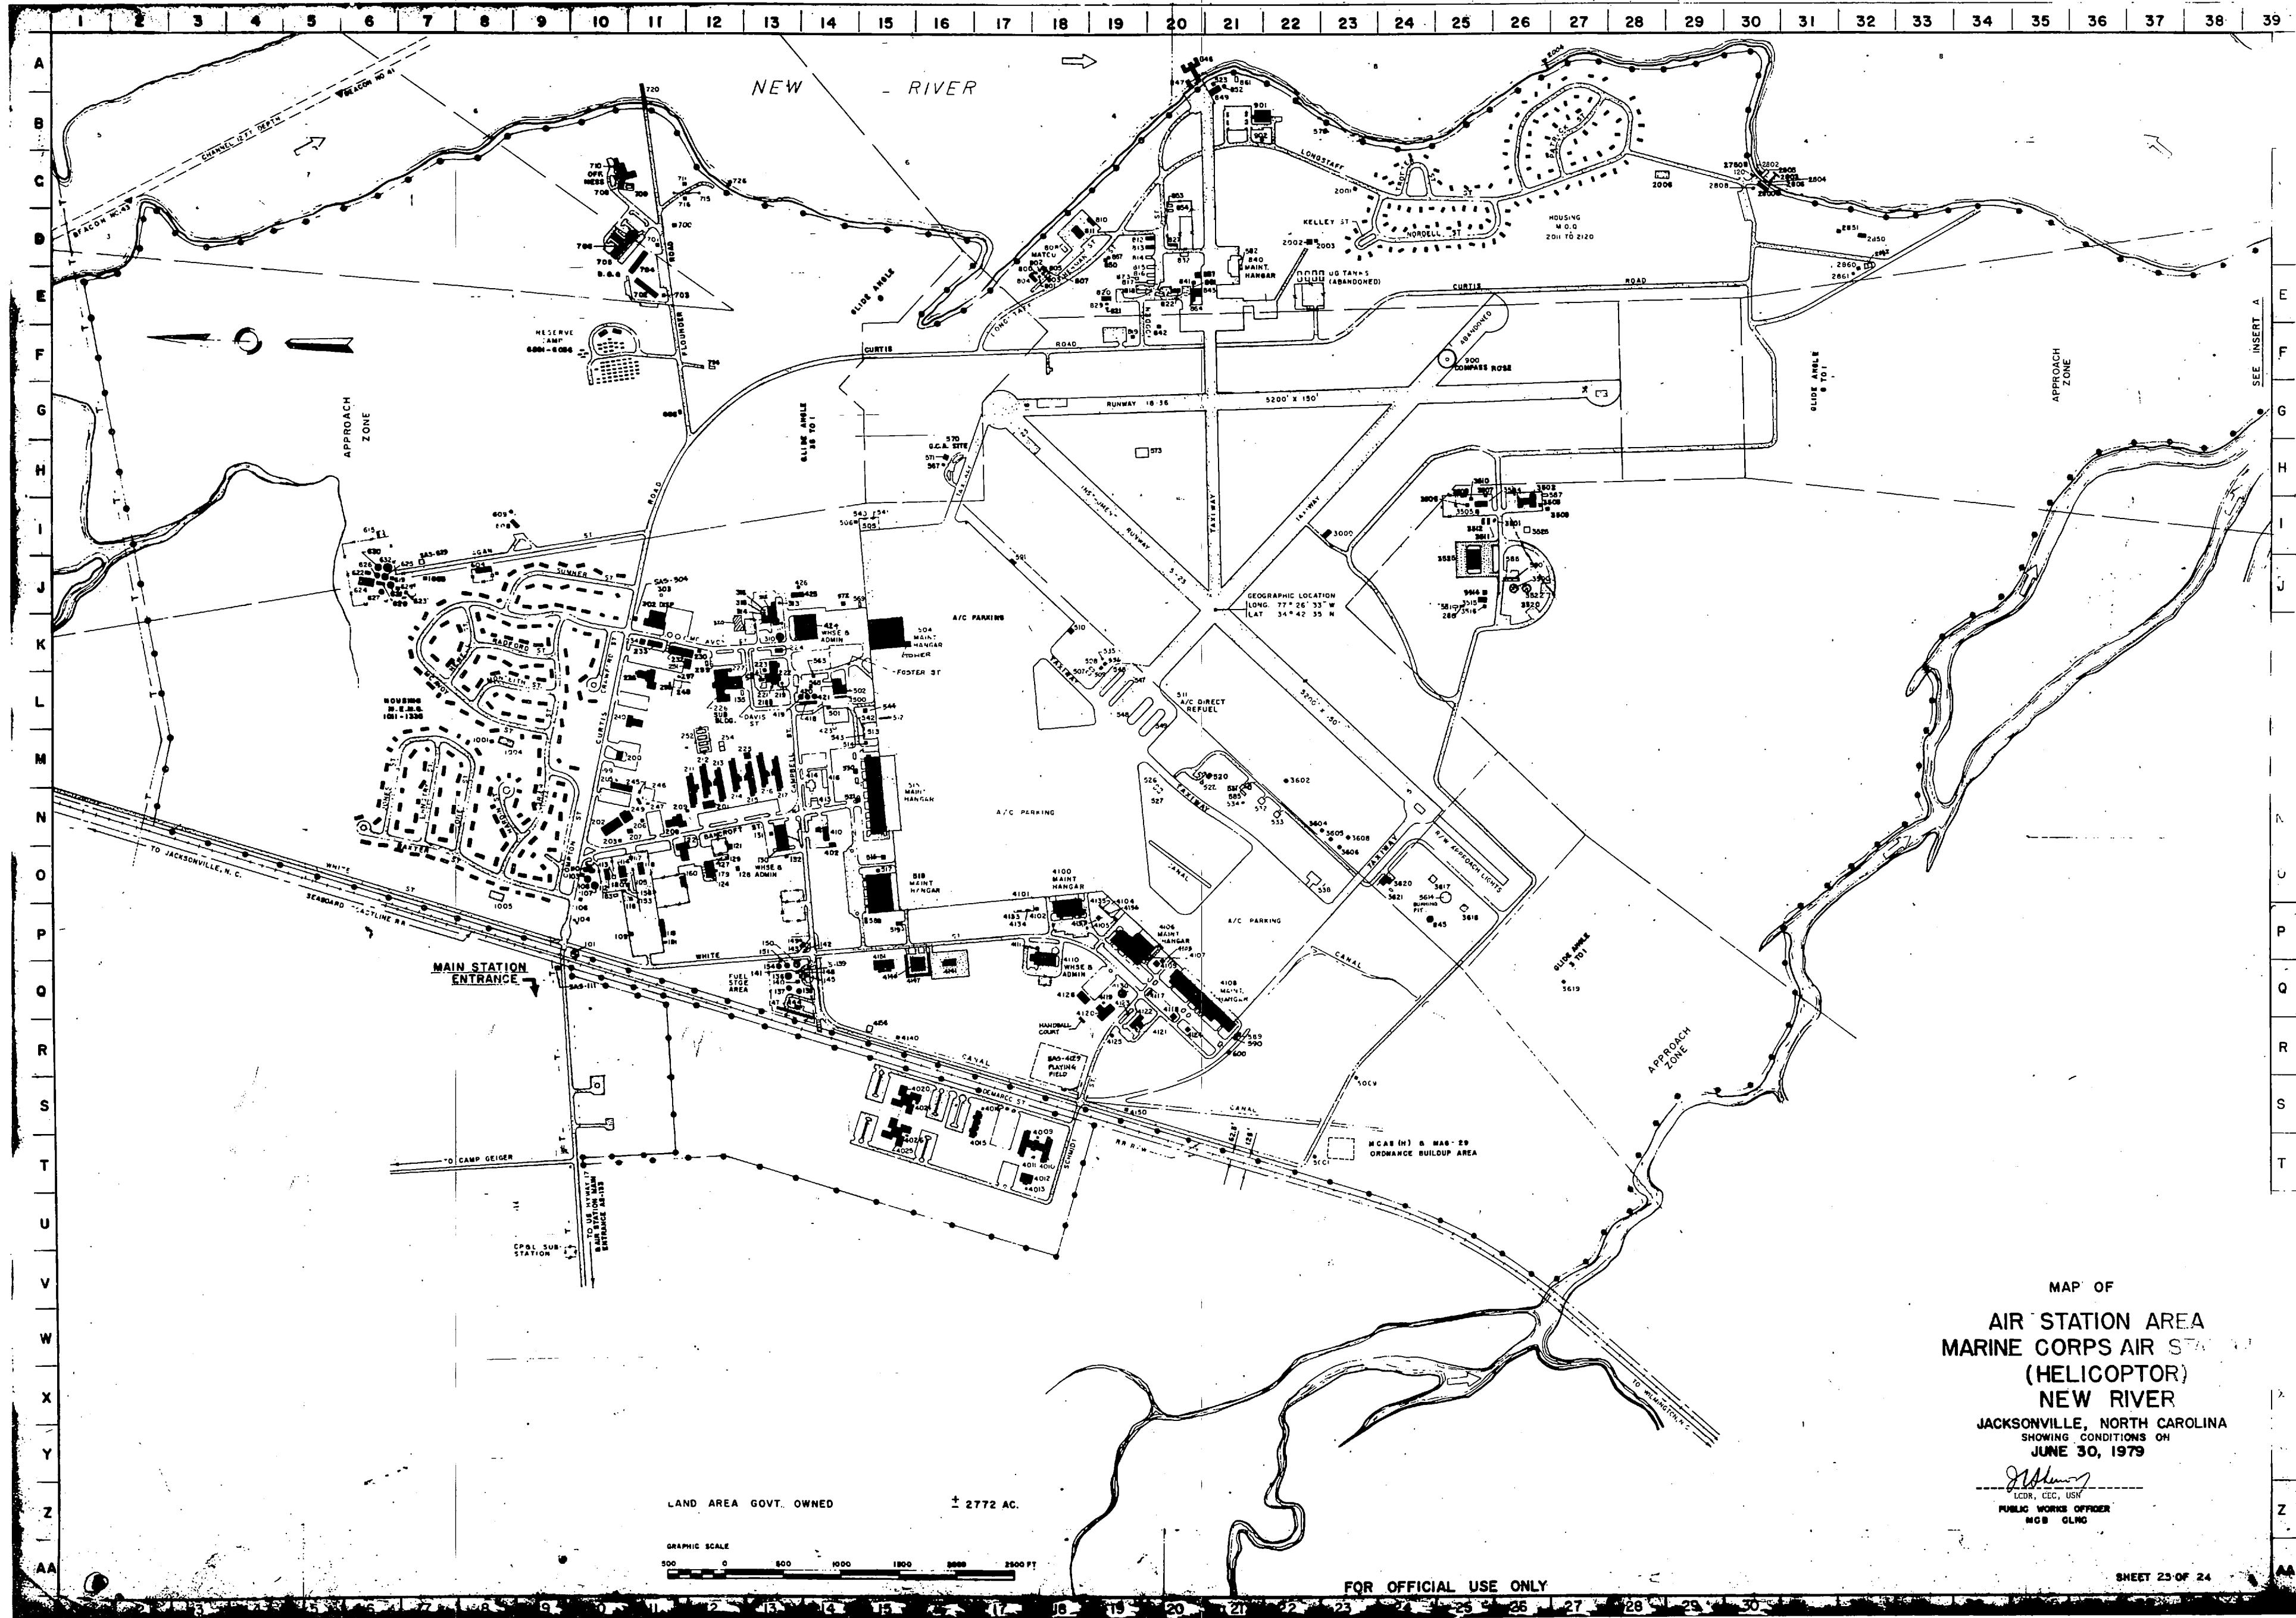

MAP OF  
 AIR STATION AREA  
 MARINE CORPS AIR STATION  
 (HELICOPTOR)  
 NEW RIVER  
 JACKSONVILLE, NORTH CAROLINA  
 SHOWING CONDITIONS ON  
 JUNE 30, 1979

*J. J. [Signature]*  
 LCDR, USMC  
 PUBLIC WORKS OFFICER  
 MOB CLMO

LAND AREA GOVT. OWNED ± 2772 AC.



FOR OFFICIAL USE ONLY

SHEET 23 OF 24





