

FILE FOLDER

DESCRIPTION ON TAB:

Sea Turtle Report

'83

- Outside/inside of actual folder did not contain handwritten information**
- Outside/inside of actual folder did contain handwritten information**
***Scanned as next image**

COOPERATIVE MARINE TURTLE TAGGING PROGRAM
TAGGING DATA (NESTING TURTLES)

Tag Number(s) APP-081 Species Caretta Date 7-29-83
(list all tag #'s and letter prefix) APP-082
Encountered

Describe location encountered 2.9 (N) Risley Pier

Circle correct answer:

"New" turtle (not carrying any tags or tag scars) Yes No

If no, then circle correct category:

- 1) Recapture of same project turtle (within season or multi-annual)
- 2) Recapture of different project turtle
- 3) Turtle has definite tag scar

Tag return address (if other than NMFS Lab/Vir Key) _____

Carapace length straight line _____ cm _____ in

Carapace width straight line _____ cm _____ in

Carapace length over curve _____ cm _____ in

Carapace width over curve _____ cm _____ in

Did turtle nest? Yes No Undetermined (circle one)

Additional remarks or data (use back if necessary) _____

Organization Tagging NREAD, Facilities, Section Marine Corps
Base, Camp LeJeune, NC





TURTLE PROJECT

Nightly Weather Conditions

On-Site Observations

Date 6-2-83 Time: 2130

General Weather Conditions Fair

Air Temperature 73°F °C Sea Water Temperature 71°F °C

Wind Speed and Direction ~5 KNOTS - S

Cloud Cover 15% Moon None (Halfmoon rose at ~0130)

Tide Fairly Low (Rising/Falling) Humidity _____ %

Comments _____

Date 6-3-83 Time: 2245

General Weather Conditions Fair

Air Temperature 74°F °C Sea Water Temperature 72°F °C

Wind Speed and Direction 10-15 KNOTS SE

Cloud Cover 10% Moon None

Tide Midway (Rising/Falling) Humidity _____ %

Comments _____

TURTLE PROJECT

Nightly Weather Conditions
On-Site Observations

Date _____ Time: _____

General Weather Conditions _____

Air Temperature _____ °C Sea Water Temperature _____ °C

Wind Speed and Direction _____

Cloud Cover _____ Moon _____

Tide _____ (Rising/Falling) Humidity _____ %

Comments _____

Date _____ Time: _____

General Weather Conditions _____

Air Temperature _____ °C Sea Water Temperature _____ °C

Wind Speed and Direction _____

Cloud Cover _____ Moon _____

Tide _____ (Rising/Falling) Humidity _____ %

Comments _____

TURTLE PROJECT

Nightly Weather Conditions

On-Site Observations

Date 6-4-83 Time: 2000General Weather Conditions CloudyAir Temperature 75°F °C Sea Water Temperature 72°F °CWind Speed and Direction N. 15 KnotsCloud Cover 70% Moon waning 3/4Tide Low, falling (Rising/Falling) Humidity _____ %Comments Raw two crabs on low tide oneon 3/4 high tide - ~~see~~Date 6-5-83 Time: 2230General Weather Conditions Partly CloudyAir Temperature 73°F °C Sea Water Temperature 70°F °CWind Speed and Direction 5-10 knots SECloud Cover 40% Moon NoneTide Low (Rising/Falling) Humidity _____ %Comments Very dark night + at approximately 0130 to 0200a thunderstorm approached the beach w/ rain and heavy thunder& lightning.

TURTLE PROJECT

Nightly Weather Conditions
On-Site Observations

Date _____ Time: _____

General Weather Conditions _____

Air Temperature _____ °C Sea Water Temperature _____ °C

Wind Speed and Direction _____

Cloud Cover _____ Moon _____

Tide _____ (Rising/Falling) Humidity _____ %

Comments _____

Date _____ Time: _____

General Weather Conditions _____

Air Temperature _____ °C Sea Water Temperature _____ °C

Wind Speed and Direction _____

Cloud Cover _____ Moon _____

Tide _____ (Rising/Falling) Humidity _____ %

Comments _____

TURTLE PROJECT

Nightly Weather Conditions

On-Site Observations

Date 6-6-83 Time: 2130General Weather Conditions CloudyAir Temperature 78°F ~~°C~~ Sea Water Temperature 73°F ~~°C~~Wind Speed and Direction 5-10 knots SECloud Cover 70% Moon NoneTide Low (Rising/Falling) Humidity _____ %

Comments _____

Date 6-7-83 Time: 2230General Weather Conditions CLOUDY, RAINYAir Temperature 78° °C Sea Water Temperature 70° °CWind Speed and Direction 0-5 knots SouthCloud Cover 95% Moon noneTide MIDWAY (Rising/Falling) Humidity _____ %

Comments _____

TURTLE PROJECT

Nightly Weather Conditions
On-Site Observations

Date _____ Time: _____

General Weather Conditions _____

Air Temperature _____ °C Sea Water Temperature _____ °C

Wind Speed and Direction _____

Cloud Cover _____ Moon _____

Tide _____ (Rising/Falling) Humidity _____ %

Comments _____

Date _____ Time: _____

General Weather Conditions _____

Air Temperature _____ °C Sea Water Temperature _____ °C

Wind Speed and Direction _____

Cloud Cover _____ Moon _____

Tide _____ (Rising/Falling) Humidity _____ %

Comments _____

TURTLE PROJECT

Nightly Weather Conditions

On-Site Observations

Date 6-8-83 Time: 2230

General Weather Conditions Fair

Air Temperature 69° °C Sea Water Temperature 70° °F °C

Wind Speed and Direction NE 5 knots

Cloud Cover 20% Moon none

Tide mid (Rising/Falling) Humidity _____ %

Comments _____

Date 6-9-83 Time: 2245

General Weather Conditions Fair

Air Temperature 70° °F °C Sea Water Temperature 69° °F °C

Wind Speed and Direction 5-10 knots NE

Cloud Cover 20% Moon None

Tide midway (Rising/Falling) Humidity _____ %

Comments _____

TURTLE PROJECT

Nightly Weather Conditions
On-Site Observations

Date _____ Time: _____

General Weather Conditions _____

Air Temperature _____ °C Sea Water Temperature _____ °C

Wind Speed and Direction _____

Cloud Cover _____ Moon _____

Tide _____ (Rising/Falling) Humidity _____ %

Comments _____

Date _____ Time: _____

General Weather Conditions _____

Air Temperature _____ °C Sea Water Temperature _____ °C

Wind Speed and Direction _____

Cloud Cover _____ Moon _____

Tide _____ (Rising/Falling) Humidity _____ %

Comments _____

TURTLE PROJECT

Nightly Weather Conditions

On-Site Observations

Date 6-10-83 Time: 2340

General Weather Conditions Fair

Air Temperature 68° F °C Sea Water Temperature 68° F °C

Wind Speed and Direction 5 knots NE

Cloud Cover 0% Moon none

Tide MIDWAY (Rising/Falling) Humidity _____ %

Comments _____

Date 6-11-83 Time: 0030

General Weather Conditions Fair

Air Temperature 65 F °C Sea Water Temperature 70° F °C

Wind Speed and Direction 5 knots East

Cloud Cover 0% Moon none

Tide MIDWAY (Rising/Falling) Humidity _____ %

Comments _____

back
6-12
6-13

TURTLE PROJECT

Nightly Weather Conditions

On-Site Observations

13.6
4.3

Date 6-12-83 Time: 2330

13.6

General Weather Conditions clear

Air Temperature 75° F °C Sea Water Temperature 72° F °C

Wind Speed and Direction 0-5 knots NE

Cloud Cover 10% Moon 1/4

Tide 3/4 High (Rising/Falling) Humidity _____ %

Comments _____

Date 6-13-83 Time: 2200

General Weather Conditions Partly cloudy

Air Temperature 80° F °C Sea Water Temperature 77° F °C

Wind Speed and Direction 0-3 knots SE

Cloud Cover 50% Moon _____

Tide High (Rising/Falling) Humidity _____ %

Comments _____

TURTLE PROJECT

Nightly Weather Conditions

On-Site Observations

Date 6-10-83 Time: 2340

General Weather Conditions Fair

Air Temperature 68° F °C Sea Water Temperature 68° F °C

Wind Speed and Direction 5 knots NE

Cloud Cover 0% Moon none

Tide MIDWAY (Rising/Falling) Humidity _____ %

Comments _____

Date 6-11-83 Time: 0030

General Weather Conditions Fair

Air Temperature 65 F °C Sea Water Temperature 70° F °C

Wind Speed and Direction 5 knots East

Cloud Cover 0% Moon none

Tide MIDWAY (Rising/Falling) Humidity _____ %

Comments _____

back
6-12
6-13

TURTLE PROJECT

Nightly Weather Conditions

On-Site Observations

2.6
4.3

Date 6-12-83 Time: 2330

13.6

General Weather Conditions clear

Air Temperature 75° F °C Sea Water Temperature 72° F °C

Wind Speed and Direction 0-5 knots NE

Cloud Cover 10% Moon 1/4

Tide 3/4 High (Rising/Falling) Humidity _____ %

Comments _____

Date 6-13-83 Time: 2200

General Weather Conditions Partly cloudy

Air Temperature 80° F °C Sea Water Temperature 77° F °C

Wind Speed and Direction 0-3 knots SE

Cloud Cover 50% Moon _____

Tide High (Rising/Falling) Humidity _____ %

Comments _____

Nightly Weather Conditions

On-Site Observations

Date 6-14-83 Time: 0200

General Weather Conditions Fair

Air Temperature 75°F °C Sea Water Temperature 73°F °C

Wind Speed and Direction 0-5 knots SE

Cloud Cover 20% Moon 5

Tide midway (Rising/Falling) Humidity _____ %

Comments _____

Date 6-15-83 Time: 2130

General Weather Conditions Clear

Air Temperature 77°F °C Sea Water Temperature 75°F °C

Wind Speed and Direction 5-10 knots NE

Cloud Cover 10% Moon half

Tide midway (Rising/Falling) Humidity _____ %

Comments _____

TURTLE PROJECT

Nightly Weather Conditions

On-Site Observations

Date 6-16-83 Time: 2130General Weather Conditions ClearAir Temperature 75° F °C Sea Water Temperature 79° F °CWind Speed and Direction 5-10 knots NECloud Cover 10% Moon _____Tide mid way (Rising/Falling) Humidity _____ %

Comments _____

Date 6-17-83 Time: 1330General Weather Conditions ClearAir Temperature 75° F °C Sea Water Temperature 77° F °CWind Speed and Direction B-1Cloud Cover 10% Moon 1/2 FullTide Rising (Rising/Falling) Humidity _____ %

Comments _____

TURTLE PROJECT

Nightly Weather Conditions

On-Site Observations

Date 6-18-83 Time: 2040

General Weather Conditions CLEAR

Air Temperature 77°F °C Sea Water Temperature 79°F °C

Wind Speed and Direction B-3

Cloud Cover 290 Moon 1/2 FULL

Tide 2100 (Rising/Falling) Humidity _____ %

Comments _____

Date 6-19-83 Time: 2130

General Weather Conditions Hazy, Partly cloudy

Air Temperature 75°F °C Sea Water Temperature 80°F °C

Wind Speed and Direction 0-5 knts SE

Cloud Cover 30% Moon 3/4

Tide Low (Rising/Falling) Humidity _____ %

Comments very hazy

20
21 or back

TURTLE PROJECT

Nightly Weather Conditions
On-Site Observations

Date 6-20-83 Time: 2200

General Weather Conditions cloudy, hazy

Air Temperature 72°F °C Sea Water Temperature 80°F °C

Wind Speed and Direction 0-5 knots SE

Cloud Cover 70% Moon 3/4

Tide midway (Rising/Falling) Humidity _____ %

Comments _____

Date 6-21-83 Time: 2200

General Weather Conditions cloudy

Air Temperature 73°F °C Sea Water Temperature 79°F °C

Wind Speed and Direction 0-5 knots NE

Cloud Cover 80% Moon _____

Tide midway (Rising/Falling) Humidity _____ %

Comments _____

TURTLE PROJECT

Nightly Weather Conditions

On-Site Observations

Date 6-22-83 Time: 2130General Weather Conditions Partly cloudyAir Temperature 74.0 °C Sea Water Temperature 79 °FWind Speed and Direction 5-10 KNOTS NECloud Cover 50% Moon almost FullTide 3/4 high (Rising/Falling) Humidity _____ %

Comments _____

Date 6-23-83 Time: 2130General Weather Conditions FairAir Temperature 25.5 °C Sea Water Temperature _____ °CWind Speed and Direction 5-10 EastCloud Cover 25% Moon Near FullTide 1/4 Falling (Rising/Falling) Humidity Hi %

Comments _____

TURTLE PROJECT

Nightly Weather Conditions

On-Site Observations

Date 6-24 Time: 2200General Weather Conditions FairAir Temperature 78 °F Sea Water Temperature 78 °FWind Speed and Direction 5-10 SWCloud Cover 0 Moon FullTide Hi (Rising/Falling) Humidity Hi %Comments Good Night For turtlesDate 6-25-83 Time: 2200General Weather Conditions CloudyAir Temperature 78 °F Sea Water Temperature 79 °FWind Speed and Direction 5-10 SWCloud Cover 90% Moon FullTide Hi (Rising/Falling) Humidity Hi %Comments Look like storms brewing

TURTLE PROJECT

Nightly Weather Conditions

On-Site Observations

Date 6-20-83 Time: 2400

General Weather Conditions Partly Cloudy

Air Temperature 75°F °C Sea Water Temperature 79°F °C

Wind Speed and Direction 10-15 knots S

Cloud Cover 50% Moon Full

Tide Low (Rising/Falling) Humidity _____ %

Comments _____

Date 6-21-83 Time: 2115

General Weather Conditions Partly cloudy

Air Temperature 78°F °C Sea Water Temperature 80°F °C

Wind Speed and Direction 10-15 SE

Cloud Cover 60% Moon None visible

Tide High (Rising/Falling) Humidity _____ %

Comments _____

TURTLE PROJECT

Nightly Weather Conditions
On-Site Observations

Date _____ Time: _____

General Weather Conditions _____

Air Temperature _____ °C Sea Water Temperature _____ °C

Wind Speed and Direction _____

Cloud Cover _____ Moon _____

Tide _____ (Rising/Falling) Humidity _____ %

Comments _____

Date _____ Time: _____

General Weather Conditions _____

Air Temperature _____ °C Sea Water Temperature _____ °C

Wind Speed and Direction _____

Cloud Cover _____ Moon _____

Tide _____ (Rising/Falling) Humidity _____ %

Comments _____

TURTLE PROJECT

Nightly Weather Conditions

On-Site Observations

Date 6-28-83 Time: 2200

General Weather Conditions Partly cloudy

Air Temperature 80°F ~~°C~~ Sea Water Temperature 79°F °C

Wind Speed and Direction 15-20 knots S

Cloud Cover 40 Moon

Tide high (Rising/Falling) Humidity %

Comments

Date 6-29-83 Time: 2200

General Weather Conditions cloudy

Air Temperature 75°F °C Sea Water Temperature 79°F °C

Wind Speed and Direction 5-10 knots S

Cloud Cover 80% Moon

Tide Mid way (Rising/Falling) Humidity %

Comments Lightning off of beach

TURTLE PROJECT

Nightly Weather Conditions

On-Site Observations

Date 6-30-83 Time: 2130

General Weather Conditions Partly Cloudy

Air Temperature 78 °F Sea Water Temperature 78 °C

Wind Speed and Direction 5-10 ESE changed to SW

Cloud Cover 35% Moon 3/4

Tide H (Rising/Falling) Humidity Hi %

Comments _____

Date 7-1-83 Time: 2230

General Weather Conditions Partly Cloudy

Air Temperature 78 °C Sea Water Temperature 79 °C

Wind Speed and Direction 5-10 -SW

Cloud Cover 60% Moon not up yet waning

Tide mid (Rising/Falling) Humidity Hi %

Comments _____

TURTLE PROJECT

Nightly Weather Conditions

On-Site Observations

Date 7-5-82 Time: 0130

General Weather Conditions Cloudy

Air Temperature 75°F °C Sea Water Temperature 78°F °C

Wind Speed and Direction 0-5 SW

Cloud Cover 100% Moon —

Tide Low (Rising/Falling) Humidity — %

Comments Heavy thunderstorms most of the night

Date 7-6-83 Time: 2130

General Weather Conditions cloudy

Air Temperature 78°F °C Sea Water Temperature 78°F °C

Wind Speed and Direction 0-2 knots S

Cloud Cover 90% Moon —

Tide Low (Rising/Falling) Humidity — %

Comments —

7-1-83 028 tags 2200 2.1(N)

TURTLE PROJECT

Nightly Weather Conditions
On-Site Observations

Date _____ Time: _____

General Weather Conditions _____

Air Temperature _____ °C Sea Water Temperature _____ °C

Wind Speed and Direction _____

Cloud Cover _____ Moon _____

Tide _____ (Rising/Falling) Humidity _____ %

Comments _____

Date _____ Time: _____

General Weather Conditions _____

Air Temperature _____ °C Sea Water Temperature _____ °C

Wind Speed and Direction _____

Cloud Cover _____ Moon _____

Tide _____ (Rising/Falling) Humidity _____ %

Comments _____

TURTLE PROJECT

Nightly Weather Conditions

On-Site Observations

Date 7-7-83 Time: 2200

General Weather Conditions Clear

Air Temperature 74°F °C Sea Water Temperature 75°F °C

Wind Speed and Direction 0-5 knots NE

Cloud Cover 15% Moon

Tide Low (Rising/Falling) Humidity %

Comments

Date 7-8-83 Time: 1400

General Weather Conditions Clear

Air Temperature 88°F °C Sea Water Temperature 77°F °C

Wind Speed and Direction 5-10 knots Fast

Cloud Cover 0 Moon New Moon

Tide Low (Rising/Falling) Humidity %

Comments

7-9
7-10 on back

25.8
23.5
2.3
25.8
21.8
4.0

TURTLE PROJECT

Nightly Weather Conditions
On-Site Observations

Date 7-9-83 Time: 1020

General Weather Conditions Clear ✓

Air Temperature 76° F °C Sea Water Temperature 72° F °C

Wind Speed and Direction EAST 10 knots

Cloud Cover 0% Moon none

Tide High (Rising/Falling) Humidity _____ %

Comments _____

Date 7-10-83 Time: 2200

General Weather Conditions cloudy

Air Temperature 78° F °C Sea Water Temperature 78° F °C

Wind Speed and Direction 10-12 knots E

Cloud Cover 95% Moon -

Tide High (Rising/Falling) Humidity _____ %

Comments _____

TURTLE PROJECT

Nightly Weather Conditions

On-Site Observations

Date 7-11-83 Time: 2230General Weather Conditions Partly cloudyAir Temperature 78°F °C Sea Water Temperature 79°F °CWind Speed and Direction 0-5 knots ECloud Cover 30% Moon —Tide High (Rising/Falling) Humidity _____ %

Comments _____

Date 7-13-83 Time: 2400General Weather Conditions ClearAir Temperature 78°F °C Sea Water Temperature 79°F °CWind Speed and Direction 5-10 knots SCloud Cover 10% Moon 1/4 (not visible)Tide High (Rising/Falling) Humidity _____ %

Comments _____

TURTLE PROJECT

Nightly Weather Conditions
On-Site Observations

Date _____ Time: _____

General Weather Conditions _____

Air Temperature _____ °C Sea Water Temperature _____ °C

Wind Speed and Direction _____

Cloud Cover _____ Moon _____

Tide _____ (Rising/Falling) Humidity _____ %

Comments _____

Date _____ Time: _____

General Weather Conditions _____

Air Temperature _____ °C Sea Water Temperature _____ °C

Wind Speed and Direction _____

Cloud Cover _____ Moon _____

Tide _____ (Rising/Falling) Humidity _____ %

Comments _____

TURTLE PROJECT

Nightly Weather Conditions

On-Site Observations



Date 7-14-83 Time: 2200

General Weather Conditions Fair to Partly cloudy

Air Temperature 80°F °C Sea Water Temperature 80°F °C

Wind Speed and Direction 0-2 knots S

Cloud Cover 20% Moon almost 1/2

Tide high (Rising/Falling) Humidity _____ %

Comments Lightning in the distance (to the south)

Date 7-15-83 Time: 0125

General Weather Conditions Clear, clouds over ocean

Air Temperature 85°F °C Sea Water Temperature 80°F °C

Wind Speed and Direction 0-5 knots SE

Cloud Cover 10% Moon half

Tide high (Rising/Falling) Humidity _____ %

Comments _____

7-25 on back.

TURTLE PROJECT

Nightly Weather Conditions

On-Site Observations

Date 7-25-83 Time: 2400

General Weather Conditions cloudy

Air Temperature 80°F °C Sea Water Temperature 80°F °C

Wind Speed and Direction 0-5 knots S

Cloud Cover 85% Moon Not visible (Full)

Tide Low (Rising/Falling) Humidity _____ %

Comments _____

Date _____ Time: _____

General Weather Conditions _____

Air Temperature _____ °C Sea Water Temperature _____ °C

Wind Speed and Direction _____

Cloud Cover _____ Moon _____

Tide _____ (Rising/Falling) Humidity _____ %

Comments _____

TURTLE PROJECT

Nightly Weather Conditions

On-Site Observations

Date 7-16-83 Time: 0330

General Weather Conditions CLEAR

Air Temperature 80°F °C Sea Water Temperature 78°F °C

Wind Speed and Direction 15 KNOTS

Cloud Cover 0 Moon 1/2 FULL

Tide RISING (Rising/Falling) Humidity Light %

Comments POOLE - JONES

Date 7-17-83 Time: 2230

General Weather Conditions Partly cloudy

Air Temperature 81°F °C Sea Water Temperature 80.4°F °C

Wind Speed and Direction 0-5 KNOTS S

Cloud Cover 45% Moon 1/2

Tide LOW (Rising/Falling) Humidity high %

Comments _____

7-22
7-23 on back

TURTLE PROJECT

Nightly Weather Conditions
On-Site Observations

Date 7-22-83 Time: 2315

General Weather Conditions Cloudy - some RAIN

Air Temperature 73° F °C Sea Water Temperature 75° F °C

Wind Speed and Direction South 10K

Cloud Cover 70% Moon 1/ not Full

Tide MIDWAY (Rising/Falling) Humidity _____ %

Comments _____

Date 7-23-83 Time: 2340

General Weather Conditions Fair

Air Temperature 80° F °C Sea Water Temperature 75° F °C

Wind Speed and Direction SW 10K

Cloud Cover 10% Moon Full

Tide MIDWAY (Rising/Falling) Humidity _____ %

Comments _____

TURTLE PROJECT

Nightly Weather Conditions

On-Site Observations

Date 7-18-83 Time: 2215

General Weather Conditions Fair but hazy

Air Temperature 84° F °C Sea Water Temperature 82° F °C

Wind Speed and Direction 0-5 knots S

Cloud Cover 10% Moon 3/4

Tide very low (Rising/Falling) Humidity _____ %

Comments Hazy

Date 7-19-83 Time: 2200

General Weather Conditions Partly cloudy

Air Temperature 84° F °C Sea Water Temperature 82° F °C

Wind Speed and Direction 0-5 knots S

Cloud Cover 40% Moon 3/4 (not visible)

Tide Low (Rising/Falling) Humidity _____ %

Comments _____

7-20
7-21 on board

TURTLE PROJECT

Nightly Weather Conditions
On-Site Observations

Date 7-20-83 Time: 2200

General Weather Conditions Fair

Air Temperature 83°F °C Sea Water Temperature 80°F °C

Wind Speed and Direction 5-10 Knots S

Cloud Cover 15% Moon almost Full

Tide Low (Rising/Falling) Humidity _____ %

Comments _____

Date 7-21-83 Time: 2150

General Weather Conditions Clear

Air Temperature 85°F °C Sea Water Temperature 80°F °C

Wind Speed and Direction 10-15 Knots S

Cloud Cover 10% Moon almost Full

Tide midway (Rising/Falling) Humidity _____ %

Comments _____

TURTLE PROJECT

Nightly Weather Conditions

On-Site Observations

Date 7-25-83 Time: 2213

General Weather Conditions Cloudy rainy

Air Temperature 78°F °C Sea Water Temperature 80°F °C

Wind Speed and Direction 0-5 knots S

Cloud Cover 95% Moon not visible (Full)

Tide high (Rising/Falling) Humidity _____ %

Comments _____

Date 7-26-83 Time: 2130

General Weather Conditions Partly Cloudy

Air Temperature 79°F °C Sea Water Temperature _____ °C

Wind Speed and Direction 5-10 knots N

Cloud Cover 40% Moon not visible (Full)

Tide High (Rising/Falling) Humidity _____ %

Comments _____

TURTLE PROJECT

Nightly Weather Conditions
On-Site Observations

Date _____ Time: _____

General Weather Conditions _____

Air Temperature _____ °C Sea Water Temperature _____ °C

Wind Speed and Direction _____

Cloud Cover _____ Moon _____

Tide _____ (Rising/Falling) Humidity _____ %

Comments _____

Date _____ Time: _____

General Weather Conditions _____

Air Temperature _____ °C Sea Water Temperature _____ °C

Wind Speed and Direction _____

Cloud Cover _____ Moon _____

Tide _____ (Rising/Falling) Humidity _____ %

Comments _____

TURTLE PROJECT

Nightly Weather Conditions

On-Site Observations

Date 7-27-83 Time: 2130

General Weather Conditions Clear

Air Temperature 79°F °C Sea Water Temperature 80°F °C

Wind Speed and Direction 5-10 knots N

Cloud Cover 15% Moon not visible (Full)

Tide High (Rising/Falling) Humidity _____ %

Comments _____

Date 7-28-83 Time: 2230

General Weather Conditions Clear

Air Temperature 80°F °C Sea Water Temperature 80°F °C

Wind Speed and Direction 5-10 knots E

Cloud Cover 15% Moon not visible (almost Full)

Tide High (Rising/Falling) Humidity _____ %

Comments _____

8-4 on back

TURTLE PROJECT

Nightly Weather Conditions
On-Site Observations

Date 8-4-83 Time: 2:30

General Weather Conditions Hazy

Air Temperature 81°F °C Sea Water Temperature 81°F °C

Wind Speed and Direction 0-5 knots E

Cloud Cover 20% Moon Not visible

Tide LW (Rising/Falling) Humidity _____ %

Comments _____

Date 8-5-83 Time: 0200

General Weather Conditions Clear

Air Temperature 80°F °C Sea Water Temperature 74°F °C

Wind Speed and Direction 15-25 knots

Cloud Cover 0% Moon LW not visible

Tide _____ (Rising/Falling) Humidity medium %

Comments _____

TURTLE PROJECT

Nightly Weather Conditions

On-Site Observations

Date 7-29-83 Time: 0345

General Weather Conditions cldy-

Air Temperature 72° F °C Sea Water Temperature 76° F °C

Wind Speed and Direction 10 KNOTS

Cloud Cover 25% Moon 3/4 ON WAYNE

Tide FALLING (Rising/Falling) Humidity Medium %

Comments Started at 2000 - 80% cloudy -
cleared to 25%.

Date 7-30-83 Time: 2040

General Weather Conditions mostly clear

Air Temperature 80° F °C Sea Water Temperature 79° F °C

Wind Speed and Direction 12-15 KNOTS SE

Cloud Cover 5% Moon on wayne 3/4

Tide (Rising/Falling) Humidity med %

Comments _____

TURTLE PROJECT

Nightly Weather Conditions
On-Site Observations

Date _____ Time: _____

General Weather Conditions _____

Air Temperature _____ °C Sea Water Temperature _____ °C

Wind Speed and Direction _____

Cloud Cover _____ Moon _____

Tide _____ (Rising/Falling) Humidity _____ %

Comments _____

Date _____ Time: _____

General Weather Conditions _____

Air Temperature _____ °C Sea Water Temperature _____ °C

Wind Speed and Direction _____

Cloud Cover _____ Moon _____

Tide _____ (Rising/Falling) Humidity _____ %

Comments _____

TURTLE PROJECT

Nightly Weather Conditions

On-Site Observations

Date 8-2-83 Time: 2230

General Weather Conditions Partly Cloudy

Air Temperature 82°F °C Sea Water Temperature 81°F °C

Wind Speed and Direction 5-10 knots S

Cloud Cover 50% Moon not visible (NW)

Tide LOW (Rising/Falling) Humidity _____ %

Comments _____

Date 8-3-83 Time: 2130

General Weather Conditions cloudy

Air Temperature 77°F °C Sea Water Temperature 79°F °C

Wind Speed and Direction 10-15 knots E

Cloud Cover 90% Moon not visible

Tide LOW (Rising/Falling) Humidity _____ %

Comments _____

TURTLE PROJECT

Nightly Weather Conditions

On-Site Observations

Date 7-31-83 Time: 2230

General Weather Conditions Partly cloudy

Air Temperature 82° F °C Sea Water Temperature 80° F °C

Wind Speed and Direction 10-15 knots S

Cloud Cover 30% Moon not visible (high waves)

Tide midway (Rising/Falling) Humidity _____ %

Comments _____

Date 8-1-83 Time: 2230

General Weather Conditions Partly cloudy

Air Temperature 81° F °C Sea Water Temperature 81° F °C

Wind Speed and Direction 5-10 knots SE

Cloud Cover 35% Moon not visible

Tide midway (Rising/Falling) Humidity _____ %

Comments _____

8-2
8-3 on back

TURTLE PROJECT

Nightly Weather Conditions

On-Site Observations

Date 8-6-83 Time: 2100

General Weather Conditions 80% to 90% cloudy - slight wind
Stormy

Air Temperature 75° F °C Sea Water Temperature 80° F °C

Wind Speed and Direction 5-10 knots South

Cloud Cover 80-90% Moon _____

Tide _____ (Rising/Falling) Humidity Light %

Comments _____

Date 8-8-83 Time: 2200

General Weather Conditions Partly cloudy

Air Temperature 82° F °C Sea Water Temperature 82° F °C

Wind Speed and Direction 5-10 knots S

Cloud Cover 45% Moon Not visible

Tide High (Rising/Falling) Humidity _____ %

Comments _____

TURTLE PROJECT

Nightly Weather Conditions
On-Site Observations

Date _____ Time: _____

General Weather Conditions _____

Air Temperature _____ °C Sea Water Temperature _____ °C

Wind Speed and Direction _____

Cloud Cover _____ Moon _____

Tide _____ (Rising/Falling) Humidity _____ %

Comments _____

Date _____ Time: _____

General Weather Conditions _____

Air Temperature _____ °C Sea Water Temperature _____ °C

Wind Speed and Direction _____

Cloud Cover _____ Moon _____

Tide _____ (Rising/Falling) Humidity _____ %

Comments _____

TURTLE PROJECT

Nightly Weather Conditions

On-Site Observations

Date 8-12-83 Time: 0240

General Weather Conditions CLdy

Air Temperature 75° F °C Sea Water Temperature 75° F °C

Wind Speed and Direction 10-15 KNOTS S.W.

Cloud Cover 60% Moon _____

Tide _____ (Rising/Falling) Humidity _____ %

Comments Temperature dropping - cold front
Approaching.

Date 8-13-83 Time: 2045

General Weather Conditions Clear

Air Temperature 72° F °C Sea Water Temperature 75° F °C

Wind Speed and Direction 10 knots out of South West

Cloud Cover 5% Moon 3/4 Full

Tide _____ (Rising/Falling) Humidity _____ %

Comments CLdy in N. West

TURTLE PROJECT

Nightly Weather Conditions
On-Site Observations

Date _____ Time: _____

General Weather Conditions _____

Air Temperature _____ °C Sea Water Temperature _____ °C

Wind Speed and Direction _____

Cloud Cover _____ Moon _____

Tide _____ (Rising/Falling) Humidity _____ %

Comments _____

Date _____ Time: _____

General Weather Conditions _____


Air Temperature _____ °C Sea Water Temperature _____ °C


Wind Speed and Direction _____


Cloud Cover _____ Moon _____


Tide _____ (Rising/Falling) Humidity _____ %


Comments _____

 


 


 

 

 

 

 

SEA TURTLE INVENTORY

for

SUMMER AND FALL 1983

NATURAL RESOURCES AND ENVIRONMENTAL AFFAIRS DIVISION
ASSISTANT CHIEF OF STAFF, FACILITIES
MARINE CORPS BASE
CAMP LEJEUNE, NORTH CAROLINA 28542

JULIAN I. WOOTEN
DIRECTOR

CHARLES D. PETERSON
SUPERVISORY WILDLIFE
MANAGER

SAM F. POOLE
WILDLIFE BIOLOGIST

BRIAN C. SPAULDING
BIOLOGICAL TECHNICIAN

HUGH R. PASSINGHAM
BIOLOGICAL TECHNICIAN

DR. FRANK B. SCHWARTZ
ADVISOR, INSTITUTE OF
MARINE SCIENCE,
MOREHEAD CITY, NORTH CAROLINA

 


TABLE OF CONTENTS

Introduction 1

Sea Turtle Inventory (Crawl Data) - Table I 2


Return Record of Tagged Turtles - Table III 7

Crawl Information in Relation to Moon and Tidal Cycles
and Weather Conditions - Table III 8

Ground Survey Numbers - Table IV 10

Aerial Survey - Table V 12

Nest Crawl Activity 13

 

INTRODUCTION

The sea turtle inventory for 1983 is a continuation of past efforts by Natural Resources and Environmental Affairs Division, Assistant Chief of Staff, Facilities, Marine Corps Base, Camp Lejeune, North Carolina, to protect sea turtle nesting activities at Onslow Beach. The sea turtle inventory consists of several programs including: nest protection, tagging of adult turtles, collecting nesting data, determining hatchling success and aerial surveys.

Management personnel began operating under a Federal Fish and Wildlife Permit during 1981, issued for working with threatened Loggerhead and Green Turtles. The permit authorizes the tagging and measurement of adults and the relocation of nests threatened by erosion, tides, extreme predation or military training activities. Nests may be moved only within 36 hours of egg laying to a safe beach location and not to a laboratory. Relocated nests are required to be monitored and hatchling success documented.

The results of the aforementioned programs are as follows:

- a. Nest protection from predators, 100%.
- b. Tagging of adults - number of turtles tagged - 14. Tag return data may be reviewed in Table II, page 7.
- c. Nesting data - number of nests - 42
- d. Total number of crawls - 103
- e. Total number of eggs - 5,031
- f. Total number of hatchlings - 3,753
- g. Number of tag returns - 4
- h. Number stranded turtles - 2


Stranding reports were submitted to the North Carolina Wildlife Resources Stranding Network Coordinator. Carcasses were buried on the beach.

Percent hatchling success is 80.9% nesting and crawl data is compiled in Tables I, II, III, IV and V, and Graphs I and II on pages 2 through 15. The enclosed maps indicate locations of turtle activity on Onslow Beach.

Aerial survey data may be found in Table V, page 12.

The Marine Corps Base, Camp Lejeune and Natural Resources and Environmental Affairs Division give special thanks to Doctor F. J. Schwartz at the Institute of Marine Science, Morehead City for his advice and services.

For copies of this report or other information concerning the sea turtle management program conducted by this agency, contact: Commanding General, Marine Corps Base, Camp Lejeune, North Carolina 28542, Attention: Director, Natural Resources and Environmental Affairs Division, Assistant Chief of Staff, Facilities.

 

SEA TURTLE INVENTORY
(Crawl Data)


TABLE I
Marine Corps Base
Camp Lejeune, North Carolina

Crawl No.	Date	Time Crawl Occurred	Active Nest	Location*	Comments
001	6-8-83	2330	X	1.6(S)	Relocated to dune 160 eggs Tags AAR 051.
002	6-11-83	0330		2.6(N)	C.O.
003	6-13-83	0330-0600		3.5(N)	C.O.
004	6-13-83	0330-0600		2.3(N)	C.O.
005	6-15-83	2330	X	1.6(S)	Relocated from 1.2(S) 121 eggs
006	6-15-83	2330		2.6(S)	C.O.
007	6-15-83	2400	X	2.3(S)	Relocated from 2.9(S) 158 eggs Tags AAR 053,
008	6-16-83	2300	X	3.7(N)	Relocated from 3.9(N) 142 eggs Tags AAR 055,
009	6-16-83	2400		0.5(S)	C.O.
010	6-17-83	0430	X	1.1(N)	94 eggs. Relocated to d
011	6-17-83	0330-0600		3.0(N)	C.O.
012	6-18-83	2300	X	3.6(N)	Relocated 8' to dune 129 eggs
013	6-18-83	2400		2.3(N)	C.O.
014	6-18-83	2430		3.7(N)	C.O.
015	6-19-83	2200	X	2.3(S)	Relocated from 2.7(S) 90 eggs Return IBS 813
016	6-19-83	0135	X	2.3(N)	Relocated from 2.0(N) 133 eggs Tags AAR 059, Relocated to dune
017	6-20-83	2300	X	3.6(N)	105 eggs Tags AAR 061, Relocated to dune
018	6-20-83	0230	X	2.3(N)	138 eggs Return IMS768
019	6-20-83	0330-0600		1.6(N)	C.O.
020	6-24-83	2200	X	2.2(N)	Relocated to dune 107 eggs Tags AAR 065, Relocated from 0.7(S)
021	6-26-83	2330	X	2.2(N)	130 eggs

** Retagged AAR 063, 064

Summary of Instructions:

* Location measured to nearest tenth of mile to the north or south of Risely Pier. Record known or estimated time when crawl was made or thought to have occurred. Conduct surveys daily during regular working hours 0800-1630 traveling by four wheel drive vehicle when tide is low. Traverse the beach flood plane in vehicle to avoid leaving tire tracks in the sand.

 


SEA TURTLE INVENTORY
(Crawl Data)

TABLE I
Marine Corps Base
Camp Lejeune, North Carolina

Crawl No.	Date	Time Crawl Occurred	Active Nest	Location#	Comments
022	6-28-83	0200	X	1.0(N)	Relocated to dunes 111 eggs
023	6-30-83	2200		2.6(S)	Return IMS 716, AAR 071 C.O. disturbed turtle
024	6-30-83	0045		1.7(N)	C.O.
025	7-1-83	0200		2.1(N)	C.O. Tags AAR 067, 068
026	7-1-83	2200		2.7(N)	Disturbed turtle C.O. tags AAR 069, 070
027	7-1-83	2130	X	4.0(N)	Relocated to dune 138 eggs Ret. IMS 813, 817
028	7-1-83	2200	X	2.3(N)	Relocated to dune 17 Eggs Ret. IMS 716, AAR 067
029	7-2-83	0030		3.7(N)	C.O.
030	7-2-83	0200		1.6(N)	C.O.
031	7-2-83	0215	X	0.1(N)	Relocated from 0.05(S) 122 eggs Ret. AAR 067, 068
032	7-2-83	0215		0.6(S)	C.O.
033	7-2-83	0215	X	2.1(N)	Return AAR 069, 070 134 eggs
034	7-2-83	2145		1.6(N)	C.O.
035	7-2-83	2245		2.1(N)	C.O.
036	7-2-83	2245	X	2.7(N)	Relocated to dune 135 eggs Ret. AAR 059, 060
037	7-2-83	2315		3.0(N)	C.O. Return IMS 817, 064
038	7-2-83	2330	X	0.6(N)	Relocated from 1.0(S) 137 eggs Tags AAR 072, 073
039	7-3-83	0145	X	0.6(N)	Relocated to dune 99 eggs Ret. IMS 716 AAR 067
040	7-5-83	2400		2.6(N)	C.O.
041	7-5-83	2200	X	3.0(N)	Relocated 14' to dune 119 eggs
042	7-5-83	2300		3.7(N)	C.O.

Summary of Instructions:

* Location measured to nearest tenth of mile to the north or south of Risely Pier. Record known or estimated time when crawl was made or thought to have occurred. Conduct surveys daily during regular working hours 0800-1630 traveling by four wheel drive vehicle when tide is low. Traverse the beach flood plane in vehicle to avoid leaving tire tracks in the sand.

 


SEA TURTLE INVENTORY
(Crawl Data)

TABLE I
Marine Corps Base
Camp Lejeune, North Carolina

Crawl No.	Date	Time Crawl Occurred	Active Nest	Location#	Comments
043	7-5-83	2330	X	3.6(N)	56 eggs
044	7-6-83	0300-0600		0.5(N)	C.O.
045	7-8-83	0100	X	0.4(N)	Relocated to dune 144 eggs Tags AAR 074, 075
046	7-10-83	2400	X	2.3(S)	Relocated from 3.6(S) 128 eggs Ret. AAR 051, 052
047	7-10-83	0100		0.1(S)	C.O.
048	7-11-83	2300		1.5(N)	C.O.
049	7-11-83	0100	X	2.3(N)	101 eggs. Ret. AAR 065, 066
050	7-11-83	2400	X	2.3(N)	Relocated from 4.5(N) 128 eggs
051	7-13-83	0135		4.2(N)	C.O.
052	7-14-83	2400		2.1(N)	C.O.
053	7-15-83	0300-0600		1.7(N)	C.O.
054	7-15-83	0300-0600	X	1.7(N)	Relocated to dune 142 eggs
055	7-16-83	2120		0.4(N)	C.O.
056	7-16-83	2230	X	0.8(N)	Relocated to dune 58 eggs Tags IMS 820, 821
057	7-16-83	2315	X	2.3(N)	Tags IMS 822, 823 117 eggs
058	7-16-83	0040		2.5(N)	C.O.
059	7-16-83	0130	X	0.1(N)	Relocated to dune 116 eggs
060	7-17-83	0300-0600		3.8(N)	C.O. (2 body pits)
061	7-17-83	0300-0600		0.4(N)	C.O.
062	7-17-83	0300-0600		1.2(S)	C.O.
063	7-17-83	2230		0.7(N)	C.O.

Summary of Instructions:

* Location measured to nearest tenth of mile to the north or south of Risely Pier. Record known or estimated time when crawl was made or thought to have occurred. Conduct surveys daily during regular working hours 0800-1630 traveling by four wheel drive vehicle when tide is low. Traverse the beach flood plane in vehicle to avoid leaving tire tracks in the sand.

 


SEA TURTLE INVENTORY
(Crawl Data)

TABLE I
Marine Corps Base
Camp Lejeune, North Carolina

Crawl No.	Date	Time Crawl Occurred	Active Nest	Location*	Comments
064	7-17-83	2200	X	2.6(N)	Relocated from 2.7(N) 119 eggs Ret. AAR 061, 0
065	7-17-83	2330	X	0.4(N)	Relocated to dune 161 eggs Ret. IMS 716, AA
066	7-17-83	2400	X	0.4(N)	Relocated from 3.1(N) 146 eggs Ret. IMS 768, 7
067	7-21-83	2400		1.8(N)	C.O.
068	7-27-83	2300		4.0(N)	C.O. Ret. IMS 817, 064
069	7-27-83	2300		3.7(N)	C.O. Tags AAR 079, 080
070	7-27-83	2300		0.2(S)	C.O. Halfway up beach
071	7-27-83	2400		0.3(N)	C.O.
072	7-28-83	2215		2.2(N)	C.O. Ret. IMS 817, 064
073	7-28-83	2230	X	2.1(N)	Relocated to dune 70 eggs Ret. AAR 079, 080
074	7-28-83	2230	X	0.4(N)	137 eggs Relocated to du
075	7-28-83	2400		2.9(N)	C.O.
076	7-28-83	0200	X	2.7(N)	134 Eggs Ret. AAR 069, 07
077	7-29-83	0030	X	2.9(N)	Relocated to dune 90 eggs Tags AAR 081, 082
078	7-29-83	0200		1.3(N)	C.O.
079	7-29-83	0220	X	0.9(S)	163 eggs Relocated to Du
080	7-30-83	2300	X	2.2(N)	127 eggs Relocated to du
081	7-30-83	2345		2.4(N)	C.O.
082	7-30-83	0300-0600		1.1(S)	C.O.
083	8-3-83	0300-0600		0.1(N)	C.O.
084	8-5-83	2210	X	3.8(N)	140 eggs Relocated to du

Summary of Instructions:

* Location measured to nearest tenth of mile to the north or south of Risely Pier. Record known or estimated time when crawl was made or thought to have occurred. Conduct surveys daily during regular working hours 0800-1630 traveling by four wheel drive vehicle when tide is low. Traverse the beach flood plane in vehicle to avoid leaving tire tracks in the sand.

 

 


TABLE II

RETURN RECORD OF TAGGED TURTLES
1983 SEA TURTLE INVENTORY

<u>Date Tagged</u>	<u>Tag Number</u>	<u>Return</u>	<u>Return</u>	<u>Return</u>	<u>Return</u>
6-30-81 (3)	IMS 746, AAR071	6-30-83 (1)	7-1-83	7-3-83	7-17-83
1981 (4)	IMS 817, 064	7-2-83 (1)	7-27-83 (1)	7-28-83 (1)	
8-1-81 (2)	IMS 768, 769 (AAR 063, 064)	6-20-83	7-17-83		
7-27-82	IMS 813, 814	6-19-83	7-1-83		
6-8-83	AAR 051, 052	7-10-83			
6-15-83	AAR 053, 054				
6-16-83	AAR 055, 056				
6-19-83	AAR 059, 060	7-2-83	8-8-83		
6-20-83	AAR 061, 062	7-17-83			
6-24-83	AAR 065, 066	7-11-83			
7-1-83 (1)	AAR 067, 068	7-2-83			
7-1-83 (1)	AAR 069, 070	7-2-83	7-28-83	8-12-83	
7-2-83	AAR 072, 073				
7-8-83	AAR 074, 075				
7-16-83	IMS 820, 821				
7-16-83	IMS 822, 823				
7-27-83 (1)	AAR 079, 080	7-28-83			
7-29-83	AAR 081, 082				

(1) Did not nest

(2) Retagged

(3) Added one tag

(4) Tagged at Cape Lookout

 


TABLE III

CRAWL INFORMATION IN RELATION TO MOON AND TIDAL CYCLES AND WEATHER CONDITIONS

Date	Moon Rise % Illumin.	Time of High Tide	Time Crawl W/O Nest	Time Crawl W/Nest	Total Crawls	Weather	Temp H2O -
6-8-83	0258 - 13%	1730		2330	1	Fair	70° -
6-11-83	0457 - 00%	1955	0330		1	Fair	70° -
6-13-83	0658 - 15%	2138	0730/0400		2	P/Cloudy	71° -
6-15-83	0919 - 20%	2331	2330	2330/2400	3	Clear	75° -
6-16-83	1029 - 30%	2400	2400	2300	2	Clear	79° -
6-17-83	1137 - 41%	0032	0300	0430	2	Clear	77° -
6-18-83	1242 - 52%	0134	2400/2430	2300	3	Clear	79° -
6-19-83	1346 - 63%	0236		2200/0135	2	P/Cloudy	80° -
6-20-83	1448 - 73%	0336	0330/0600	2300/0230	3	Cloudy	80° -
6-24-83	1849 - 98%	1920		2200	1	Fair	78° -
6-26-83	2034 - 100%	2039		2330	1	P/Cloudy	79° -
6-28-83	2158 - 94%	2154		0200	1	P/Cloudy	79° - 8
6-30-83	2303 - 81%	2314	2200/0045/ 0200		3	P/Cloudy	78° - 7
7-1-83	2340 - 73%	2356	2200/0030/ 0200/0215	2130/2200/ 0215/0215	8	P/Cloudy	79° -
7-2-83	2400 - 65%	0041	2145/2245/ 2315	2245/2330/ 0145	6	-	-
7-5-83	0105 - 35%	0231	2400/2300	2200/2330	4	Cloudy	78° -
7-6-83	0138 - 25%	0326	0330/0600		1	Cloudy	78° -
7-8-83	0301 - 9%	1734		0100	1	Clear	77° - 8
7-10-83	0458 - 0%	1941	0100	2400	2	Cloudy	78° -
7-11-83	0608 - 0%	2032	2300	0100/2400	3	P/Cloudy	79° -
7-13-83	0834 - 9%	2218	0135		1	Clear	75° -
7-14-83	0945 - 17%	2313	2400		1	P/Cloudy	80° -
7-15-83	1052 - 27%	1148	0300/0600	0330/0600	2	Clear	80° -
7-16-83	1157 - 38%	0011	2120/0040/ 0300/0600/ 0300/0600/ 0300/0600	2230/2315/ 0130	8	Clear	78° -

 


TABLE III (continued)

CRAWL INFORMATION IN RELATION TO MOON AND TIDAL CYCLES AND WEATHER CONDITIONS

Date	Moon Rise % Illumin.	Time of High Tide	Time Crawl W/O Nest	Time Crawl W/Nest	Total Crawls	Temp Weather H2O - A
7-17-83	1300 - 49%	0110	2230	2200/2330/ 2400	4	P/Cloudy 80° - 83°
7-21-83	1701 - 86%	1728	2400		1	Clear 80° - 85°
7-27-83	2114 - 96%	2126	2300/2300/ 2300/2400		4	Clear 80° - 70°
7-28-83	2142 - 92%	2201	2215/2400	2230/2230/ 0030	5	Clear 80° - 80°
7-29-83	2210 - 86%	2238	0200	0030/0220	3	Cloudy 76° - 72°
7-30-83	2237 - 79%	2316	2345/0300/ 0600	2200	3	Clear 79° - 80°
8-3-83	0010 - 40%	0150	0300-0600		1	Cloudy 79° - 77°
8-5-83	0138 - 20%	1636		2210	1	Clear 74° - 80°
8-8-83	0455 - 1%	1025	2245/2230		2	P/Cloudy 82° - 82°
8-12-83	0943 - 24%	2252	2400	0130	2	Cloudy 75° - 75°

 


TABLE IV

GROUND SURVEY NUMBERS

(Nights not separated at Midnight)

<u>Date</u>	<u>Crawls/No Nest</u>	<u>Crawls/Nest</u>	<u>Total</u>
6-8-83	0	1	1
6-9-83	0	0	0
6-10-83	0	0	0
6-11-83	1	0	1
6-12-83	0	0	0
6-13-83	2	0	2
6-14-83	0	0	0
6-15-83	1	2	3
6-16-83	1	1	2
6-17-83	1	1	2
6-18-83	2	1	3
6-19-83	0	2	2
6-20-83	1	2	3
6-21-83	0	0	0
6-22-83	0	0	0
6-23-83	0	0	0
6-24-83	0	1	1
6-25-83	0	0	0
6-26-83	0	1	1
6-27-83	0	0	0
6-28-83	0	1	1
6-29-83	0	0	0
6-30-83	3	0	3
7-1-83	4	4	8
7-2-83	3	3	6
7-3-83	0	0	0
7-4-83	0	0	0
7-5-83	2	2	4
7-6-83	1	0	1
7-7-83	0	0	0
7-8-83	0	1	1
7-9-83	0	0	0
7-10-83	1	1	2
7-11-83	1	2	3
7-12-83	0	0	0
7-13-83	1	0	1
7-14-83	1	0	1
7-15-83	1	1	2
7-16-83	5	3	8
7-17-83	1	3	4
7-18-83	0	0	0
7-19-83	0	0	0
7-20-83	0	0	0
7-21-83	1	0	1
7-22-83	0	0	0
7-23-83	0	0	0
7-24-83	0	0	0
7-25-83	0	0	0
7-26-83	0	0	0
7-27-83	4	0	4
7-28-83	2	3	5
7-29-83	1	2	3

 


TABLE IV

GROUND SURVEY NUMBERS

Wights not separated at Ministry

<u>Date</u>	<u>Crawls/No Nest</u>	<u>Crawls/No Nest</u>	<u>Total</u>
7-30-83	2	1	3
7-31-83	0	0	0
8-1-83	0	0	0
8-2-83	0	0	0
8-3-83	1	0	1
8-4-82	0	0	0
8-5-83	0	1	1
8-6-83	0	0	0
8-7-83	0	0	0
8-8-83	2	0	2
8-9-83	0	0	0
8-10-83	0	0	0
8-11-83	0	0	0
8-12-83	1	1	2
8-13-83	0	0	0


 


TABLE V
AERIAL SURVEY

1983

Date	ONSLow BEACH						BROWNS ISLAND						HAMMOCKS BEACH						Weather Condition
	NC	OC	NN	ON	NP	OP	NC	OC	NN	ON	NP	OP	NC	OC	NN	ON	NP	OP	
5-26-83																			Fog/clear
5-31-83															1				Fog/cloudy
6-3-83																1			Fog/cloudy
6-7-83																			Fog/rain/cloudy
6-10-83																			Fog/rain/cloudy
6-13-83	1						1		1	1									Clear
6-17-83			5				2		6						1				Fog/clear
6-22-83			1	5			2		2	7	7		1		2	1			Haze/cloudy
6-24-83									1										Fog/cloudy
6-29-83			1						1		1		1		1				Haze/cloudy
7-5-83	2	1	2	1			2		1						2	2	2		Fog/cloudy
7-7-83							2		1				1		2				Haze/cloudy
7-10-83													3		2		1		Haze/fog/cloudy
7-15-83	2		2										1		3	1	1		Fog/cloudy
7-19-83			1	2			2		4		3		3		3	3		1	Haze/fog/cloudy
7-22-83				1						1	1								Rain/cloudy
7-27-83									1	1	2								Clear
7-29-83	1	2	3				1	1	1	1	2		1		1		1		Clear
8-4-83	1		1				2	4			2				2	1			Rain
8-11-83									3	3		2	2		3				Fog
8-19-83															2	3			Haze
8-23-83																			Fog
8-31-83	Did not make Flight-Weather Range Use																		

 



NEST AND CRAWL ACTIVITY
ONSLOW BEACH, MARINE CORPS BASE
CAMP LEJEUNE, NORTH CAROLINA

Nests - upper map

Crawls no nest - lower map

Dots indicates multiple usage

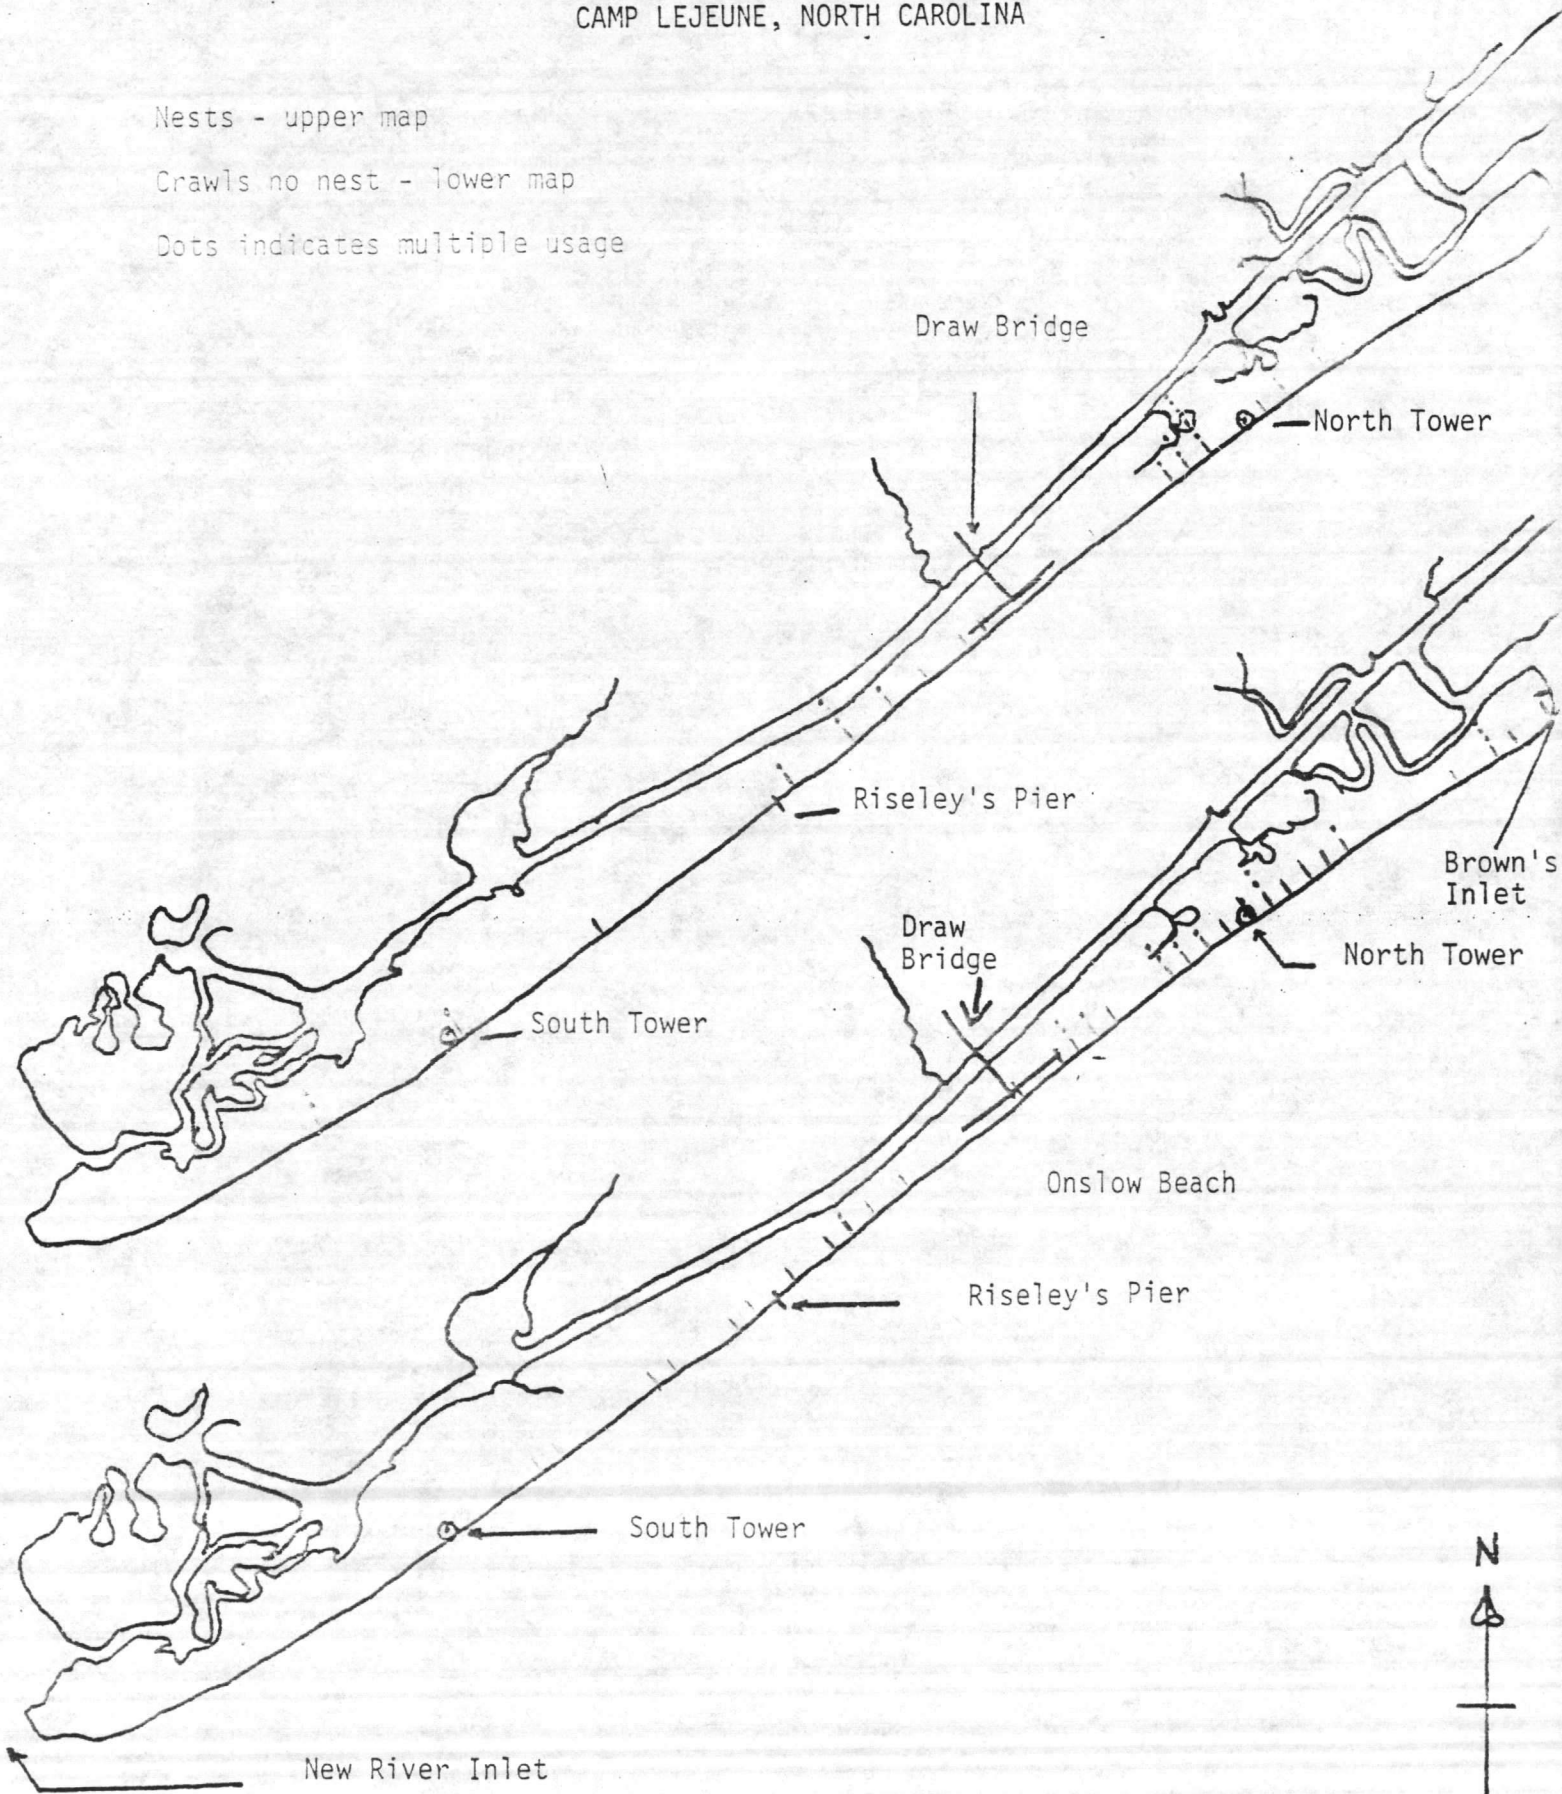

 

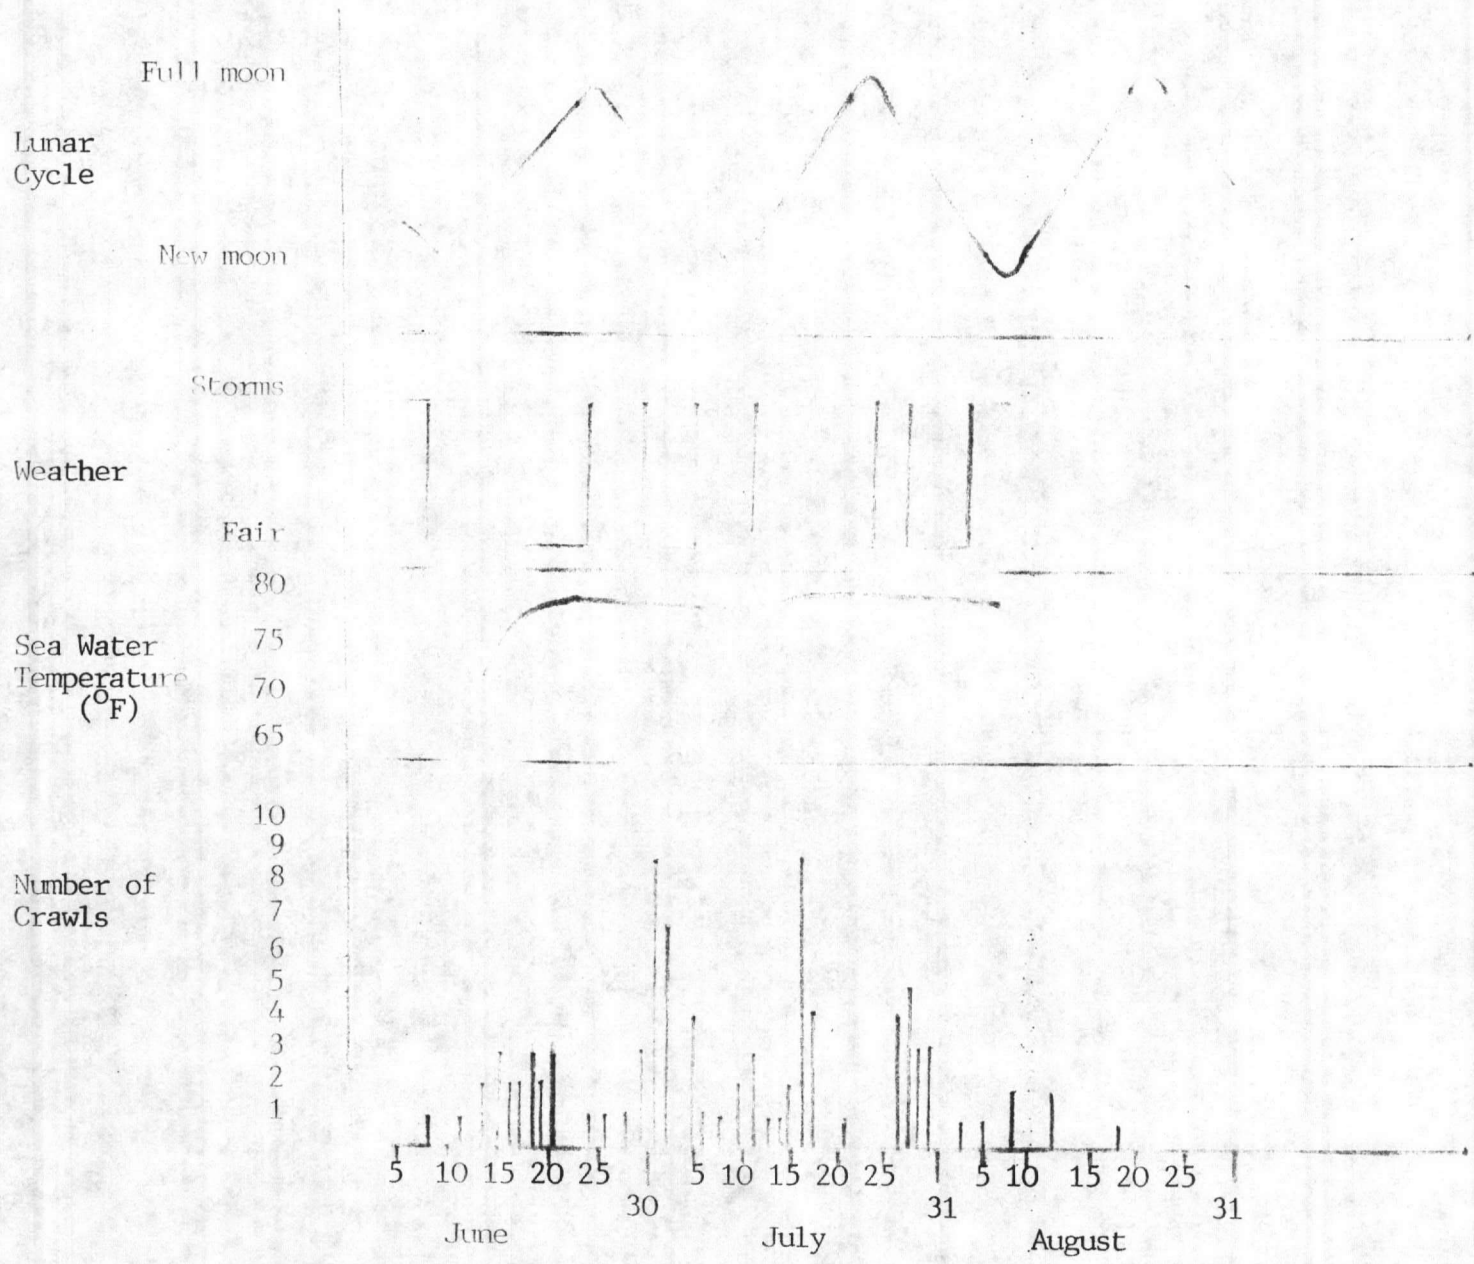
 


Fig. 1. Crawls in relation to lunar cycle, weather and seawater temperature




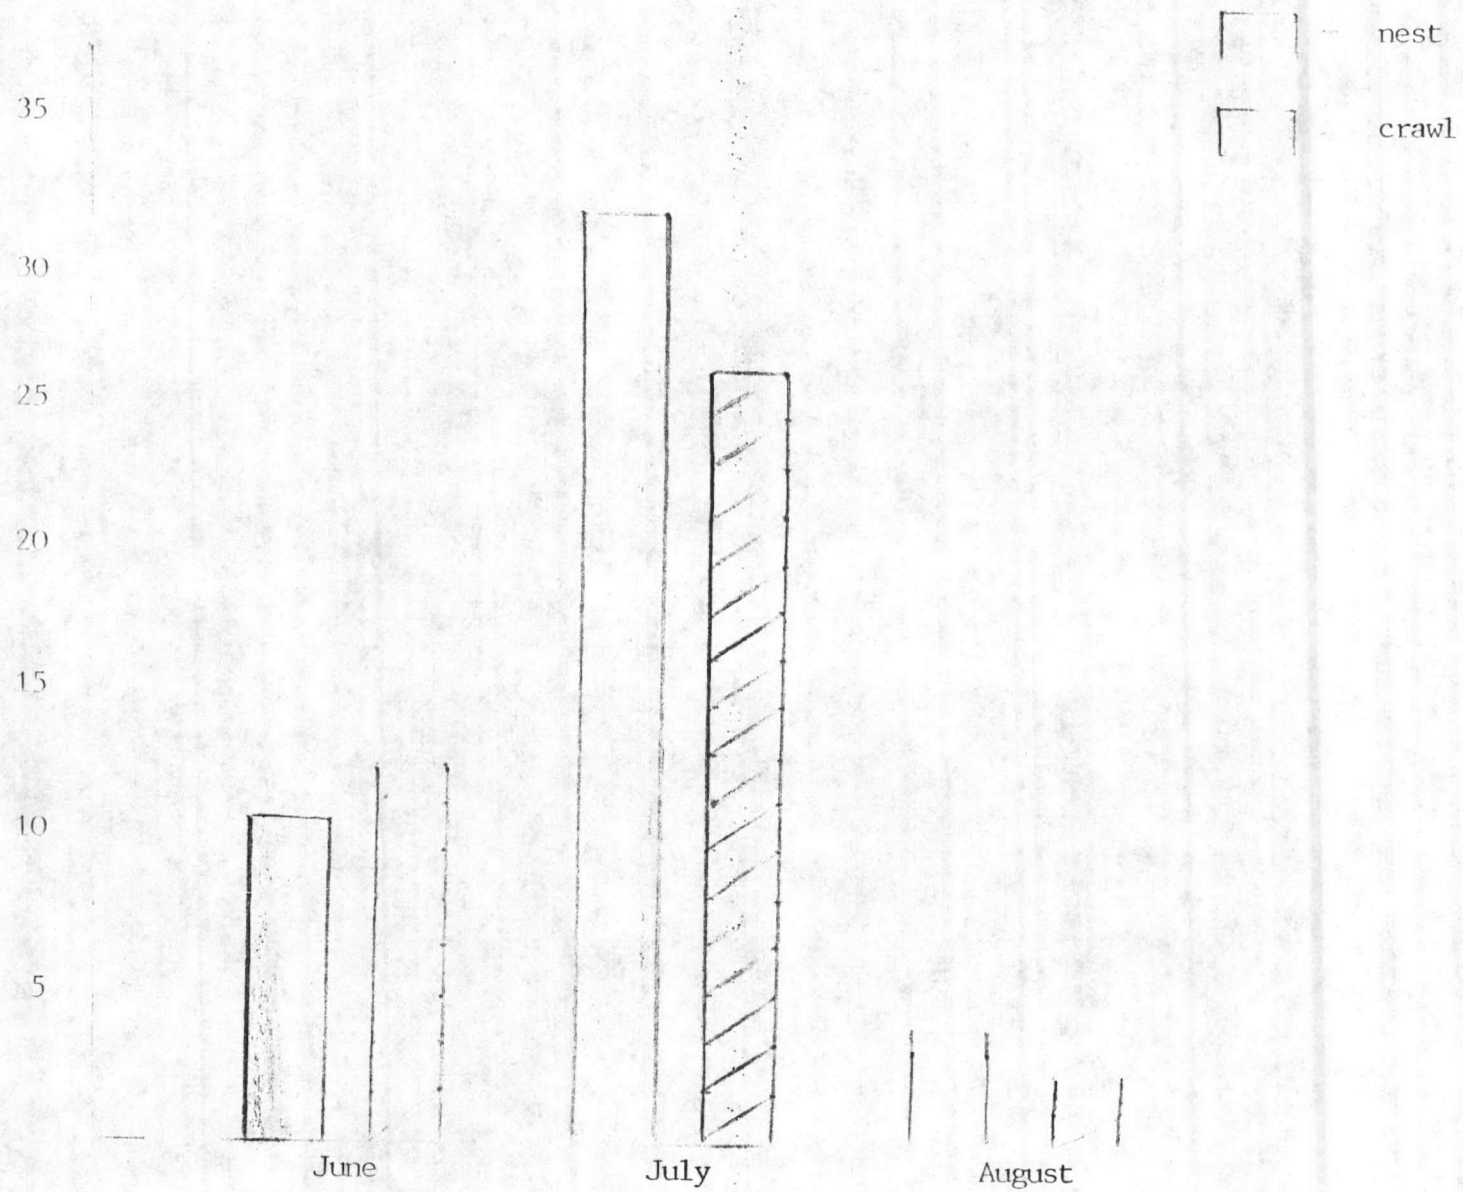


Fig. 2 Total crawls and nests by months

 

AERIAL SURVEY DATA

Date: Sept 26 1980 Time: S 08:00 F 11:00

Recorder Name: Jimmy B. Pugh

Crew Names: None Pilot: J. R. Rios

Co-Pilot: None Crew Chief: None

Others: None

Weather: General 5 miles Fog & Haze Cloud Cover Clear

Wind Speed Less than 5K Sea Conditions Light Chop

BEACH AERIAL SURVEYS Altitude 100 Ft

Air Speed 60 K


Location	Crawls		Nests		Nest Predation	
	New	Old	New	Old	New	Old
Onslow Beach	0	0	0	0	0	0
Browns Island	0	0	0	0	0	0
Bear Beach	0	0	0	0	0	0

OCEAN AERIAL SURVEYS Altitude 400 Ft

Air Speed 60 K

Bell Buoy from Bogue Inlet to New River Inlet	Live Turtles		Dead Turtles
	Juvenile	Adults	
	0	0	0

Comments: _____

 

AERIAL SURVEY DATA

Date: May 31 1982 Time: S 06:00 F 08:30

Recorder Name: H. A. Townsend

Crew Names: None Pilot: Jerry R. Rich

Co-Pilot: None Crew Chief: None

Others: None

Weather: General 4 miles Fog Cloud Cover 2000 SCT

Wind Speed 240 @ 10-12 K Sea Conditions Chop


BEACH AERIAL SURVEYS Altitude 100 Ft
Air Speed 60 K


Location	Crawls		Nests		Nest Predation	
	New	Old	New	Old	New	Old
Onslow Beach	0	0	0	0	0	0
Browns Island	0	0	0	0	0	0
Bear Beach	0	0	1	0	0	0

OCEAN AERIAL SURVEYS Altitude 400 Ft
Air Speed 60 K

	Live Turtles		Dead Turtles
	Juvenile	Adults	
Bell Buoy from Bogue Inlet to New River Inlet			One dead turtle on Browns Island

Comments: _____

 

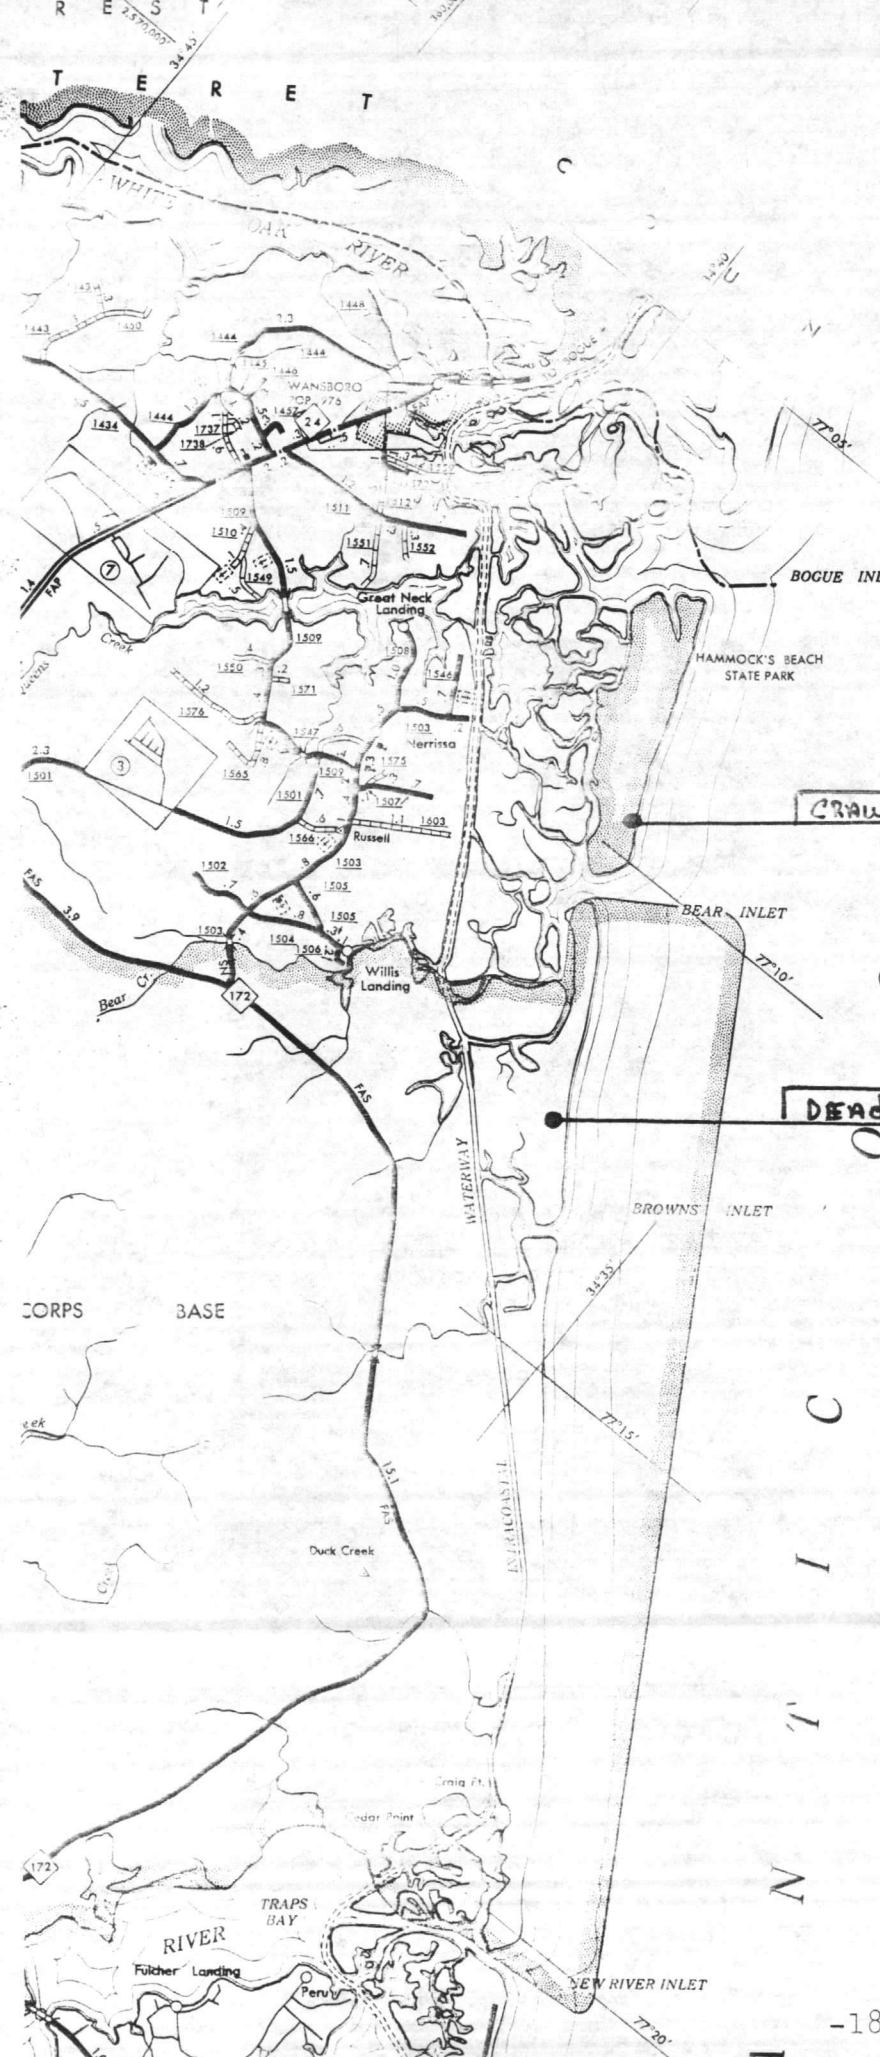

LEGEND

- PRIMITIVE OR UNIMPROVED ROAD
- GRADED AND DRAINED ROAD
- SOIL, GRAVEL OR STONE SURFACED ROAD
- HARD SURFACED ROAD
- 4 LANE UNDIVIDED HIGHWAY
- DIVIDED HIGHWAY
- HIGHWAY WITH FRONTAGE ROADS
- FULL CONTROL ACCESS
- FEDERAL AID INTERSTATE ROAD
- FEDERAL AID PRIMARY ROAD
- FEDERAL AID SECONDARY ROAD
- FEDERAL AID URBAN
- NON-SYSTEM ROAD
- PROJECTED LOCATION
- INTERSECTION DISTANCE
- TRAFFIC CIRCLE
- HIGHWAY INTERCHANGE
- DETAILED HIGHWAY INTERCHANGE
- INTERSTATE HIGHWAY
- U.S. NUMBERED HIGHWAY
- N.C. NUMBERED HIGHWAY
- SECONDARY ROAD NUMBERS
- UNDERGROUND CABLE
- RAILROAD, ANY NUMBER OF TRACKS USED BY SINGLE OPERATING COMPANY
- RAILROAD, ANY NUMBER OF TRACKS USED BY MORE THAN ONE OPERATING COMPANY ON SAME OR ADJACENT RIGHTS-OF-WAY
- RAILROAD STATION
- GRADE CROSSING
- UNDERPASS
- OVERPASS
- RAILROAD TUNNEL
- ARMY, NAVY OR MARINE CORPS FIELD COMM. OR MUNICIPAL AIRPORT
- MARKED AUXILIARY FIELD HANGAR ON FIELD "B" IN SYMBOL
- DOCK, PIER OR LANDING
- FREE OR TOLL FERRY
- LIGHT, NAUTICAL
- LIGHTHOUSE
- COAST GUARD STATION
- CANAL
- NARROW STREAM
- WIDE STREAM
- DAM WITH LOCK
- DAM
- RESERVOIR, POND OR LAKE
- PROMINENT PEAK, NUMERALS INDICATE ELEVATION
- ROAD THROUGH MOUNTAIN PASS
- HIGHWAY BRIDGE, OVER 20 FT.
- DRAW SPAN ON BRIDGE
- HIGHWAY TUNNEL
- FORD
- STATE LINE
- COUNTY LINE
- CITY LIMITS
- RESERVATION OR PARK BOUNDARY
- INSET AREA
- DELIMITED AREA, POPULATION EST.
- COUNTY SEAT
- OTHER TOWNS AND VILLAGES
- TRIANGULATION STATION
- INCORPORATED CITY OR VILLAGE, GENERALIZED
- SCHOOL
- CHURCH
- CHURCH WITH CEMETERY
- CEMETERY
- HOSPITAL
- CORRECTIONAL OR PENAL INSTN.
- HIGHWAY GARAGE, OR MAINT. YARD
- HIGHWAY DIV. OR DIST. OFFICE
- WEIGHT STATION
- PATROL STATION
- REST AREA
- MONUMENT - SMALL HISTORICAL SITE


CRAWL 5-31-83

DEAD Turtle 5-31-83

MAY-31-1983

• - 1 Crawl with dig
 • - 1 DEAD Turtle

J.R. Rich

 

AERIAL SURVEY DATA

Date: June 2 1980 Time: S 04:00 F 08:00

Recorder Name: J. R. Rich

Crew Names: None Pilot: J. R. Rich

Co-Pilot: None Crew Chief: None

Others: None

Weather: General 3 to 5 miles low Cloud Cover 4000 feet

Wind Speed Less than 5 K Sea Conditions calm


BEACH AERIAL SURVEYS Altitude 100 Ft
Air Speed 60 K


Location	Crawls		Nests		Nest Predation	
	New	Old	New	Old	New	Old
Onslow Beach	0	0	0	0	0	0
Browns Island	0	0	0	0	0	0
Bear Beach	0	0	0	1	0	0

OCEAN AERIAL SURVEYS Altitude 1400 Ft
Air Speed 60 K

Location	Live Turtles		Dead Turtles
	Juvenile	Adults	
Bell Buoy from Bogue Inlet to New River Inlet	0	0	1 Dead Turtle Browns Island first seen 5 31 80.

Comments: _____

 

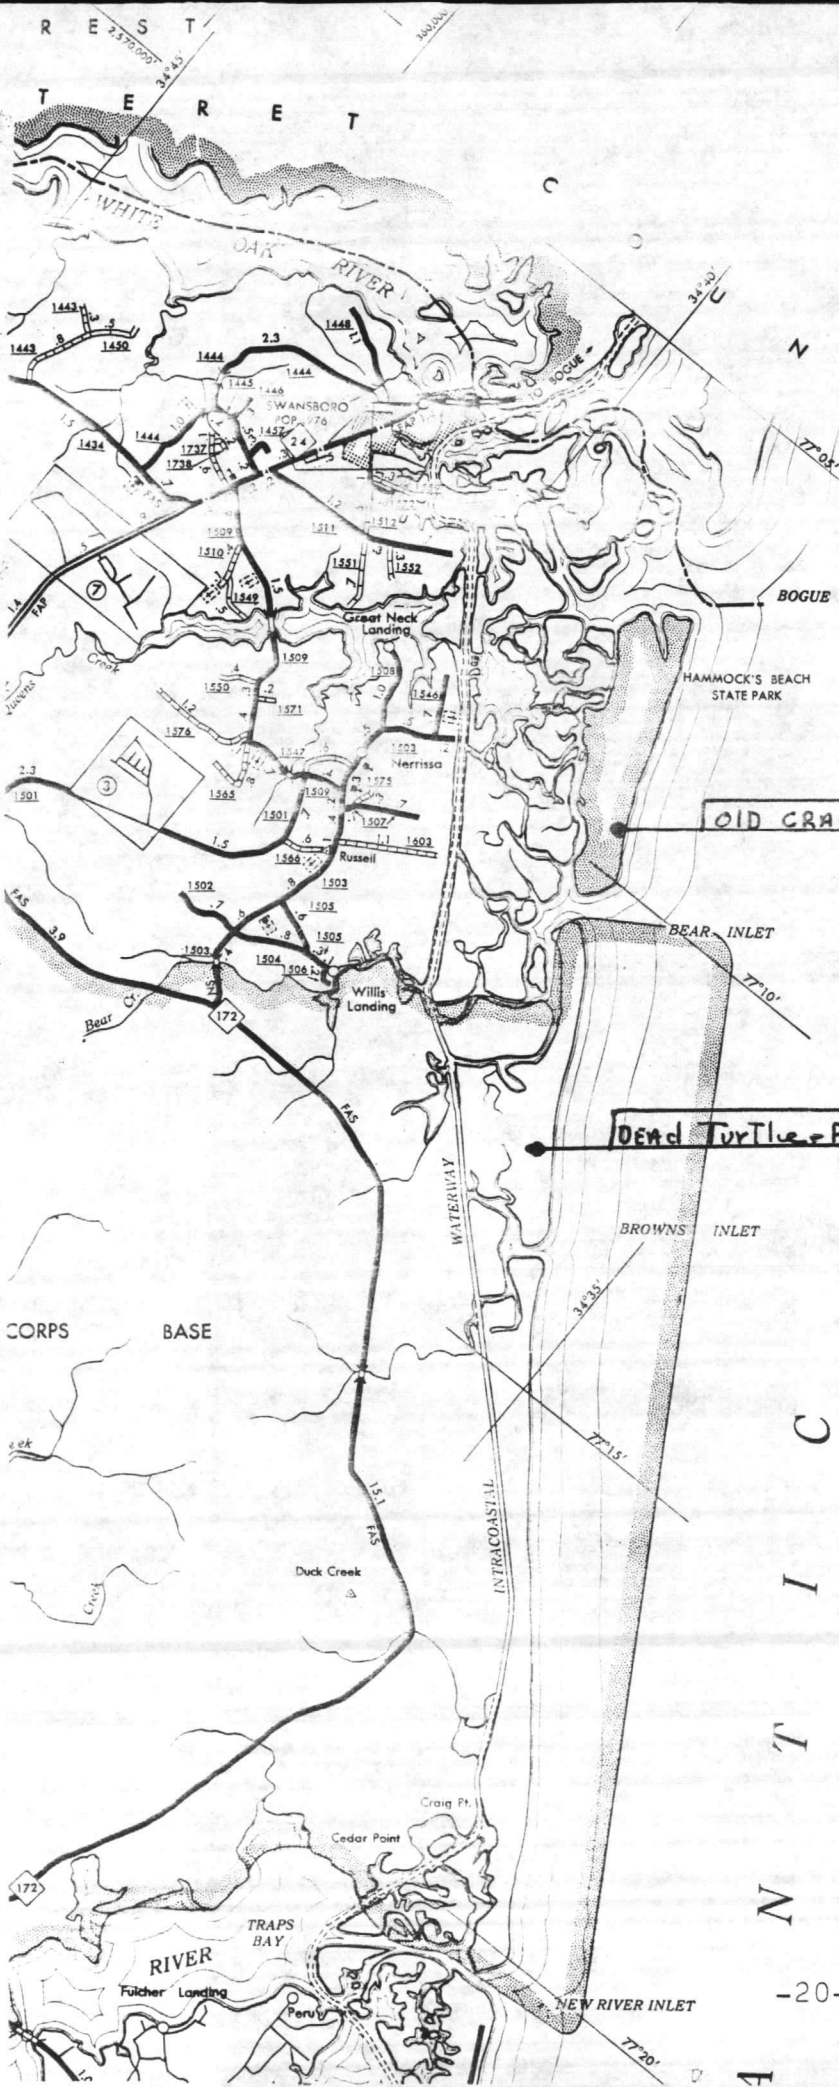

LEGEND


- PRIMITIVE OR UNIMPROVED ROAD
- GRADED AND DRAINED ROAD
- SOIL, GRAVEL OR STONE SURFACED ROAD
- HARD SURFACED ROAD
- 4 LANE UNDIVIDED HIGHWAY
- DIVIDED HIGHWAY
- HIGHWAY WITH FRONTAGE ROADS
- FULL CONTROL ACCESS
- FEDERAL AID INTERSTATE ROAD
- FEDERAL AID PRIMARY ROAD
- FEDERAL AID SECONDARY ROAD
- FEDERAL AID URBAN
- NON-SYSTEM ROAD
- PROJECTED LOCATION
- INTERSECTION DISTANCE
- TRAFFIC CIRCLE
- HIGHWAY INTERCHANGE
- DETAILED HIGHWAY INTERCHANGE
- INTERSTATE HIGHWAY
- U.S. NUMBERED HIGHWAY
- N.C. NUMBERED HIGHWAY
- SECONDARY ROAD NUMBERS
- UNDERGROUND CABLE
- RAILROAD, ANY NUMBER OF TRACKS USED BY SINGLE OPERATING COMPANY
- RAILROAD, ANY NUMBER OF TRACKS USED BY MORE THAN ONE OPERATING COMPANY ON SAME OR ADJACENT RIGHTS-OF-WAY
- RAILROAD STATION
- GRADE CROSSING
- UNDERPASS
- OVERPASS
- RAILROAD TUNNEL
- ARMY, NAVY OR MARINE CORPS FIELD COMM. OR MUNICIPAL AIRPORT
- MARKED AUXILIARY FIELD HANGAR ON FIELD "B" IN SYMBOL
- DOCK, PIER OR LANDING
- FREE OR TOLL FERRY
- LIGHT, NAUTICAL
- LIGHTHOUSE
- COAST GUARD STATION
- CANAL
- NARROW STREAM
- WIDE STREAM
- DAM WITH LOCK
- DAM
- RESERVOIR, POND OR LAKE
- PROMINENT PEAK, NUMERALS INDICATE ELEVATION
- ROAD THROUGH MOUNTAIN PASS
- HIGHWAY BRIDGE, OVER 20 FT.
- DRAW SPAN ON BRIDGE
- HIGHWAY TUNNEL
- FORD
- STATE LINE
- COUNTY LINE
- CITY LIMITS
- RESERVATION OR PARK BOUNDARY
- INSET AREA
- DELIMITED AREA, POPULATION EST.
- COUNTY SEAT
- OTHER TOWNS AND VILLAGES
- TRIANGULATION STATION
- INCORPORATED CITY OR VILLAGE, GENERALIZED
- SCHOOL
- CHURCH
- CHURCH WITH CEMETERY
- CEMETERY
- HOSPITAL
- CORRECTIONAL OR PENAL INSTN.
- HIGHWAY GARAGE, OR MAINT. YARD
- HIGHWAY DIV. OR DIST. OFFICE
- WEIGHT STATION
- PATROL STATION
- REST AREA
- MONUMENT - SMALL HISTORICAL SITE

OLD CRAWL - FIRST SEEN 5-31-83

DEAD Turtle - FIRST SEEN 5-31-83

June-3-83 J.R. Rich

- - OLD CRAWL with Dig - FIRST SEEN 5-31-83
- - DEAD Turtle - FIRST SEEN 5-31-83

 

AERIAL SURVEY DATA

Date: June 7 1933 Time: 8:00 AM

Recorder Name: Jerry R. Rich

Crew Names: None Pilot: _____

Co-Pilot: None Crew Chief: _____

Others: None

Weather: General 3-4 miles fog & rain Cloud Cover 2000 3000 5000 0%

Wind Speed WSW 12-15 K Sea Conditions White caps

BEACH AERIAL SURVEYS Altitude 100 Ft

Air Speed 60 K


Location	Crawls		Nests		Nest Predation	
	New	Old	New	Old	New	Old
Onslow Beach	0	0	0	0	0	0
Browns Island	0	0	0	0	0	0
Bear Beach	0	0	0	0	0	0


OCEAN AERIAL SURVEYS Altitude 400 Ft

Air Speed 60 K

	Live Turtles		Dead Turtles
	Juvenile	Adults	
Bell Buoy from Bogue Inlet to New River Inlet	0	0	One old dead turtle first seen 5-31-33 on Browns Island. One New dead turtle on Browns Island.

Comments: _____

 


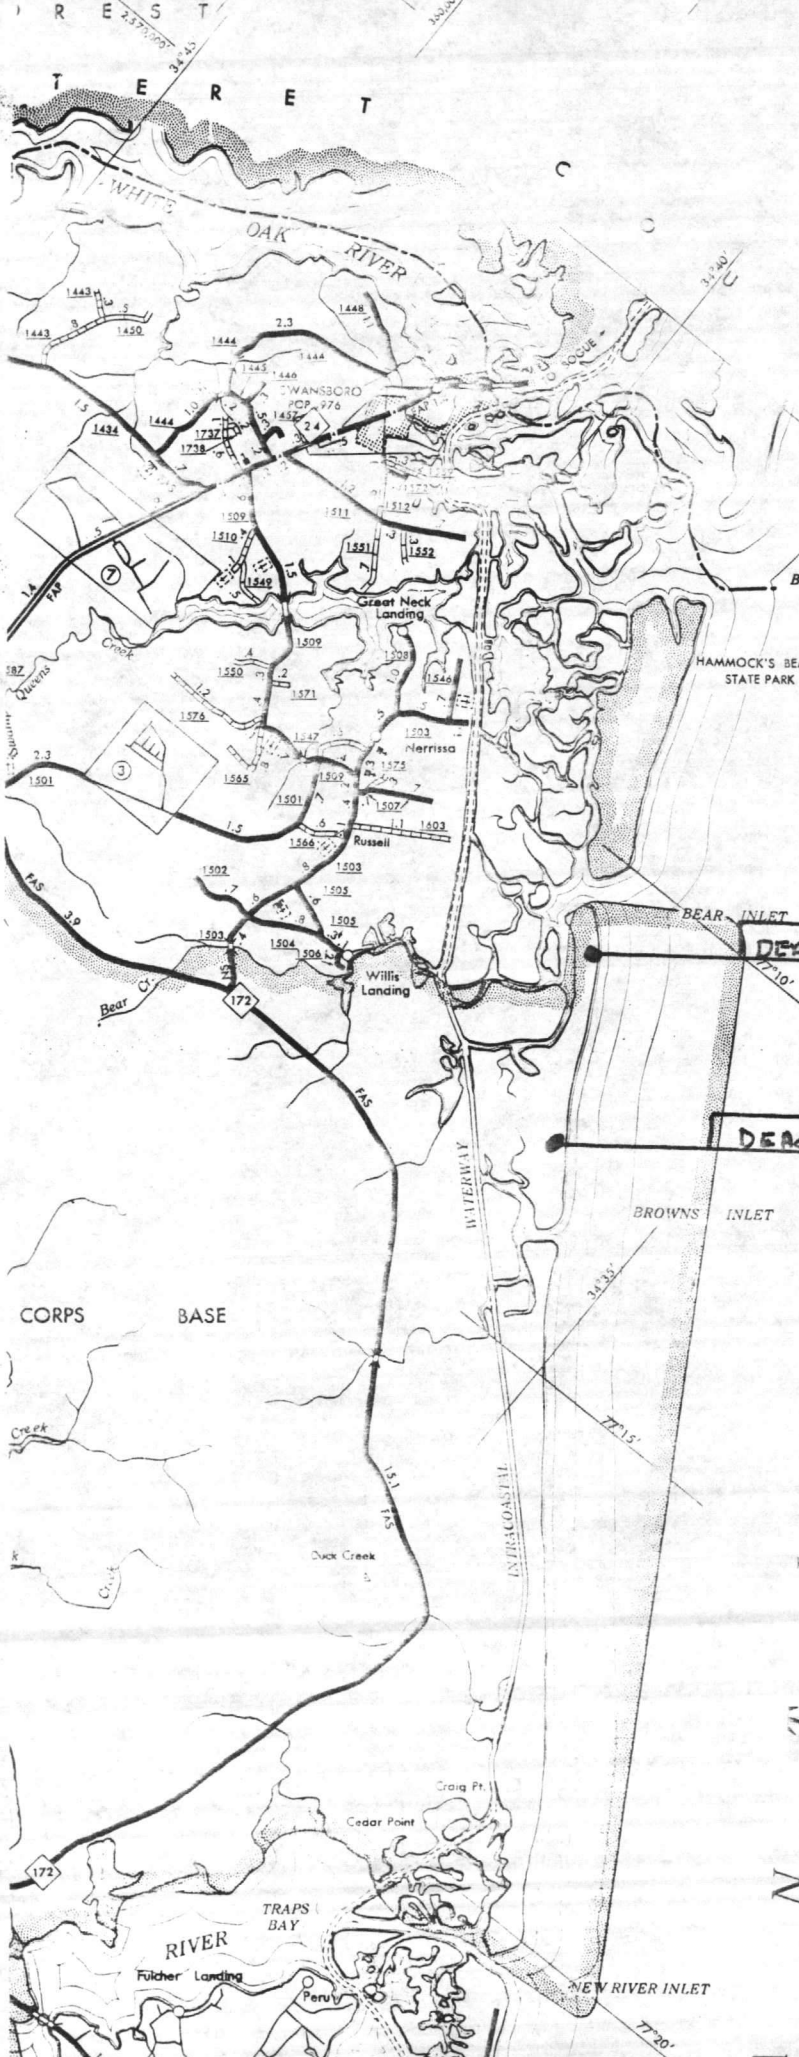

LEGEND

- PRIMITIVE OR UNIMPROVED ROAD
- GRADED AND DRAINED ROAD
- SOIL, GRAVEL OR STONE SURFACED ROAD
- HARD SURFACED ROAD
- 4 LANE UNDIVIDED HIGHWAY
- DIVIDED HIGHWAY
- HIGHWAY WITH FRONTAGE ROADS
- FULL CONTROL ACCESS
- FEDERAL AID INTERSTATE ROAD
- FEDERAL AID PRIMARY ROAD
- FEDERAL AID SECONDARY ROAD
- FEDERAL AID URBAN
- NON-SYSTEM ROAD
- PROJECTED LOCATION
- INTERSECTION LOCATION
- TRAFFIC CIRCLE
- HIGHWAY INTERCHANGE
- DETAILED HIGHWAY INTERCHANGE
- INTERSTATE HIGHWAY
- U.S. NUMBERED HIGHWAY
- N.C. NUMBERED HIGHWAY
- SECONDARY ROAD NUMBERS
- UNDERGROUND CABLE
- RAILROAD, ANY NUMBER OF TRACKS USED BY SINGLE OPERATING COMPANY
- RAILROAD, ANY NUMBER OF TRACKS USED BY MORE THAN ONE OPERATING COMPANY ON SAME OR ADJACENT RIGHTS-OF-WAY
- RAILROAD STATION
- GRADE CROSSING
- UNDERPASS
- OVERPASS
- RAILROAD TUNNEL
- ARMY, NAVY OR MARINE CORPS FIELD
- COMM. OR MUNICIPAL AIRPORT
- MARKED AUXILIARY FIELD
- HANGAR ON FIELD "B" IN SYMBOL
- DOCK, PIER OR LANDING
- FREE OR TOLL FERRY
- LIGHT, NAUTICAL
- LIGHTHOUSE
- COAST GUARD STATION
- CANAL
- NARROW STREAM
- WIDE STREAM
- DAM WITH LOCK
- DAM
- RESERVOIR, POND OR LAKE
- PROMINENT PEAK, NUMERALS INDICATE ELEVATION
- ROAD THROUGH MOUNTAIN PASS
- HIGHWAY BRIDGE, OVER 20 FT.
- DRAW SPAN ON BRIDGE
- HIGHWAY TUNNEL
- FORD
- STATE LINE
- COUNTY LINE
- CITY LIMITS
- RESERVATION OR PARK BOUNDARY
- INSET AREA
- DELIMITED AREA, POPULATION EST.
- COUNTY SEAT
- OTHER TOWNS AND VILLAGES
- TRIANGULATION STATION
- INCORPORATED CITY OR VILLAGE, GENERALIZED
- SCHOOL
- CHURCH
- CHURCH WITH CEMETERY
- CEMETERY
- HOSPITAL
- CORRECTIONAL OR PENAL INSTN.
- HIGHWAY GARAGE, OR MAINT. YARD
- HIGHWAY DIV. OR DIST. OFFICE
- WEIGHT STATION
- PATROL STATION
- REST AREA
- MONUMENT - SMALL HISTORICAL SITE

June-7-83 J.B. Rich
 • Two DEAD Turtles, ONE NEW, ONE FIRST SEEN 5-31-93

 

AERIAL SURVEY DATA

Date: June 10 1980 Time: S 06:06 F 09:00

Recorder Name: Jerry R. Rice

Crew Names: None Pilot: J. R. Rice

Co-Pilot: None Crew Chief: None

Others: None

Weather: General 2 miles rain at 1000 Cloud Cover 500 070

Wind Speed N.E. 15-20 K Sea Conditions White caps

BEACH AERIAL SURVEYS Altitude 100 Ft

Air Speed 60 K


Location	Crawls		Nests		Nest Predation	
	New	Old	New	Old	New	Old
Onslow Beach	0	0	0	0	0	0
Browns Island	0	0	0	0	0	0
Bear Beach	0	0	0	0	0	0

OCEAN AERIAL SURVEYS Altitude 200 Ft

Air Speed 60 K

	Live Turtles		Dead Turtles
	Juvenile	Adults	
Bell Buoy from Bogue Inlet to New River Inlet	0	0	2 Dead Turtle on Browns Island. Same two turtle seen on June 7 33

Comments: _____

 

AERIAL SURVEY DATA

Date: June 10, 1983 Time: S 08:01 F 08:01

Recorder Name: Jerry R. Rion

Crew Names: None Pilot: J. R. Rion

Co-Pilot: None Crew Chief: None

Others: None

Weather: General Clear 10 miles vis. Cloud Cover None

Wind Speed NE 5 K Sea Conditions Light chop

BEACH AERIAL SURVEYS Altitude 100 Ft

Air Speed 60 K


Location	Crawls		Nests		Nest Predation	
	New	Old	New	Old	New	Old
Onslow Beach	1	0	0	0	0	0
Browns Island	1	0	1	1	0	0
Bear Beach	0	0	0	0	0	0


OCEAN AERIAL SURVEYS Altitude 300 Ft

Air Speed 60 K

	Live Turtles		Dead Turtles
	Juvenile	Adults	
Bell Buoy from Bogue Inlet to New River Inlet	0	0	1 dead turtle Bear Beach 2 dead turtle Browns Island, same two as reported June 10 1983

Comments: _____

 

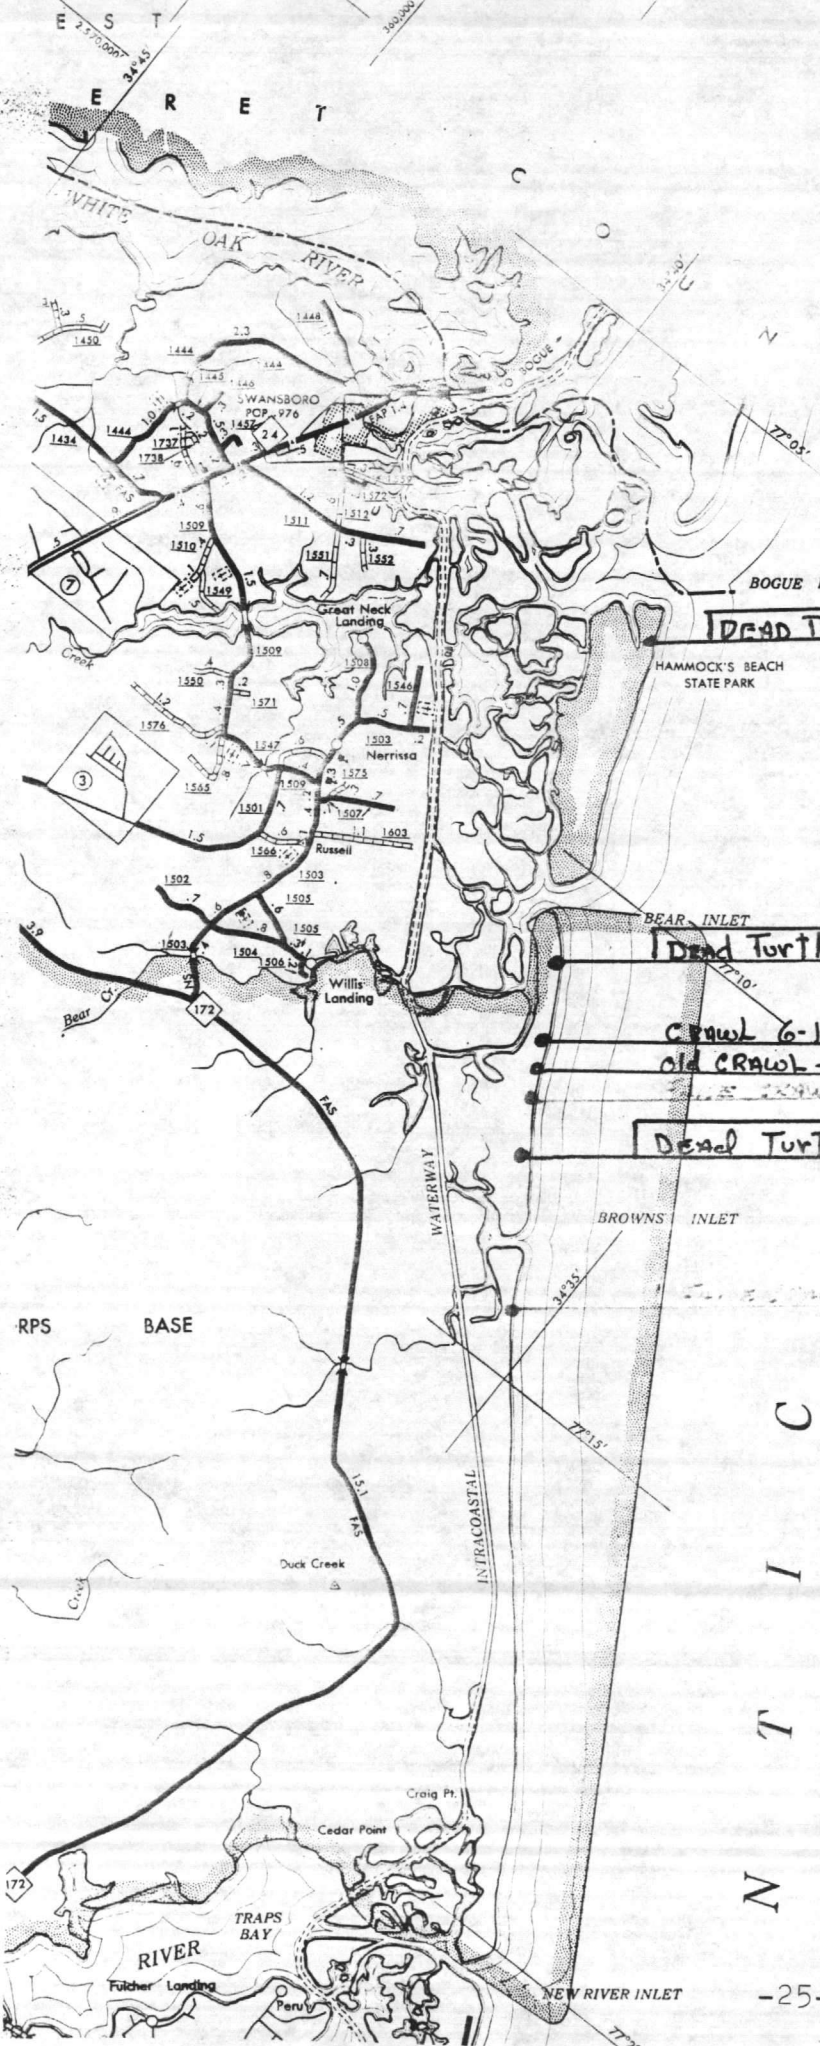




6-13-83 J.R. Biehl

- - THREE DEAD Turtles, ONE NEW, TWO old.
- - TWO CRAWLS WITH NEST.
- -

 



NEST AND CRAWL ACTIVITY
ONSLow BEACH, MARINE CORPS BASE
CAMP LEJEUNE, NORTH CAROLINA

Nests - upper map

Crawls no nest - lower map

Dots indicates multiple usage

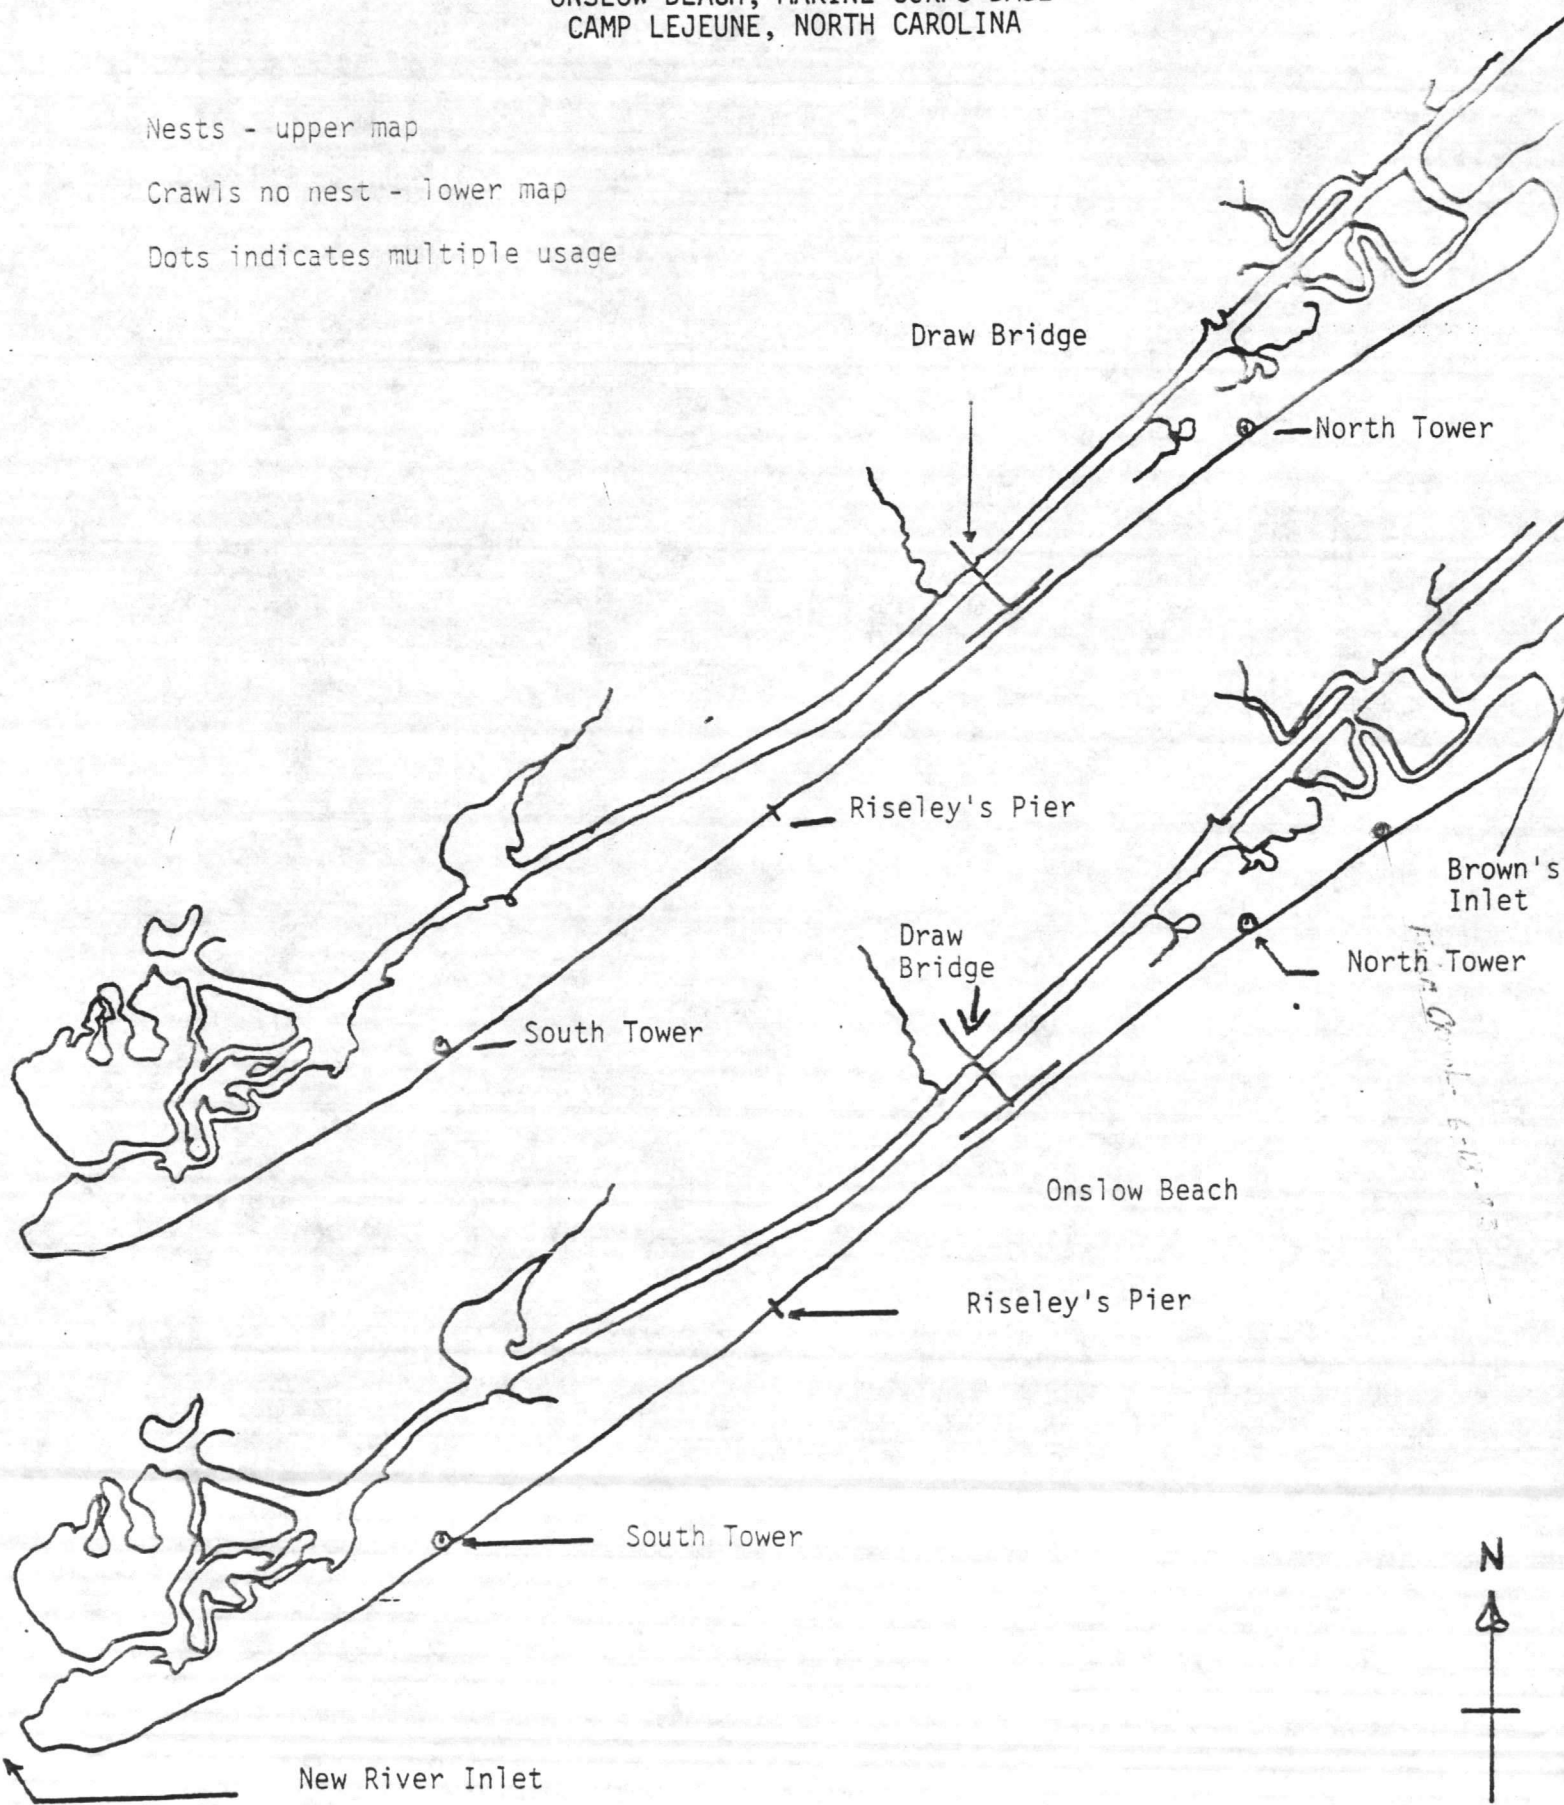

 

AERIAL SURVEY DATA

Date: June 17 30 Time: S 08:00 F 00:15

Recorder Name: H. A. Townsend

Crew Names: None Pilot: H. A. Townsend

Co-Pilot: None Crew Chief: None

Others: None

Weather: General 4 miles fog Cloud Cover clear

Wind Speed calm Sea Conditions Calm

BEACH AERIAL SURVEYS

Altitude 100 Ft

Air Speed 60 K

Location	Crawls		Nests		Nest Predation	
	New	Old	New	Old	New	Old
Onslow Beach	0	0	5	0	0	0
Browns Island	2	0	6	0	0	0
Bear Beach	0	0	1	0	0	0


OCEAN AERIAL SURVEYS

Altitude 400 Ft

Air Speed 60 K

	Live Turtles		Dead Turtles
	Juvenile	Adults	
Bell Buoy from Bogue Inlet to New River Inlet	0	0	0


Comments: _____

 

S T
E R E T



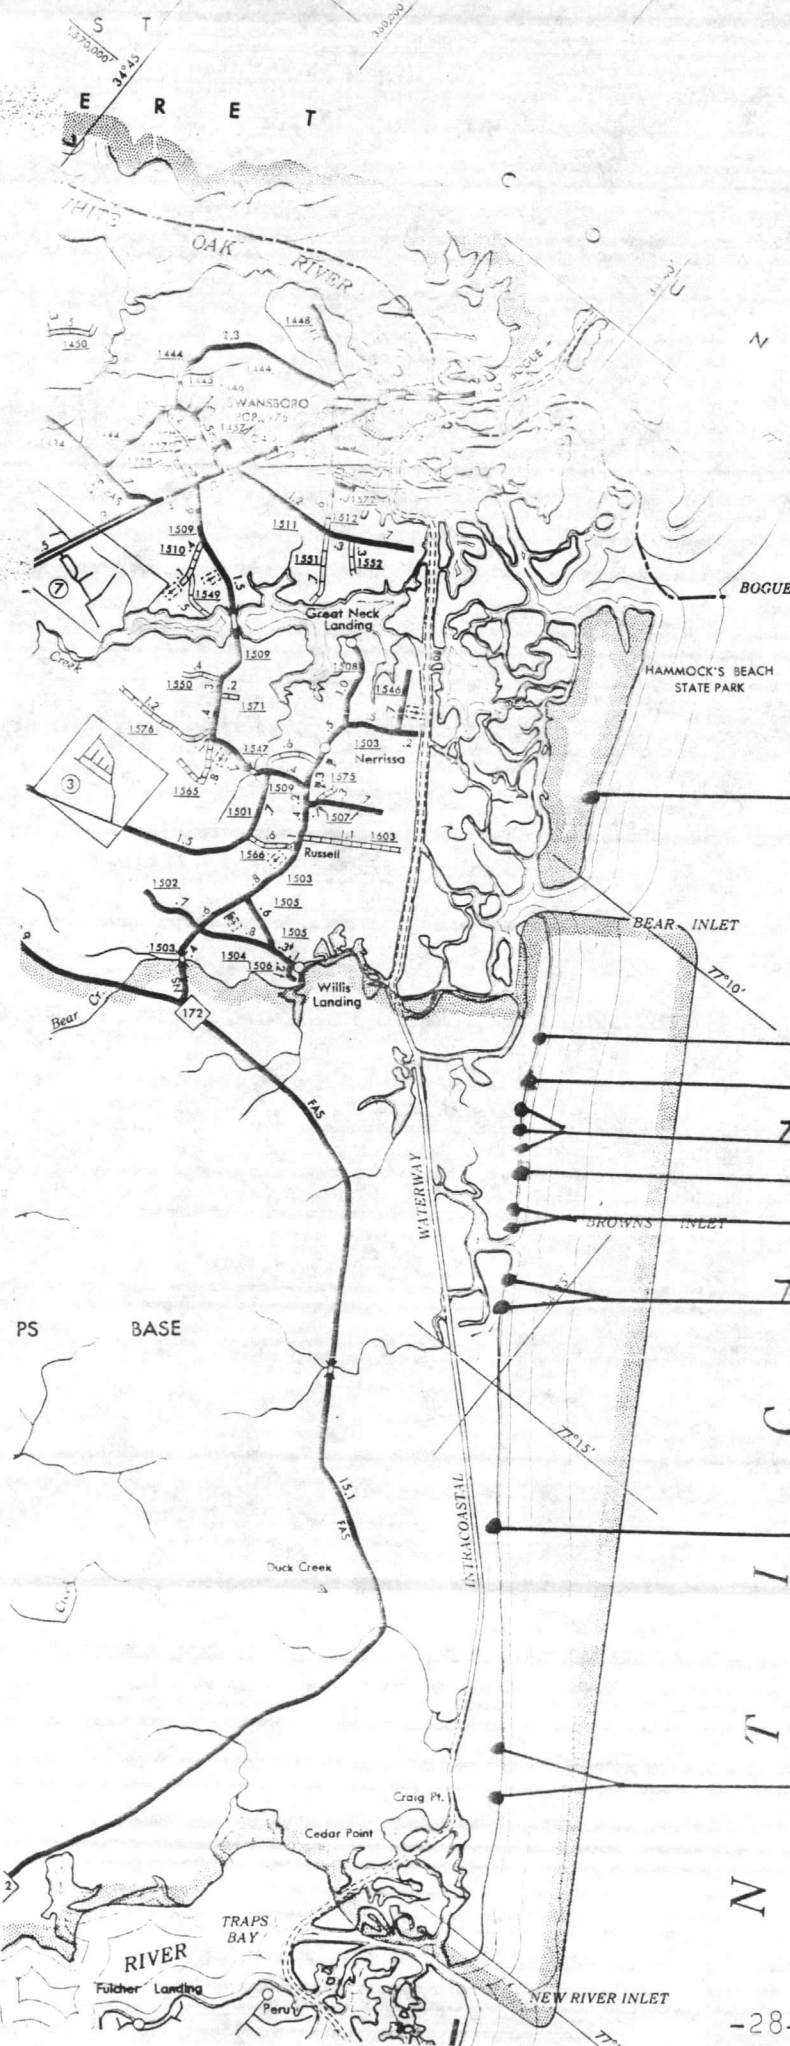

CRAWL- 6-17-83

CRAWL- 6-17-83

FALSE CRAWL- 6-17-83

THREE CRAWLS- 6-17-83

FALSE CRAWL- 6-17-83

TWO CRAWLS- 6-17-83

TWO CRAWLS- 6-17-83


CRAWL- 6-17-83

TWO CRAWLS- 6-17-83

6-17-83 - Flight by H.A. Townsend


• - 12 CRAWLS with NEST 6-17-83


o -

 

NEST AND CRAWL ACTIVITY
 ONSLOW BEACH, MARINE CORPS BASE
 CAMP LEJEUNE, NORTH CAROLINA

Nests - upper map
 Crawls no nest - lower map
 Dots indicates multiple usage

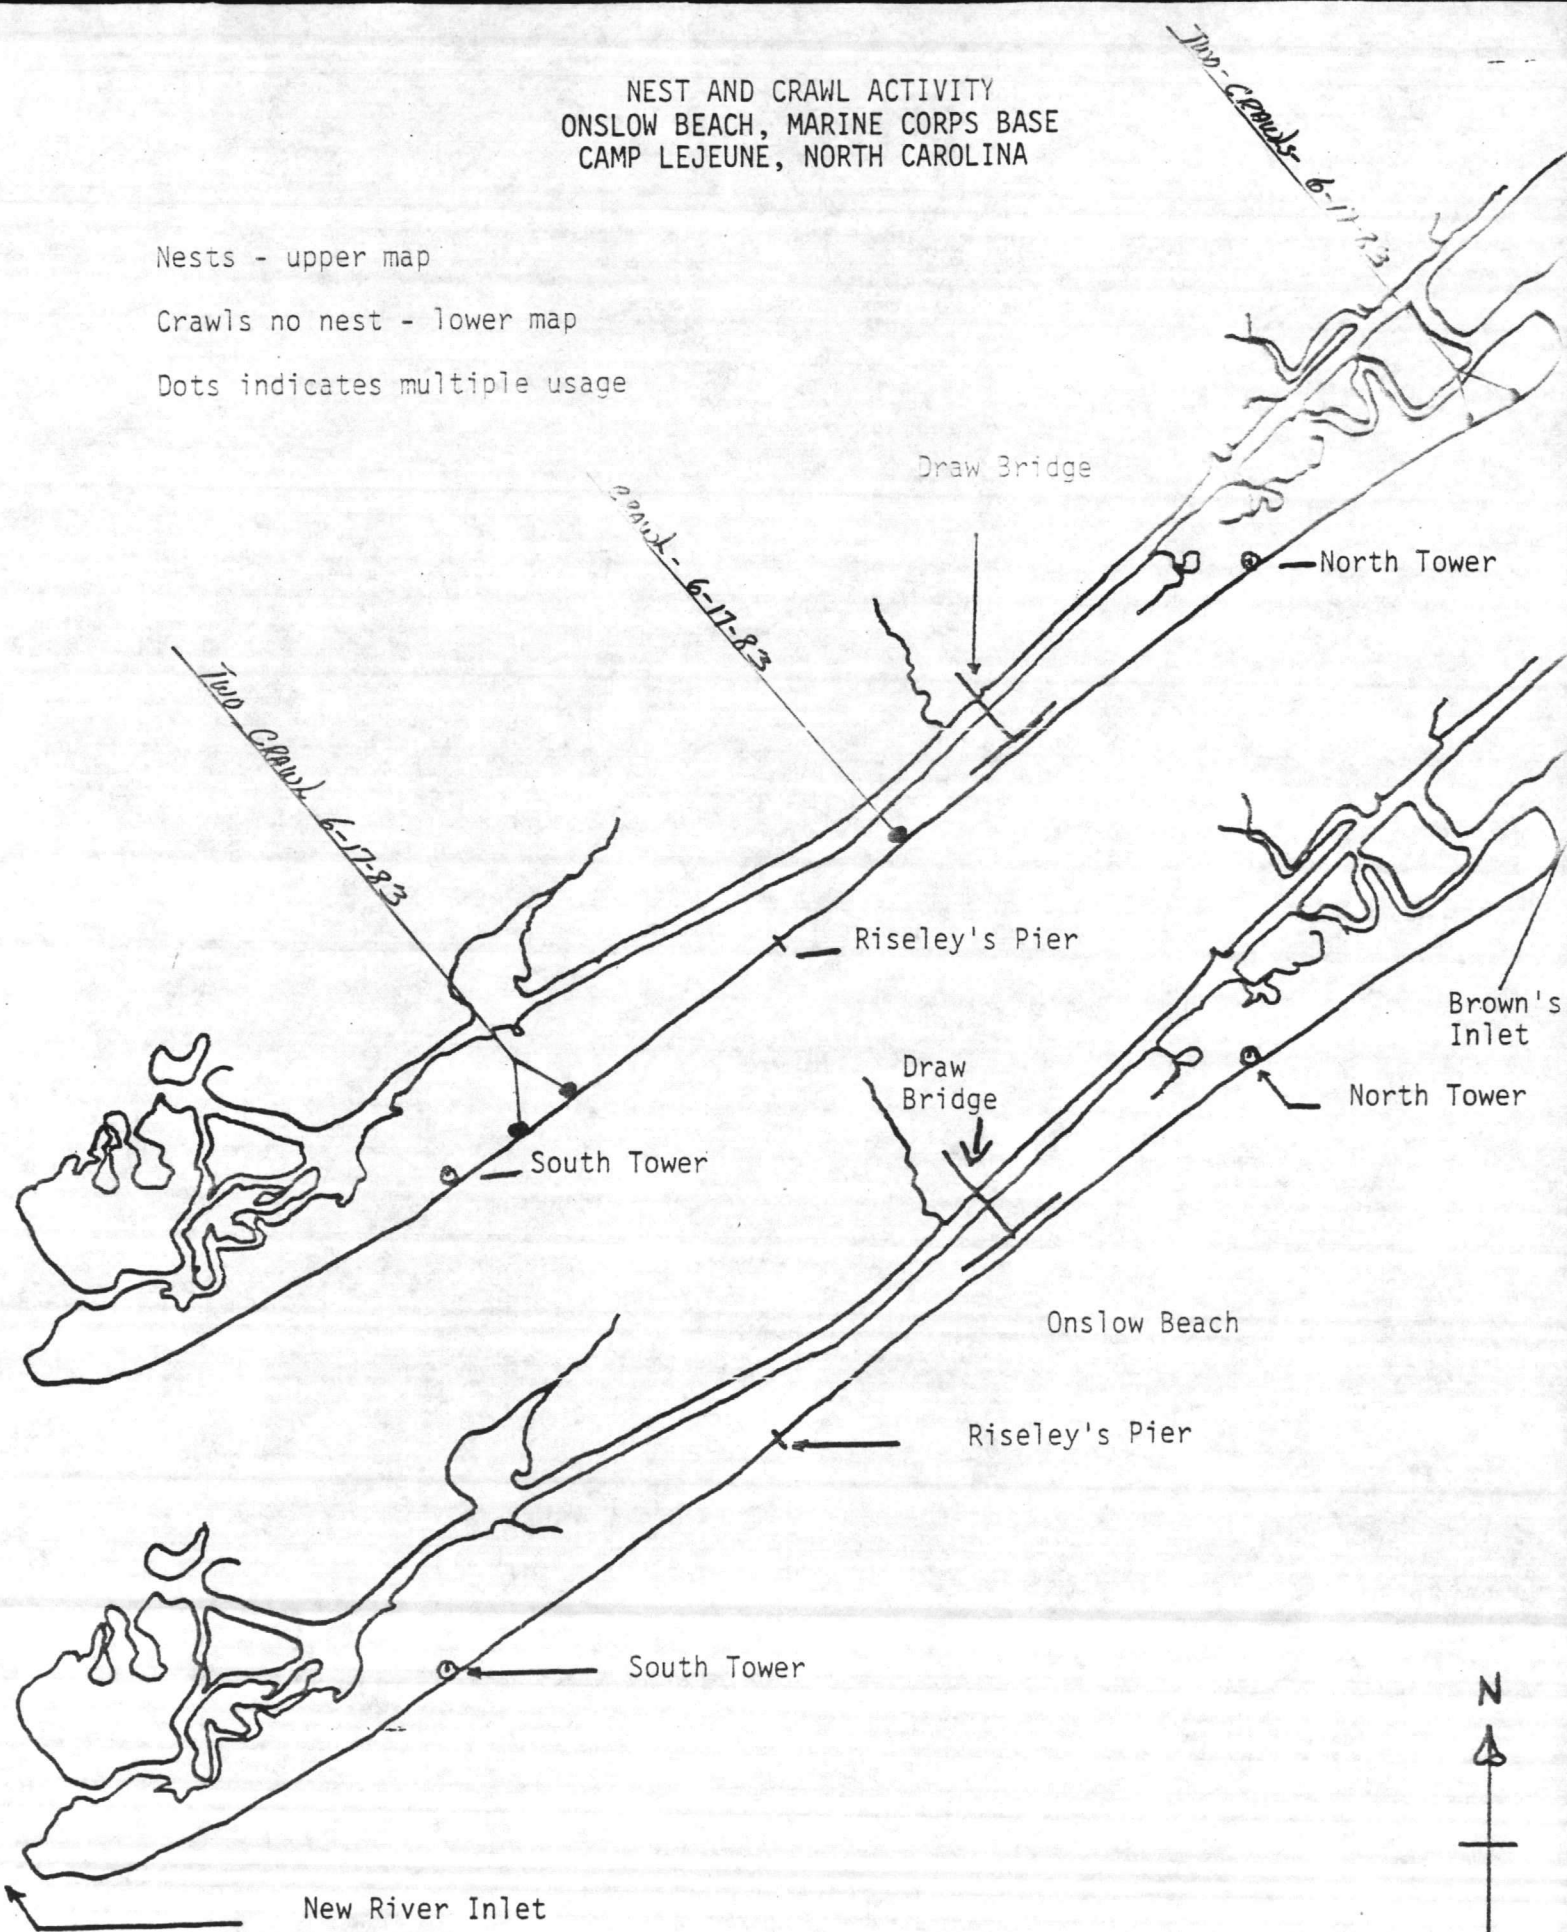

 

AERIAL SURVEY DATA

Date: June 22 83 Time: S 06:05 F 08:10

Recorder Name: Jerry R. Rich

Crew Names: None Pilot: J. R. Rich

Co-Pilot: None Crew Chief: None

Others: None

Weather: General 3 miles vis. Cloud Cover 1000 Set 2000 HLT

Wind Speed NW 8-12 K Sea Conditions Mod chop

BEACH AERIAL SURVEYS Altitude 100 Ft

Air Speed 60 K


Location	Crawls		Nests		Nest Predation	
	New	Old	New	Old	New	Old
Onslow Beach	0	0	1	5	0	0
Browns Island	2	0	2	7	7	0
Bear Beach	1	0	2	1	0	0

OCEAN AERIAL SURVEYS Altitude 300 Ft

Air Speed 60 K

Location	Live Turtles		Dead Turtles
	Juvenile	Adults	
Bell Buoy from Bogue Inlet to New River Inlet	None	None	None

Comments: Saw one large grey fox digging out eggs on Browns Island

 



NEST AND CRAWL ACTIVITY
ONSLow BEACH, MARINE CORPS BASE
CAMP LEJEUNE, NORTH CAROLINA

Nests - upper map

Crawls no nest - lower map


Dots indicates multiple usage

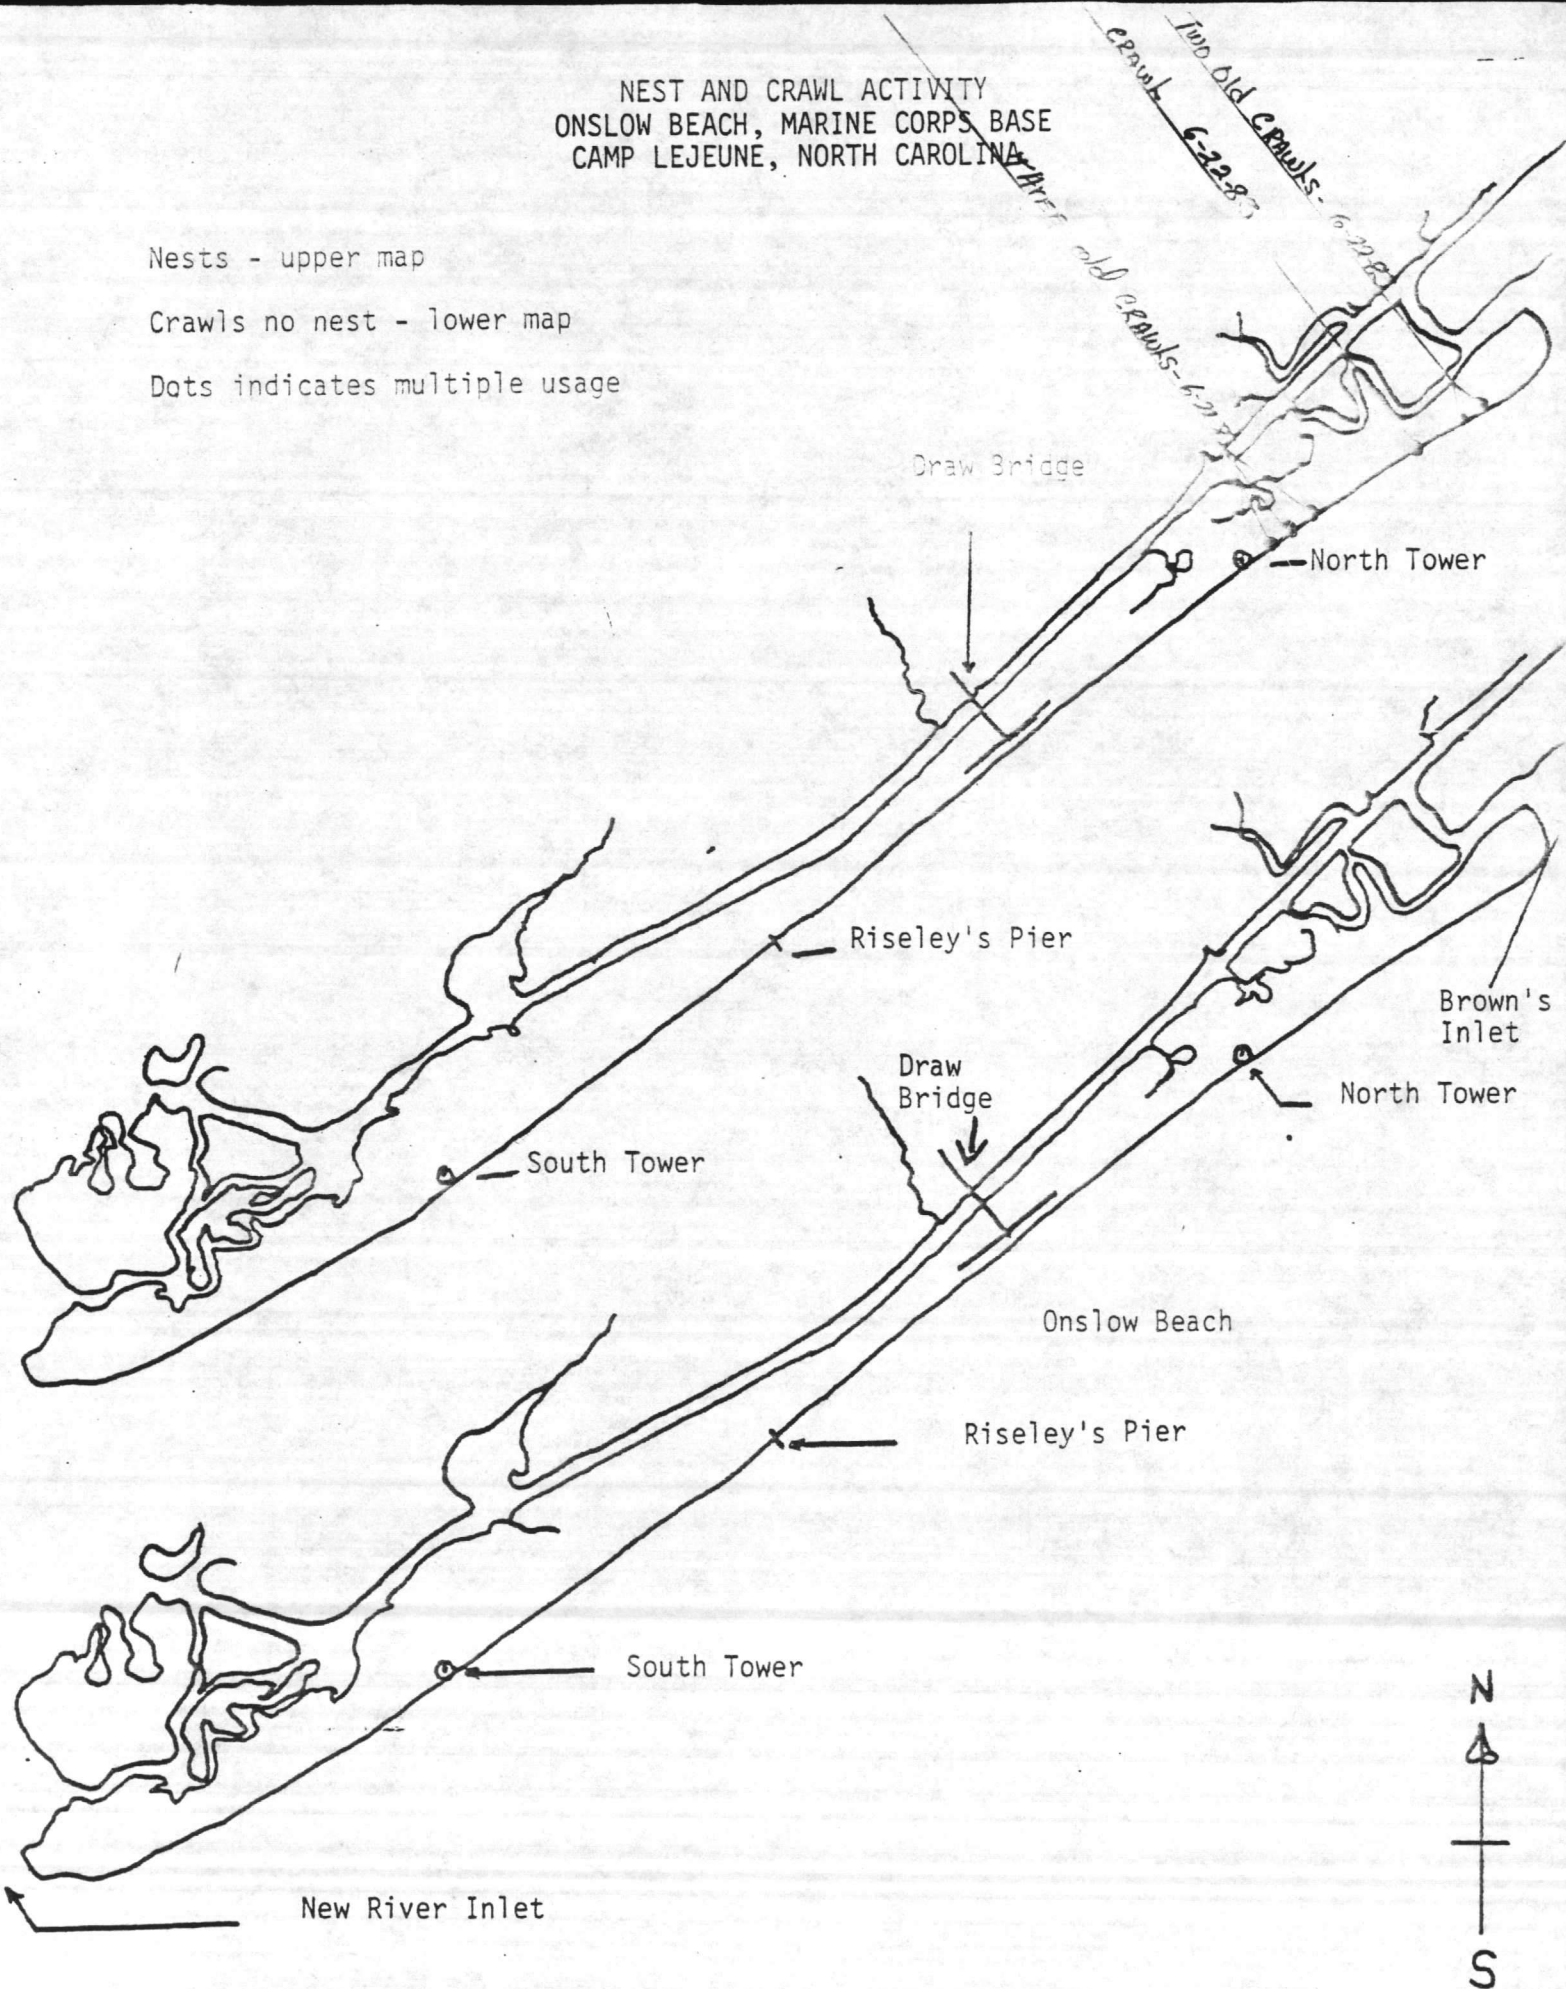

 




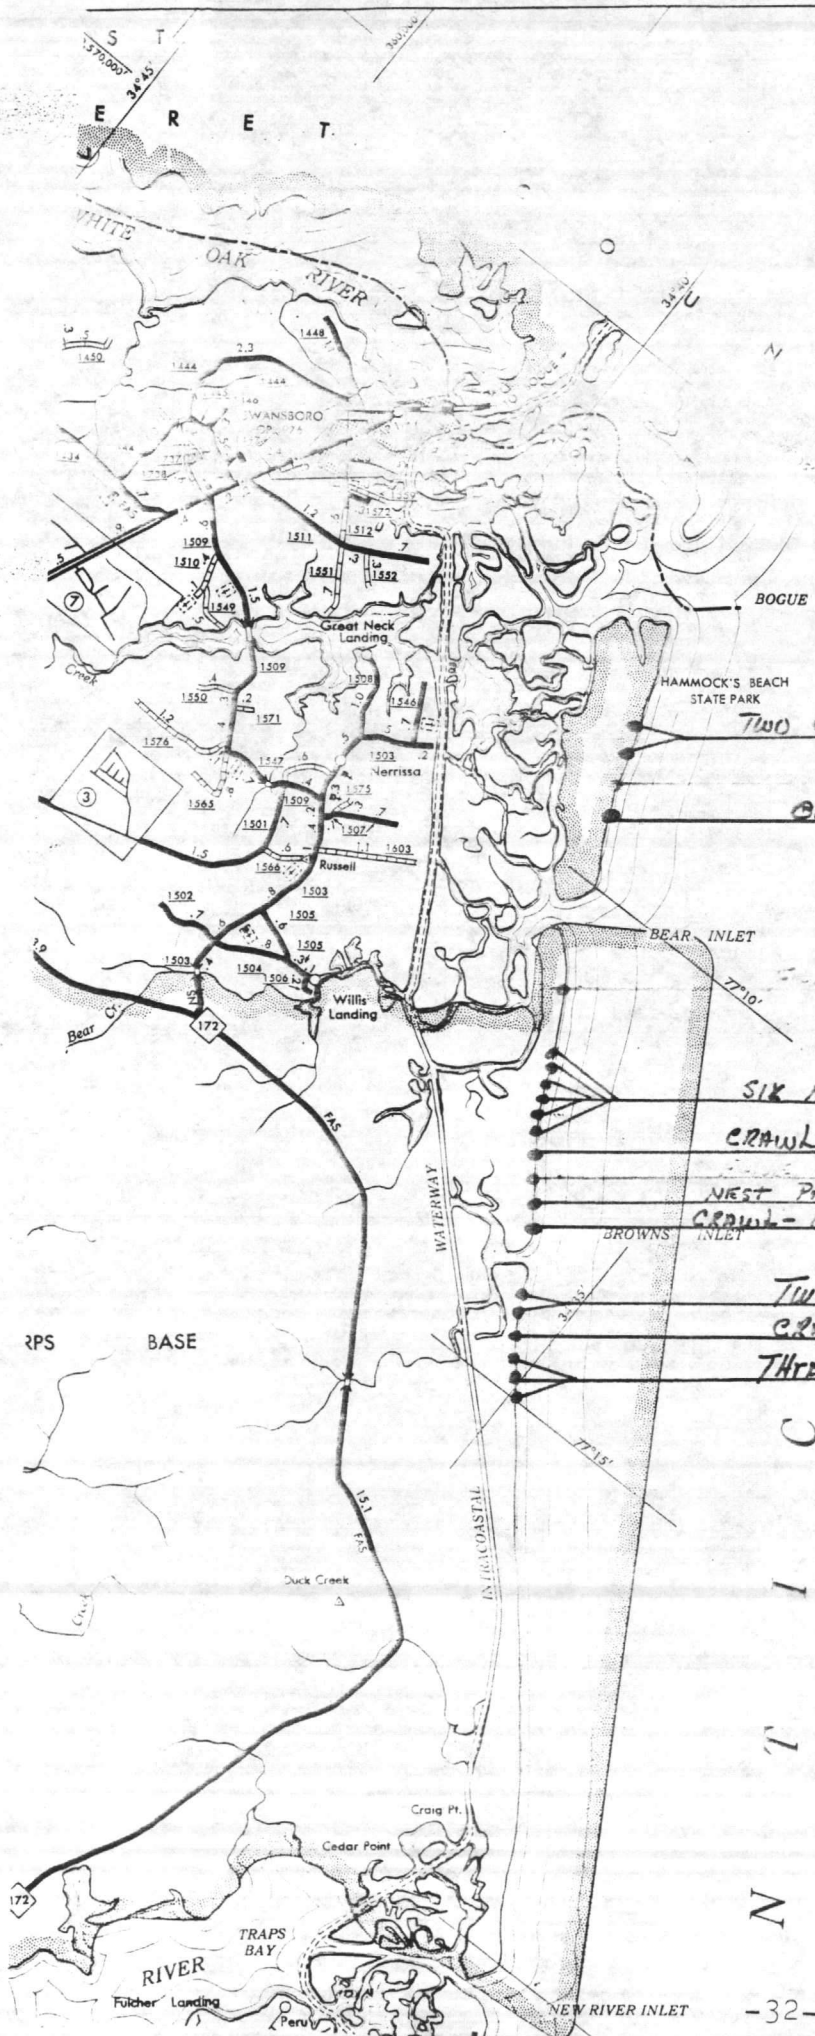

6-22-83	J.R. Rich
11- CRAWLS with NEST	
7- NEST PREDATION - SAW LARGE GREY FOX	
Digging in ONE NEST	

 

AERIAL SURVEY DATA

Date: June 14 1968 Time: S 06:00 F 08:00

Recorder Name: Jerry R. Rich

Crew Names: None Pilot: J. R. Rich

Co-Pilot: None Crew Chief: None

Others: None

Weather: General II to III fog Cloud Cover II 200 ft bvc

Wind Speed NE less than 5 K Sea Conditions Calm


BEACH AERIAL SURVEYS Altitude 100 Ft
Air Speed 60 K


Location	Crawls		Nests		Nest Predation	
	New	Old	New	Old	New	Old
Onslow Beach	0	0	0	0	0	0
Browns Island	0	0	1	0	0	0
Bear Beach	0	0	0	0	0	0

OCEAN AERIAL SURVEYS Altitude 200 Ft
Air Speed 60 K

	Live Turtles		Dead Turtles
	Juvenile	Adults	
Bell Buoy from Bogue Inlet to New River Inlet	0	1	0

Comments: _____

 

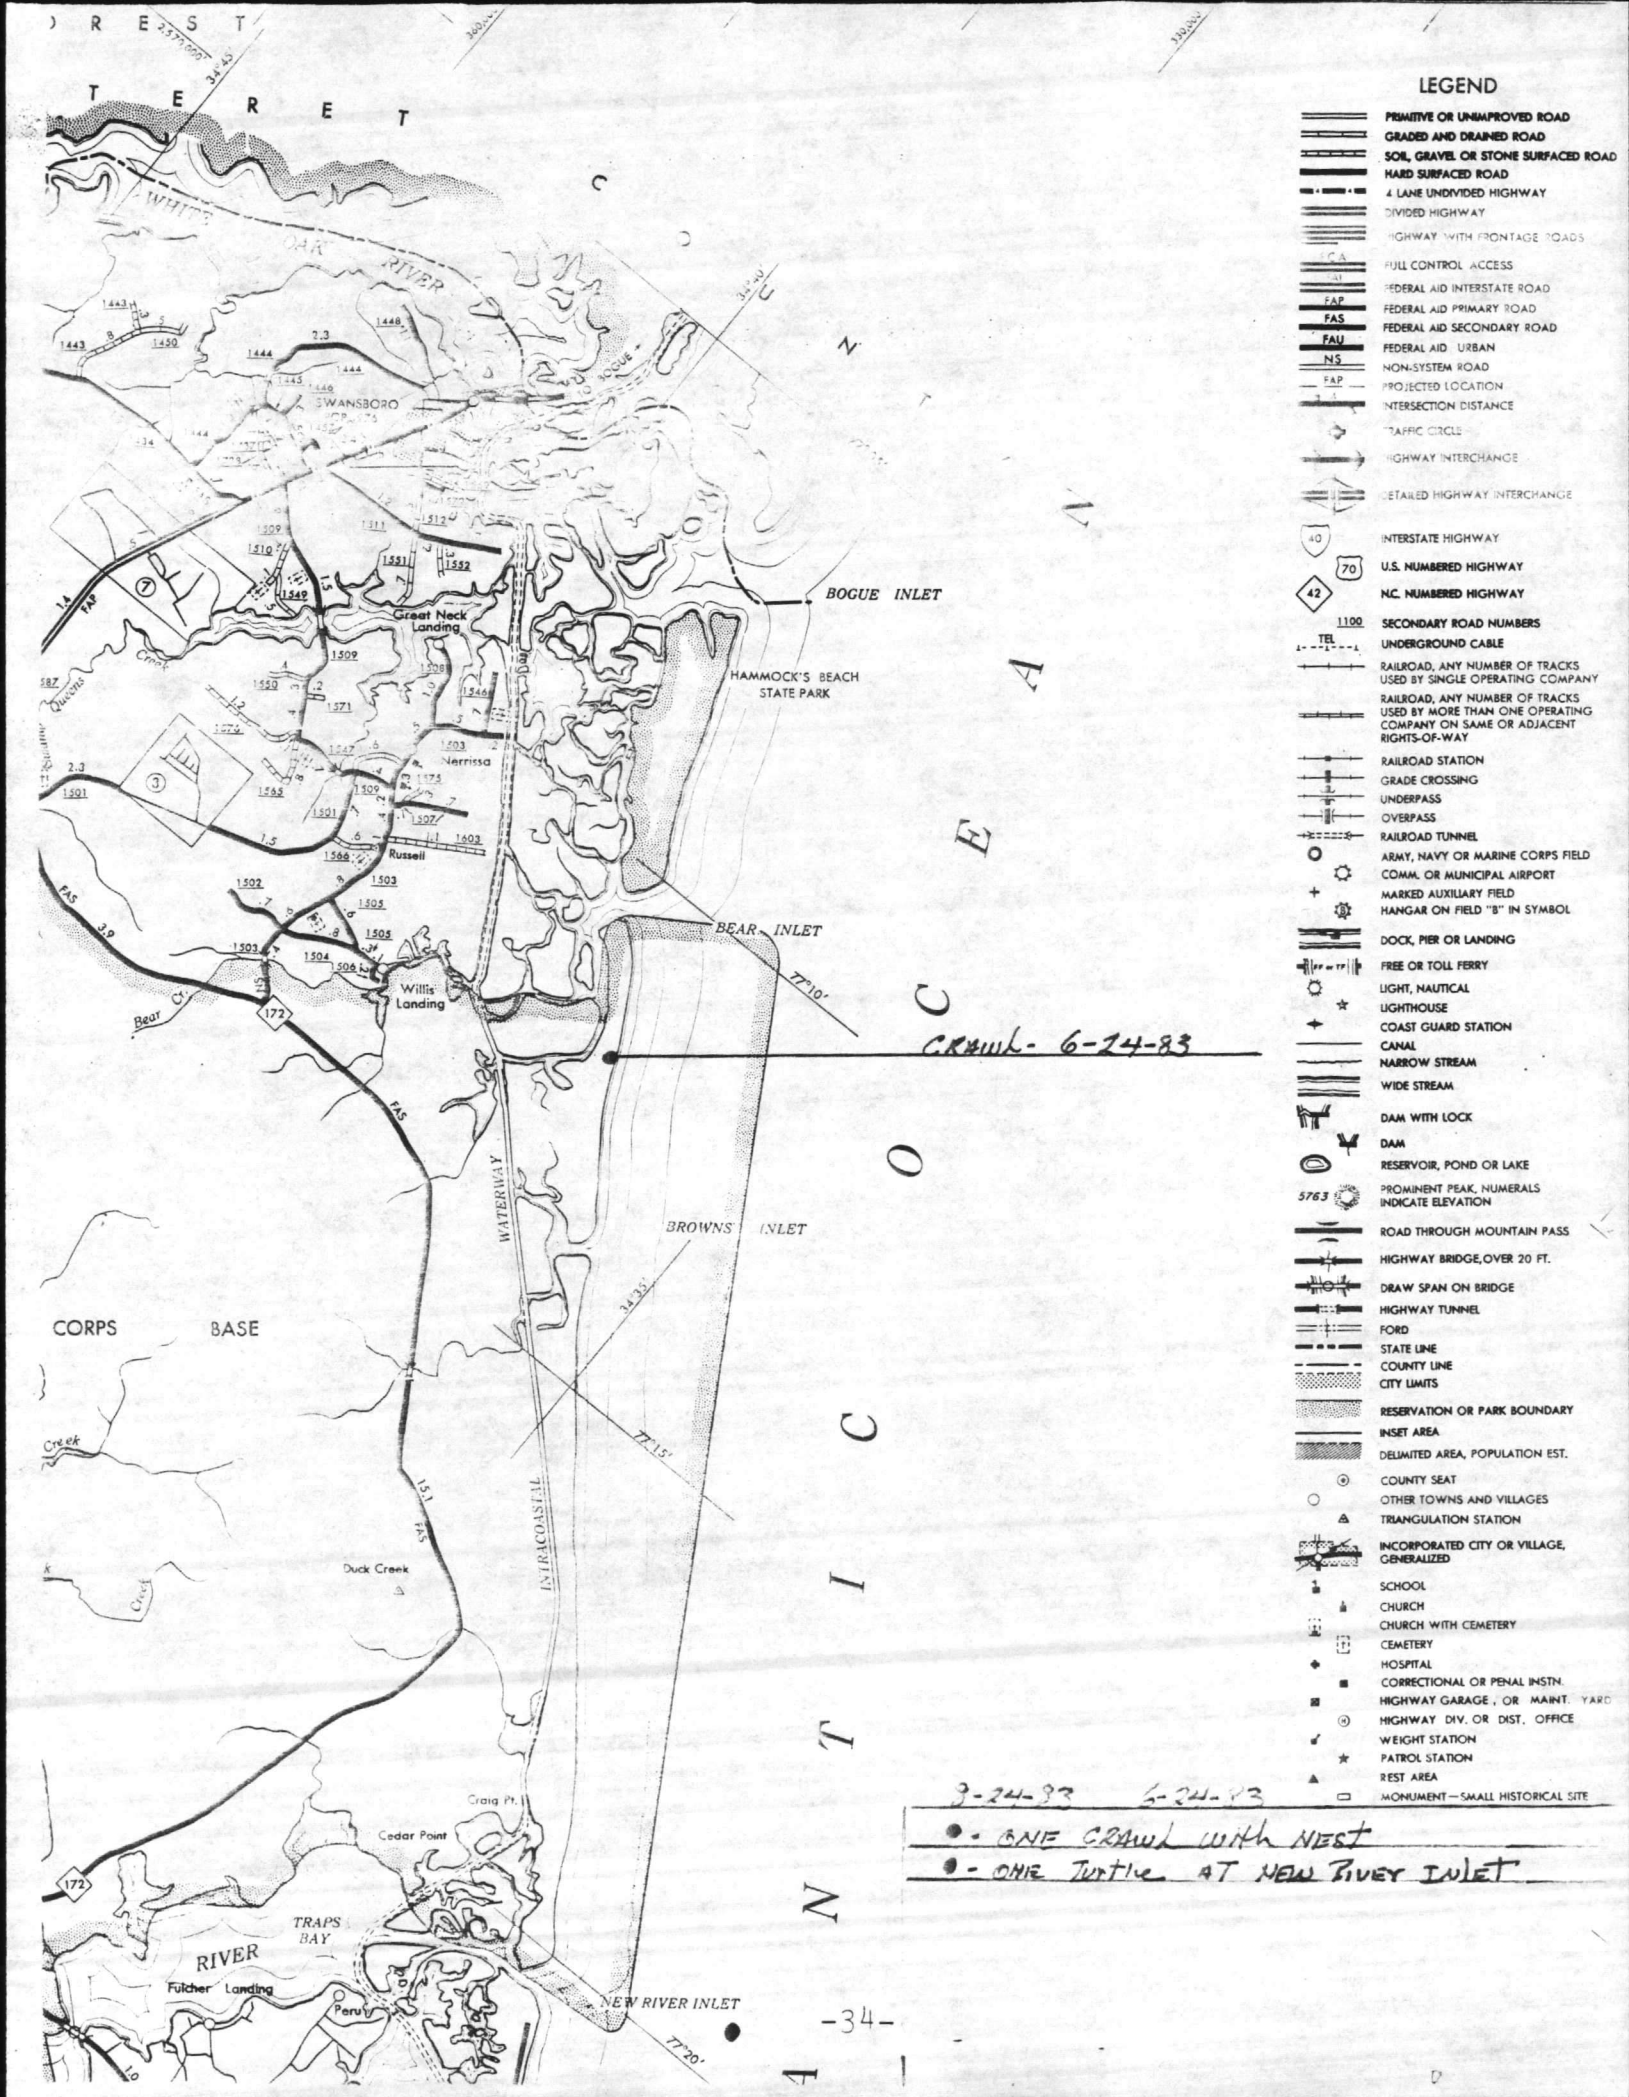


LEGEND

- PRIMITIVE OR UNIMPROVED ROAD
- GRADED AND DRAINED ROAD
- SOIL, GRAVEL OR STONE SURFACED ROAD
- HARD SURFACED ROAD
- 4 LANE UNDIVIDED HIGHWAY
- DIVIDED HIGHWAY
- HIGHWAY WITH FRONTAGE ROADS
- FULL CONTROL ACCESS
- FEDERAL AID INTERSTATE ROAD
- FEDERAL AID PRIMARY ROAD
- FEDERAL AID SECONDARY ROAD
- FEDERAL AID URBAN
- NON-SYSTEM ROAD
- PROJECTED LOCATION
- INTERSECTION DISTANCE
- TRAFFIC CIRCLE
- HIGHWAY INTERCHANGE
- DETAILED HIGHWAY INTERCHANGE
- INTERSTATE HIGHWAY
- U.S. NUMBERED HIGHWAY
- N.C. NUMBERED HIGHWAY
- SECONDARY ROAD NUMBERS
- UNDERGROUND CABLE
- RAILROAD, ANY NUMBER OF TRACKS USED BY SINGLE OPERATING COMPANY
- RAILROAD, ANY NUMBER OF TRACKS USED BY MORE THAN ONE OPERATING COMPANY ON SAME OR ADJACENT RIGHTS-OF-WAY
- RAILROAD STATION
- GRADE CROSSING
- UNDERPASS
- OVERPASS
- RAILROAD TUNNEL
- ARMY, NAVY OR MARINE CORPS FIELD
- COMM. OR MUNICIPAL AIRPORT
- MARKED AUXILIARY FIELD
- HANGAR ON FIELD "B" IN SYMBOL
- DOCK, PIER OR LANDING
- FREE OR TOLL FERRY
- LIGHT, NAUTICAL
- LIGHTHOUSE
- COAST GUARD STATION
- CANAL
- NARROW STREAM
- WIDE STREAM
- DAM WITH LOCK
- DAM
- RESERVOIR, POND OR LAKE
- PROMINENT PEAK, NUMERALS INDICATE ELEVATION
- ROAD THROUGH MOUNTAIN PASS
- HIGHWAY BRIDGE, OVER 20 FT.
- DRAW SPAN ON BRIDGE
- HIGHWAY TUNNEL
- FORD
- STATE LINE
- COUNTY LINE
- CITY LIMITS
- RESERVATION OR PARK BOUNDARY
- INSET AREA
- DELIMITED AREA, POPULATION EST.
- COUNTY SEAT
- OTHER TOWNS AND VILLAGES
- TRIANGULATION STATION
- INCORPORATED CITY OR VILLAGE, GENERALIZED
- SCHOOL
- CHURCH
- CHURCH WITH CEMETERY
- CEMETERY
- HOSPITAL
- CORRECTIONAL OR PENAL INSTN.
- HIGHWAY GARAGE, OR MAINT. YARD
- HIGHWAY DIV. OR DIST. OFFICE
- WEIGHT STATION
- PATROL STATION
- REST AREA
- MONUMENT - SMALL HISTORICAL SITE

CRAWL- 6-24-83

3-24-83 6-24-83
 ● - ONE CRAWL WITH NEST
 ● - ONE TURTLE AT NEW RIVER INLET

 















 



NEST AND CRAWL ACTIVITY
ONslow BEACH, MARINE CORPS BASE
CAMP LEJEUNE, NORTH CAROLINA


Nests - upper map

Crawls no nest - lower map

Dots indicates multiple usage

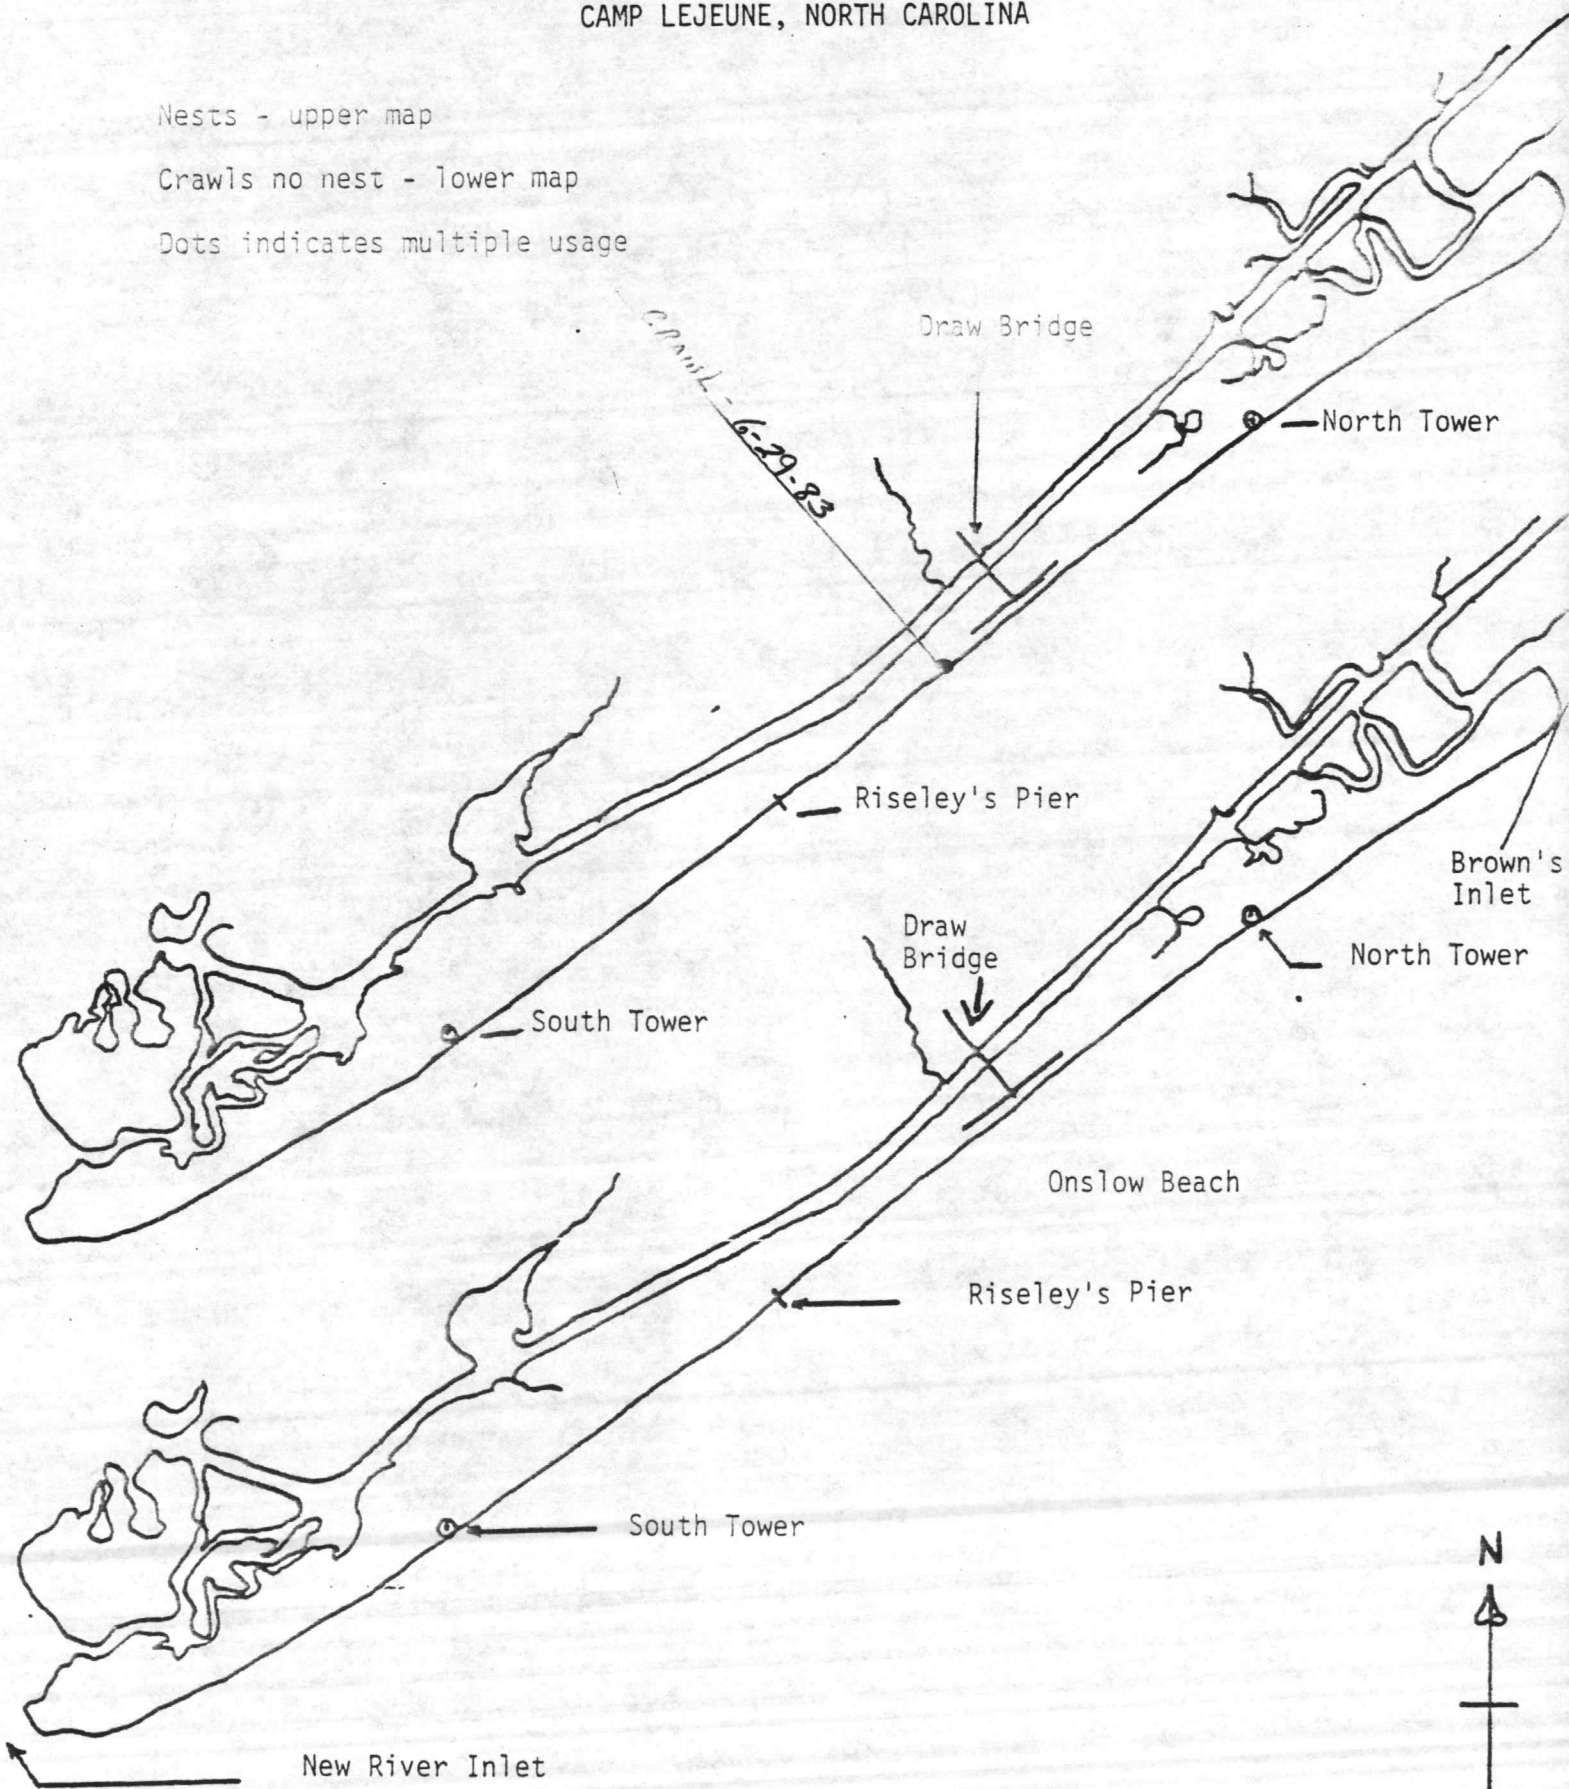

 

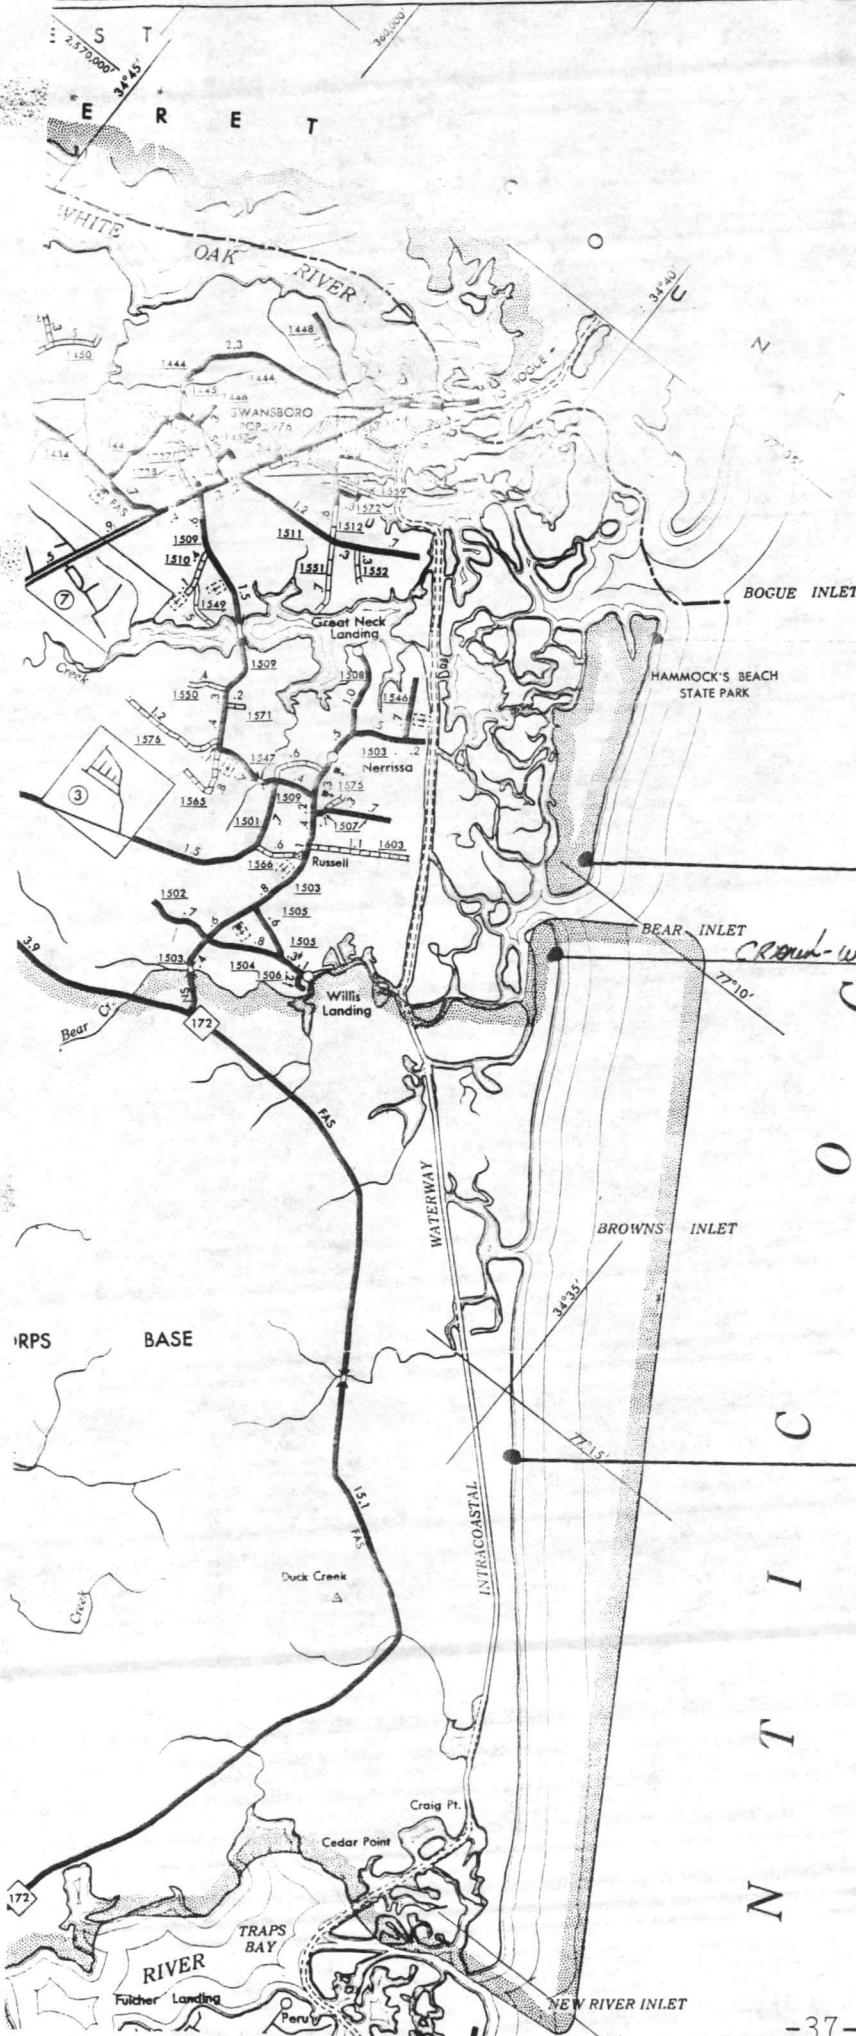


LEGEND

- PRIMITIVE OR UNIMPROVED ROAD
- GRADED AND DRAINED ROAD
- SOIL, GRAVEL OR STONE SURFACED ROAD
- HARD SURFACED ROAD
- 4 LANE UNDIVIDED HIGHWAY
- DIVIDED HIGHWAY
- HIGHWAY WITH FRONTAGE ROADS
- FULL CONTROL ACCESS
- FEDERAL AID INTERSTATE ROAD
- FEDERAL AID PRIMARY ROAD
- FEDERAL AID SECONDARY ROAD
- FEDERAL AID URBAN
- NON-SYSTEM ROAD
- PROJECTED LOCATION
- INTERSECTION DISTANCE
- TRAFFIC CIRCLE
- HIGHWAY INTERCHANGE
- DETAILED HIGHWAY INTERCHANGE
- INTERSTATE HIGHWAY
- U.S. NUMBERED HIGHWAY
- N.C. NUMBERED HIGHWAY
- SECONDARY ROAD NUMBERS
- UNDERGROUND CABLE
- RAILROAD, ANY NUMBER OF TRACKS USED BY SINGLE OPERATING COMPANY
- RAILROAD, ANY NUMBER OF TRACKS USED BY MORE THAN ONE OPERATING COMPANY ON SAME OR ADJACENT RIGHTS-OF-WAY
- RAILROAD STATION
- GRADE CROSSING
- UNDERPASS
- OVERPASS
- RAILROAD TUNNEL
- ARMY, NAVY OR MARINE CORPS FIELD
- COMM. OR MUNICIPAL AIRPORT
- MARKED AUXILIARY FIELD
- HANGAR ON FIELD "B" IN SYMBOL
- DOCK, PIER OR LANDING
- FREE OR TOLL FERRY
- LIGHT, NAUTICAL
- LIGHTHOUSE
- COAST GUARD STATION
- CANAL
- NARROW STREAM
- WIDE STREAM
- DAM WITH LOCK
- DAM
- RESERVOIR, POND OR LAKE
- PROMINENT PEAK, NUMERALS INDICATE ELEVATION
- ROAD THROUGH MOUNTAIN PASS
- HIGHWAY BRIDGE, OVER 20 FT.
- DRAW SPAN ON BRIDGE
- HIGHWAY TUNNEL
- FORD
- STATE LINE
- COUNTY LINE
- CITY LIMITS
- RESERVATION OR PARK BOUNDARY
- INSET AREA
- DELIMITED AREA, POPULATION EST.
- COUNTY SEAT
- OTHER TOWNS AND VILLAGES
- TRIANGULATION STATION
- INCORPORATED CITY OR VILLAGE, GENERALIZED
- SCHOOL
- CHURCH
- CHURCH WITH CEMETERY
- CEMETERY
- HOSPITAL
- CORRECTIONAL OR PENAL INSTN.
- HIGHWAY GARAGE, OR MAINT. YARD
- HIGHWAY DIV. OR DIST. OFFICE
- WEIGHT STATION
- PATROL STATION
- REST AREA
- MONUMENT - SMALL HISTORICAL SITE

8-29-83 J.R. Rich

- - Two CRAWLS with NEST
- -
- - ONE CRAWL with NEST PRELIMINATION

 


















 

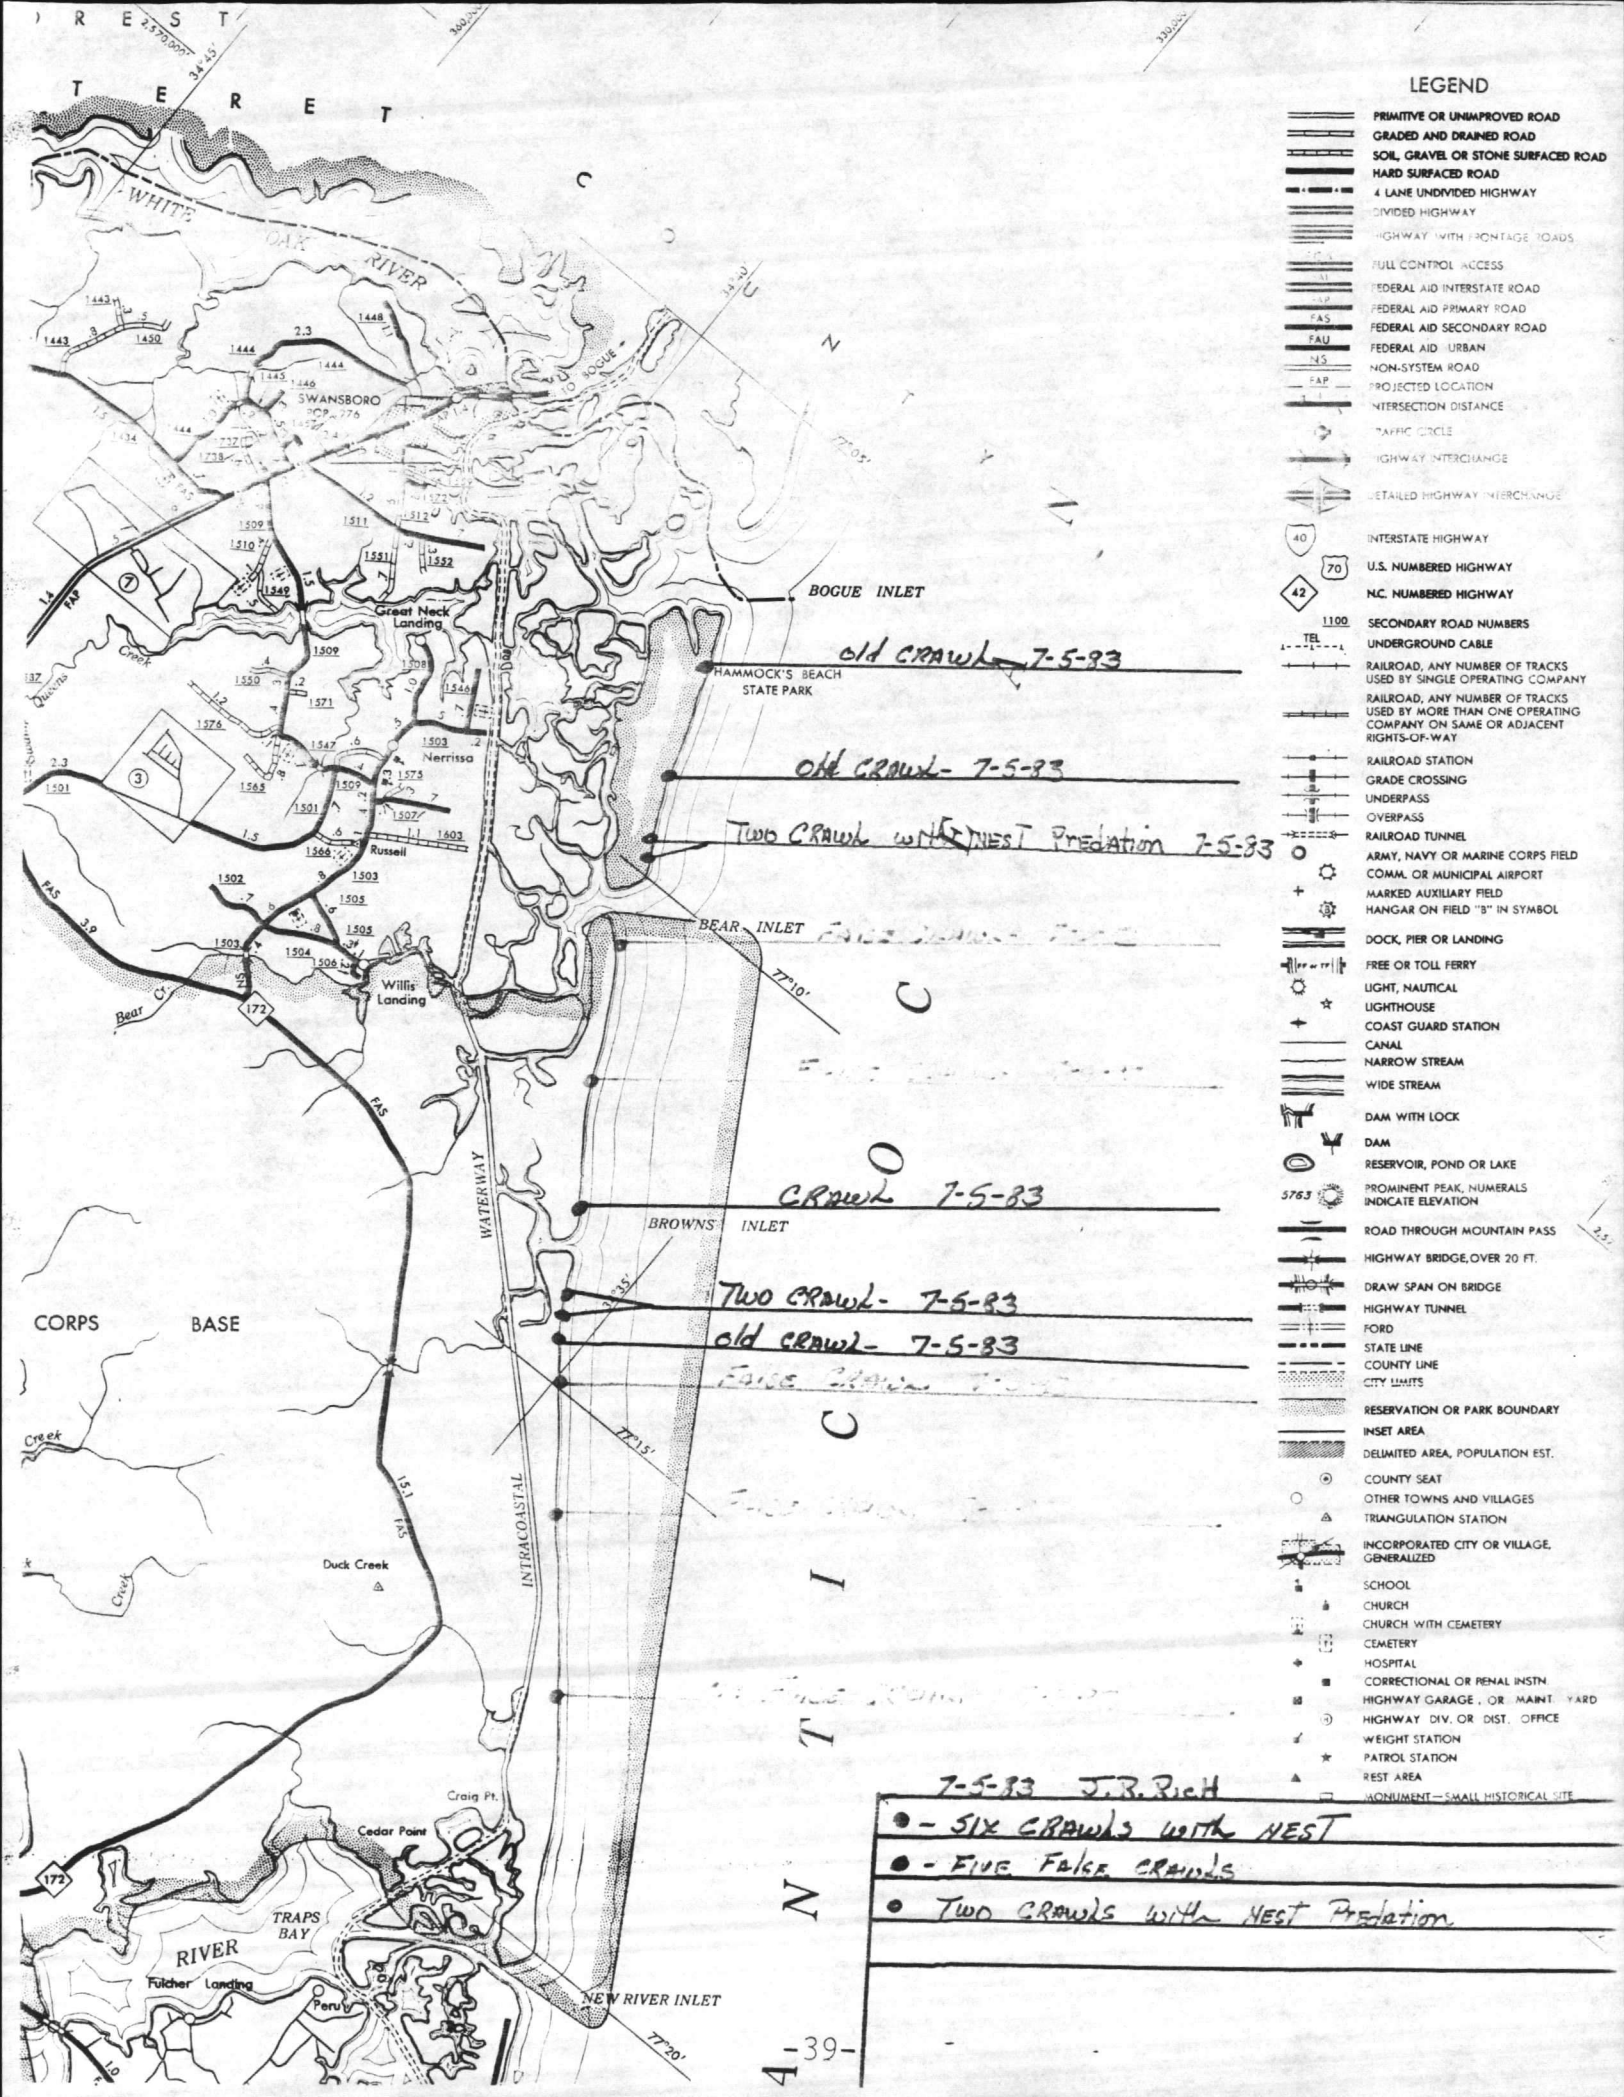


LEGEND

- PRIMITIVE OR UNIMPROVED ROAD
- GRADED AND DRAINED ROAD
- SOIL, GRAVEL OR STONE SURFACED ROAD
- HARD SURFACED ROAD
- 4 LANE UNDIVIDED HIGHWAY
- DIVIDED HIGHWAY
- HIGHWAY WITH FRONTAGE ROADS
- FULL CONTROL ACCESS
- FEDERAL AID INTERSTATE ROAD
- FEDERAL AID PRIMARY ROAD
- FEDERAL AID SECONDARY ROAD
- FEDERAL AID URBAN
- NON-SYSTEM ROAD
- PROJECTED LOCATION
- INTERSECTION DISTANCE
- TRAFFIC CIRCLE
- HIGHWAY INTERCHANGE
- DETAILED HIGHWAY INTERCHANGE
- INTERSTATE HIGHWAY
- U.S. NUMBERED HIGHWAY
- N.C. NUMBERED HIGHWAY
- SECONDARY ROAD NUMBERS
- UNDERGROUND CABLE
- RAILROAD, ANY NUMBER OF TRACKS USED BY SINGLE OPERATING COMPANY
- RAILROAD, ANY NUMBER OF TRACKS USED BY MORE THAN ONE OPERATING COMPANY ON SAME OR ADJACENT RIGHTS-OF-WAY
- RAILROAD STATION
- GRADE CROSSING
- UNDERPASS
- OVERPASS
- RAILROAD TUNNEL
- ARMY, NAVY OR MARINE CORPS FIELD
- COMM. OR MUNICIPAL AIRPORT
- MARKED AUXILIARY FIELD
- HANGAR ON FIELD "B" IN SYMBOL
- DOCK, PIER OR LANDING
- FREE OR TOLL FERRY
- LIGHT, NAUTICAL
- LIGHTHOUSE
- COAST GUARD STATION
- CANAL
- NARROW STREAM
- WIDE STREAM
- DAM WITH LOCK
- DAM
- RESERVOIR, POND OR LAKE
- PROMINENT PEAK, NUMERALS INDICATE ELEVATION
- ROAD THROUGH MOUNTAIN PASS
- HIGHWAY BRIDGE, OVER 20 FT.
- DRAW SPAN ON BRIDGE
- HIGHWAY TUNNEL
- FORD
- STATE LINE
- COUNTY LINE
- CITY LIMITS
- RESERVATION OR PARK BOUNDARY
- INSET AREA
- DELIMITED AREA, POPULATION EST.
- COUNTY SEAT
- OTHER TOWNS AND VILLAGES
- TRIANGULATION STATION
- INCORPORATED CITY OR VILLAGE, GENERALIZED
- SCHOOL
- CHURCH
- CHURCH WITH CEMETERY
- CEMETERY
- HOSPITAL
- CORRECTIONAL OR PENAL INSTN.
- HIGHWAY GARAGE, OR MAINT. YARD
- HIGHWAY DIV. OR DIST. OFFICE
- WEIGHT STATION
- PATROL STATION
- REST AREA
- MONUMENT - SMALL HISTORICAL SITE

7-5-83 J.R. Rich

●	- SIX CRAWLS WITH NEST
●	- FIVE FALSE CRAWLS
●	- TWO CRAWLS WITH NEST PREDATION

4-39-

 



NEST AND CRAWL ACTIVITY
 ONSLOW BEACH, MARINE CORPS BASE
 CAMP LEJEUNE, NORTH CAROLINA

Nests - upper map

Crawls no nest - lower map

Dots indicates multiple usage

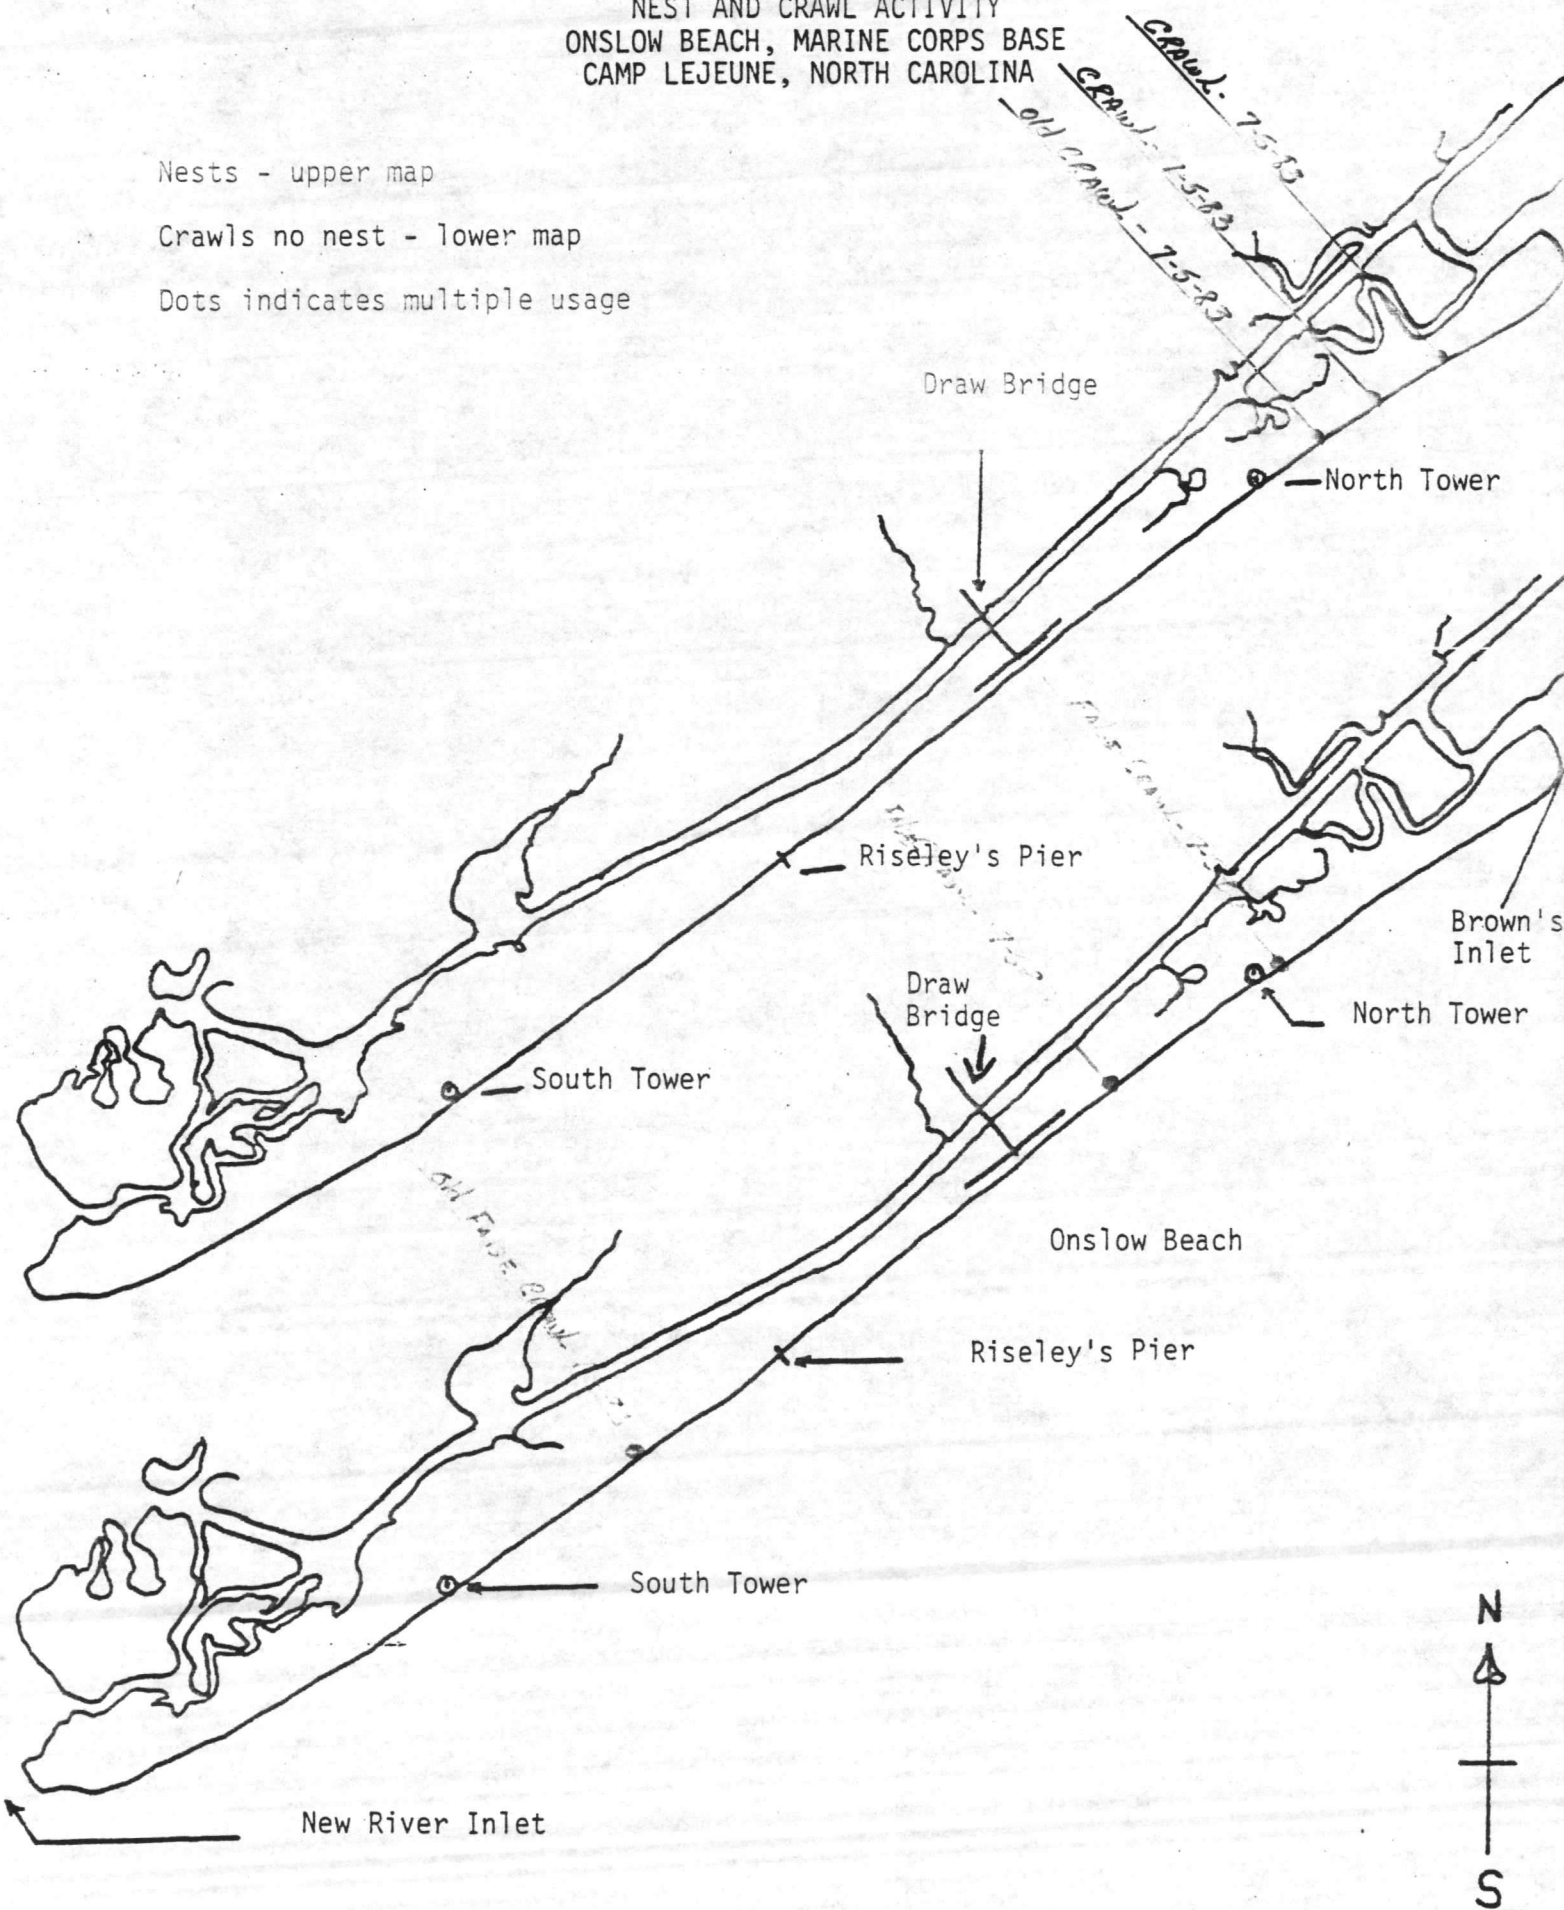

 

AERIAL SURVEY DATA

Date: July 7 1966 Time: S 06:10 F 08:00

Recorder Name: Jerry R. Rich

Crew Names: None Pilot: J. R. Rich

Co-Pilot: None Crew Chief: None

Others: None

Weather: General 2000 SCT 5 miles haze Cloud Cover 2000 SCT

Wind Speed NE 16-22 K Sea Conditions White caps


BEACH AERIAL SURVEYS Altitude 100 FT
 Air Speed 60 K


Location	Crawls		Nests		Nest Predation	
	New	Old	New	Old	New	Old
Onslow Beach	0	0	0	0	0	0
Browns Island	2	0	1	0	0	0
Bear Beach	1	0	2	0	0	0

OCEAN AERIAL SURVEYS Altitude 400 FT
 Air Speed 60 K

	Live Turtles		Dead Turtles
	Juvenile	Adults	
Bell Buoy from Bogue Inlet to New River Inlet	None	None	None

Comments: _____

 


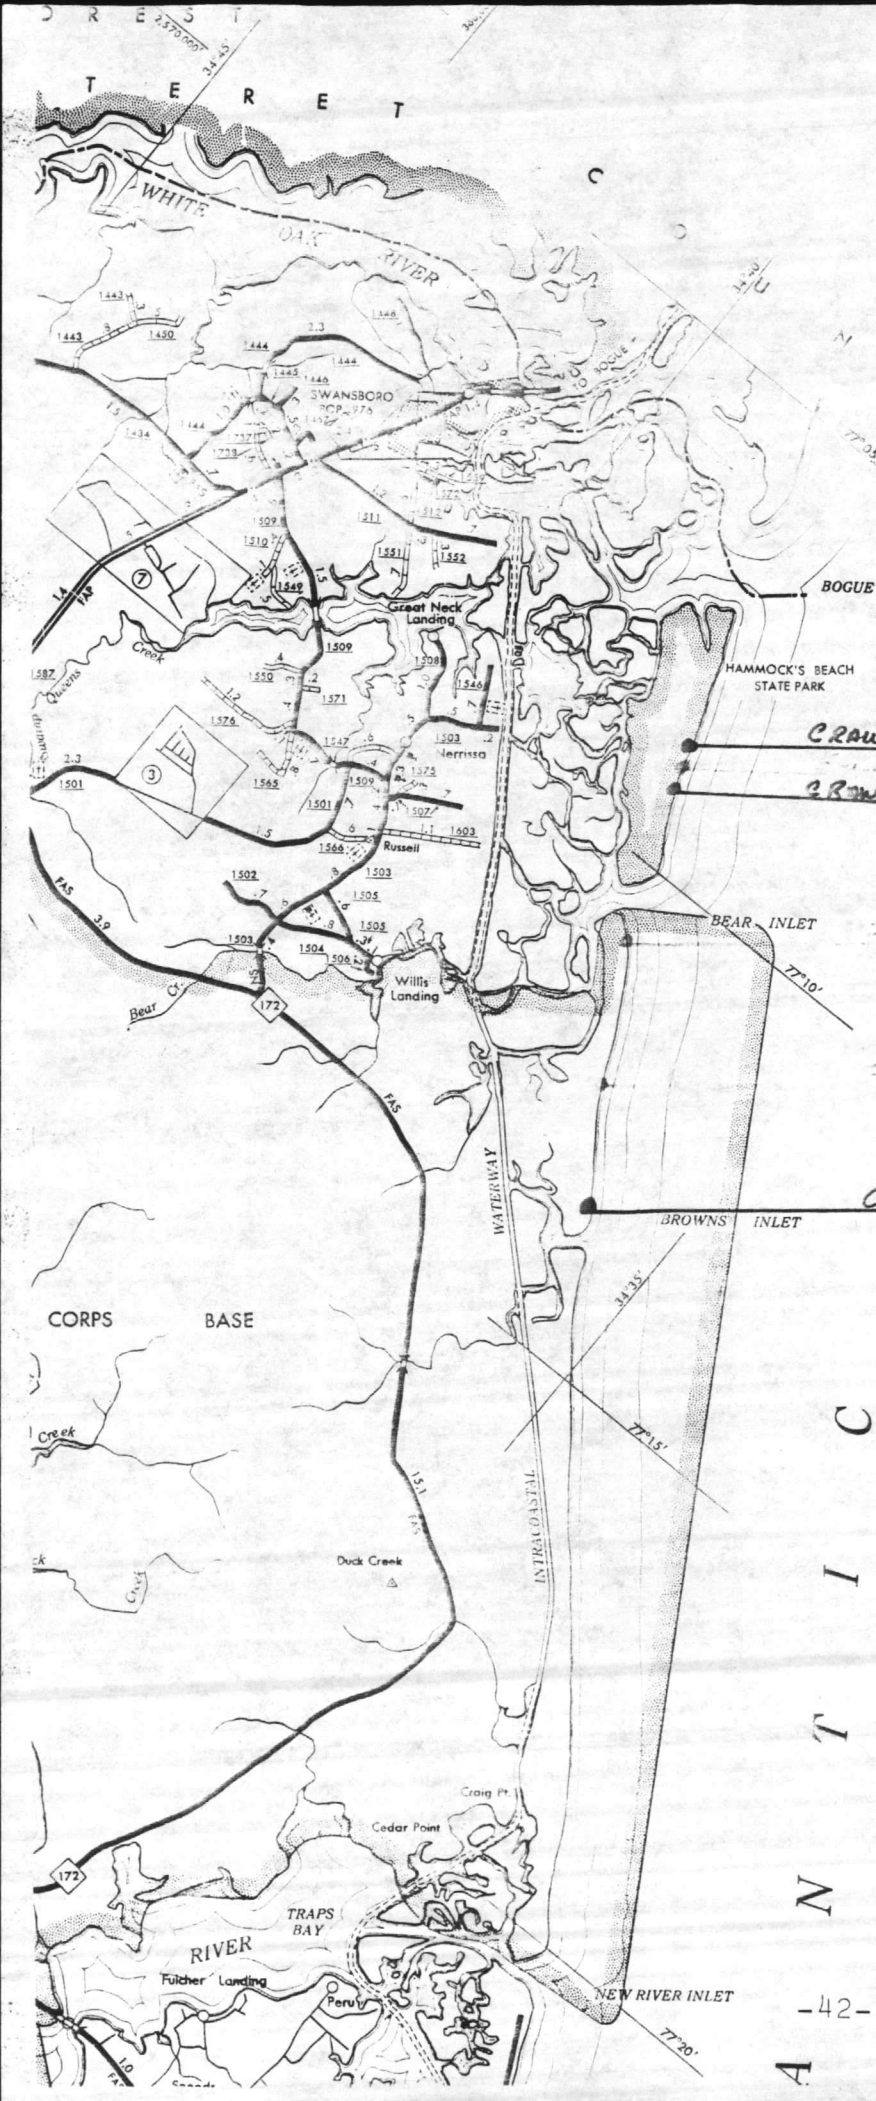

LEGEND

- PRIMITIVE OR UNIMPROVED ROAD
- GRADED AND DRAINED ROAD
- SOIL, GRAVEL OR STONE SURFACED ROAD
- HARD SURFACED ROAD
- 4 LANE UNDIVIDED HIGHWAY
- DIVIDED HIGHWAY
- HIGHWAY WITH FRONTAGE ROADS
- FULL CONTROL ACCESS
- FEDERAL AID INTERSTATE ROAD
- FEDERAL AID PRIMARY ROAD
- FEDERAL AID SECONDARY ROAD
- FEDERAL AID URBAN
- NON-SYSTEM ROAD
- PROJECTED LOCATION
- INTERSECTION DISTANCE
- TRAFFIC CIRCLE
- HIGHWAY INTERCHANGE
- DETAILED HIGHWAY INTERCHANGE
- INTERSTATE HIGHWAY
- U.S. NUMBERED HIGHWAY
- N.C. NUMBERED HIGHWAY
- SECONDARY ROAD NUMBERS
- UNDERGROUND CABLE
- RAILROAD, ANY NUMBER OF TRACKS USED BY SINGLE OPERATING COMPANY
- RAILROAD, ANY NUMBER OF TRACKS USED BY MORE THAN ONE OPERATING COMPANY ON SAME OR ADJACENT RIGHTS-OF-WAY
- RAILROAD STATION
- GRADE CROSSING
- UNDERPASS
- OVERPASS
- RAILROAD TUNNEL
- ARMY, NAVY OR MARINE CORPS FIELD
- COMM. OR MUNICIPAL AIRPORT
- MARKED AUXILIARY FIELD
- HANGAR ON FIELD "B" IN SYMBOL
- DOCK, PIER OR LANDING
- FREE OR TOLL FERRY
- LIGHT, NAUTICAL
- LIGHTHOUSE
- COAST GUARD STATION
- CANAL
- NARROW STREAM
- WIDE STREAM
- DAM WITH LOCK
- DAM
- RESERVOIR, POND OR LAKE
- PROMINENT PEAK, NUMERALS INDICATE ELEVATION
- ROAD THROUGH MOUNTAIN PASS
- HIGHWAY BRIDGE, OVER 20 FT.
- DRAW SPAN ON BRIDGE
- HIGHWAY TUNNEL
- FORD
- STATE LINE
- COUNTY LINE
- CITY LIMITS
- RESERVATION OR PARK BOUNDARY
- INSET AREA
- DELIMITED AREA, POPULATION EST.
- COUNTY SEAT
- OTHER TOWNS AND VILLAGES
- TRIANGULATION STATION
- INCORPORATED CITY OR VILLAGE, GENERALIZED
- SCHOOL
- CHURCH
- CHURCH WITH CEMETERY
- CEMETERY
- HOSPITAL
- CORRECTIONAL OR PENAL INSTN.
- HIGHWAY GARAGE, OR MAINT. YARD
- HIGHWAY DIV. OR DIST. OFFICE
- WEIGHT STATION
- PATROL STATION
- REST AREA
- MONUMENT - SMALL HISTORICAL SITE

7-7-83 J.B. Rich
 • - THREE CRAWLS WITH NEET

 

AERIAL SURVEY DATA

Date: July 10 80 Time: S 08:00 F 18:00

Recorder Name: James R. Rich

Crew Names: None Pilot: J. R. Rich

Co-Pilot: None Crew Chief: None

Others: None

Weather: General 5 miles haze & fog Cloud Cover 10000 SCT

Wind Speed W 5-7 K Sea Conditions Light Chop


BEACH AERIAL SURVEYS Altitude 100 Ft
 Air Speed 60 K

Location	Crawls		Nests		Nest Predation	
	New	Old	New	Old	New	Old
Onslow Beach	0	0	0	0	0	0
Browns Island	0	0	0	0	0	0
Bear Beach	3	0	2	0	1	0

OCEAN AERIAL SURVEYS Altitude 400 Ft
 Air Speed 60 K


	Live Turtles		Dead Turtles
	Juvenile	Adults	
Bell Buoy from Bogue Inlet to New River Inlet	None	None	None

Comments: _____

 




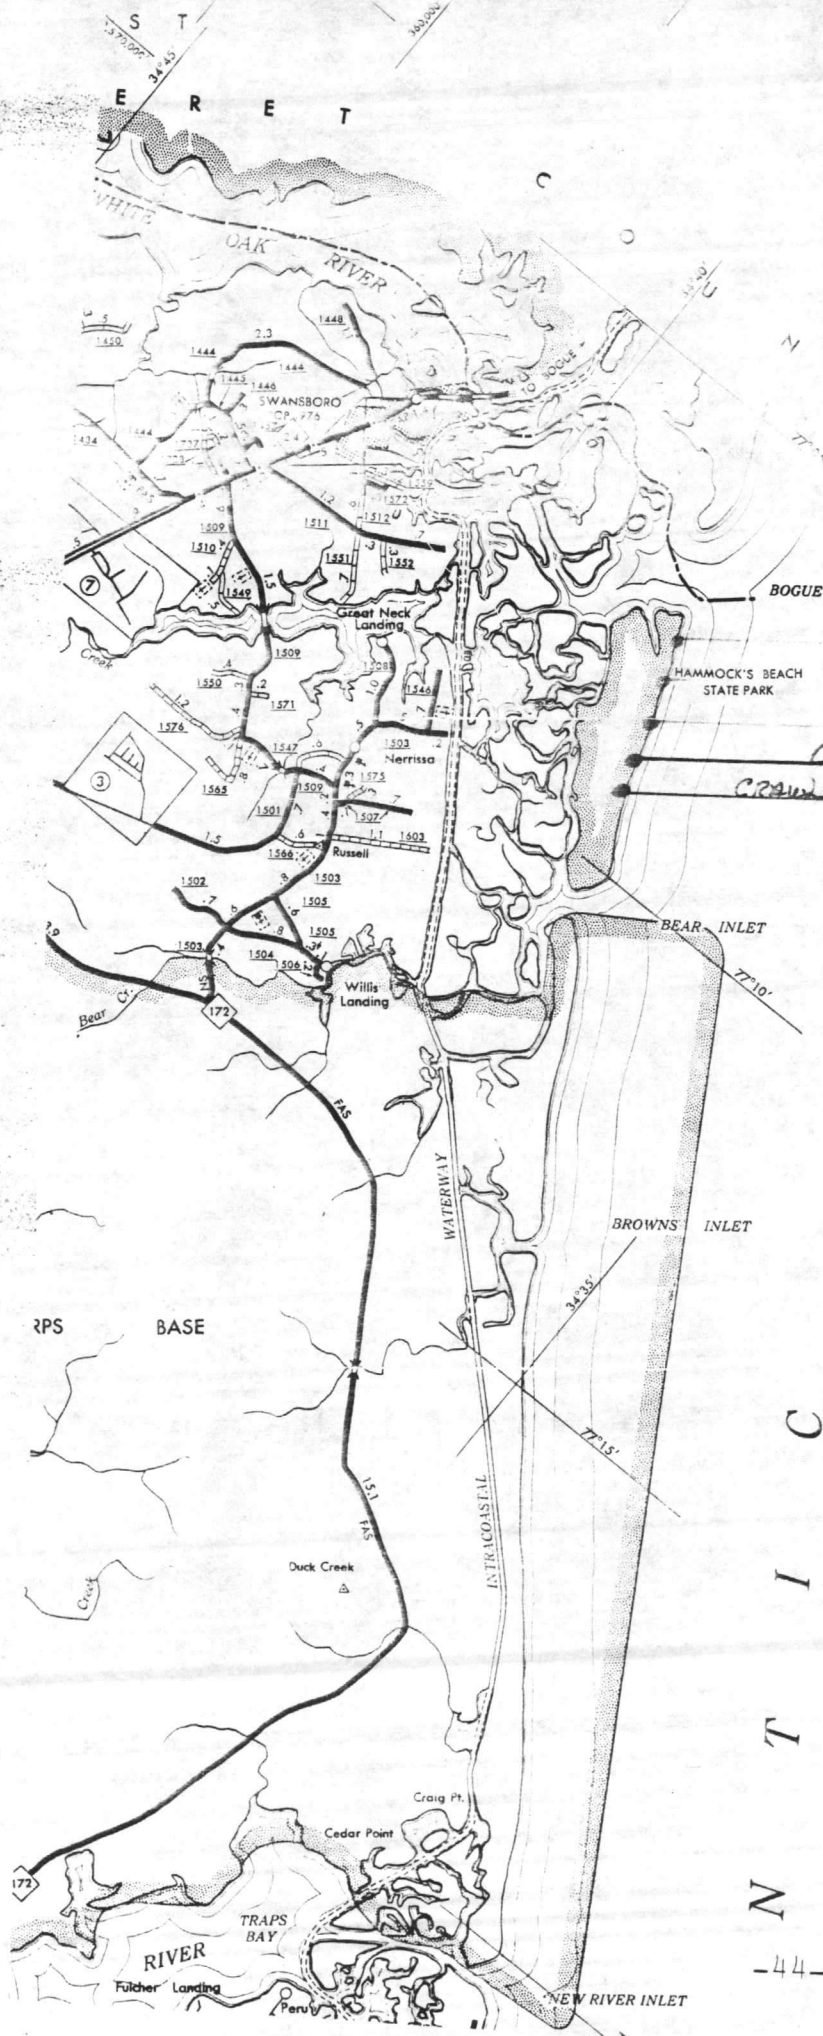

7-10-83 T.R. Rich

●	ONE CRAWL with NEST- 7-10-83
○	ONE CRAWL with NEST Prediction 7-10-83
●	ONE CRAWL with NEST Prediction 7-10-83

 

AERIAL SURVEY DATA

Date: Jul 15 1988 Time: S 06:05 F 12:00

Recorder Name: Jerry R. Rich

Crew Names: None Pilot: J. R. Rich

Co-Pilot: None Crew Chief: None

Others: None

Weather: General 1 miles vis. fog. Cloud Cover 200 OVC

Wind Speed Calm Sea Conditions Calm

BEACH AERIAL SURVEYS Altitude 100 Ft

Air Speed 60 K


Location	Crawls		Nests		Nest Predation	
	New	Old	New	Old	New	Old
Onslow Beach	2	0	2	0	0	0
Browns Island	0	0	0	0	0	0
Bear Beach	1	0	3	1	1	0


OCEAN AERIAL SURVEYS Altitude 200 Ft

Air Speed 60 K

Location	Live Turtles		Dead Turtles
	Juvenile	Adults	
Bell Buoy from Bogue Inlet to New River Inlet	None	None	None

Comments: _____

 

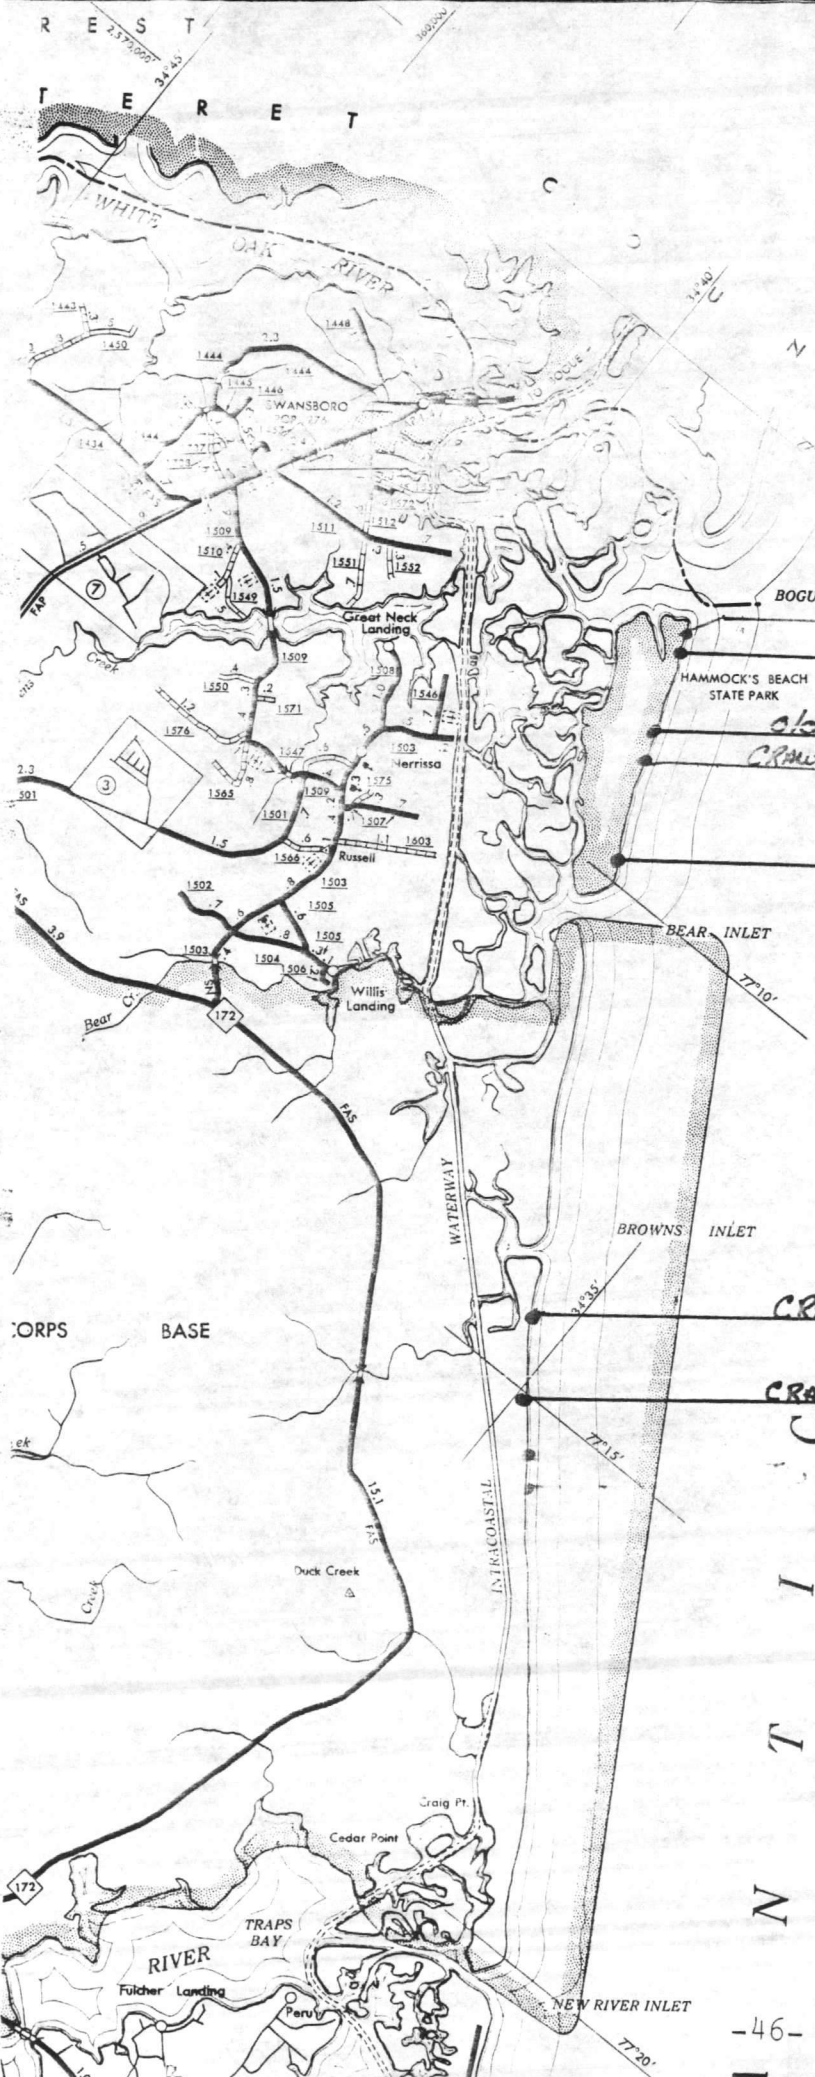


LEGEND

- PRIMITIVE OR UNIMPROVED ROAD
- GRADED AND DRAINED ROAD
- SOIL, GRAVEL OR STONE SURFACED ROAD
- HARD SURFACED ROAD
- 4 LANE UNDIVIDED HIGHWAY
- DIVIDED HIGHWAY
- HIGHWAY WITH FRONTAGE ROADS
- FULL CONTROL ACCESS
- FEDERAL AID INTERSTATE ROAD
- FEDERAL AID PRIMARY ROAD
- FEDERAL AID SECONDARY ROAD
- FEDERAL AID URBAN
- NON-SYSTEM ROAD
- PROJECTED LOCATION
- INTERSECTION DISTANCE
- TRAFFIC CIRCLE
- HIGHWAY INTERCHANGE
- DETAILED HIGHWAY INTERCHANGE
- INTERSTATE HIGHWAY
- U.S. NUMBERED HIGHWAY
- N.C. NUMBERED HIGHWAY
- SECONDARY ROAD NUMBERS
- UNDERGROUND CABLE
- RAILROAD, ANY NUMBER OF TRACKS USED BY SINGLE OPERATING COMPANY
- RAILROAD, ANY NUMBER OF TRACKS USED BY MORE THAN ONE OPERATING COMPANY ON SAME OR ADJACENT RIGHTS-OF-WAY
- RAILROAD STATION
- GRADE CROSSING
- UNDERPASS
- OVERPASS
- RAILROAD TUNNEL
- ARMY, NAVY OR MARINE CORPS FIELD COMM. OR MUNICIPAL AIRPORT
- MARKED AUXILIARY FIELD
- HANGAR ON FIELD "B" IN SYMBOL
- DOCK, PIER OR LANDING
- FREE OR TOLL FERRY
- LIGHT, NAUTICAL
- LIGHTHOUSE
- COAST GUARD STATION
- CANAL
- NARROW STREAM
- WIDE STREAM
- DAM WITH LOCK
- DAM
- RESERVOIR, POND OR LAKE
- PROMINENT PEAK, NUMERALS INDICATE ELEVATION
- ROAD THROUGH MOUNTAIN PASS
- HIGHWAY BRIDGE, OVER 20 FT.
- DRAW SPAN ON BRIDGE
- HIGHWAY TUNNEL
- FORD
- STATE LINE
- COUNTY LINE
- CITY LIMITS
- RESERVATION OR PARK BOUNDARY
- INSET AREA
- DELIMITED AREA, POPULATION EST.
- COUNTY SEAT
- OTHER TOWNS AND VILLAGES
- TRIANGULATION STATION
- INCORPORATED CITY OR VILLAGE, GENERALIZED
- SCHOOL
- CHURCH
- CHURCH WITH CEMETERY
- CEMETERY
- HOSPITAL
- CORRECTIONAL OR PENAL INSTN.
- HIGHWAY GARAGE, OR MAINT. YARD
- HIGHWAY DIV. OR DIST. OFFICE
- WEIGHT STATION
- PATROL STATION
- REST AREA
- MONUMENT - SMALL HISTORICAL SITE

CRAWL 7-15-83
old Crawl 7-15-83
CRAWL WITH NEST Predation 7-15-83
CRAWL 7-15-83


CRAWL 7-15-83
CRAWL 7-15-83


- 7-15-83 J.R. Rich**
- - FIVE CRAWLS WITH NEST
 - - THREE CRAWLS WITH NEST
 - - ONE CRAWL WITH NEST Predation

 

NEST AND CRAWL ACTIVITY
 ONSLOW BEACH, MARINE CORPS BASE
 CAMP LEJEUNE, NORTH CAROLINA

Nests - upper map
 Crawls no nest - lower map
 Dots indicates multiple usage

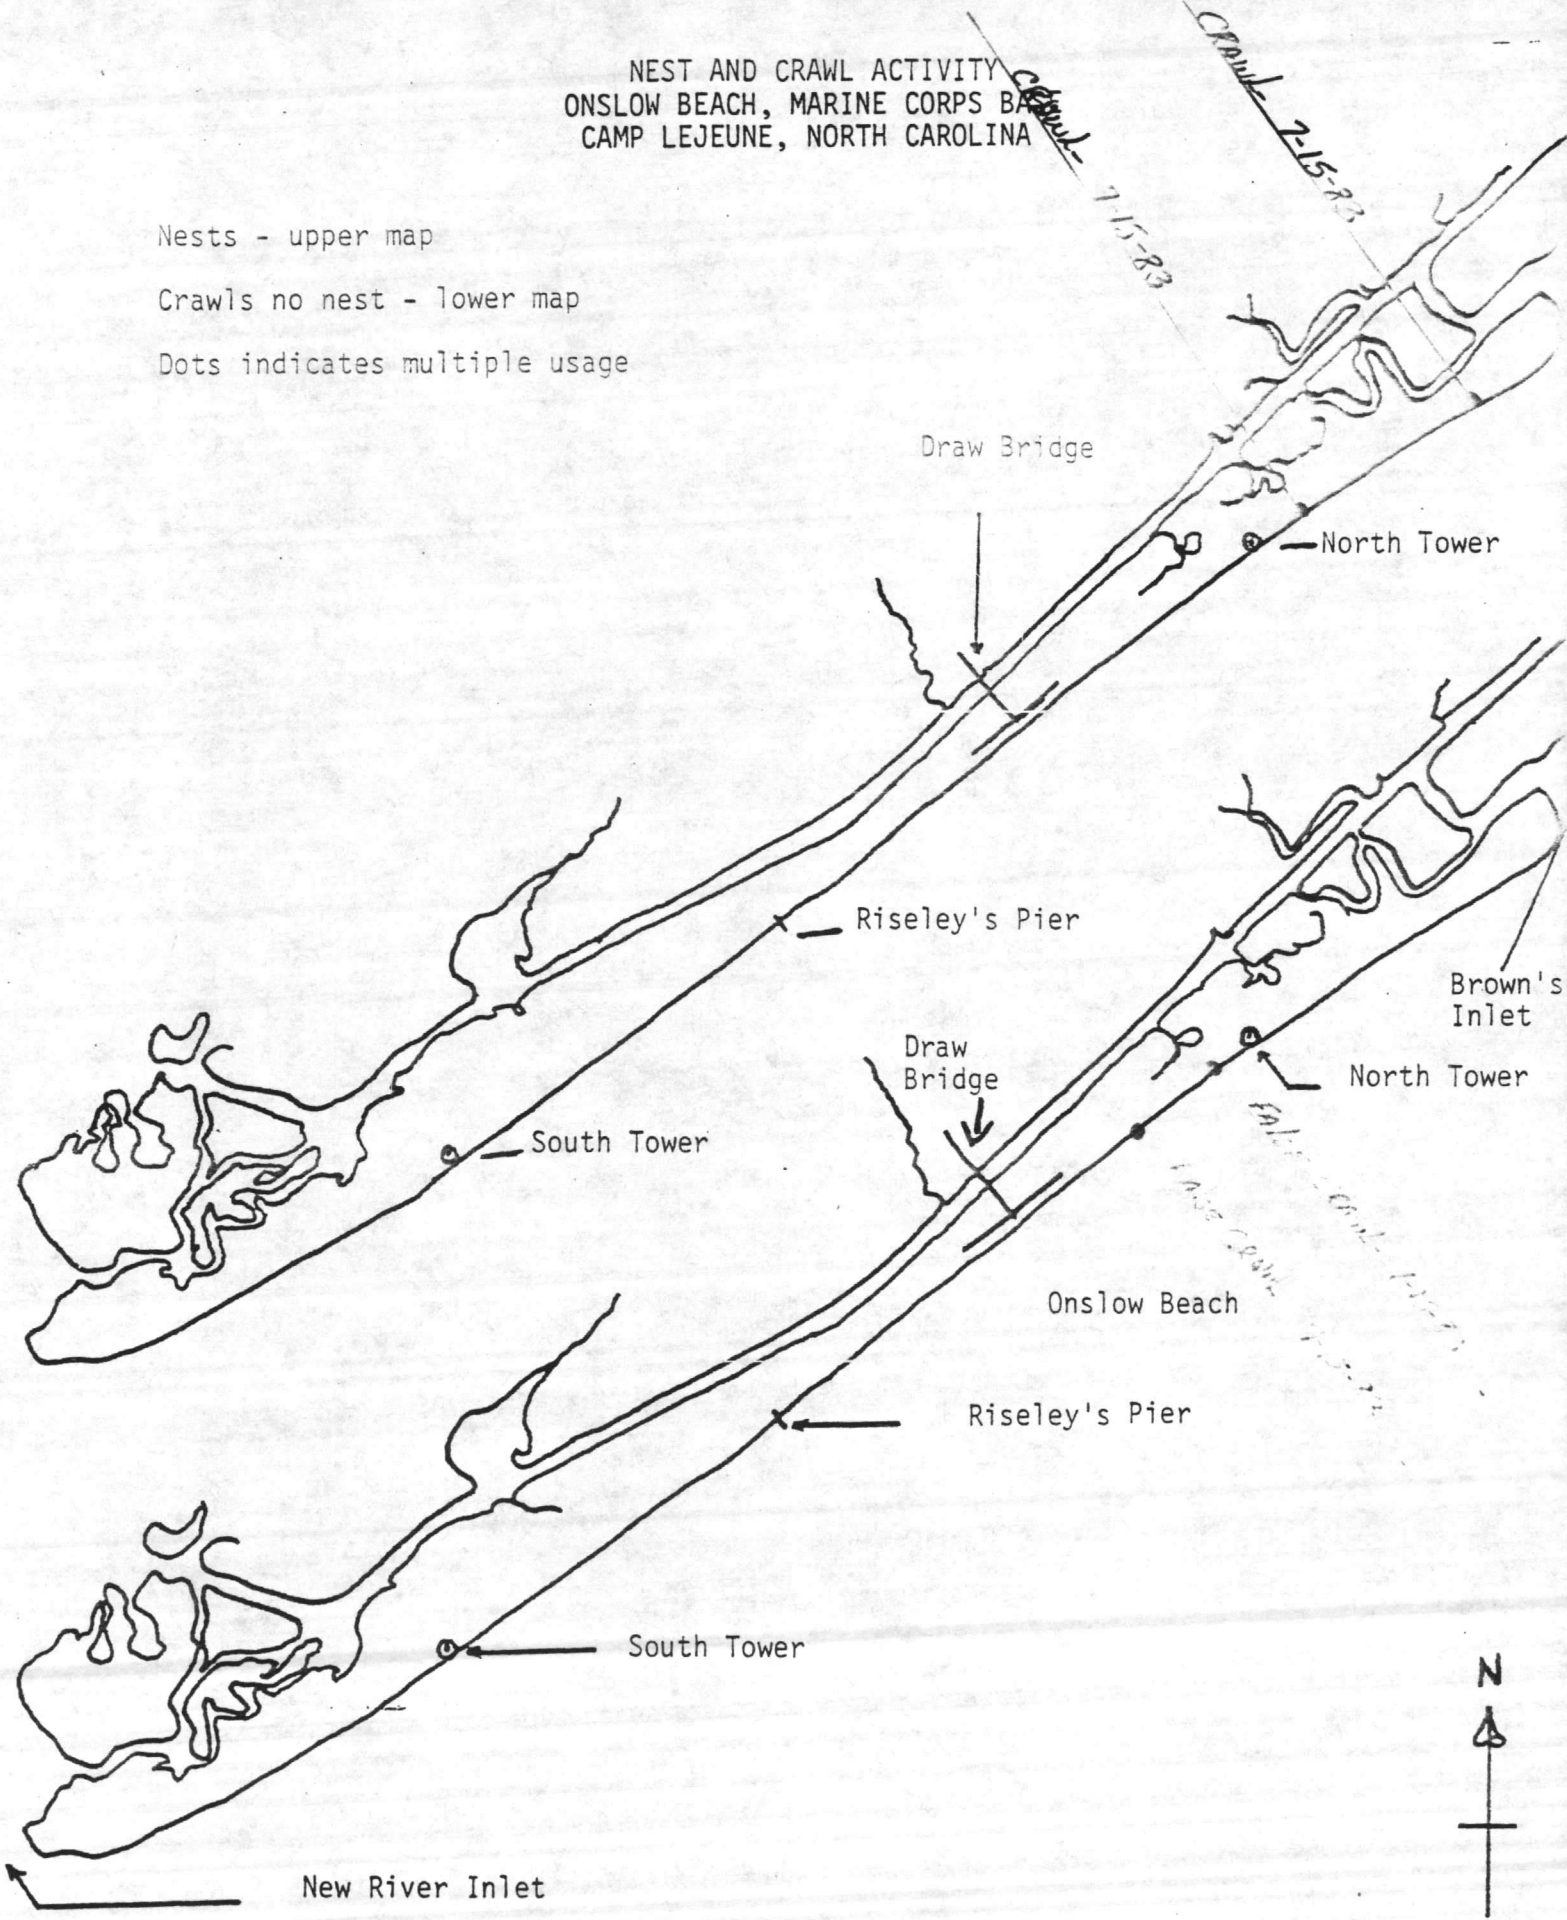

 

AERIAL SURVEY DATA

Date: July 19 1980 Time: S 06:00 F 08:30

Recorder Name: Jenny R. Rich

Crew Names: None Pilot: J. R. Rich

Co-Pilot: None Crew Chief: None

Others: None

Weather: General -K 1 mile fog & haze Cloud Cover -K fog & haze

Wind Speed SW less than 5 K Sea Conditions Calm

BEACH AERIAL SURVEYS Altitude 100 Ft

Air Speed 60 K


Location	Crawls		Nests		Nest Predation	
	New	Old,	New	Old	New	Old
Onslow Beach	0	0	1	2	0	0
Browns Island	2	0	4	0	3	0
Bear Beach	3	0	3	3	0	1

OCEAN AERIAL SURVEYS Altitude 200 Ft

Air Speed 60 K


	Live Turtles		Dead Turtles
	Juvenile	Adults	
Bell Buoy from Bogue Inlet to New River Inlet	None	None	None

Comments: _____

 




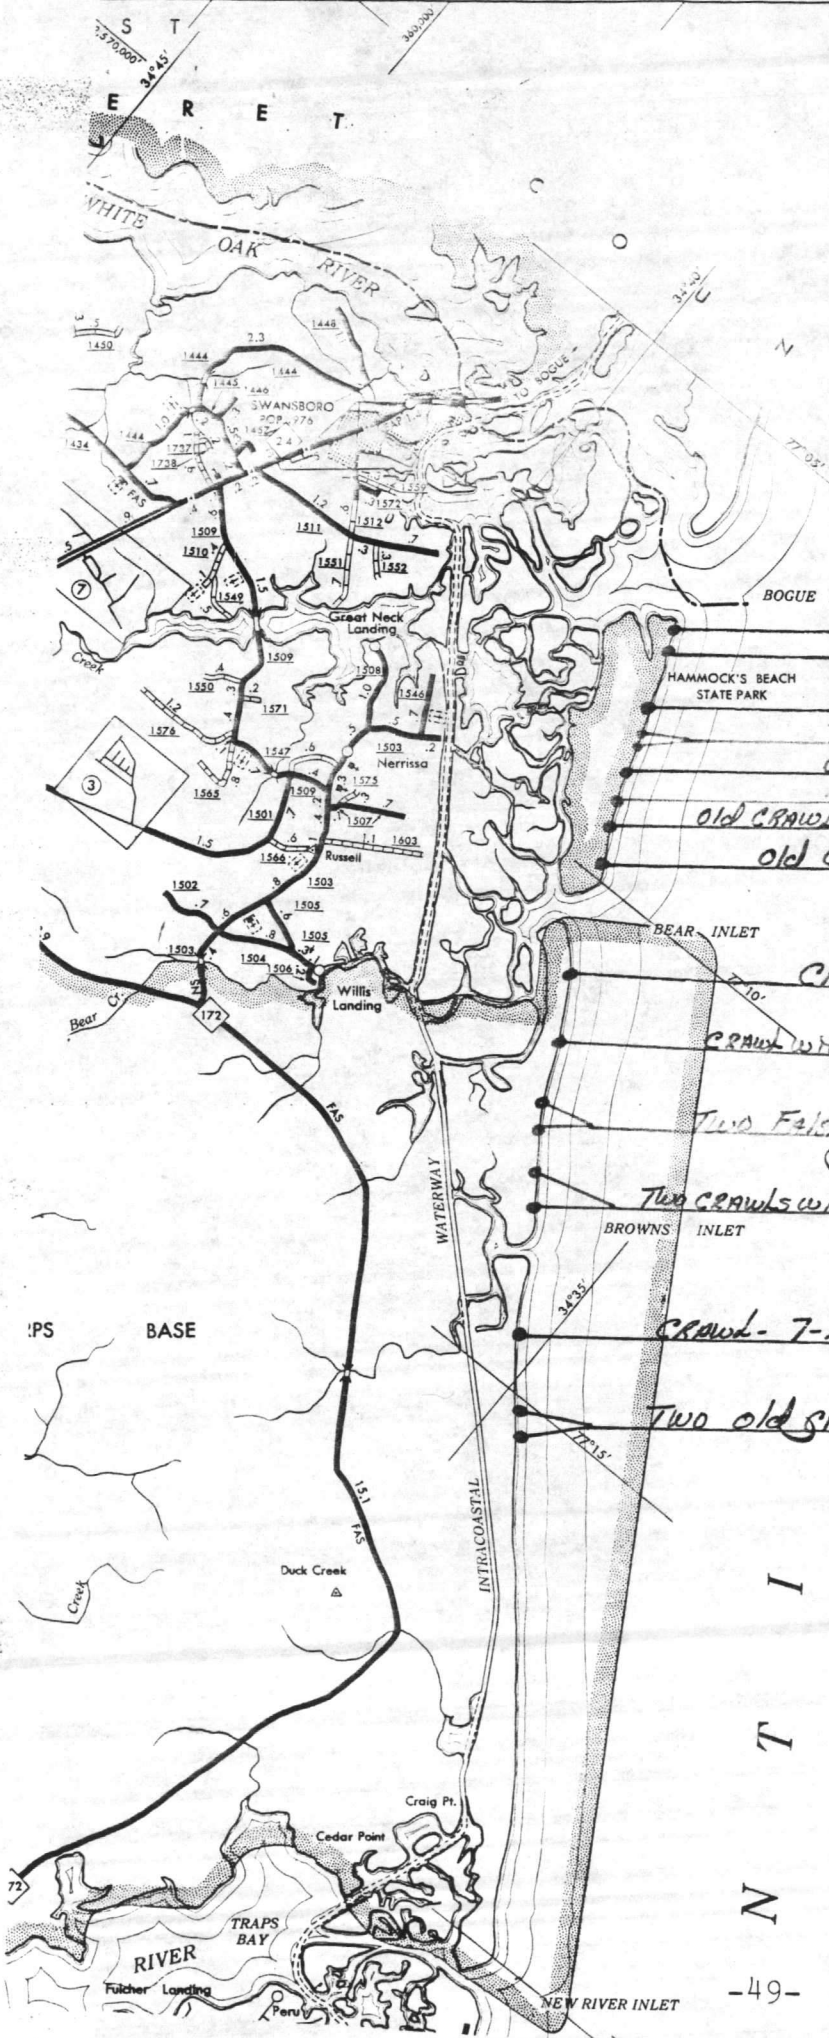

CRAWL - 7-19-83
old CRAWL 7-19-83
CRAWL 7-19-83
CRAWL 7-19-83
old CRAWL with NEST Predation 7-19-83
old CRAWL - 7-19-83
CRAWL - 7-19-83
CRAWL with NEST Predation 7-19-83
Two False Crawls 7-19-83
Two CRAWLS with NEST Predation - 7-19-83
CRAWL - 7-19-83
Two old crawls - 7-19-83

7-19-83 J.R. Roth

•	NINE CRAWLS with NEST
•	TWO FALSE CRAWLS
•	THREE CRAWLS with NEST Predation

 



NEST AND CRAWL ACTIVITY
ONSLow BEACH, MARINE CORPS BASE
CAMP LEJEUNE, NORTH CAROLINA

Nests - upper map

Crawls no nest - lower map

Dots indicates multiple usage

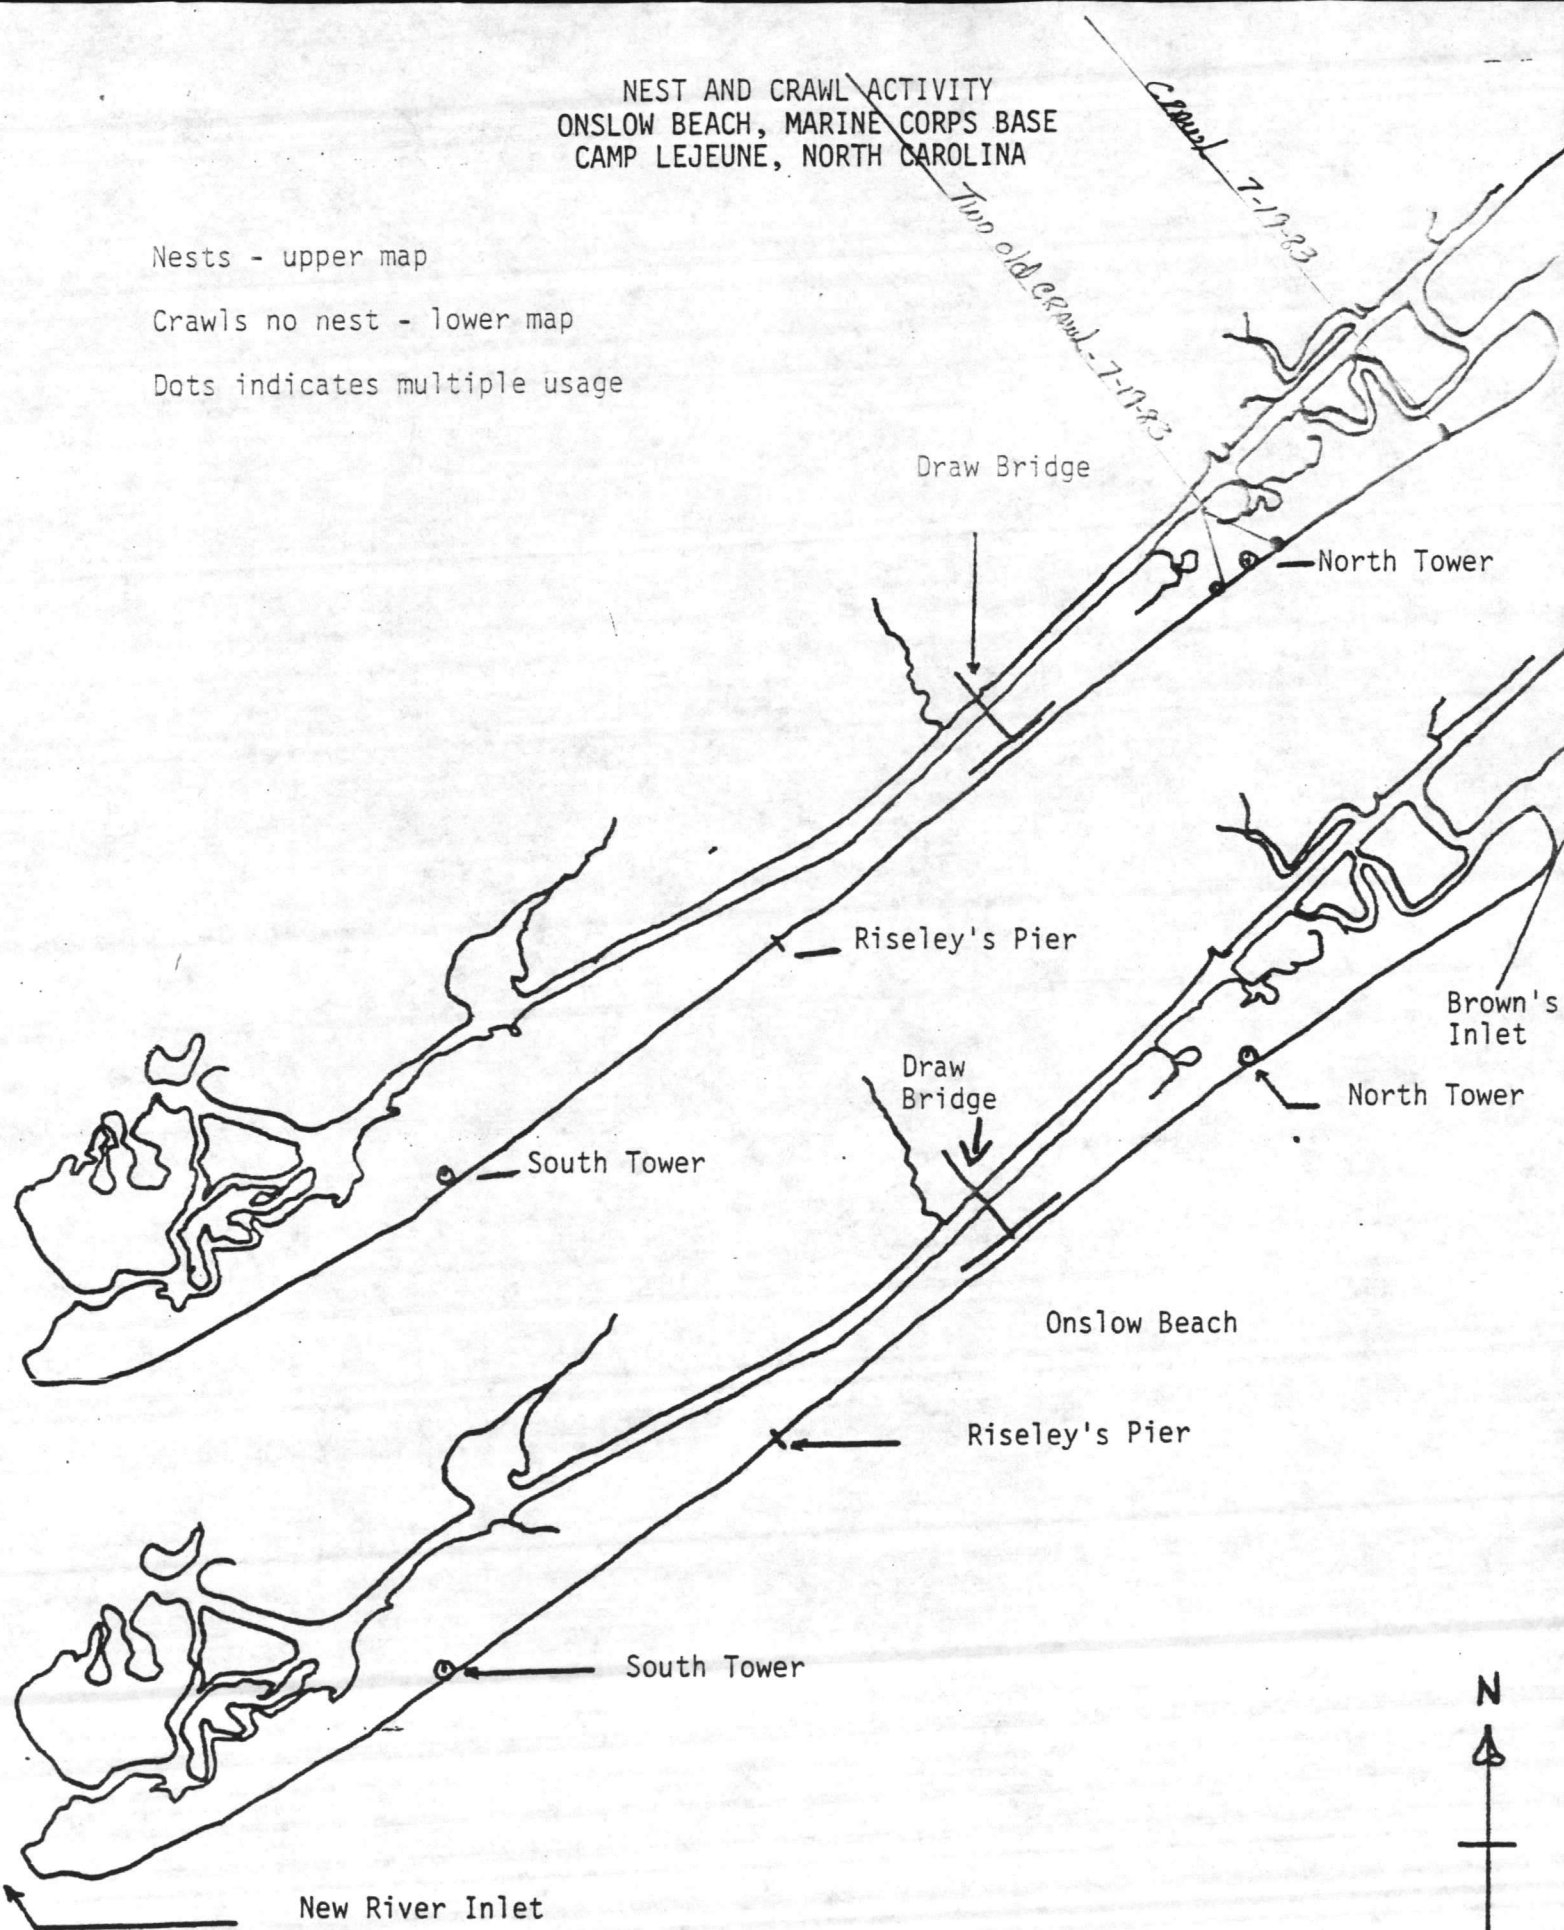

 

AERIAL SURVEY DATA

Date: July 22 82 Time: S 06:00 F 08:00

Recorder Name: Jenny R. Rich

Crew Names: None Pilot: J. R. Rich

Co-Pilot: None Crew Chief: None

Others: None

Weather: General SCT TWR & rain Cloud Cover 2000-3000 BKN

Wind Speed SW 10-12 K Sea Conditions Chop White Caps


BEACH AERIAL SURVEYS Altitude 100 Ft
 Air Speed 60 K

Location	Crawls		Nests		Nest Predation	
	New	Old	New	Old	New	Old
Onslow Beach	0	0	0	1	0	0
Browns Island	0	0	0	1	1	0
Bear Beach	0	0	0	0	0	0

OCEAN AERIAL SURVEYS Altitude 300 FT
 Air Speed 60 K

	Live Turtles		Dead Turtles
	Juvenile	Adults	
Bell Buoy from Bogue Inlet to New River Inlet	None	None	None


Comments: _____

 

R E S T
T E R R E T


LEGEND

- PRIMITIVE OR UNIMPROVED ROAD
- GRADED AND DRAINED ROAD
- SOIL, GRAVEL OR STONE SURFACED ROAD
- HARD SURFACED ROAD
- 4 LANE UNDIVIDED HIGHWAY
- DIVIDED HIGHWAY
- HIGHWAY WITH FRONTAGE ROADS
- FULL CONTROL ACCESS
- FEDERAL AID INTERSTATE ROAD
- FEDERAL AID PRIMARY ROAD
- FEDERAL AID SECONDARY ROAD
- FEDERAL AID URBAN
- NON-SYSTEM ROAD
- PROJECTED LOCATION
- INTERSECTION DISTANCE
- TRAFFIC CIRCLE
- HIGHWAY INTERCHANGE
- DETAILED HIGHWAY INTERCHANGE
- INTERSTATE HIGHWAY
- U.S. NUMBERED HIGHWAY
- N.C. NUMBERED HIGHWAY
- SECONDARY ROAD NUMBERS
- UNDERGROUND CABLE
- RAILROAD, ANY NUMBER OF TRACKS USED BY SINGLE OPERATING COMPANY
- RAILROAD, ANY NUMBER OF TRACKS USED BY MORE THAN ONE OPERATING COMPANY ON SAME OR ADJACENT RIGHTS-OF-WAY
- RAILROAD STATION
- GRADE CROSSING
- UNDERPASS
- OVERPASS
- RAILROAD TUNNEL
- ARMY, NAVY OR MARINE CORPS FIELD
- COMM. OR MUNICIPAL AIRPORT
- MARKED AUXILIARY FIELD
- HANGAR ON FIELD "B" IN SYMBOL
- DOCK, PIER OR LANDING
- FREE OR TOLL FERRY
- LIGHT, NAUTICAL
- LIGHTHOUSE
- COAST GUARD STATION
- CANAL
- NARROW STREAM
- WIDE STREAM
- DAM WITH LOCK
- DAM
- RESERVOIR, POND OR LAKE
- PROMINENT PEAK, NUMERALS INDICATE ELEVATION
- ROAD THROUGH MOUNTAIN PASS
- HIGHWAY BRIDGE, OVER 20 FT.
- DRAW SPAN ON BRIDGE
- HIGHWAY TUNNEL
- FORD
- STATE LINE
- COUNTY LINE
- CITY LIMITS
- RESERVATION OR PARK BOUNDARY
- INSET AREA
- DELIMITED AREA, POPULATION EST.
- COUNTY SEAT
- OTHER TOWNS AND VILLAGES
- TRIANGULATION STATION
- INCORPORATED CITY OR VILLAGE, GENERALIZED
- SCHOOL
- CHURCH
- CHURCH WITH CEMETERY
- CEMETERY
- HOSPITAL
- CORRECTIONAL OR PENAL INSTN.
- HIGHWAY GARAGE, OR MAINT. YARD
- HIGHWAY DIV. OR DIST. OFFICE
- WEIGHT STATION
- PATROL STATION
- REST AREA
- MONUMENT - SMALL HISTORICAL SITE

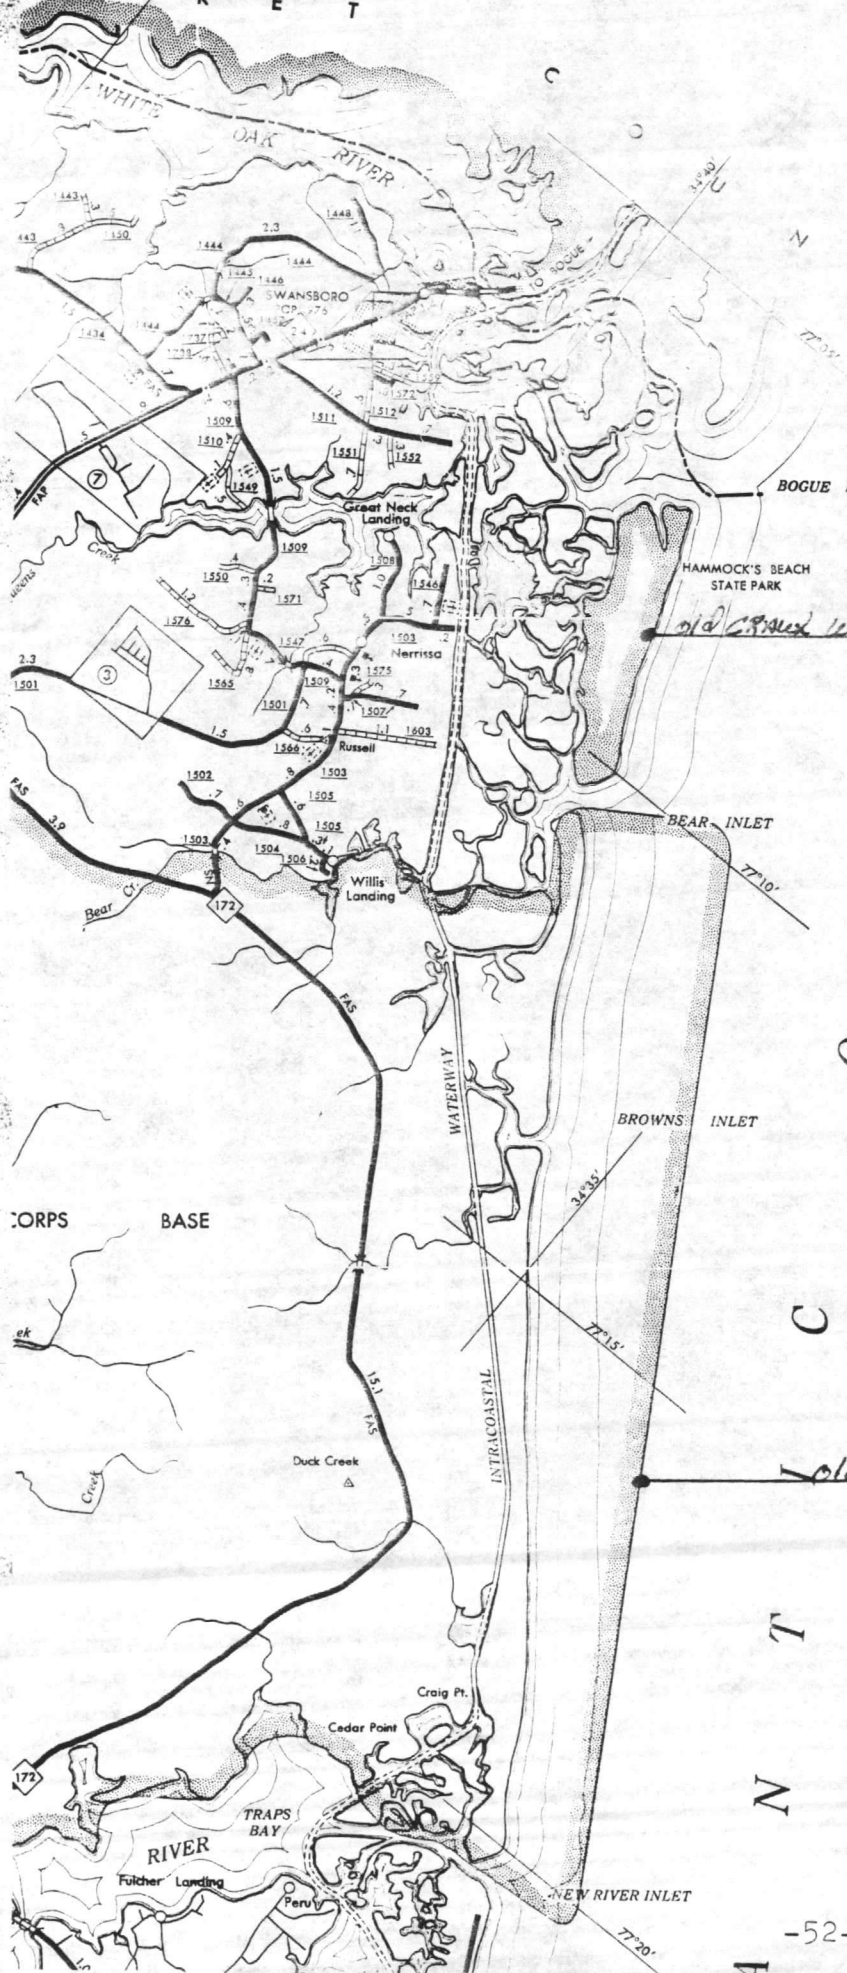

7-22-83 J.T.R. Rich

- - ONE CRAWL with NEST
- - ONE CRAWL with NEST Predations

 



NEST AND CRAWL ACTIVITY
ONslow BEACH, MARINE CORPS BASE
CAMP LEJEUNE, NORTH CAROLINA


Nests - upper map


Crawls no nest - lower map

Dots indicates multiple usage

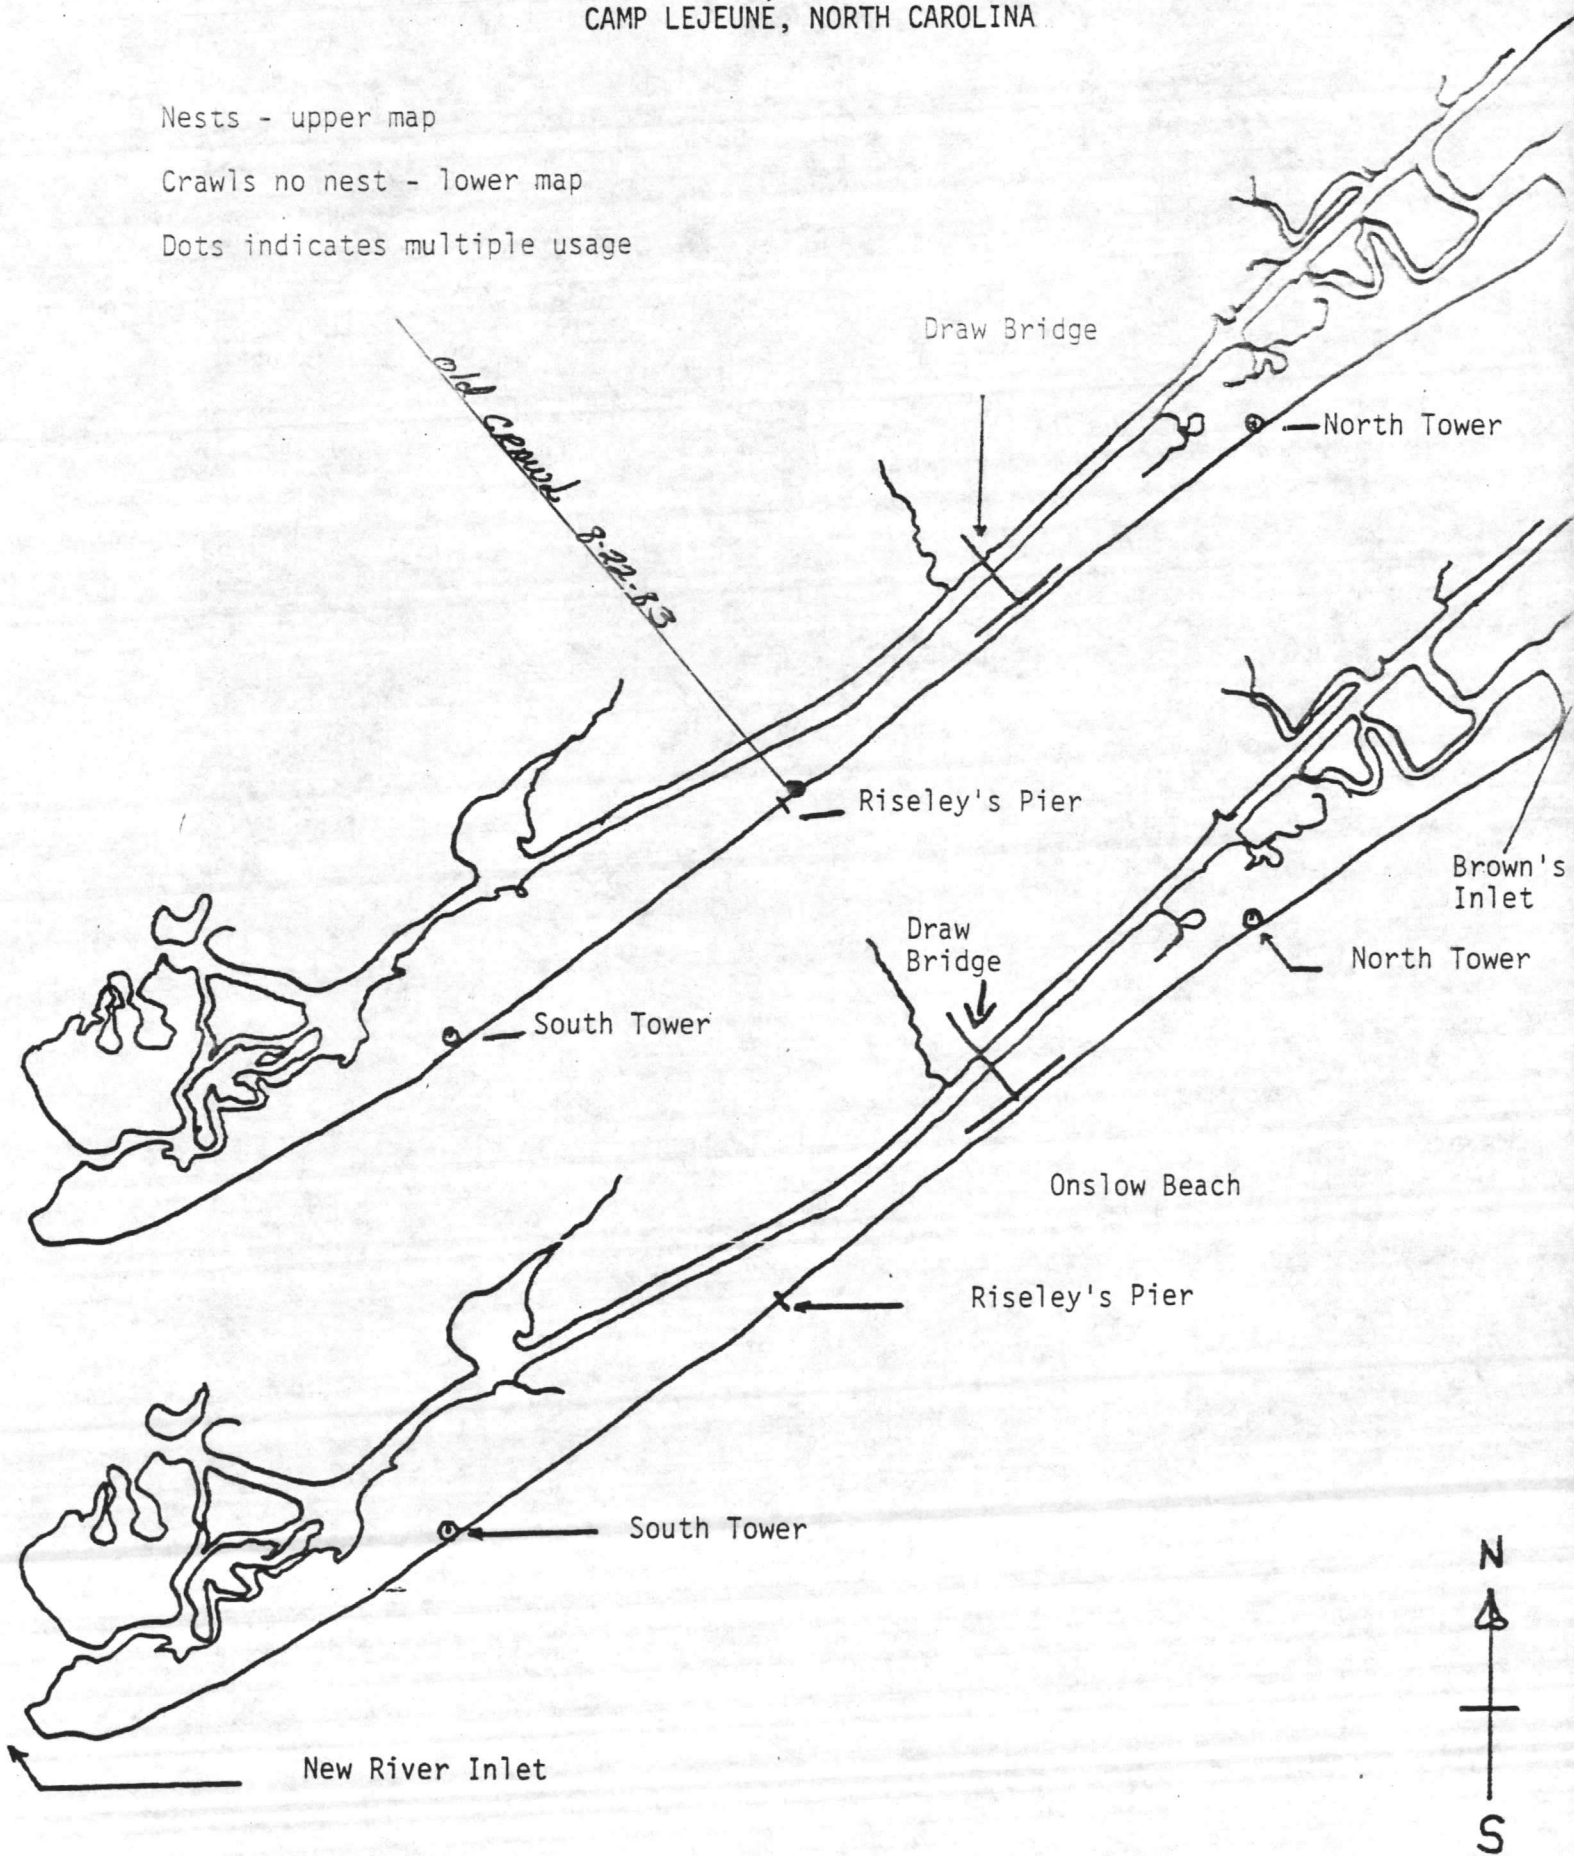

 

 

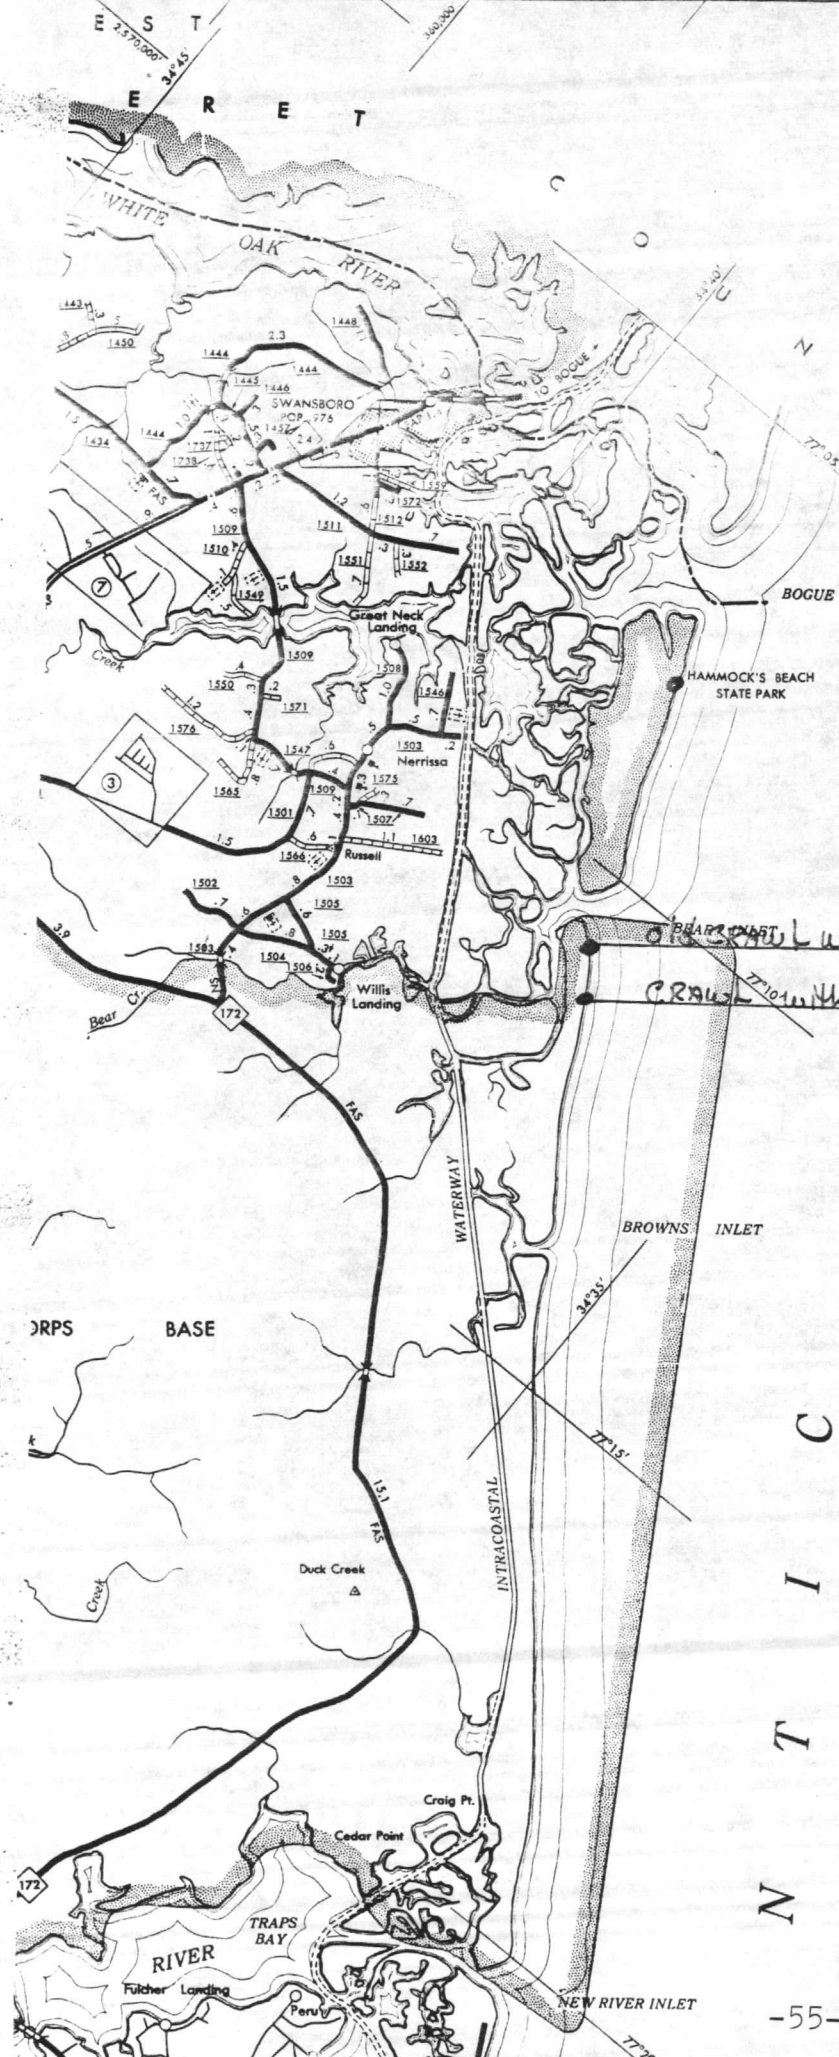


LEGEND

- PRIMITIVE OR UNIMPROVED ROAD
- GRADED AND DRAINED ROAD
- SOIL, GRAVEL OR STONE SURFACED ROAD
- HARD SURFACED ROAD
- 4 LANE UNDIVIDED HIGHWAY
- DIVIDED HIGHWAY
- HIGHWAY WITH FRONTAGE ROADS
- FULL CONTROL ACCESS
- FEDERAL AID INTERSTATE ROAD
- FEDERAL AID PRIMARY ROAD
- FEDERAL AID SECONDARY ROAD
- FEDERAL AID URBAN
- NON-SYSTEM ROAD
- PROJECTED LOCATION
- INTERSECTION DISTANCE
- TRAFFIC CIRCLE
- HIGHWAY INTERCHANGE
- DETAILED HIGHWAY INTERCHANGE
- INTERSTATE HIGHWAY
- U.S. NUMBERED HIGHWAY
- N.C. NUMBERED HIGHWAY
- SECONDARY ROAD NUMBERS
- UNDERGROUND CABLE
- RAILROAD, ANY NUMBER OF TRACKS USED BY SINGLE OPERATING COMPANY
- RAILROAD, ANY NUMBER OF TRACKS USED BY MORE THAN ONE OPERATING COMPANY ON SAME OR ADJACENT RIGHTS-OF-WAY
- RAILROAD STATION
- GRADE CROSSING
- UNDERPASS
- OVERPASS
- RAILROAD TUNNEL
- ARMY, NAVY OR MARINE CORPS FIELD
- COMM. OR MUNICIPAL AIRPORT
- MARKED AUXILIARY FIELD
- HANGAR ON FIELD "B" IN SYMBOL
- DOCK, PIER OR LANDING
- FREE OR TOLL FERRY
- LIGHT, NAUTICAL
- LIGHTHOUSE
- COAST GUARD STATION
- CANAL
- NARROW STREAM
- WIDE STREAM
- DAM WITH LOCK
- DAM
- RESERVOIR, POND OR LAKE
- PROMINENT PEAK, NUMERALS INDICATE ELEVATION
- ROAD THROUGH MOUNTAIN PASS
- HIGHWAY BRIDGE, OVER 20 FT.
- DRAW SPAN ON BRIDGE
- HIGHWAY TUNNEL
- FORD
- STATE LINE
- COUNTY LINE
- CITY LIMITS
- RESERVATION OR PARK BOUNDARY
- INSET AREA
- DELIMITED AREA, POPULATION EST.
- COUNTY SEAT
- OTHER TOWNS AND VILLAGES
- TRIANGULATION STATION
- INCORPORATED CITY OR VILLAGE, GENERALIZED
- SCHOOL
- CHURCH
- CHURCH WITH CEMETERY
- CEMETERY
- HOSPITAL
- CORRECTIONAL OR PENAL INSTN.
- HIGHWAY GARAGE, OR MAINT. YARD
- HIGHWAY DIV. OR DIST. OFFICE
- WEIGHT STATION
- PATROL STATION
- REST AREA
- MONUMENT - SMALL HISTORICAL SITE

7-27-83 J.R. RICH

• - Two Cranks with NEST Predation

 

AERIAL SURVEY DATA

Date: July 29 1980 Time: S 06:14 F 08:30

Recorder Name: J. R. Rich

Crew Names: None Pilot: J. R. Rich

Co-Pilot: None Crew Chief: None

Others: None

Weather: General 3000 BKII 7 miles vis. Cloud Cover 3000 BKII

Wind Speed Less than 5 K. Sea Conditions Calm

BEACH AERIAL SURVEYS Altitude 100 Ft

Air Speed 60 K


Location	Crawls		Nests		Nest Predation	
	New	Old	New	Old	New	Old
Onslow Beach	1	2	3	0	0	0
Browns Island	1	1	1	1	2	0
Bear Beach	1	0	1	0	1	0

OCEAN AERIAL SURVEYS Altitude 300 FT

Air Speed 60 K

	Live Turtles		Dead Turtles
	Juvenile	Adults	
Bell Buoy from Bogue Inlet to New River Inlet	None	None	None

Comments: _____

 

R E S T
T E R R E T


LEGEND

- PRIMITIVE OR UNIMPROVED ROAD
- GRADED AND DRAINED ROAD
- SOIL, GRAVEL OR STONE SURFACED ROAD
- HARD SURFACED ROAD
- 4 LANE UNDIVIDED HIGHWAY
- DIVIDED HIGHWAY
- HIGHWAY WITH FRONTAGE ROADS
- FULL CONTROL ACCESS
- FEDERAL AID INTERSTATE ROAD
- FEDERAL AID PRIMARY ROAD
- FEDERAL AID SECONDARY ROAD
- FEDERAL AID URBAN
- NON-SYSTEM ROAD
- PROJECTED LOCATION
- INTERSECTION DISTANCE
- TRAFFIC CIRCLE
- HIGHWAY INTERCHANGE
- DETAILED HIGHWAY INTERCHANGE
- INTERSTATE HIGHWAY
- U.S. NUMBERED HIGHWAY
- N.C. NUMBERED HIGHWAY
- SECONDARY ROAD NUMBERS
- UNDERGROUND CABLE
- RAILROAD, ANY NUMBER OF TRACKS USED BY SINGLE OPERATING COMPANY
- RAILROAD, ANY NUMBER OF TRACKS USED BY MORE THAN ONE OPERATING COMPANY ON SAME OR ADJACENT RIGHTS-OF-WAY
- RAILROAD STATION
- GRADE CROSSING
- UNDERPASS
- OVERPASS
- RAILROAD TUNNEL
- ARMY, NAVY OR MARINE CORPS FIELD
- COMM. OR MUNICIPAL AIRPORT
- MARKED AUXILIARY FIELD
- HANGAR ON FIELD "B" IN SYMBOL
- DOCK, PIER OR LANDING
- FREE OR TOLL FERRY
- LIGHT, NAUTICAL
- LIGHTHOUSE
- COAST GUARD STATION
- CANAL
- NARROW STREAM
- WIDE STREAM
- DAM WITH LOCK
- DAM
- RESERVOIR, POND OR LAKE
- PROMINENT PEAK, NUMERALS INDICATE ELEVATION
- ROAD THROUGH MOUNTAIN PASS
- HIGHWAY BRIDGE, OVER 20 FT.
- DRAW SPAN ON BRIDGE
- HIGHWAY TUNNEL
- FORD
- STATE LINE
- COUNTY LINE
- CITY LIMITS
- RESERVATION OR PARK BOUNDARY
- INSET AREA
- DELIMITED AREA, POPULATION EST.
- COUNTY SEAT
- OTHER TOWNS AND VILLAGES
- TRIANGULATION STATION
- INCORPORATED CITY OR VILLAGE, GENERALIZED
- SCHOOL
- CHURCH
- CHURCH WITH CEMETERY
- CEMETERY
- CORRECTIONAL OR PENAL INSTN.
- HIGHWAY GARAGE, OR MAINT. YARD
- HIGHWAY DIV. OR DIST. OFFICE
- WEIGHT STATION
- PATROL STATION
- REST AREA
- MONUMENT - SMALL HISTORICAL SITE



Terry-R. Rich - 7-29-83

•	THREE CRAWLS with NEST
•	ONE Edge CRAWL
•	THREE CRAWLS with NEST Predation

 



NEST AND CRAWL ACTIVITY
ONslow BEACH, MARINE CORPS BASE
CAMP LEJEUNE, NORTH CAROLINA

Nests - upper map

Crawls no nest - lower map

Dots indicates multiple usage

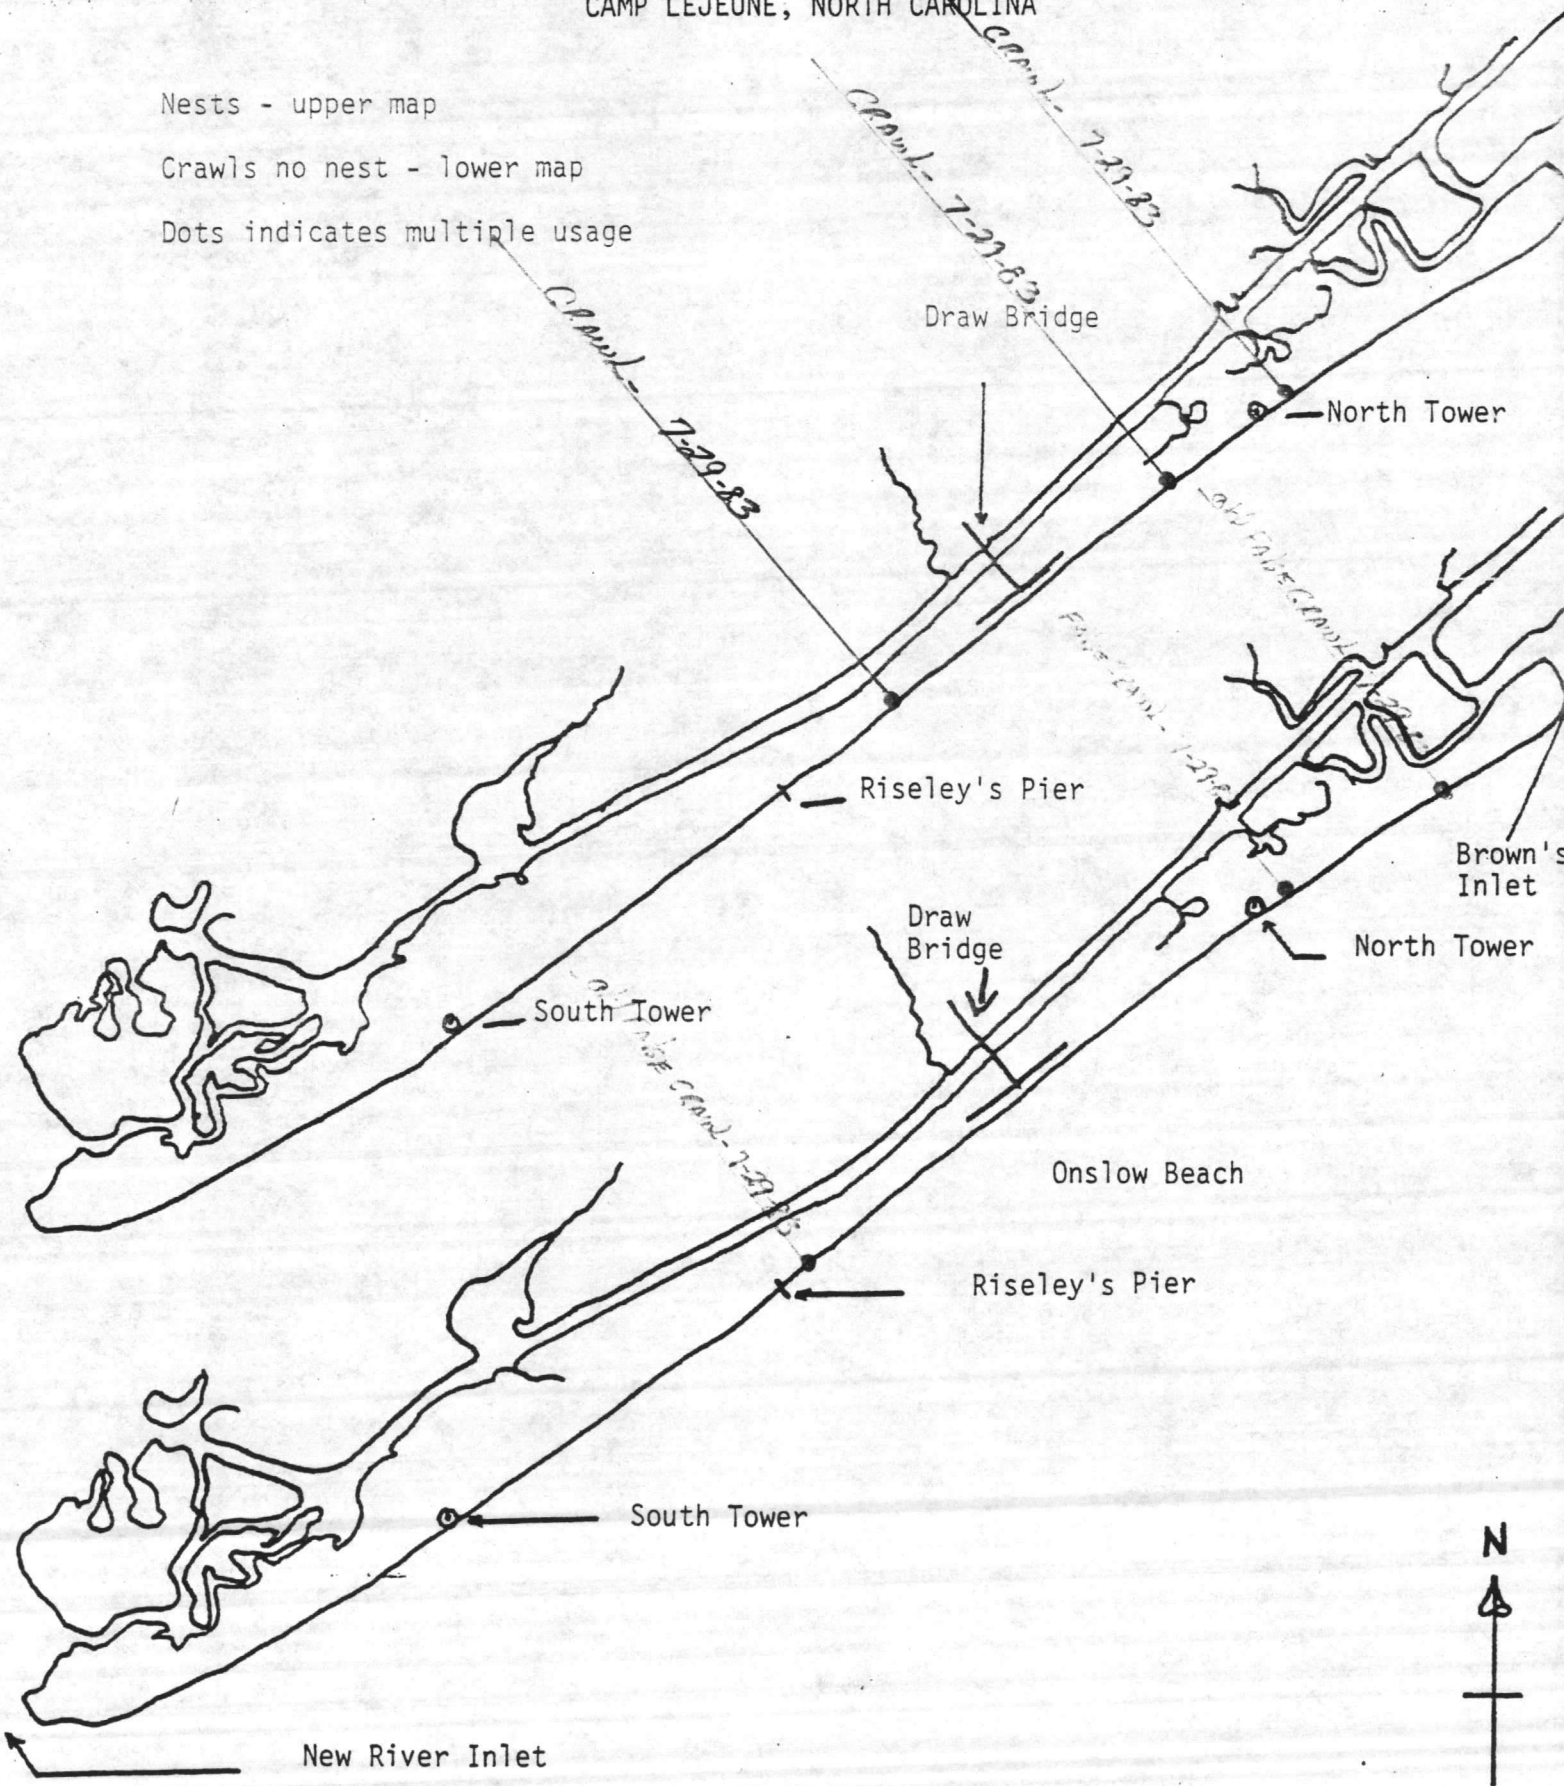

 

AERIAL SURVEY DATA

Date: August 4 1983 Time: S 08:00 F 09:00

Recorder Name: Jerry R. Rich

Crew Names: None Pilot: J. R. Rich

Co-Pilot: None Crew Chief: None

Others: None

Weather: General 1000 Bkn Rain Cloud Cover 1000 BKN

Wind Speed Calm Sea Conditions Calm

BEACH AERIAL SURVEYS Altitude 100 Ft

Air Speed 60 K


Location	Crawls		Nests		Nest Predation	
	New	Old	New	Old	New	Old
Onslow Beach	1	0	1	0	0	0
Browns Island	2	0	0	4	2	0
Bear Beach	0	0	2	1	0	0


OCEAN AERIAL SURVEYS Altitude 300 Ft

Air Speed 60 K

	Live Turtles		Dead Turtles
	Juvenile	Adults	
Bell Buoy from Bogue Inlet to New River Inlet	None	None	None

Comments:

 


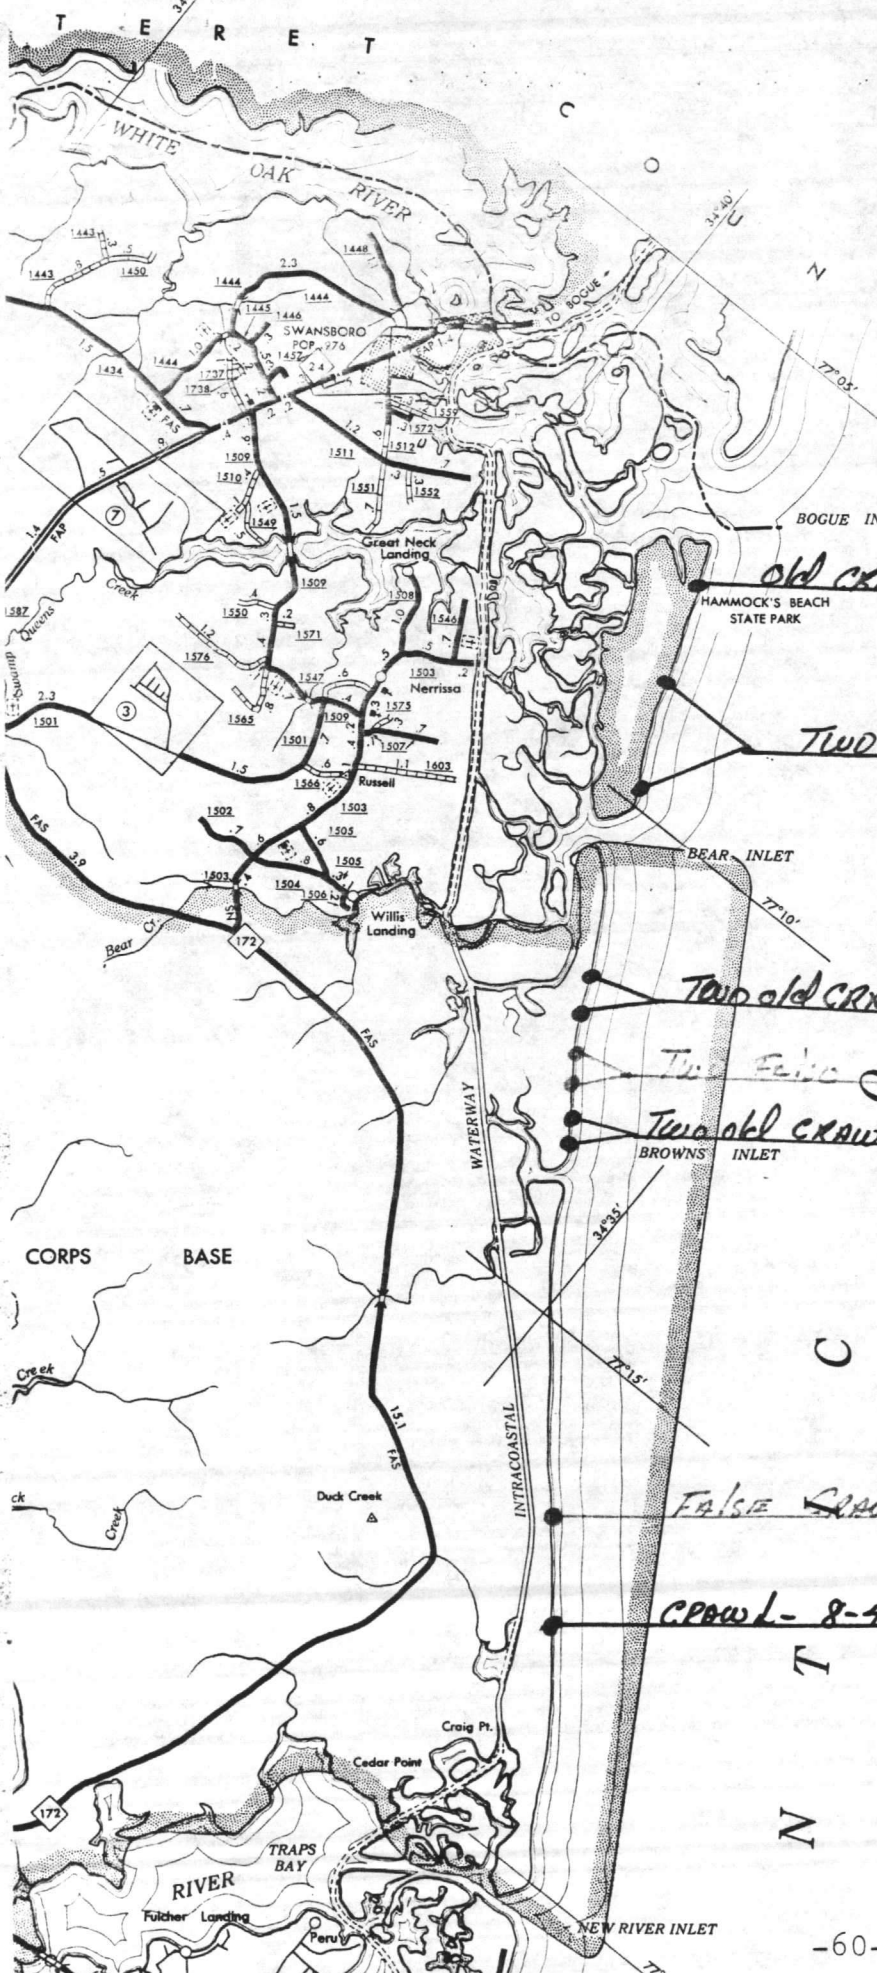

LEGEND

- PRIMITIVE OR UNIMPROVED ROAD
- GRADED AND DRAINED ROAD
- SOIL, GRAVEL OR STONE SURFACED ROAD
- HARD SURFACED ROAD
- 4 LANE UNDIVIDED HIGHWAY
- DIVIDED HIGHWAY
- HIGHWAY WITH FRONTAGE ROADS
- FULL CONTROL ACCESS
- FEDERAL AID INTERSTATE ROAD
- FEDERAL AID PRIMARY ROAD
- FEDERAL AID SECONDARY ROAD
- FEDERAL AID URBAN
- NON-SYSTEM ROAD
- PROJECTED LOCATION
- INTERSECTION DISTANCE
- TRAFFIC CIRCLE
- HIGHWAY INTERCHANGE
- DETAILED HIGHWAY INTERCHANGE
- INTERSTATE HIGHWAY
- U.S. NUMBERED HIGHWAY
- N.C. NUMBERED HIGHWAY
- SECONDARY ROAD NUMBERS
- UNDERGROUND CABLE
- RAILROAD, ANY NUMBER OF TRACKS USED BY SINGLE OPERATING COMPANY
- RAILROAD, ANY NUMBER OF TRACKS USED BY MORE THAN ONE OPERATING COMPANY ON SAME OR ADJACENT RIGHTS-OF-WAY
- RAILROAD STATION
- GRADE CROSSING
- UNDERPASS
- OVERPASS
- RAILROAD TUNNEL
- ARMY, NAVY OR MARINE CORPS FIELD
- COMM. OR MUNICIPAL AIRPORT
- MARKED AUXILIARY FIELD
- HANGAR ON FIELD "B" IN SYMBOL
- DOCK, PIER OR LANDING
- FREE OR TOLL FERRY
- LIGHT, NAUTICAL
- LIGHTHOUSE
- COAST GUARD STATION
- CANAL
- NARROW STREAM
- WIDE STREAM
- DAM WITH LOCK
- DAM
- RESERVOIR, POND OR LAKE
- PROMINENT PEAK, NUMERALS INDICATE ELEVATION
- ROAD THROUGH MOUNTAIN PASS
- HIGHWAY BRIDGE OVER 20 FT.
- DRAW SPAN ON BRIDGE
- HIGHWAY TUNNEL
- FORD
- STATE LINE
- COUNTY LINE
- CITY LIMITS
- RESERVATION OR PARK BOUNDARY
- INSET AREA
- DELIMITED AREA, POPULATION EST.
- COUNTY SEAT
- OTHER TOWNS AND VILLAGES
- TRIANGULATION STATION
- INCORPORATED CITY OR VILLAGE, GENERALIZED
- SCHOOL
- CHURCH
- CHURCH WITH CEMETERY
- CEMETERY
- HOSPITAL
- CORRECTIONAL OR PENAL INSTN.
- HIGHWAY GARAGE, OR MAINT. YARD
- HIGHWAY DIV. OR DIST. OFFICE
- WEIGHT STATION
- PATROL STATION
- REST AREA
- MONUMENT - SMALL HISTORICAL SITE

- 8-4-83
- - Six Crawls with NEST 8-4-83
 - - ~~Two False Crawls~~
 - - Two old crawls with NEST Predation

 



NEST AND CRAWL ACTIVITY
ON SLOW BEACH, MARINE CORPS BASE
CAMP LEJEUNE, NORTH CAROLINA

Nests - upper map

Crawls no nest - lower map

Dots indicates multiple usage

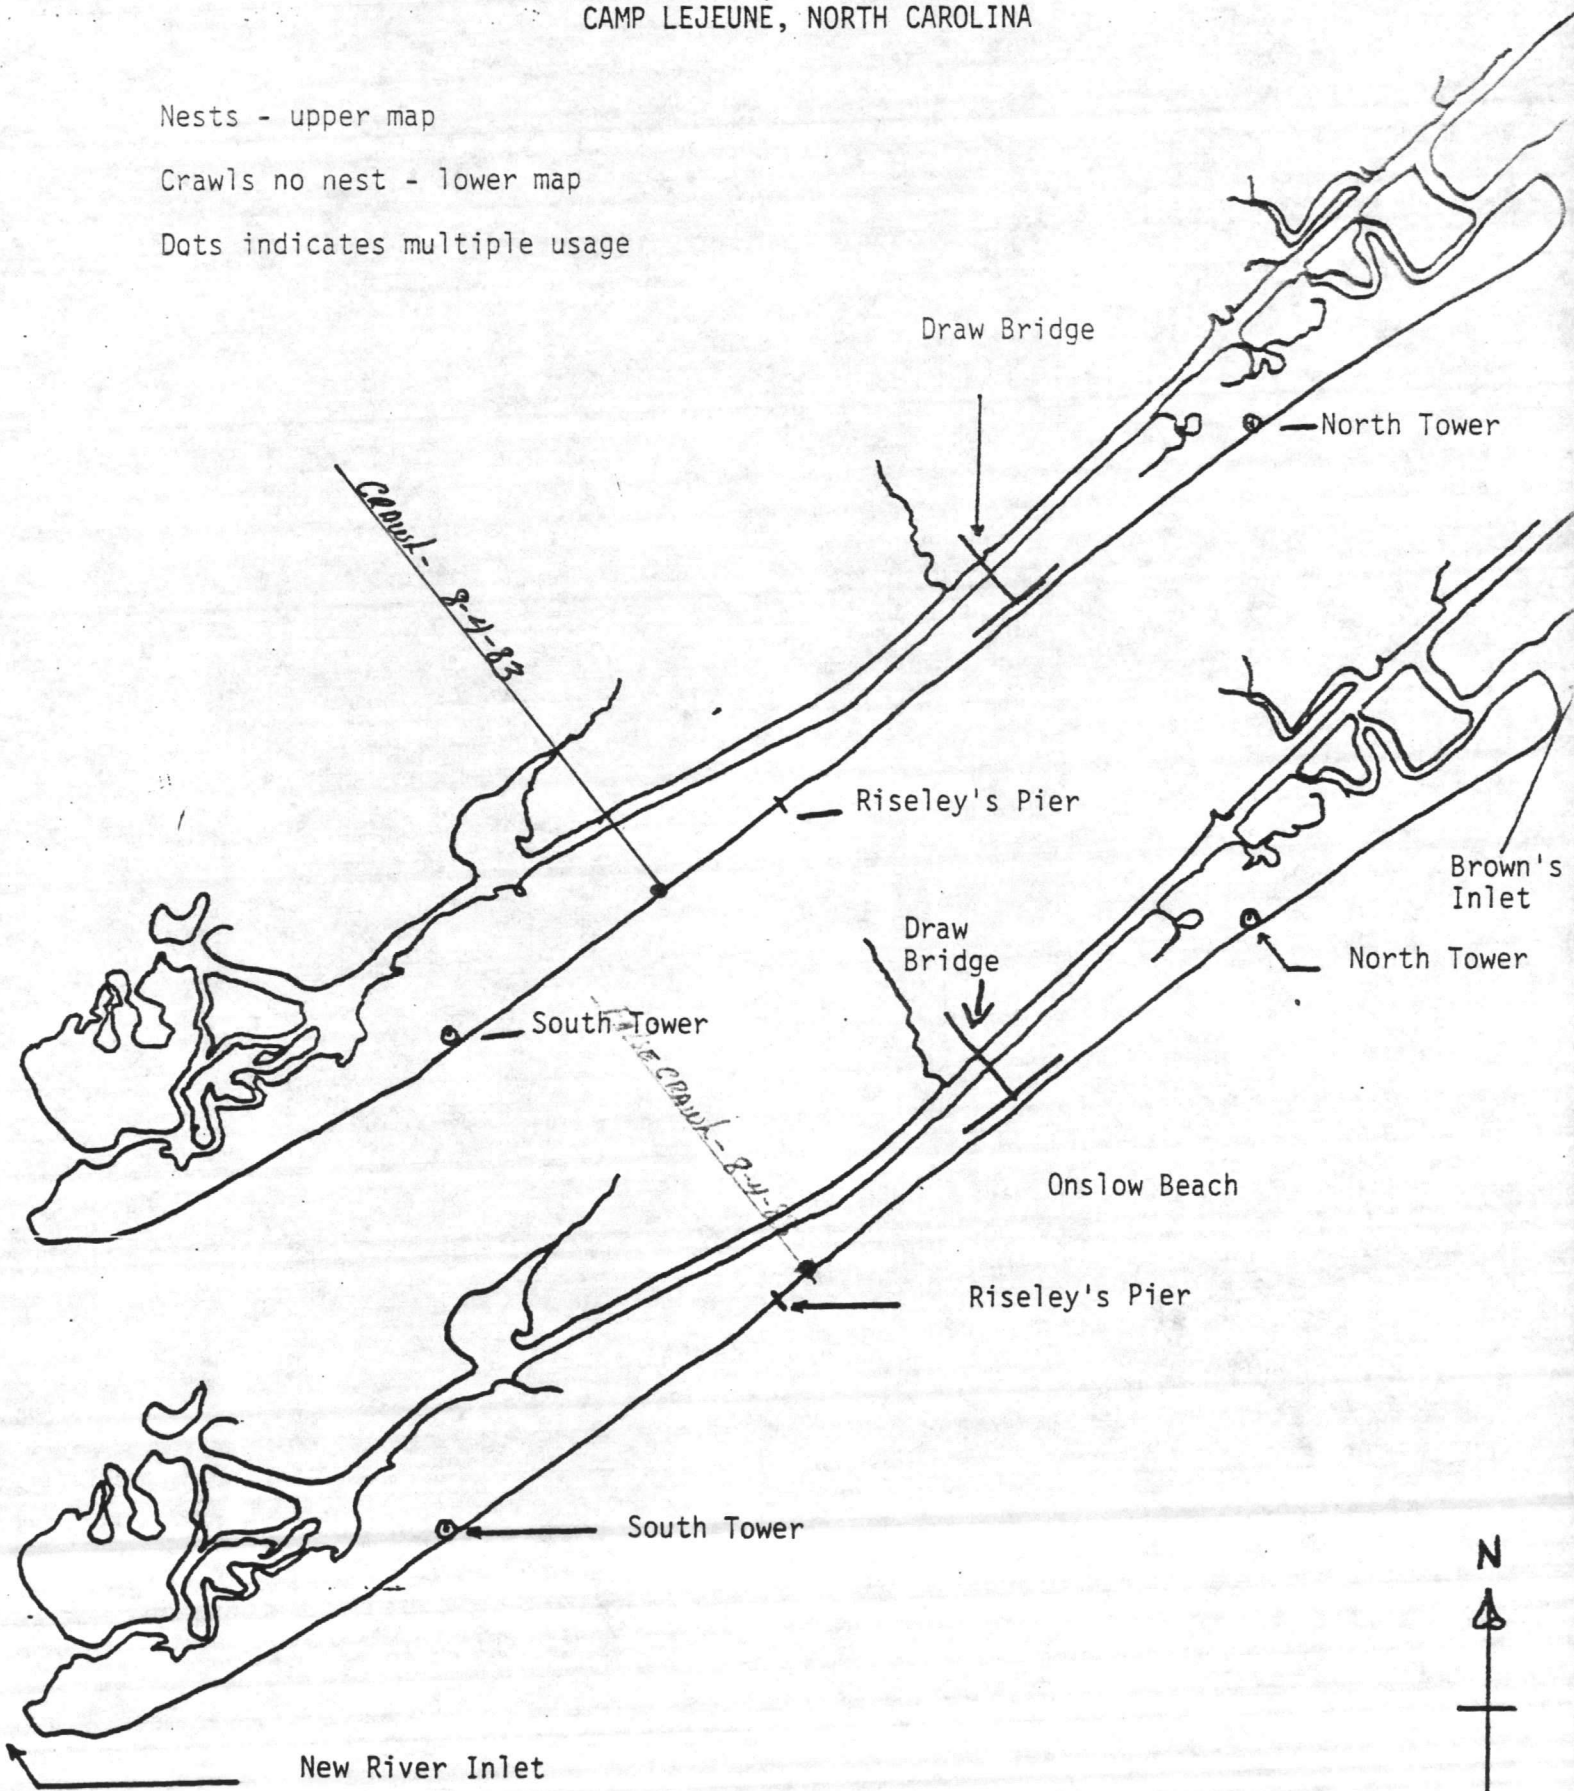

 

AERIAL SURVEY DATA

Date: August 9 1983 Time: S 06:10 F 08:12

Recorder Name: Jerry R. Rich

Crew Names: None Pilot: J. R. Rich

Co-Pilot: None Crew Chief: None

Others: None

Weather: General 2-3 miles fog & haze Cloud Cover Clear

Wind Speed SW 8 K Sea Conditions Light chop

BEACH AERIAL SURVEYS Altitude 100 Ft

Air Speed 60 K


Location	Crawls		Nests		Nest Predation	
	New	Old	New	Old	New	Old
Onslow Beach	1	0	0	0	0	0
Browns Island	1	0	4	0	3	0
Bear Beach	0	0	1	0	0	0


OCEAN AERIAL SURVEYS Altitude 300 Ft

Air Speed 60 K

	Live Turtles		Dead Turtles
	Juvenile	Adults	
Bell Buoy from Bogue Inlet to New River Inlet	None	None	None

Comments:

 

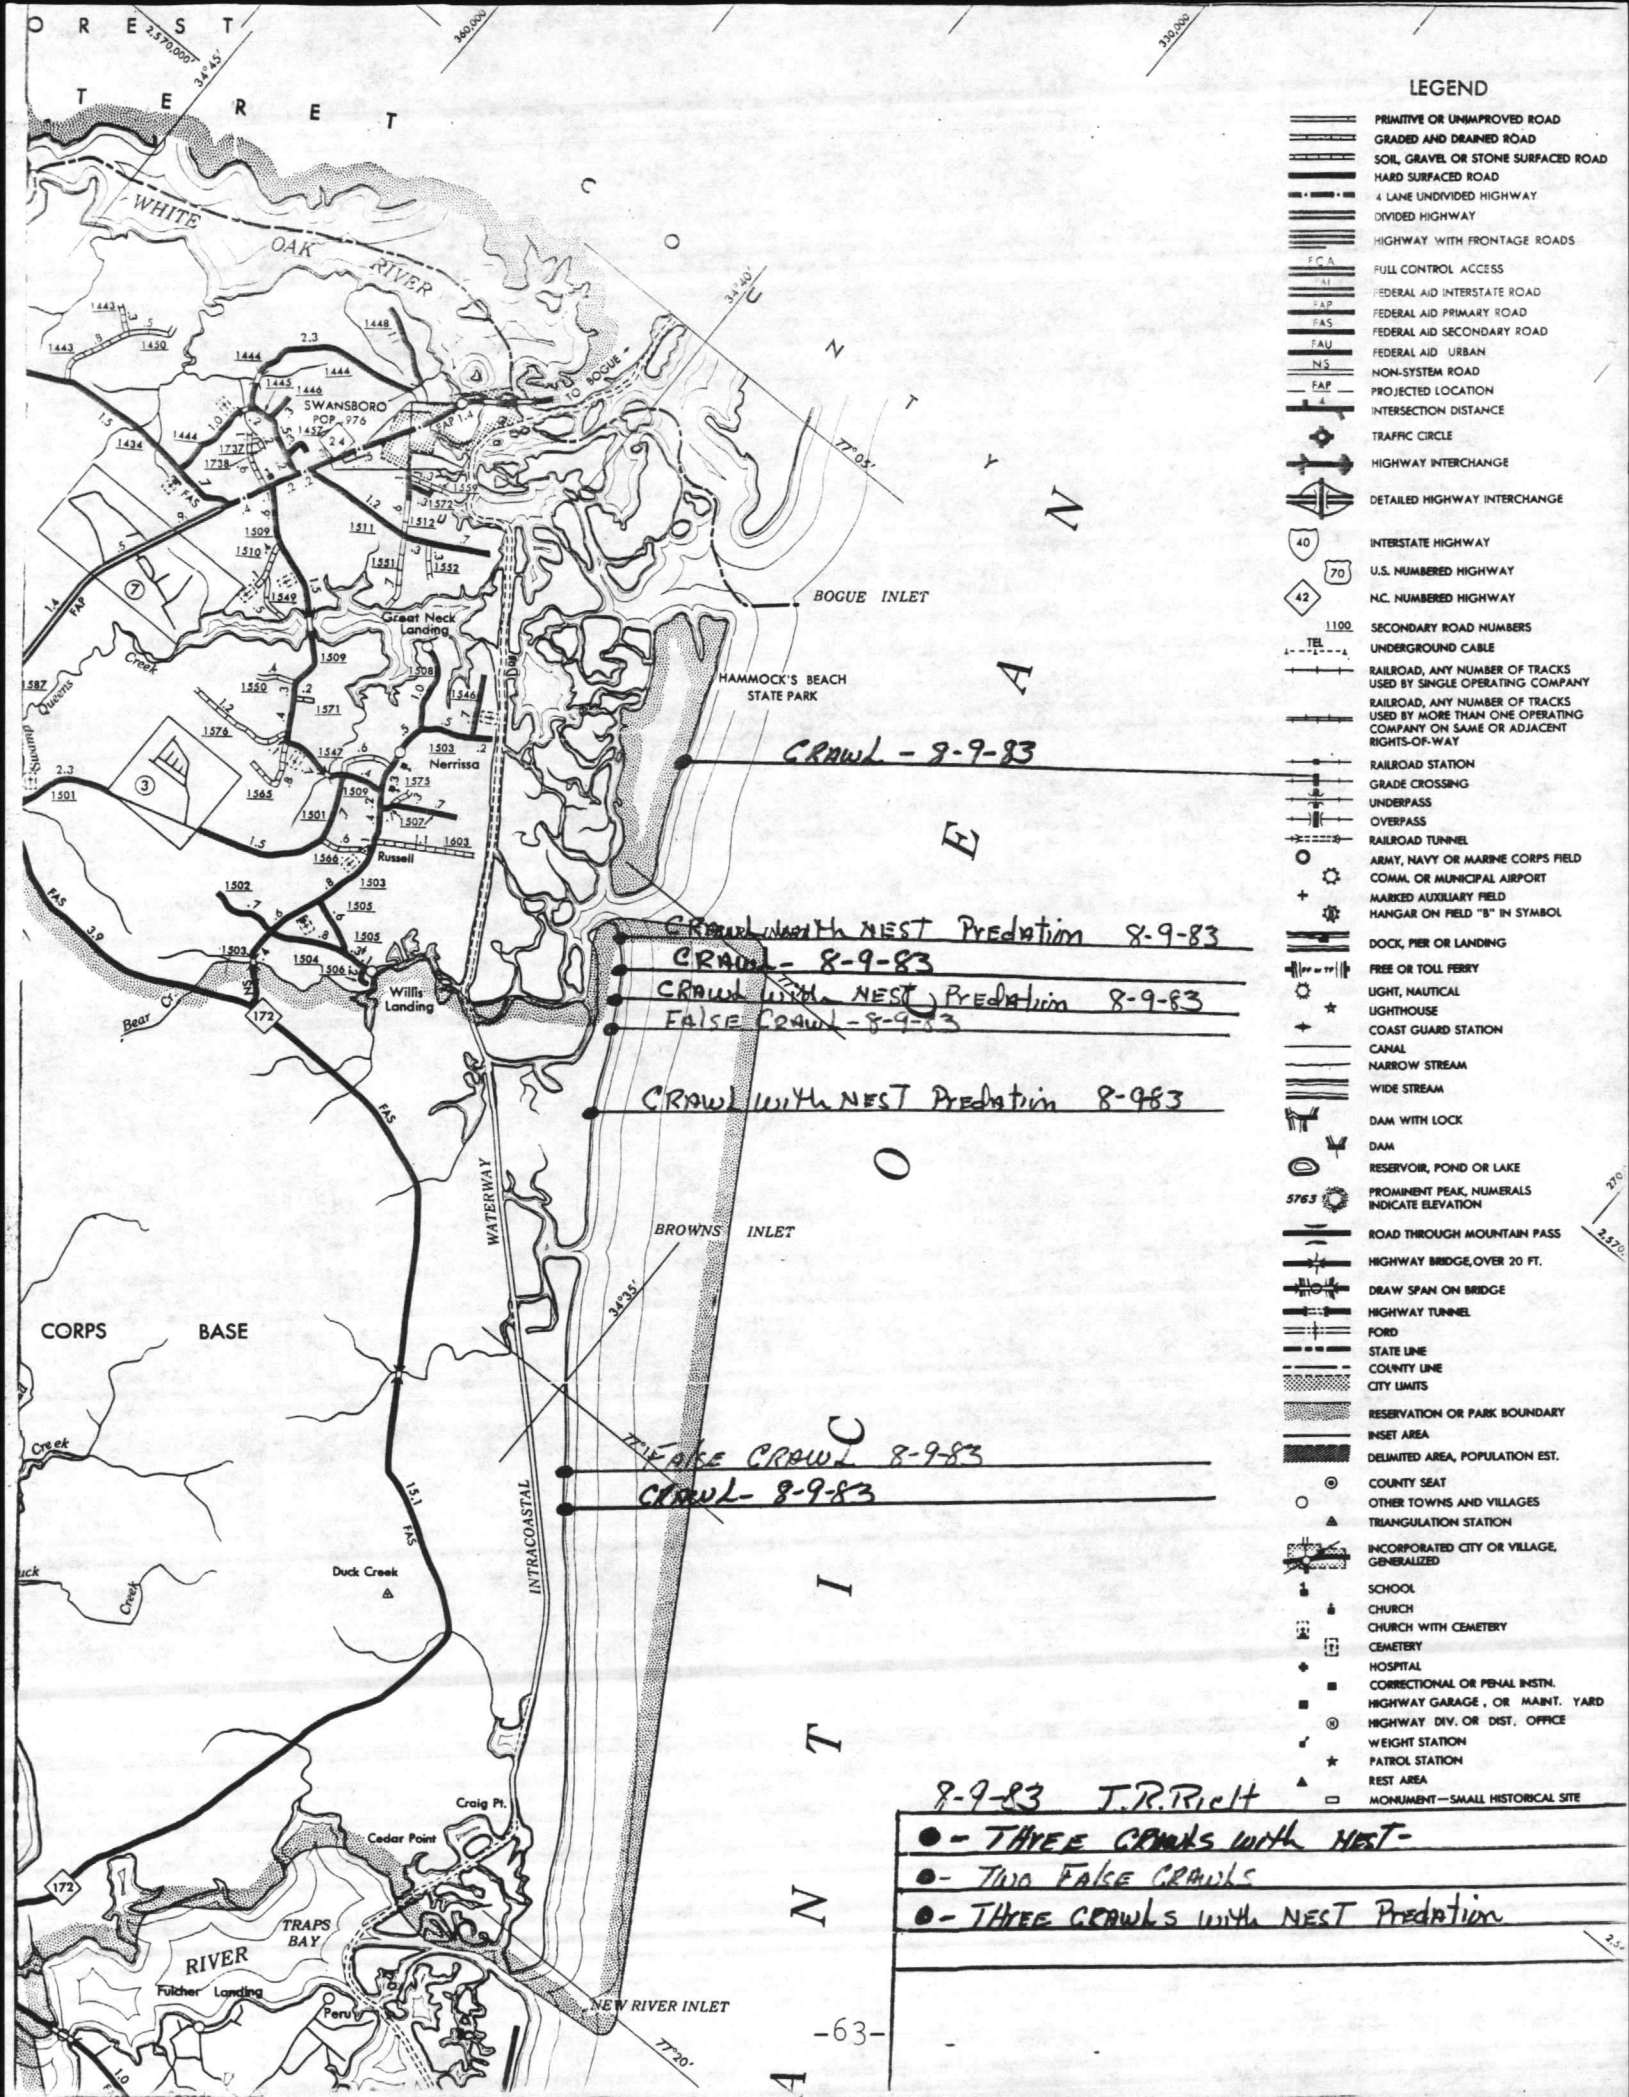

LEGEND

- PRIMITIVE OR UNIMPROVED ROAD
- GRADED AND DRAINED ROAD
- SOIL, GRAVEL OR STONE SURFACED ROAD
- HARD SURFACED ROAD
- 4 LANE UNDIVIDED HIGHWAY
- DIVIDED HIGHWAY
- HIGHWAY WITH FRONTAGE ROADS
- FULL CONTROL ACCESS
- FEDERAL AID INTERSTATE ROAD
- FEDERAL AID PRIMARY ROAD
- FEDERAL AID SECONDARY ROAD
- FEDERAL AID URBAN
- NON-SYSTEM ROAD
- PROJECTED LOCATION
- INTERSECTION DISTANCE
- TRAFFIC CIRCLE
- HIGHWAY INTERCHANGE
- DETAILED HIGHWAY INTERCHANGE
- INTERSTATE HIGHWAY
- U.S. NUMBERED HIGHWAY
- N.C. NUMBERED HIGHWAY
- SECONDARY ROAD NUMBERS
- UNDERGROUND CABLE
- RAILROAD, ANY NUMBER OF TRACKS USED BY SINGLE OPERATING COMPANY
- RAILROAD, ANY NUMBER OF TRACKS USED BY MORE THAN ONE OPERATING COMPANY ON SAME OR ADJACENT RIGHTS-OF-WAY
- RAILROAD STATION
- GRADE CROSSING
- UNDERPASS
- OVERPASS
- RAILROAD TUNNEL
- ARMY, NAVY OR MARINE CORPS FIELD COMM. OR MUNICIPAL AIRPORT
- MARKED AUXILIARY FIELD HANGAR ON FIELD "B" IN SYMBOL
- DOCK, PIER OR LANDING
- FREE OR TOLL FERRY
- LIGHT, NAUTICAL
- LIGHTHOUSE
- COAST GUARD STATION
- CANAL
- NARROW STREAM
- WIDE STREAM
- DAM WITH LOCK
- DAM
- RESERVOIR, POND OR LAKE
- PROMINENT PEAK, NUMERALS INDICATE ELEVATION
- ROAD THROUGH MOUNTAIN PASS
- HIGHWAY BRIDGE, OVER 20 FT.
- DRAW SPAN ON BRIDGE
- HIGHWAY TUNNEL
- FORD
- STATE LINE
- COUNTY LINE
- CITY LIMITS
- RESERVATION OR PARK BOUNDARY
- INSET AREA
- DELIMITED AREA, POPULATION EST.
- COUNTY SEAT
- OTHER TOWNS AND VILLAGES
- TRIANGULATION STATION
- INCORPORATED CITY OR VILLAGE, GENERALIZED
- SCHOOL
- CHURCH
- CHURCH WITH CEMETERY
- CEMETERY
- HOSPITAL
- CORRECTIONAL OR PENAL INSTN.
- HIGHWAY GARAGE, OR MAINT. YARD
- HIGHWAY DIV. OR DIST. OFFICE
- WEIGHT STATION
- PATROL STATION
- REST AREA
- MONUMENT - SMALL HISTORICAL SITE


CRAWL with NEST Predation 8-9-83

CRAWL - 8-9-83

CRAWL with NEST Predation 8-9-83

FALSE CRAWL - 8-9-83

CRAWL with NEST Predation 8-9-83

FALSE CRAWL 8-9-83


CRAWL - 8-9-83

8-9-83 T.R. RICH

● - THREE CRAWLS with NEST -

● - TWO FALSE CRAWLS

● - THREE CRAWLS with NEST Predation

 



NEST AND CRAWL ACTIVITY
 ONSLOW BEACH, MARINE CORPS BASE
 CAMP LEJEUNE, NORTH CAROLINA

Nests - upper map

Crawls no nest - lower map

Dots indicates multiple usage

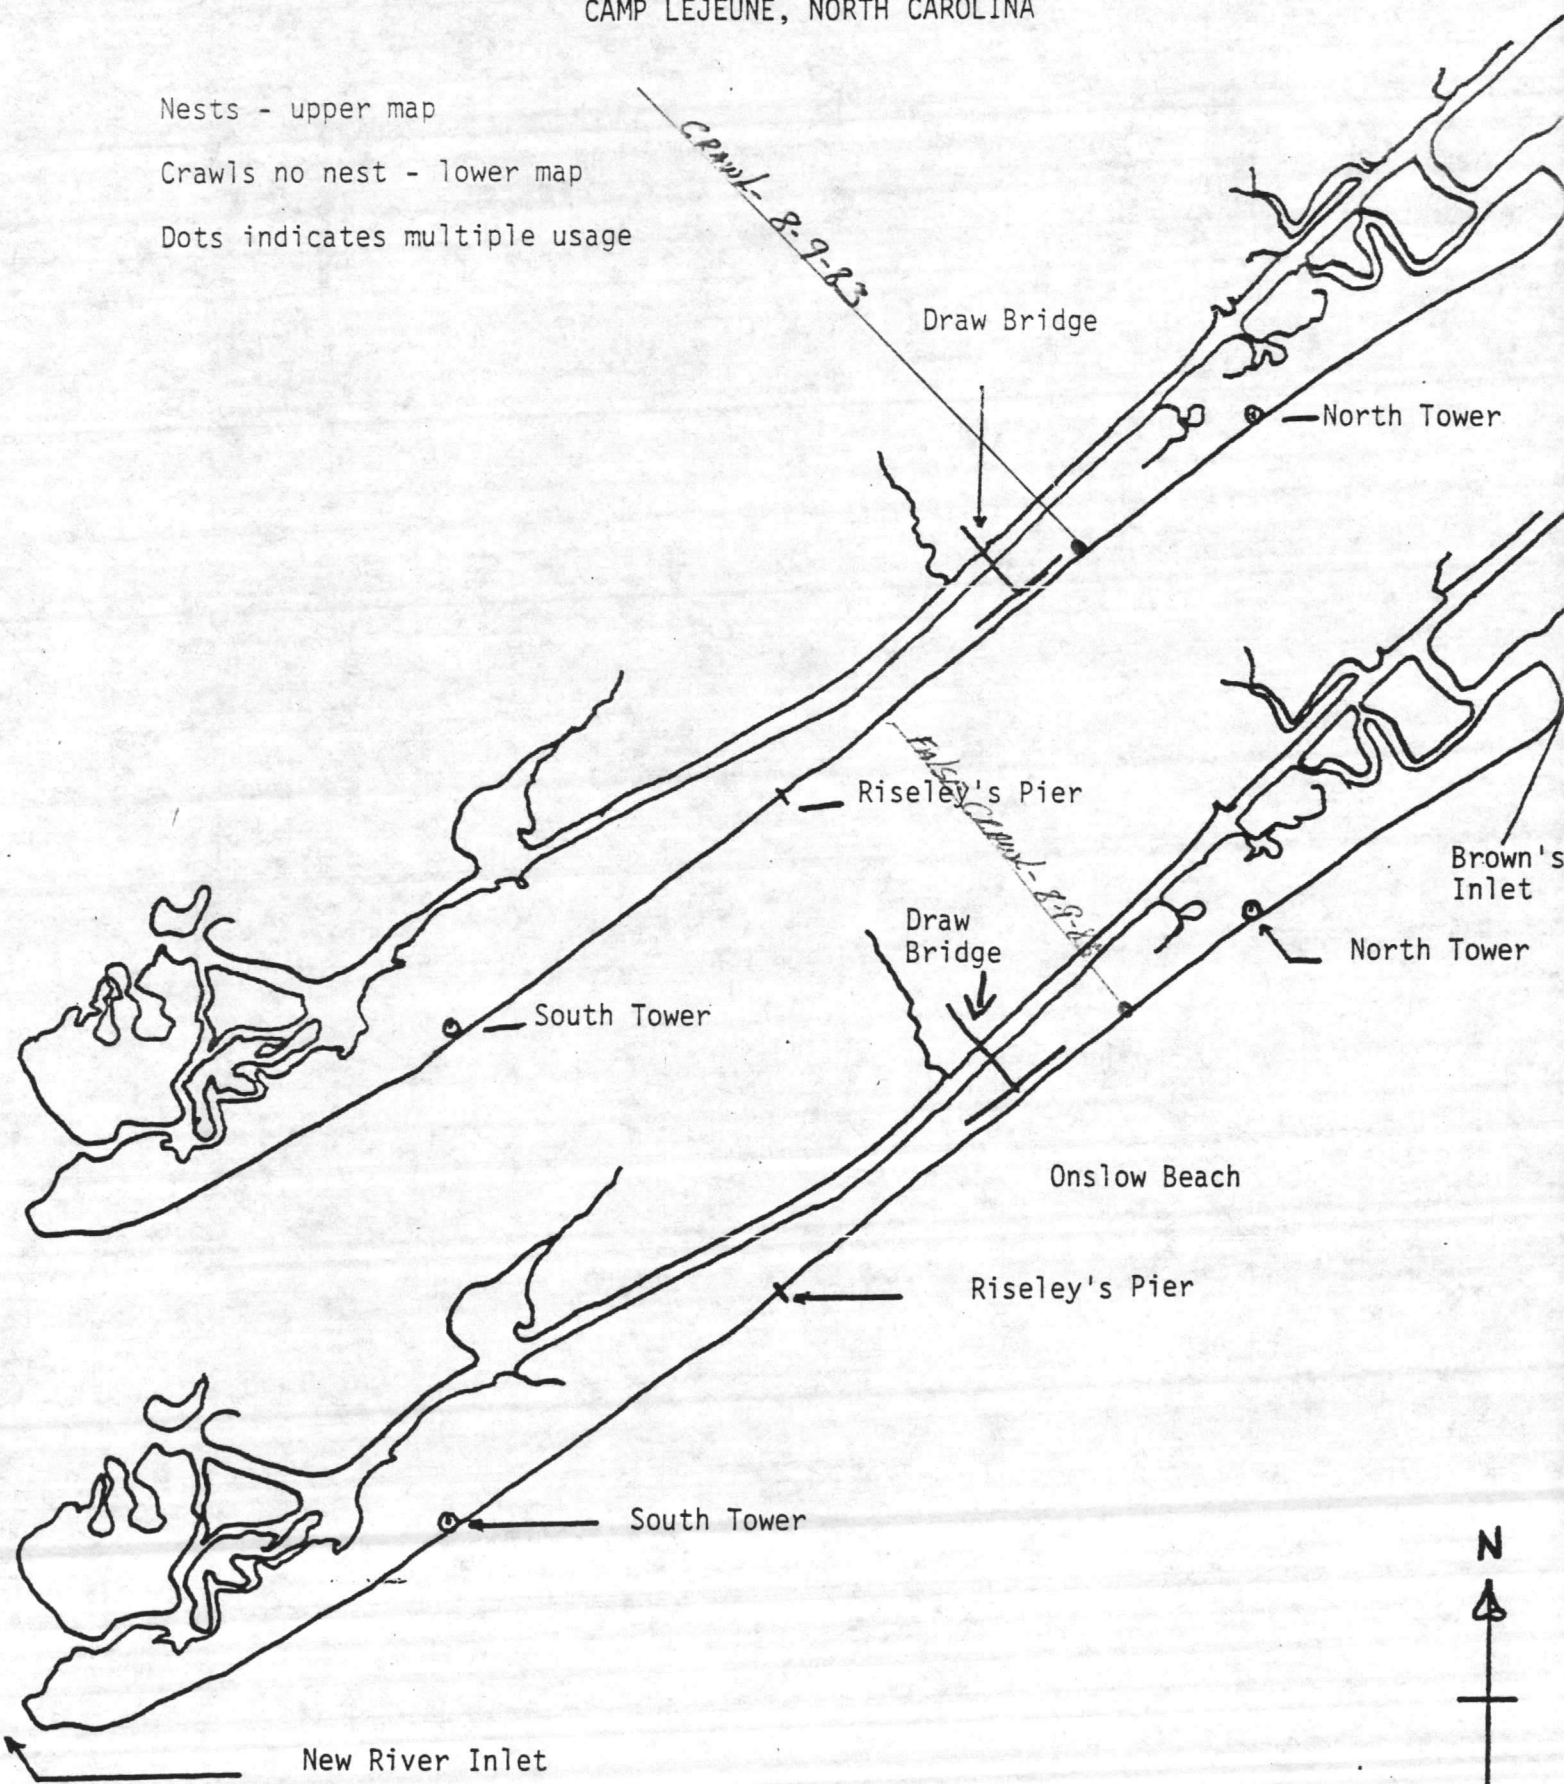

 

AERIAL SURVEY DATA

Date: August 11 1983 Time: S 06:02 F 08:22

Recorder Name: Jerry R. Rich

Crew Names: None Pilot: J. R. Rich

Co-Pilot: None Crew Chief: None

Others: None

Weather: General 1 mile fog & haze Cloud Cover 800 OVC

Wind Speed SW 8-10 K Sea Conditions Chop


BEACH AERIAL SURVEYS Altitude 100 Ft.
Air Speed 60 K


Location	Crawls		Nests		Nest Predation	
	New	Old	New	Old	New	Old
Onslow Beach	0	0	0	0	0	0
Browns Island	2	0	3	3	0	2
Bear Beach	2	0	3	0	0	0

OCEAN AERIAL SURVEYS Altitude 300 Ft
Air Speed 60 K

	Live Turtles		Dead Turtles
	Juvenile	Adults	
Bell Buoy from Bogue Inlet to New River Inlet	None	None	None

Comments:

 

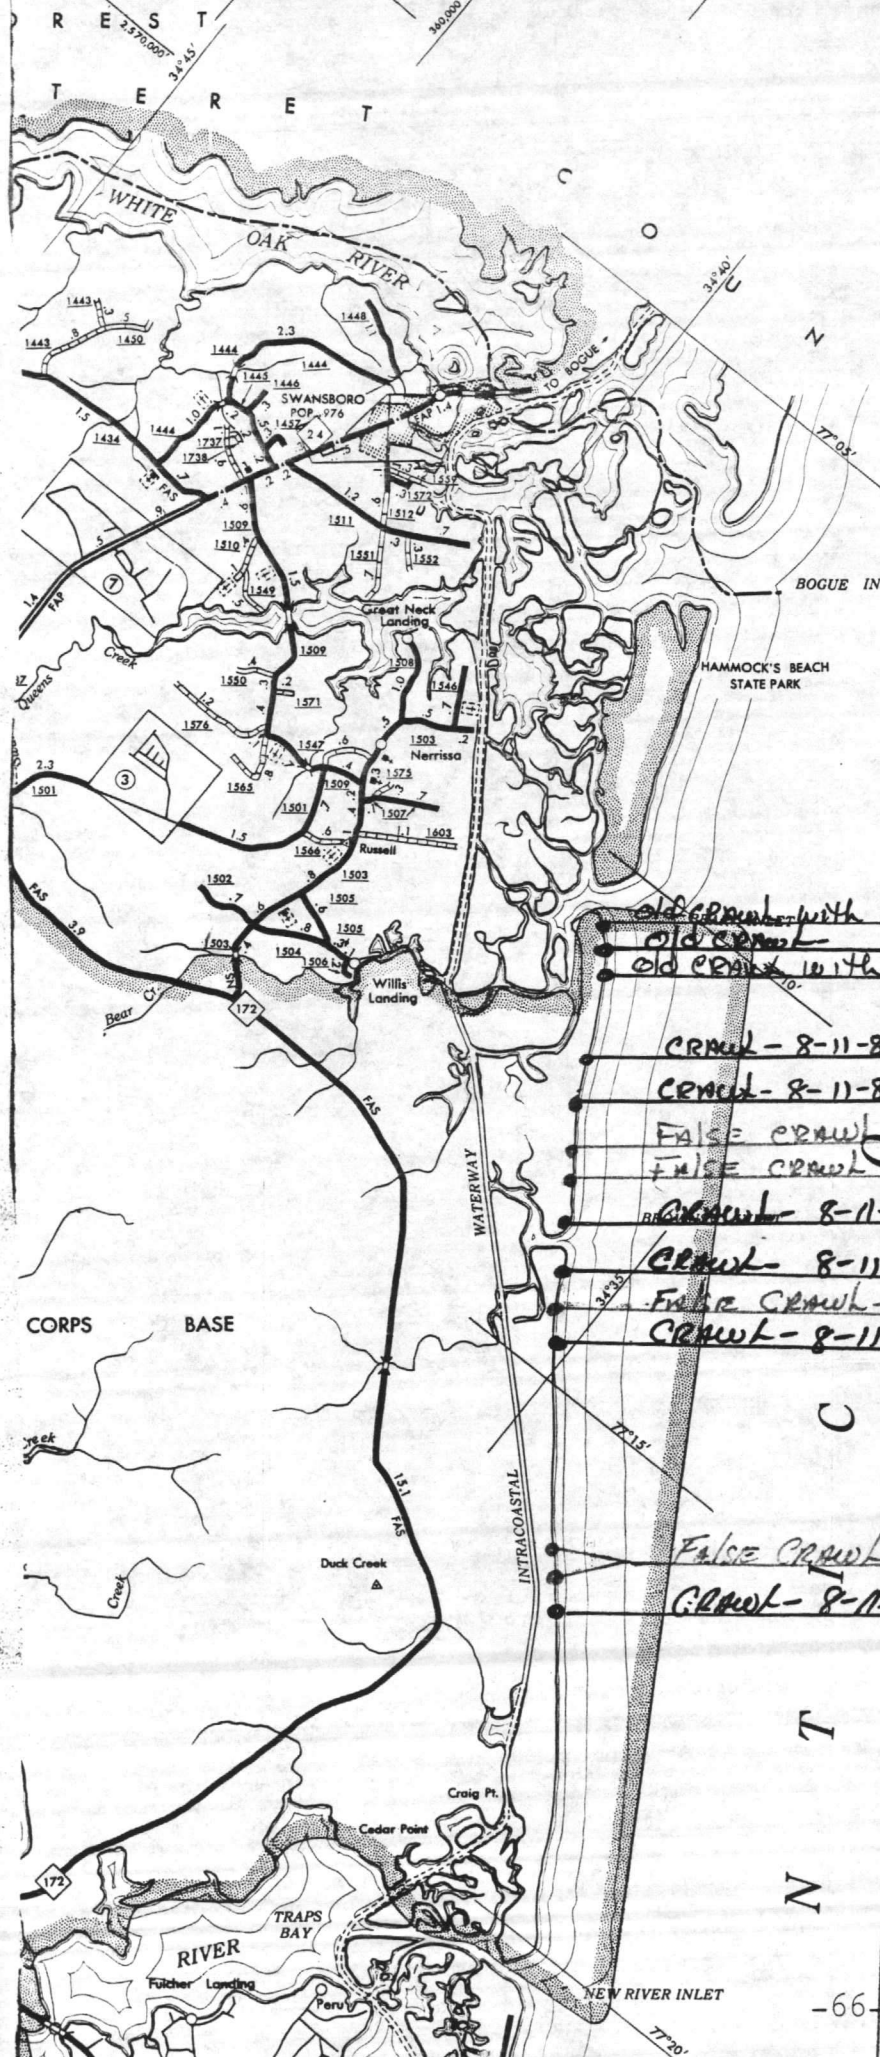


LEGEND

- PRIMITIVE OR UNIMPROVED ROAD
- GRADED AND DRAINED ROAD
- SOIL, GRAVEL OR STONE SURFACED ROAD
- HARD SURFACED ROAD
- 4 LANE UNDIVIDED HIGHWAY
- DIVIDED HIGHWAY
- HIGHWAY WITH FRONTAGE ROADS
- FCA FULL CONTROL ACCESS
- FAI FEDERAL AID INTERSTATE ROAD
- FAP FEDERAL AID PRIMARY ROAD
- FAS FEDERAL AID SECONDARY ROAD
- FAU FEDERAL AID URBAN
- NS NON-SYSTEM ROAD
- P4 PROJECTED LOCATION
- I4 INTERSECTION DISTANCE
- TRAFFIC CIRCLE
- HIGHWAY INTERCHANGE
- DETAILED HIGHWAY INTERCHANGE
- INTERSTATE HIGHWAY
- U.S. NUMBERED HIGHWAY
- N.C. NUMBERED HIGHWAY
- SECONDARY ROAD NUMBERS
- UNDERGROUND CABLE
- RAILROAD, ANY NUMBER OF TRACKS USED BY SINGLE OPERATING COMPANY
- RAILROAD, ANY NUMBER OF TRACKS USED BY MORE THAN ONE OPERATING COMPANY ON SAME OR ADJACENT RIGHTS-OF-WAY
- RAILROAD STATION
- GRADE CROSSING
- UNDERPASS
- OVERPASS
- RAILROAD TUNNEL
- ARMY, NAVY OR MARINE CORPS FIELD
- COMAL OR MUNICIPAL AIRPORT
- MARKED AUXILIARY FIELD
- HANGAR ON FIELD "B" IN SYMBOL
- DOCK, PIER OR LANDING
- FREE OR TOLL FERRY
- LIGHT, NAUTICAL
- LIGHTHOUSE
- COAST GUARD STATION
- CANAL
- NARROW STREAM
- WIDE STREAM
- DAM WITH LOCK
- DAM
- RESERVOIR, POND OR LAKE
- PROMINENT PEAK, NUMERALS INDICATE ELEVATION
- ROAD THROUGH MOUNTAIN PASS
- HIGHWAY BRIDGE, OVER 20 FT.
- DRAW SPAN ON BRIDGE
- HIGHWAY TUNNEL
- FORD
- STATE LINE
- COUNTY LINE
- CITY LIMITS
- RESERVATION OR PARK BOUNDARY
- INSET AREA
- DELIMITED AREA, POPULATION EST.
- COUNTY SEAT
- OTHER TOWNS AND VILLAGES
- TRIANGULATION STATION
- INCORPORATED CITY OR VILLAGE, GENERALIZED
- SCHOOL
- CHURCH
- CHURCH WITH CEMETERY
- CEMETERY
- HOSPITAL
- CORRECTIONAL OR PENAL INSTN.
- HIGHWAY GARAGE, OR MAINT. YARD
- HIGHWAY DIV. OR DIST. OFFICE
- WEIGHT STATION
- PATROL STATION
- REST AREA
- MONUMENT - SMALL HISTORICAL SITE


OLD CRAWL WITH NEST PREDATION 8-11-83
 OLD CRAWL 8-11-83
 OLD CRAWL WITH NEST PREDATION 9-11-83
 CRAWL - 8-11-83
 CRAWL - 8-11-83
 FALSE CRAWL - 8-11-83
 FALSE CRAWL 8-11-83
 CRAWL - 8-11-83
 CRAWL - 8-11-83
 FALSE CRAWL - 8-11-83
 CRAWL - 8-11-83
 FALSE CRAWL - 8-11-83
 CRAWL - 8-11-83
 FALSE CRAWL - 8-11-83
 CRAWL - 8-11-83


8-11-83 J.R. Rich
 ● - SEVEN CRAWLS WITH NEST
 ● - FIVE FALSE CRAWLS
 ● - TWO CRAWLS WITH NEST PREDATION

 

NEST AND CRAWL ACTIVITY
 ONSLOW BEACH, MARINE CORPS BASE
 CAMP LEJEUNE, NORTH CAROLINA

Nests - upper map
 Crawls no nest - lower map
 Dots indicates multiple usage

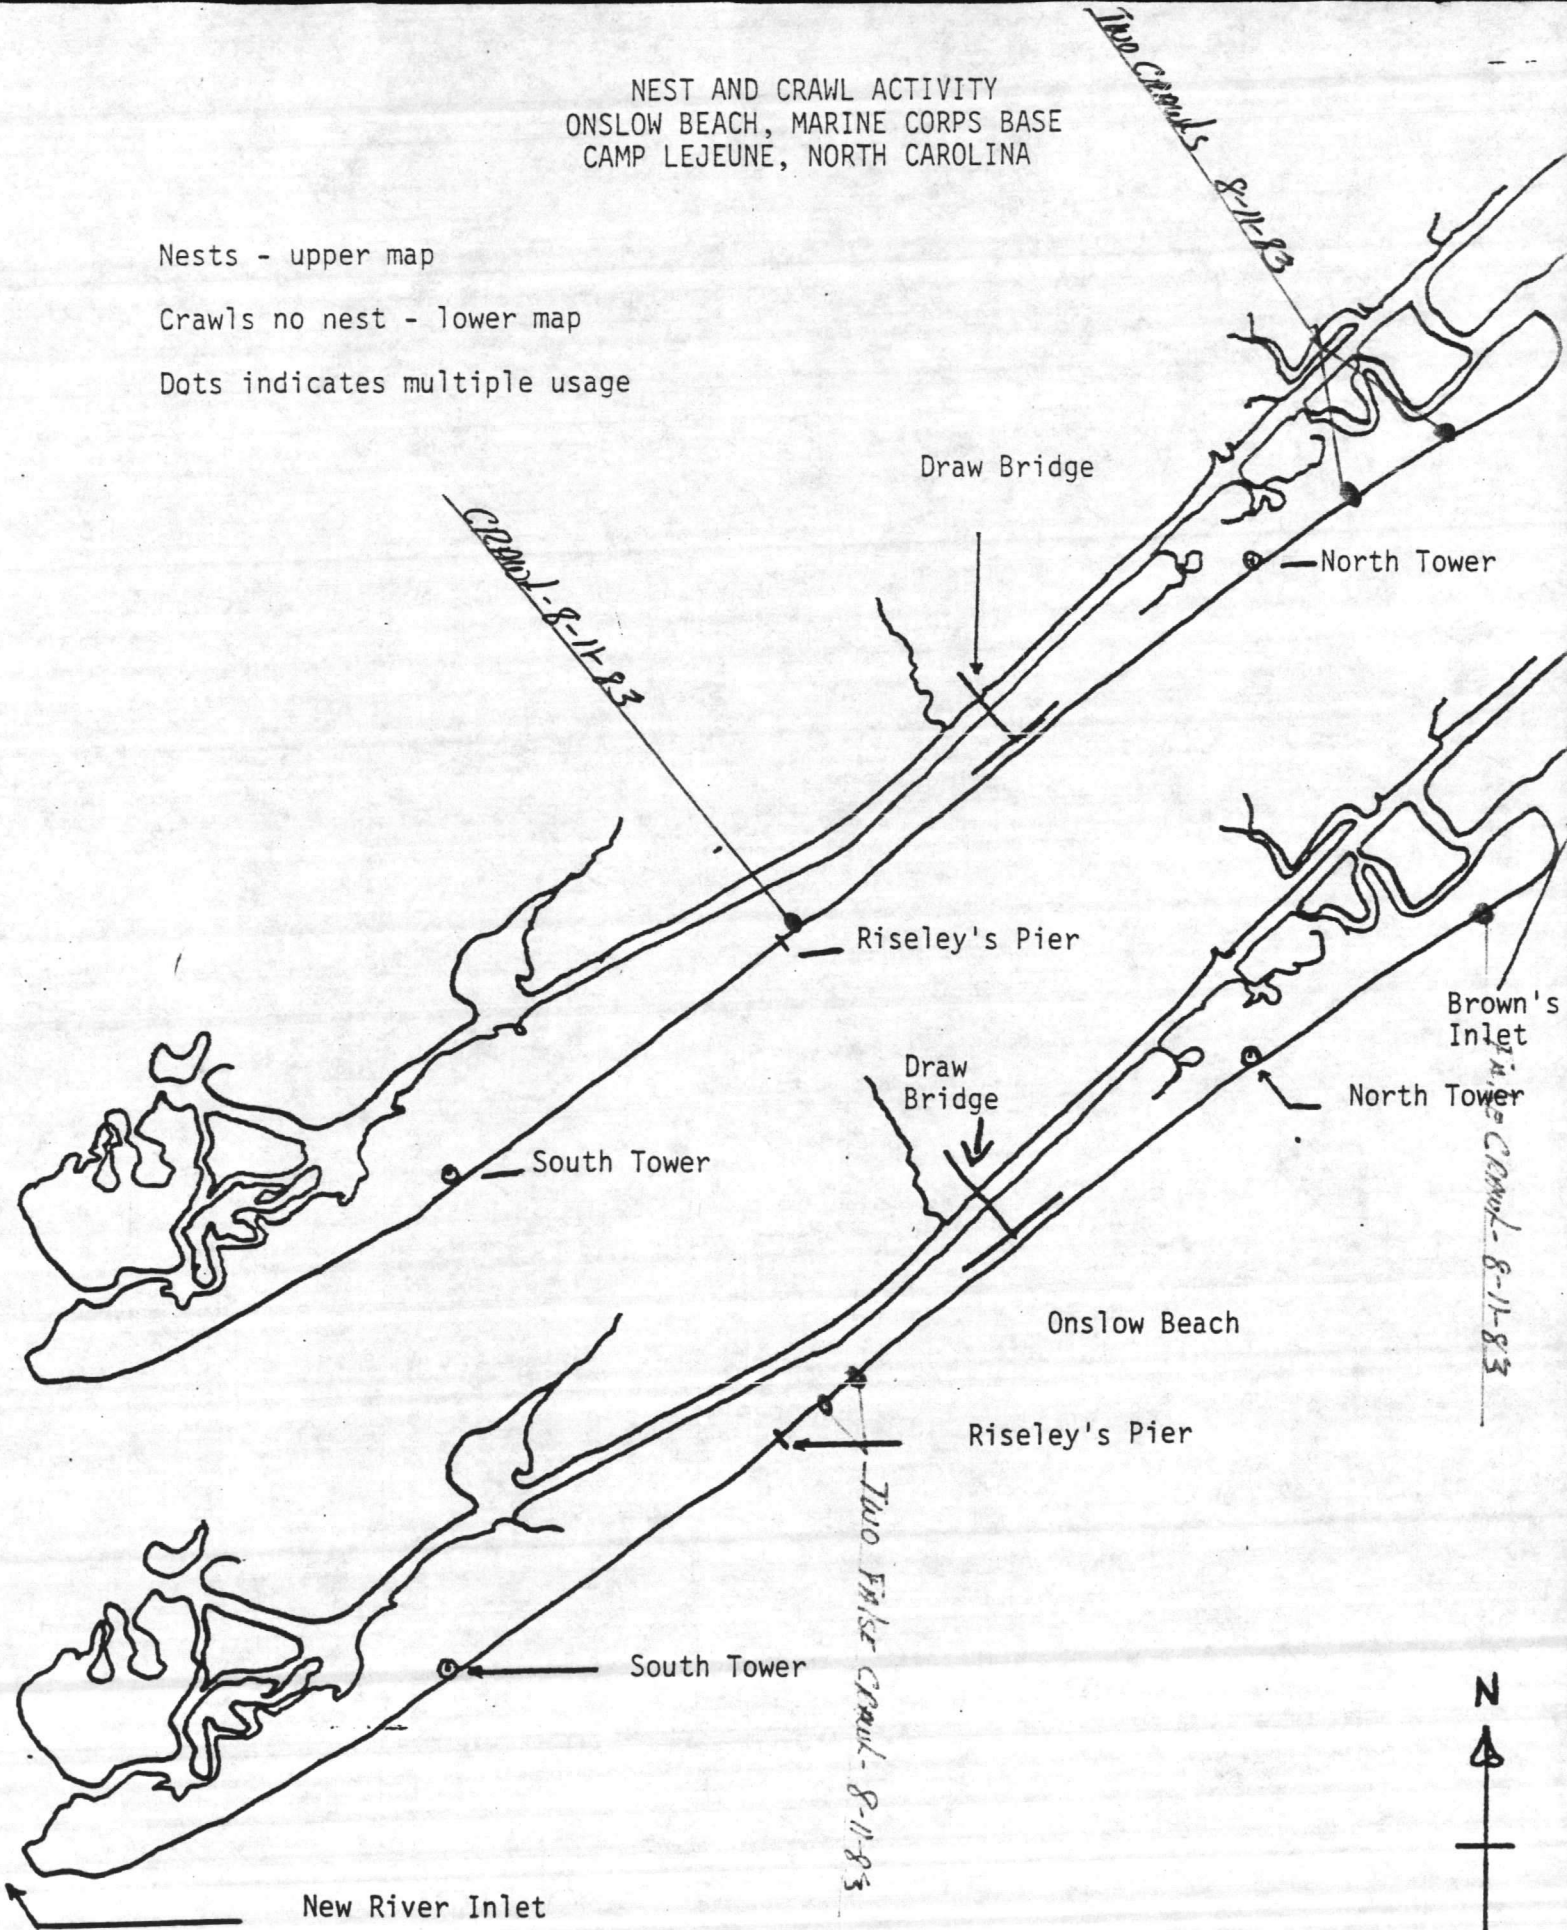

 

AERIAL SURVEY DATA

Date: August 16 1983 Time: S 06:04 F 08:05

Recorder Name: Jerry R. Rich

Crew Names: None Pilot: J. R. Rich

Co-Pilot: None Crew Chief: None

Others: None

Weather: General 1-2 miles fog Cloud Cover 1000 SCT

Wind Speed Less than 5 K Sea Conditions Calm

BEACH AERIAL SURVEYS Altitude 100 FT

Air Speed 60 K

Location	Crawls		Nests		Nest Predation	
	New	Old	New	Old	New	Old
Onslow Beach	0	0	0	0	0	0
Browns Island	1	0	3	0	2	0
Bear Beach	0	0	1	4	0	0


OCEAN AERIAL SURVEYS


Altitude 300 Ft

Air Speed 60 K

Bell Boy from Bogue Inlet to New River Inlet	Live Turtles		Dead Turtles
	Juvenile	Adults	
	None	None	None

Comments:

 

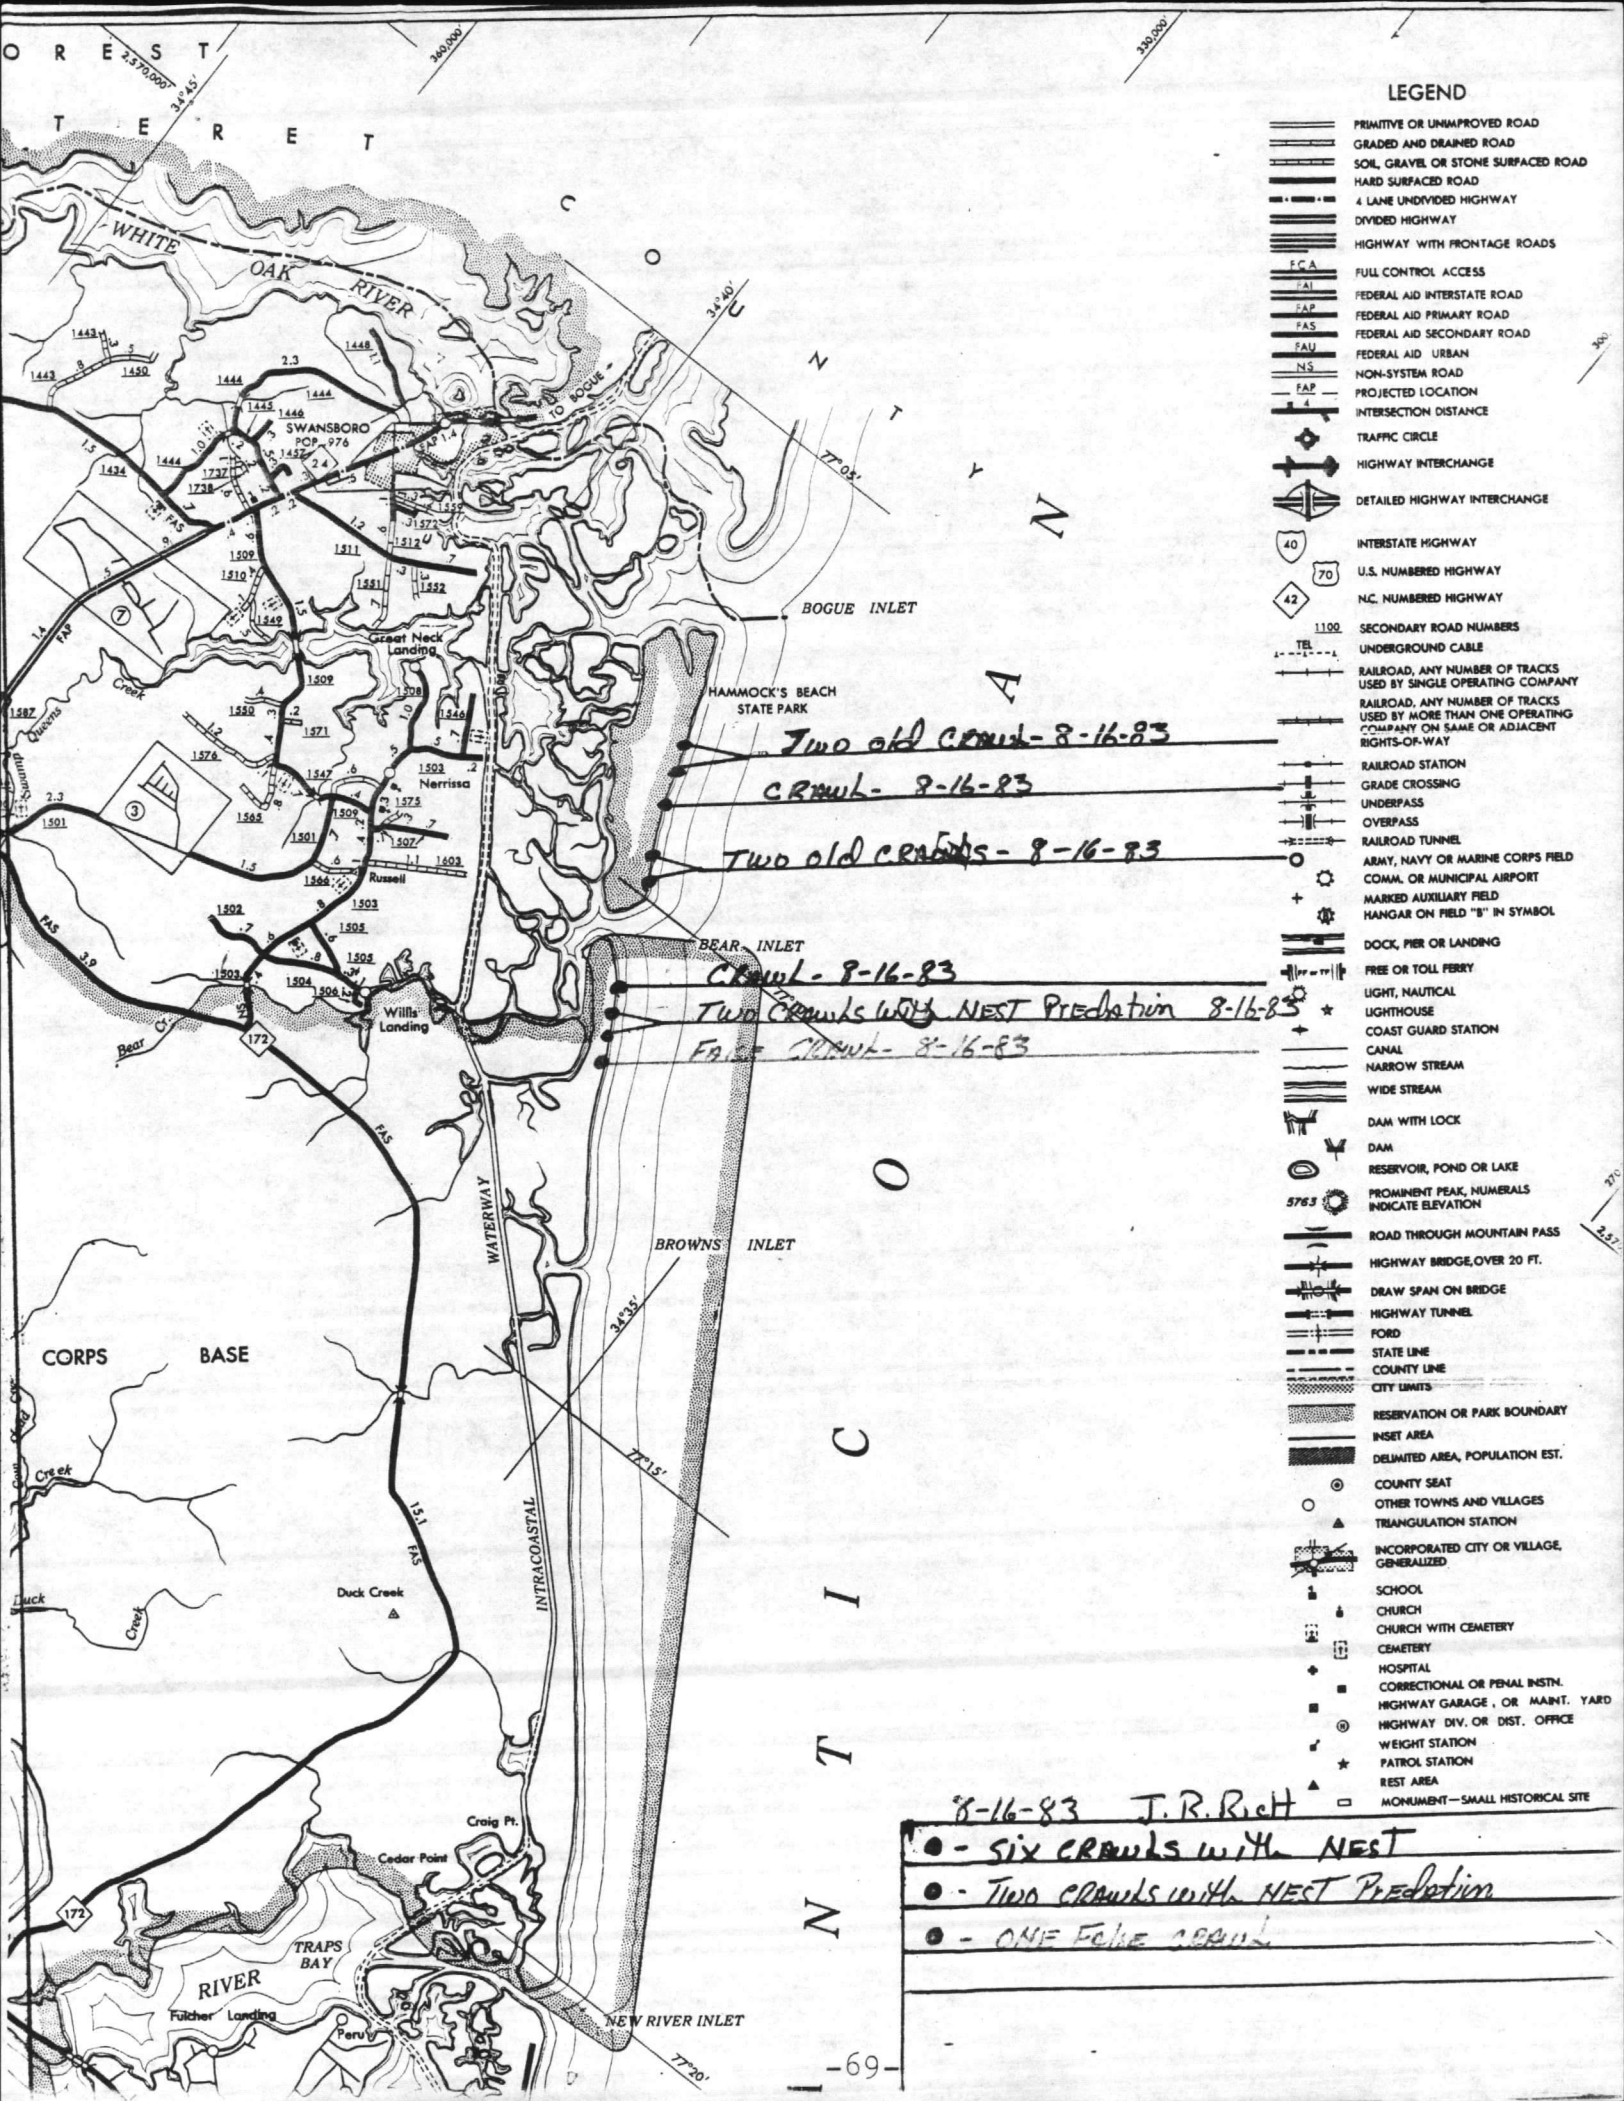


LEGEND

- ==== PRIMITIVE OR UNIMPROVED ROAD
- ==== GRADED AND DRAINED ROAD
- ==== SOIL, GRAVEL OR STONE SURFACED ROAD
- ==== HARD SURFACED ROAD
- ==== 4 LANE UNDIVIDED HIGHWAY
- ==== DIVIDED HIGHWAY
- ==== HIGHWAY WITH FRONTAGE ROADS
- FGA FULL CONTROL ACCESS
- FBI FEDERAL AID INTERSTATE ROAD
- FAP FEDERAL AID PRIMARY ROAD
- FAS FEDERAL AID SECONDARY ROAD
- FAU FEDERAL AID URBAN
- NS NON-SYSTEM ROAD
- FAP PROJECTED LOCATION
- ⊕ INTERSECTION DISTANCE
- ⊙ TRAFFIC CIRCLE
- ⊕ HIGHWAY INTERCHANGE
- ⊕ DETAILED HIGHWAY INTERCHANGE
- 40 INTERSTATE HIGHWAY
- 70 U.S. NUMBERED HIGHWAY
- 42 N.C. NUMBERED HIGHWAY
- 1100 SECONDARY ROAD NUMBERS
- TEL UNDERGROUND CABLE
- RAILROAD, ANY NUMBER OF TRACKS USED BY SINGLE OPERATING COMPANY
- RAILROAD, ANY NUMBER OF TRACKS USED BY MORE THAN ONE OPERATING COMPANY ON SAME OR ADJACENT RIGHTS-OF-WAY
- RAILROAD STATION
- GRADE CROSSING
- UNDERPASS
- OVERPASS
- RAILROAD TUNNEL
- ARMY, NAVY OR MARINE CORPS FIELD
- COMM. OR MUNICIPAL AIRPORT
- MARKED AUXILIARY FIELD
- HANGAR ON FIELD "B" IN SYMBOL
- DOCK, PIER OR LANDING
- FREE OR TOLL FERRY
- LIGHT, NAUTICAL
- LIGHTHOUSE
- COAST GUARD STATION
- HARBOR STREAM
- WIDE STREAM
- DAM WITH LOCK
- DAM
- RESERVOIR, POND OR LAKE
- PROMINENT PEAK, NUMERALS INDICATE ELEVATION
- 5763
- ROAD THROUGH MOUNTAIN PASS
- HIGHWAY BRIDGE, OVER 20 FT.
- DRAW SPAN ON BRIDGE
- HIGHWAY TUNNEL
- FORD
- STATE LINE
- COUNTY LINE
- CITY LIMITS
- RESERVATION OR PARK BOUNDARY
- INSET AREA
- DELIMITED AREA, POPULATION EST.
- ⊙ COUNTY SEAT
- ⊙ OTHER TOWNS AND VILLAGES
- ⊙ TRIANGULATION STATION
- INCORPORATED CITY OR VILLAGE, GENERALIZED
- SCHOOL
- CHURCH
- CHURCH WITH CEMETERY
- CEMETERY
- HOSPITAL
- CORRECTIONAL OR PENAL INSTN.
- HIGHWAY GARAGE, OR MAINT. YARD
- HIGHWAY DIV. OR DIST. OFFICE
- WEIGHT STATION
- PATROL STATION
- REST AREA
- MONUMENT—SMALL HISTORICAL SITE

Two old CRAWL - 8-16-83
 CRAWL - 8-16-83
 Two old CRAWLS - 8-16-83
 CRAWL - 8-16-83
 Two CRAWLS WITH NEST Prediction 8-16-83
 False CRAWL - 8-16-83

8-16-83 J.R. Rich

●	- Six CRAWLS with NEST
●	- Two CRAWLS with NEST Prediction
●	- ONE False CRAWL

 

AERIAL SURVEY DATA

Date: August 19 83 Time: S 06:01 F 08:04

Recorder Name: Jerry R. Rich

Crew Names: None Pilot: J. R. Rich

Co-Pilot: None Crew Chief: None

Others: None

Weather: General 10,000 BKN 3 miles haze Cloud Cover 10,000 BKN

Wind Speed SSW 10-15 K Sea Conditions White caps


BEACH AERIAL SURVEYS Altitude 100 Ft
Air Speed 60 K


Location	Crawls		Nests		Nest Predation	
	New	Old	New	Old	New	Old
Onslow Beach	0	0	0	0	0	0
Browns Island	0	0	0	0	0	0
Bear Beach	0	0	2	3	0	0

OCEAN AERIAL SURVEYS Altitude 300 Ft
Air Speed 60 K

	Live Turtles		Dead Turtles
	Juvenile	Adults	
Bell Buoy from Bogue Inlet to New River Inlet	None	None	None

Comments:

 

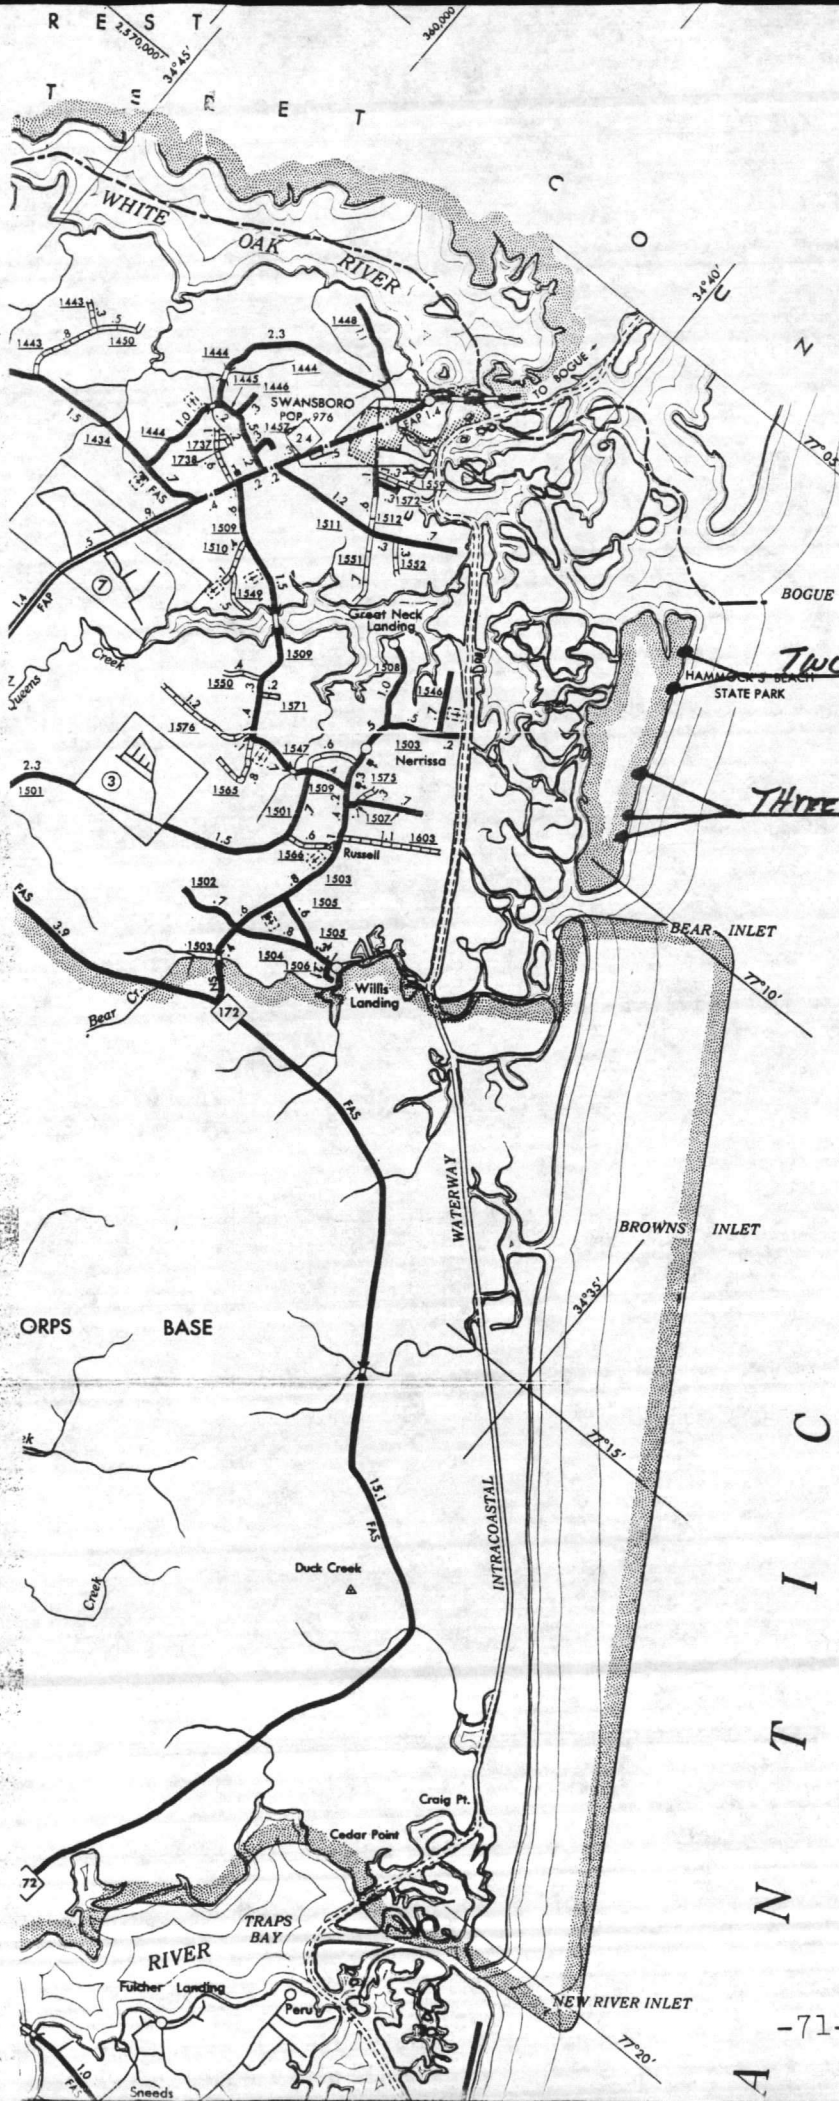

LEGEND


- PRIMITIVE OR UNIMPROVED ROAD
- GRADED AND DRAINED ROAD
- SOIL, GRAVEL OR STONE SURFACED ROAD
- HARD SURFACED ROAD
- 4 LANE UNDIVIDED HIGHWAY
- DIVIDED HIGHWAY
- HIGHWAY WITH FRONTAGE ROADS
- FULL CONTROL ACCESS
- FEDERAL AID INTERSTATE ROAD
- FEDERAL AID PRIMARY ROAD
- FEDERAL AID SECONDARY ROAD
- FEDERAL AID URBAN
- NON-SYSTEM ROAD
- PROJECTED LOCATION
- INTERSECTION DISTANCE
- TRAFFIC CIRCLE
- HIGHWAY INTERCHANGE
- DETAILED HIGHWAY INTERCHANGE
- INTERSTATE HIGHWAY
- U.S. NUMBERED HIGHWAY
- N.C. NUMBERED HIGHWAY
- SECONDARY ROAD NUMBERS
- UNDERGROUND CABLE
- RAILROAD, ANY NUMBER OF TRACKS USED BY SINGLE OPERATING COMPANY
- RAILROAD, ANY NUMBER OF TRACKS USED BY MORE THAN ONE OPERATING COMPANY ON SAME OR ADJACENT RIGHTS-OF-WAY
- RAILROAD STATION
- GRADE CROSSING
- UNDERPASS
- OVERPASS
- RAILROAD TUNNEL
- ARMY, NAVY OR MARINE CORPS FIELD
- COMM. OR MUNICIPAL AIRPORT
- MARKED AUXILIARY FIELD
- HANGAR ON FIELD "B" IN SYMBOL
- DOCK, PIER OR LANDING
- FREE OR TOLL FERRY
- LIGHT, NAUTICAL
- LIGHTHOUSE
- COAST GUARD STATION
- CANAL
- NARROW STREAM
- WIDE STREAM
- DAM WITH LOCK
- DAM
- RESERVOIR, POND OR LAKE
- PROMINENT PEAK, NUMERALS INDICATE ELEVATION
- ROAD THROUGH MOUNTAIN PASS
- HIGHWAY BRIDGE, OVER 20 FT.
- DRAW SPAN ON BRIDGE
- HIGHWAY TUNNEL
- FORD
- STATE LINE
- COUNTY LINE
- CITY LIMITS
- RESERVATION OR PARK BOUNDARY
- INSET AREA
- DELIMITED AREA, POPULATION EST.
- COUNTY SEAT
- OTHER TOWNS AND VILLAGES
- TRIANGULATION STATION
- INCORPORATED CITY OR VILLAGE, GENERALIZED
- SCHOOL
- CHURCH
- CHURCH WITH CEMETERY
- CEMETERY
- HOSPITAL
- CORRECTIONAL OR PENAL INSTN.
- HIGHWAY GARAGE, OR MAINT. YARD
- HIGHWAY DIV. OR DIST. OFFICE
- WEIGHT STATION
- PATROL STATION
- REST AREA
- MONUMENT—SMALL HISTORICAL SITE


Two Crows - 8-19-83


Three old Crows - 8-19-83

8-19-83 J.R. Rich

• - FIVE CROWS WITH NEST

 

 


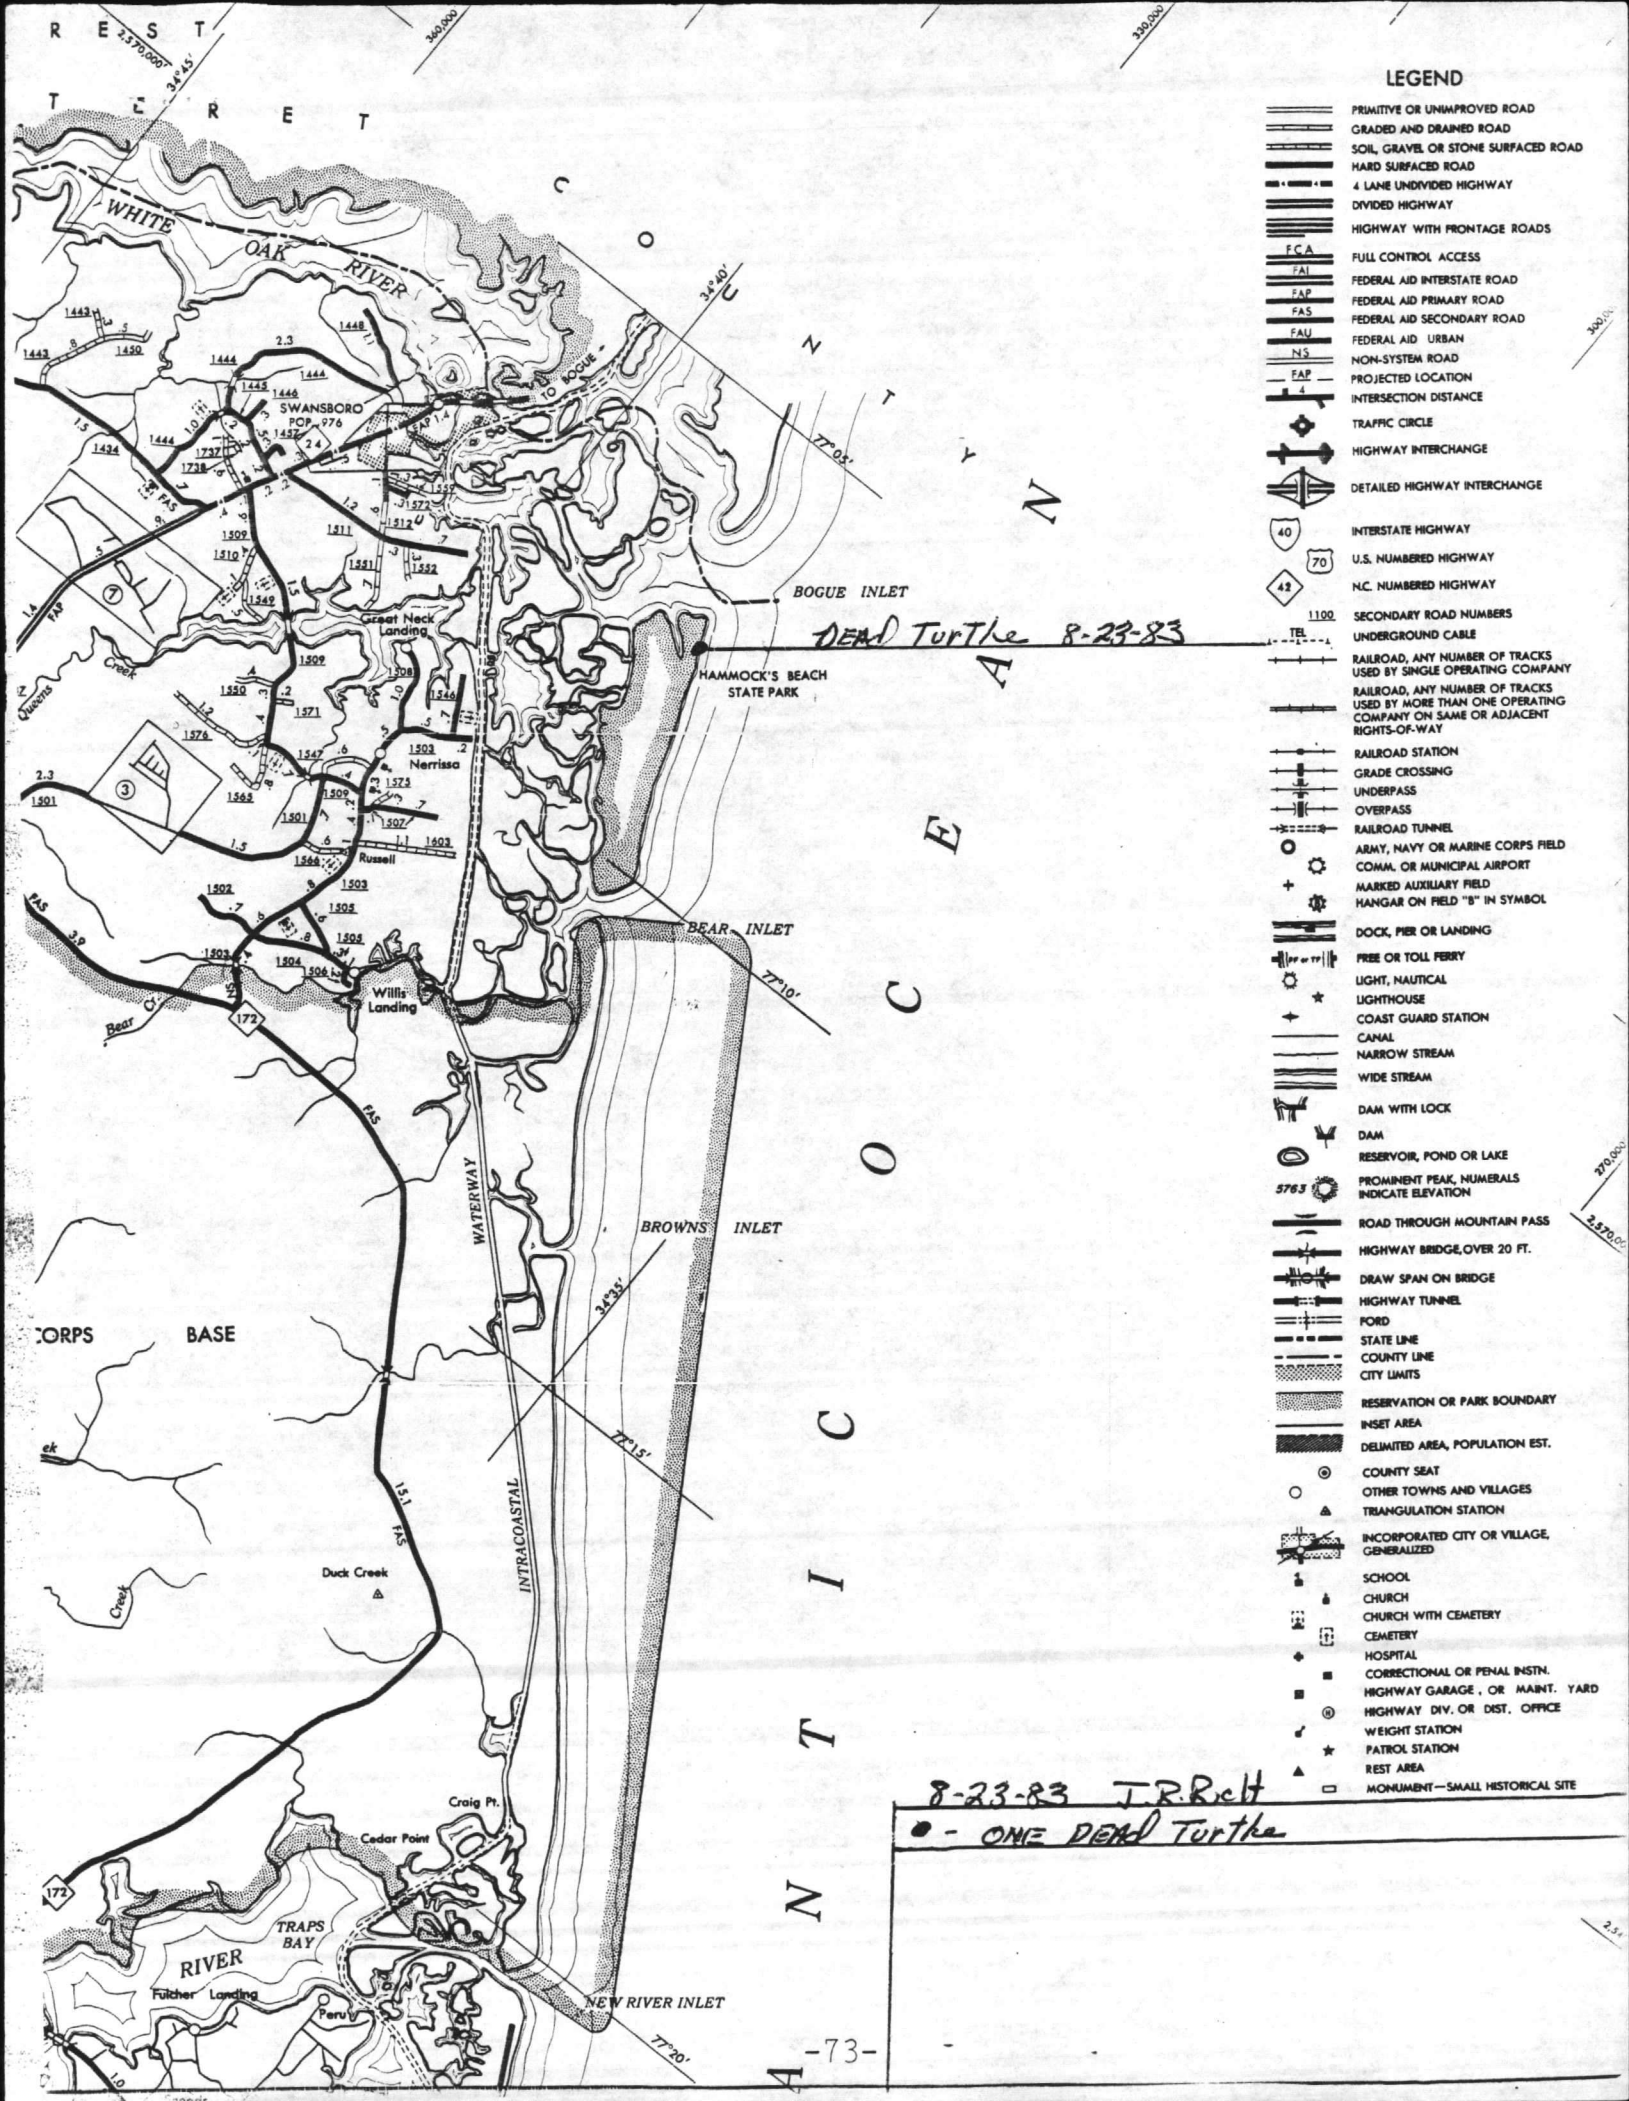


LEGEND

- PRIMITIVE OR UNIMPROVED ROAD
- GRADED AND DRAINED ROAD
- SOIL, GRAVEL OR STONE SURFACED ROAD
- HARD SURFACED ROAD
- 4 LANE UNDIVIDED HIGHWAY
- DIVIDED HIGHWAY
- HIGHWAY WITH FRONTAGE ROADS
- FCA FULL CONTROL ACCESS
- FAI FEDERAL AID INTERSTATE ROAD
- FAP FEDERAL AID PRIMARY ROAD
- FAS FEDERAL AID SECONDARY ROAD
- FAU FEDERAL AID URBAN
- NS NON-SYSTEM ROAD
- FAP PROJECTED LOCATION
- INTERSECTION DISTANCE
- TRAFFIC CIRCLE
- HIGHWAY INTERCHANGE
- DETAILED HIGHWAY INTERCHANGE
- INTERSTATE HIGHWAY
- U.S. NUMBERED HIGHWAY
- N.C. NUMBERED HIGHWAY
- SECONDARY ROAD NUMBERS
- UNDERGROUND CABLE
- RAILROAD, ANY NUMBER OF TRACKS USED BY SINGLE OPERATING COMPANY
- RAILROAD, ANY NUMBER OF TRACKS USED BY MORE THAN ONE OPERATING COMPANY ON SAME OR ADJACENT RIGHTS-OF-WAY
- RAILROAD STATION
- GRADE CROSSING
- UNDERPASS
- OVERPASS
- RAILROAD TUNNEL
- ARMY, NAVY OR MARINE CORPS FIELD
- COMM. OR MUNICIPAL AIRPORT
- MARKED AUXILIARY FIELD
- HANGAR ON FIELD "B" IN SYMBOL
- DOCK, PIER OR LANDING
- FREE OR TOLL FERRY
- LIGHT, NAUTICAL
- LIGHTHOUSE
- COAST GUARD STATION
- CANAL
- NARROW STREAM
- WIDE STREAM
- DAM WITH LOCK
- DAM
- RESERVOIR, POND OR LAKE
- PROMINENT PEAK, NUMERALS INDICATE ELEVATION
- ROAD THROUGH MOUNTAIN PASS
- HIGHWAY BRIDGE OVER 20 FT.
- DRAW SPAN ON BRIDGE
- HIGHWAY TUNNEL
- FORD
- STATE LINE
- COUNTY LINE
- CITY LIMITS
- RESERVATION OR PARK BOUNDARY
- INSET AREA
- DELIMITED AREA, POPULATION EST.
- COUNTY SEAT
- OTHER TOWNS AND VILLAGES
- TRIANGULATION STATION
- INCORPORATED CITY OR VILLAGE, GENERALIZED
- SCHOOL
- CHURCH
- CHURCH WITH CEMETERY
- CEMETERY
- HOSPITAL
- CORRECTIONAL OR PENAL INSTN.
- HIGHWAY GARAGE, OR MAINT. YARD
- HIGHWAY DIV. OR DIST. OFFICE
- WEIGHT STATION
- PATROL STATION
- REST AREA
- MONUMENT - SMALL HISTORICAL SITE

8-23-83 J.R. Relt
 • - ONE DEAD Turtle

 

 



DEPARTMENT OF THE INTERIOR
U.S. FISH AND WILDLIFE SERVICE

Hugh Passingham 3-201
(2/76)

FEDERAL FISH AND WILDLIFE PERMIT

1. PERMITTEE

Camp Lejeune Marine
Corps Base
U.S. Marine Corps
Camp Lejeune, North Carolina 28542

2. AUTHORITY-STATUTES

16 USC 1533(d)

REGULATIONS (Attached)

50 CFR 17.32

3. NUMBER

PRT 2-7844

4. RENEWABLE

YES
 NO

5. MAY COPY

YES
 NO

6. EFFECTIVE

MAY 6 1983

7. EXPIRES

05/31/85

8. NAME AND TITLE OF PRINCIPAL OFFICER (If #1 is a business)

Julian I. Wooten, Director

9. TYPE OF PERMIT

THREATENED SPECIES

10. LOCATION WHERE AUTHORIZED ACTIVITY MAY BE CONDUCTED

Camp Lejeune, North Carolina

11. CONDITIONS AND AUTHORIZATIONS:

A. GENERAL CONDITIONS SET OUT IN SUBPART D OF 50 CFR 17.3, AND SPECIFIC CONDITIONS CONTAINED IN FEDERAL REGULATIONS CITED IN BLOCK #2 ABOVE, ARE HEREBY MADE A PART OF THIS PERMIT. ALL ACTIVITIES AUTHORIZED HEREIN MUST BE CARRIED OUT IN ACCORD WITH AND FOR THE PURPOSES DESCRIBED IN THE APPLICATION SUBMITTED. CONTINUED VALIDITY OR RENEWAL OF THIS PERMIT IS SUBJECT TO COMPLETE AND TIMELY COMPLIANCE WITH ALL APPLICABLE CONDITIONS, INCLUDING THE FILING OF ALL REQUIRED INFORMATION AND REPORTS.

B. THE VALIDITY OF THIS PERMIT IS ALSO CONDITIONED UPON STRICT OBSERVANCE OF ALL APPLICABLE FOREIGN, STATE, LOCAL OR OTHER FEDERAL LAW.

C. VALID FOR USE BY PERMITTEE NAMED ABOVE

D. Authorized to take green (*Chelonia mydas*) and loggerhead (*Caretta caretta*) sea turtles to tag and measure adults and to relocate nests for the purpose of scientific research and enhancement of survival. PROVIDED: (1) only nests threatened by erosion, tides, extreme predation or military activities are moved, (2) nests may be relocated only to safe beach sites (not laboratories), (3) relocated nests are monitored and hatching success recorded, (4) the permittee may move nests only within 24 hours of egg deposition or after two weeks following deposition (preferably eggs should be moved within 12 hours of deposition) and (5) no eggs be removed or relocated outside the Camp Lejeune general beach vicinity.

E. Nesting females should be double-tagged by placing one tag on each front flipper.

F. The Atlanta, GA USFWS Endangered Species Office (404/831-4671) must be notified before commencing the permitted activity.

ADDITIONAL CONDITIONS AND AUTHORIZATIONS ON REVERSE ALSO APPLY

12. REPORTING REQUIREMENTS

A report of activities conducted under authority of this permit must be submitted to the Wildlife Permit Office, P.O. Box 3654, Arlington, VA 22203 by January 31st following each year this permit is in effect.

ISSUED BY

Larry LaRochelle


TITLE

Chief, Branch of Permits
Federal Wildlife Permit Office

DATE


MAY 6 1983

ORIGINAL

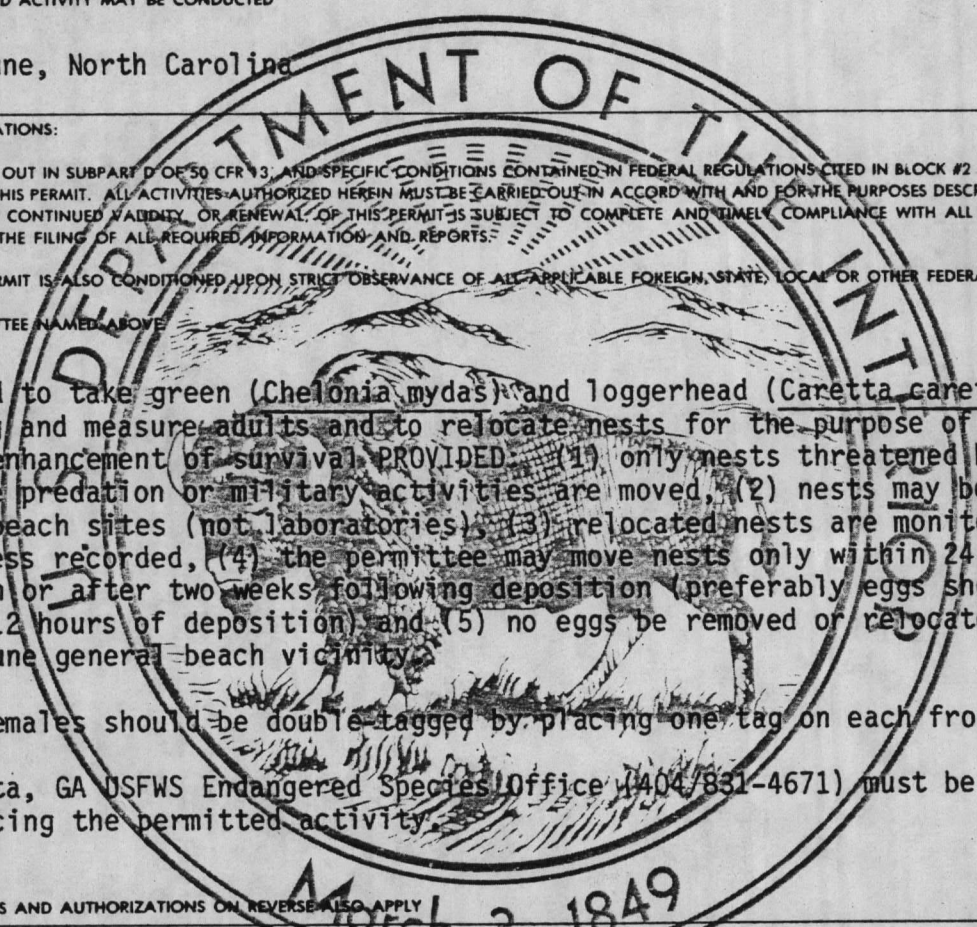



G. Acceptance of this permit serves as evidence that the permittee understands and agrees to abide by the "Special Conditions for Marine Mammals and Native Endangered and Threatened Species Permits" (copy attached). The permittee must have a copy of this permit in his possession while conducting the authorized activities.

 



United States Department of the Interior

ADDRESS ONLY THE DIRECTOR,
FISH AND WILDLIFE SERVICE

FISH AND WILDLIFE SERVICE
WASHINGTON, D.C. 20240


Implemented June 1982

Special Conditions for Marine Mammals and Native Endangered and Threatened Species Permits

1. Permittee must comply with the attached General Permit Conditions specified by the Federal Wildlife Permit Office.
2. Any dead or injured specimens of the authorized wildlife found may be salvaged or cared for.
3. Unless otherwise authorized on the face of the permit, the wildlife must be immediately released at or near the capture site after permitted activity.
4. Unexpected death or escape of the authorized wildlife shall be reported to the Federal Wildlife Permit Office (703/235-1903) before the end of the next business day.
5. BIRD banding, marking, radio tagging, etc. must be conducted in accordance with a Federal Bird Marking and Salvage permit.

THE FOLLOWING CONDITIONS APPLY UNTIL AUTHORIZED DISPOSAL OF THE WILDLIFE, REGARDLESS OF THE EXPIRATION DATE OF THE PERMIT:

6. The authorized wildlife may NOT be sold, donated or transferred unless the receiver has first been issued authorization by the Director.
7. Any dead authorized wildlife shall be preserved and held for scientific purposes whenever practical.
8. Any live SEA TURTLES held must be maintained in accordance with the "Care and Maintenance Standards for Sea Turtles Held in Captivity" specified by the Federal Wildlife Permit Office.
9. MARINE MAMMALS must be cared for and maintained in accordance with the Animal and Plant Health Inspection Service's regulations on "Marine Mammals; Humane Handling, Care, Treatment, and Transportation".

 

SEA TURTLE INVENTORY

for

SUMMER AND FALL 1983

NATURAL RESOURCES AND ENVIRONMENTAL AFFAIRS DIVISION
ASSISTANT CHIEF OF STAFF, FACILITIES
MARINE CORPS BASE
CAMP LEJEUNE, NORTH CAROLINA 28542

JULIAN I. WOOTEN
DIRECTOR


CHARLES D. PETERSON
SUPERVISORY WILDLIFE
MANAGER

SAM F. POOLE
WILDLIFE BIOLOGIST

BRIAN C. SPAULDING
BIOLOGICAL TECHNICIAN

HUGH R. PASSINGHAM
BIOLOGICAL TECHNICIAN

DR. FRANK B. SCHWARTZ
ADVISOR, INSTITUTE OF
MARINE SCIENCE,
MOREHEAD CITY, NORTH CAROLINA

 

SEA TURTLE INVENTORY

for

SUMMER AND FALL 1983

NATURAL RESOURCES AND ENVIRONMENTAL AFFAIRS DIVISION
ASSISTANT CHIEF OF STAFF, FACILITIES
MARINE CORPS BASE
CAMP LEJEUNE, NORTH CAROLINA 28542

JULIAN I. WOOTEN
DIRECTOR

CHARLES D. PETERSON
SUPERVISORY WILDLIFE
MANAGER

SAM F. POOLE
WILDLIFE BIOLOGIST

BRIAN C. SPAULDING
BIOLOGICAL TECHNICIAN

HUGH R. PASSINGHAM
BIOLOGICAL TECHNICIAN

DR. FRANK B. SCHWARTZ
ADVISOR, INSTITUTE OF
MARINE SCIENCE,
MOREHEAD CITY, NORTH CAROLINA

 


TABLE OF CONTENTS

Introduction 1

Sea Turtle Inventory (Crawl Data) - Table I 2

Return Record of Tagged Turtles - Table III 7

Crawl Information in Relation to Moon and Tidal Cycles
and Weather Conditions - Table III 8

Ground Survey Numbers - Table IV 10

Aerial Survey - Table V 12

Nest Crawl Activity 13

[Faint, illegible text throughout the page]

INTRODUCTION

The sea turtle inventory for 1983 is a continuation of past efforts by Natural Resources and Environmental Affairs Division, Assistant Chief of Staff, Facilities, Marine Corps Base, Camp Lejeune, North Carolina, to protect sea turtle nesting activities at Onslow Beach. The sea turtle inventory consists of several programs including: nest protection, tagging of adult turtles, collecting nesting data, determining hatchling success and aerial surveys.

Management personnel began operating under a Federal Fish and Wildlife Permit during 1981, issued for working with threatened Loggerhead and Green Turtles. The permit authorizes the tagging and measurement of adults and the relocation of nests threatened by erosion, tides, extreme predation or military training activities. Nests may be moved only within 36 hours of egg laying to a safe beach location and not to a laboratory. Relocated nests are required to be monitored and hatchling success documented.

The results of the aforementioned programs are as follows:

- a. Nest protection from predators, 100%.
- b. Tagging of adults - number of turtles tagged - 14. Tag return data may be reviewed in Table II, page 7.
- c. Nesting data - number of nests - 42.
- d. Total number of crawls - 103.
- e. Total number of eggs - 5,031
- f. Total number of hatchlings - 3,753
- g. Number of tag returns - 4
- h. Number stranded turtles - 2


Stranding reports were submitted to the North Carolina Wildlife Resources Stranding Network Coordinator. Carcasses were buried on the beach.

Percent hatchling success is 80.9% nesting and crawl data is compiled in Tables I, II, III, IV and V, and Graphs I and II on pages 2 through 15. The enclosed maps indicate locations of turtle activity on Onslow Beach.

Aerial survey data may be found in Table V, page 12.

The Marine Corps Base, Camp Lejeune and Natural Resources and Environmental Affairs Division give special thanks to Doctor F. J. Schwartz at the Institute of Marine Science, Morehead City for his advice and services.

For copies of this report or other information concerning the sea turtle management program conducted by this agency, contact: Commanding General, Marine Corps Base, Camp Lejeune, North Carolina 28542, Attention: Director, Natural Resources and Environmental Affairs Division, Assistant Chief of Staff, Facilities.

 

SEA TURTLE INVENTORY
(Crawl Data)


TABLE I
Marine Corps Base
Camp Lejeune, North Carolina

Crawl No.	Date	Time Crawl Occurred	Active Nest	Location*	Comments
001	6-8-83	2330	X	1.6(S)	Relocated to dune 160 eggs Tags AAR 051,052
002	6-11-83	0330		2.6(N)	C.O.
003	6-13-83	0330-0600		3.5(N)	C.O.
004	6-13-83	0330-0600		2.3(N)	C.O.
005	6-15-83	2330	X	1.6(S)	Relocated from 1.2(S) 121 eggs
006	6-15-83	2330		2.6(S)	C.O.
007	6-15-83	2400	X	2.3(S)	Relocated from 2.9(S) 158 eggs Tags AAR 053,054
008	6-16-83	2300	X	3.7(N)	Relocated from 3.9(N) 142 eggs Tags AAR 055,056
009	6-16-83	2400		0.5(S)	C.O.
010	6-17-83	0430	X	1.1(N)	94 eggs. Relocated to dune
011	6-17-83	0330-0600		3.0(N)	C.O.
012	6-18-83	2300	X	3.6(N)	Relocated 8' to dune 129 eggs
013	6-18-83	2400		2.3(N)	C.O.
014	6-18-83	2430		3.7(N)	C.O.
015	6-19-83	2200	X	2.3(S)	Relocated from 2.7(S) 90 eggs Return IBS 813,814
016	6-19-83	0135	X	2.3(N)	Relocated from 2.0(N) 133 eggs Tags AAR 059,060
017	6-20-83	2300	X	3.6(N)	Relocated to dune 105 eggs Tags AAR 061,062
018	6-20-83	0230	X	2.3(N)	Relocated to dune ** 138 eggs Return IMS768,769
019	6-20-83	0330-0600		1.6(N)	C.O.
020	6-24-83	2200	X	2.2(N)	Relocated to dune 107 eggs Tags AAR 065,066
021	6-26-83	2330	X	2.2(N)	Relocated from 0.7(S) 130 eggs

** Retagged AAR 063, 064

Summary of Instructions:

* Location measured to nearest tenth of mile to the north or south of Risely Pier. Record known or estimated time when crawl was made or thought to have occurred. Conduct surveys daily during regular working hours 0800-1630 traveling by four wheel drive vehicle when tide is low. Traverse the beach flood plane in vehicle to avoid leaving tire tracks in the sand.

 


SEA TURTLE INVENTORY
(Crawl Data)

TABLE I
Marine Corps Base
Camp Lejeune, North Carolina

Crawl No.	Date	Time Crawl Occurred	Active Nest	Location*	Comments
022	6-28-83	0200	X	1.0(N)	Relocated to dunes 111 eggs
023	6-30-83	2200		2.6(S)	Return IMS 716, AAR 071 C.O. disturbed turtle
024	6-30-83	0045		1.7(N)	C.O.
025	7-1-83	0200		2.1(N)	C.O. Tags AAR 067, 068
026	7-1-83	2200		2.7(N)	Disturbed turtle C.O. tags AAR 069, 070
027	7-1-83	2130	X	4.0(N)	Relocated to dune 138 eggs Ret. IMS 813,814
028	7-1-83	2200	X	2.3(N)	Relocated to dune 17 Eggs Ret. IMS716, AAR071
029	7-2-83	0030		3.7(N)	C.O.
030	7-2-83	0200		1.6(N)	C.O.
031	7-2-83	0215	X	0.1(N)	Relocated from 0.05(S) 122 eggs Ret. AAR 067,068
032	7-2-83	0215		0.6(S)	C.O.
033	7-2-83	0215	X	2.1(N)	Return AAR 069,070 134 eggs
034	7-2-83	2145		1.6(N)	C.O.
035	7-2-83	2245		2.1(N)	C.O.
036	7-2-83	2245	X	2.7(N)	Relocated to dune 135 eggs Ret. AAR 059,060
037	7-2-83	2315		3.0(N)	C.O. Return IMS 817,064
038	7-2-83	2330	X	0.6(N)	Relocated from 1.0(S) 137 eggs Tags AAR 072,073
039	7-3-83	0145	X	0.6(N)	Relocated to dune 99 eggs Ret. IMS716 AAR 071
040	7-5-83	2400		2.6(N)	C.O.
041	7-5-83	2200	X	3.0(N)	Relocated 14' to dune 119 eggs
042	7-5-83	2300		3.7(N)	C.O.

Summary of Instructions:

* Location measured to nearest tenth of mile to the north or south of Risely Pier. Record known or estimated time when crawl was made or thought to have occurred. Conduct surveys daily during regular working hours 0800-1630 traveling by four wheel drive vehicle when tide is low. Traverse the beach flood plane in vehicle to avoid leaving tire tracks in the sand.

 


SEA TURTLE INVENTORY
(Crawl Data)

TABLE I
Marine Corps Base
Camp Lejeune, North Carolina

Crawl No.	Date	Time Crawl Occurred	Active Nest	Location*	Comments
043	7-5-83	2330	X	3.6(N)	56 eggs
044	7-6-83	0300-0600		0.5(N)	C.O.
045	7-8-83	0100	X	0.4(N)	Relocated to dune 144 eggs Tags AAR 074,075
046	7-10-83	2400	X	2.3(S)	Relocated from 3.6(S) 128 eggs Ret.AAR 051, 052
047	7-10-83	0100		0.1(S)	C.O.
048	7-11-83	2300		1.5(N)	C.O.
049	7-11-83	0100	X	2.3(N)	101 eggs. Ret.AAR 065, 066
050	7-11-83	2400	X	2.3(N)	Relocated from 4.5(N) 128 eggs
051	7-13-83	0135		4.2(N)	C.O.
052	7-14-83	2400		2.1(N)	C.O.
053	7-15-83	0300-0600		1.7(N)	C.O.
054	7-15-83	0300-0600	X	1.7(N)	Relocated to dune 142 eggs
055	7-16-83	2120		0.4(N)	C.O.
056	7-16-83	2230	X	0.8(N)	Relocated to dune 58 eggs Tags IMS 820,821
057	7-16-83	2315	X	2.3(N)	Tags IMS 822, 823 117 eggs
058	7-16-83	0040		2.5(N)	C.O.
059	7-16-83	0130	X	0.1(N)	Relocated to dune 116 eggs
060	7-17-83	0300-0600		3.8(N)	C.O. (2 body pits)
061	7-17-83	0300-0600		0.4(N)	C.O.
062	7-17-83	0300-0600		1.2(S)	C.O.
063	7-17-83	2230		0.7(N)	C.O.

Summary of Instructions:

* Location measured to nearest tenth of mile to the north or south of Risely Pier. Record known or estimated time when crawl was made or thought to have occurred. Conduct surveys daily during regular working hours 0800-1630 traveling by four wheel drive vehicle when tide is low. Traverse the beach flood plane in vehicle to avoid leaving tire tracks in the sand.

 


SEA TURTLE INVENTORY
(Crawl Data)

TABLE I
Marine Corps Base
Camp Lejeune, North Carolina

Crawl No.	Date	Time Crawl Occurred	Active Nest	Location*	Comments
064	7-17-83	2200	X	2.6(N)	Relocated from 2.7(N) 119 eggs Ret. AAR 061, 062
065	7-17-83	2330	X	0.4(N)	Relocated to dune 161 eggs Ret. IMS 716, AAR 071
066	7-17-83	2400	X	0.4(N)	Relocated from 3.1(N) 146 eggs Ret. IMS 768, 769
067	7-21-83	2400		1.8(N)	C.O.
068	7-27-83	2300		4.0(N)	C.O. Ret. IMS 817, 064
069	7-27-83	2300		3.7(N)	C.O. Tags AAR 079, 080
070	7-27-83	2300		0.2(S)	C.O. Halfway up beach
071	7-27-83	2400		0.3(N)	C.O.
072	7-28-83	2215		2.2(N)	C.O. Ret. IMS 817, 064
073	7-28-83	2230	X	2.1(N)	Relocated to dune 70 eggs Ret. AAR 079, 080
074	7-28-83	2230	X	0.4(N)	137 eggs Relocated to dune
075	7-28-83	2400		2.9(N)	C.O.
076	7-28-83	0200	X	2.7(N)	134 Eggs Ret. AAR 069, 070
077	7-29-83	0030	X	2.9(N)	Relocated to dune 90 eggs Tags AAR 081, 082
078	7-29-83	0200		1.3(N)	C.O.
079	7-29-83	0220	X	0.9(S)	163 eggs Relocated to Dune
080	7-30-83	2300	X	2.2(N)	127 eggs Relocated to dune
081	7-30-83	2345		2.4(N)	C.O.
082	7-30-83	0300-0600		1.1(S)	C.O.
083	8-3-83	0300-0600		0.1(N)	C.O.
084	8-5-83	2210	X	3.8(N)	140 eggs Relocated to dune

Summary of Instructions:

* Location measured to nearest tenth of mile to the north or south of Risely Pier. Record known or estimated time when crawl was made or thought to have occurred. Conduct surveys daily during regular working hours 0800-1630 traveling by four wheel drive vehicle when tide is low. Traverse the beach flood plane in vehicle to avoid leaving tire tracks in the sand.

 

 


TABLE II

RETURN RECORD OF TAGGED TURTLES
1983 SEA TURTLE INVENTORY

<u>Date Tagged</u>	<u>Tag Number</u>	<u>Return</u>	<u>Return</u>	<u>Return</u>	<u>Return</u>
6-30-81 (3)	IMS 746, AAR071	6-30-83 (1)	7-1-83	7-3-83	7-17-83
1981 (4)	IMS 817, 064	7-2-83 (1)	7-27-83 (1)	7-28-83 (1)	
8-1-81 (2)	IMS 768, 769 (AAR 063, 064)	6-20-83	7-17-83		
7-27-82	IMS 813, 814	6-19-83	7-1-83		
6-8-83	AAR 051, 052	7-10-83			
6-15-83	AAR 053, 054				
6-16-83	AAR 055, 056				
6-19-83	AAR 059, 060	7-2-83	8-8-83		
6-20-83	AAR 061, 062	7-17-83			
6-24-83	AAR 065, 066	7-11-83			
7-1-83 (1)	AAR 067, 068	7-2-83			
7-1-83 (1)	AAR 069, 070	7-2-83	7-28-83	8-12-83	
7-2-83	AAR 072, 073				
7-8-83	AAR 074, 075				
7-16-83	IMS 820, 821				
7-16-83	IMS 822, 823				
7-21-83	AAR 076, 078				
7-27-83 (1)	AAR 079, 080	7-28-83			
7-29-83	AAR 081, 082				

(1) Did not nest

(2) Retagged

(3) Added one tag

(4) Tagged at Cape Lookout

(IMS 817)

 


TABLE III

CRAWL INFORMATION IN RELATION TO MOON AND TIDAL CYCLES AND WEATHER CONDITIONS

Date	Moon Rise % Illumin.	Time of High Tide	Time Crawl W/O Nest	Time Crawl W/Nest	Total Crawls	Weather	Temp H2O - AIR
6-8-83	0258 - 13%	1730		2330	1	Fair	70° - 69°
6-11-83	0457 - 00%	1955	0330		1	Fair	70° - 65°
6-13-83	0658 - 15%	2138	0730/0400		2	P/Cloudy	71° - 80°
6-15-83	0919 - 20%	2331	2330	2330/2400	3	Clear	75° - 77°
6-16-83	1029 - 30%	2400	2400	2300	2	Clear	79° - 75°
6-17-83	1137 - 41%	0032	0300	0430	2	Clear	77° - 75°
6-18-83	1242 - 52%	0134	2400/2430	2300	3	Clear	79° - 77°
6-19-83	1346 - 63%	0236		2200/0135	2	P/Cloudy	80° - 75°
6-20-83	1448 - 73%	0336	0330/0600	2300/0230	3	Cloudy	80° - 77°
6-24-83	1849 - 98%	1920		2200	1	Fair	78° - 78°
6-26-83	2034 - 100%	2039		2330	1	P/Cloudy	79° - 75°
6-28-83	2158 - 94%	2154		0200	1	P/Cloudy	79° - 80°
6-30-83	2303 - 81%	2314	2200/0045/ 0200		3	P/Cloudy	78° - 78°
7-1-83	2340 - 73%	2356	2200/0030/ 0200/0215	2130/2200/ 0215/0215	8	P/Cloudy	79° - 78°
7-2-83	2400 - 65%	0041	2145/2245/ 2315	2245/2330/ 0145	6	-	-
7-5-83	0105 - 35%	0231	2400/2300	2200/2330	4	Cloudy	78° - 75°
7-6-83	0138 - 25%	0326	0330/0600		1	Cloudy	78° - 78°
7-8-83	0301 - 9%	1734		0100	1	Clear	77° - 88°
7-10-83	0458 - 0%	1941	0100	2400	2	Cloudy	78° - 78°
7-11-83	0608 - 0%	2032	2300	0100/2400	3	P/Cloudy	79° - 78°
7-13-83	0834 - 9%	2218	0135		1	Clear	79° - 78°
7-14-83	0945 - 17%	2313	2400		1	P/Cloudy	80° - 80°
7-15-83	1052 - 27%	1148	0300/0600	0330/0600	2	Clear	80° - 85°
7-16-83	1157 - 38%	0011	2120/0040/ 0300/0600/ 0300/0600/ 0300/0600	2230/2315/ 0130	8	Clear	78° - 80°

 


TABLE III (continued)

CRAWL INFORMATION IN RELATION TO MOON AND TIDAL CYCLES AND WEATHER CONDITIONS

Date	Moon Rise % Illumin.	Time of High Tide	Time Crawl W/O Nest	Time Crawl W/Nest	Total Crawls	Temp Weather	H2O - AIR
7-17-83	1300 - 49%	0110	2230	2200/2330/ 2400	4	P/Cloudy	80° - 83°
7-21-83	1701 - 86%	1728	2400		1	Clear	80° - 85°
7-27-83	2114 - 96%	2126	2300/2300/ 2300/2400		4	Clear	80° - 79°
7-28-83	2142 - 92%	2201	2215/2400	2230/2230/ 0030	5	Clear	80° - 80°
7-29-83	2210 - 86%	2238	0200	0030/0220	3	Cloudy	76° - 72°
7-30-83	2237 - 79%	2316	2345/0300/ 0600	2200	3	Clear	79° - 80°
8-3-83	0010 - 40%	0150	0300-0600		1	Cloudy	79° - 77°
8-5-83	0138 - 20%	1636		2210	1	Clear	74° - 80°
8-8-83	0455 - 1%	1925	2245/2230		2	P/Cloudy	82° - 82°
8-12-83	0943 - 24%	2252	2400	0130	2	Cloudy	75° - 75°

 


TABLE IV
GROUND SURVEY NUMBERS

(Nights not separated at Midnight)

<u>Date</u>	<u>Crawls/No Nest</u>	<u>Crawls/Nest</u>	<u>Total</u>
6-8-83	0	1	1
6-9-83	0	0	0
6-10-83	0	0	0
6-11-83	1	0	1
6-12-83	0	0	0
6-13-83	2	0	2
6-14-83	0	0	0
6-15-83	1	2	3
6-16-83	1	1	2
6-17-83	1	1	2
6-18-83	2	1	3
6-19-83	0	2	2
6-20-83	1	2	3
6-21-83	0	0	0
6-22-83	0	0	0
6-23-83	0	0	0
6-24-83	0	1	1
6-25-83	0	0	0
6-26-83	0	1	1
6-27-83	0	0	0
6-28-83	0	1	1
6-29-83	0	0	0
6-30-83	3	0	3
7-1-83	4	4	8
7-2-83	3	3	6
7-3-83	0	0	0
7-4-83	0	0	0
7-5-83	2	2	4
7-6-83	1	0	1
7-7-83	0	0	0
7-8-83	0	1	1
7-9-83	0	0	0
7-10-83	1	1	2
7-11-83	1	2	3
7-12-83	0	0	0
7-13-83	1	0	1
7-14-83	1	0	1
7-15-83	1	1	2
7-16-83	5	3	8
7-17-83	1	3	4
7-18-83	0	0	0
7-19-83	0	0	0
7-20-83	0	0	0
7-21-83	1	0	1
7-22-83	0	0	0
7-23-83	0	0	0
7-24-83	0	0	0
7-25-83	0	0	0
7-26-83	0	0	0
7-27-83	4	0	4
7-28-83	2	3	5
7-29-83	1	2	3

 


TABLE IV

GROUND SURVEY NUMBERS

(Nights not separated at Midnight)


<u>Date</u>	<u>Crawls/No Nest</u>	<u>Crawls/Nest</u>	<u>Total</u>
7-30-83	2	1	3
7-31-83	0	0	0
8-1-83	0	0	0
8-2-83	0	0	0
8-3-83	1	0	1
8-4-82	0	0	0
8-5-83	0	1	1
8-6-83	0	0	0
8-7-83	0	0	0
8-8-83	2	0	2
8-9-83	0	0	0
8-10-83	0	0	0
8-11-83	0	0	0
8-12-83	1	1	2
8-13-83	0	0	0



TABLE V
AERIAL SURVEY

1983

Date	ONslow BEACH						BROWNS ISLAND						HAMMOCKS BEACH						Weather Condition
	NC	OC	NN	ON	NP	OP	NC	OC	NN	ON	NP	OP	NC	OC	NN	ON	NP	OP	
5-26-83																			Fog/clear
5-31-83															1				Fog/cloudy
6-3-83																1			Fog/cloudy
6-7-83																			Fog/rain/cloudy
6-10-83																			Fog/rain/cloudy
6-13-83	1						1		1	1									Clear
6-17-83			5				2		6						1				Fog/clear
6-22-83			1	5			2		2	7	7		1		2	1			Haze/cloudy
6-24-83									1										Fog/cloudy
6-29-83			1						1		1		1		1				Haze/cloudy
7-5-83	2	1	2	1			2		1						2	2	2		Fog/cloudy
7-7-83							2		1				1		2				Haze/cloudy
7-10-83													3		2		1		Haze/fog/cloudy
7-15-83	2		2										1		3	1	1		Fog/cloudy
7-19-83			1	2			2		4		3		3		3	3		1	Haze/fog/cloudy
7-22-83				1						1	1								Rain/cloudy
7-27-83									1	1	2								Clear
7-29-83	1	2	3				1	1	1	1	2		1		1		1		Clear
8-4-83	1		1				2	4			2				2	1			Rain
8-11-83									3	3		2	2		3				Fog
8-19-83															2	3			Haze
8-23-83																			Fog
8-31-83	Did not make Flight-Weather Range Use																		

 



NEST AND CRAWL ACTIVITY
ONSLow BEACH, MARINE CORPS BASE
CAMP LEJEUNE, NORTH CAROLINA

Nests - upper map

Crawls no nest - lower map

Dots indicates multiple usage

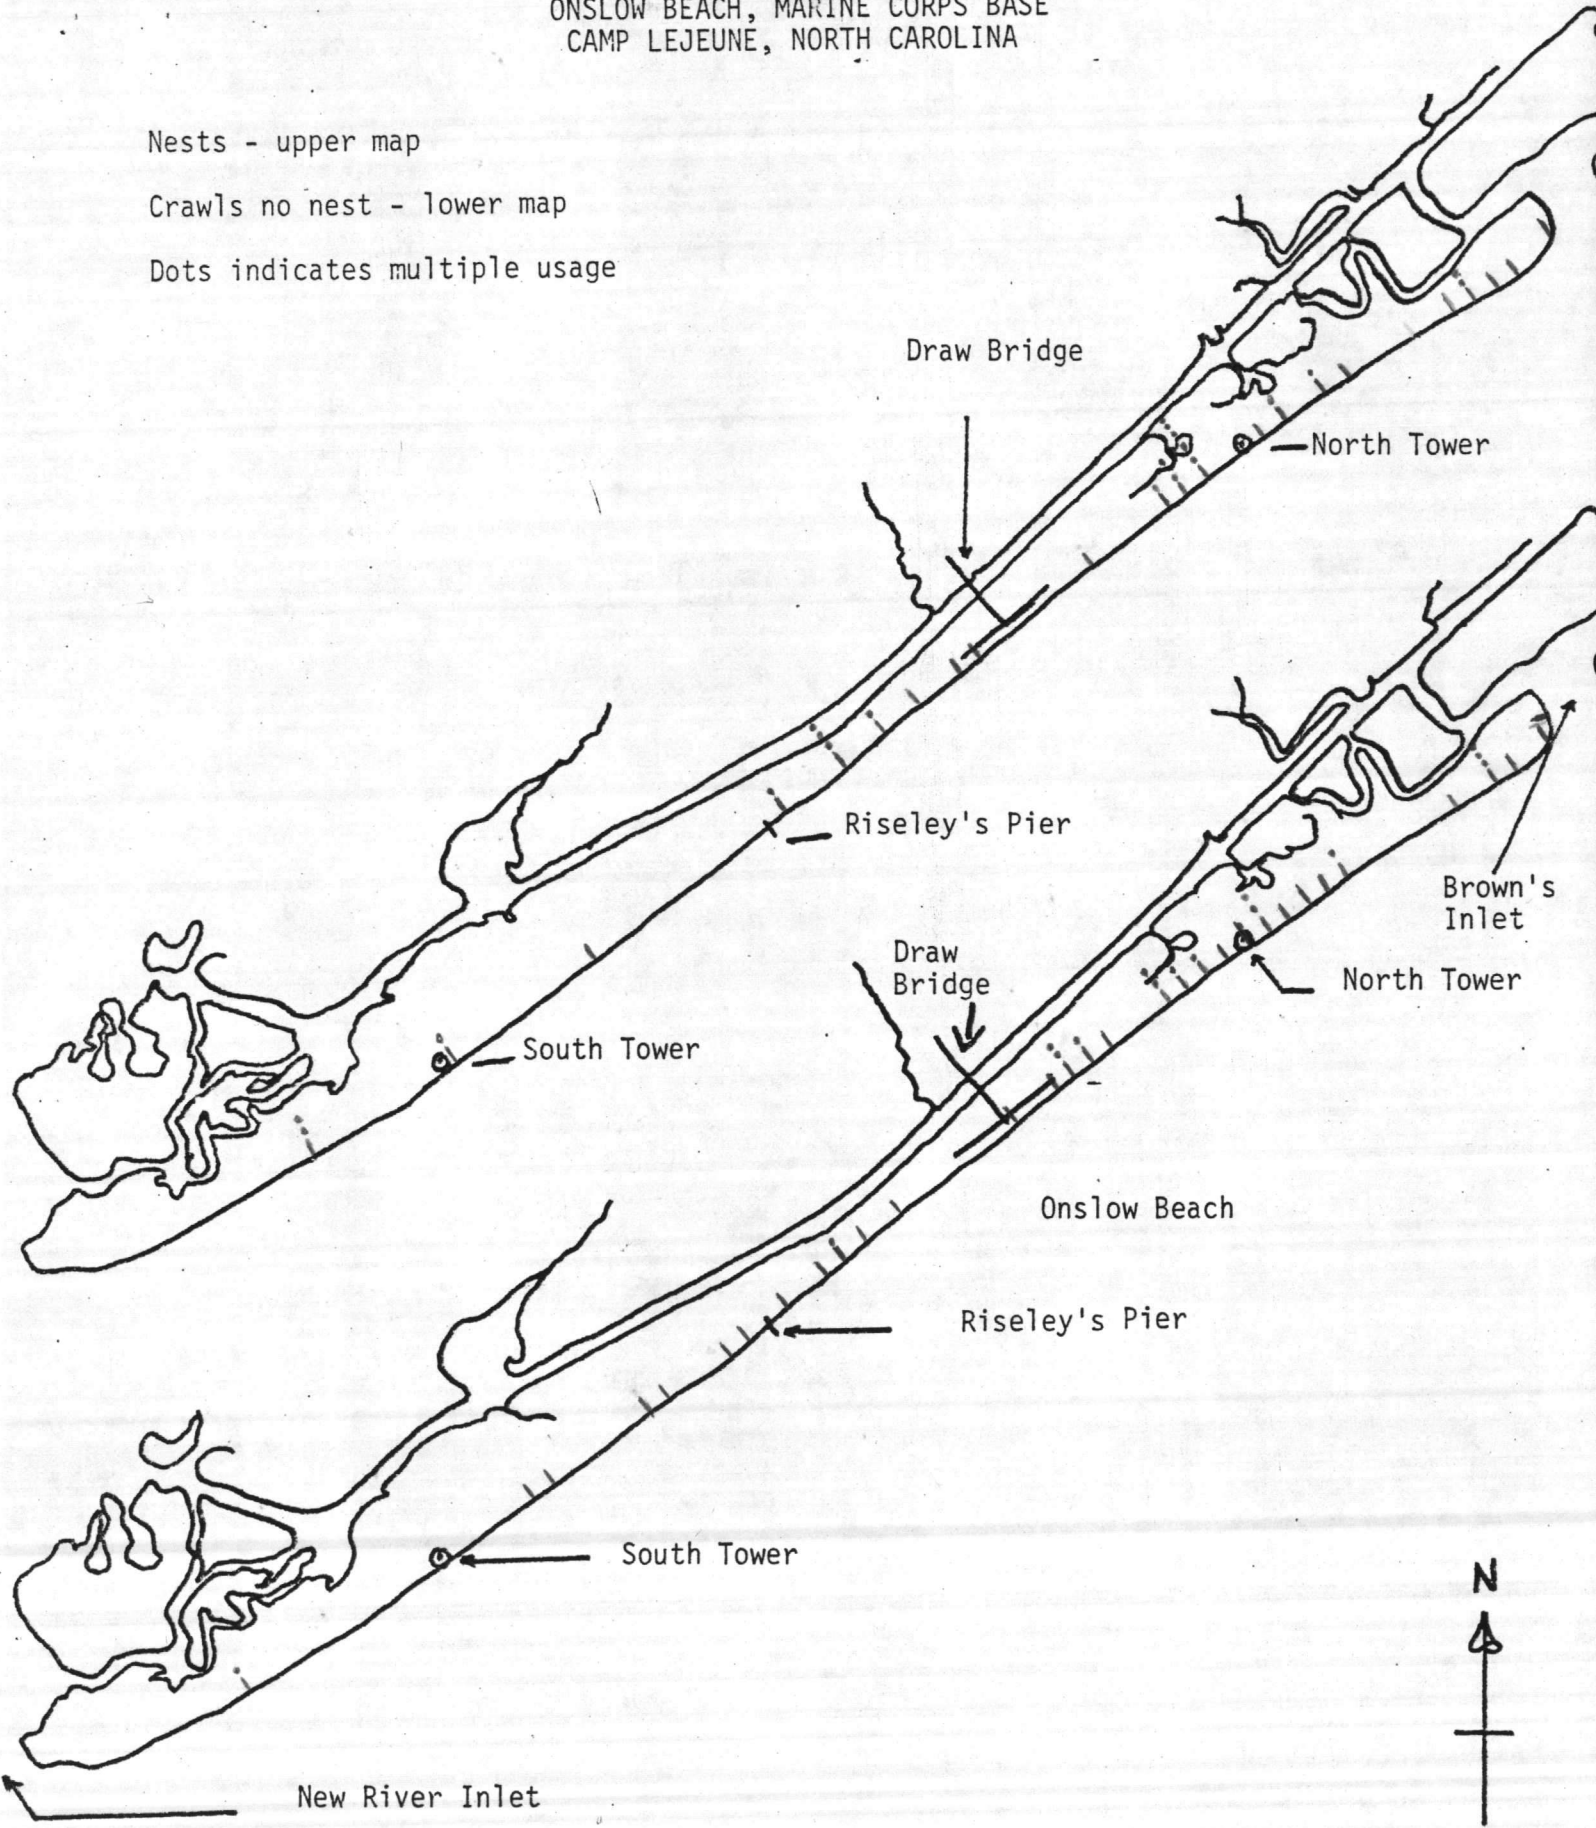

 


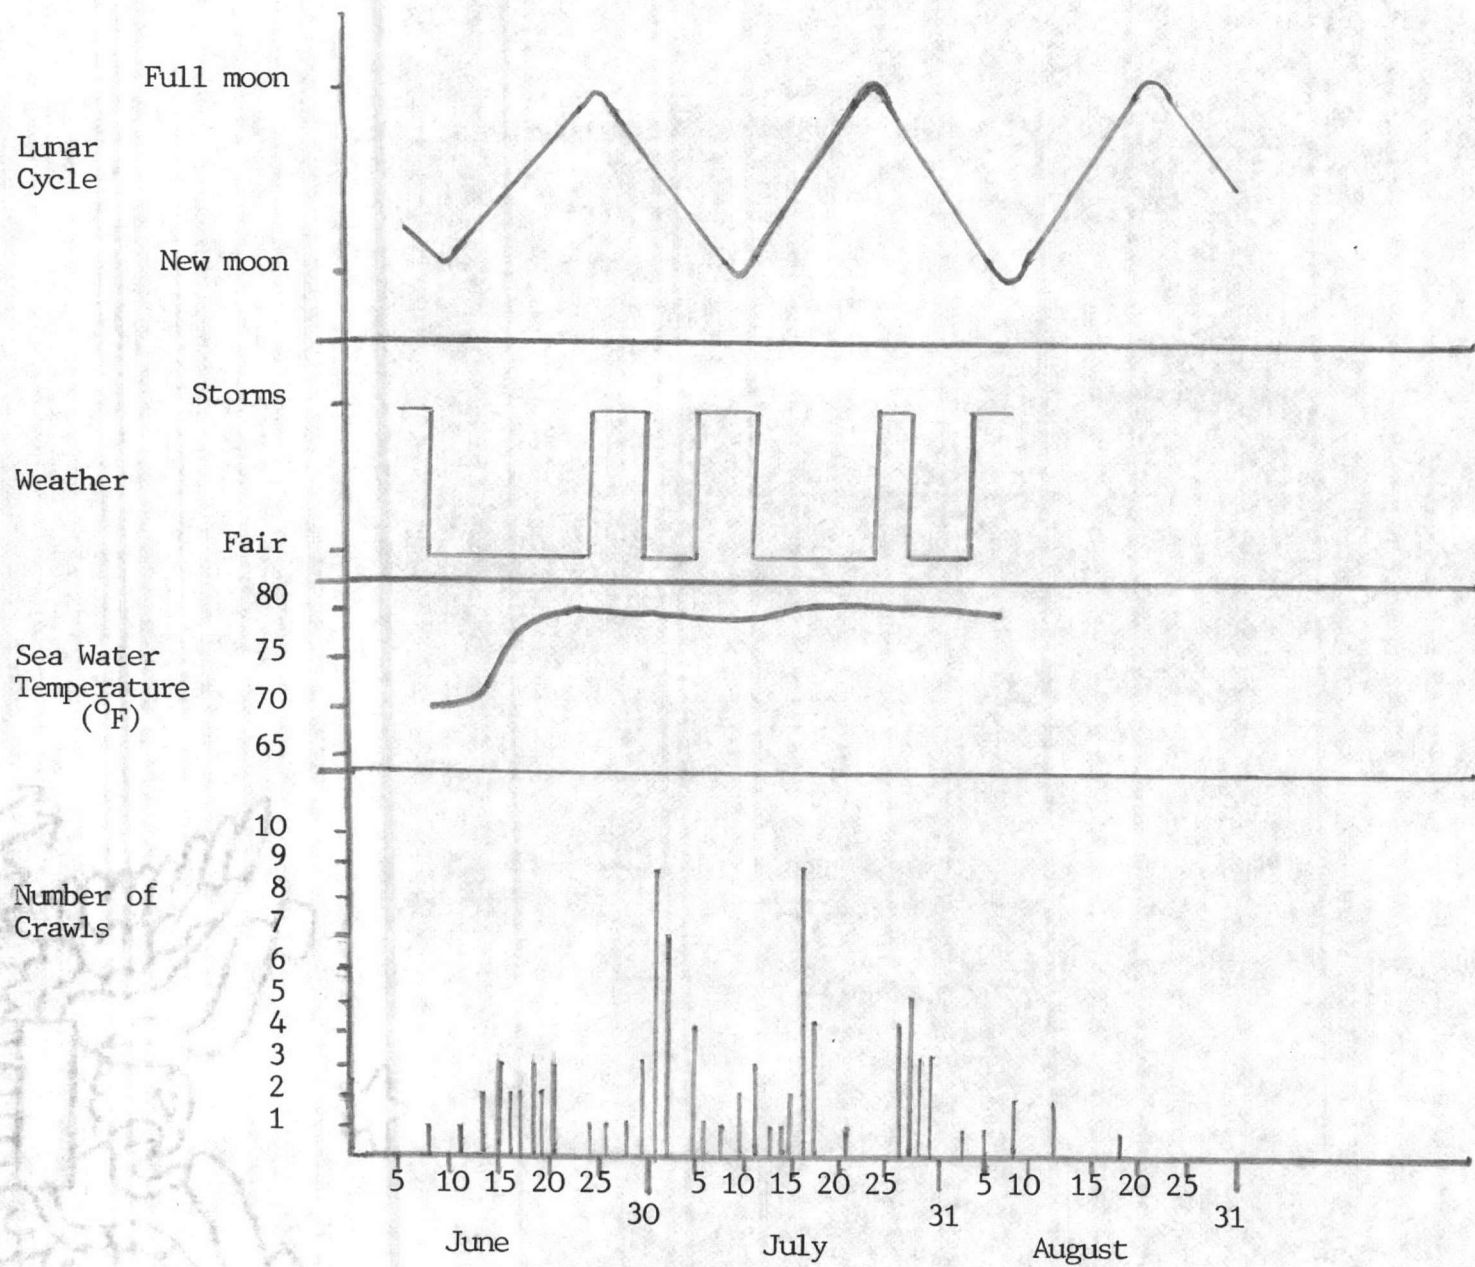


Fig. 1. Crawls in relation to lunar cycle, weather and seawater temperature

 

1980




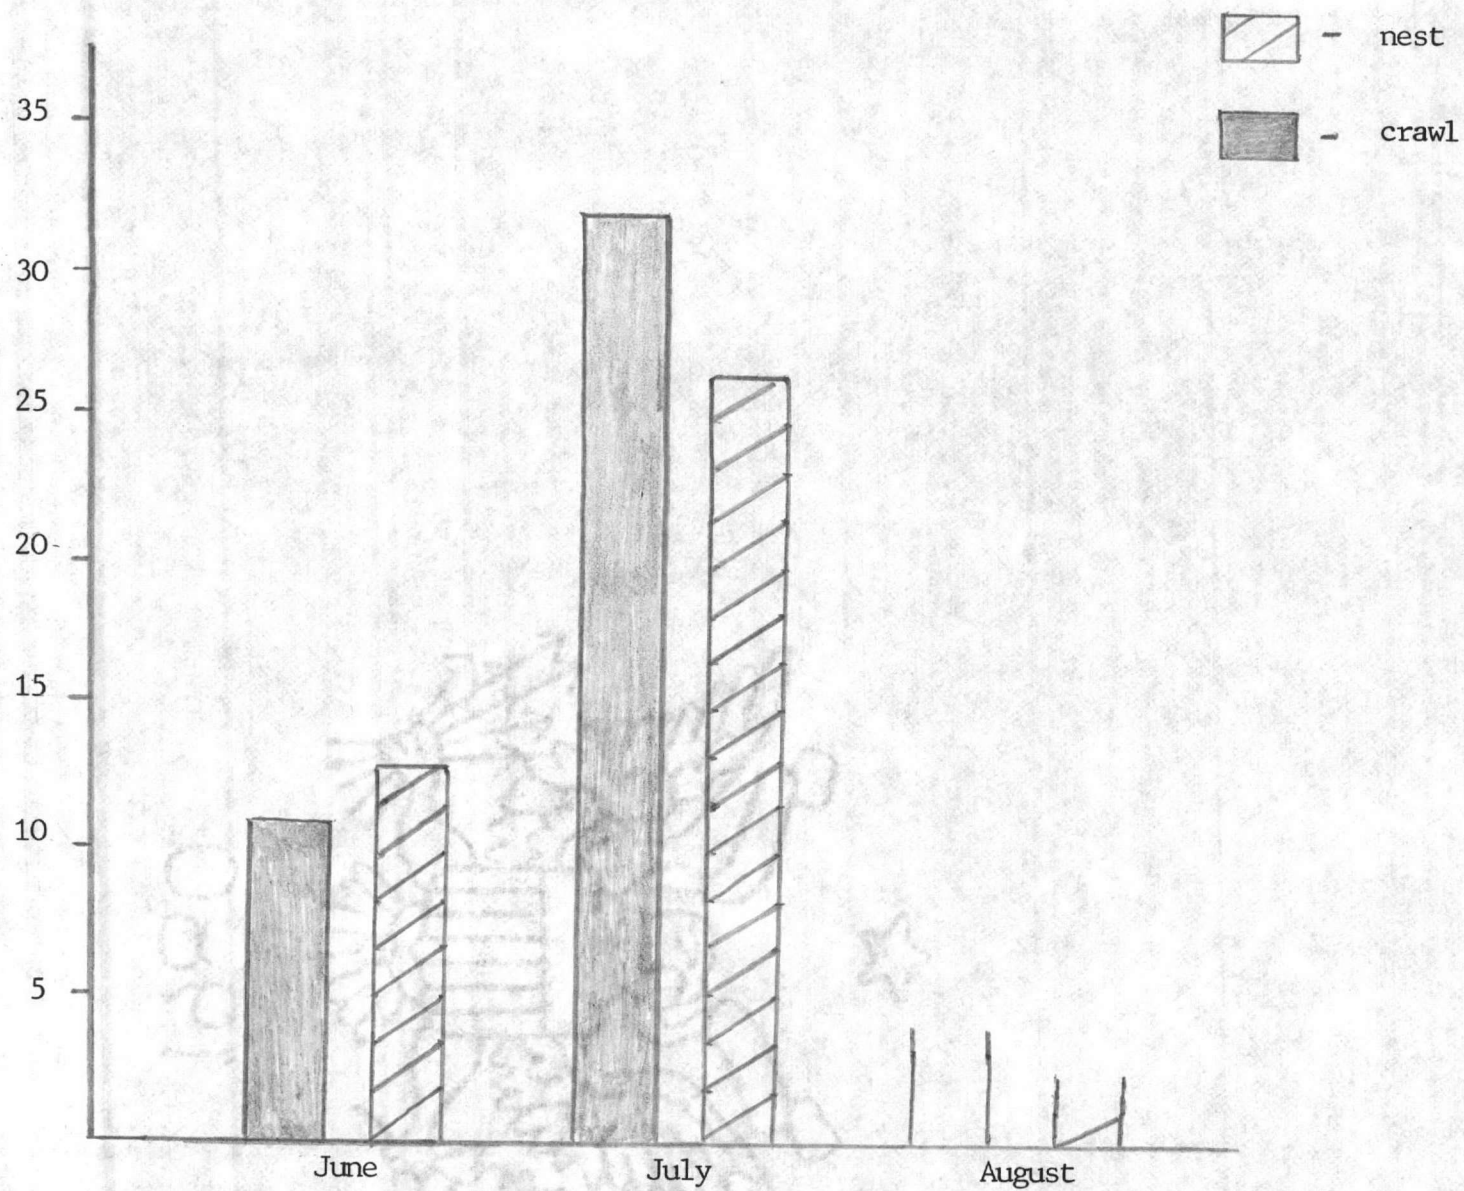


Fig. 2 Total crawls and nests by months

1930

 

24

AERIAL SURVEY DATA

Date: May 26 1983 Time: S 06:00 F 08:00

Recorder Name: Jerry R. Rich

Crew Names: None Pilot: J. R. Rich

Co-Pilot: None Crew Chief: None

Others: None

Weather: General 5 miles Fog & Haze Cloud Cover Clear

Wind Speed Less than 5K Sea Conditions Light Chop

BEACH AERIAL SURVEYS Altitude 100 Ft
Air Speed 60 K

Location	Crawls		Nests		Nest Predation	
	New	Old	New	Old	New	Old
Onslow Beach	0	0	0	0	0	0
Browns Island	0	0	0	0	0	0
Bear Beach	0	0	0	0	0	0

OCEAN AERIAL SURVEYS Altitude 400 Ft
Air Speed 60 K

	Live Turtles		Dead Turtles
	Juvenile	Adults	
Bell Buoy from Bogue Inlet to New River Inlet	0	0	0

Comments:






AERIAL SURVEY DATA

Date: May 31 1983 Time: S 06:00 F 08:30

Recorder Name: H. A. Townsend

Crew Names: None Pilot: Jerry R. Rich

Co-Pilot: None Crew Chief: None

Others: None

Weather: General 4 miles Fog Cloud Cover 2000 SCT

Wind Speed 240 @ 10-12 K Sea Conditions Chop

BEACH AERIAL SURVEYS Altitude 100 Ft
Air Speed 60 K

Location	Crawls		Nests		Nest Predation	
	New	Old	New	Old	New	Old
Onslow Beach	0	0	0	0	0	0
Browns Island	0	0	0	0	0	0
Bear Beach	0	0	1	0	0	0

OCEAN AERIAL SURVEYS Altitude 400 Ft
Air Speed 60 K

	Live Turtles		Dead Turtles
	Juvenile	Adults	
Bell Buoy from Bogue Inlet to New River Inlet			One dead turtle on Browns Island

Comments:

06:30

06:30

06:30


































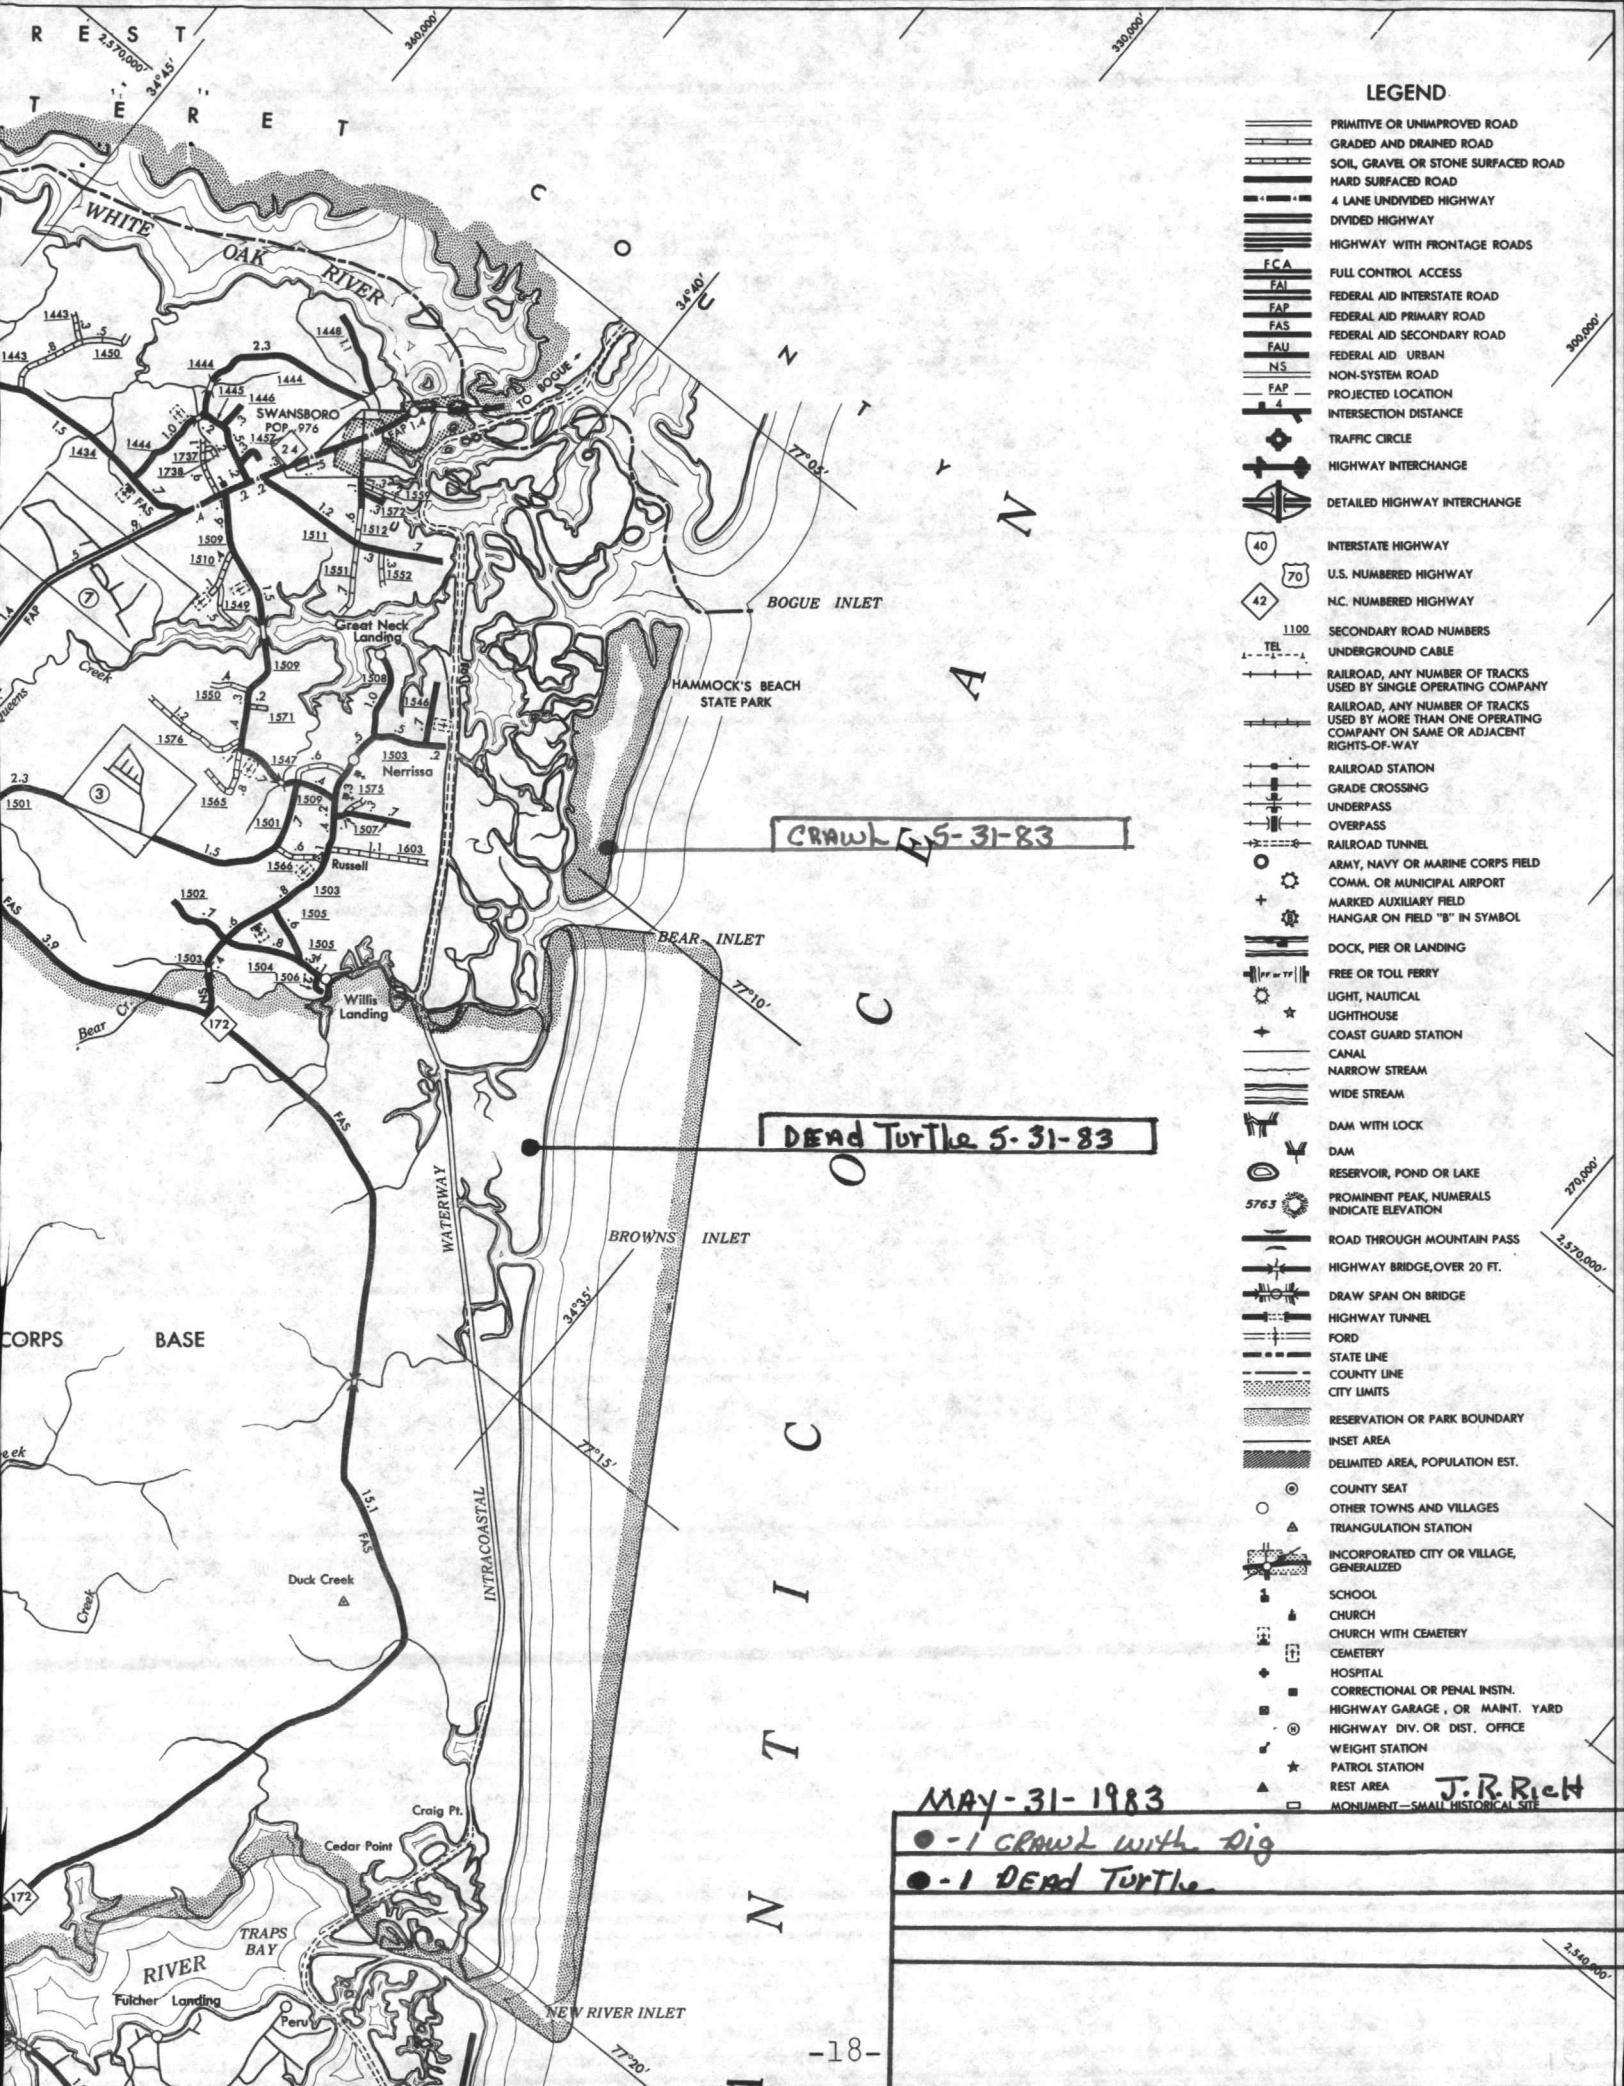

LEGEND

- PRIMITIVE OR UNIMPROVED ROAD
- GRADED AND DRAINED ROAD
- SOIL, GRAVEL OR STONE SURFACED ROAD
- HARD SURFACED ROAD
- 4 LANE UNDIVIDED HIGHWAY
- DIVIDED HIGHWAY
- HIGHWAY WITH FRONTAGE ROADS
- FCA FULL CONTROL ACCESS
- FAI FEDERAL AID INTERSTATE ROAD
- FAP FEDERAL AID PRIMARY ROAD
- FAS FEDERAL AID SECONDARY ROAD
- FAU FEDERAL AID URBAN
- NS NON-SYSTEM ROAD
- FAP 4 PROJECTED LOCATION
- INTERSECTION DISTANCE
- TRAFFIC CIRCLE
- HIGHWAY INTERCHANGE
- DETAILED HIGHWAY INTERCHANGE
- INTERSTATE HIGHWAY
- U.S. NUMBERED HIGHWAY
- N.C. NUMBERED HIGHWAY
- SECONDARY ROAD NUMBERS
- UNDERGROUND CABLE
- RAILROAD, ANY NUMBER OF TRACKS USED BY SINGLE OPERATING COMPANY
- RAILROAD, ANY NUMBER OF TRACKS USED BY MORE THAN ONE OPERATING COMPANY ON SAME OR ADJACENT RIGHTS-OF-WAY
- RAILROAD STATION
- GRADE CROSSING
- UNDERPASS
- OVERPASS
- RAILROAD TUNNEL
- ARMY, NAVY OR MARINE CORPS FIELD
- COMM. OR MUNICIPAL AIRPORT
- MARKED AUXILIARY FIELD
- HANGAR ON FIELD "B" IN SYMBOL
- DOCK, PIER OR LANDING
- FREE OR TOLL FERRY
- LIGHT, NAUTICAL
- LIGHTHOUSE
- COAST GUARD STATION
- CANAL
- NARROW STREAM
- WIDE STREAM
- DAM WITH LOCK
- DAM
- RESERVOIR, POND OR LAKE
- PROMINENT PEAK, NUMERALS INDICATE ELEVATION
- ROAD THROUGH MOUNTAIN PASS
- HIGHWAY BRIDGE, OVER 20 FT.
- DRAW SPAN ON BRIDGE
- HIGHWAY TUNNEL
- FORD
- STATE LINE
- COUNTY LINE
- CITY LIMITS
- RESERVATION OR PARK BOUNDARY
- INSET AREA
- DELIMITED AREA, POPULATION EST.
- COUNTY SEAT
- OTHER TOWNS AND VILLAGES
- TRIANGULATION STATION
- INCORPORATED CITY OR VILLAGE, GENERALIZED
- SCHOOL
- CHURCH
- CHURCH WITH CEMETERY
- CEMETERY
- HOSPITAL
- CORRECTIONAL OR PENAL INSTN.
- HIGHWAY GARAGE, OR MAINT. YARD
- HIGHWAY DIV. OR DIST. OFFICE
- WEIGHT STATION
- PATROL STATION
- REST AREA
- MONUMENT - SMALL HISTORICAL SITE

CRAWL 5-31-83

DEAD Turtle 5-31-83

MAY-31-1983
 ● -1 CRAWL with Dig
 ● -1 DEAD Turtle

J.R. RICH



AERIAL SURVEY DATA

Date: June 3 1983 Time: S 06:00 F 08:00

Recorder Name: J. R. Rich

Crew Names: None Pilot: J. R. Rich

Co-Pilot: None Crew Chief: None

Others: None

Weather: General 3 to 5 miles fog. Cloud Cover 4000 Sct

Wind Speed Less than 5 K Sea Conditions calm

BEACH AERIAL SURVEYS Altitude 100 Ft
Air Speed 60 K

Location	Crawls		Nests		Nest Predation	
	New	Old	New	Old	New	Old
Onslow Beach	0	0	0	0	0	0
Browns Island	0	0	0	0	0	0
Bear Beach	0	0	0	1	0	0

OCEAN AERIAL SURVEYS Altitude 400 Ft
Air Speed 60 K

	Live Turtles		Dead Turtles
	Juvenile	Adults	
Bell Buoy from Bogue Inlet to New River Inlet	0	0	1 Dead Turtle Browns Island first seen 5 31 83.

Comments:













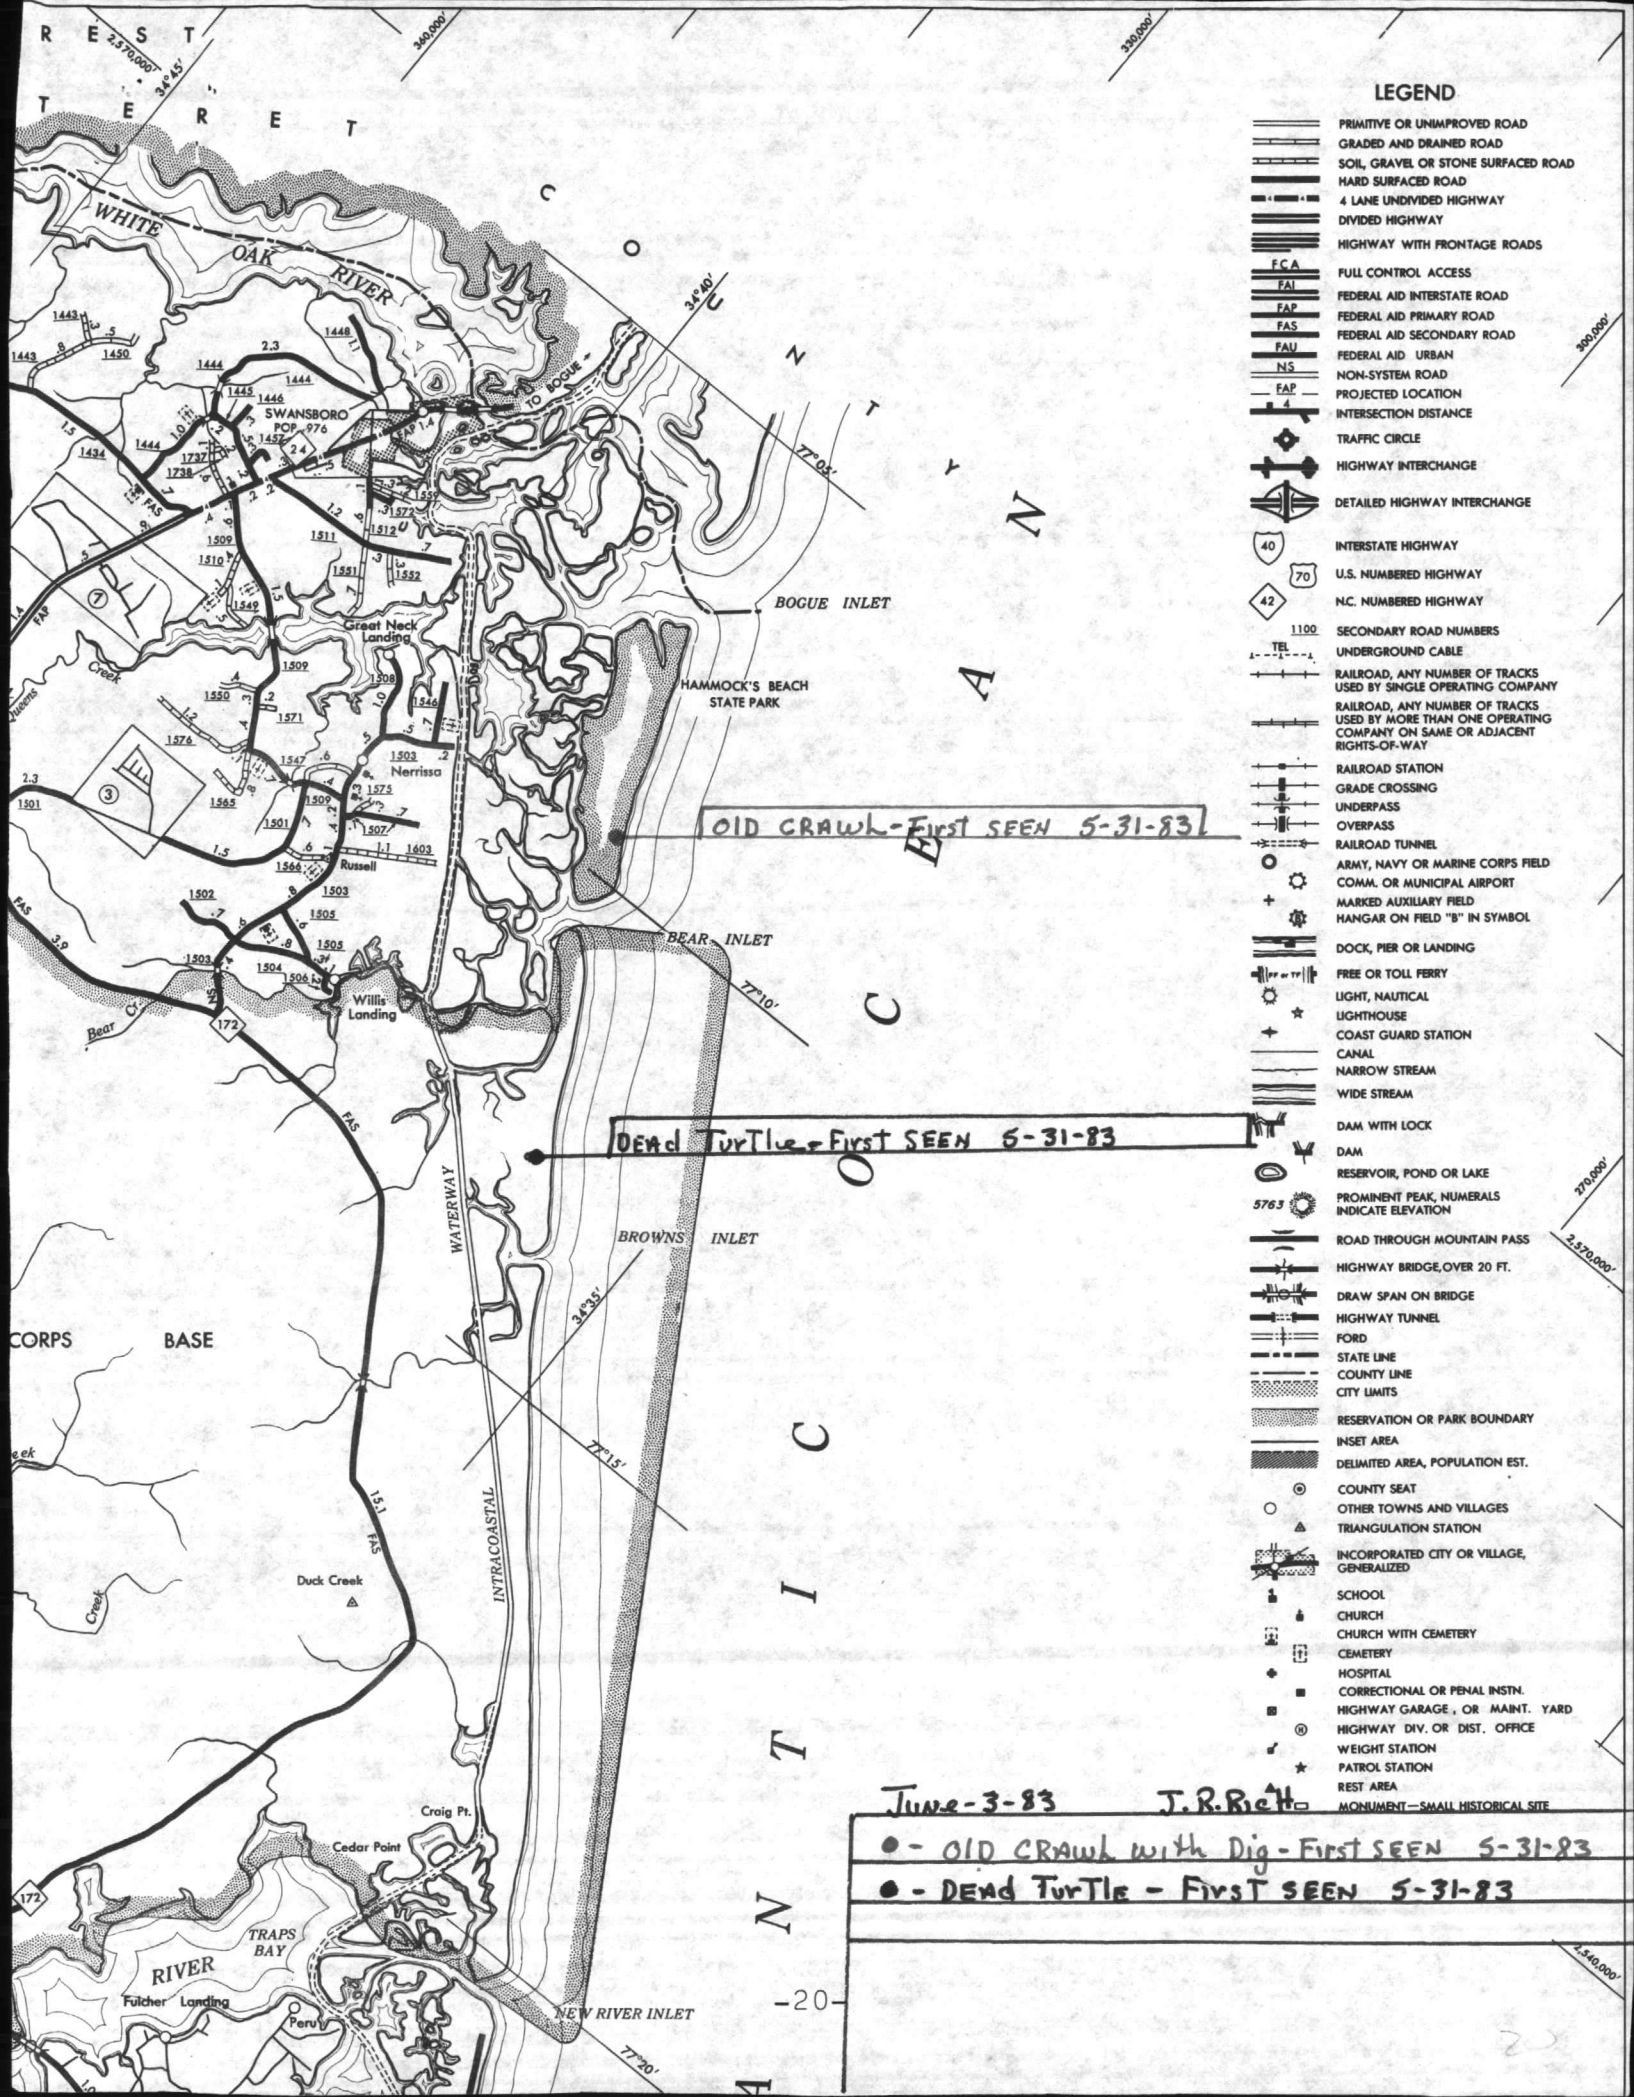

LEGEND

- PRIMITIVE OR UNIMPROVED ROAD
- GRADED AND DRAINED ROAD
- SOIL, GRAVEL OR STONE SURFACED ROAD
- HARD SURFACED ROAD
- 4 LANE UNDIVIDED HIGHWAY
- DIVIDED HIGHWAY
- HIGHWAY WITH FRONTAGE ROADS
- FULL CONTROL ACCESS
- FEDERAL AID INTERSTATE ROAD
- FEDERAL AID PRIMARY ROAD
- FEDERAL AID SECONDARY ROAD
- FEDERAL AID URBAN
- NON-SYSTEM ROAD
- PROJECTED LOCATION
- INTERSECTION DISTANCE
- TRAFFIC CIRCLE
- HIGHWAY INTERCHANGE
- DETAILED HIGHWAY INTERCHANGE
- INTERSTATE HIGHWAY
- U.S. NUMBERED HIGHWAY
- N.C. NUMBERED HIGHWAY
- SECONDARY ROAD NUMBERS
- UNDERGROUND CABLE
- RAILROAD, ANY NUMBER OF TRACKS USED BY SINGLE OPERATING COMPANY
- RAILROAD, ANY NUMBER OF TRACKS USED BY MORE THAN ONE OPERATING COMPANY ON SAME OR ADJACENT RIGHTS-OF-WAY
- RAILROAD STATION
- GRADE CROSSING
- UNDERPASS
- OVERPASS
- RAILROAD TUNNEL
- ARMY, NAVY OR MARINE CORPS FIELD
- COMM. OR MUNICIPAL AIRPORT
- MARKED AUXILIARY FIELD
- HANGAR ON FIELD "B" IN SYMBOL
- DOCK, PIER OR LANDING
- FREE OR TOLL FERRY
- LIGHT, NAUTICAL
- LIGHTHOUSE
- COAST GUARD STATION
- CANAL
- NARROW STREAM
- WIDE STREAM
- DAM WITH LOCK
- DAM
- RESERVOIR, POND OR LAKE
- PROMINENT PEAK, NUMERALS INDICATE ELEVATION
- ROAD THROUGH MOUNTAIN PASS
- HIGHWAY BRIDGE, OVER 20 FT.
- DRAW SPAN ON BRIDGE
- HIGHWAY TUNNEL
- FORD
- STATE LINE
- COUNTY LINE
- CITY LIMITS
- RESERVATION OR PARK BOUNDARY
- INSET AREA
- DELIMITED AREA, POPULATION EST.
- COUNTY SEAT
- OTHER TOWNS AND VILLAGES
- TRIANGULATION STATION
- INCORPORATED CITY OR VILLAGE, GENERALIZED
- SCHOOL
- CHURCH
- CHURCH WITH CEMETERY
- CEMETERY
- HOSPITAL
- CORRECTIONAL OR PENAL INSTN.
- HIGHWAY GARAGE, OR MAINT. YARD
- HIGHWAY DIV. OR DIST. OFFICE
- WEIGHT STATION
- PATROL STATION
- REST AREA
- MONUMENT - SMALL HISTORICAL SITE

OLD CRAWL - First SEEN 5-31-83


June-3-83

J.R. Reth

• - OLD CRAWL with Dig - First SEEN 5-31-83

• - DEAD Turtle - First SEEN 5-31-83



AERIAL SURVEY DATA

Date: June 7 1983 Time: S 06:04 F 08:15

Recorder Name: Jerry R. Rich

Crew Names: None Pilot: _____

Co-Pilot: None Crew Chief: _____

Others: None

Weather: General 3-4 miles fog & rain Cloud Cover 2000 BKN 5000 OVC

Wind Speed WSW 12-15 K Sea Conditions White caps

BEACH AERIAL SURVEYS Altitude 100 Ft
Air Speed 60 K

Location	Crawls		Nests		Nest Predation	
	New	Old	New	Old	New	Old
Onslow Beach	0	0	0	0	0	0
Browns Island	0	0	0	0	0	0
Bear Beach	0	0	0	0	0	0

OCEAN AERIAL SURVEYS Altitude 400 Ft
Air Speed 60 K

Location	Live Turtles		Dead Turtles
	Juvenile	Adults	
Bell Buoy from Bogue Inlet to New River Inlet	0	0	One old dead turtle first seen 5-31-83 on Browns Island One New dead turtle on Browns Island.

Comments: _____





































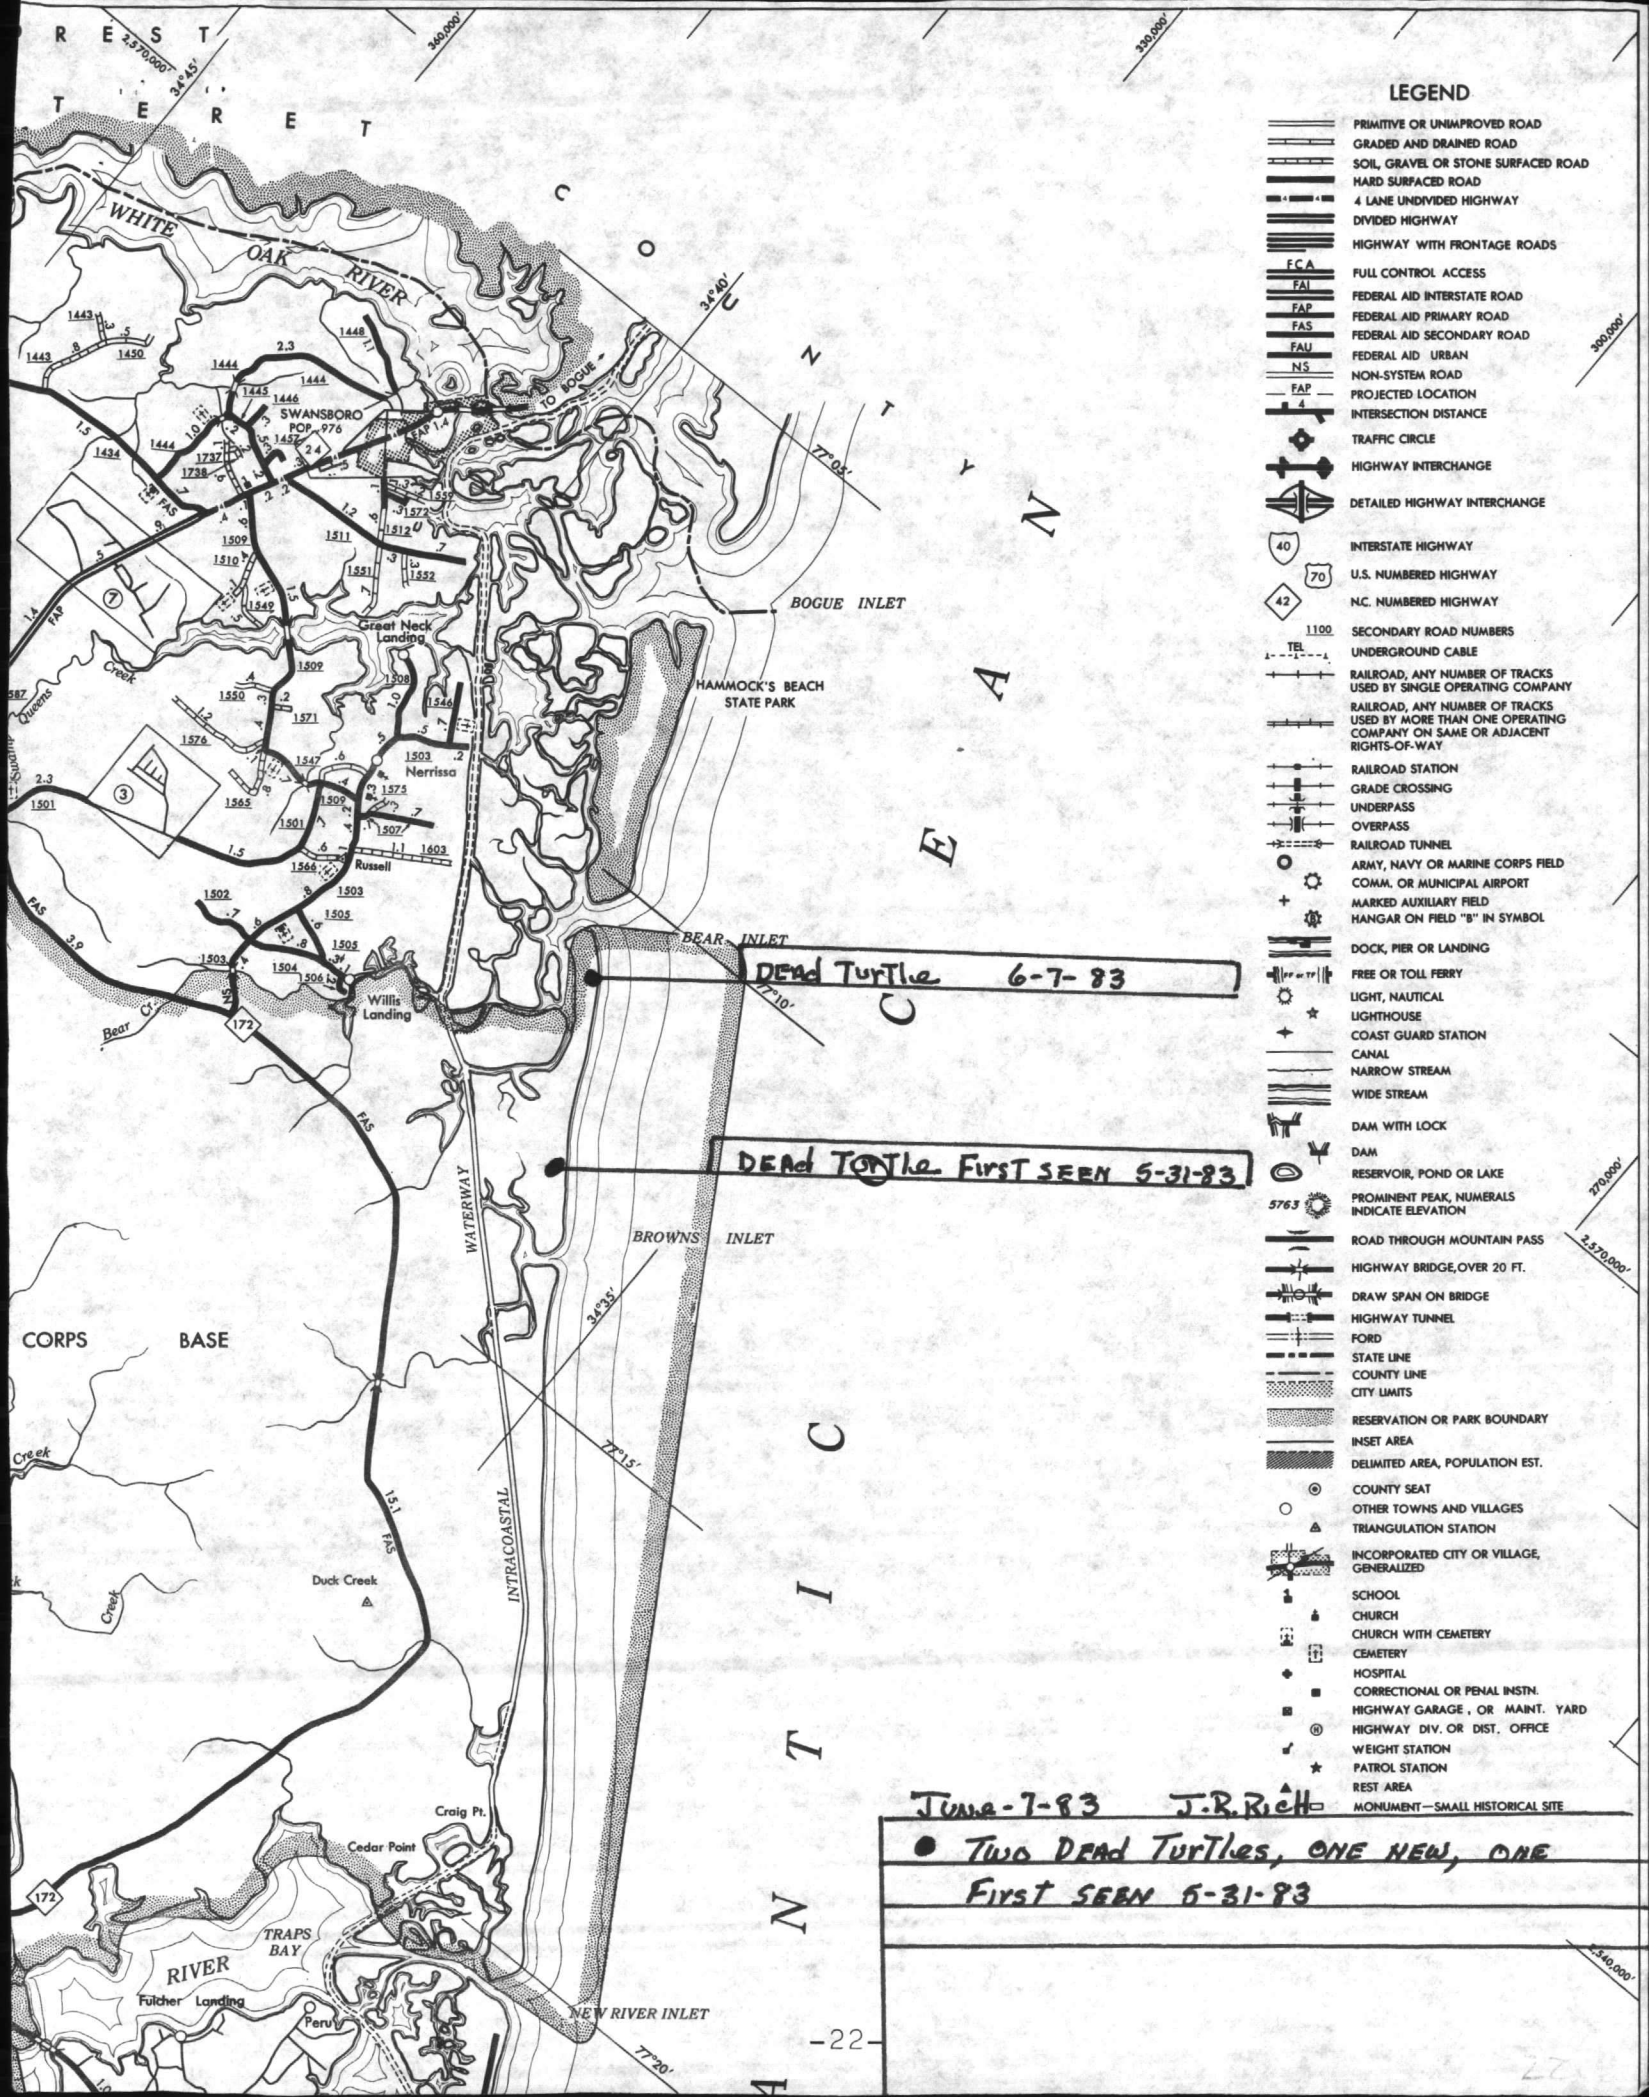

LEGEND

- PRIMITIVE OR UNIMPROVED ROAD
- GRADED AND DRAINED ROAD
- SOIL, GRAVEL OR STONE SURFACED ROAD
- HARD SURFACED ROAD
- 4 LANE UNDIVIDED HIGHWAY
- DIVIDED HIGHWAY
- HIGHWAY WITH FRONTAGE ROADS
- FCA FULL CONTROL ACCESS
- FAI FEDERAL AID INTERSTATE ROAD
- FAP FEDERAL AID PRIMARY ROAD
- FAS FEDERAL AID SECONDARY ROAD
- FAU FEDERAL AID URBAN
- NS NON-SYSTEM ROAD
- PROJECTED LOCATION
- INTERSECTION DISTANCE
- TRAFFIC CIRCLE
- HIGHWAY INTERCHANGE
- DETAILED HIGHWAY INTERCHANGE
- INTERSTATE HIGHWAY
- U.S. NUMBERED HIGHWAY
- N.C. NUMBERED HIGHWAY
- SECONDARY ROAD NUMBERS
- UNDERGROUND CABLE
- RAILROAD, ANY NUMBER OF TRACKS USED BY SINGLE OPERATING COMPANY
- RAILROAD, ANY NUMBER OF TRACKS USED BY MORE THAN ONE OPERATING COMPANY ON SAME OR ADJACENT RIGHTS-OF-WAY
- RAILROAD STATION
- GRADE CROSSING
- UNDERPASS
- OVERPASS
- RAILROAD TUNNEL
- ARMY, NAVY OR MARINE CORPS FIELD
- COMM. OR MUNICIPAL AIRPORT
- MARKED AUXILIARY FIELD
- HANGAR ON FIELD "B" IN SYMBOL
- DOCK, PIER OR LANDING
- FREE OR TOLL FERRY
- LIGHT, NAUTICAL
- LIGHTHOUSE
- COAST GUARD STATION
- CANAL
- NARROW STREAM
- WIDE STREAM
- DAM WITH LOCK
- DAM
- RESERVOIR, POND OR LAKE
- PROMINENT PEAK, NUMERALS INDICATE ELEVATION
- ROAD THROUGH MOUNTAIN PASS
- HIGHWAY BRIDGE, OVER 20 FT.
- DRAW SPAN ON BRIDGE
- HIGHWAY TUNNEL
- FORD
- STATE LINE
- COUNTY LINE
- CITY LIMITS
- RESERVATION OR PARK BOUNDARY
- INSET AREA
- DELIMITED AREA, POPULATION EST.
- COUNTY SEAT
- OTHER TOWNS AND VILLAGES
- TRIANGULATION STATION
- INCORPORATED CITY OR VILLAGE, GENERALIZED
- SCHOOL
- CHURCH
- CHURCH WITH CEMETERY
- CEMETERY
- HOSPITAL
- CORRECTIONAL OR PENAL INSTN.
- HIGHWAY GARAGE, OR MAINT. YARD
- HIGHWAY DIV. OR DIST. OFFICE
- WEIGHT STATION
- PATROL STATION
- REST AREA
- MONUMENT - SMALL HISTORICAL SITE

June-7-83 J.R. Rich

• Two DEAD Turtles, ONE NEW, ONE FIRST SEEN 5-31-83




AERIAL SURVEY DATA

Date: June 10 1983 Time: S 06:06 F 08:10

Recorder Name: Jerry R. Rich

Crew Names: None Pilot: J. R. Rich

Co-Pilot: None Crew Chief: None

Others: None

Weather: General 2 miles rain & fog Cloud Cover 500 OVC

Wind Speed N.E. 15-20 K Sea Conditions White caps

BEACH AERIAL SURVEYS Altitude 100 Ft
Air Speed 60 K

Location	Crawls		Nests		Nest Predation	
	New	Old	New	Old	New	Old
Onslow Beach	0	0	0	0	0	0
Browns Island	0	0	0	0	0	0
Bear Beach	0	0	0	0	0	0

OCEAN AERIAL SURVEYS Altitude 200 Ft
Air Speed 60 K

	Live Turtles		Dead Turtles
	Juvenile	Adults	
Bell Buoy from Bogue Inlet to New River Inlet	0	0	2 Dead Turtle on Browns Island Same two turtle seen on June 7 83

Comments:




































AERIAL SURVEY DATA

Date: June 13 1983 Time: S 06:04 F 08:24

Recorder Name: Jerry R. Rich

Crew Names: None Pilot: J. R. Rich

Co-Pilot: None Crew Chief: None

Others: None

Weather: General Clear 10 miles vis. Cloud Cover Clear

Wind Speed NE 5 K Sea Conditions Light chop

BEACH AERIAL SURVEYS Altitude 100 Ft

Air Speed 60 K

Location	Crawls		Nests		Nest Predation	
	New	Old	New	Old	New	Old
Onslow Beach	1	0	0	0	0	0
Browns Island	1	0	1	1	0	0
Bear Beach	0	0	0	0	0	0

OCEAN AERIAL SURVEYS Altitude 300 Ft

Air Speed 60 K

	Live Turtles		Dead Turtles
	Juvenile	Adults	
Bell Buoy from Bogue Inlet to New River Inlet	0	0	1 dead turtle Bear Beach 2 dead turtle Browns Island, same two as reported June 10 1983

Comments:








































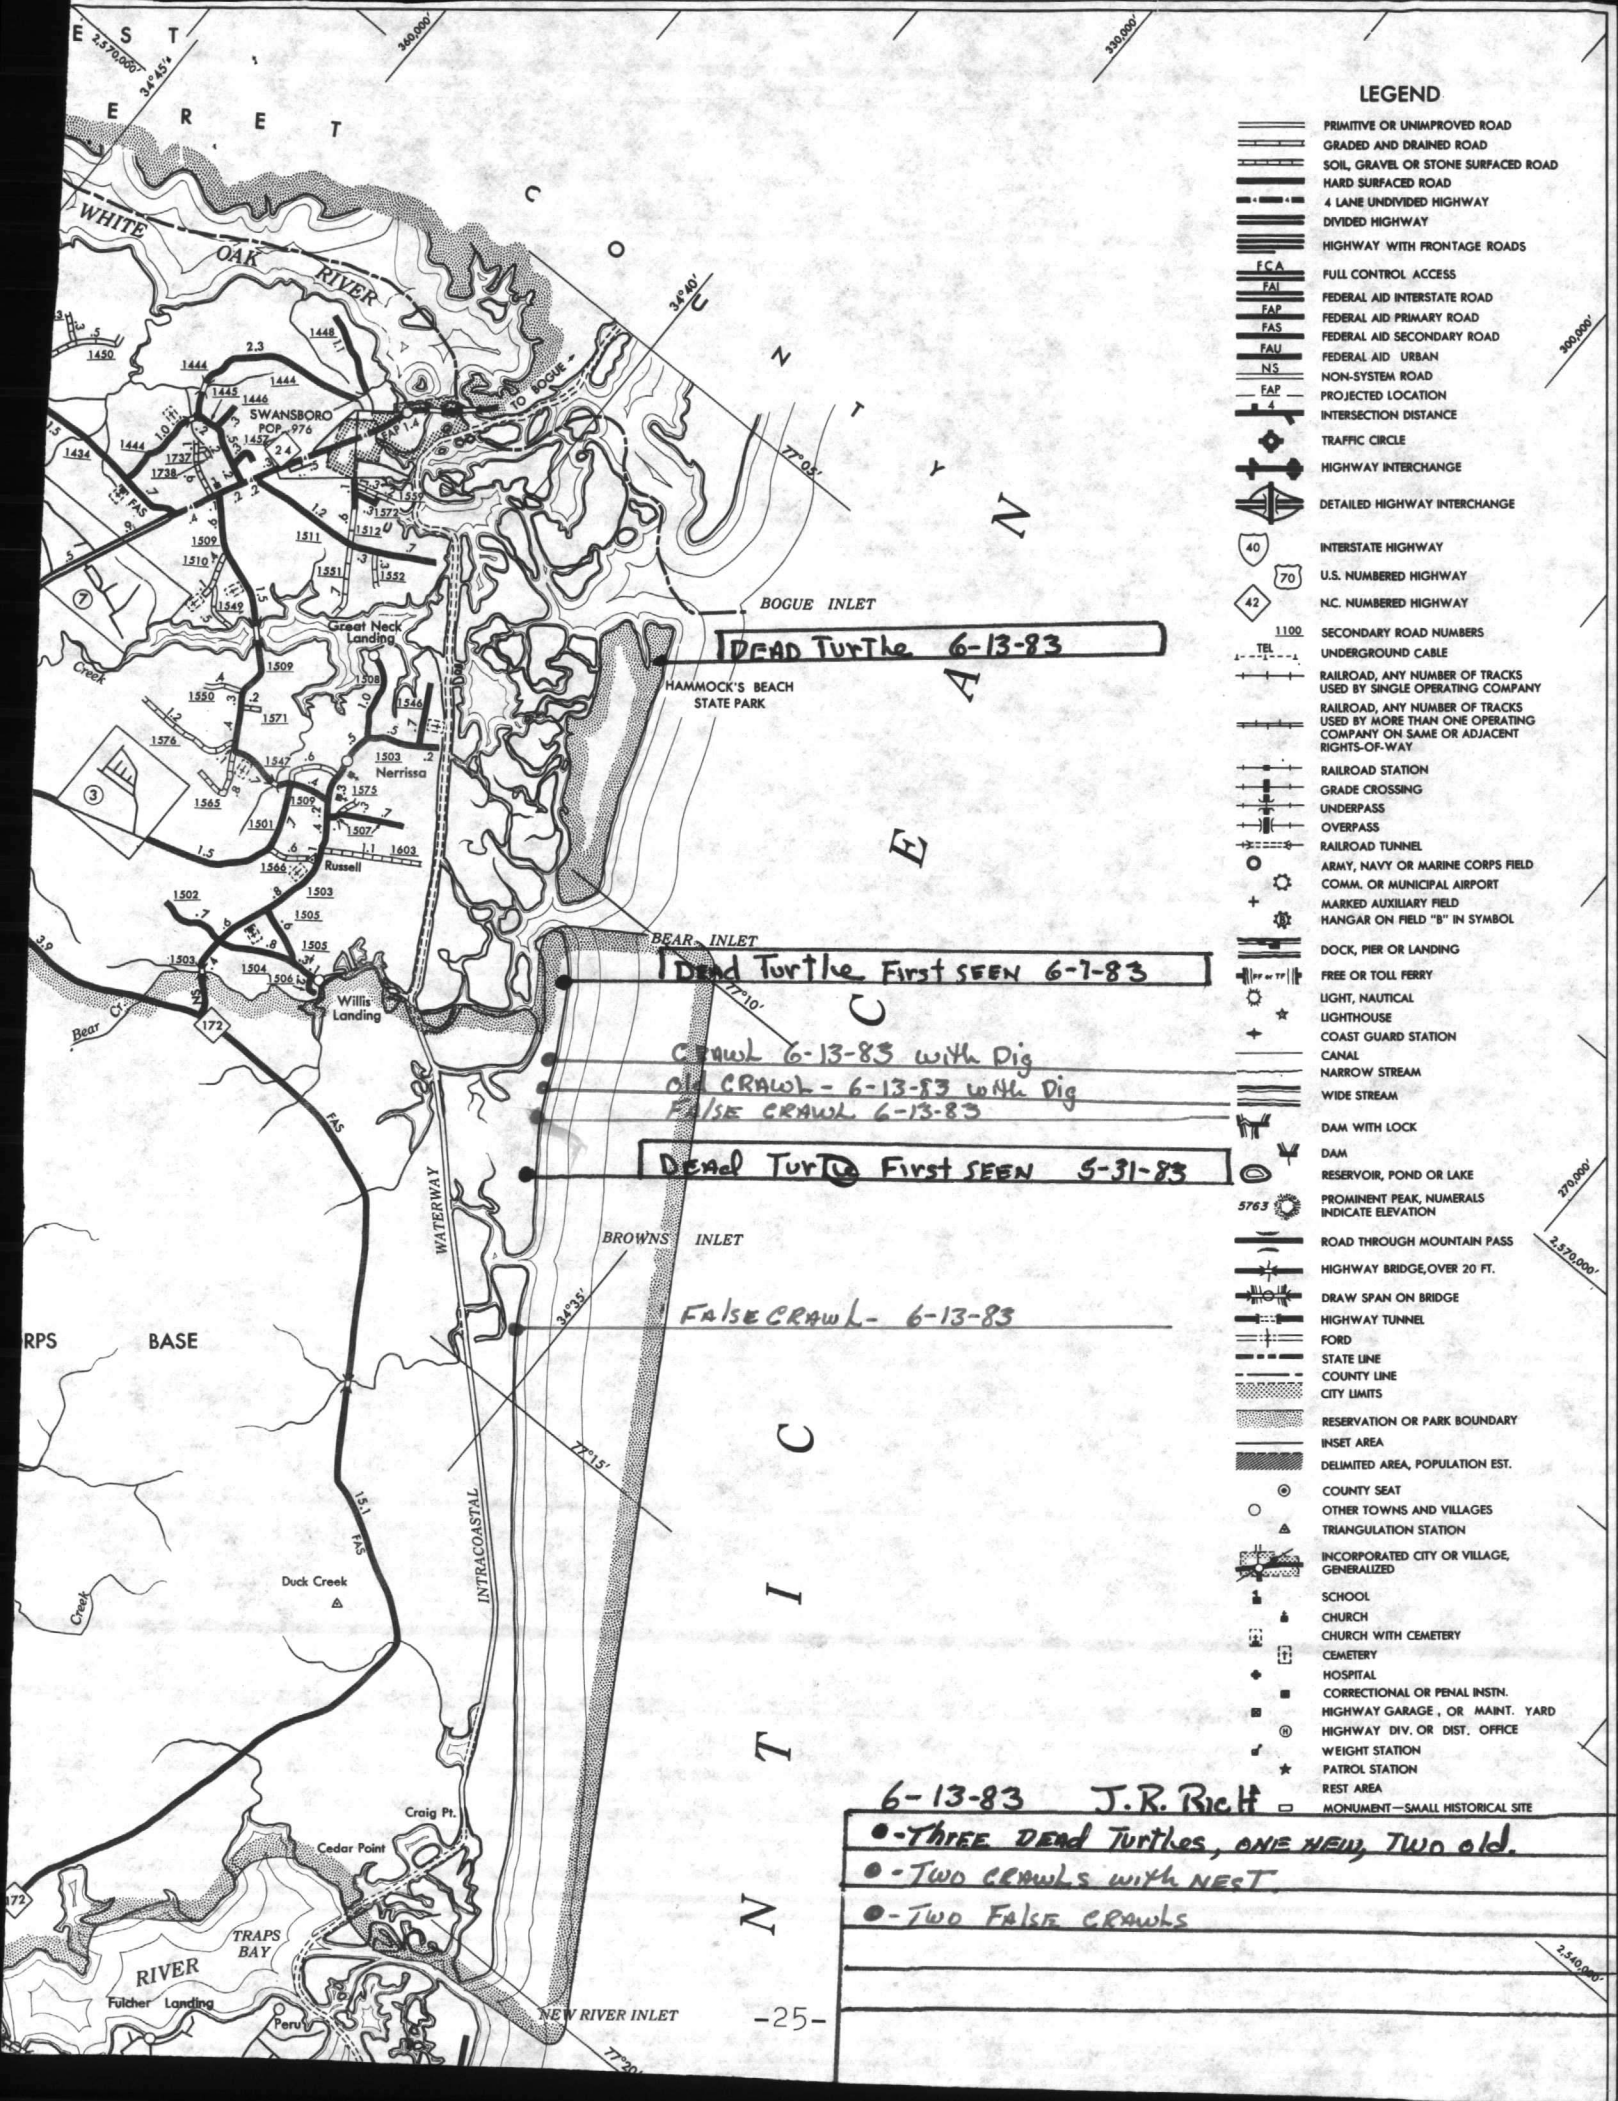

LEGEND

- PRIMITIVE OR UNIMPROVED ROAD
- GRADED AND DRAINED ROAD
- SOIL, GRAVEL OR STONE SURFACED ROAD
- HARD SURFACED ROAD
- 4 LANE UNDIVIDED HIGHWAY
- DIVIDED HIGHWAY
- HIGHWAY WITH FRONTAGE ROADS
- FCA FULL CONTROL ACCESS
- FAI FEDERAL AID INTERSTATE ROAD
- FAP FEDERAL AID PRIMARY ROAD
- FAS FEDERAL AID SECONDARY ROAD
- FAU FEDERAL AID URBAN
- NS NON-SYSTEM ROAD
- FAP PROJECTED LOCATION
- INTERSECTION DISTANCE
- TRAFFIC CIRCLE
- HIGHWAY INTERCHANGE
- DETAILED HIGHWAY INTERCHANGE
- INTERSTATE HIGHWAY
- U.S. NUMBERED HIGHWAY
- N.C. NUMBERED HIGHWAY
- SECONDARY ROAD NUMBERS
- UNDERGROUND CABLE
- RAILROAD, ANY NUMBER OF TRACKS USED BY SINGLE OPERATING COMPANY
- RAILROAD, ANY NUMBER OF TRACKS USED BY MORE THAN ONE OPERATING COMPANY ON SAME OR ADJACENT RIGHTS-OF-WAY
- RAILROAD STATION
- GRADE CROSSING
- UNDERPASS
- OVERPASS
- RAILROAD TUNNEL
- ARMY, NAVY OR MARINE CORPS FIELD
- COMM. OR MUNICIPAL AIRPORT
- MARKED AUXILIARY FIELD
- HANGAR ON FIELD "B" IN SYMBOL
- DOCK, PIER OR LANDING
- FREE OR TOLL FERRY
- LIGHT, NAUTICAL
- LIGHTHOUSE
- COAST GUARD STATION
- CANAL
- NARROW STREAM
- WIDE STREAM
- DAM WITH LOCK
- DAM
- RESERVOIR, POND OR LAKE
- PROMINENT PEAK, NUMERALS INDICATE ELEVATION
- ROAD THROUGH MOUNTAIN PASS
- HIGHWAY BRIDGE, OVER 20 FT.
- DRAW SPAN ON BRIDGE
- HIGHWAY TUNNEL
- FORD
- STATE LINE
- COUNTY LINE
- CITY LIMITS
- RESERVATION OR PARK BOUNDARY
- INSET AREA
- DELIMITED AREA, POPULATION EST.
- COUNTY SEAT
- OTHER TOWNS AND VILLAGES
- TRIANGULATION STATION
- INCORPORATED CITY OR VILLAGE, GENERALIZED
- SCHOOL
- CHURCH
- CHURCH WITH CEMETERY
- CEMETERY
- HOSPITAL
- CORRECTIONAL OR PENAL INSTN.
- HIGHWAY GARAGE, OR MAINT. YARD
- HIGHWAY DIV. OR DIST. OFFICE
- WEIGHT STATION
- PATROL STATION
- REST AREA
- MONUMENT - SMALL HISTORICAL SITE

Dead Turtle 6-13-83

Dead Turtle First SEEN 6-7-83

*Crawl 6-13-83 with Dig
Old CRAWL - 6-13-83 with Dig
FALSE CRAWL 6-13-83*

Dead Turtle First SEEN 5-31-83

FALSE CRAWL - 6-13-83

6-13-83 J.R. Biehl

- - THREE DEAD TURTLES, ONE NEW, TWO OLD.
- - TWO CRAWLS WITH NEST
- - TWO FALSE CRAWLS







NEST AND CRAWL ACTIVITY
ONSLow BEACH, MARINE CORPS BASE
CAMP LEJEUNE, NORTH CAROLINA

Nests - upper map

Crawls no nest - lower map

Dots indicates multiple usage

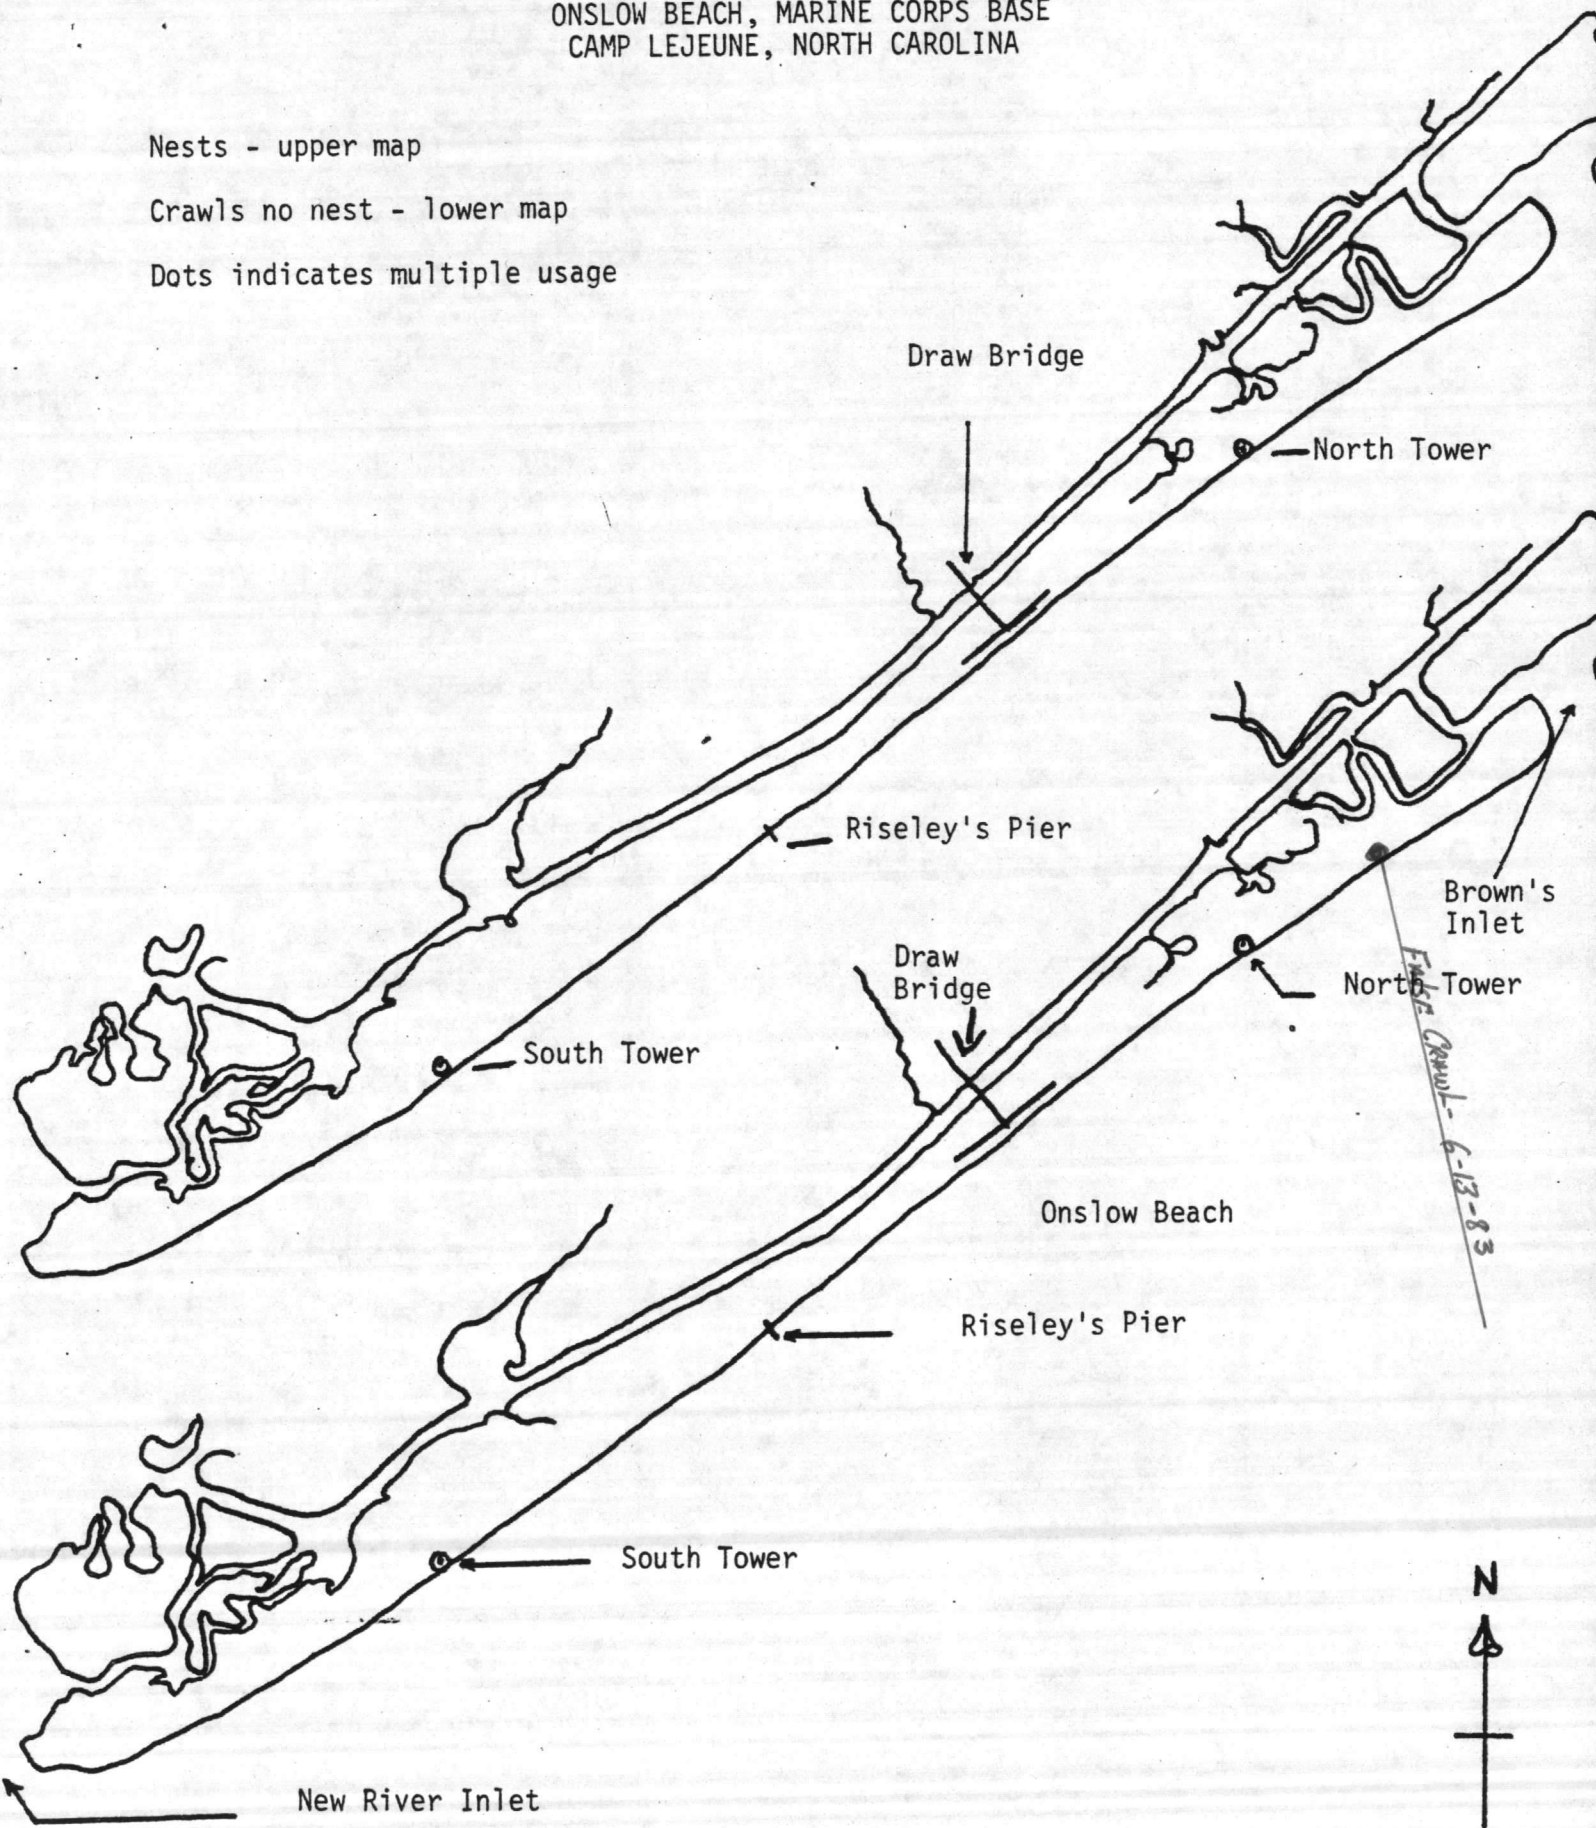

 

AERIAL SURVEY DATA

Date: June 17 83 Time: S 06:00 F 09:45

Recorder Name: H. A. Townsend

Crew Names: None Pilot: H. A. Townsend

Co-Pilot: None Crew Chief: None

Others: None

Weather: General 4 miles fog Cloud Cover clear

Wind Speed calm Sea Conditions Calm

BEACH AERIAL SURVEYS Altitude 100 Ft
Air Speed 60 K

Location	Crawls		Nests		Nest Predation	
	New	Old	New	Old	New	Old
Onslow Beach	0	0	5	0	0	0
Browns Island	2	0	6	0	0	0
Bear Beach	0	0	1	0	0	0

OCEAN AERIAL SURVEYS Altitude 400 Ft
Air Speed 60 K

	Live Turtles		Dead Turtles
	Juvenile	Adults	
Bell Buoy from Bogue Inlet to New River Inlet	0	0	0

Comments:

04:00

05:30

07:00

08:30

09:00

09:30

10:00

10:30

11:00

11:30

12:00

12:30

13:00

13:30

14:00

0

0

0

0

0

0

0

0

0

0

0

0

0

0

0

1

0

0

15:00

15:30


0

0

0

LEGEND

- PRIMITIVE OR UNIMPROVED ROAD
- GRADED AND DRAINED ROAD
- SOIL, GRAVEL OR STONE SURFACED ROAD
- HARD SURFACED ROAD
- 4 LANE UNDIVIDED HIGHWAY
- DIVIDED HIGHWAY
- HIGHWAY WITH FRONTAGE ROADS
- FCA FULL CONTROL ACCESS
- FAI FEDERAL AID INTERSTATE ROAD
- FAP FEDERAL AID PRIMARY ROAD
- FAS FEDERAL AID SECONDARY ROAD
- FAU FEDERAL AID URBAN
- NS NON-SYSTEM ROAD
- FAP 4 PROJECTED LOCATION
- INTERSECTION DISTANCE
- TRAFFIC CIRCLE
- HIGHWAY INTERCHANGE
- DETAILED HIGHWAY INTERCHANGE
- INTERSTATE HIGHWAY
- U.S. NUMBERED HIGHWAY
- N.C. NUMBERED HIGHWAY
- SECONDARY ROAD NUMBERS
- UNDERGROUND CABLE
- RAILROAD, ANY NUMBER OF TRACKS USED BY SINGLE OPERATING COMPANY
- RAILROAD, ANY NUMBER OF TRACKS USED BY MORE THAN ONE OPERATING COMPANY ON SAME OR ADJACENT RIGHTS-OF-WAY
- RAILROAD STATION
- GRADE CROSSING
- UNDERPASS
- OVERPASS
- RAILROAD TUNNEL
- ARMY, NAVY OR MARINE CORPS FIELD COMM. OR MUNICIPAL AIRPORT
- MARKED AUXILIARY FIELD HANGAR ON FIELD "B" IN SYMBOL
- DOCK, PIER OR LANDING
- FREE OR TOLL FERRY
- LIGHT, NAUTICAL LIGHTHOUSE
- COAST GUARD STATION
- CANAL
- NARROW STREAM
- WIDE STREAM
- DAM WITH LOCK
- DAM
- RESERVOIR, POND OR LAKE
- PROMINENT PEAK, NUMERALS INDICATE ELEVATION
- ROAD THROUGH MOUNTAIN PASS
- HIGHWAY BRIDGE, OVER 20 FT.
- DRAW SPAN ON BRIDGE
- HIGHWAY TUNNEL
- FORD
- STATE LINE
- COUNTY LINE
- CITY LIMITS
- RESERVATION OR PARK BOUNDARY
- INSET AREA
- DELIMITED AREA, POPULATION EST.
- COUNTY SEAT
- OTHER TOWNS AND VILLAGES
- TRIANGULATION STATION
- INCORPORATED CITY OR VILLAGE, GENERALIZED
- SCHOOL
- CHURCH
- CHURCH WITH CEMETERY
- CEMETERY
- HOSPITAL
- CORRECTIONAL OR PENAL INSTN.
- HIGHWAY GARAGE, OR MAINT. YARD
- HIGHWAY DIV. OR DIST. OFFICE
- WEIGHT STATION
- PATROL STATION
- REST AREA
- MONUMENT - SMALL HISTORICAL SITE

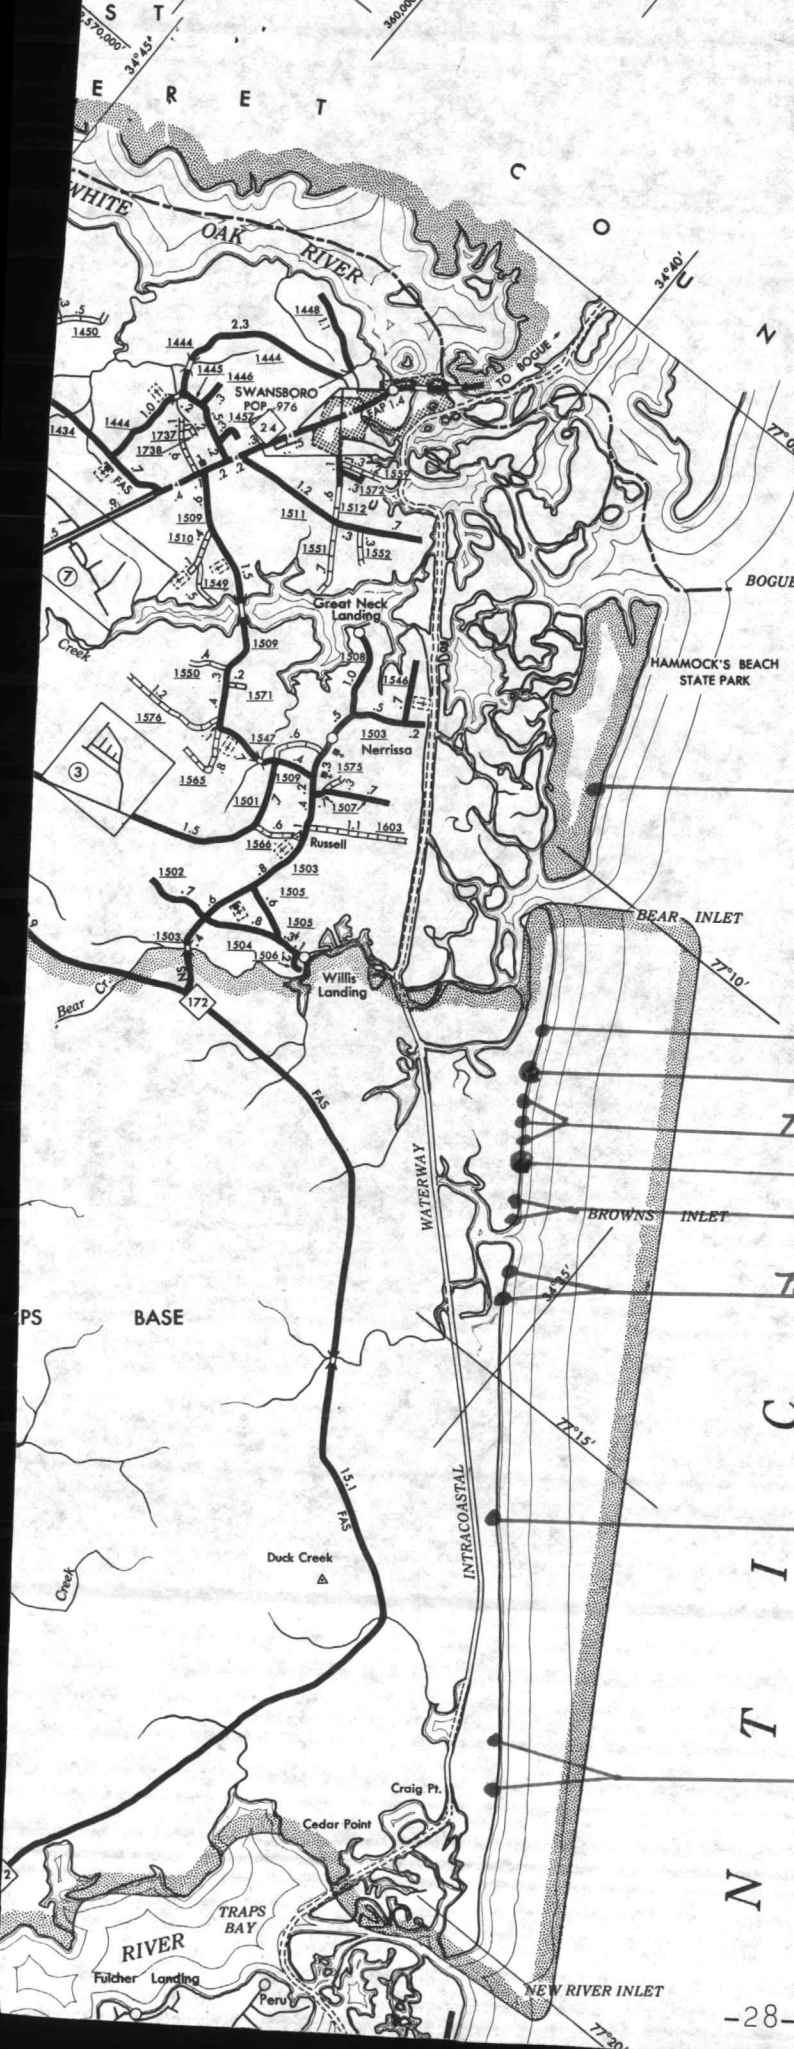

CRAWL- 6-17-83

FALSE CRAWL- 6-17-83

THREE CRAWLS- 6-17-83

FALSE CRAWL- 6-17-83

TWO CRAWLS- 6-17-83

TWO CRAWLS- 6-17-83

CRAWL- 6-17-83

TWO CRAWLS- 6-17-83

6-17-83 - Flight by H.A. Townsend

• - 12 CRAWLS with NEST 6-17-83

○ - 2 FALSE CRAWLS


62783 - FIVE M. RM. [unclear]
[unclear]
[unclear]

NEST AND CRAWL ACTIVITY
ONSLow BEACH, MARINE CORPS BASE
CAMP LEJEUNE, NORTH CAROLINA

Nests - upper map

Crawls no nest - lower map

Dots indicates multiple usage

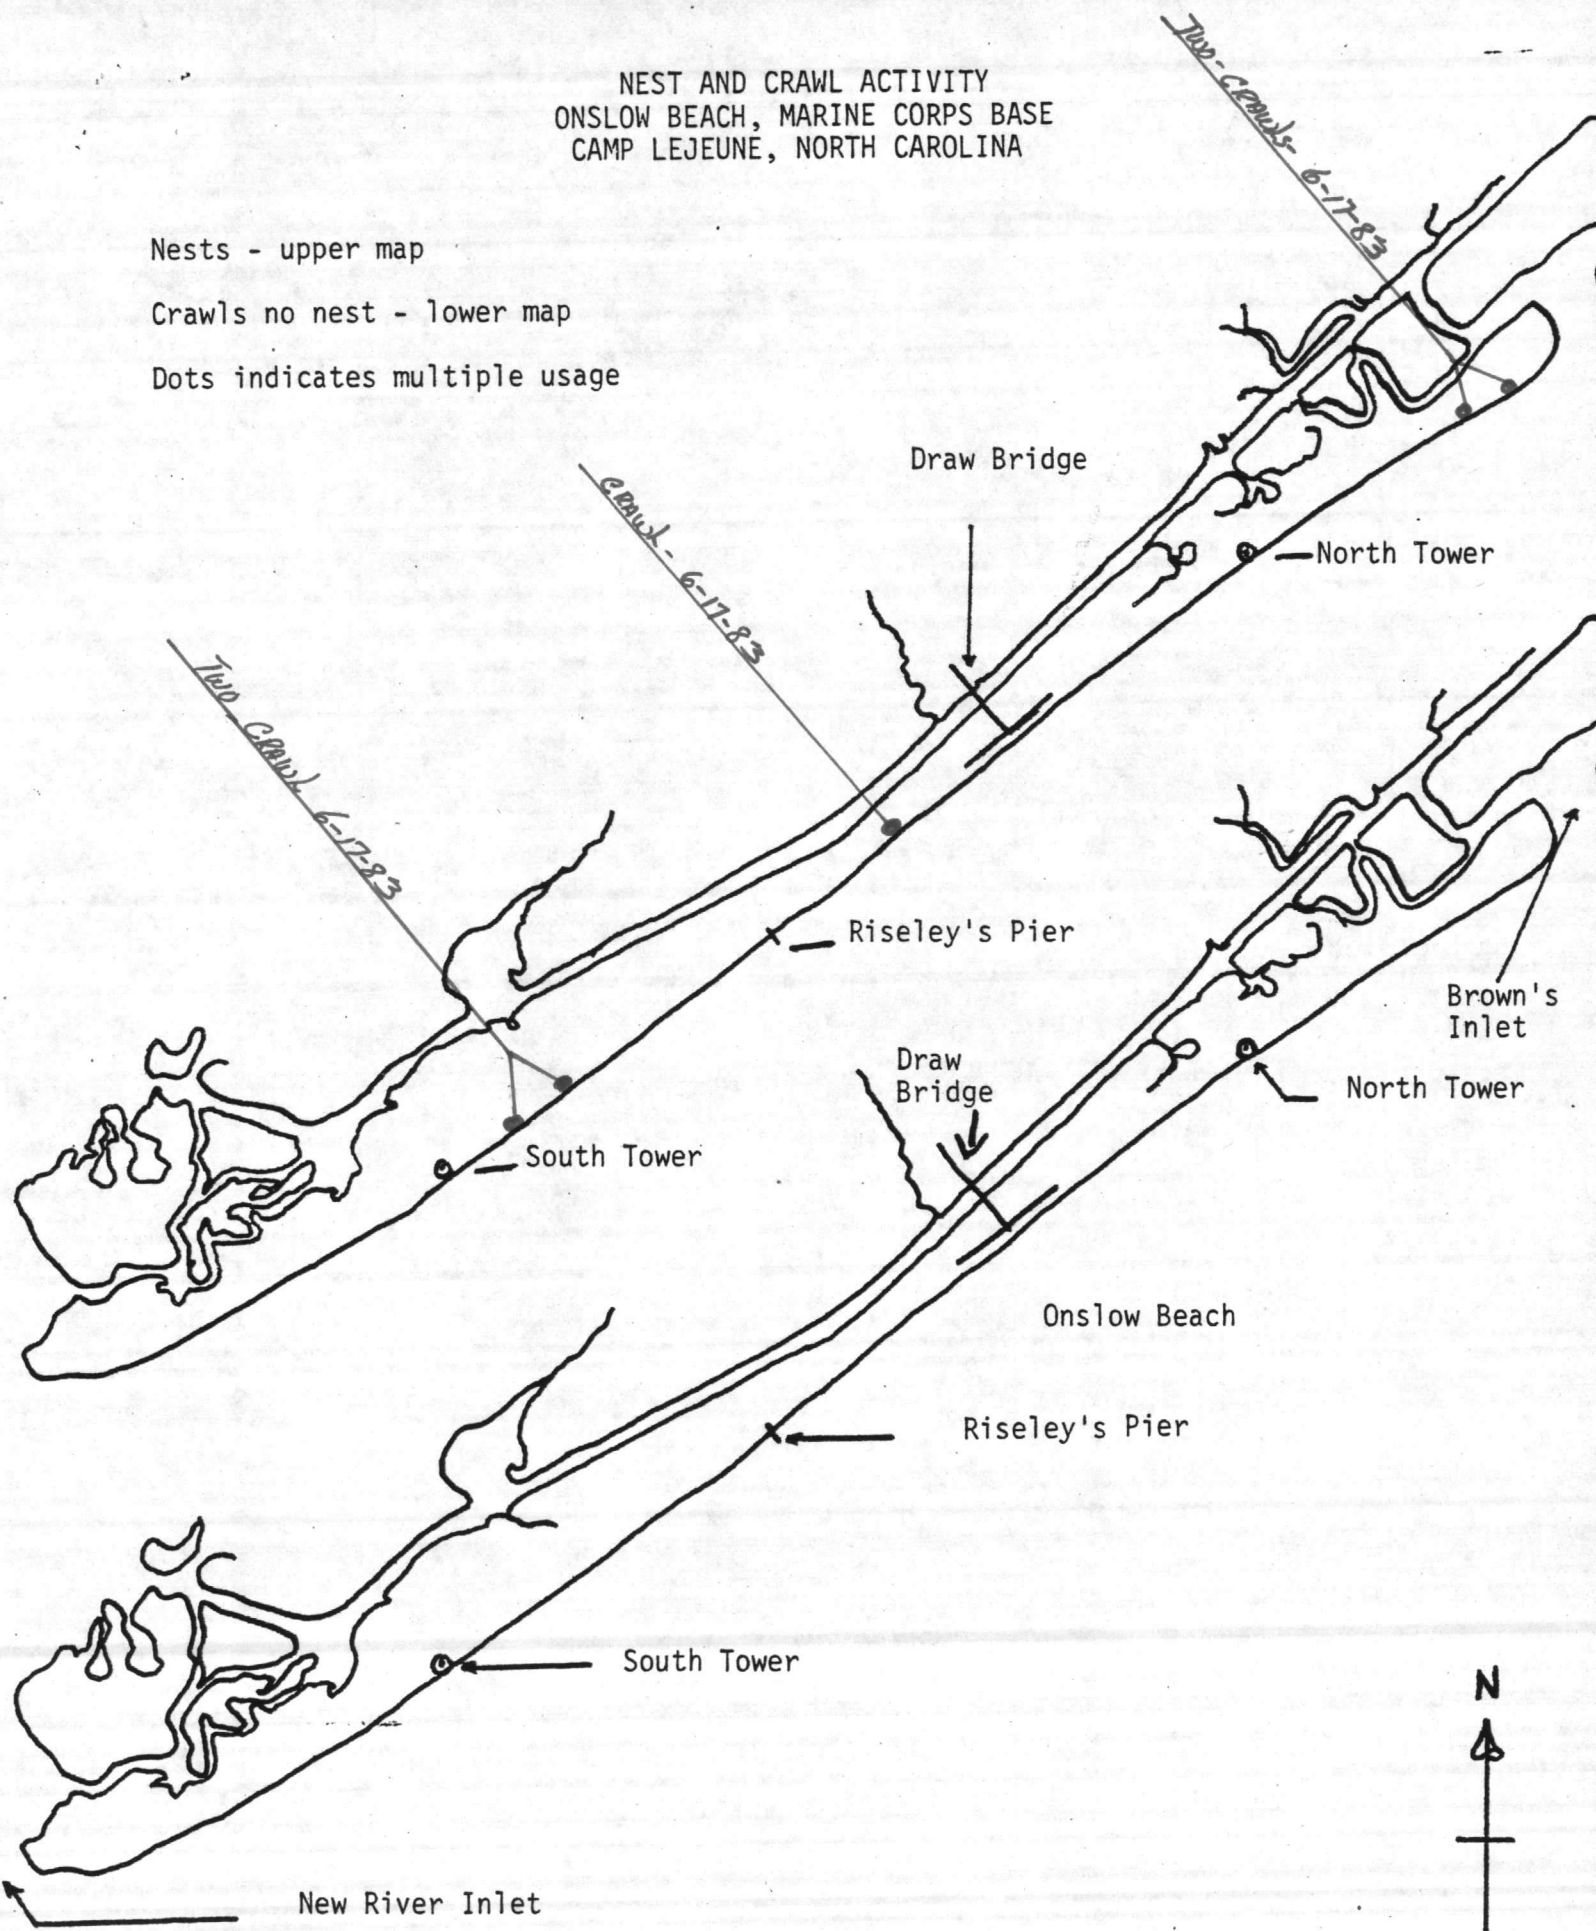

AERIAL SURVEY DATA

Date: June 22 83 Time: S 06:05 F 08:19

Recorder Name: Jerry R. Rich

Crew Names: None Pilot: J. R. Rich

Co-Pilot: None Crew Chief: None

Others: None

Weather: General 3 miles vis. Cloud Cover 1000 Set 2000 BKN

Wind Speed NW 8-12 K Sea Conditions Mod chop

BEACH AERIAL SURVEYS Altitude 100 Ft

Air Speed 60 K

Location	Crawls		Nests		Nest Predation	
	New	Old	New	Old	New	Old
Onslow Beach	0	0	1	5	0	0
Browns Island	2	0	2	7	7	0
Bear Beach	1	0	2	1	0	0

OCEAN AERIAL SURVEYS Altitude 300 Ft

Air Speed 60 K

	Live Turtles		Dead Turtles
	Juvenile	Adults	
Bell Buoy from Bogue Inlet to New River Inlet	None	None	None


Comments: Saw one large grey fox digging out eggs on Browns Island


NEST AND CRAWL ACTIVITY
 ONSLOW BEACH, MARINE CORPS BASE
 CAMP LEJEUNE, NORTH CAROLINA

Nests - upper map

Crawls no nest - lower map


Dots indicates multiple usage

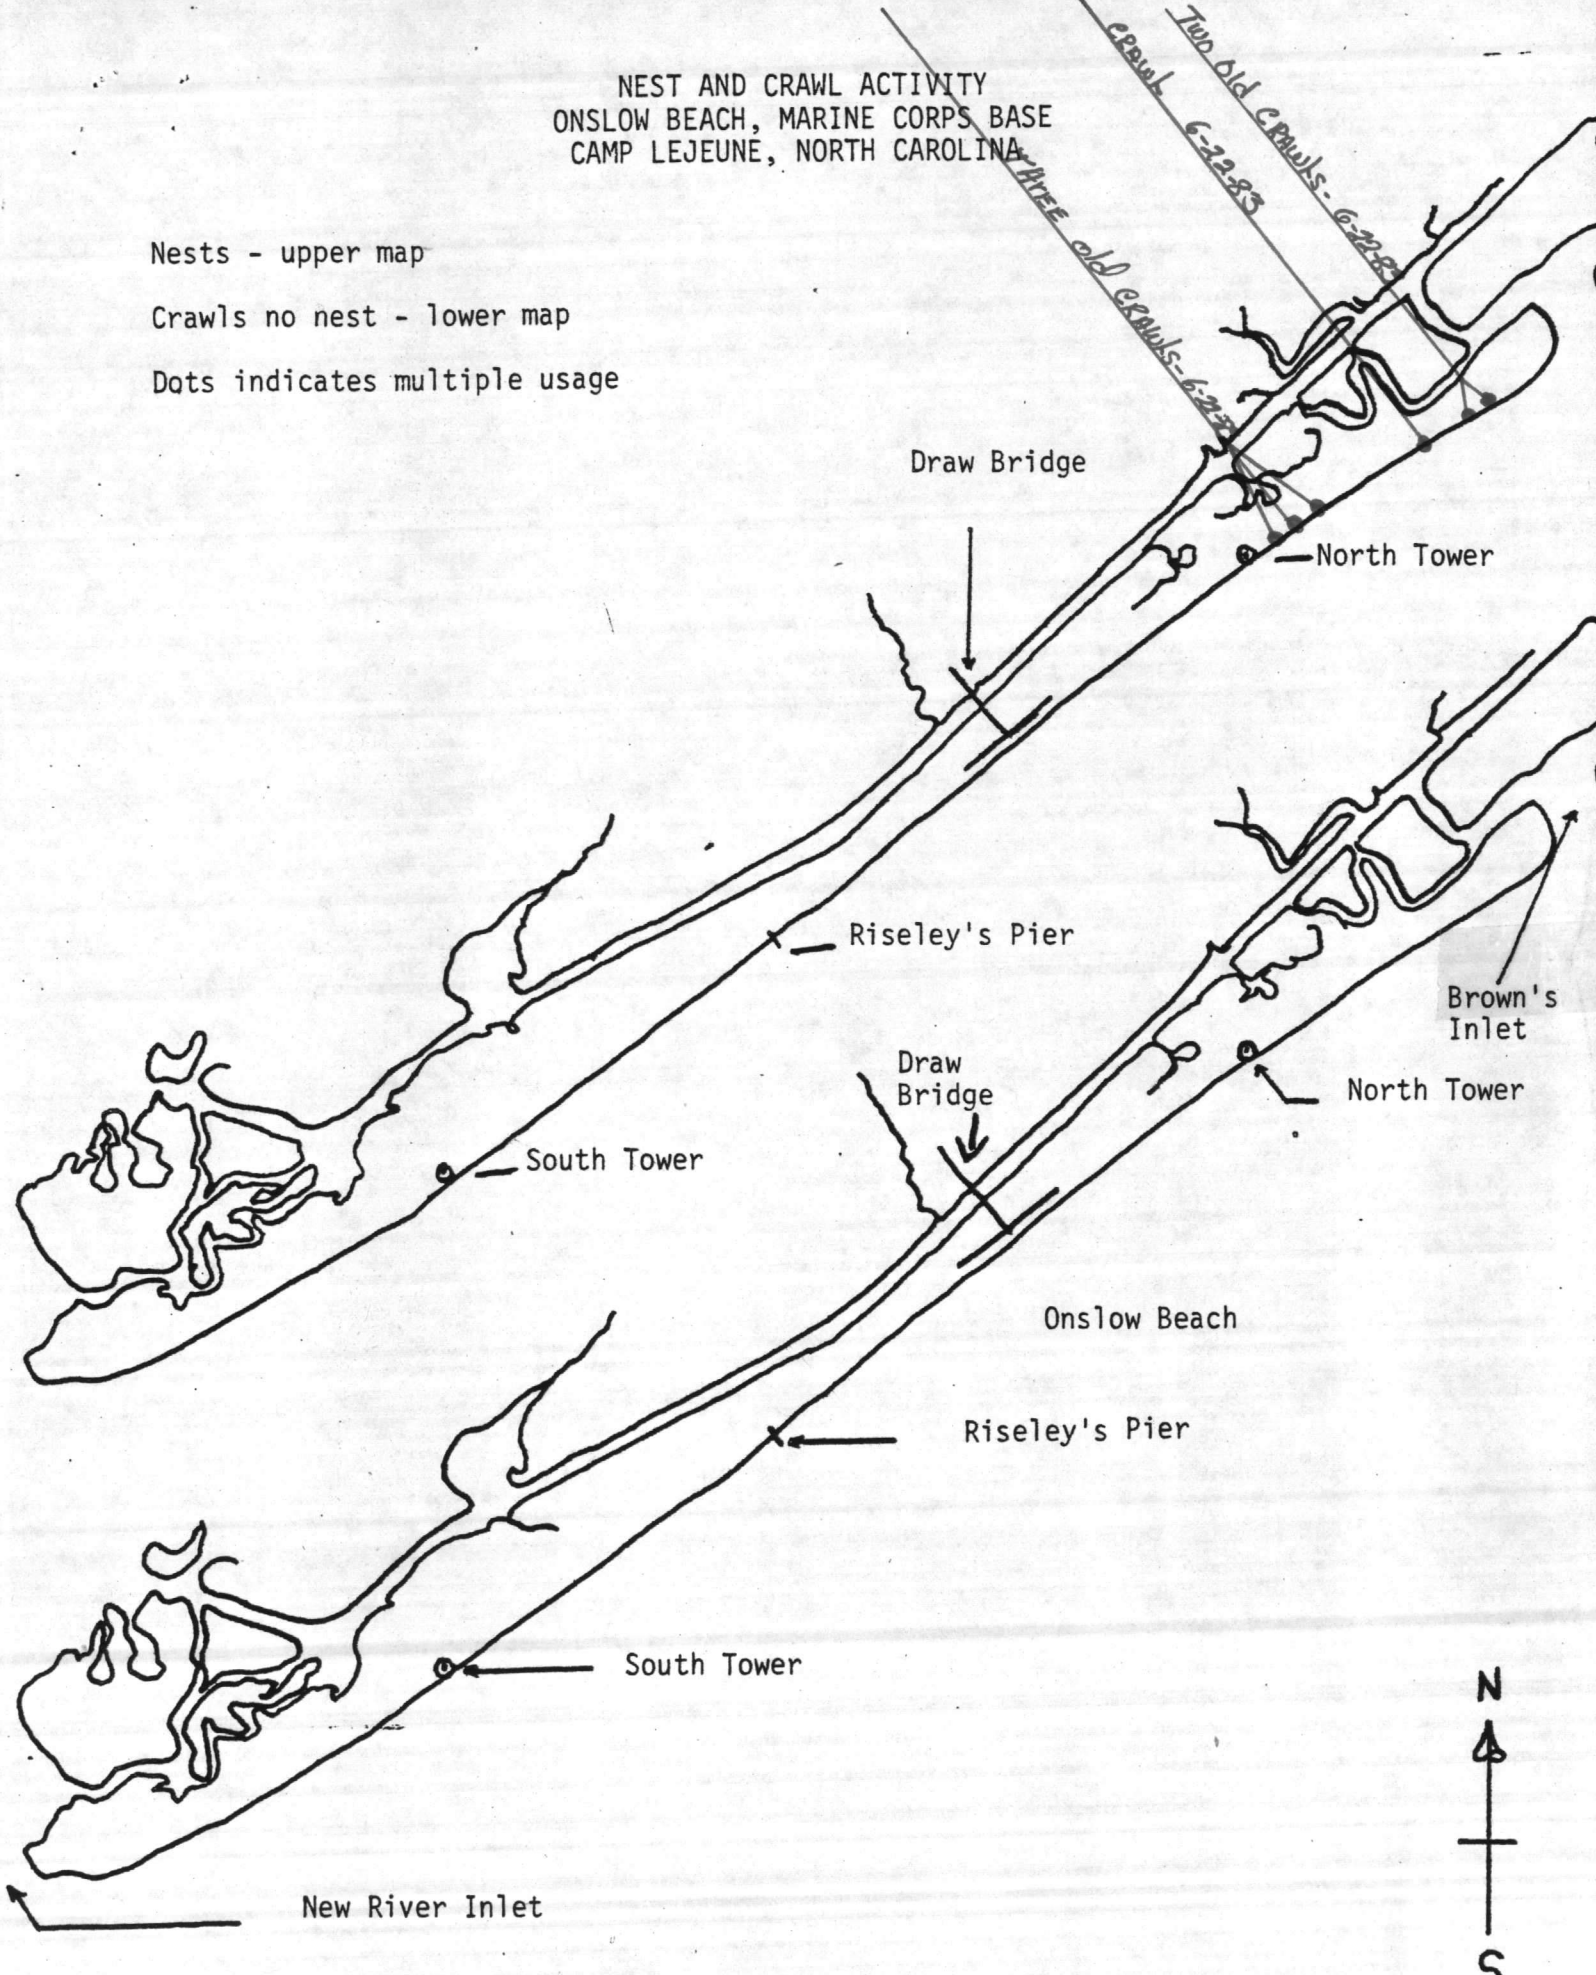

 

LEGEND

- PRIMITIVE OR UNIMPROVED ROAD
- GRADED AND DRAINED ROAD
- SOIL, GRAVEL OR STONE SURFACED ROAD
- HARD SURFACED ROAD
- 4 LANE UNDIVIDED HIGHWAY
- DIVIDED HIGHWAY
- HIGHWAY WITH FRONTAGE ROADS
- FULL CONTROL ACCESS
- FEDERAL AID INTERSTATE ROAD
- FEDERAL AID PRIMARY ROAD
- FEDERAL AID SECONDARY ROAD
- FEDERAL AID URBAN
- NON-SYSTEM ROAD
- PROJECTED LOCATION
- INTERSECTION DISTANCE
- TRAFFIC CIRCLE
- HIGHWAY INTERCHANGE
- DETAILED HIGHWAY INTERCHANGE
- INTERSTATE HIGHWAY
- U.S. NUMBERED HIGHWAY
- N.C. NUMBERED HIGHWAY
- SECONDARY ROAD NUMBERS
- UNDERGROUND CABLE
- RAILROAD, ANY NUMBER OF TRACKS USED BY SINGLE OPERATING COMPANY
- RAILROAD, ANY NUMBER OF TRACKS USED BY MORE THAN ONE OPERATING COMPANY ON SAME OR ADJACENT RIGHTS-OF-WAY
- RAILROAD STATION
- GRADE CROSSING
- UNDERPASS
- OVERPASS
- RAILROAD TUNNEL
- ARMY, NAVY OR MARINE CORPS FIELD
- COMM. OR MUNICIPAL AIRPORT
- MARKED AUXILIARY FIELD
- HANGAR ON FIELD "B" IN SYMBOL
- DOCK, PIER OR LANDING
- FREE OR TOLL FERRY
- LIGHT, NAUTICAL
- LIGHTHOUSE
- COAST GUARD STATION
- CANAL
- NARROW STREAM
- WIDE STREAM
- DAM WITH LOCK
- DAM
- RESERVOIR, POND OR LAKE
- PROMINENT PEAK, NUMERALS INDICATE ELEVATION
- ROAD THROUGH MOUNTAIN PASS
- HIGHWAY BRIDGE, OVER 20 FT.
- DRAW SPAN ON BRIDGE
- HIGHWAY TUNNEL
- FORD
- STATE LINE
- COUNTY LINE
- CITY LIMITS
- RESERVATION OR PARK BOUNDARY
- INSET AREA
- DELIMITED AREA, POPULATION EST.
- COUNTY SEAT
- OTHER TOWNS AND VILLAGES
- TRIANGULATION STATION
- INCORPORATED CITY OR VILLAGE, GENERALIZED
- SCHOOL
- CHURCH
- CHURCH WITH CEMETERY
- CEMETERY
- HOSPITAL
- CORRECTIONAL OR PENAL INSTN.
- HIGHWAY GARAGE, OR MAINT. YARD
- HIGHWAY DIV. OR DIST. OFFICE
- WEIGHT STATION
- PATROL STATION
- REST AREA
- MONUMENT—SMALL HISTORICAL SITE

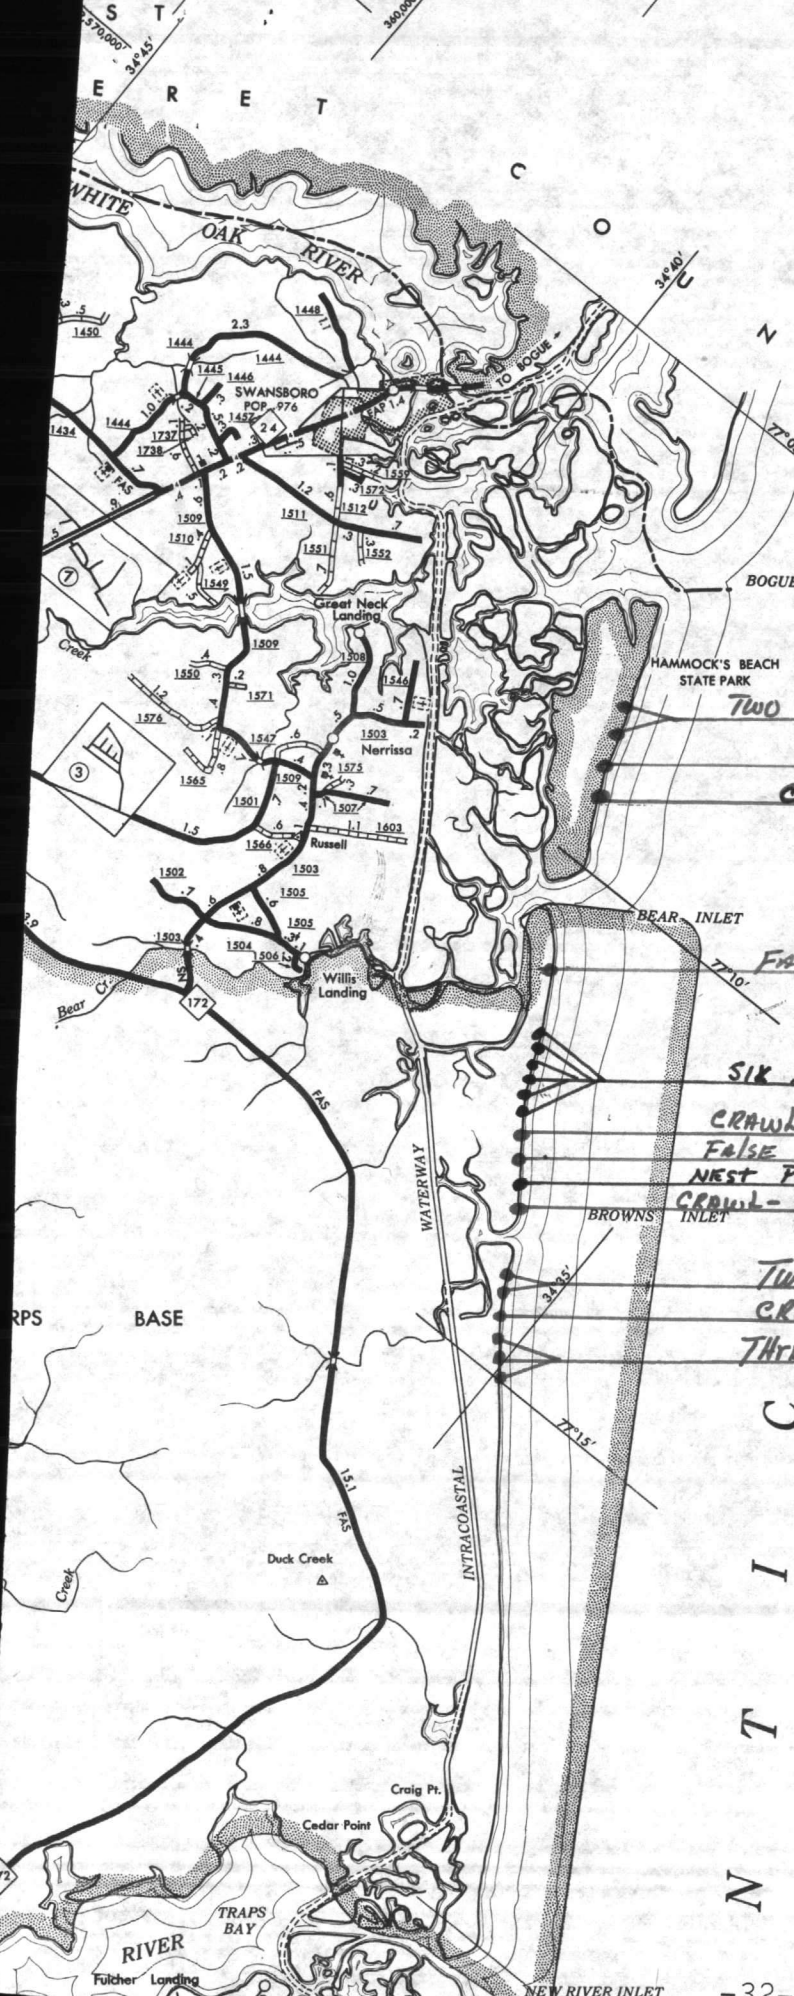

A

TWO CRAWLS 6-22-83

FALSE CRAWL 6-22-83

OLD CRAWL 6-22-83

B

FALSE CRAWL 6-22-83

C

SIX NEST Predation

CRAWL 6-22-83

FALSE CRAWL 6-22-83

NEST Predation 6-22-83

CRAWL- 6-22-83

D


TWO OLD CRAWLS 6-22-83

CRAWL 6-22-83

THREE OLD CRAWLS 6-22-83

6-22-83 J.R. Rich

11- CRAWLS with NEST
3- FALSE CRAWLS
7- NEST Predation - SAW LARGE GREY FOX
Digging ON ONE NEST

 

AERIAL SURVEY DATA

Date: June 24 83 Time: S 06:08 F 08:10

Recorder Name: Jerry R. Rich

Crew Names: None Pilot: J. R. Rich

Co-Pilot: None Crew Chief: None

Others: None

Weather: General X 1/2 to 1/4 vis fog Cloud Cover X 200 ft ovc

Wind Speed NE less than 5 K Sea Conditions Calm

BEACH AERIAL SURVEYS Altitude 100 Ft
Air Speed 60 K

Location	Crawls		Nests		Nest Predation	
	New	Old	New	Old	New	Old
Onslow Beach	0	0	0	0	0	0
Browns Island	0	0	1	0	0	0
Bear Beach	0	0	0	0	0	0

OCEAN AERIAL SURVEYS Altitude 200 Ft
Air Speed 60 K

	Live Turtles		Dead Turtles
	Juvenile	Adults	
Bell Buoy from Bogue Inlet to New River Inlet	0	1	0

Comments:





































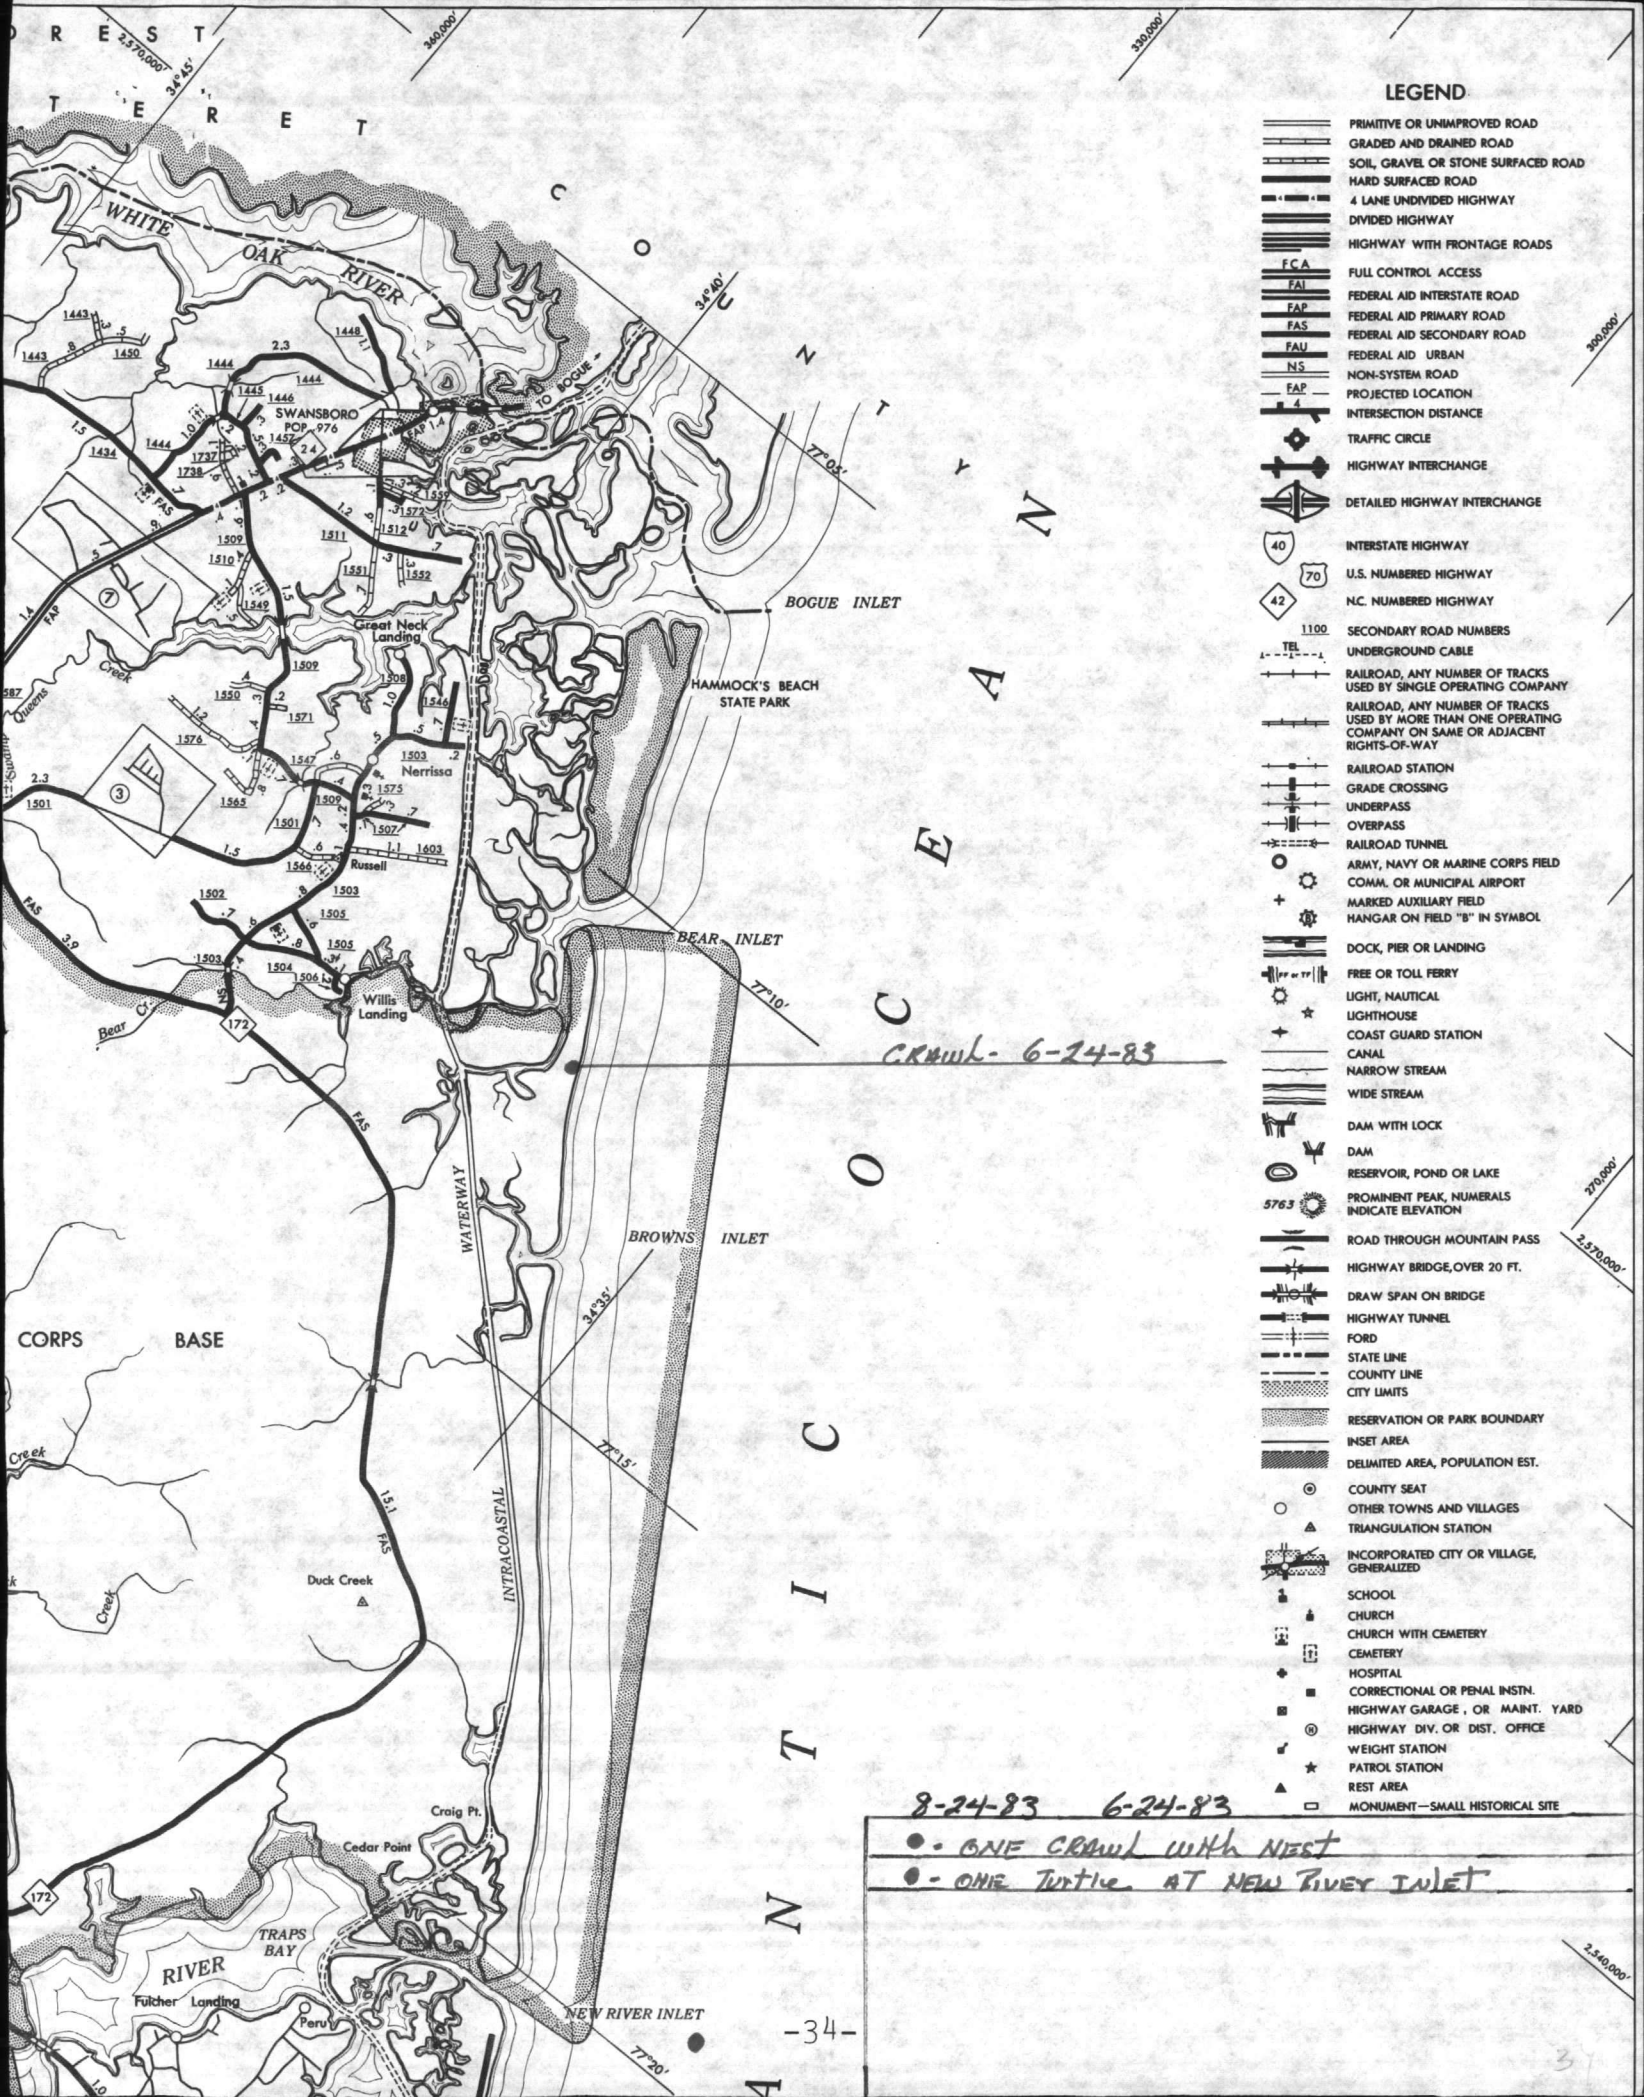


LEGEND

- PRIMITIVE OR UNIMPROVED ROAD
- GRADED AND DRAINED ROAD
- SOIL, GRAVEL OR STONE SURFACED ROAD
- HARD SURFACED ROAD
- 4 LANE UNDIVIDED HIGHWAY
- DIVIDED HIGHWAY
- HIGHWAY WITH FRONTAGE ROADS
- FCA FULL CONTROL ACCESS
- FAI FEDERAL AID INTERSTATE ROAD
- FAP FEDERAL AID PRIMARY ROAD
- FAS FEDERAL AID SECONDARY ROAD
- FAU FEDERAL AID URBAN
- NS NON-SYSTEM ROAD
- P.P. PROJECTED LOCATION
- I.D. INTERSECTION DISTANCE
- T.C. TRAFFIC CIRCLE
- H.I. HIGHWAY INTERCHANGE
- D.H.I. DETAILED HIGHWAY INTERCHANGE
- I.H. INTERSTATE HIGHWAY
- U.S. U.S. NUMBERED HIGHWAY
- N.C. N.C. NUMBERED HIGHWAY
- S.R.N. SECONDARY ROAD NUMBERS
- U.C. UNDERGROUND CABLE
- R.S. RAILROAD, ANY NUMBER OF TRACKS USED BY SINGLE OPERATING COMPANY
- R.M. RAILROAD, ANY NUMBER OF TRACKS USED BY MORE THAN ONE OPERATING COMPANY ON SAME OR ADJACENT RIGHTS-OF-WAY
- R.St. RAILROAD STATION
- G.C. GRADE CROSSING
- U.P. UNDERPASS
- O.P. OVERPASS
- R.T. RAILROAD TUNNEL
- A.N.M.C. ARMY, NAVY OR MARINE CORPS FIELD COMM. OR MUNICIPAL AIRPORT
- M.A.F. MARKED AUXILIARY FIELD HANGAR ON FIELD "B" IN SYMBOL
- D.P.L. DOCK, PIER OR LANDING
- F.T. FREE OR TOLL FERRY
- L.N. LIGHT, NAUTICAL
- L. LIGHTHOUSE
- C.G.S. COAST GUARD STATION
- C. CANAL
- N.S. NARROW STREAM
- W.S. WIDE STREAM
- D.W.L. DAM WITH LOCK
- D. DAM
- R.P.L. RESERVOIR, POND OR LAKE
- P.P. PROMINENT PEAK, NUMERALS INDICATE ELEVATION
- R.T.M.P. ROAD THROUGH MOUNTAIN PASS
- H.B. HIGHWAY BRIDGE, OVER 20 FT.
- D.S. DRAW SPAN ON BRIDGE
- H.T. HIGHWAY TUNNEL
- F. FORD
- S.L. STATE LINE
- C.L. COUNTY LINE
- C.L. CITY LIMITS
- R.P.B. RESERVATION OR PARK BOUNDARY
- I.A. INSET AREA
- D.A. DELIMITED AREA, POPULATION EST.
- C.S. COUNTY SEAT
- O.T.V. OTHER TOWNS AND VILLAGES
- T.S. TRIANGULATION STATION
- I.C.V. INCORPORATED CITY OR VILLAGE, GENERALIZED
- S. SCHOOL
- Ch. CHURCH
- Ch.C. CHURCH WITH CEMETERY
- C. CEMETERY
- H. HOSPITAL
- C.P.I. CORRECTIONAL OR PENAL INSTN.
- H.G. HIGHWAY GARAGE, OR MAINT. YARD
- H.D. HIGHWAY DIV. OR DIST. OFFICE
- W.S. WEIGHT STATION
- P.S. PATROL STATION
- R.A. REST AREA
- M. MONUMENT - SMALL HISTORICAL SITE

CRAWL- 6-24-83

8-24-83	6-24-83
• - ONE CRAWL WITH NEST	
• - ONE TURTLE AT NEW RIVER INLET	

 

AERIAL SURVEY DATA

Date: June 29 83 Time: S 05:38 F 07:38

Recorder Name: Jerry R. Rich

Crew Names: None Pilot: Jerry R. Rich

Co-Pilot: None Crew Chief: None

Others: None

Weather: General 5 miles haze Cloud Cover 5000 Bkn

Wind Speed SW 12-15 K Sea Conditions White Caps

BEACH AERIAL SURVEYS Altitude 100 Ft
Air Speed 60 K

Location	Crawls		Nests		Nest Predation	
	New	Old	New	Old	New	Old
Onslow Beach	0	0	1	0	0	0
Browns Island	0	0	1	0	1	0
Bear Beach	1	0	1	0	0	0

OCEAN AERIAL SURVEYS Altitude 400 Ft
Air Speed 60 K

	Live Turtles		Dead Turtles
	Juvenile	Adults	
Bell Buoy from Bogue Inlet to New River Inlet	None	None	None

Comments:

1942

1943

NEST AND CRAWL ACTIVITY
ONSLow BEACH, MARINE CORPS BASE
CAMP LEJEUNE, NORTH CAROLINA

Nests - upper map

Crawls no nest - lower map

Dots indicates multiple usage

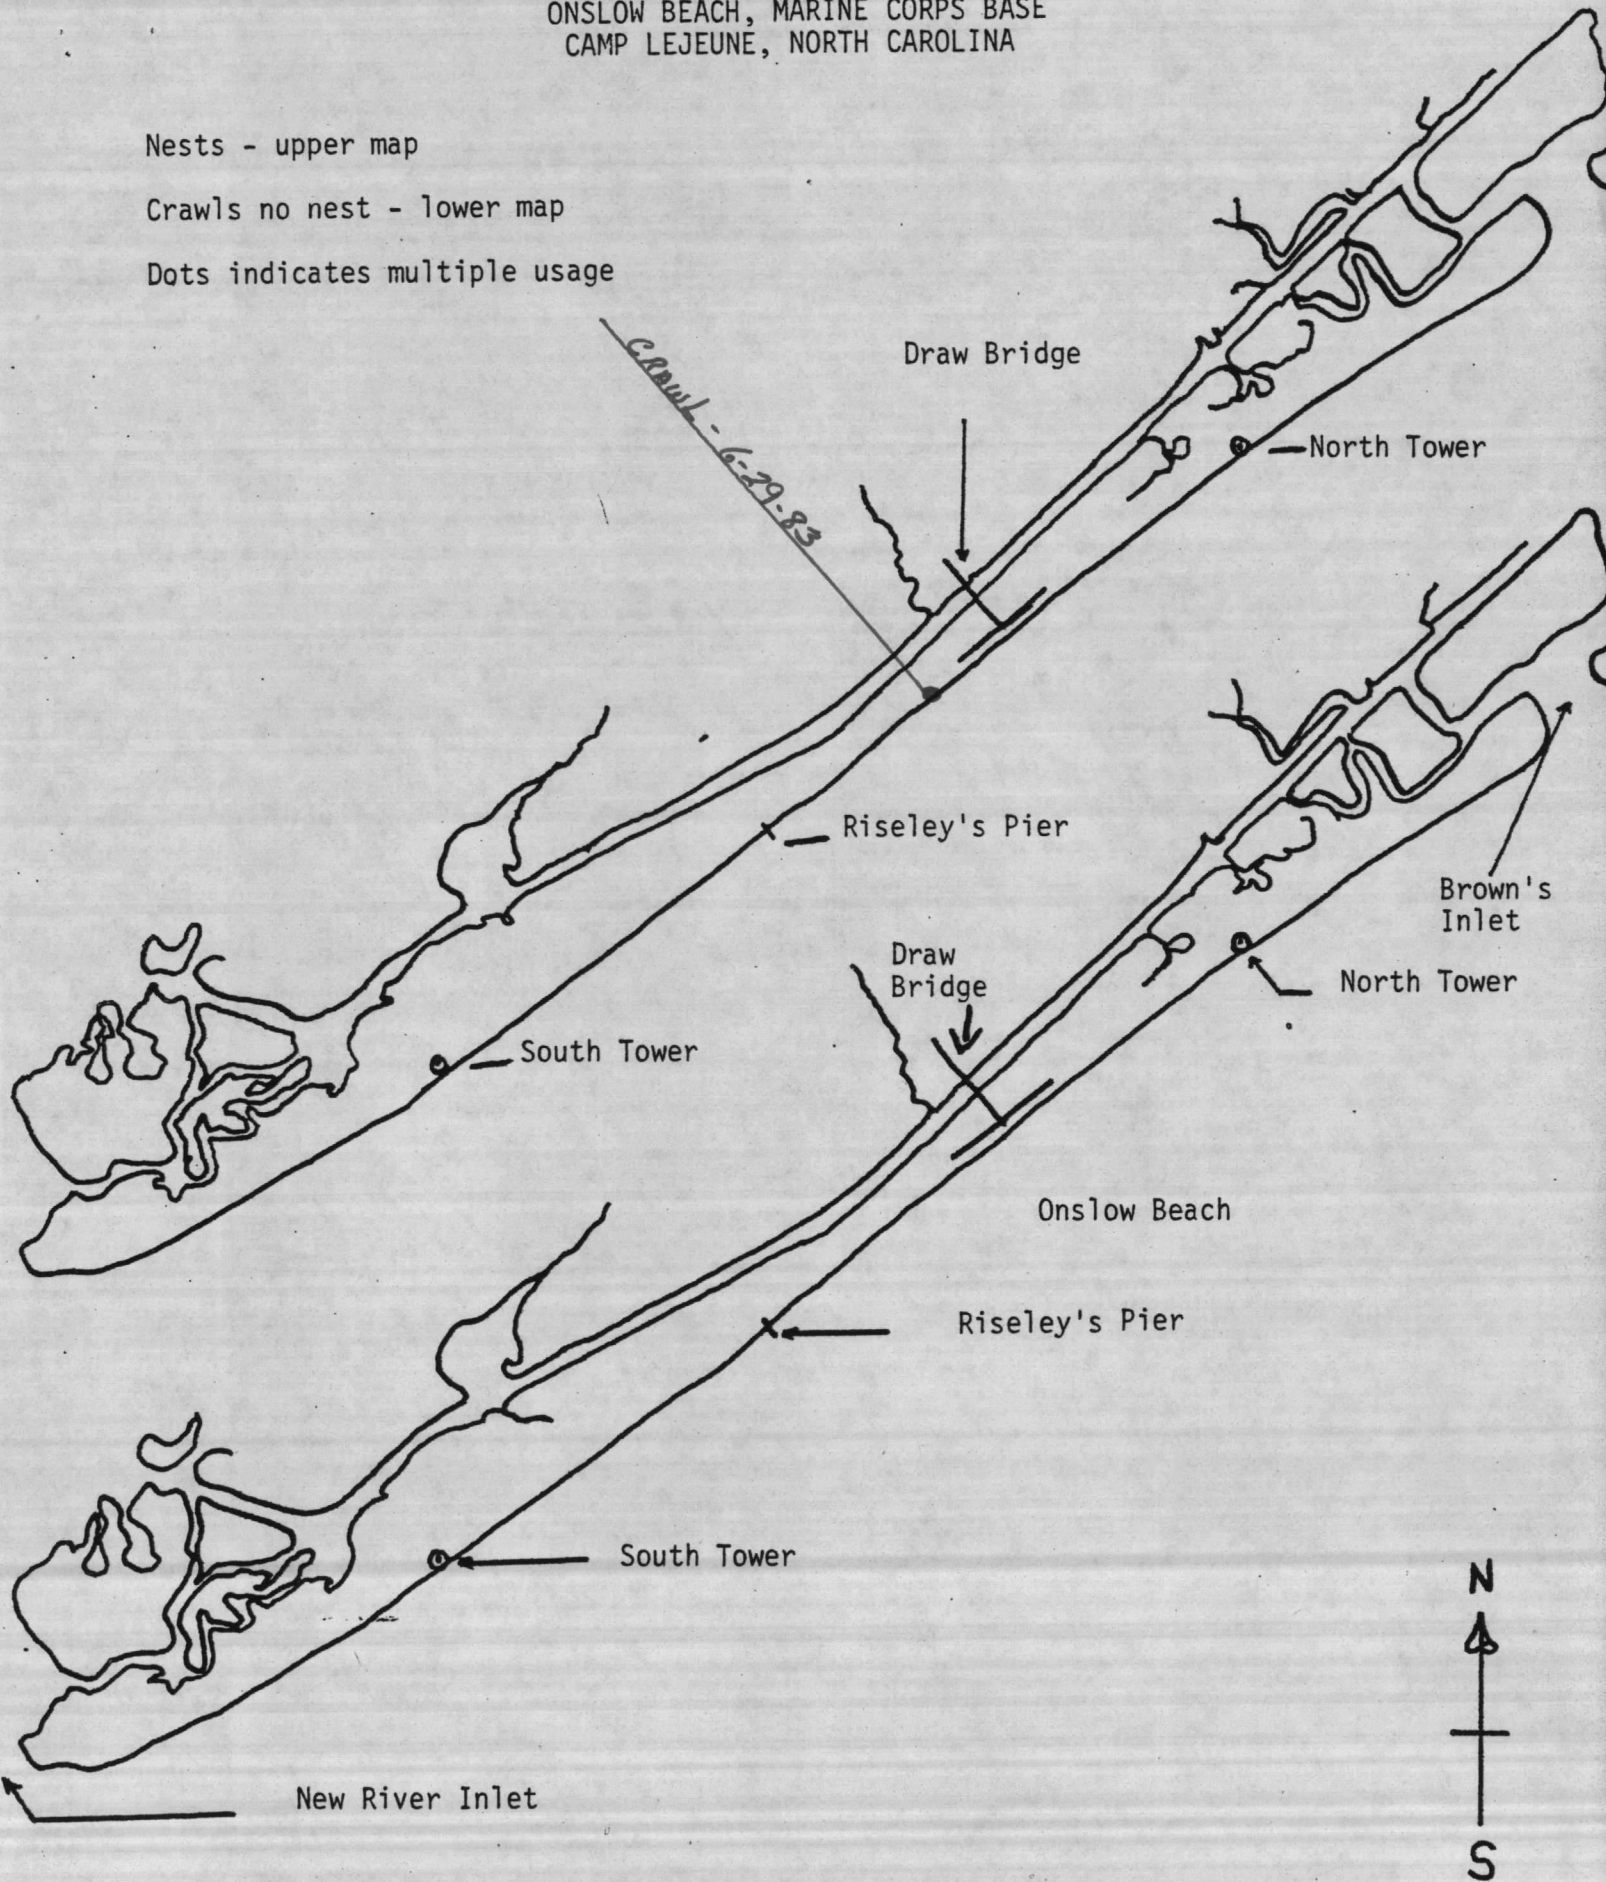

 

LEGEND

- PRIMITIVE OR UNIMPROVED ROAD
- GRADED AND DRAINED ROAD
- SOIL, GRAVEL OR STONE SURFACED ROAD
- HARD SURFACED ROAD
- 4 LANE UNDIVIDED HIGHWAY
- DIVIDED HIGHWAY
- HIGHWAY WITH FRONTAGE ROADS
- FCA FULL CONTROL ACCESS
- FAI FEDERAL AID INTERSTATE ROAD
- FAP FEDERAL AID PRIMARY ROAD
- FAS FEDERAL AID SECONDARY ROAD
- FAU FEDERAL AID URBAN
- NS NON-SYSTEM ROAD
- FAP 4 PROJECTED LOCATION
- INTERSECTION DISTANCE
- TRAFFIC CIRCLE
- HIGHWAY INTERCHANGE
- DETAILED HIGHWAY INTERCHANGE
- INTERSTATE HIGHWAY
- U.S. NUMBERED HIGHWAY
- N.C. NUMBERED HIGHWAY
- SECONDARY ROAD NUMBERS
- UNDERGROUND CABLE
- RAILROAD, ANY NUMBER OF TRACKS USED BY SINGLE OPERATING COMPANY
- RAILROAD, ANY NUMBER OF TRACKS USED BY MORE THAN ONE OPERATING COMPANY ON SAME OR ADJACENT RIGHTS-OF-WAY
- RAILROAD STATION
- GRADE CROSSING
- UNDERPASS
- OVERPASS
- RAILROAD TUNNEL
- ARMY, NAVY OR MARINE CORPS FIELD
- COMM. OR MUNICIPAL AIRPORT
- MARKED AUXILIARY FIELD
- HANGAR ON FIELD "B" IN SYMBOL
- DOCK, PIER OR LANDING
- FREE OR TOLL FERRY
- LIGHT, NAUTICAL
- LIGHTHOUSE
- COAST GUARD STATION
- CANAL
- NARROW STREAM
- WIDE STREAM
- DAM WITH LOCK
- DAM
- RESERVOIR, POND OR LAKE
- PROMINENT PEAK, NUMERALS INDICATE ELEVATION
- ROAD THROUGH MOUNTAIN PASS
- HIGHWAY BRIDGE, OVER 20 FT.
- DRAW SPAN ON BRIDGE
- HIGHWAY TUNNEL
- FORD
- STATE LINE
- COUNTY LINE
- CITY LIMITS
- RESERVATION OR PARK BOUNDARY
- INSET AREA
- DELIMITED AREA, POPULATION EST.
- COUNTY SEAT
- OTHER TOWNS AND VILLAGES
- TRIANGULATION STATION
- INCORPORATED CITY OR VILLAGE, GENERALIZED
- SCHOOL
- CHURCH
- CHURCH WITH CEMETERY
- CEMETERY
- HOSPITAL
- CORRECTIONAL OR PENAL INSTN.
- HIGHWAY GARAGE, OR MAINT. YARD
- HIGHWAY DIV. OR DIST. OFFICE
- WEIGHT STATION
- PATROL STATION
- REST AREA
- MONUMENT—SMALL HISTORICAL SITE



6-29-83 J.R. Rich

●	- TWO CRAWLS WITH NEST
○	- ONE FALSE CRAWL
●	- ONE CRAWL WITH NEST PREDATION



AERIAL SURVEY DATA

Date: July 5 83 Time: S 06:03 F 08:10

Recorder Name: Jerry R. Rich

Crew Names: None Pilot: J. R. Rich

Co-Pilot: None Crew Chief: None

Others: None

Weather: General 6 miles fog & Haze Cloud Cover 2000 SCT

Wind Speed W-7K Sea Conditions Light chop

BEACH AERIAL SURVEYS Altitude 100 Ft

Air Speed 60 K

Location	Crawls		Nests		Nest Predation	
	New	Old	New	Old	New	Old
Onslow Beach	2	1	2	1	0	0
Browns Island	2	0	1	0	0	0
Bear Beach	0	0	2	2	2	0

OCEAN AERIAL SURVEYS Altitude 400 Ft

Air Speed 60 K

	Live Turtles		Dead Turtles
	Juvenile	Adults	
Bell Buoy from Bogue Inlet to New River Inlet	None	None	None

Comments:

08:10



















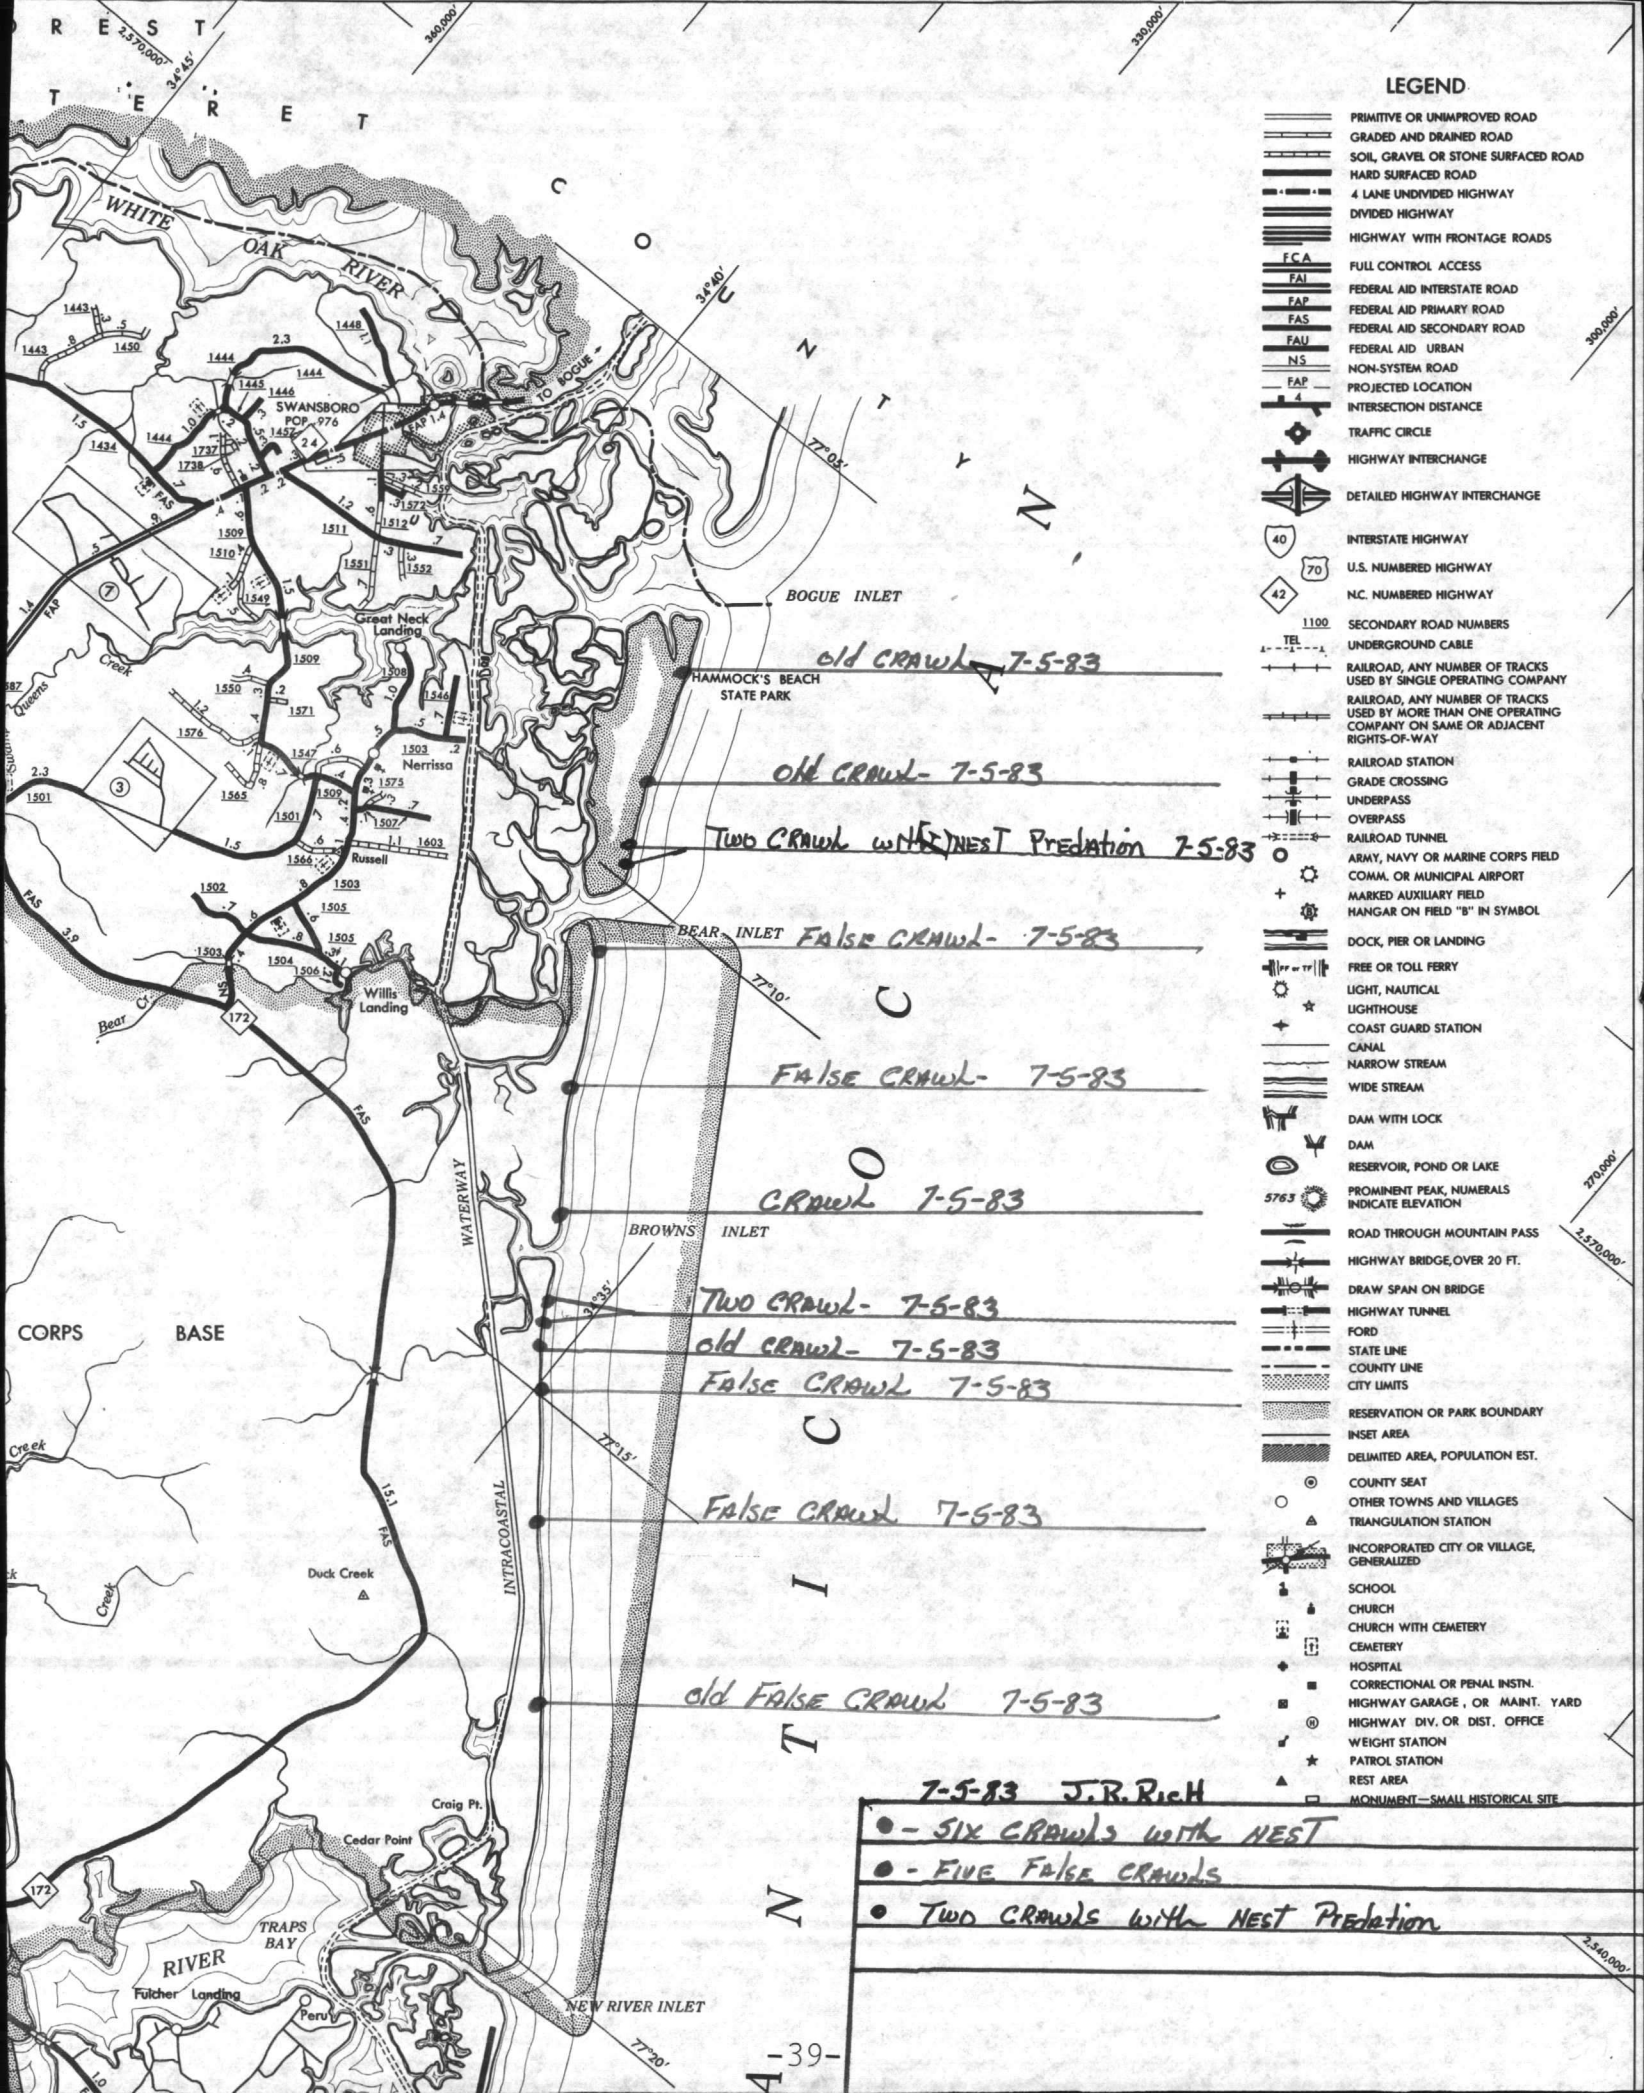


LEGEND

- PRIMITIVE OR UNIMPROVED ROAD
- GRADED AND DRAINED ROAD
- SOIL, GRAVEL OR STONE SURFACED ROAD
- HARD SURFACED ROAD
- 4 LANE UNDIVIDED HIGHWAY
- DIVIDED HIGHWAY
- HIGHWAY WITH FRONTAGE ROADS
- FCA FULL CONTROL ACCESS
- FAI FEDERAL AID INTERSTATE ROAD
- FAP FEDERAL AID PRIMARY ROAD
- FAS FEDERAL AID SECONDARY ROAD
- FAU FEDERAL AID URBAN
- NS NON-SYSTEM ROAD
- FAP PROJECTED LOCATION
- FAP INTERSECTION DISTANCE
- TRAFFIC CIRCLE
- HIGHWAY INTERCHANGE
- DETAILED HIGHWAY INTERCHANGE
- 40 INTERSTATE HIGHWAY
- 70 U.S. NUMBERED HIGHWAY
- 42 N.C. NUMBERED HIGHWAY
- 1100 SECONDARY ROAD NUMBERS
- UNDERGROUND CABLE
- RAILROAD, ANY NUMBER OF TRACKS USED BY SINGLE OPERATING COMPANY
- RAILROAD, ANY NUMBER OF TRACKS USED BY MORE THAN ONE OPERATING COMPANY ON SAME OR ADJACENT RIGHTS-OF-WAY
- RAILROAD STATION
- GRADE CROSSING
- UNDERPASS
- OVERPASS
- RAILROAD TUNNEL
- ARMY, NAVY OR MARINE CORPS FIELD COMM. OR MUNICIPAL AIRPORT
- MARKED AUXILIARY FIELD HANGAR ON FIELD "B" IN SYMBOL
- DOCK, PIER OR LANDING
- FREE OR TOLL FERRY
- LIGHT, NAUTICAL
- LIGHTHOUSE
- COAST GUARD STATION
- CANAL
- NARROW STREAM
- WIDE STREAM
- DAM WITH LOCK
- DAM
- RESERVOIR, POND OR LAKE
- 5763 PROMINENT PEAK, NUMERALS INDICATE ELEVATION
- ROAD THROUGH MOUNTAIN PASS
- HIGHWAY BRIDGE, OVER 20 FT.
- DRAW SPAN ON BRIDGE
- HIGHWAY TUNNEL
- FORD
- STATE LINE
- COUNTY LINE
- CITY LIMITS
- RESERVATION OR PARK BOUNDARY
- INSET AREA
- DELIMITED AREA, POPULATION EST.
- COUNTY SEAT
- OTHER TOWNS AND VILLAGES
- TRIANGULATION STATION
- INCORPORATED CITY OR VILLAGE, GENERALIZED
- SCHOOL
- CHURCH
- CHURCH WITH CEMETERY
- CEMETERY
- HOSPITAL
- CORRECTIONAL OR PENAL INSTN.
- HIGHWAY GARAGE, OR MAINT. YARD
- HIGHWAY DIV. OR DIST. OFFICE
- WEIGHT STATION
- PATROL STATION
- REST AREA
- MONUMENT - SMALL HISTORICAL SITE

7-5-83 J.R. Rich

● - SIX CRAWLS WITH NEST
● - FIVE FALSE CRAWLS
● TWO CRAWLS WITH NEST PREDATION

 



NEST AND CRAWL ACTIVITY
 ONSLOW BEACH, MARINE CORPS BASE
 CAMP LEJEUNE, NORTH CAROLINA

Nests - upper map

Crawls no nest - lower map

Dots indicates multiple usage

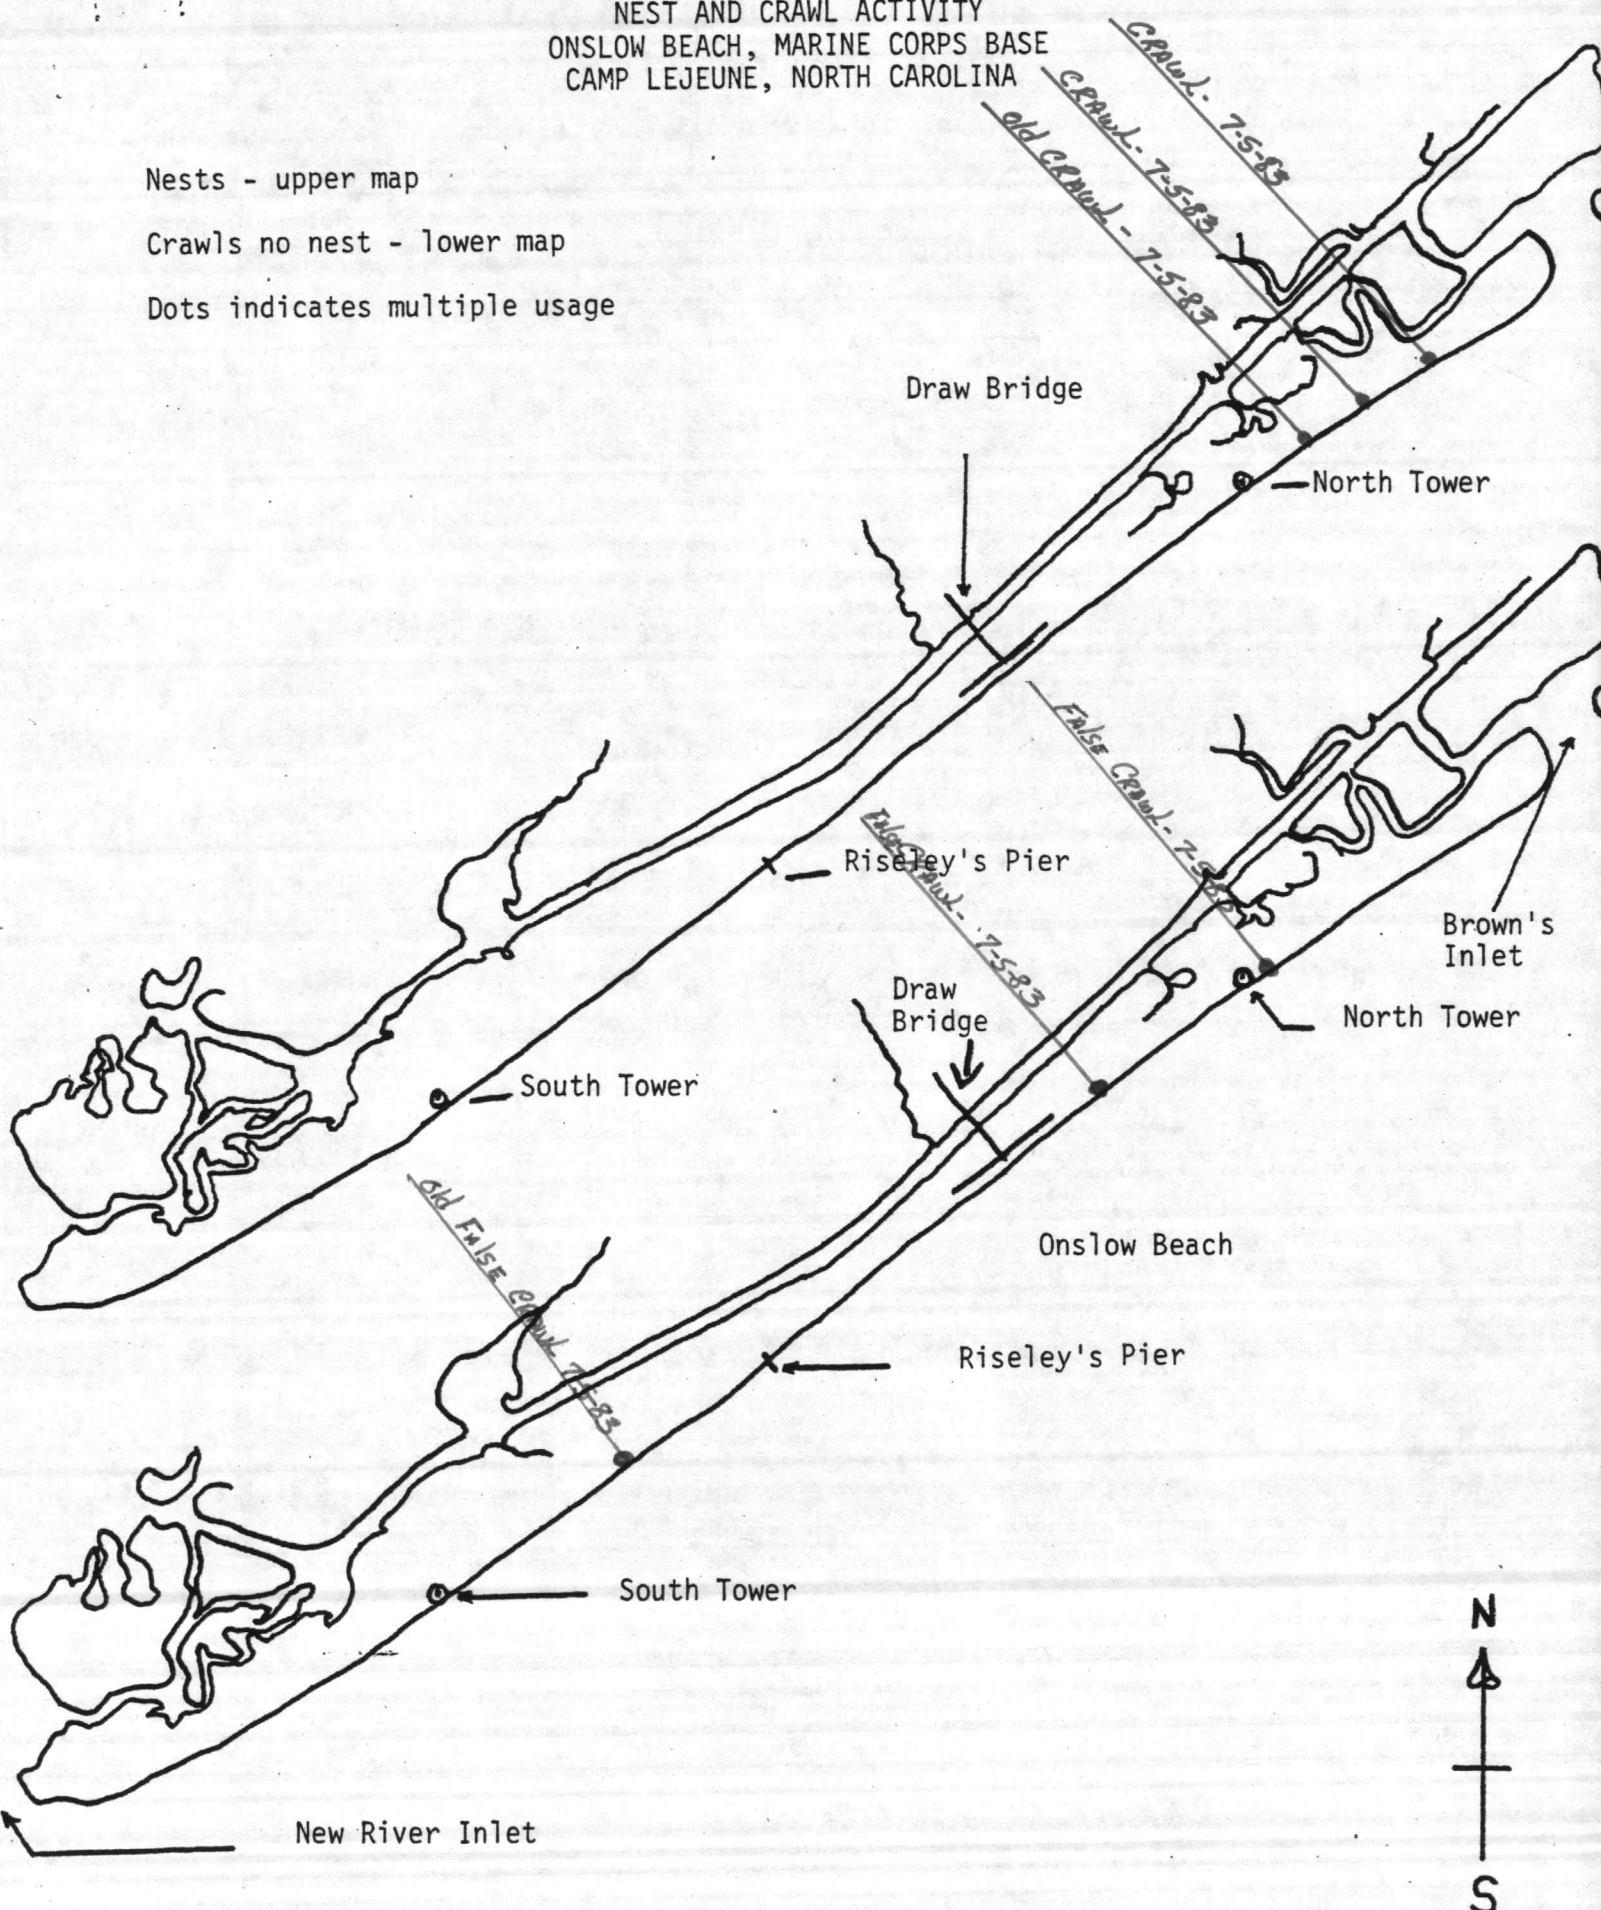

 

AERIAL SURVEY DATA

Date: July 7 1983 Time: S 06:18 F 08:20

Recorder Name: Jerry R. Rich

Crew Names: None Pilot: J. R. Rich

Co-Pilot: None Crew Chief: None

Others: None

Weather: General 2000 SCT 5 miles haze Cloud Cover 2000 SCT

Wind Speed NE 16-22 K Sea Conditions White caps

BEACH AERIAL SURVEYS Altitude 100 FT
Air Speed 60 K

Location	Crawls		Nests		Nest Predation	
	New	Old	New	Old	New	Old
Onslow Beach	0	0	0	0	0	0
Browns Island	2	0	1	0	0	0
Bear Beach	1	0	2	0	0	0

OCEAN AERIAL SURVEYS Altitude 400 FT
Air Speed 60 K

	Live Turtles		Dead Turtles
	Juvenile	Adults	
Bell Buoy from Bogue Inlet to New River Inlet	None	None	None

Comments:






















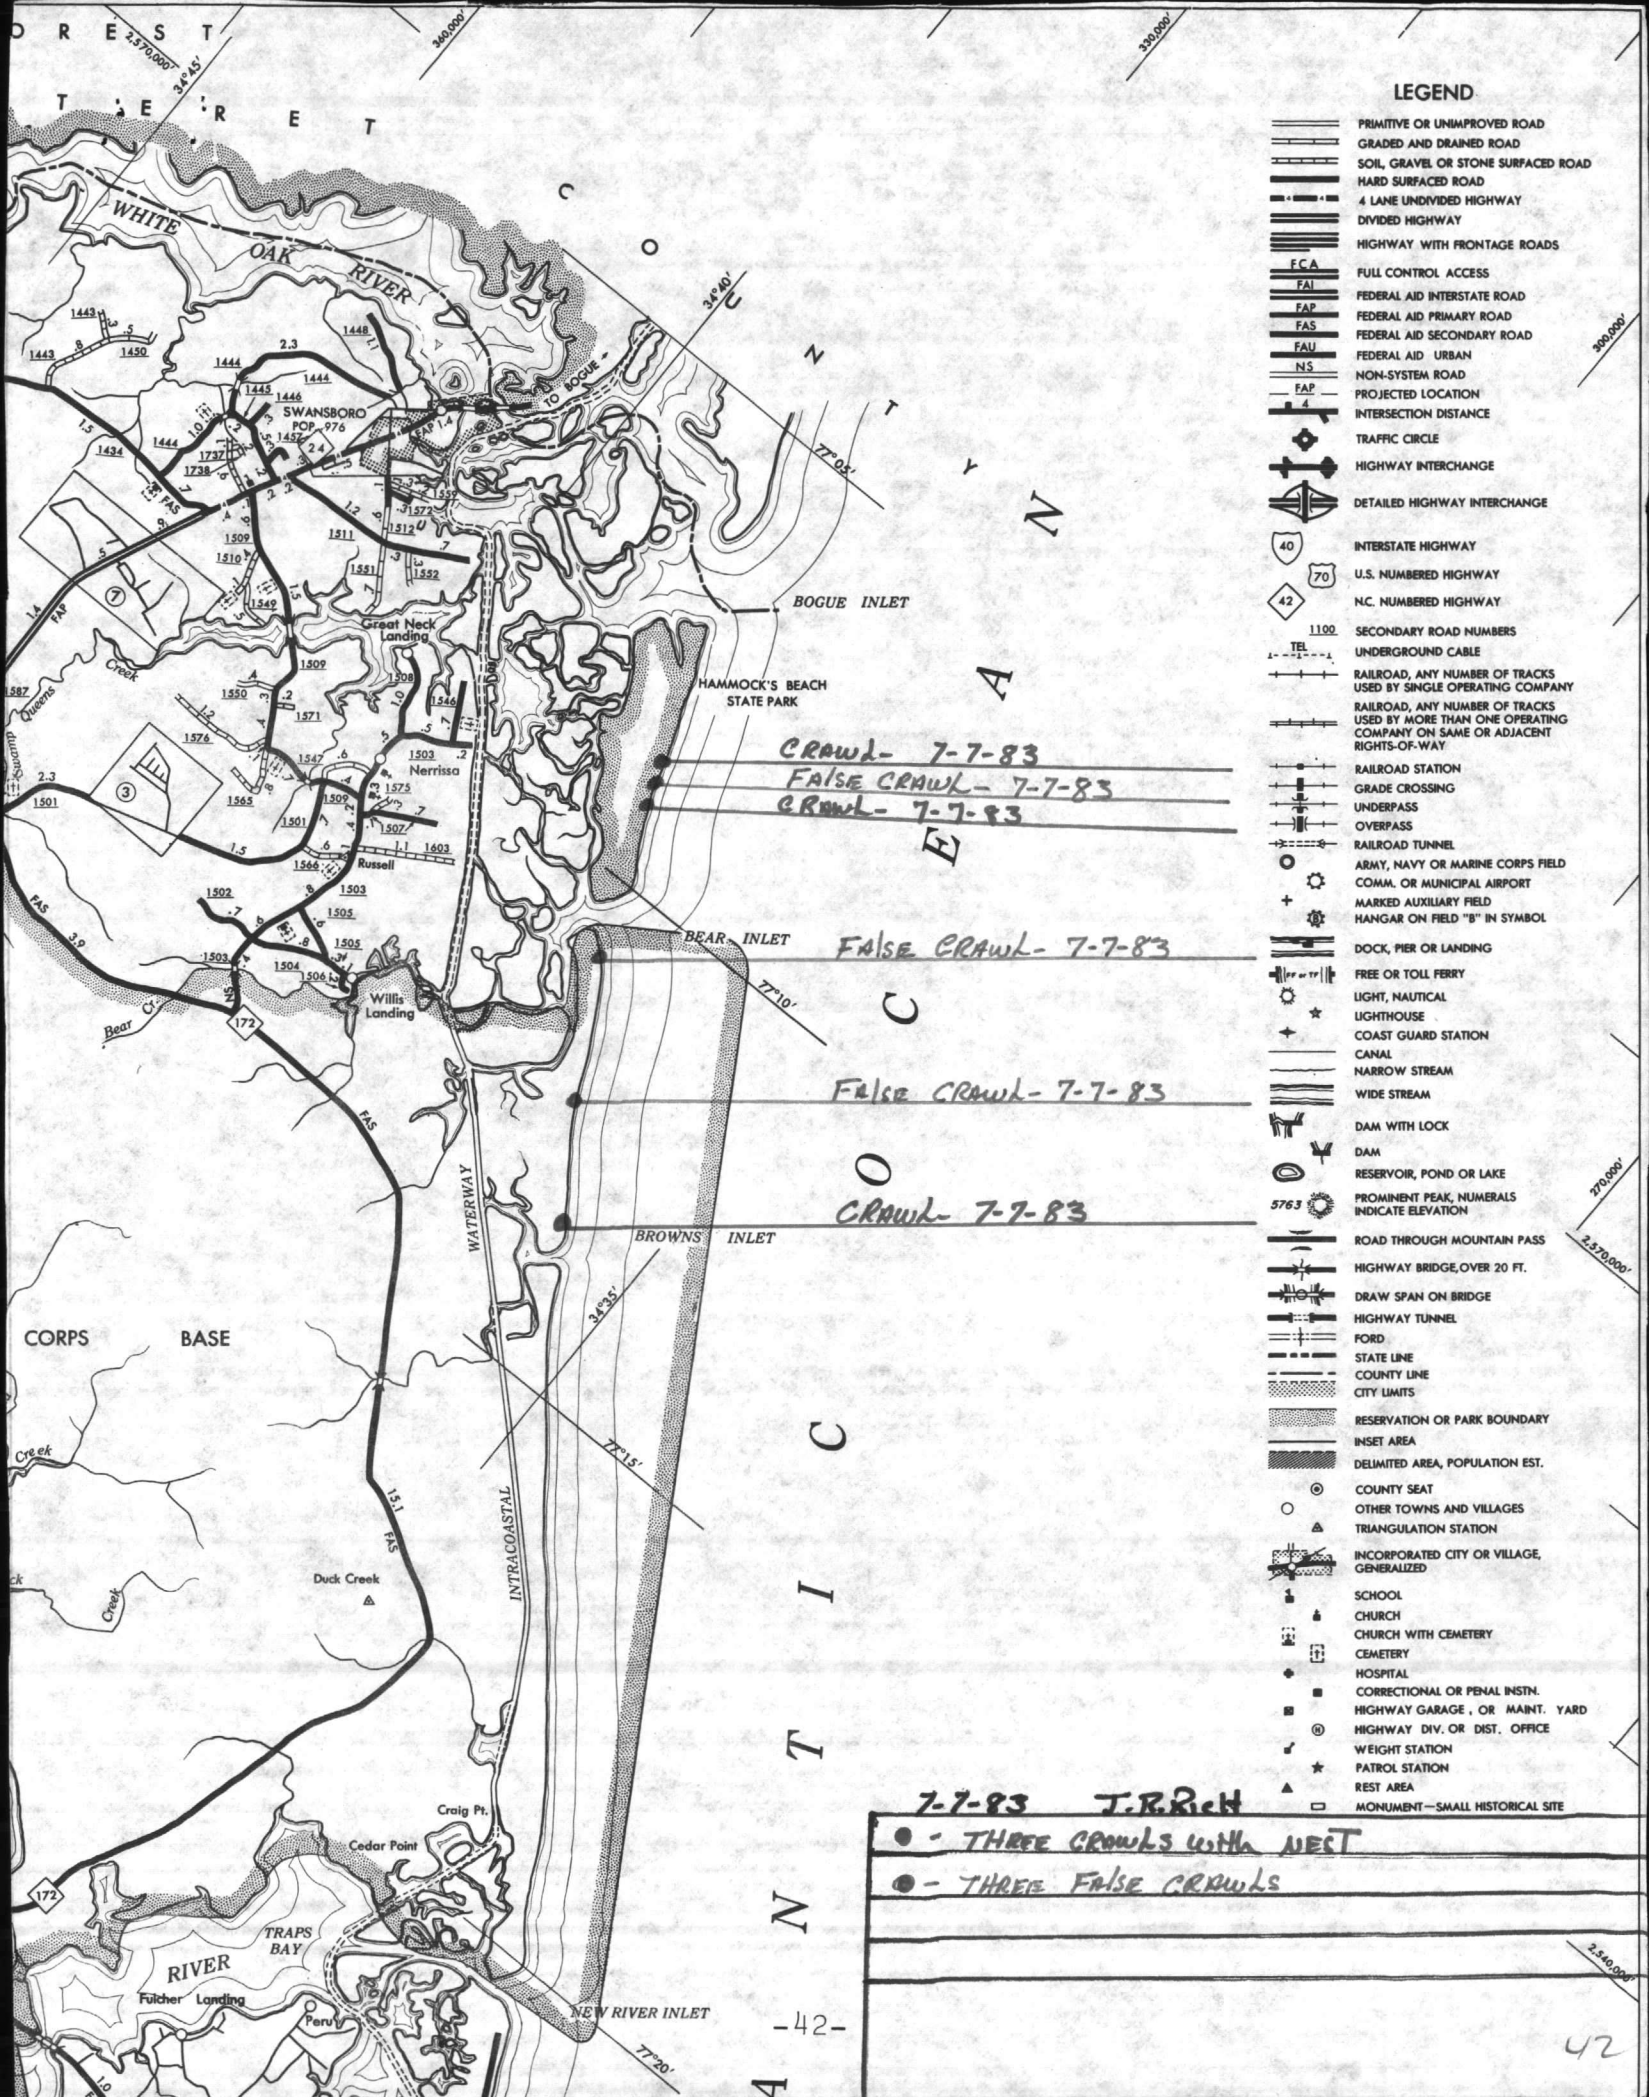


LEGEND

- PRIMITIVE OR UNIMPROVED ROAD
- GRADED AND DRAINED ROAD
- SOIL, GRAVEL OR STONE SURFACED ROAD
- HARD SURFACED ROAD
- 4 LANE UNDIVIDED HIGHWAY
- DIVIDED HIGHWAY
- HIGHWAY WITH FRONTAGE ROADS
- FCA FULL CONTROL ACCESS
- FAL FEDERAL AID INTERSTATE ROAD
- FAP FEDERAL AID PRIMARY ROAD
- FAS FEDERAL AID SECONDARY ROAD
- FAU FEDERAL AID URBAN
- NS NON-SYSTEM ROAD
- FAP PROJECTED LOCATION
- FAP INTERSECTION DISTANCE
- TRAFFIC CIRCLE
- HIGHWAY INTERCHANGE
- DETAILED HIGHWAY INTERCHANGE
- INTERSTATE HIGHWAY
- U.S. NUMBERED HIGHWAY
- N.C. NUMBERED HIGHWAY
- SECONDARY ROAD NUMBERS
- UNDERGROUND CABLE
- RAILROAD, ANY NUMBER OF TRACKS USED BY SINGLE OPERATING COMPANY
- RAILROAD, ANY NUMBER OF TRACKS USED BY MORE THAN ONE OPERATING COMPANY ON SAME OR ADJACENT RIGHTS-OF-WAY
- RAILROAD STATION
- GRADE CROSSING
- UNDERPASS
- OVERPASS
- RAILROAD TUNNEL
- ARMY, NAVY OR MARINE CORPS FIELD COMM. OR MUNICIPAL AIRPORT
- MARKED AUXILIARY FIELD HANGAR ON FIELD "B" IN SYMBOL
- DOCK, PIER OR LANDING
- FREE OR TOLL FERRY
- LIGHT, NAUTICAL
- LIGHTHOUSE
- COAST GUARD STATION
- CANAL
- NARROW STREAM
- WIDE STREAM
- DAM WITH LOCK
- DAM
- RESERVOIR, POND OR LAKE
- PROMINENT PEAK, NUMERALS INDICATE ELEVATION
- ROAD THROUGH MOUNTAIN PASS
- HIGHWAY BRIDGE, OVER 20 FT.
- DRAW SPAN ON BRIDGE
- HIGHWAY TUNNEL
- FORD
- STATE LINE
- COUNTY LINE
- CITY LIMITS
- RESERVATION OR PARK BOUNDARY
- INSET AREA
- DELIMITED AREA, POPULATION EST.
- COUNTY SEAT
- OTHER TOWNS AND VILLAGES
- TRIANGULATION STATION
- INCORPORATED CITY OR VILLAGE, GENERALIZED
- SCHOOL
- CHURCH
- CHURCH WITH CEMETERY
- CEMETERY
- HOSPITAL
- CORRECTIONAL OR PENAL INSTN.
- HIGHWAY GARAGE, OR MAINT. YARD
- HIGHWAY DIV. OR DIST. OFFICE
- WEIGHT STATION
- PATROL STATION
- REST AREA
- MONUMENT - SMALL HISTORICAL SITE

7-7-83 J.R. RICH

- - THREE CRAWLS WITH MEET
- - THREE FALSE CRAWLS

42

 

AERIAL SURVEY DATA

Date: July 10 83 Time: S 06:08 F 08:20

Recorder Name: Jerry R. Rich

Crew Names: None Pilot: J. R. Rich

Co-Pilot: None Crew Chief: None

Others: None

Weather: General 5 miles haze & fog Cloud Cover 10000 SCT

Wind Speed W 5-7 K Sea Conditions Light Chop

BEACH AERIAL SURVEYS Altitude 100 Ft
Air Speed 60 K

Location	Crawls		Nests		Nest Predation	
	New	Old	New	Old	New	Old
Onslow Beach	0	0	0	0	0	0
Browns Island	0	0	0	0	0	0
Bear Beach	3	0	2	0	1	0

OCEAN AERIAL SURVEYS Altitude 400 Ft
Air Speed 60 K

	Live Turtles		Dead Turtles
	Juvenile	Adults	
Bell Buoy from Bogue Inlet to New River Inlet	None	None	None

Comments:

08:30


































LEGEND

- PRIMITIVE OR UNIMPROVED ROAD
- GRADED AND DRAINED ROAD
- SOIL, GRAVEL OR STONE SURFACED ROAD
- HARD SURFACED ROAD
- 4 LANE UNDIVIDED HIGHWAY
- DIVIDED HIGHWAY
- HIGHWAY WITH FRONTAGE ROADS
- FCA FULL CONTROL ACCESS
- FAI FEDERAL AID INTERSTATE ROAD
- FAP FEDERAL AID PRIMARY ROAD
- FAS FEDERAL AID SECONDARY ROAD
- FAU FEDERAL AID URBAN
- NS NON-SYSTEM ROAD
- FAP PROJECTED LOCATION
- INTERSECTION DISTANCE
- TRAFFIC CIRCLE
- HIGHWAY INTERCHANGE
- DETAILED HIGHWAY INTERCHANGE
- INTERSTATE HIGHWAY
- U.S. NUMBERED HIGHWAY
- N.C. NUMBERED HIGHWAY
- SECONDARY ROAD NUMBERS
- UNDERGROUND CABLE
- RAILROAD, ANY NUMBER OF TRACKS USED BY SINGLE OPERATING COMPANY
- RAILROAD, ANY NUMBER OF TRACKS USED BY MORE THAN ONE OPERATING COMPANY ON SAME OR ADJACENT RIGHTS-OF-WAY
- RAILROAD STATION
- GRADE CROSSING
- UNDERPASS
- OVERPASS
- RAILROAD TUNNEL
- ARMY, NAVY OR MARINE CORPS FIELD
- COMM. OR MUNICIPAL AIRPORT
- MARKED AUXILIARY FIELD
- HANGAR ON FIELD "B" IN SYMBOL
- DOCK, PIER OR LANDING
- FREE OR TOLL FERRY
- LIGHT, NAUTICAL
- LIGHTHOUSE
- COAST GUARD STATION
- CANAL
- NARROW STREAM
- WIDE STREAM
- DAM WITH LOCK
- DAM
- RESERVOIR, POND OR LAKE
- PROMINENT PEAK, NUMERALS INDICATE ELEVATION
- ROAD THROUGH MOUNTAIN PASS
- HIGHWAY BRIDGE OVER 20 FT.
- DRAW SPAN ON BRIDGE
- HIGHWAY TUNNEL
- FORD
- STATE LINE
- COUNTY LINE
- CITY LIMITS
- RESERVATION OR PARK BOUNDARY
- INSET AREA
- DELIMITED AREA, POPULATION EST.
- COUNTY SEAT
- OTHER TOWNS AND VILLAGES
- TRIANGULATION STATION
- INCORPORATED CITY OR VILLAGE, GENERALIZED
- SCHOOL
- CHURCH
- CHURCH WITH CEMETERY
- CEMETERY
- HOSPITAL
- CORRECTIONAL OR PENAL INSTN.
- HIGHWAY GARAGE, OR MAINT. YARD
- HIGHWAY DIV. OR DIST. OFFICE
- WEIGHT STATION
- PATROL STATION
- REST AREA
- MONUMENT—SMALL HISTORICAL SITE

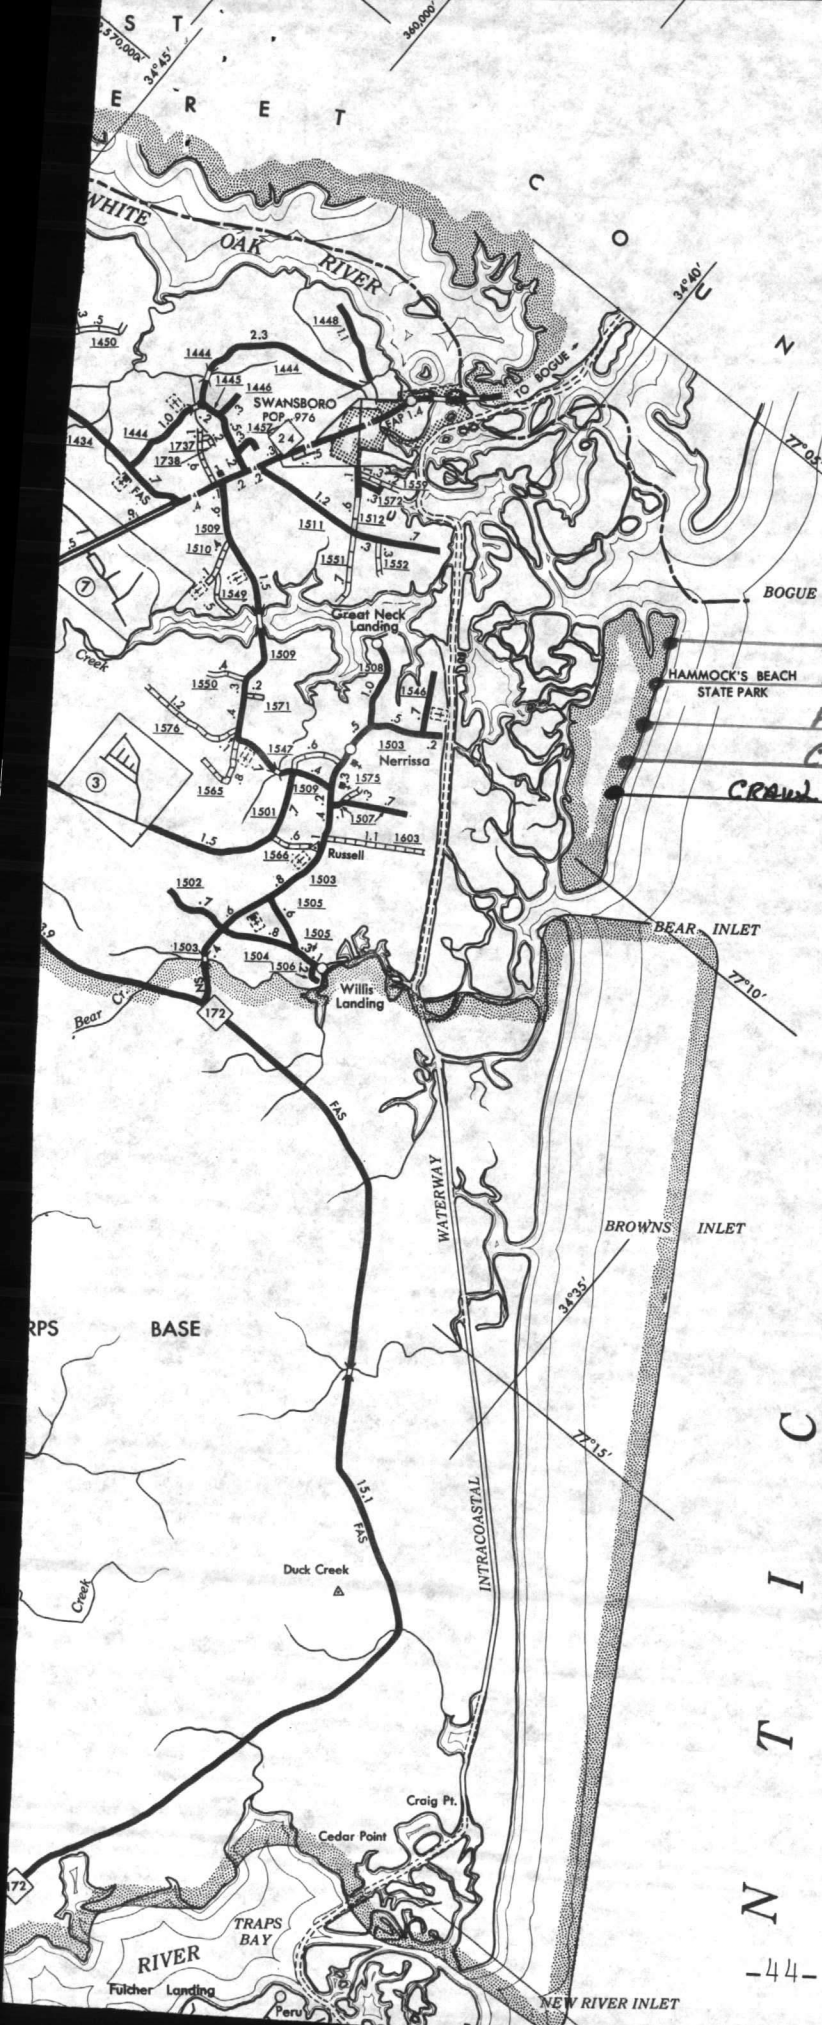

False CRAWL 7-10-83
 False CRAWL 7-10-83
 False CRAWL - 7-10-83
 CRAWL - 7-10-83
 CRAWL with NEST Predation 7-10-83

- 7-10-83 T.R. Rich
- - ONE CRAWL with NEST - 7-10-83
 - - THREE FALSE CRAWLS 7-10-83
 - ONE CRAWL with NEST Predation 7-10-83

 

AERIAL SURVEY DATA

Date: July 15 1983 Time: S 06:05 F 13:00

Recorder Name: Jerry R. Rich

Crew Names: None Pilot: J. R. Rich

Co-Pilot: None Crew Chief: None

Others: None

Weather: General 1 miles vis. fog. Cloud Cover 200 OVC

Wind Speed Calm Sea Conditions Calm

BEACH AERIAL SURVEYS Altitude 100 Ft

Air Speed 60 K

Location	Crawls		Nests		Nest Predation	
	New	Old	New	Old	New	Old
Onslow Beach	2	0	2	0	0	0
Browns Island	0	0	0	0	0	0
Bear Beach	1	0	3	1	1	0

OCEAN AERIAL SURVEYS Altitude 200 Ft

Air Speed 60 K

	Live Turtles		Dead Turtles
	Juvenile	Adults	
Bell Buoy from Bogue Inlet to New River Inlet	None	None	None

Comments:






























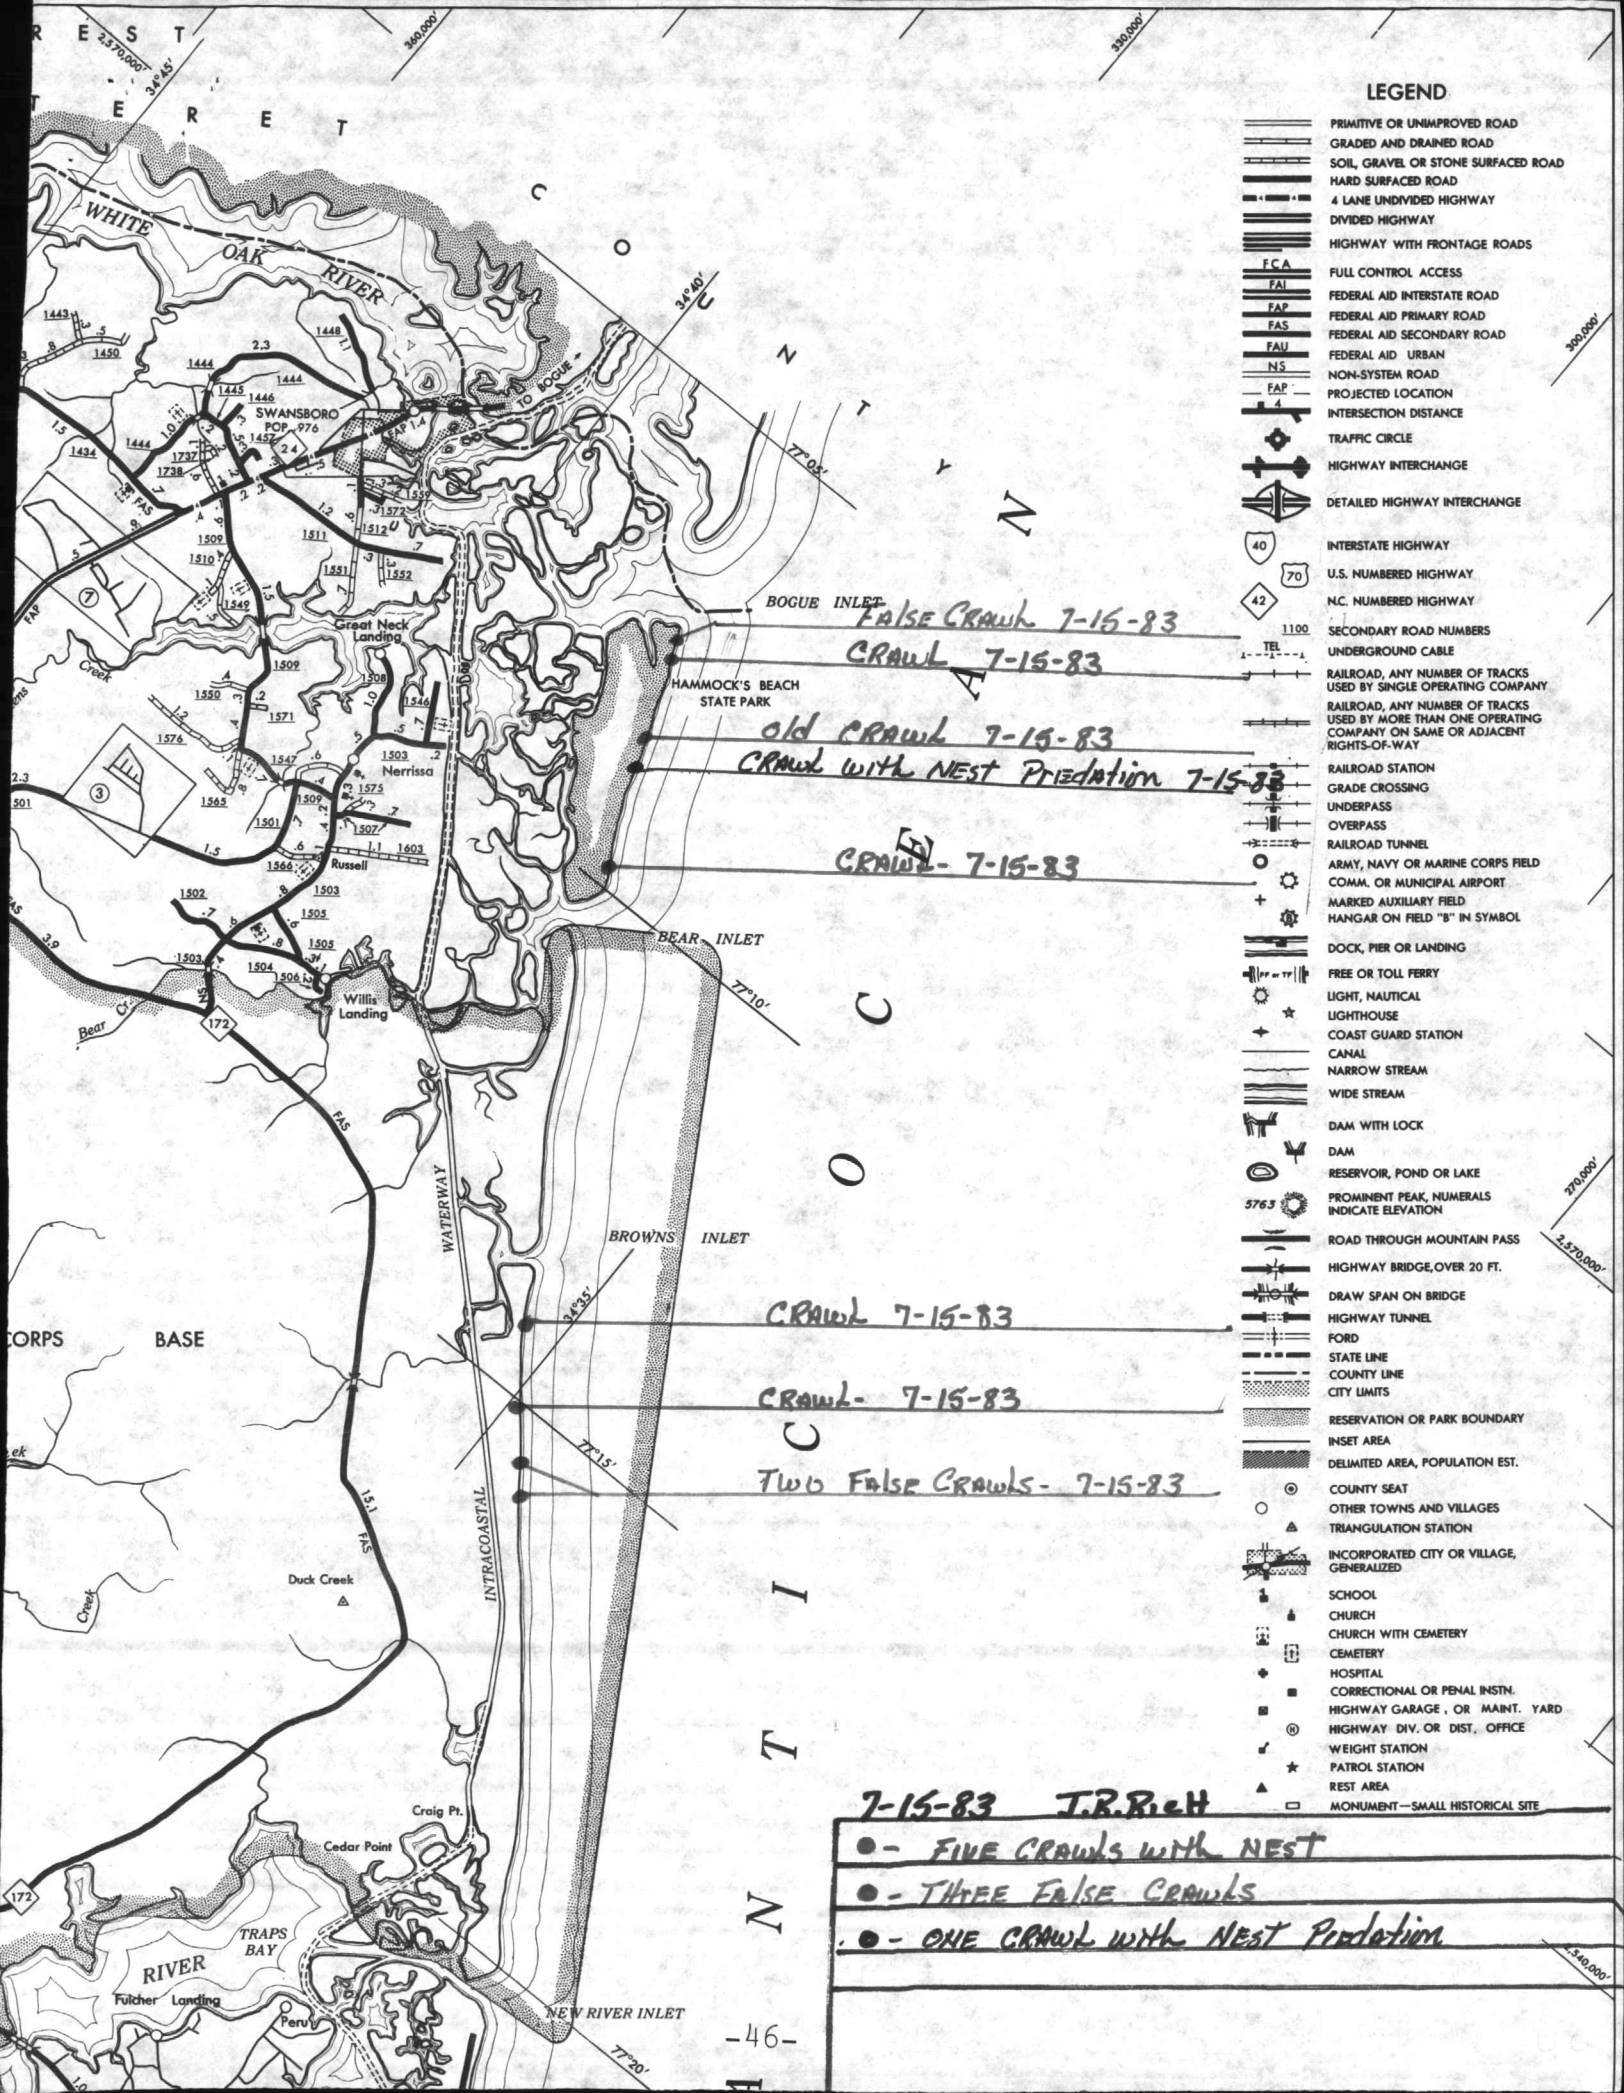

LEGEND

- PRIMITIVE OR UNIMPROVED ROAD
- GRADED AND DRAINED ROAD
- SOIL, GRAVEL OR STONE SURFACED ROAD
- HARD SURFACED ROAD
- 4 LANE UNDIVIDED HIGHWAY
- DIVIDED HIGHWAY
- HIGHWAY WITH FRONTAGE ROADS
- FCA FULL CONTROL ACCESS
- FAI FEDERAL AID INTERSTATE ROAD
- FAP FEDERAL AID PRIMARY ROAD
- FAS FEDERAL AID SECONDARY ROAD
- FAU FEDERAL AID URBAN
- NS NON-SYSTEM ROAD
- EAP PROJECTED LOCATION
- INTERSECTION DISTANCE
- TRAFFIC CIRCLE
- HIGHWAY INTERCHANGE
- DETAILED HIGHWAY INTERCHANGE
- INTERSTATE HIGHWAY
- U.S. NUMBERED HIGHWAY
- N.C. NUMBERED HIGHWAY
- SECONDARY ROAD NUMBERS
- UNDERGROUND CABLE
- RAILROAD, ANY NUMBER OF TRACKS USED BY SINGLE OPERATING COMPANY
- RAILROAD, ANY NUMBER OF TRACKS USED BY MORE THAN ONE OPERATING COMPANY ON SAME OR ADJACENT RIGHTS-OF-WAY
- RAILROAD STATION
- GRADE CROSSING
- UNDERPASS
- OVERPASS
- RAILROAD TUNNEL
- ARMY, NAVY OR MARINE CORPS FIELD COMM. OR MUNICIPAL AIRPORT
- MARKED AUXILIARY FIELD
- HANGAR ON FIELD "B" IN SYMBOL
- DOCK, PIER OR LANDING
- FREE OR TOLL FERRY
- LIGHT, NAUTICAL
- LIGHTHOUSE
- COAST GUARD STATION
- CANAL
- NARROW STREAM
- WIDE STREAM
- DAM WITH LOCK
- DAM
- RESERVOIR, POND OR LAKE
- PROMINENT PEAK, NUMERALS INDICATE ELEVATION
- ROAD THROUGH MOUNTAIN PASS
- HIGHWAY BRIDGE, OVER 20 FT.
- DRAW SPAN ON BRIDGE
- HIGHWAY TUNNEL
- FORD
- STATE LINE
- COUNTY LINE
- CITY LIMITS
- RESERVATION OR PARK BOUNDARY
- INSET AREA
- DELIMITED AREA, POPULATION EST.
- COUNTY SEAT
- OTHER TOWNS AND VILLAGES
- TRIANGULATION STATION
- INCORPORATED CITY OR VILLAGE, GENERALIZED
- SCHOOL
- CHURCH
- CHURCH WITH CEMETERY
- CEMETERY
- HOSPITAL
- CORRECTIONAL OR PENAL INSTN.
- HIGHWAY GARAGE, OR MAINT. YARD
- HIGHWAY DIV. OR DIST. OFFICE
- WEIGHT STATION
- PATROL STATION
- REST AREA
- MONUMENT - SMALL HISTORICAL SITE

7-15-83 J.R. Rieh

- - FIVE CRAWLS WITH NEST
- - THREE FALSE CRAWLS
- - ONE CRAWL WITH NEST PREDATION




NEST AND CRAWL ACTIVITY
 ONSLOW BEACH, MARINE CORPS BASE
 CAMP LEJEUNE, NORTH CAROLINA

Nests - upper map

Crawls no nest - lower map

Dots indicates multiple usage

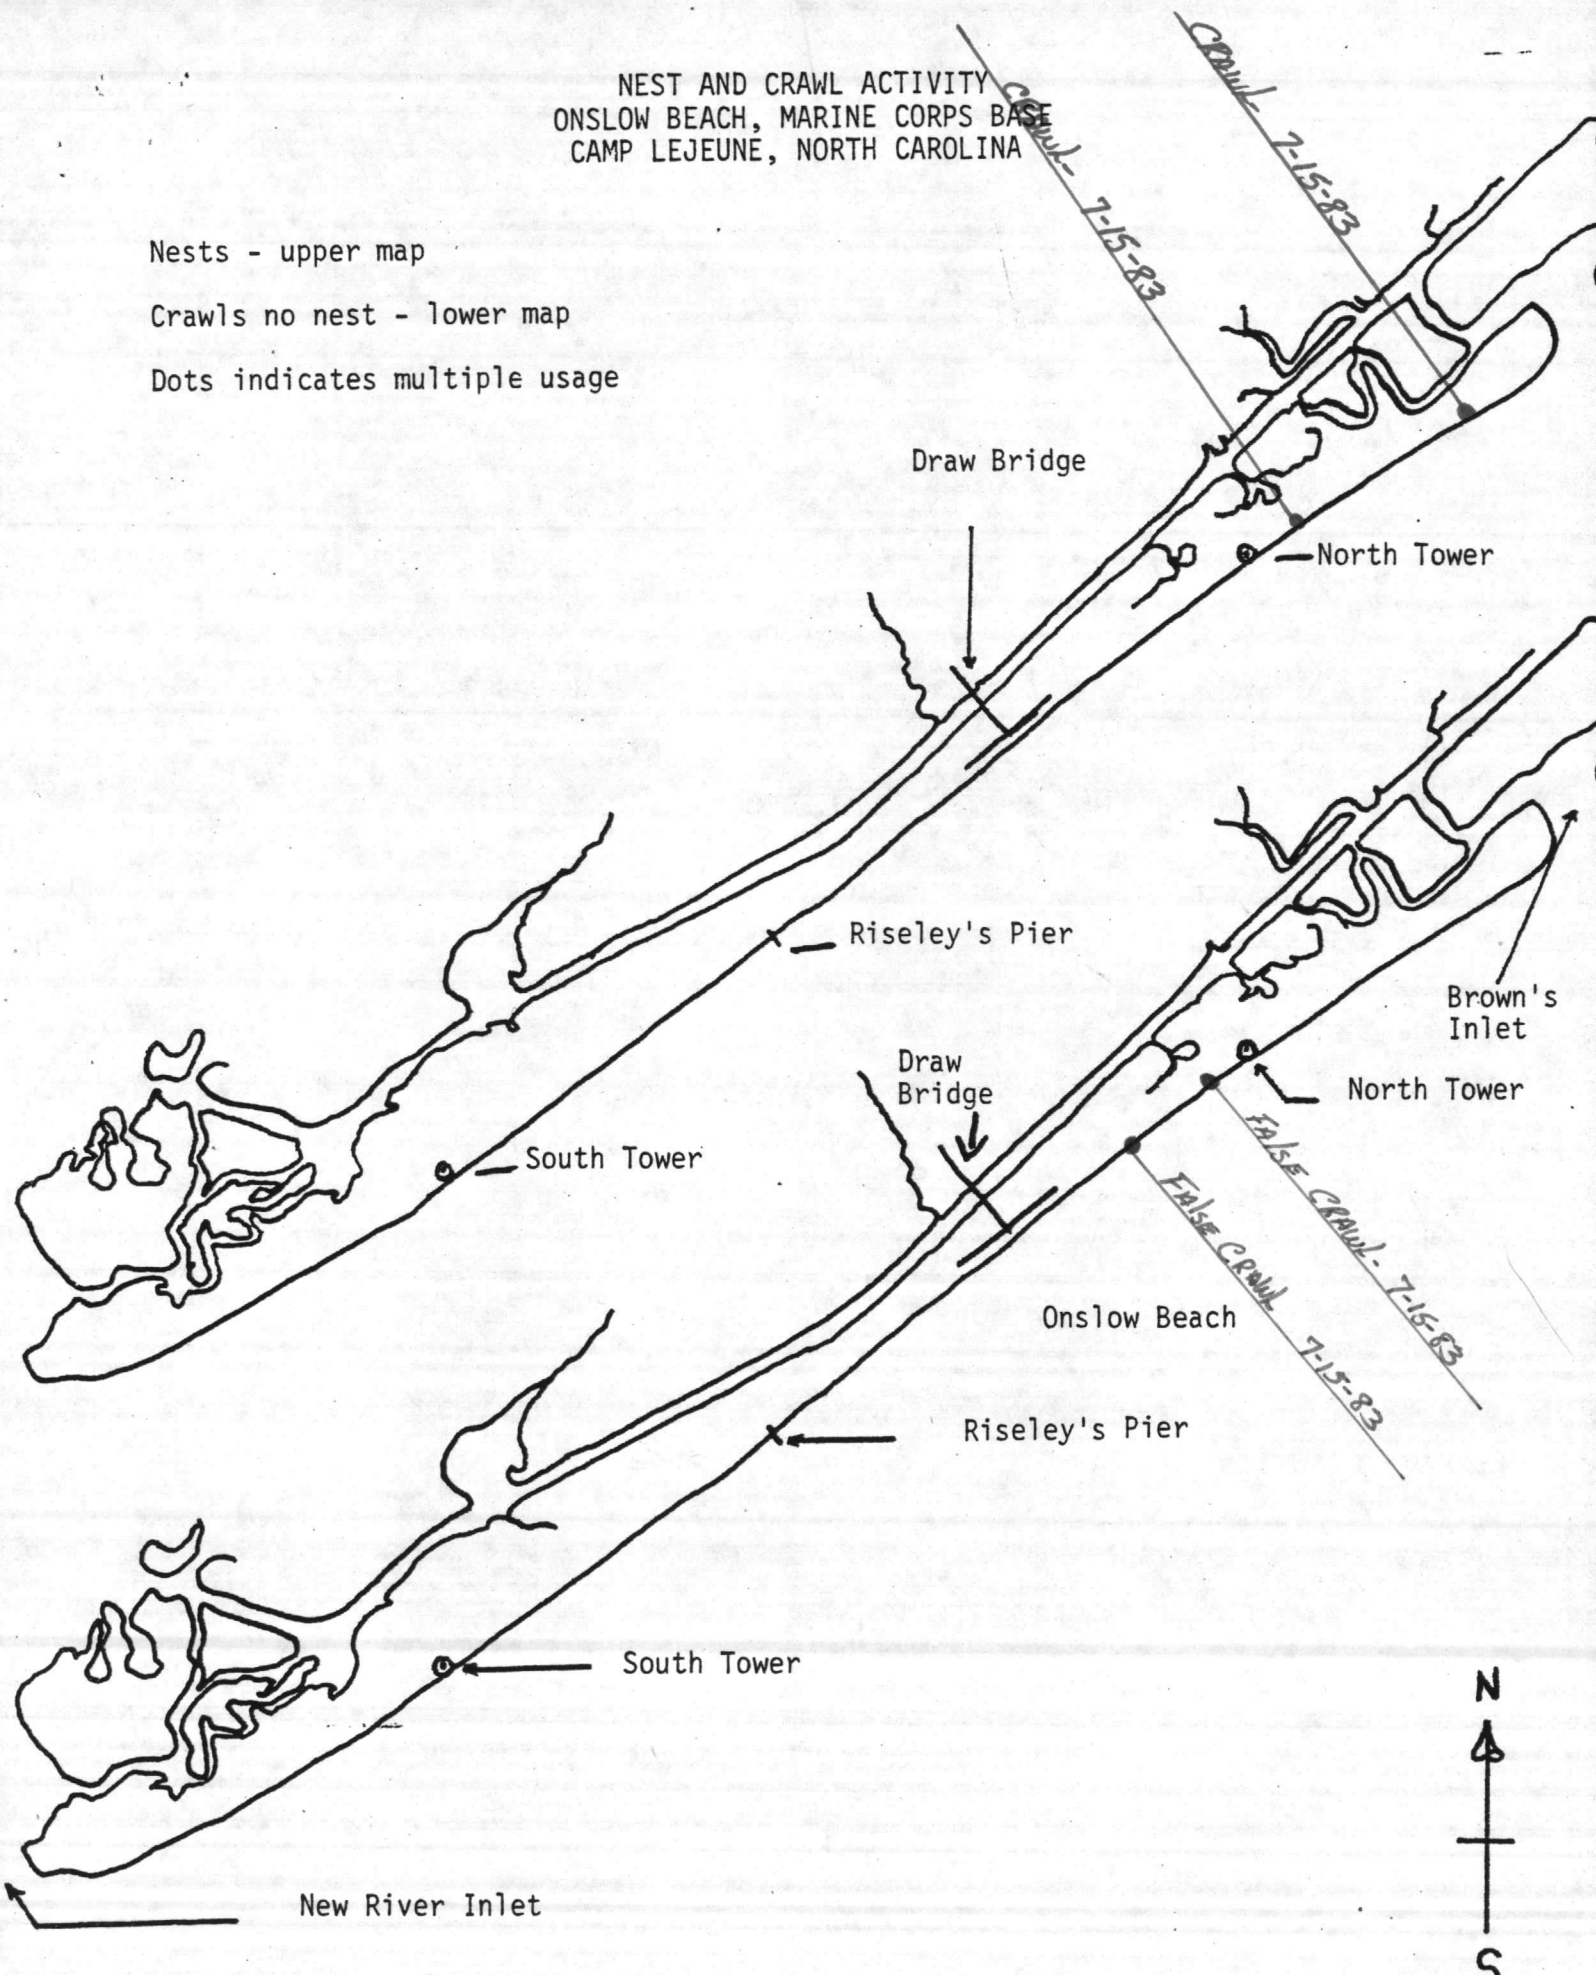

AERIAL SURVEY DATA

Date: July 19 1983 Time: S 06:09 F 08:30

Recorder Name: Jerry R. Rich

Crew Names: None Pilot: J. R. Rich

Co-Pilot: None Crew Chief: None

Others: None

Weather: General -X 1 mile fog & haze Cloud Cover -X fog & haze

Wind Speed SW less than 5 K Sea Conditions Calm

BEACH AERIAL SURVEYS Altitude 100 Ft
Air Speed 60 K

Location	Crawls		Nests		Nest Predation	
	New	Old	New	Old	New	Old
Onslow Beach	0	0	1	2	0	0
Browns Island	2	0	4	0	3	0
Bear Beach	3	0	3	3	0	1

OCEAN AERIAL SURVEYS Altitude 200 Ft
Air Speed 60 K

	Live Turtles		Dead Turtles
	Juvenile	Adults	
Bell Buoy from Bogue Inlet to New River Inlet	None	None	None

Comments:








































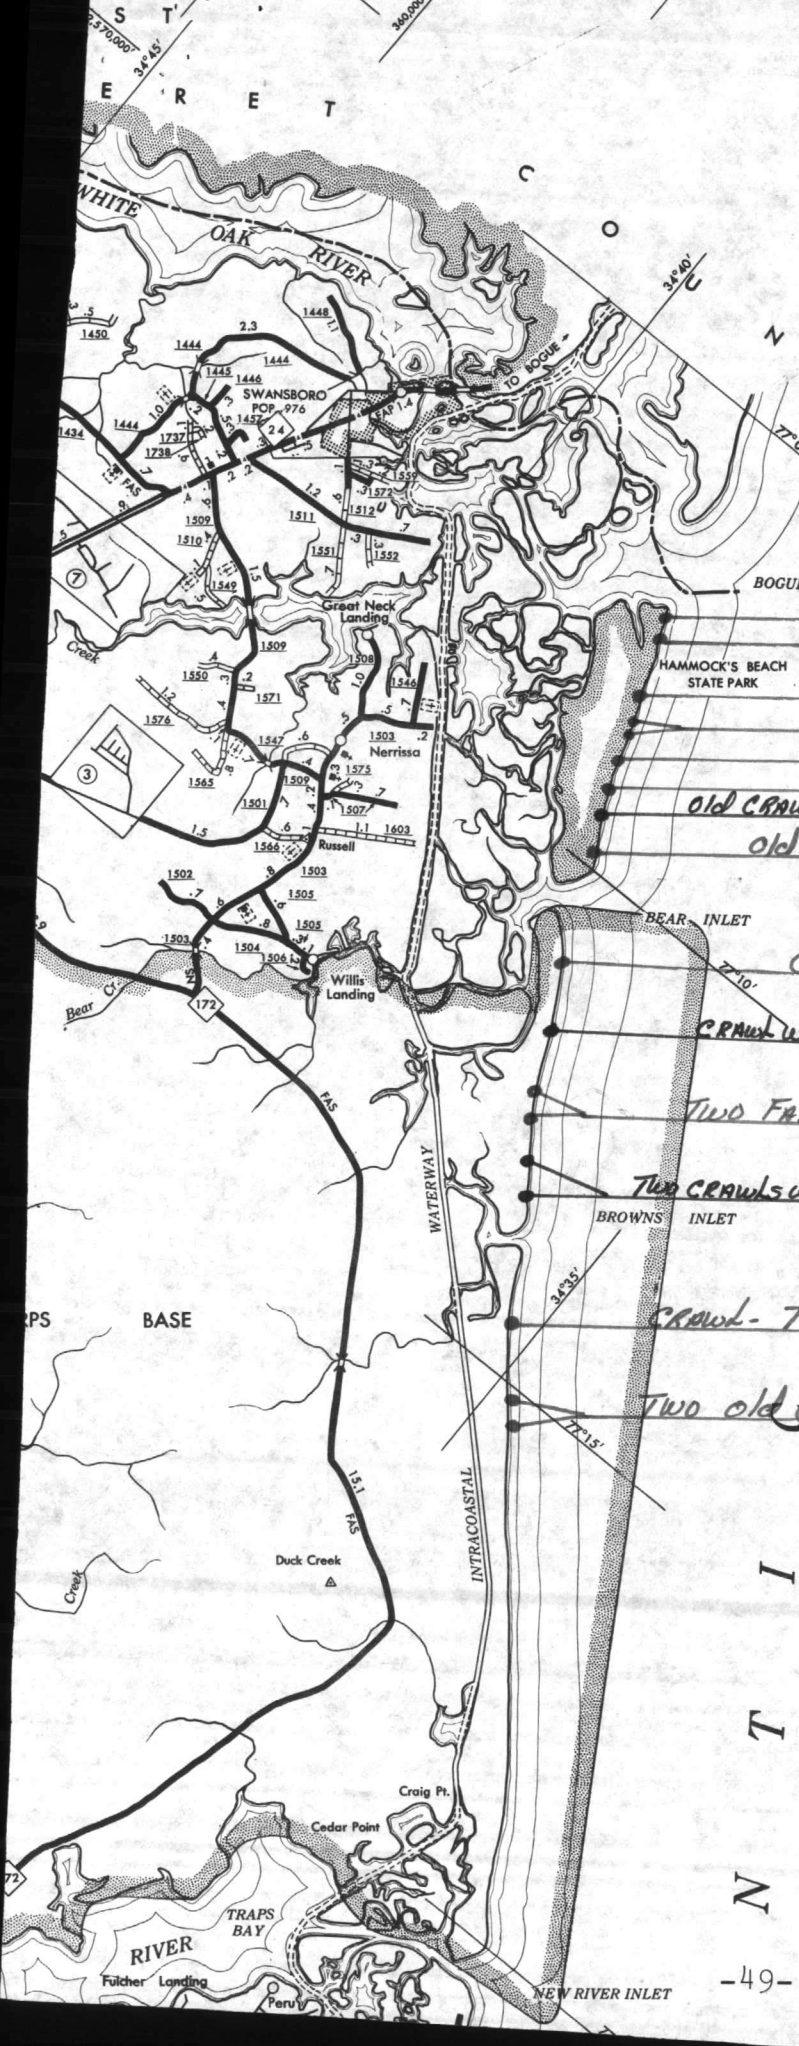


CRAWL - 7-19-83
Old CRAWL 7-19-83

CRAWL 7-19-83
TWO FALSE CRAWL - 7-19-83
CRAWL 7-19-83
FALSE CRAWL 7-19-83
Old CRAWL with NEST Predation 7-19-83
Old CRAWL - 7-19-83

CRAWL - 7-19-83
CRAWL with NEST Predation 7-19-83
TWO FALSE CRAWLS 7-19-83
TWO CRAWLS with NEST Predation - 7-19-83

CRAWL - 7-19-83
TWO Old CRAWLS - 7-19-83

- 7-19-83 J.R. Rott**
- *NINE CRAWLS with NEST*
 - *FIVE FALSE CRAWLS*
 - *THREE CRAWLS with NEST Predation*

 



NEST AND CRAWL ACTIVITY
ONSLow BEACH, MARINE CORPS BASE
CAMP LEJEUNE, NORTH CAROLINA

Nests - upper map

Crawls no nest - lower map

Dots indicates multiple usage

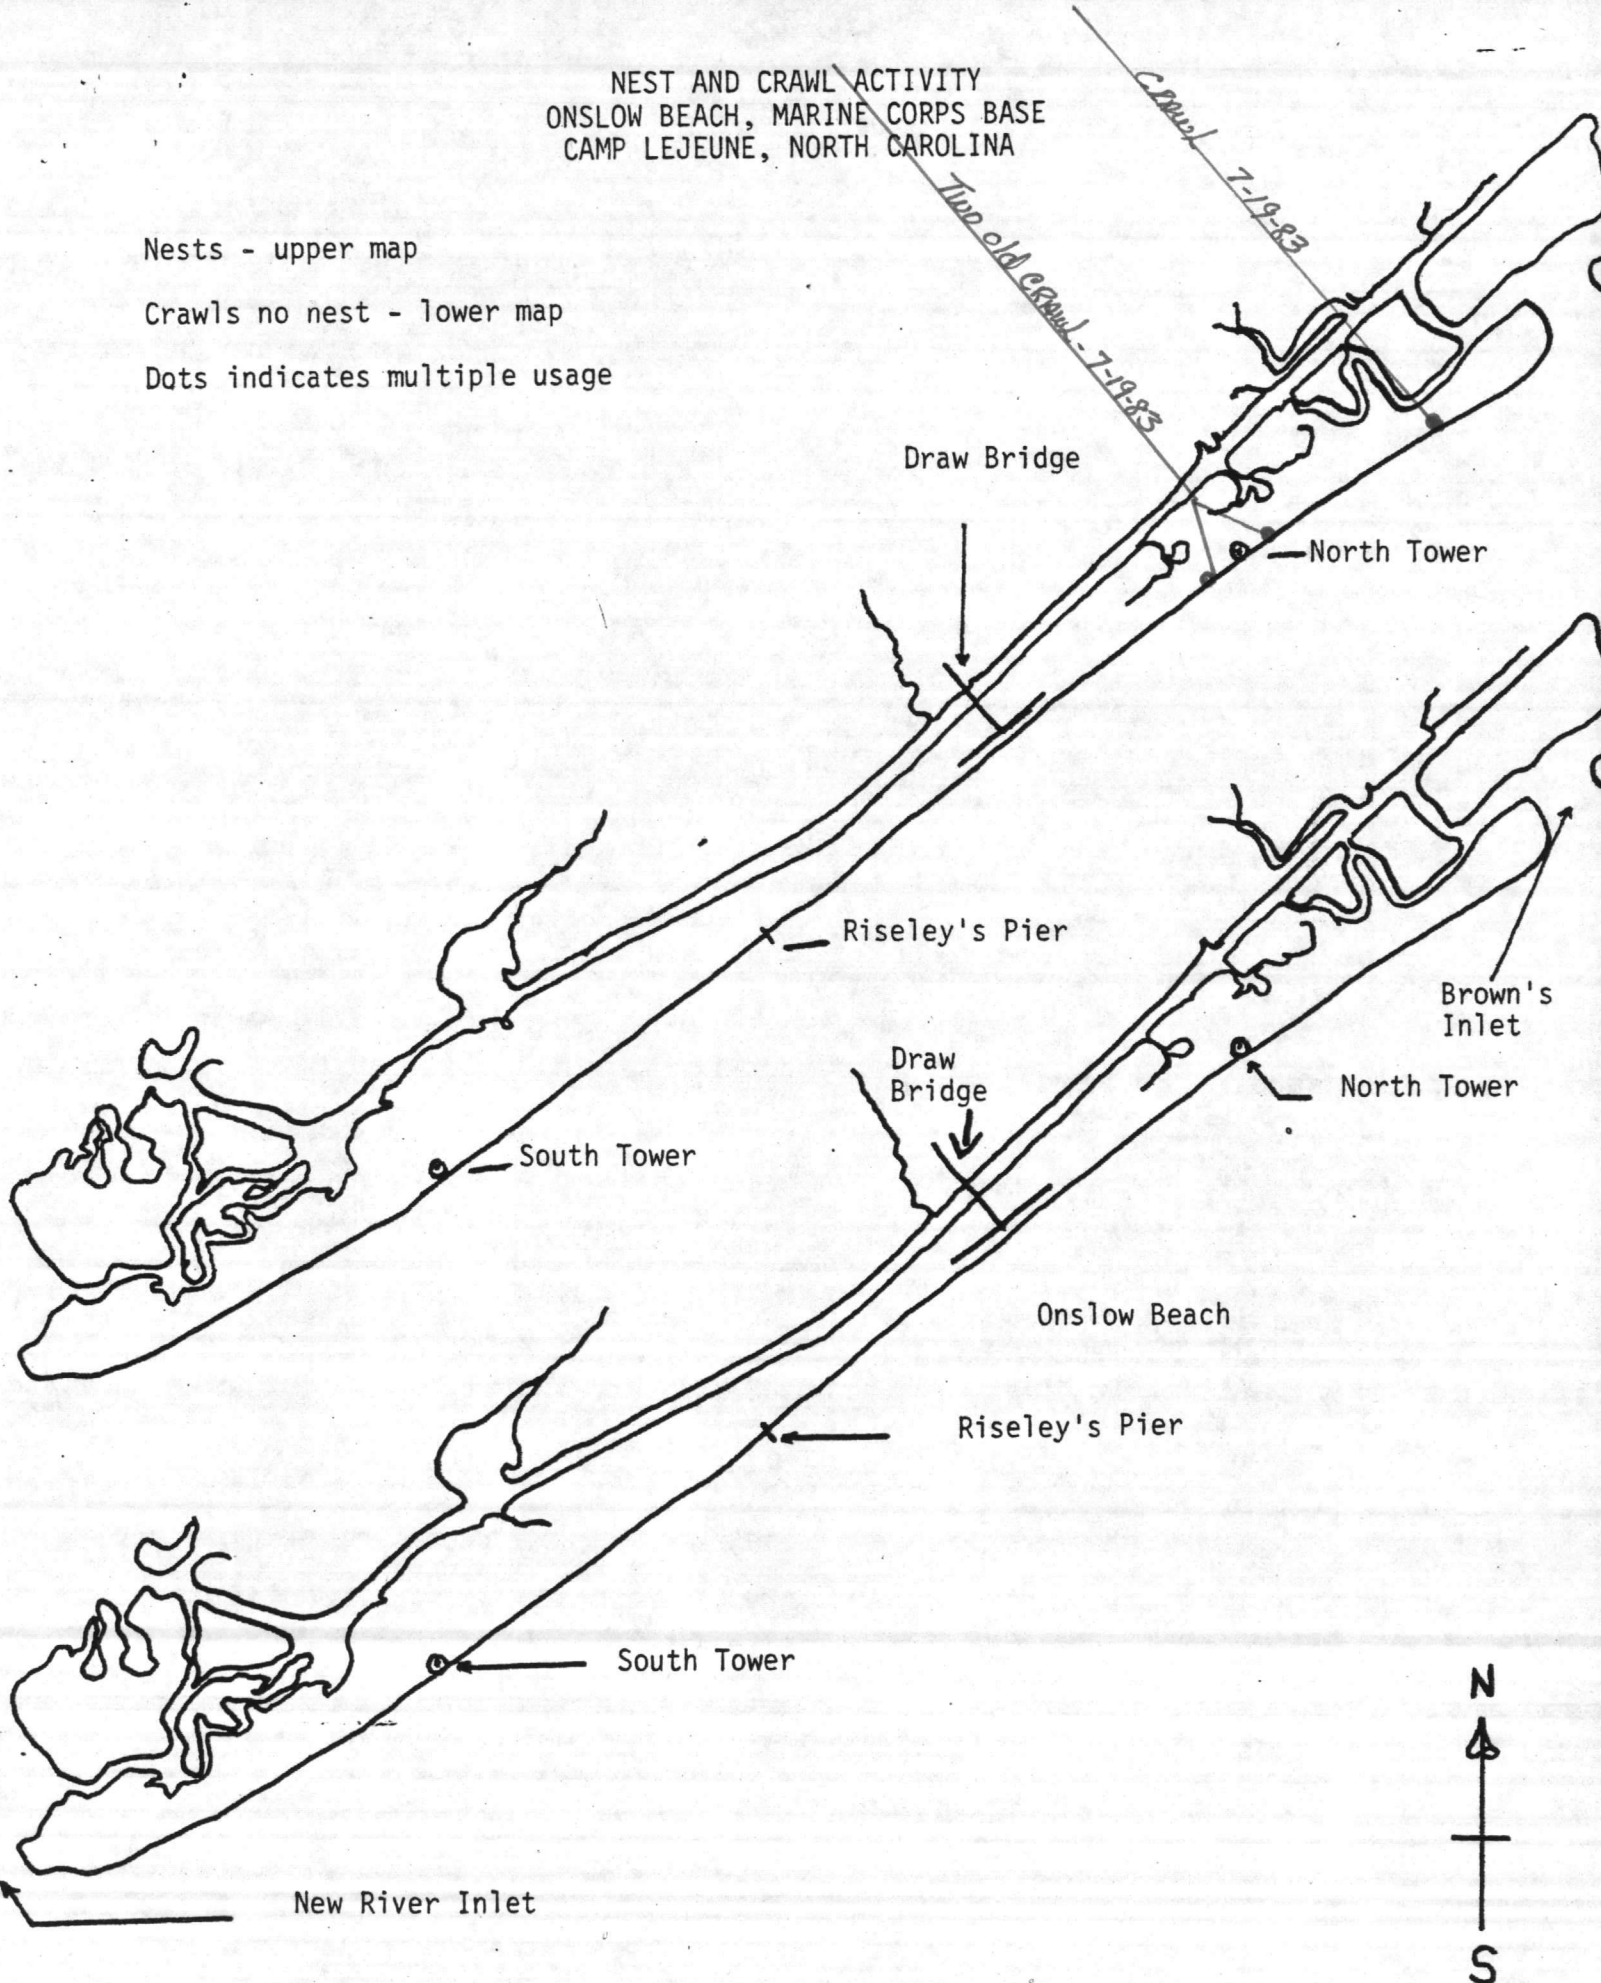

 

AERIAL SURVEY DATA

Date: July 22 83 Time: S 06:13 F 08:29

Recorder Name: Jerry R. Rich

Crew Names: None Pilot: J. R. Rich

Co-Pilot: None Crew Chief: None

Others: None

Weather: General SCT TWR & rain Cloud Cover 2000-3000 BKN

Wind Speed SW 10-12 K Sea Conditions Chop White Caps

BEACH AERIAL SURVEYS Altitude 100 Ft
Air Speed 60 K

Location	Crawls		Nests		Nest Predation	
	New	Old	New	Old	New	Old
Onslow Beach	0	0	0	1	0	0
Browns Island	0	0	0	1	1	0
Bear Beach	0	0	0	0	0	0

OCEAN AERIAL SURVEYS Altitude 300 FT
Air Speed 60 K

	Live Turtles		Dead Turtles
	Juvenile	Adults	
Bell Buoy from Bogue Inlet to New River Inlet	None	None	None

Comments:

08:30




































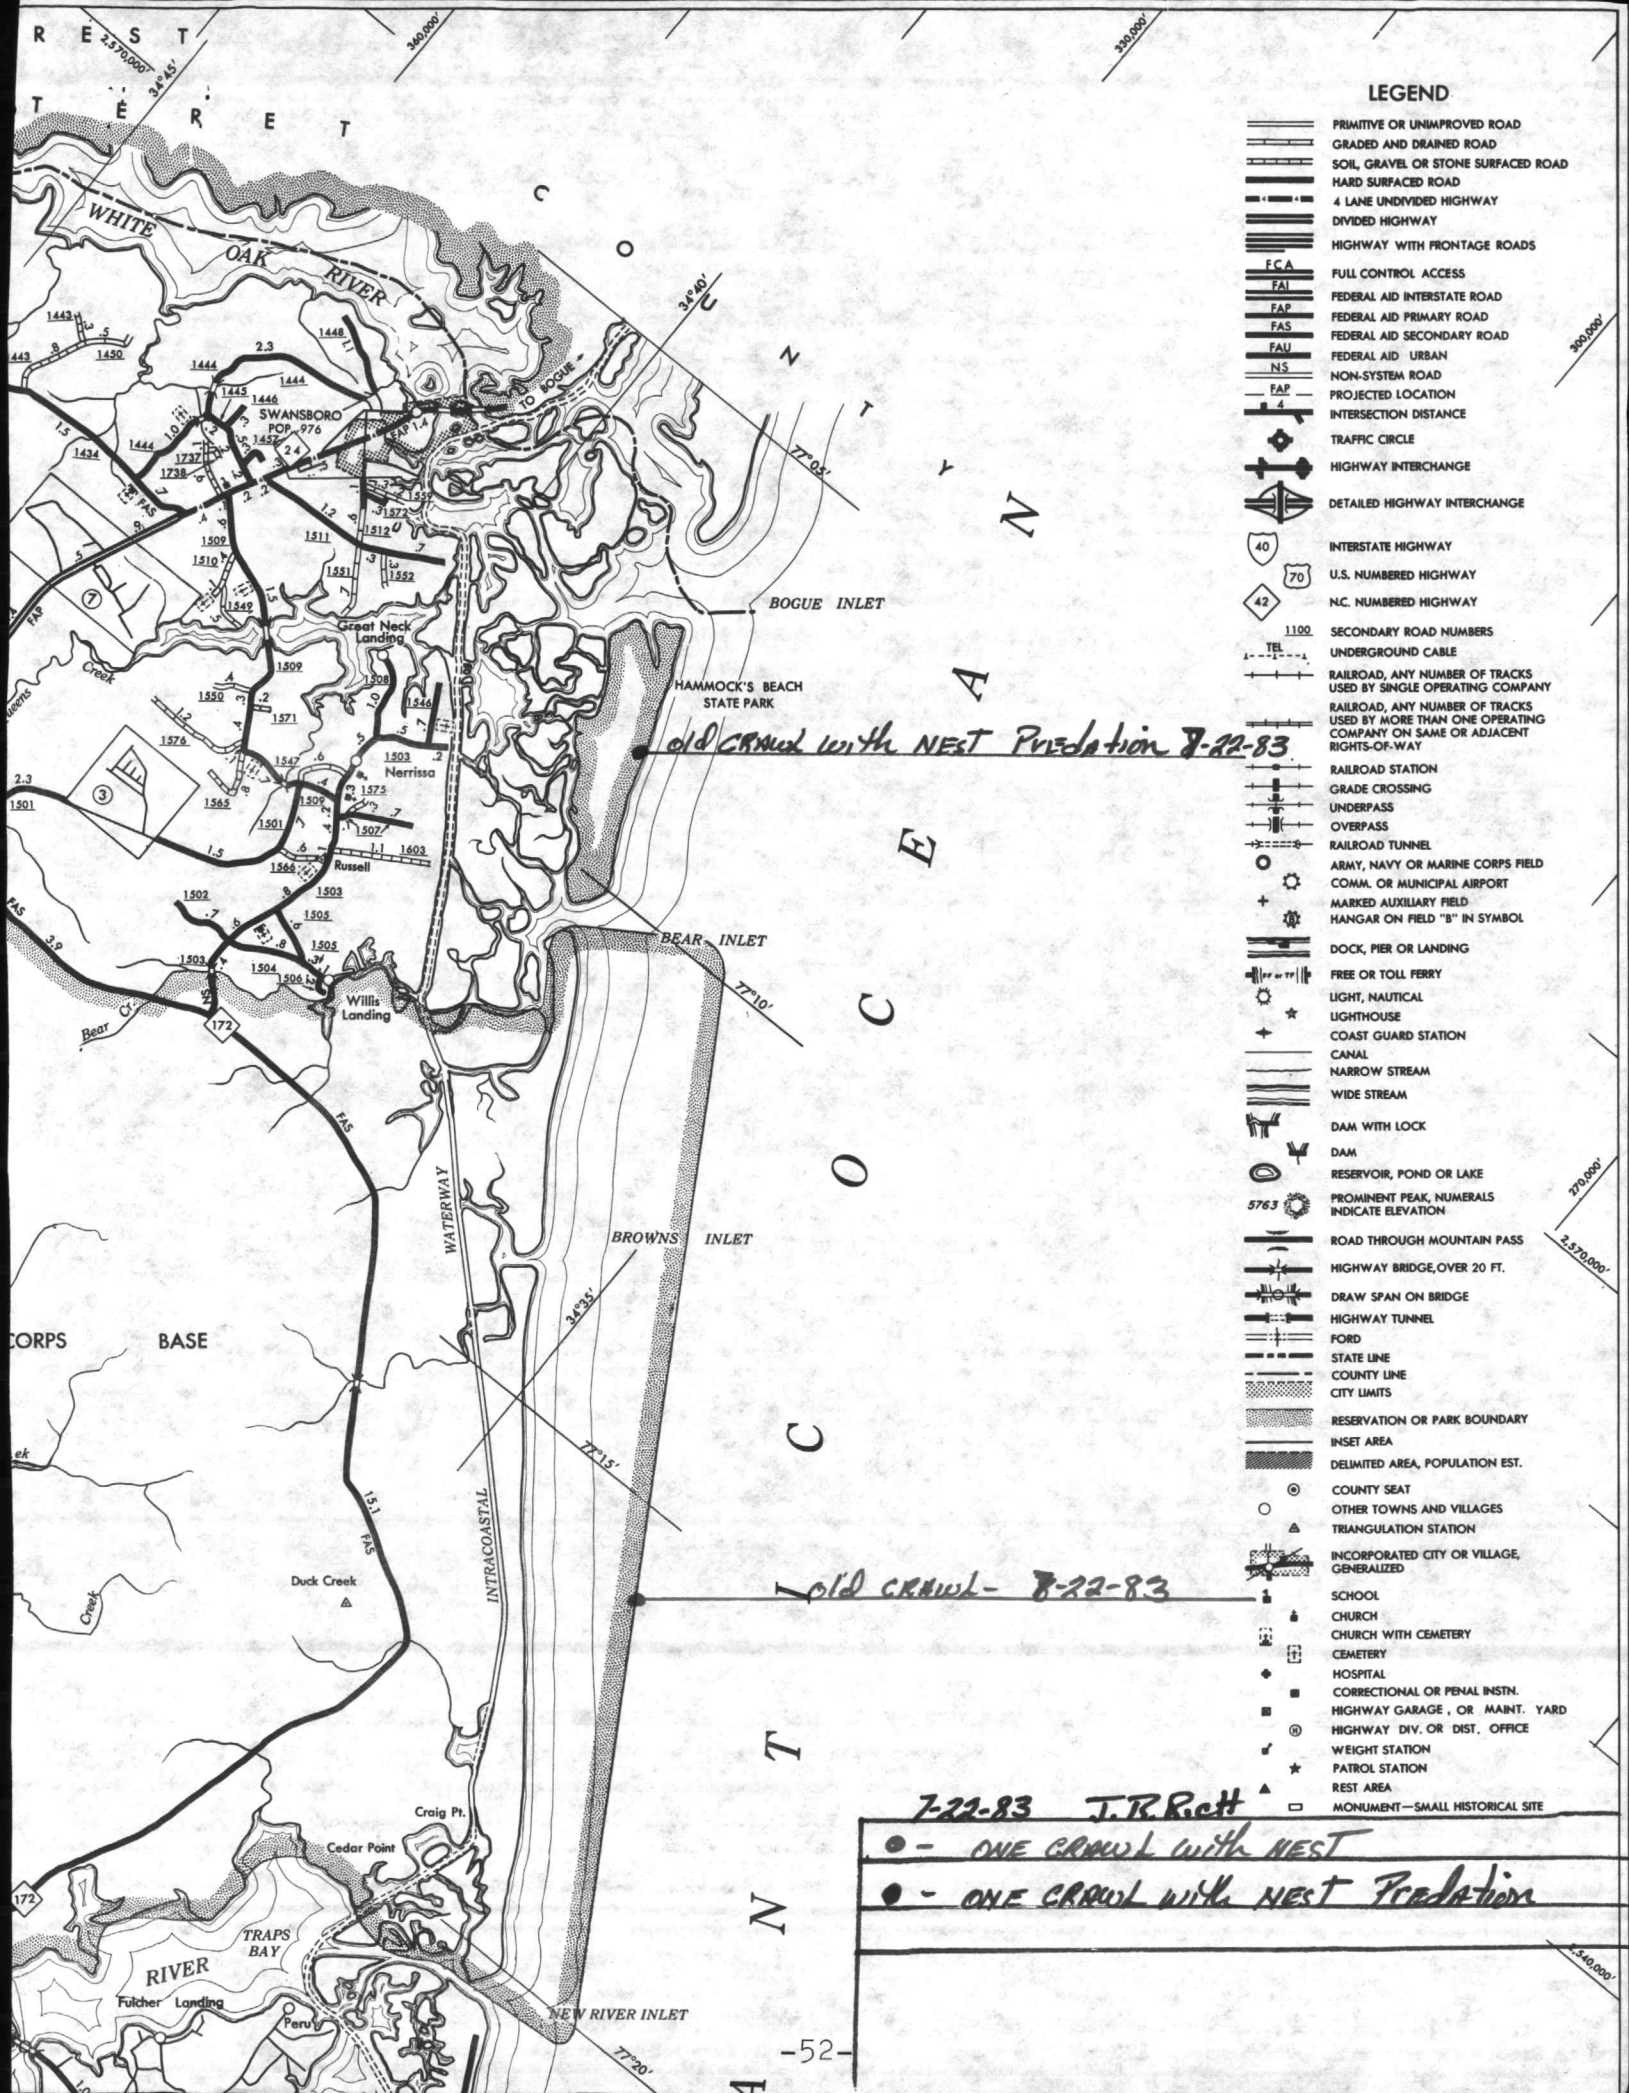


LEGEND

- PRIMITIVE OR UNIMPROVED ROAD
- GRADED AND DRAINED ROAD
- SOIL, GRAVEL OR STONE SURFACED ROAD
- HARD SURFACED ROAD
- 4 LANE UNDIVIDED HIGHWAY
- DIVIDED HIGHWAY
- HIGHWAY WITH FRONTAGE ROADS
- FCA FULL CONTROL ACCESS
- FAI FEDERAL AID INTERSTATE ROAD
- FAP FEDERAL AID PRIMARY ROAD
- FAS FEDERAL AID SECONDARY ROAD
- FAU FEDERAL AID URBAN
- NS NON-SYSTEM ROAD
- FAP PROJECTED LOCATION
- INTERSECTION DISTANCE
- TRAFFIC CIRCLE
- HIGHWAY INTERCHANGE
- DETAILED HIGHWAY INTERCHANGE
- INTERSTATE HIGHWAY
- U.S. NUMBERED HIGHWAY
- N.C. NUMBERED HIGHWAY
- SECONDARY ROAD NUMBERS
- UNDERGROUND CABLE
- RAILROAD, ANY NUMBER OF TRACKS USED BY SINGLE OPERATING COMPANY
- RAILROAD, ANY NUMBER OF TRACKS USED BY MORE THAN ONE OPERATING COMPANY ON SAME OR ADJACENT RIGHTS-OF-WAY
- RAILROAD STATION
- GRADE CROSSING
- UNDERPASS
- OVERPASS
- RAILROAD TUNNEL
- ARMY, NAVY OR MARINE CORPS FIELD
- COMM. OR MUNICIPAL AIRPORT
- MARKED AUXILIARY FIELD
- HANGAR ON FIELD "B" IN SYMBOL
- DOCK, PIER OR LANDING
- FREE OR TOLL FERRY
- LIGHT, NAUTICAL
- LIGHTHOUSE
- COAST GUARD STATION
- CANAL
- NARROW STREAM
- WIDE STREAM
- DAM WITH LOCK
- DAM
- RESERVOIR, POND OR LAKE
- PROMINENT PEAK, NUMERALS INDICATE ELEVATION
- ROAD THROUGH MOUNTAIN PASS
- HIGHWAY BRIDGE, OVER 20 FT.
- DRAW SPAN ON BRIDGE
- HIGHWAY TUNNEL
- FORD
- STATE LINE
- COUNTY LINE
- CITY LIMITS
- RESERVATION OR PARK BOUNDARY
- INSET AREA
- DELIMITED AREA, POPULATION EST.
- COUNTY SEAT
- OTHER TOWNS AND VILLAGES
- TRIANGULATION STATION
- INCORPORATED CITY OR VILLAGE, GENERALIZED
- SCHOOL
- CHURCH
- CHURCH WITH CEMETERY
- CEMETERY
- HOSPITAL
- CORRECTIONAL OR PENAL INSTN.
- HIGHWAY GARAGE, OR MAINT. YARD
- HIGHWAY DIV. OR DIST. OFFICE
- WEIGHT STATION
- PATROL STATION
- REST AREA
- MONUMENT - SMALL HISTORICAL SITE

old crawl with NEST Predation 7-22-83

old crawl - 7-22-83

- 7-22-83 J.R. Rietz
- - ONE CRAWL with NEST
 - - ONE CRAWL with NEST Predation

 



NEST AND CRAWL ACTIVITY
ONSLow BEACH, MARINE CORPS BASE
CAMP LEJEUNE, NORTH CAROLINA

Nests - upper map

Crawls no nest - lower map

Dots indicates multiple usage

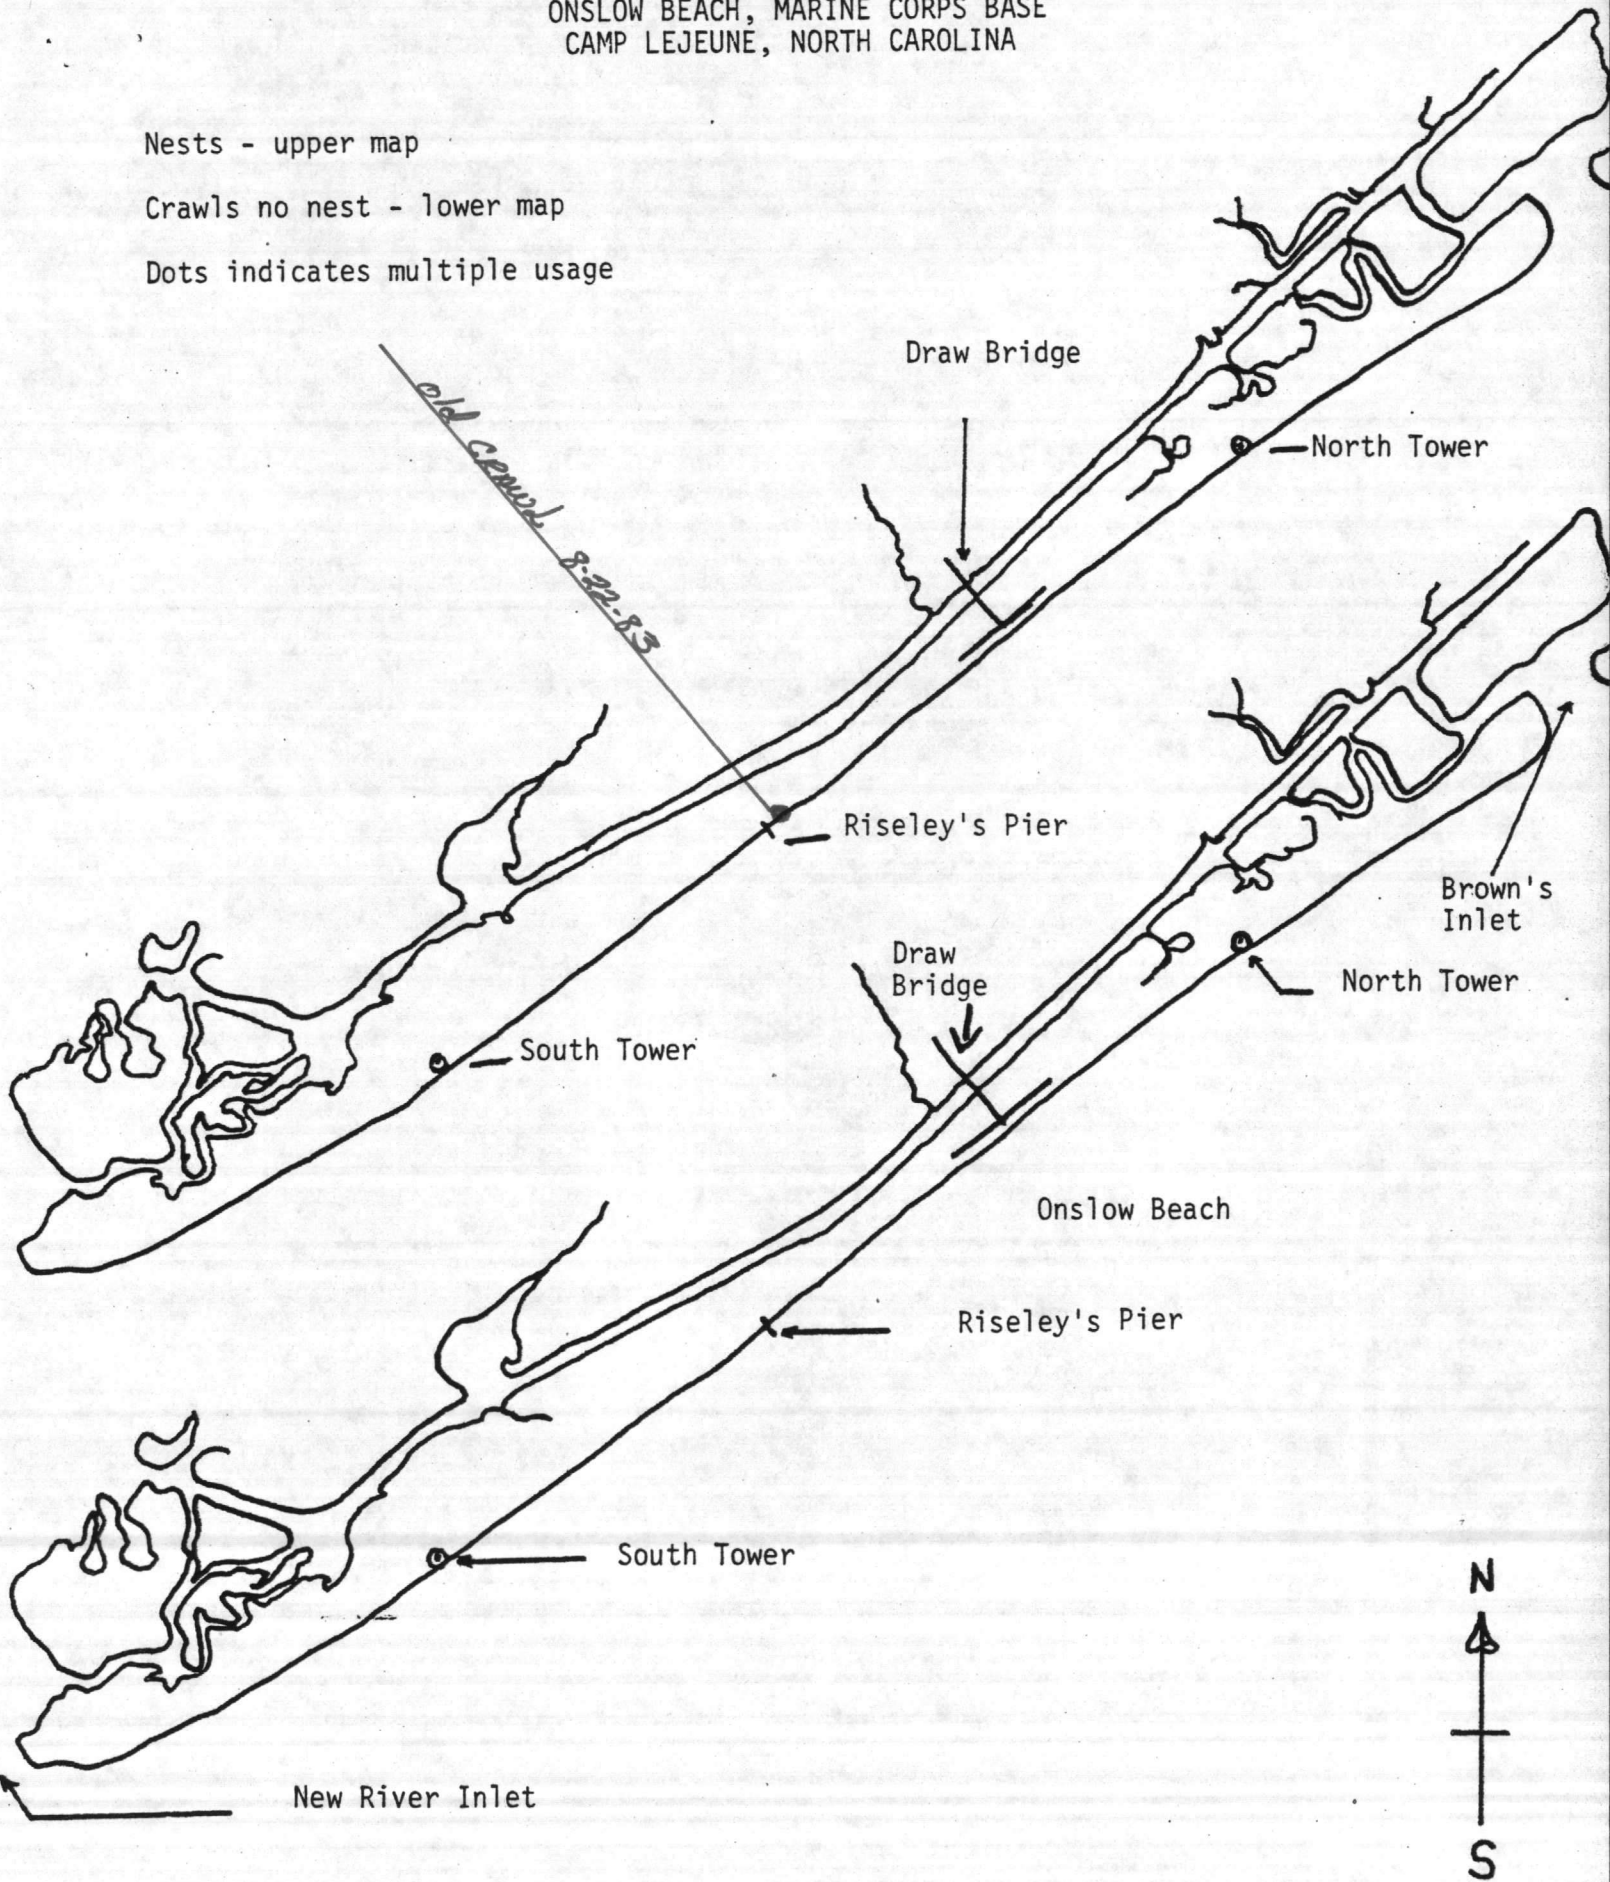

 

AERIAL SURVEY DATA

Date: July 27 1983 Time: S 06:10 F 08:10

Recorder Name: Jerry R. Rich

Crew Names: None Pilot: J. R. Rich

Co-Pilot: None Crew Chief: None

Others: None

Weather: General clear 7 miles vis Cloud Cover Clear

Wind Speed ENE 8-10 K Sea Conditions Light Chop

BEACH AERIAL SURVEYS Altitude 100 FT
Air Speed 60 K

Location	Crawls		Nests		Nest Predation	
	New	Old	New	Old	New	Old
Onslow Beach	0	0	0	0	0	0
Browns Island	0	0	1	1	2	0
Bear Beach	0	0	0	0	0	0

OCEAN AERIAL SURVEYS Altitude 300 Ft
Air Speed 60 K

	Live Turtles		Dead Turtles
	Juvenile	Adults	
Bell Buoy from Bogue Inlet to New River Inlet	None	None	None

Comments:























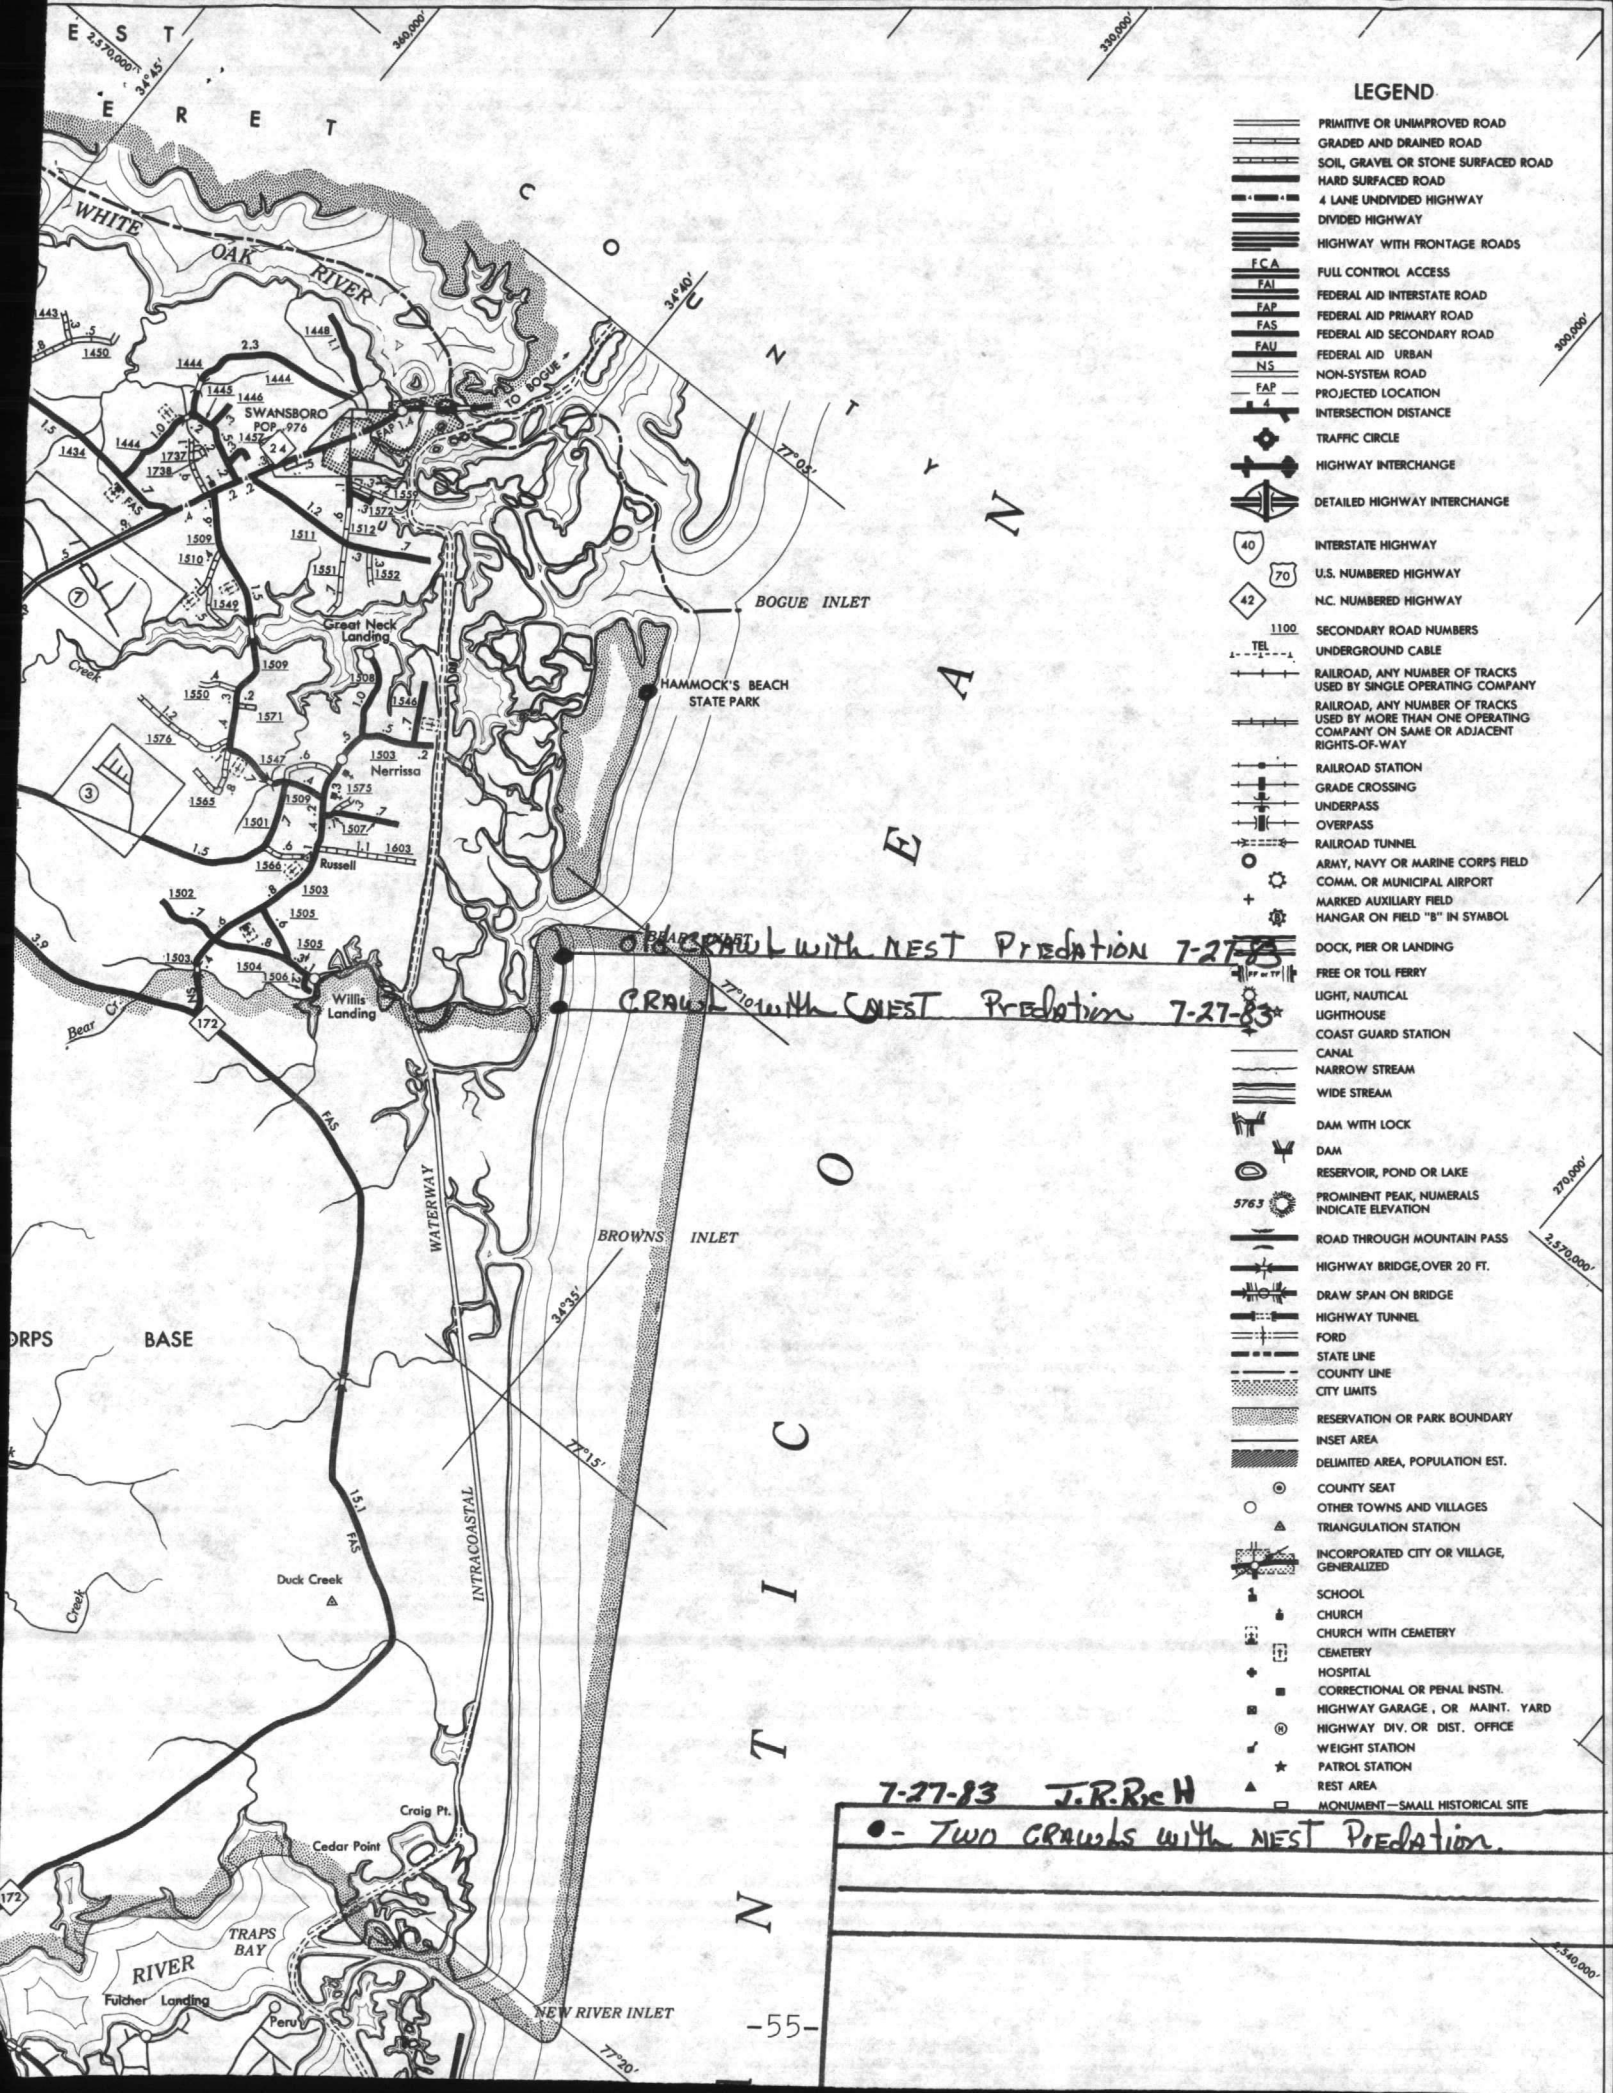


LEGEND

- PRIMITIVE OR UNIMPROVED ROAD
- GRADED AND DRAINED ROAD
- SOIL, GRAVEL OR STONE SURFACED ROAD
- HARD SURFACED ROAD
- 4 LANE UNDIVIDED HIGHWAY
- DIVIDED HIGHWAY
- HIGHWAY WITH FRONTAGE ROADS
- FCA FULL CONTROL ACCESS
- FAI FEDERAL AID INTERSTATE ROAD
- FAP FEDERAL AID PRIMARY ROAD
- FAS FEDERAL AID SECONDARY ROAD
- FAU FEDERAL AID URBAN
- NS NON-SYSTEM ROAD
- P4 PROJECTED LOCATION
- I4 INTERSECTION DISTANCE
- TC TRAFFIC CIRCLE
- HI HIGHWAY INTERCHANGE
- DHI DETAILED HIGHWAY INTERCHANGE
- I40 INTERSTATE HIGHWAY
- U.S. NUMBERED HIGHWAY
- N.C. NUMBERED HIGHWAY
- 1100 SECONDARY ROAD NUMBERS
- TEL UNDERGROUND CABLE
- RR RAILROAD, ANY NUMBER OF TRACKS USED BY SINGLE OPERATING COMPANY
- RR RAILROAD, ANY NUMBER OF TRACKS USED BY MORE THAN ONE OPERATING COMPANY ON SAME OR ADJACENT RIGHTS-OF-WAY
- RR RAILROAD STATION
- GC GRADE CROSSING
- UP UNDERPASS
- OP OVERPASS
- RT RAILROAD TUNNEL
- A/N/M COMM. OR MUNICIPAL AIRPORT
- A/N/M MARKED AUXILIARY FIELD HANGAR ON FIELD "B" IN SYMBOL
- DP DOCK, PIER OR LANDING
- FF FREE OR TOLL FERRY
- LN LIGHT, NAUTICAL
- LH LIGHTHOUSE
- CGS COAST GUARD STATION
- C CANAL
- NS NARROW STREAM
- WS WIDE STREAM
- DL DAM WITH LOCK
- D DAM
- R/P/L RESERVOIR, POND OR LAKE
- 576.3 PROMINENT PEAK, NUMERALS INDICATE ELEVATION
- RMP ROAD THROUGH MOUNTAIN PASS
- HB HIGHWAY BRIDGE, OVER 20 FT.
- DS DRAW SPAN ON BRIDGE
- HT HIGHWAY TUNNEL
- F FORD
- SL STATE LINE
- CL COUNTY LINE
- CL CITY LIMITS
- RP RESERVATION OR PARK BOUNDARY
- IA INSET AREA
- DA DELIMITED AREA, POPULATION EST.
- CS COUNTY SEAT
- OTV OTHER TOWNS AND VILLAGES
- TS TRIANGULATION STATION
- ICIV INCORPORATED CITY OR VILLAGE, GENERALIZED
- S SCHOOL
- CH CHURCH
- CHC CHURCH WITH CEMETERY
- CEM CEMETERY
- H HOSPITAL
- CPI CORRECTIONAL OR PENAL INSTN.
- HGYG HIGHWAY GARAGE, OR MAINT. YARD
- HDO HIGHWAY DIV. OR DIST. OFFICE
- WS WEIGHT STATION
- PS PATROL STATION
- RA REST AREA
- M-SHS MONUMENT - SMALL HISTORICAL SITE

7-27-83
 7-27-83
 7-27-83

7-27-83 J.R.R.H
 • - Two Crawls with NEST Predation.

 













Comments:


























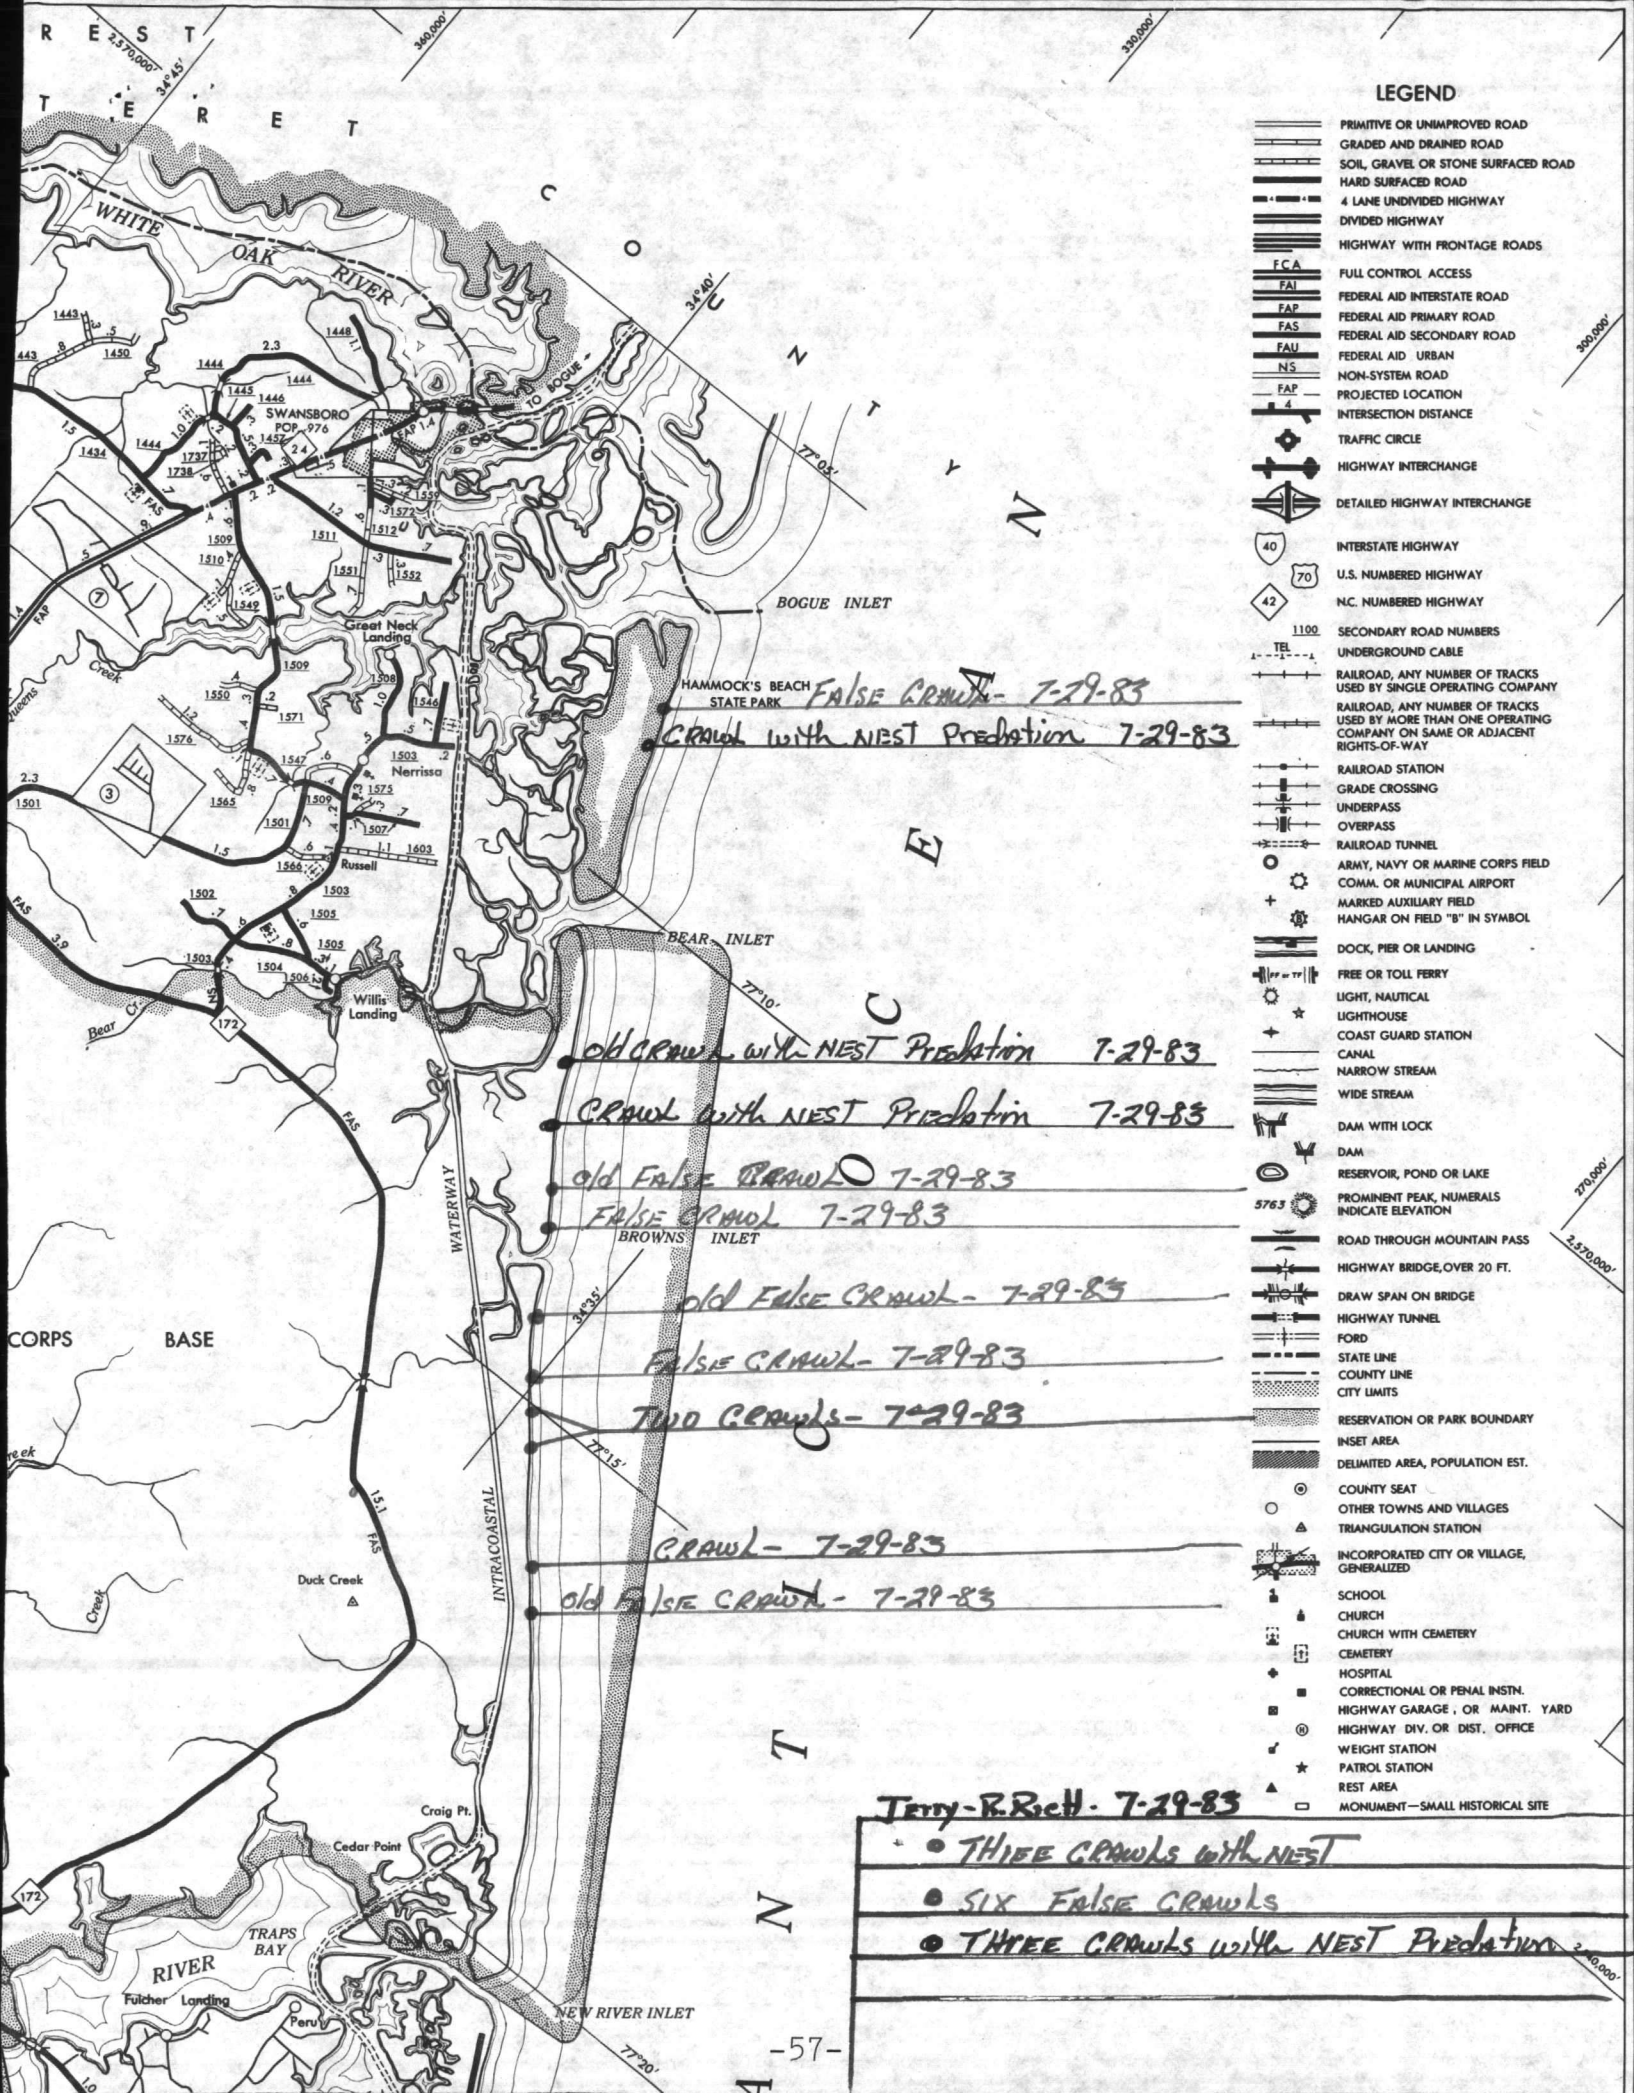

LEGEND

- PRIMITIVE OR UNIMPROVED ROAD
- GRADED AND DRAINED ROAD
- SOIL, GRAVEL OR STONE SURFACED ROAD
- HARD SURFACED ROAD
- 4 LANE UNDIVIDED HIGHWAY
- DIVIDED HIGHWAY
- HIGHWAY WITH FRONTAGE ROADS
- FCA FULL CONTROL ACCESS
- FAI FEDERAL AID INTERSTATE ROAD
- FAP FEDERAL AID PRIMARY ROAD
- FAS FEDERAL AID SECONDARY ROAD
- FAU FEDERAL AID URBAN
- NS NON-SYSTEM ROAD
- FAP PROJECTED LOCATION
- INTERSECTION DISTANCE
- TRAFFIC CIRCLE
- HIGHWAY INTERCHANGE
- DETAILED HIGHWAY INTERCHANGE
- INTERSTATE HIGHWAY
- U.S. NUMBERED HIGHWAY
- N.C. NUMBERED HIGHWAY
- SECONDARY ROAD NUMBERS
- UNDERGROUND CABLE
- RAILROAD, ANY NUMBER OF TRACKS USED BY SINGLE OPERATING COMPANY
- RAILROAD, ANY NUMBER OF TRACKS USED BY MORE THAN ONE OPERATING COMPANY ON SAME OR ADJACENT RIGHTS-OF-WAY
- RAILROAD STATION
- GRADE CROSSING
- UNDERPASS
- OVERPASS
- RAILROAD TUNNEL
- ARMY, NAVY OR MARINE CORPS FIELD COMM. OR MUNICIPAL AIRPORT
- MARKED AUXILIARY FIELD HANGAR ON FIELD "B" IN SYMBOL
- DOCK, PIER OR LANDING
- FREE OR TOLL FERRY
- LIGHT, NAUTICAL
- LIGHTHOUSE
- COAST GUARD STATION
- CANAL
- NARROW STREAM
- WIDE STREAM
- DAM WITH LOCK
- DAM
- RESERVOIR, POND OR LAKE
- PROMINENT PEAK, NUMERALS INDICATE ELEVATION
- ROAD THROUGH MOUNTAIN PASS
- HIGHWAY BRIDGE, OVER 20 FT.
- DRAW SPAN ON BRIDGE
- HIGHWAY TUNNEL
- FORD
- STATE LINE
- COUNTY LINE
- CITY LIMITS
- RESERVATION OR PARK BOUNDARY
- INSET AREA
- DELIMITED AREA, POPULATION EST.
- COUNTY SEAT
- OTHER TOWNS AND VILLAGES
- TRIANGULATION STATION
- INCORPORATED CITY OR VILLAGE, GENERALIZED
- SCHOOL
- CHURCH
- CHURCH WITH CEMETERY
- CEMETERY
- HOSPITAL
- CORRECTIONAL OR PENAL INSTN.
- HIGHWAY GARAGE, OR MAINT. YARD
- HIGHWAY DIV. OR DIST. OFFICE
- WEIGHT STATION
- PATROL STATION
- REST AREA
- MONUMENT - SMALL HISTORICAL SITE

FALSE CRAWL - 7-29-83
 Crawl with NEST Predation 7-29-83
 Old Crawl with NEST Predation 7-29-83
 Crawl with NEST Predation 7-29-83
 Old False Crawl - 7-29-83
 FALSE CRAWL 7-29-83
 Old False Crawl - 7-29-83
 False Crawl - 7-29-83
 Two Crawls - 7-29-83
 Crawl - 7-29-83
 Old False Crawl - 7-29-83

Terry-R. Rich - 7-29-83


- THREE CRAWLS with NEST
- SIX FALSE CRAWLS
- THREE CRAWLS with NEST Predation


[Faint, illegible handwriting on lined paper]


NEST AND CRAWL ACTIVITY
 ONSLOW BEACH, MARINE CORPS BASE
 CAMP LEJEUNE, NORTH CAROLINA

Nests - upper map
 Crawls no nest - lower map
 Dots indicates multiple usage

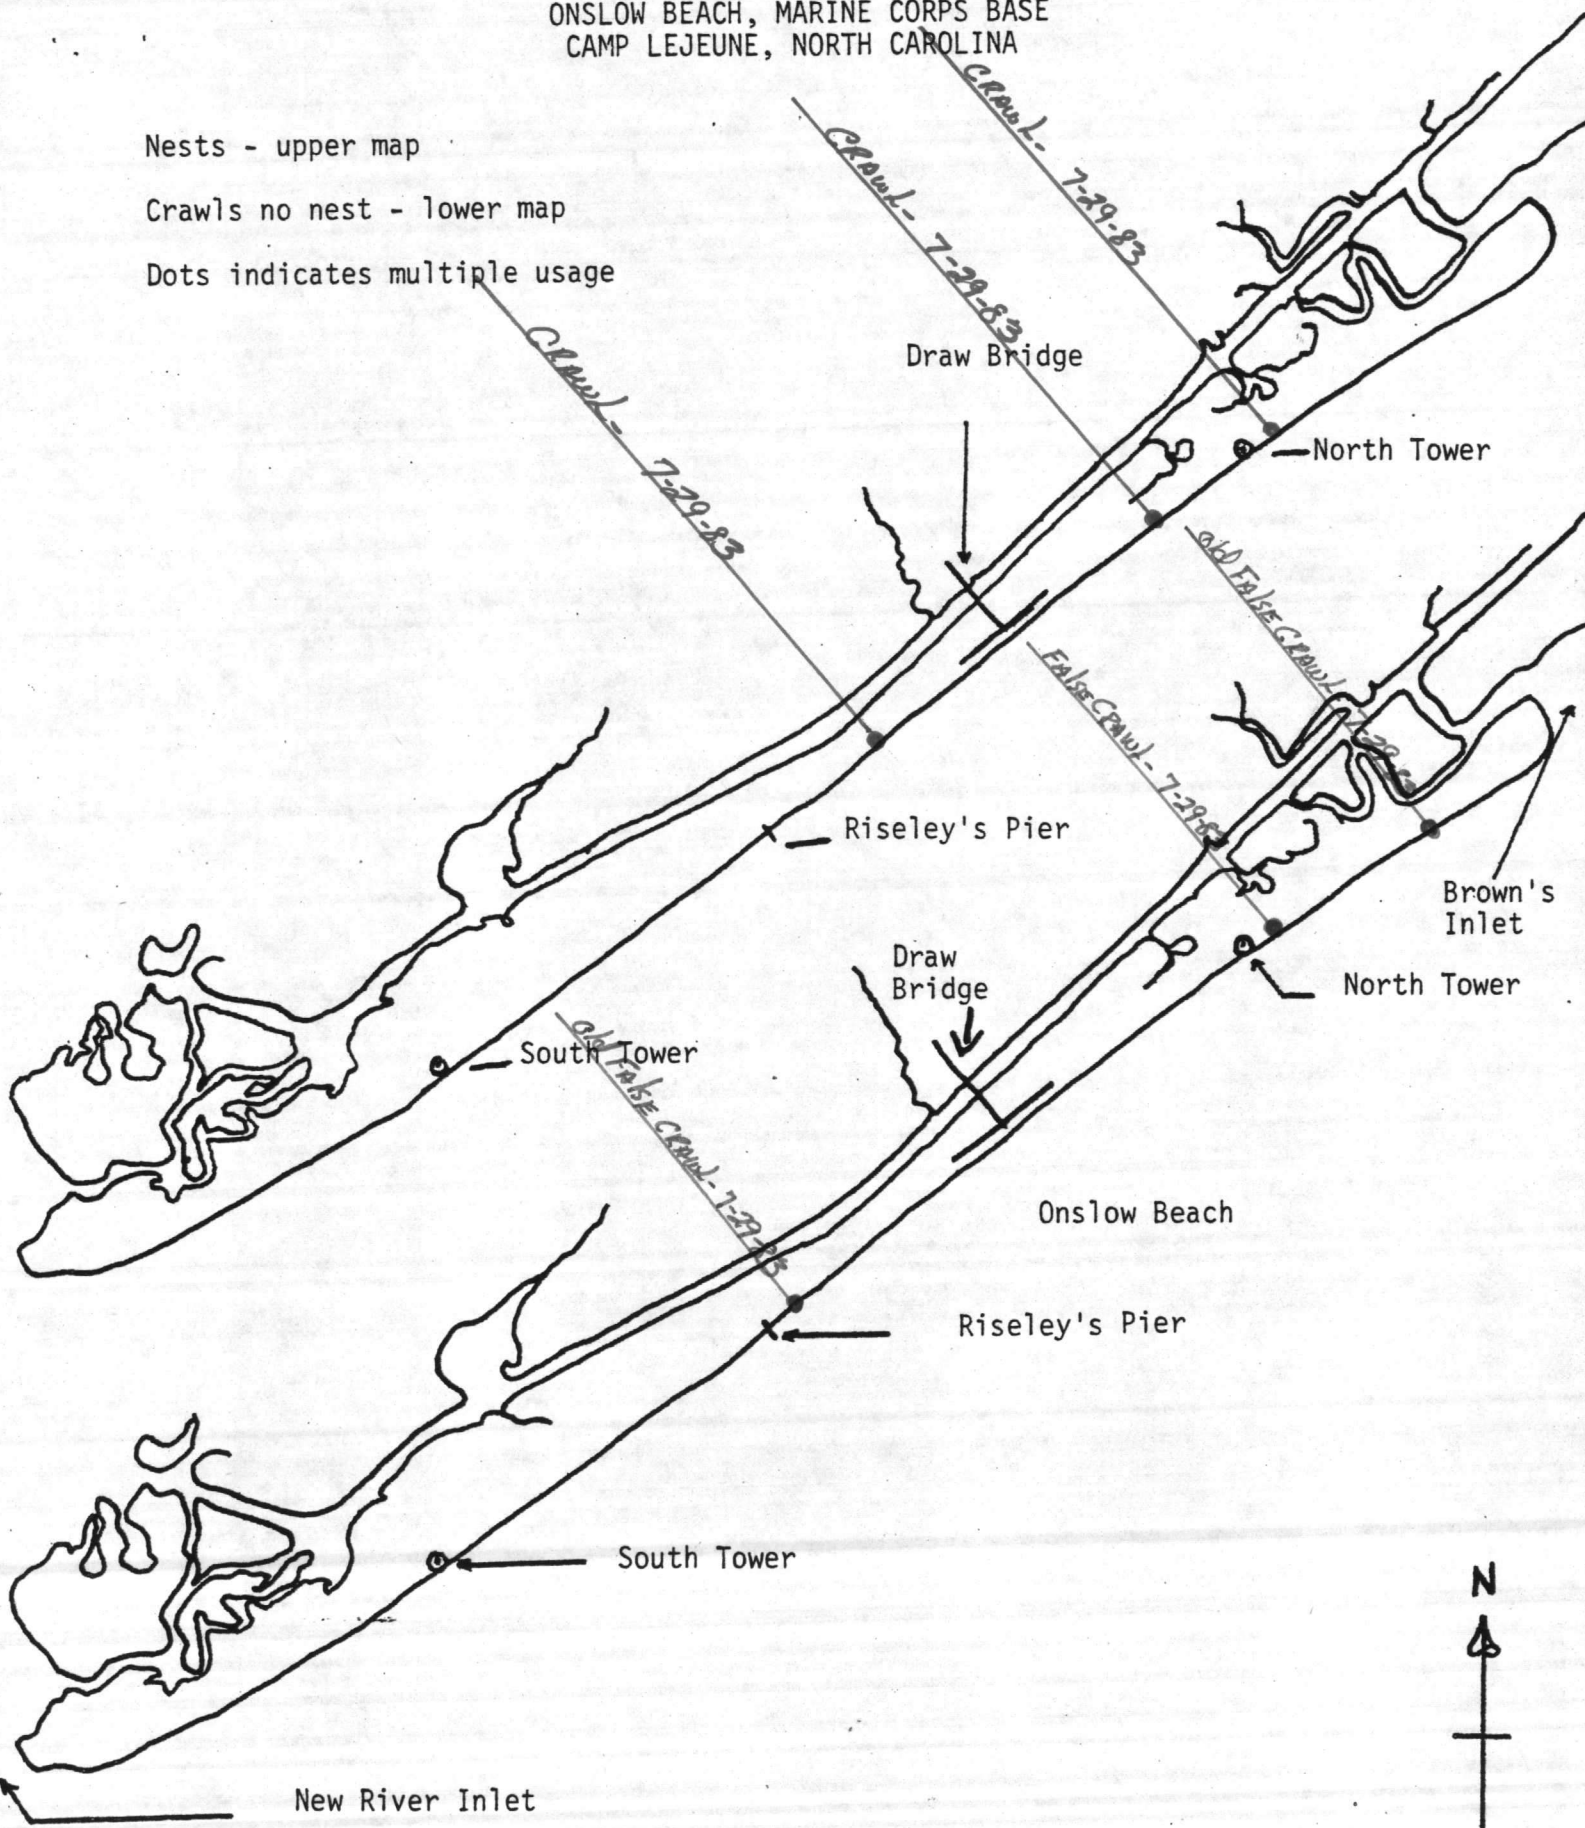

 

AERIAL SURVEY DATA

Date: August 4 1983 Time: S 06:13 F 08:20

Recorder Name: Jerry R. Rich

Crew Names: None Pilot: J. R. Rich

Co-Pilot: None Crew Chief: None

Others: None

Weather: General 1000 Bkn Rain Cloud Cover 1000 BKN

Wind Speed Calm Sea Conditions Calm

BEACH AERIAL SURVEYS Altitude 100 Ft
Air Speed 60 K

Location	Crawls		Nests		Nest Predation	
	New	Old	New	Old	New	Old
Onslow Beach	1	0	1	0	0	0
Browns Island	2	0	0	4	2	0
Bear Beach	0	0	2	1	0	0

OCEAN AERIAL SURVEYS Altitude 300 Ft
Air Speed 60 K

	Live Turtles		Dead Turtles
	Juvenile	Adults	
Bell Buoy from Bogue Inlet to New River Inlet	None	None	None

Comments:






































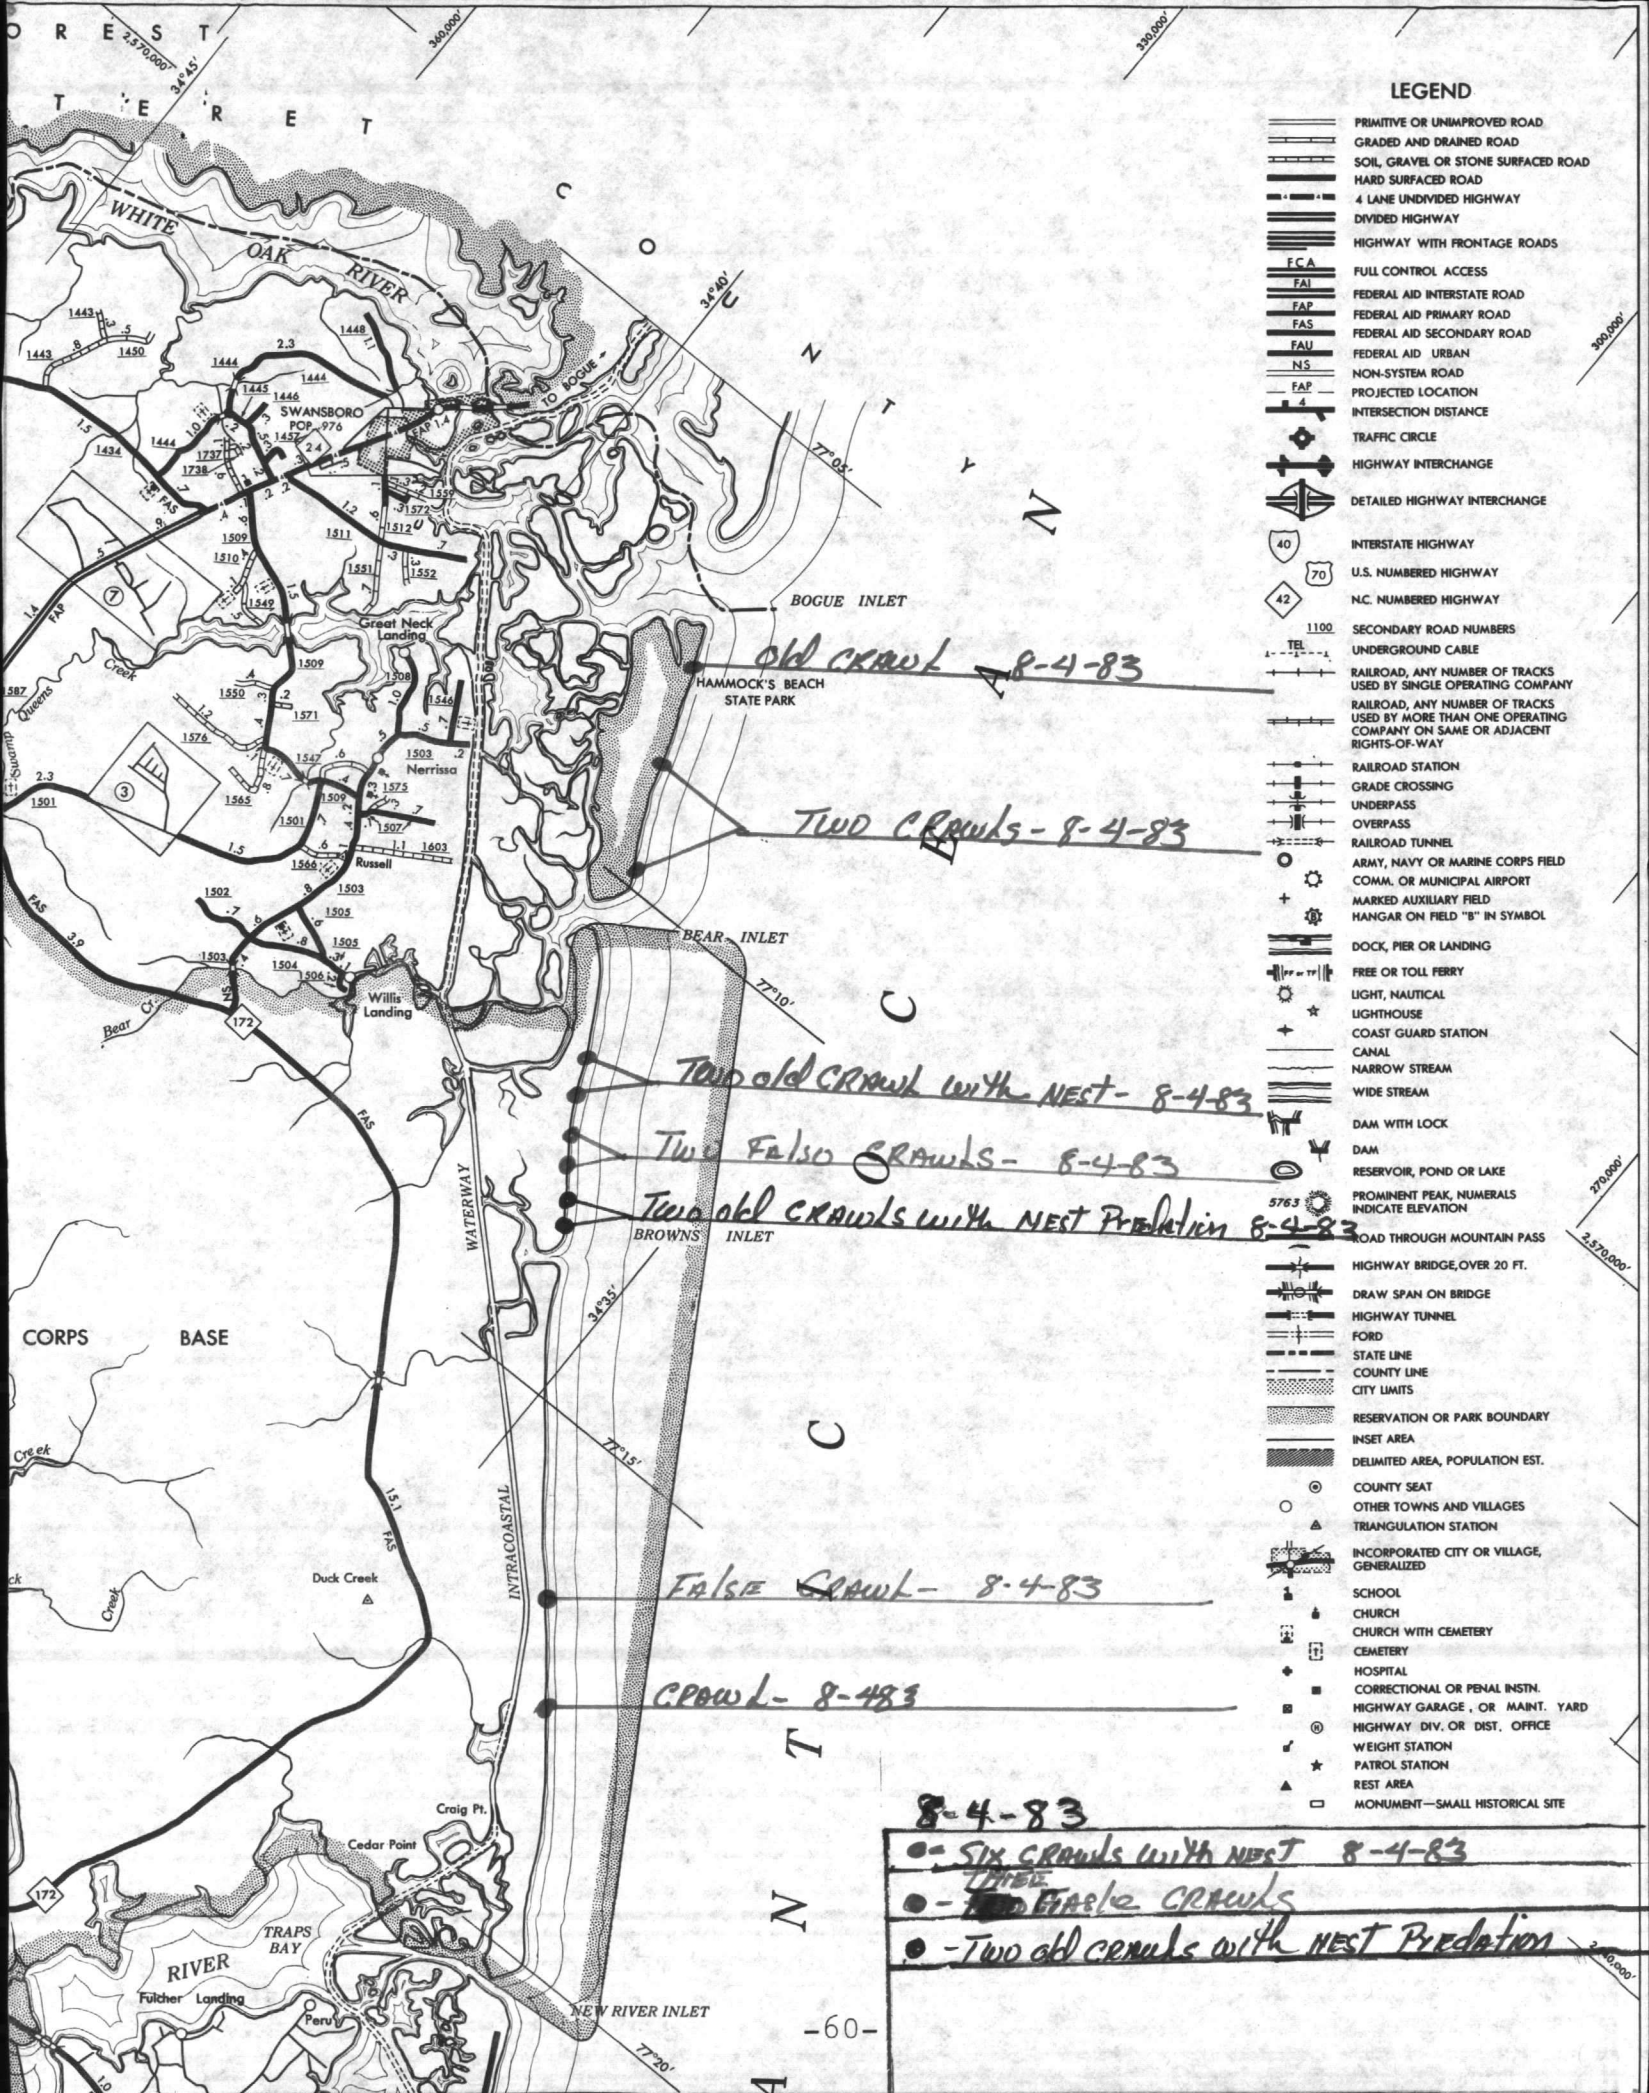

LEGEND

- PRIMITIVE OR UNIMPROVED ROAD
- GRADED AND DRAINED ROAD
- SOIL, GRAVEL OR STONE SURFACED ROAD
- HARD SURFACED ROAD
- 4 LANE UNDIVIDED HIGHWAY
- DIVIDED HIGHWAY
- HIGHWAY WITH FRONTAGE ROADS
- FCA FULL CONTROL ACCESS
- FAI FEDERAL AID INTERSTATE ROAD
- FAP FEDERAL AID PRIMARY ROAD
- FAS FEDERAL AID SECONDARY ROAD
- FAU FEDERAL AID URBAN
- NS NON-SYSTEM ROAD
- FAP PROJECTED LOCATION
- INTERSECTION DISTANCE
- TRAFFIC CIRCLE
- HIGHWAY INTERCHANGE
- DETAILED HIGHWAY INTERCHANGE
- INTERSTATE HIGHWAY
- U.S. NUMBERED HIGHWAY
- N.C. NUMBERED HIGHWAY
- SECONDARY ROAD NUMBERS
- UNDERGROUND CABLE
- RAILROAD, ANY NUMBER OF TRACKS USED BY SINGLE OPERATING COMPANY
- RAILROAD, ANY NUMBER OF TRACKS USED BY MORE THAN ONE OPERATING COMPANY ON SAME OR ADJACENT RIGHTS-OF-WAY
- RAILROAD STATION
- GRADE CROSSING
- UNDERPASS
- OVERPASS
- RAILROAD TUNNEL
- ARMY, NAVY OR MARINE CORPS FIELD COMM. OR MUNICIPAL AIRPORT
- MARKED AUXILIARY FIELD HANGAR ON FIELD "B" IN SYMBOL
- DOCK, PIER OR LANDING
- FREE OR TOLL FERRY
- LIGHT, NAUTICAL
- LIGHTHOUSE
- COAST GUARD STATION
- CANAL
- NARROW STREAM
- WIDE STREAM
- DAM WITH LOCK
- DAM
- RESERVOIR, POND OR LAKE
- PROMINENT PEAK, NUMERALS INDICATE ELEVATION
- ROAD THROUGH MOUNTAIN PASS
- HIGHWAY BRIDGE, OVER 20 FT.
- DRAW SPAN ON BRIDGE
- HIGHWAY TUNNEL
- FORD
- STATE LINE
- COUNTY LINE
- CITY LIMITS
- RESERVATION OR PARK BOUNDARY
- INSET AREA
- DELIMITED AREA, POPULATION EST.
- COUNTY SEAT
- OTHER TOWNS AND VILLAGES
- TRIANGULATION STATION
- INCORPORATED CITY OR VILLAGE, GENERALIZED
- SCHOOL
- CHURCH
- CHURCH WITH CEMETERY
- CEMETERY
- HOSPITAL
- CORRECTIONAL OR PENAL INSTN.
- HIGHWAY GARAGE, OR MAINT. YARD
- HIGHWAY DIV. OR DIST. OFFICE
- WEIGHT STATION
- PATROL STATION
- REST AREA
- MONUMENT - SMALL HISTORICAL SITE

old crawl - 8-4-83

TWO CRAWLS - 8-4-83

Two old CRAWL with NEST - 8-4-83

Two False CRAWLS - 8-4-83


Two old CRAWLS with NEST Predation 8-4-83

FALSE CRAWL - 8-4-83

CRAWL - 8-4-83

8-4-83

- - Six CRAWLS with NEST 8-4-83
- - ~~Two~~ False CRAWLS
- - Two old CRAWLS with NEST Predation

 


12-1-19	12-1-19


NEST AND CRAWL ACTIVITY
ONSLow BEACH, MARINE CORPS BASE
CAMP LEJEUNE, NORTH CAROLINA

Nests - upper map

Crawls no nest - lower map

Dots indicates multiple usage

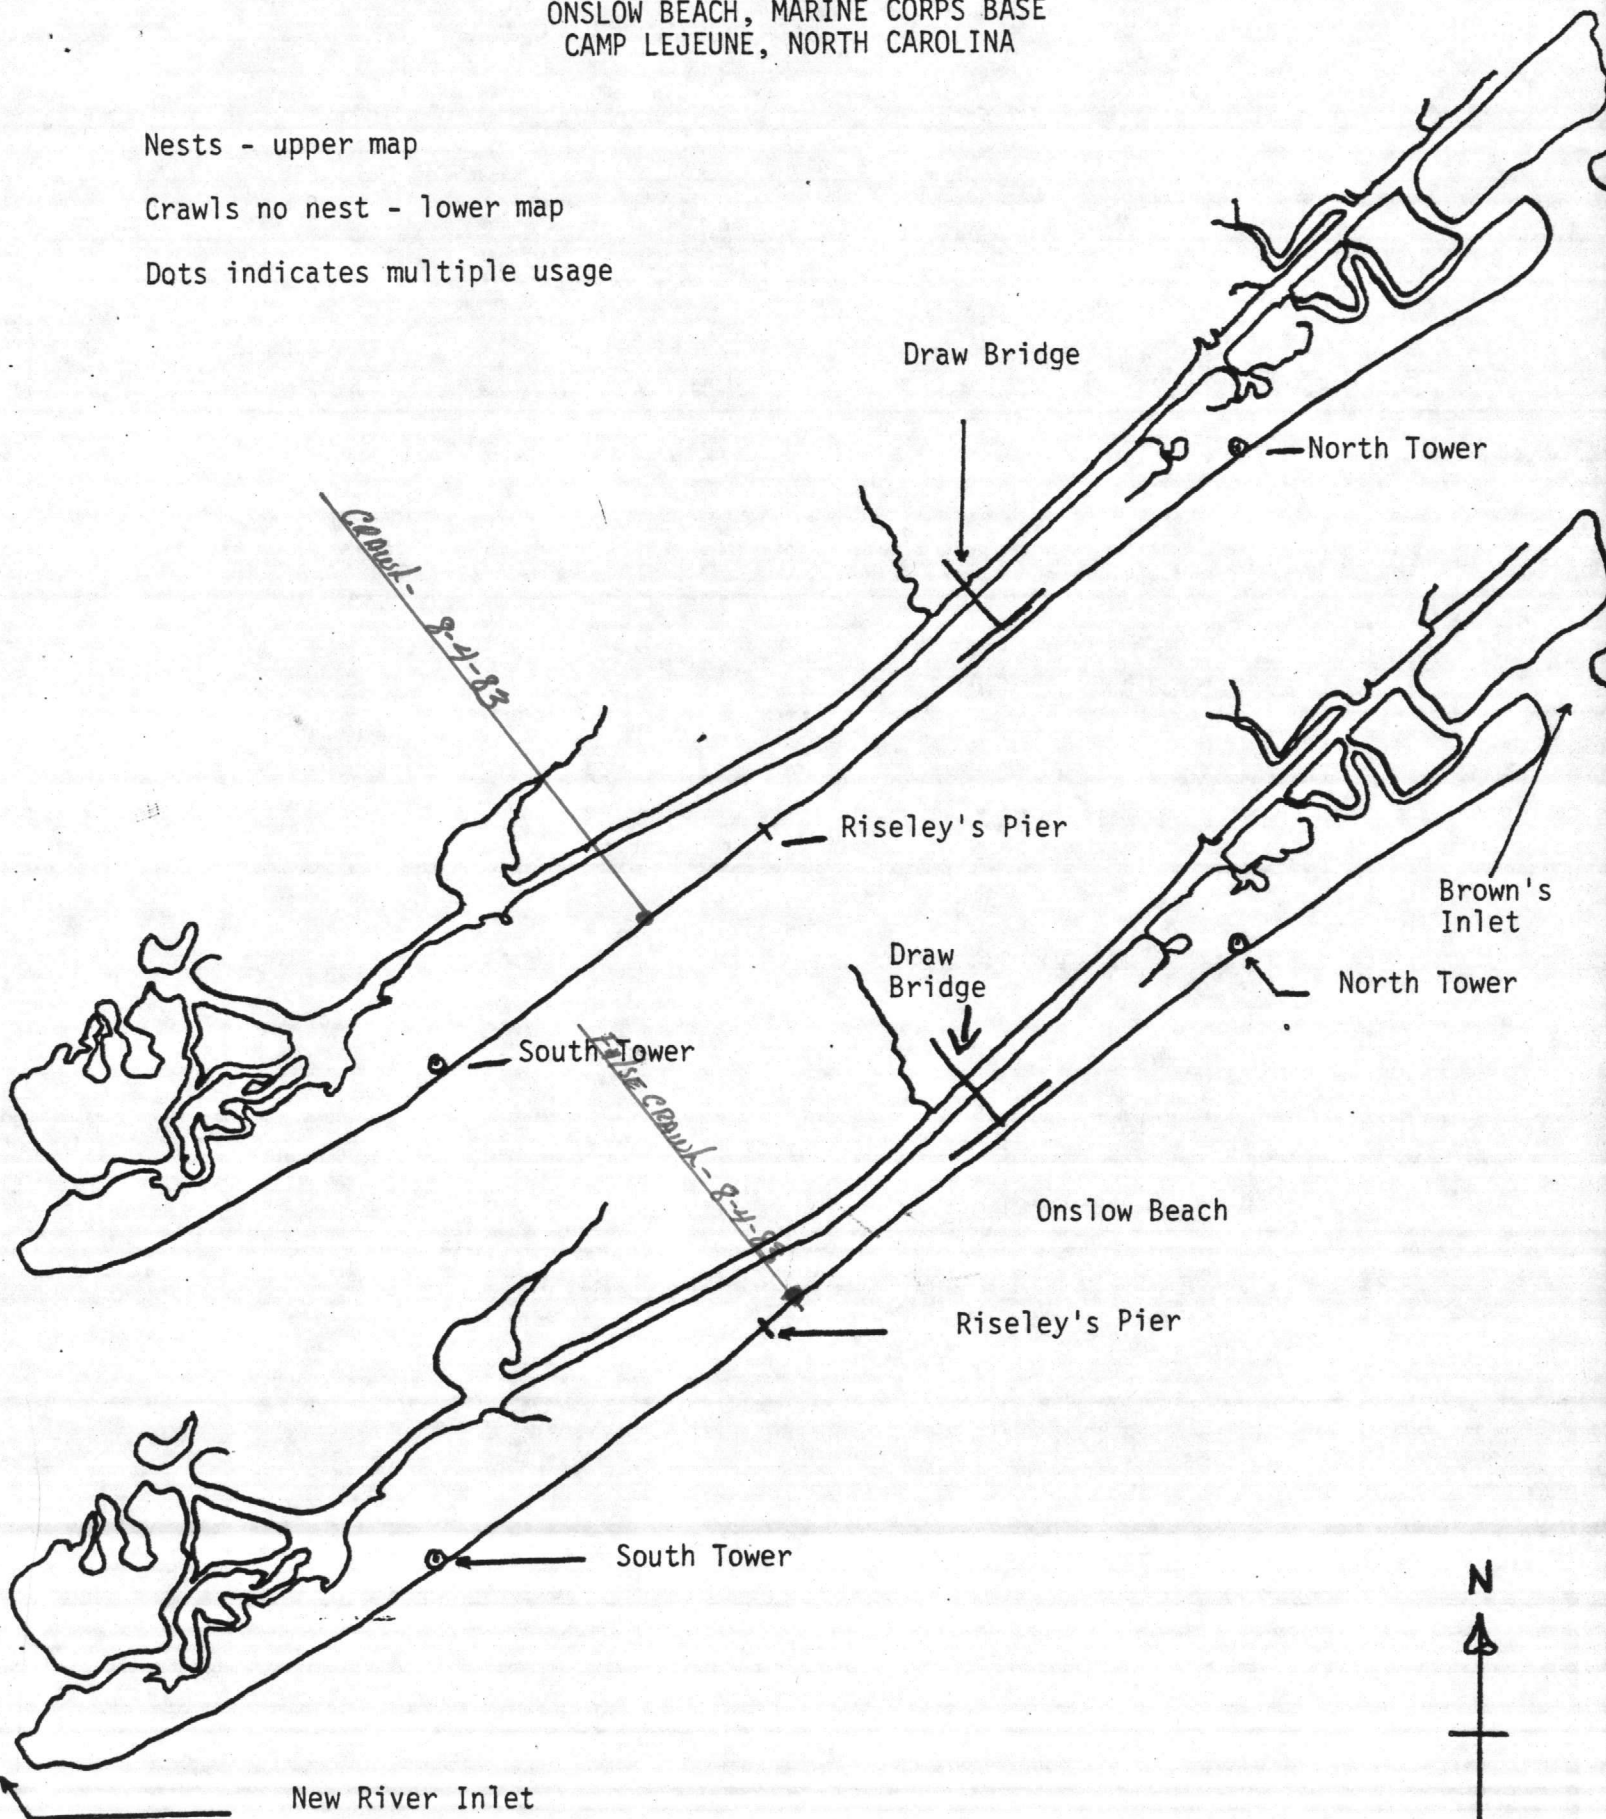

 

AERIAL SURVEY DATA

Date: August 9 1983 Time: S 06:10 F 08:12

Recorder Name: Jerry R. Rich

Crew Names: None Pilot: J. R. Rich

Co-Pilot: None Crew Chief: None

Others: None

Weather: General 2-3 miles fog & haze Cloud Cover Clear

Wind Speed SW 8 K Sea Conditions Light chop

BEACH AERIAL SURVEYS Altitude 100 Ft
Air Speed 60 K

Location	Crawls		Nests		Nest Predation	
	New	Old	New	Old	New	Old
Onslow Beach	1	0	0	0	0	0
Browns Island	1	0	4	0	3	0
Bear Beach	0	0	1	0	0	0

OCEAN AERIAL SURVEYS Altitude 300 Ft
Air Speed 60 K

	Live Turtles		Dead Turtles
	Juvenile	Adults	
Bell Buoy from Bogue Inlet to New River Inlet	None	None	None

Comments:



































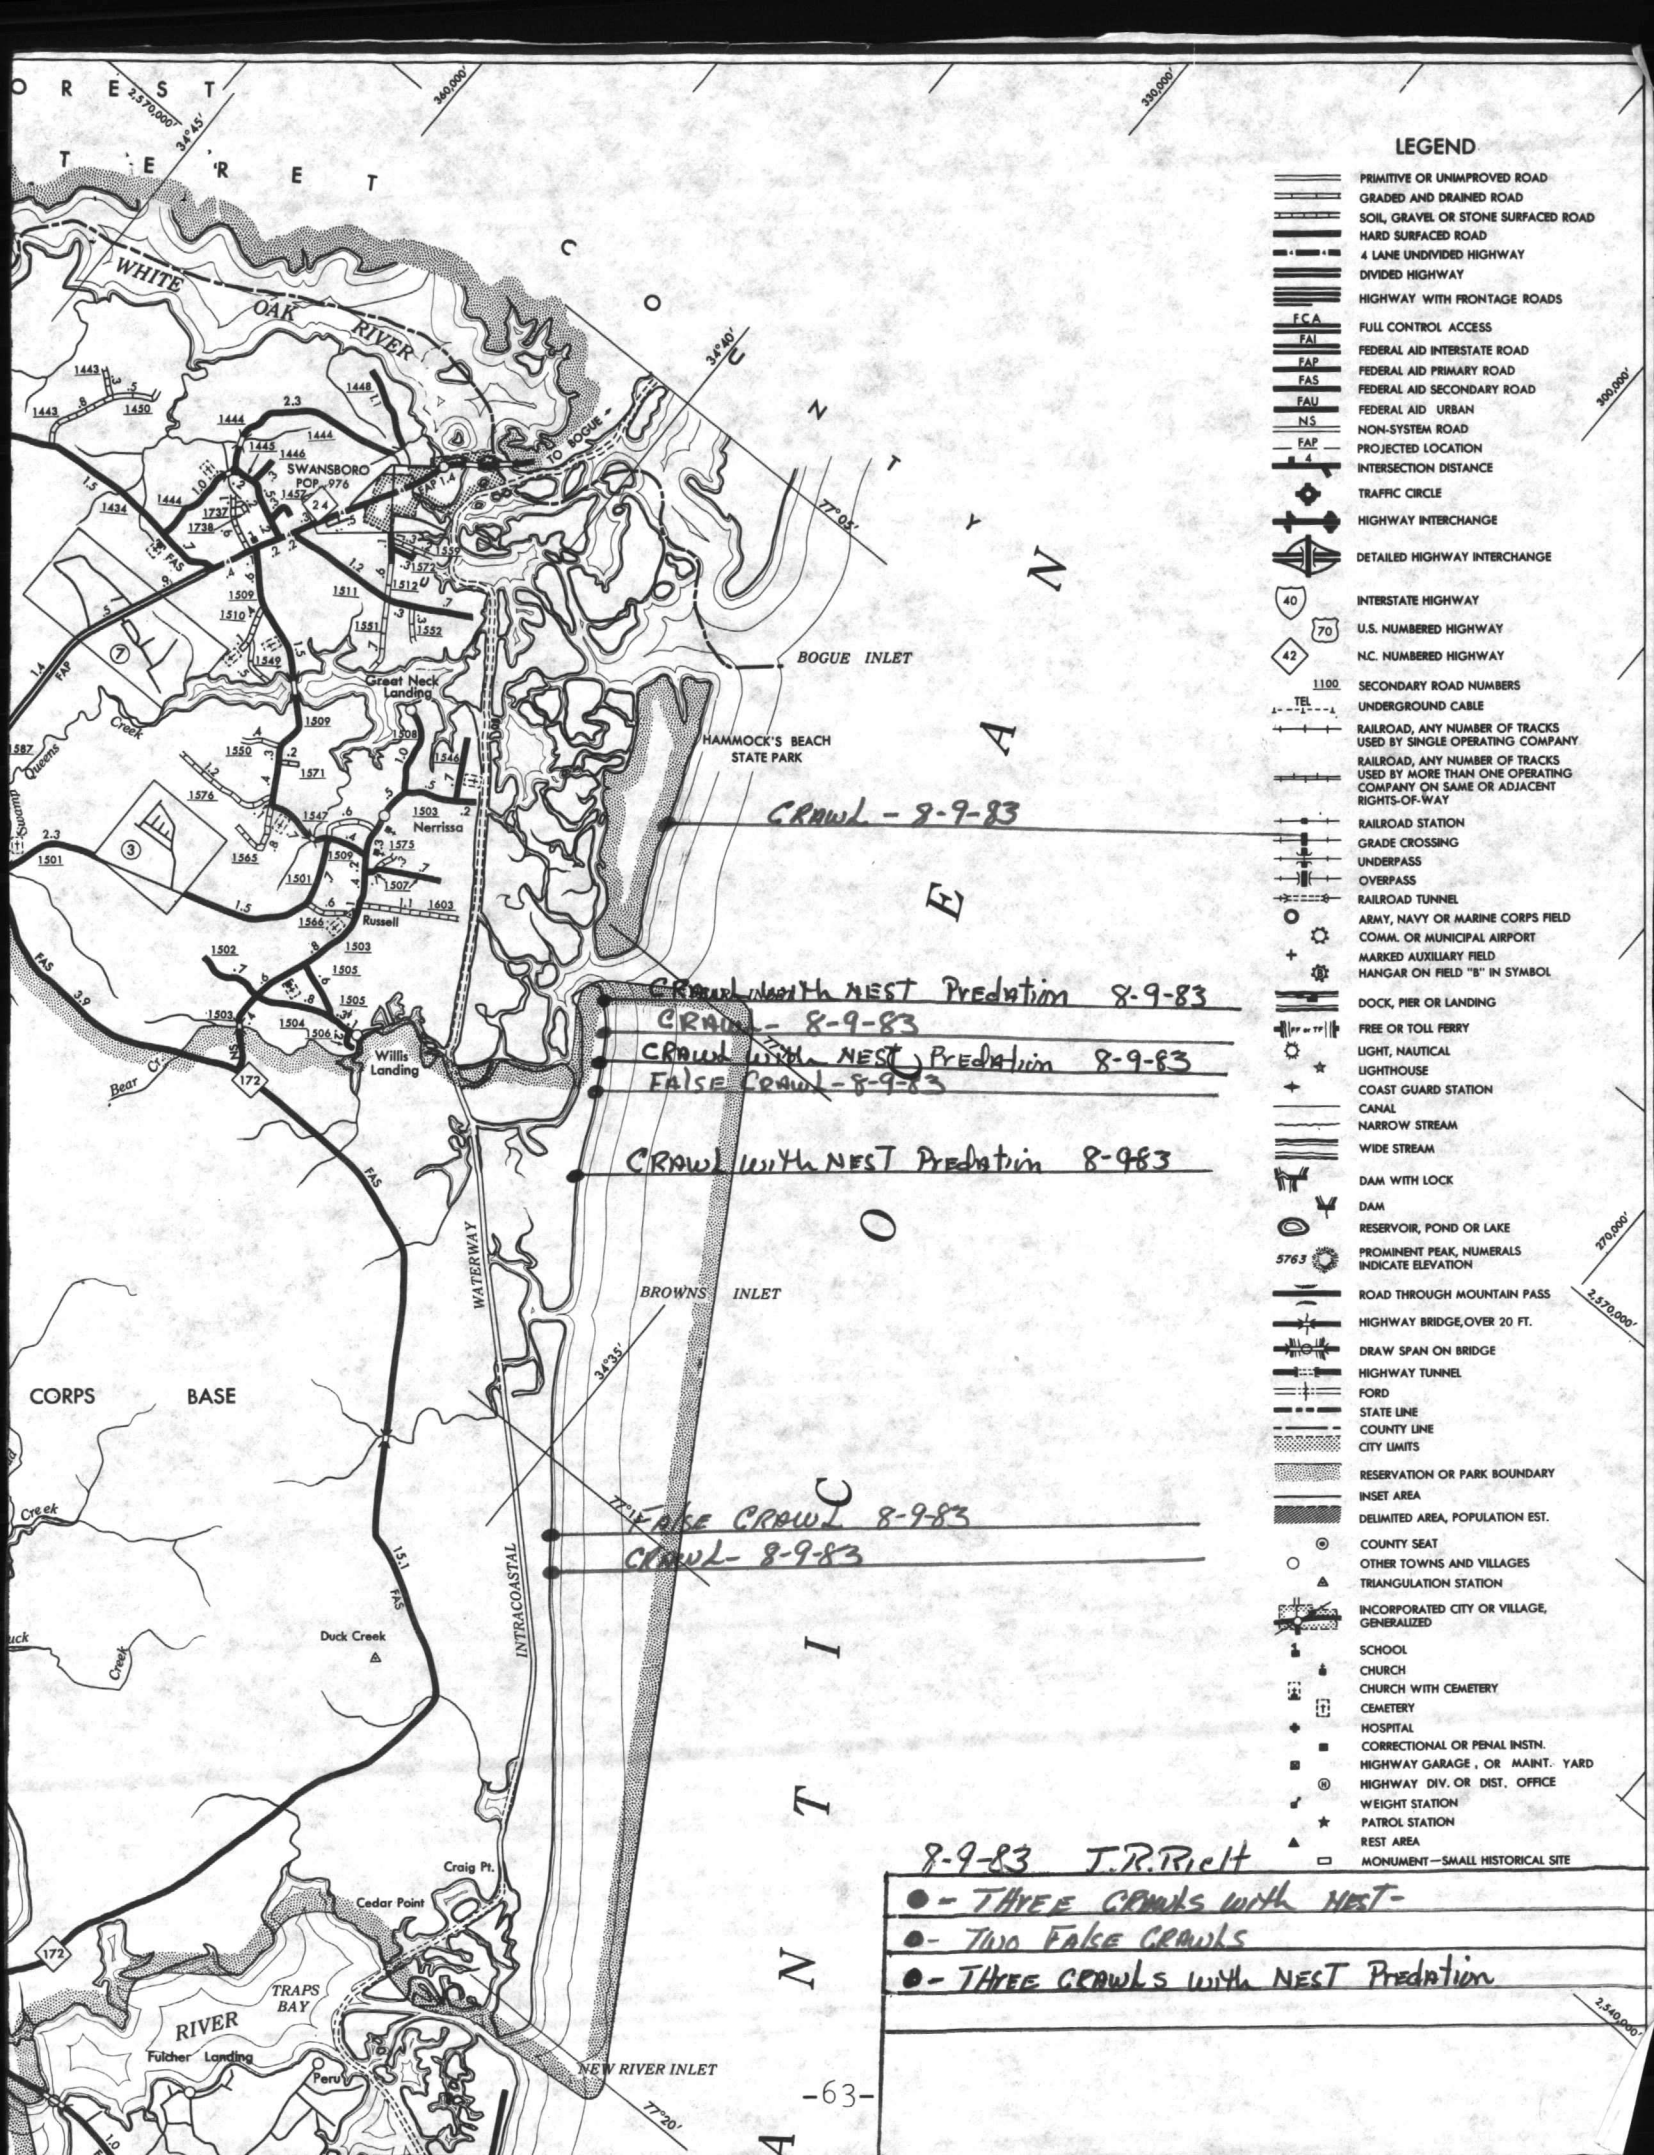

LEGEND

- PRIMITIVE OR UNIMPROVED ROAD
- GRADED AND DRAINED ROAD
- SOIL, GRAVEL OR STONE SURFACED ROAD
- HARD SURFACED ROAD
- 4 LANE UNDIVIDED HIGHWAY
- DIVIDED HIGHWAY
- HIGHWAY WITH FRONTAGE ROADS
- FCA FULL CONTROL ACCESS
- FAI FEDERAL AID INTERSTATE ROAD
- FAP FEDERAL AID PRIMARY ROAD
- FAS FEDERAL AID SECONDARY ROAD
- FAU FEDERAL AID URBAN
- NS NON-SYSTEM ROAD
- EAP PROJECTED LOCATION
- I INTERSECTION DISTANCE
- C TRAFFIC CIRCLE
- I HIGHWAY INTERCHANGE
- D DETAILED HIGHWAY INTERCHANGE
- 40 INTERSTATE HIGHWAY
- 70 U.S. NUMBERED HIGHWAY
- 42 N.C. NUMBERED HIGHWAY
- 1100 SECONDARY ROAD NUMBERS
- TEL UNDERGROUND CABLE
- RAILROAD, ANY NUMBER OF TRACKS USED BY SINGLE OPERATING COMPANY
- RAILROAD, ANY NUMBER OF TRACKS USED BY MORE THAN ONE OPERATING COMPANY ON SAME OR ADJACENT RIGHTS-OF-WAY
- S RAILROAD STATION
- G GRADE CROSSING
- U UNDERPASS
- O OVERPASS
- T RAILROAD TUNNEL
- A ARMY, NAVY OR MARINE CORPS FIELD
- A COMM. OR MUNICIPAL AIRPORT
- A MARKED AUXILIARY FIELD
- A HANGAR ON FIELD "B" IN SYMBOL
- D DOCK, PIER OR LANDING
- F FREE OR TOLL FERRY
- L LIGHT, NAUTICAL LIGHTHOUSE
- C COAST GUARD STATION
- C CANAL
- N NARROW STREAM
- W WIDE STREAM
- D DAM WITH LOCK
- D DAM
- R RESERVOIR, POND OR LAKE
- P PROMINENT PEAK, NUMERALS INDICATE ELEVATION
- P ROAD THROUGH MOUNTAIN PASS
- B HIGHWAY BRIDGE, OVER 20 FT.
- T HIGHWAY TUNNEL
- F FORD
- S STATE LINE
- C COUNTY LINE
- C CITY LIMITS
- R RESERVATION OR PARK BOUNDARY
- I INSET AREA
- D DELIMITED AREA, POPULATION EST.
- C COUNTY SEAT
- O OTHER TOWNS AND VILLAGES
- T TRIANGULATION STATION
- I INCORPORATED CITY OR VILLAGE, GENERALIZED
- S SCHOOL
- C CHURCH
- C CHURCH WITH CEMETERY
- C CEMETERY
- H HOSPITAL
- C CORRECTIONAL OR PENAL INSTN.
- G HIGHWAY GARAGE, OR MAINT. YARD
- D HIGHWAY DIV. OR DIST. OFFICE
- W WEIGHT STATION
- P PATROL STATION
- R REST AREA
- M MONUMENT - SMALL HISTORICAL SITE

CRAWL - 8-9-83

CRAWL with NEST Predation 8-9-83

FALSE CRAWL - 8-9-83

CRAWL with NEST Predation 8-9-83

FALSE CRAWL 8-9-83

CRAWL - 8-9-83

8-9-83 J.R. Rielt

- - THREE CRAWLS with NEST -*
- - Two FALSE CRAWLS*
- - THREE CRAWLS with NEST Predation*








NEST AND CRAWL ACTIVITY
ON SLOW BEACH, MARINE CORPS BASE
CAMP LEJEUNE, NORTH CAROLINA

Nests - upper map

Crawls no nest - lower map

Dots indicates multiple usage

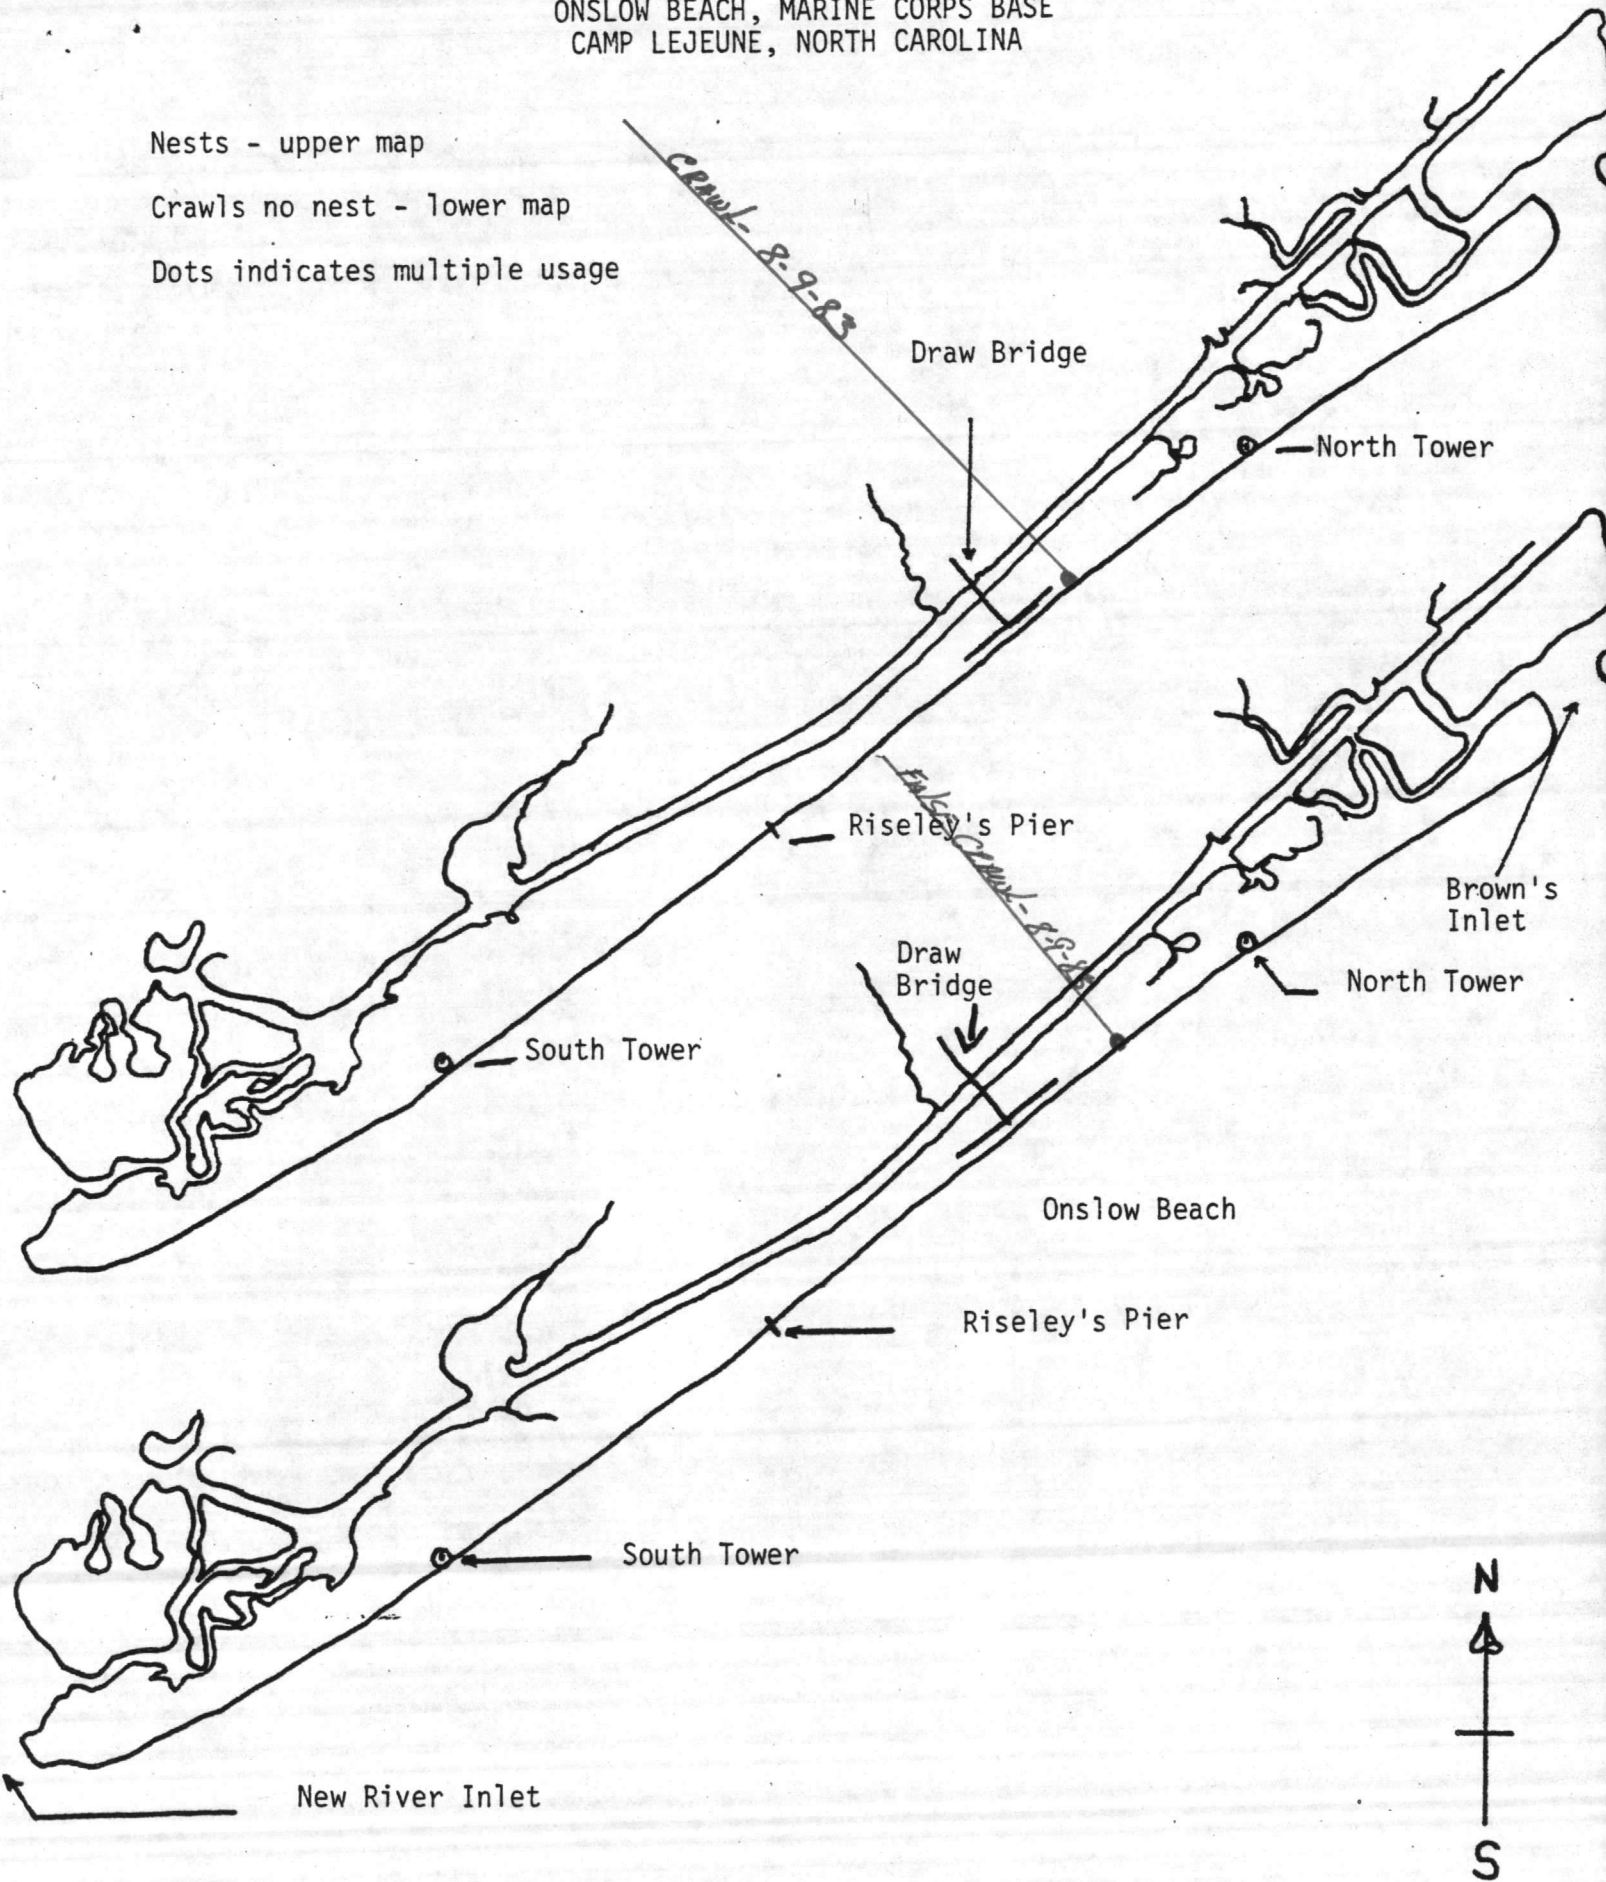

 

AERIAL SURVEY DATA

Date: August 11 1983 Time: S 06:02 F 08:22

Recorder Name: Jerry R. Rich

Crew Names: None Pilot: J. R. Rich

Co-Pilot: None Crew Chief: None

Others: None

Weather: General 1 mile fog & haze Cloud Cover 800 OVC

Wind Speed SW 8-10 K Sea Conditions Chop

BEACH AERIAL SURVEYS Altitude 100 Ft
Air Speed 60 K

Location	Crawls		Nests		Nest Predation	
	New	Old	New	Old	New	Old
Onslow Beach	0	0	0	0	0	0
Browns Island	2	0	3	3	0	2
Bear Beach	2	0	3	0	0	0

OCEAN AERIAL SURVEYS Altitude 300 Ft
Air Speed 60 K

	Live Turtles		Dead Turtles
	Juvenile	Adults	
Bell Buoy from Bogue Inlet to New River Inlet	None	None	None

Comments:

0000

0000

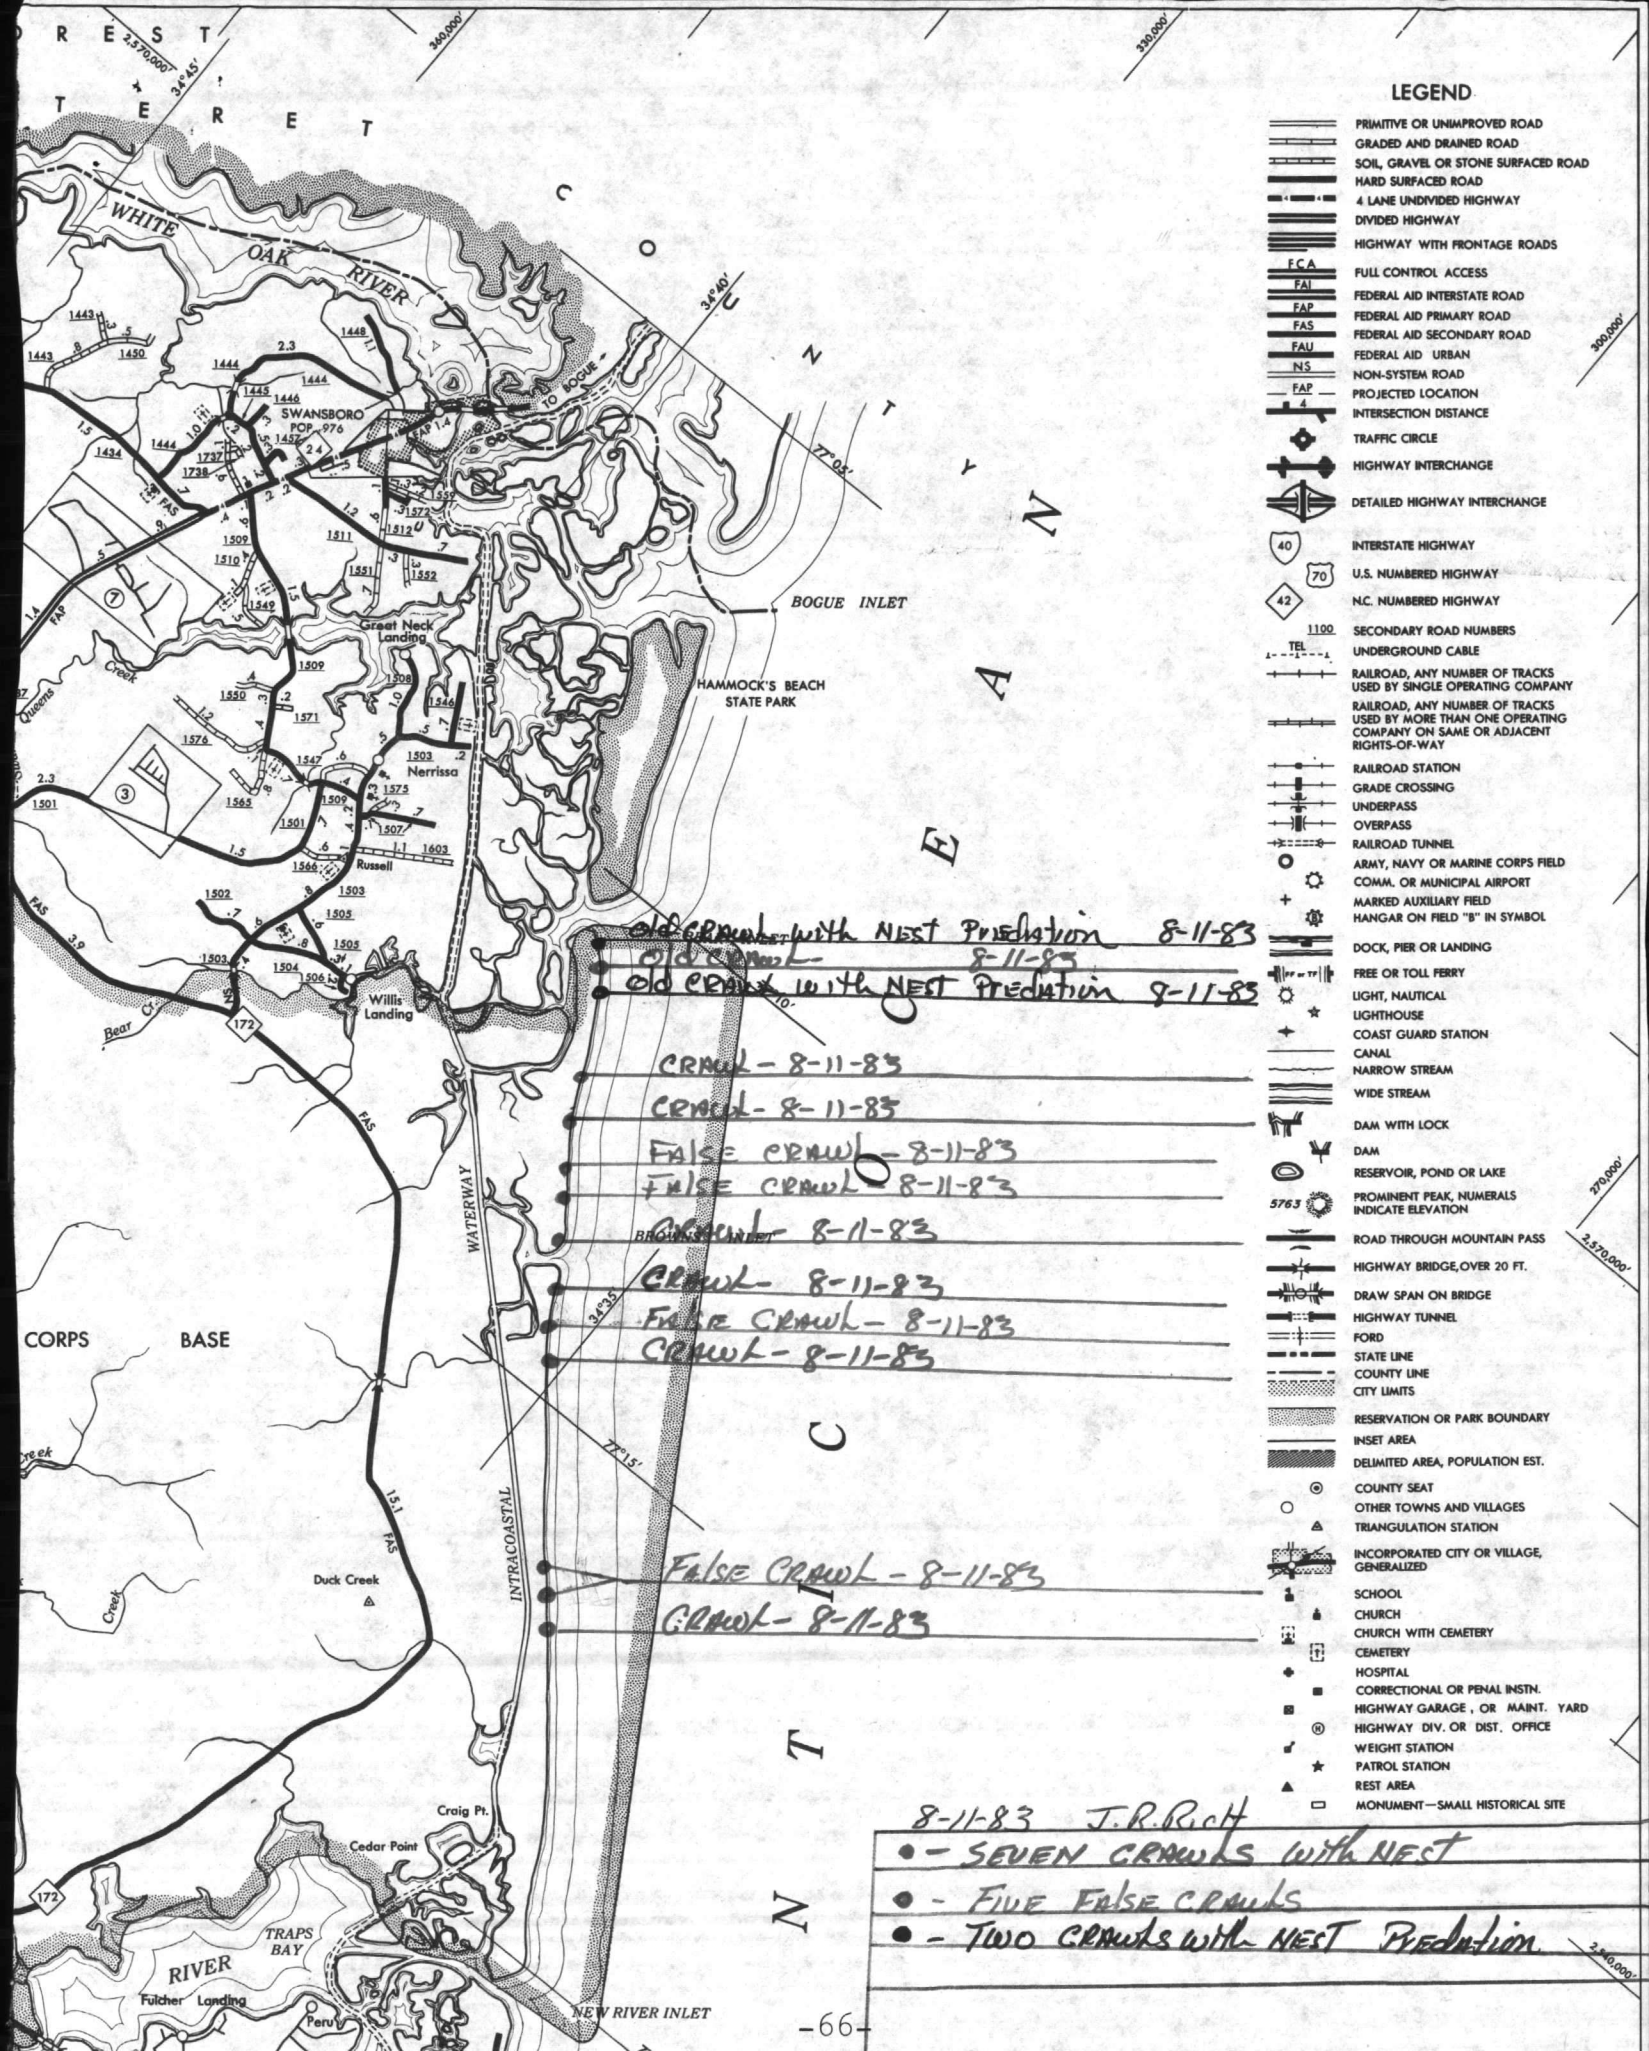


LEGEND

- PRIMITIVE OR UNIMPROVED ROAD
- GRADED AND DRAINED ROAD
- SOIL, GRAVEL OR STONE SURFACED ROAD
- HARD SURFACED ROAD
- 4 LANE UNDIVIDED HIGHWAY
- DIVIDED HIGHWAY
- HIGHWAY WITH FRONTAGE ROADS
- FCA FULL CONTROL ACCESS
- FAI FEDERAL AID INTERSTATE ROAD
- FAP FEDERAL AID PRIMARY ROAD
- FAS FEDERAL AID SECONDARY ROAD
- FAU FEDERAL AID URBAN
- NS NON-SYSTEM ROAD
- FAP PROJECTED LOCATION
- I INTERSECTION LOCATION
- TRAFFIC CIRCLE
- HIGHWAY INTERCHANGE
- DETAILED HIGHWAY INTERCHANGE
- 40 INTERSTATE HIGHWAY
- 70 U.S. NUMBERED HIGHWAY
- 42 N.C. NUMBERED HIGHWAY
- 1100 SECONDARY ROAD NUMBERS
- TEL UNDERGROUND CABLE
- RAILROAD, ANY NUMBER OF TRACKS USED BY SINGLE OPERATING COMPANY
- RAILROAD, ANY NUMBER OF TRACKS USED BY MORE THAN ONE OPERATING COMPANY ON SAME OR ADJACENT RIGHTS-OF-WAY
- RAILROAD STATION
- GRADE CROSSING
- UNDERPASS
- OVERPASS
- RAILROAD TUNNEL
- ARMY, NAVY OR MARINE CORPS FIELD
- COMM. OR MUNICIPAL AIRPORT
- MARKED AUXILIARY FIELD
- HANGAR ON FIELD "B" IN SYMBOL
- DOCK, PIER OR LANDING
- FREE OR TOLL FERRY
- LIGHT, NAUTICAL
- LIGHTHOUSE
- COAST GUARD STATION
- CANAL
- NARROW STREAM
- WIDE STREAM
- DAM WITH LOCK
- DAM
- RESERVOIR, POND OR LAKE
- 5763 PROMINENT PEAK, NUMERALS INDICATE ELEVATION
- ROAD THROUGH MOUNTAIN PASS
- HIGHWAY BRIDGE, OVER 20 FT.
- DRAW SPAN ON BRIDGE
- HIGHWAY TUNNEL
- FORD
- STATE LINE
- COUNTY LINE
- CITY LIMITS
- RESERVATION OR PARK BOUNDARY
- INSET AREA
- DELIMITED AREA, POPULATION EST.
- COUNTY SEAT
- OTHER TOWNS AND VILLAGES
- TRIANGULATION STATION
- INCORPORATED CITY OR VILLAGE, GENERALIZED
- SCHOOL
- CHURCH
- CHURCH WITH CEMETERY
- CEMETERY
- HOSPITAL
- CORRECTIONAL OR PENAL INSTN.
- HIGHWAY GARAGE, OR MAINT. YARD
- HIGHWAY DIV. OR DIST. OFFICE
- WEIGHT STATION
- PATROL STATION
- REST AREA
- MONUMENT - SMALL HISTORICAL SITE

~~Old CRAWL with NEST Predation 8-11-83~~
~~Old CRAWL 8-11-83~~
~~Old CRAWL with NEST Predation 8-11-83~~
 CRAWL - 8-11-83
 CRAWL - 8-11-83
 FALSE CRAWL - 8-11-83
 FALSE CRAWL - 8-11-83
 CRAWL - 8-11-83
 CRAWL - 8-11-83
 FALSE CRAWL - 8-11-83
 CRAWL - 8-11-83
 FALSE CRAWL - 8-11-83
 CRAWL - 8-11-83
 FALSE CRAWL - 8-11-83
 CRAWL - 8-11-83

8-11-83 J.R. Rich

●	- SEVEN CRAWLS with NEST
●	- FIVE FALSE CRAWLS
●	- TWO CRAWLS with NEST Predation

 



NEST AND CRAWL ACTIVITY
 ONSLOW BEACH, MARINE CORPS BASE
 CAMP LEJEUNE, NORTH CAROLINA

Nests - upper map

Crawls no nest - lower map

Dots indicates multiple usage

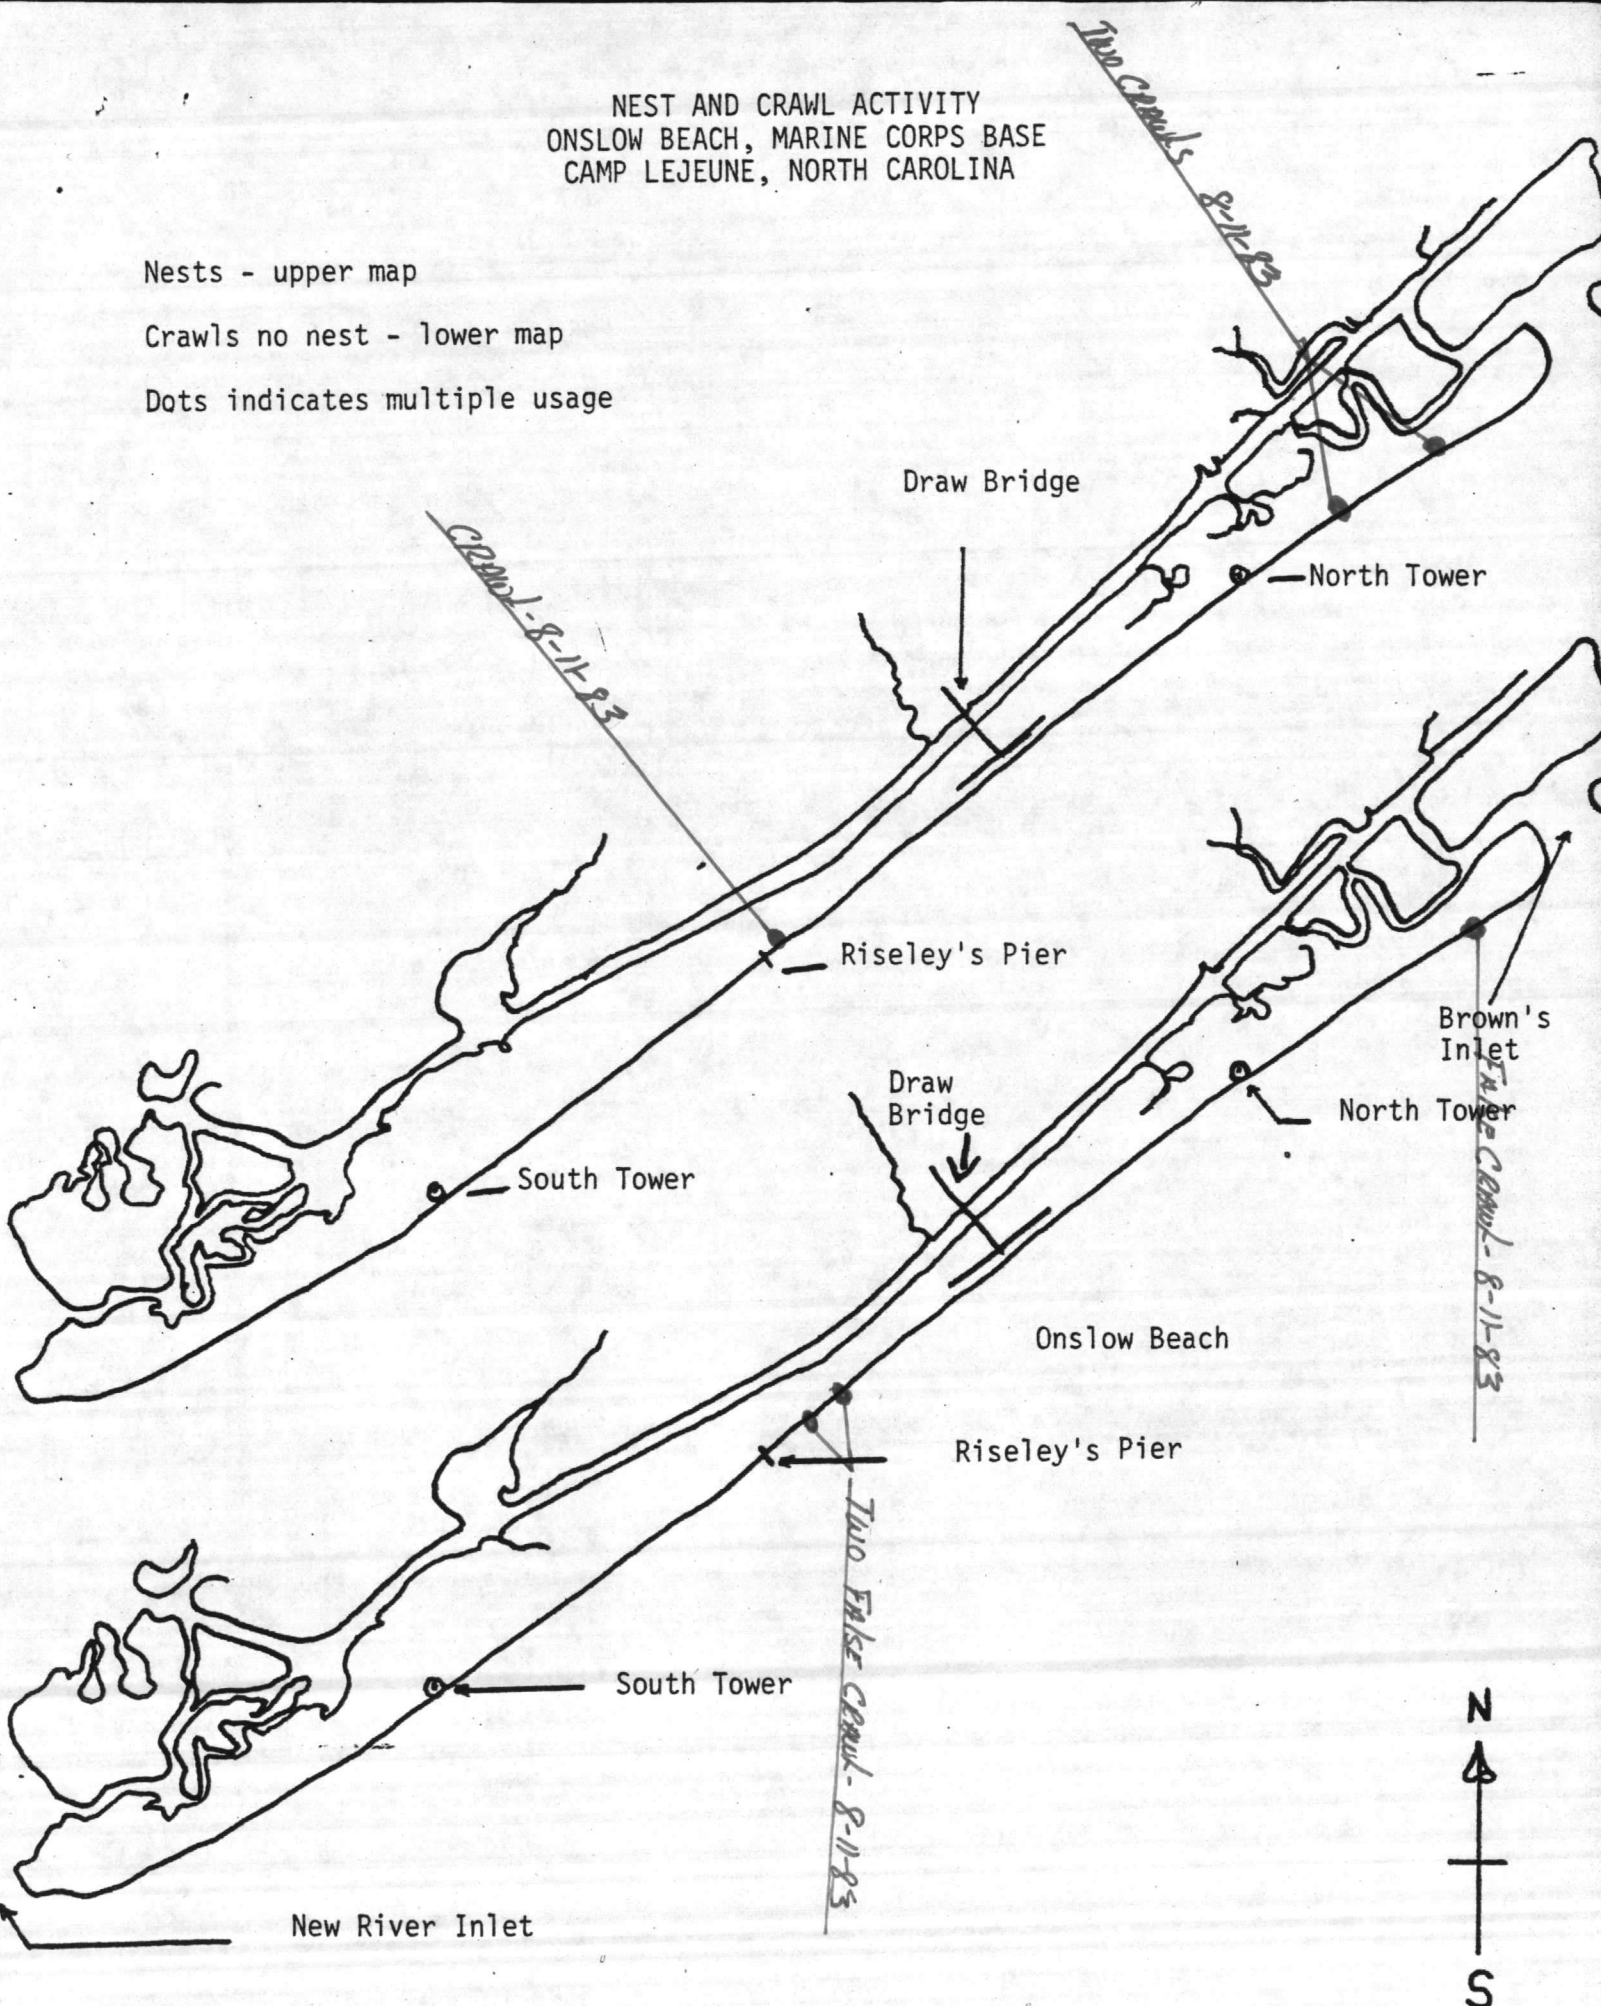

 

AERIAL SURVEY DATA

Date: August 16 1983 Time: S 06:04 F 08:05

Recorder Name: Jerry R. Rich

Crew Names: None Pilot: J. R. Rich

Co-Pilot: None Crew Chief: None

Others: None

Weather: General 1-2 miles fog Cloud Cover 1000 SCT

Wind Speed Less than 5 K Sea Conditions Calm

BEACH AERIAL SURVEYS Altitude 100 FT

Air Speed 60 K

Location	Crawls		Nests		Nest Predation	
	New	Old	New	Old	New	Old
Onslow Beach	0	0	0	0	0	0
Browns Island	1	0	3	0	2	0
Bear Beach	0	0	1	4	0	0

OCEAN AERIAL SURVEYS Altitude 300 Ft

Air Speed 60 K

	Live Turtles		Dead Turtles
	Juvenile	Adults	
Bell Buoy from Bogue Inlet to New River Inlet	None	None	None

Comments:






































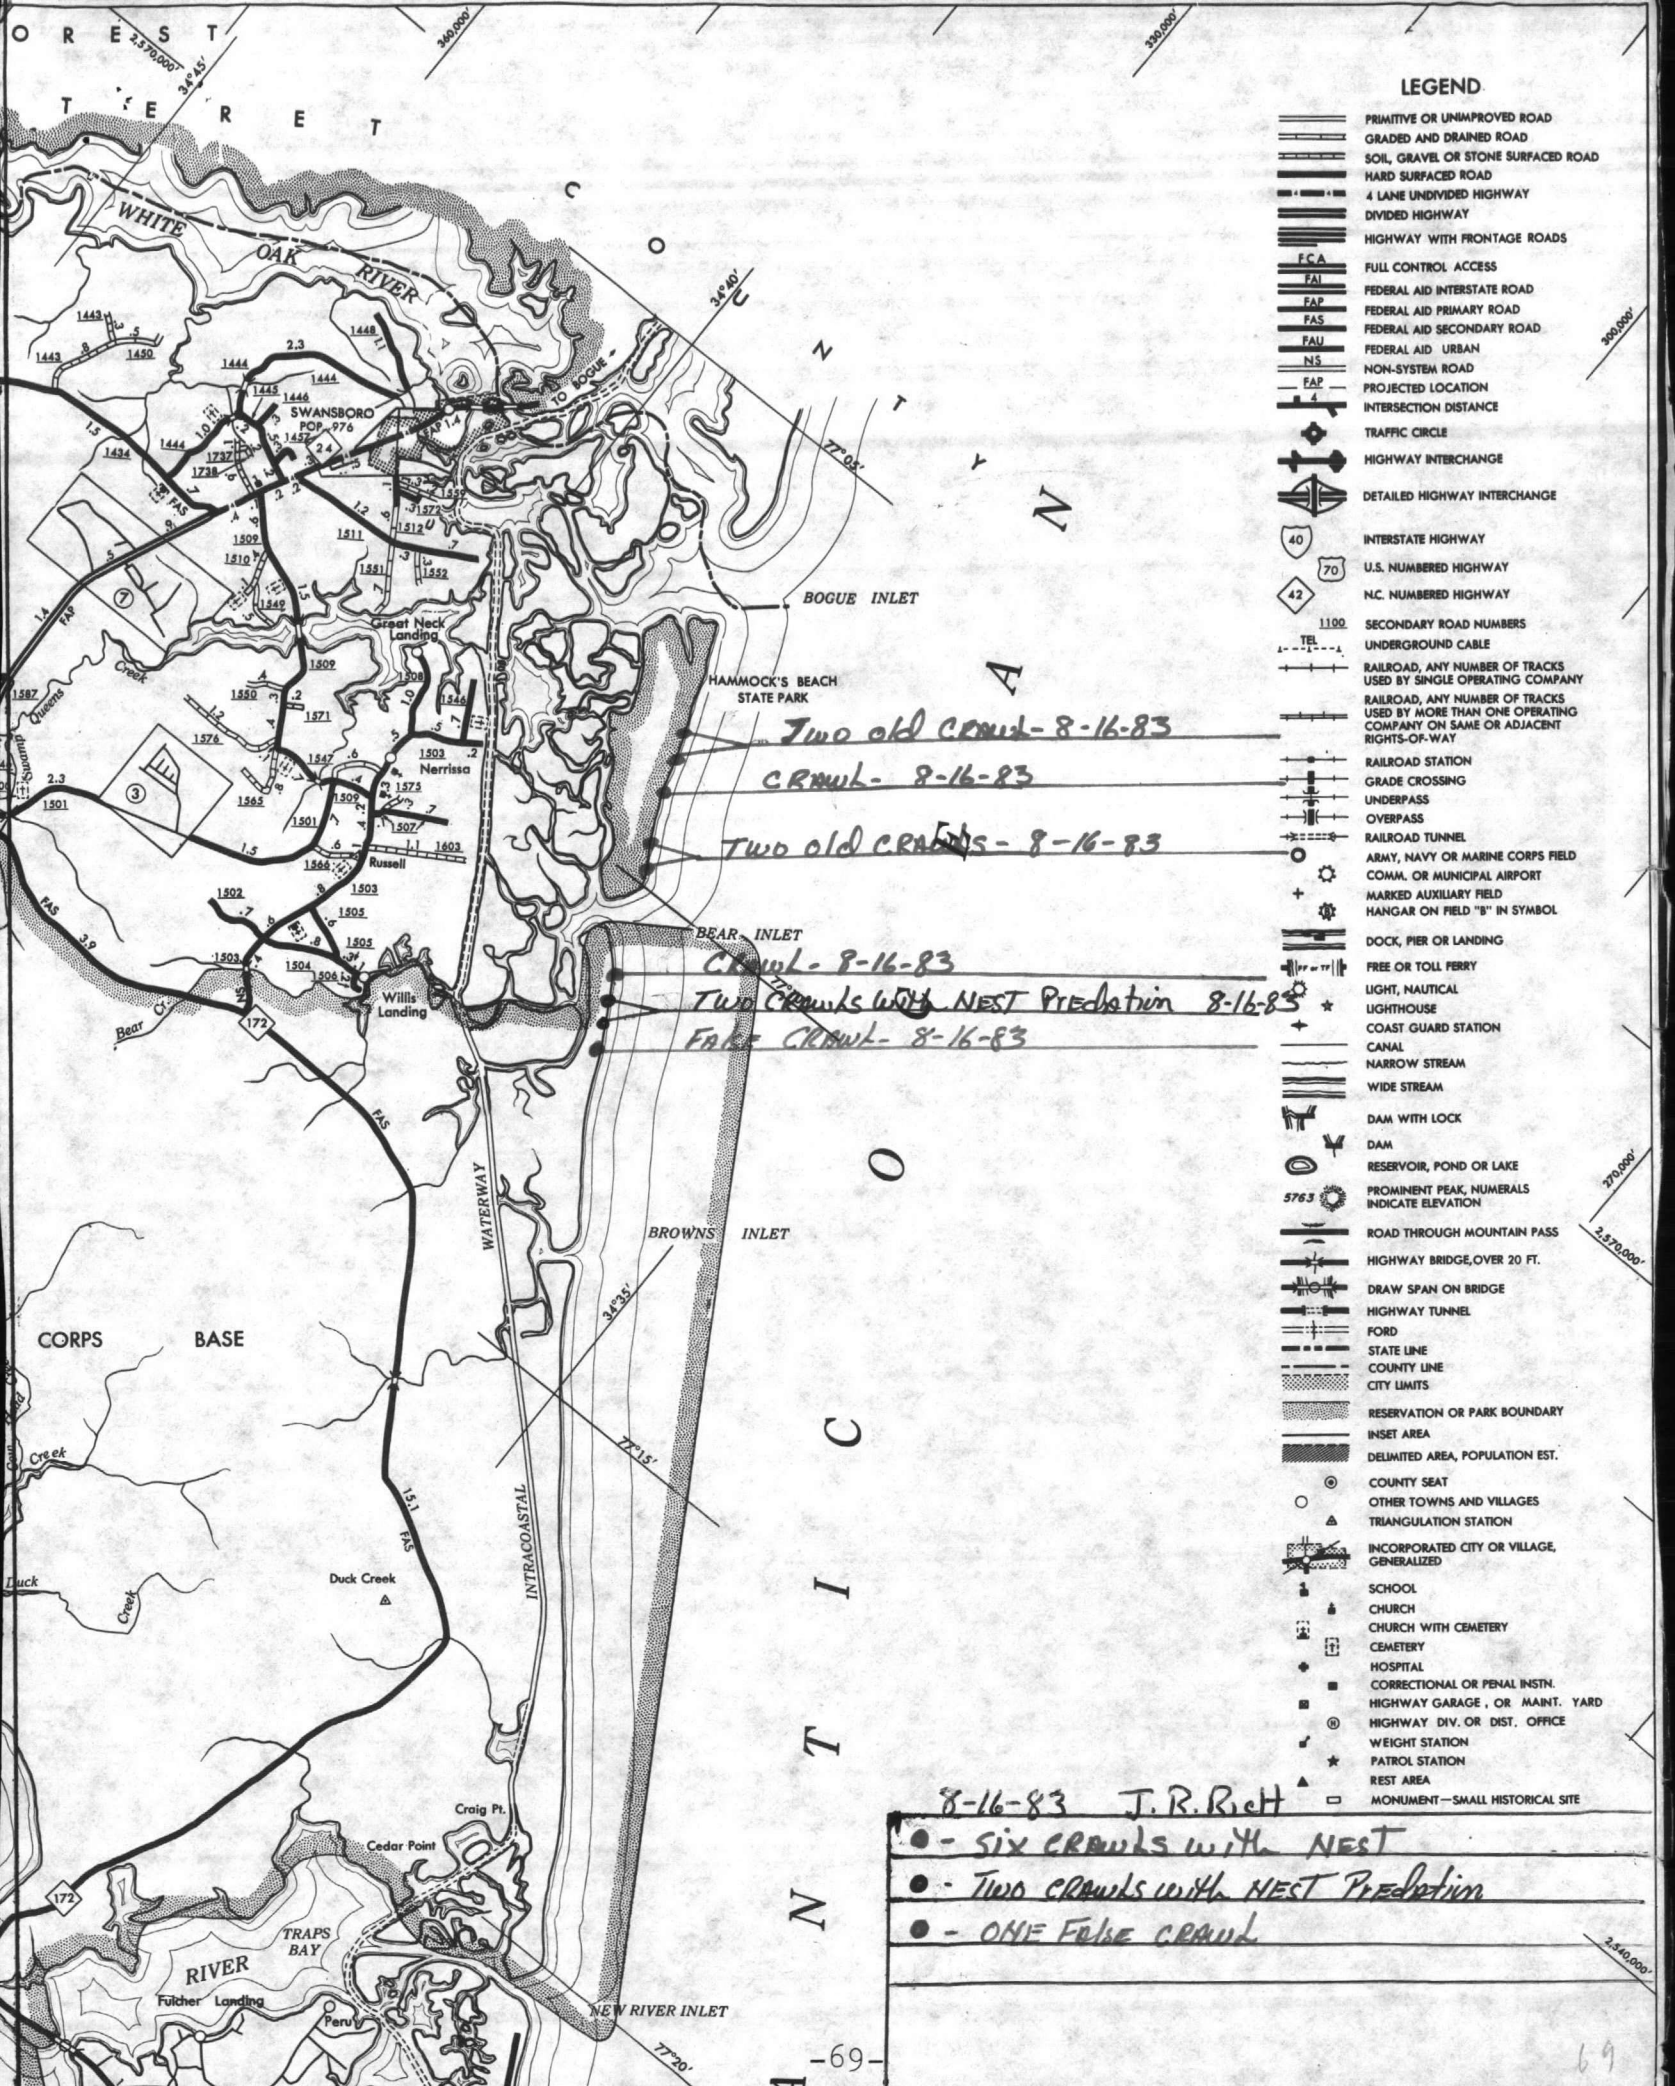

LEGEND

- PRIMITIVE OR UNIMPROVED ROAD
- GRADED AND DRAINED ROAD
- SOIL, GRAVEL OR STONE SURFACED ROAD
- HARD SURFACED ROAD
- 4 LANE UNDIVIDED HIGHWAY
- DIVIDED HIGHWAY
- HIGHWAY WITH FRONTAGE ROADS
- FCA FULL CONTROL ACCESS
- FAI FEDERAL AID INTERSTATE ROAD
- FAP FEDERAL AID PRIMARY ROAD
- FAS FEDERAL AID SECONDARY ROAD
- FAU FEDERAL AID URBAN
- NS NON-SYSTEM ROAD
- FAP 4 PROJECTED LOCATION
- INTERSECTION DISTANCE
- TRAFFIC CIRCLE
- HIGHWAY INTERCHANGE
- DETAILED HIGHWAY INTERCHANGE
- INTERSTATE HIGHWAY
- U.S. NUMBERED HIGHWAY
- N.C. NUMBERED HIGHWAY
- SECONDARY ROAD NUMBERS
- UNDERGROUND CABLE
- RAILROAD, ANY NUMBER OF TRACKS USED BY SINGLE OPERATING COMPANY
- RAILROAD, ANY NUMBER OF TRACKS USED BY MORE THAN ONE OPERATING COMPANY ON SAME OR ADJACENT RIGHTS-OF-WAY
- RAILROAD STATION
- GRADE CROSSING UNDERPASS
- OVERPASS
- RAILROAD TUNNEL
- ARMY, NAVY OR MARINE CORPS FIELD
- COMM. OR MUNICIPAL AIRPORT
- MARKED AUXILIARY FIELD
- HANGAR ON FIELD "B" IN SYMBOL
- DOCK, PIER OR LANDING
- FREE OR TOLL FERRY
- LIGHT, NAUTICAL
- LIGHTHOUSE
- COAST GUARD STATION
- CANAL
- NARROW STREAM
- WIDE STREAM
- DAM WITH LOCK
- DAM
- RESERVOIR, POND OR LAKE
- PROMINENT PEAK, NUMERALS INDICATE ELEVATION
- ROAD THROUGH MOUNTAIN PASS
- HIGHWAY BRIDGE, OVER 20 FT.
- DRAW SPAN ON BRIDGE
- HIGHWAY TUNNEL
- FORD
- STATE LINE
- COUNTY LINE
- CITY LIMITS
- RESERVATION OR PARK BOUNDARY
- INSET AREA
- DELIMITED AREA, POPULATION EST.
- COUNTY SEAT
- OTHER TOWNS AND VILLAGES
- TRIANGULATION STATION
- INCORPORATED CITY OR VILLAGE, GENERALIZED
- SCHOOL
- CHURCH
- CHURCH WITH CEMETERY
- CEMETERY
- HOSPITAL
- CORRECTIONAL OR PENAL INSTN.
- HIGHWAY GARAGE, OR MAINT. YARD
- HIGHWAY DIV. OR DIST. OFFICE
- WEIGHT STATION
- PATROL STATION
- REST AREA
- MONUMENT—SMALL HISTORICAL SITE

Two old CRAWLS - 8-16-83

CRAWL - 8-16-83

Two old CRAWLS - 8-16-83


CRAWL - 8-16-83

Two CRAWLS with NEST Prediction 8-16-83

False CRAWL - 8-16-83

8-16-83 J.R. Rich

- - six CRAWLS with NEST
- - Two CRAWLS with NEST Prediction
- - ONE False CRAWL

 

AERIAL SURVEY DATA

Date: August 19 83 Time: S 06:01 F 08:04

Recorder Name: Jerry R. Rich

Crew Names: None Pilot: J. R. Rich

Co-Pilot: None Crew Chief: None

Others: None

Weather: General 10,000 BKN 3 miles haze Cloud Cover 10,000 BKN

Wind Speed SSW 10-15 K Sea Conditions White caps

BEACH AERIAL SURVEYS Altitude 100 Ft

Air Speed 60 K

Location	Crawls		Nests		Nest Predation	
	New	Old	New	Old	New	Old
Onslow Beach	0	0	0	0	0	0
Browns Island	0	0	0	0	0	0
Bear Beach	0	0	2	3	0	0

OCEAN AERIAL SURVEYS Altitude 300 Ft

Air Speed 60 K

	Live Turtles		Dead Turtles
	Juvenile	Adults	
Bell Buoy from Bogue Inlet to New River Inlet	None	None	None

Comments:

1000

1000

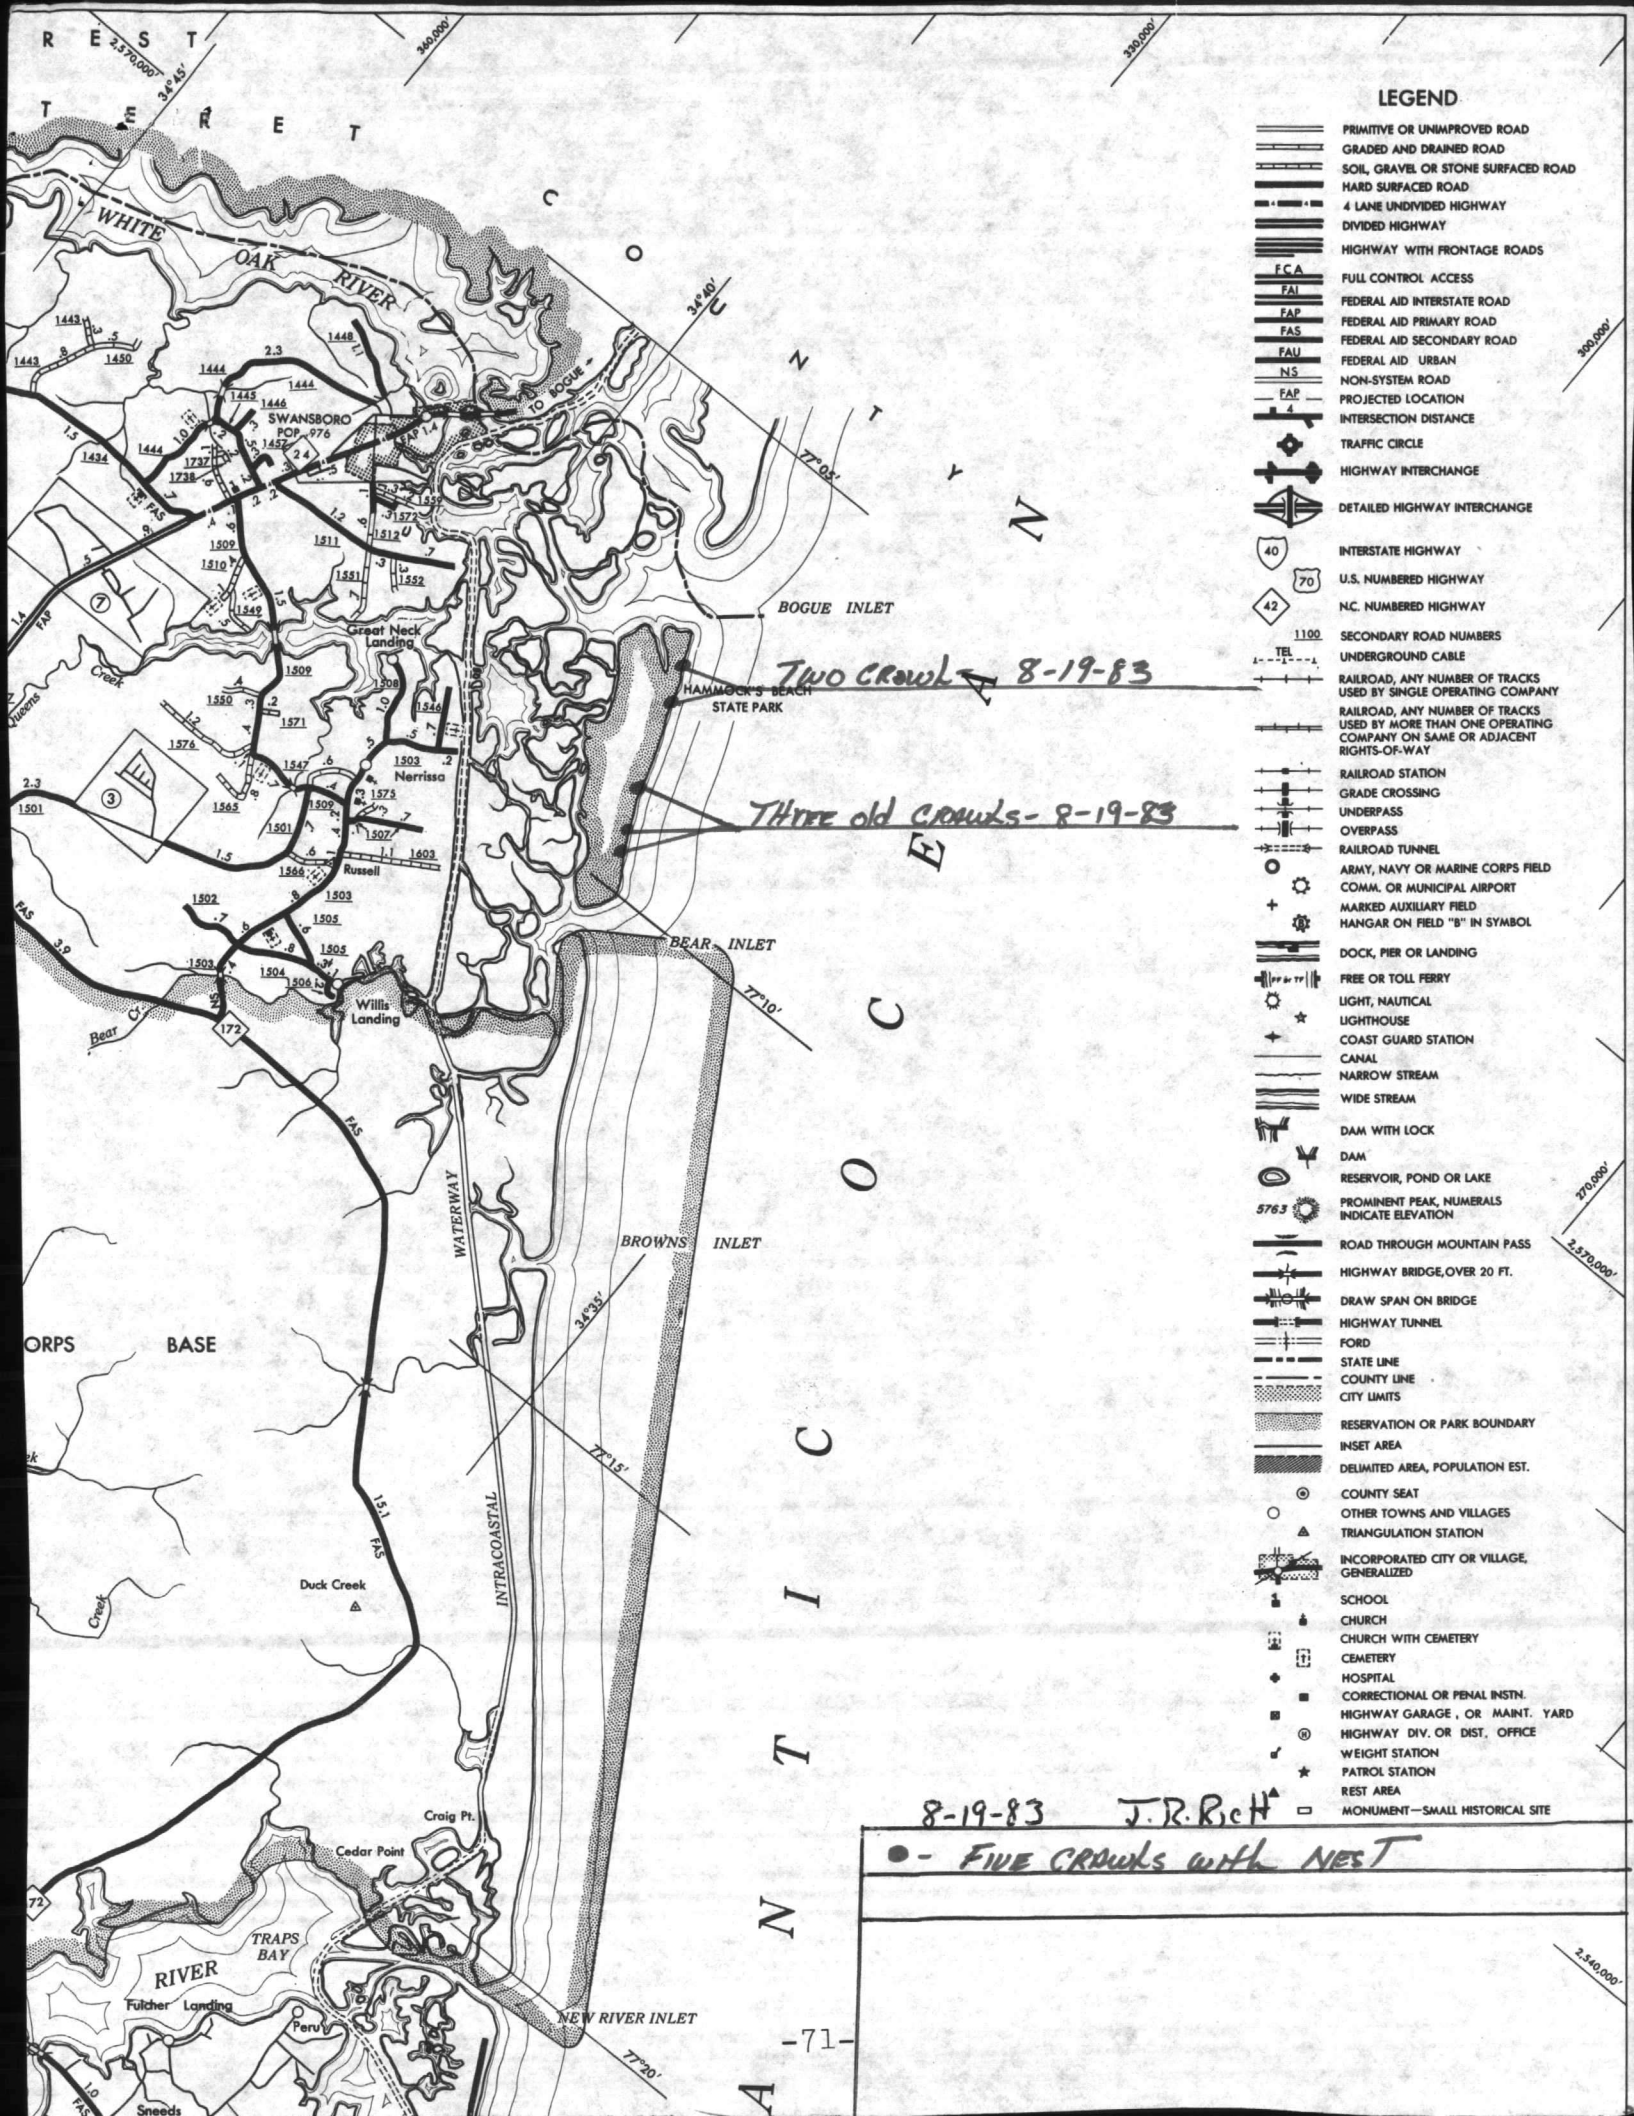

LEGEND

- PRIMITIVE OR UNIMPROVED ROAD
- GRADED AND DRAINED ROAD
- SOIL, GRAVEL OR STONE SURFACED ROAD
- HARD SURFACED ROAD
- 4 LANE UNDIVIDED HIGHWAY
- DIVIDED HIGHWAY
- HIGHWAY WITH FRONTAGE ROADS
- FCA FULL CONTROL ACCESS
- FAI FEDERAL AID INTERSTATE ROAD
- FAP FEDERAL AID PRIMARY ROAD
- FAS FEDERAL AID SECONDARY ROAD
- FAU FEDERAL AID URBAN
- NS NON-SYSTEM ROAD
- FAP PROJECTED LOCATION
- INTERSECTION DISTANCE
- TRAFFIC CIRCLE
- HIGHWAY INTERCHANGE
- DETAILED HIGHWAY INTERCHANGE
- INTERSTATE HIGHWAY
- U.S. NUMBERED HIGHWAY
- N.C. NUMBERED HIGHWAY
- SECONDARY ROAD NUMBERS
- UNDERGROUND CABLE
- RAILROAD, ANY NUMBER OF TRACKS USED BY SINGLE OPERATING COMPANY
- RAILROAD, ANY NUMBER OF TRACKS USED BY MORE THAN ONE OPERATING COMPANY ON SAME OR ADJACENT RIGHTS-OF-WAY
- RAILROAD STATION
- GRADE CROSSING
- UNDERPASS
- OVERPASS
- RAILROAD TUNNEL
- ARMY, NAVY OR MARINE CORPS FIELD
- COMM. OR MUNICIPAL AIRPORT
- MARKED AUXILIARY FIELD
- HANGAR ON FIELD "B" IN SYMBOL
- DOCK, PIER OR LANDING
- FREE OR TOLL FERRY
- LIGHT, NAUTICAL
- LIGHTHOUSE
- COAST GUARD STATION
- CANAL
- NARROW STREAM
- WIDE STREAM
- DAM WITH LOCK
- DAM
- RESERVOIR, POND OR LAKE
- PROMINENT PEAK, NUMERALS INDICATE ELEVATION
- ROAD THROUGH MOUNTAIN PASS
- HIGHWAY BRIDGE, OVER 20 FT.
- DRAW SPAN ON BRIDGE
- HIGHWAY TUNNEL
- FORD
- STATE LINE
- COUNTY LINE
- CITY LIMITS
- RESERVATION OR PARK BOUNDARY
- INSET AREA
- DELIMITED AREA, POPULATION EST.
- COUNTY SEAT
- OTHER TOWNS AND VILLAGES
- TRIANGULATION STATION
- INCORPORATED CITY OR VILLAGE, GENERALIZED
- SCHOOL
- CHURCH
- CHURCH WITH CEMETERY
- CEMETERY
- HOSPITAL
- CORRECTIONAL OR PENAL INSTN.
- HIGHWAY GARAGE, OR MAINT. YARD
- HIGHWAY DIV. OR DIST. OFFICE
- WEIGHT STATION
- PATROL STATION
- REST AREA
- MONUMENT—SMALL HISTORICAL SITE

Two Crows - 8-19-83

Three old crows - 8-19-83

8-19-83 J.R. Rich
 ● - *FIVE CROWS with NEST*





AERIAL SURVEY DATA

Date: 8-23 83 Time: S _____ F _____

Recorder Name: Jerry R. Rich

Crew Names: None Pilot: _____

Co-Pilot: None Crew Chief: _____

Others: None

Weather: General 900 ovc 1 mile fog & haze Cloud Cover 1000 ovc

Wind Speed 230 10 K Sea Conditions Chop

BEACH AERIAL SURVEYS

Altitude 100 Ft

Air Speed 60 K

Location	Crawls		Nests		Nest Predation	
	New	Old	New	Old	New	Old
Onslow Beach	0	0	0	0	0	0
Browns Island	0	0	0	0	0	0
Bear Beach	0	0	0	0	0	0

OCEAN AERIAL SURVEYS

Altitude 300 Ft

Air Speed 60 K

	Live Turtles		Dead Turtles
	Juvenile	Adults	
Bell Buoy from Bogue Inlet to New River Inlet	None	None	One dead turtle Bear Beach

Comments: _____

















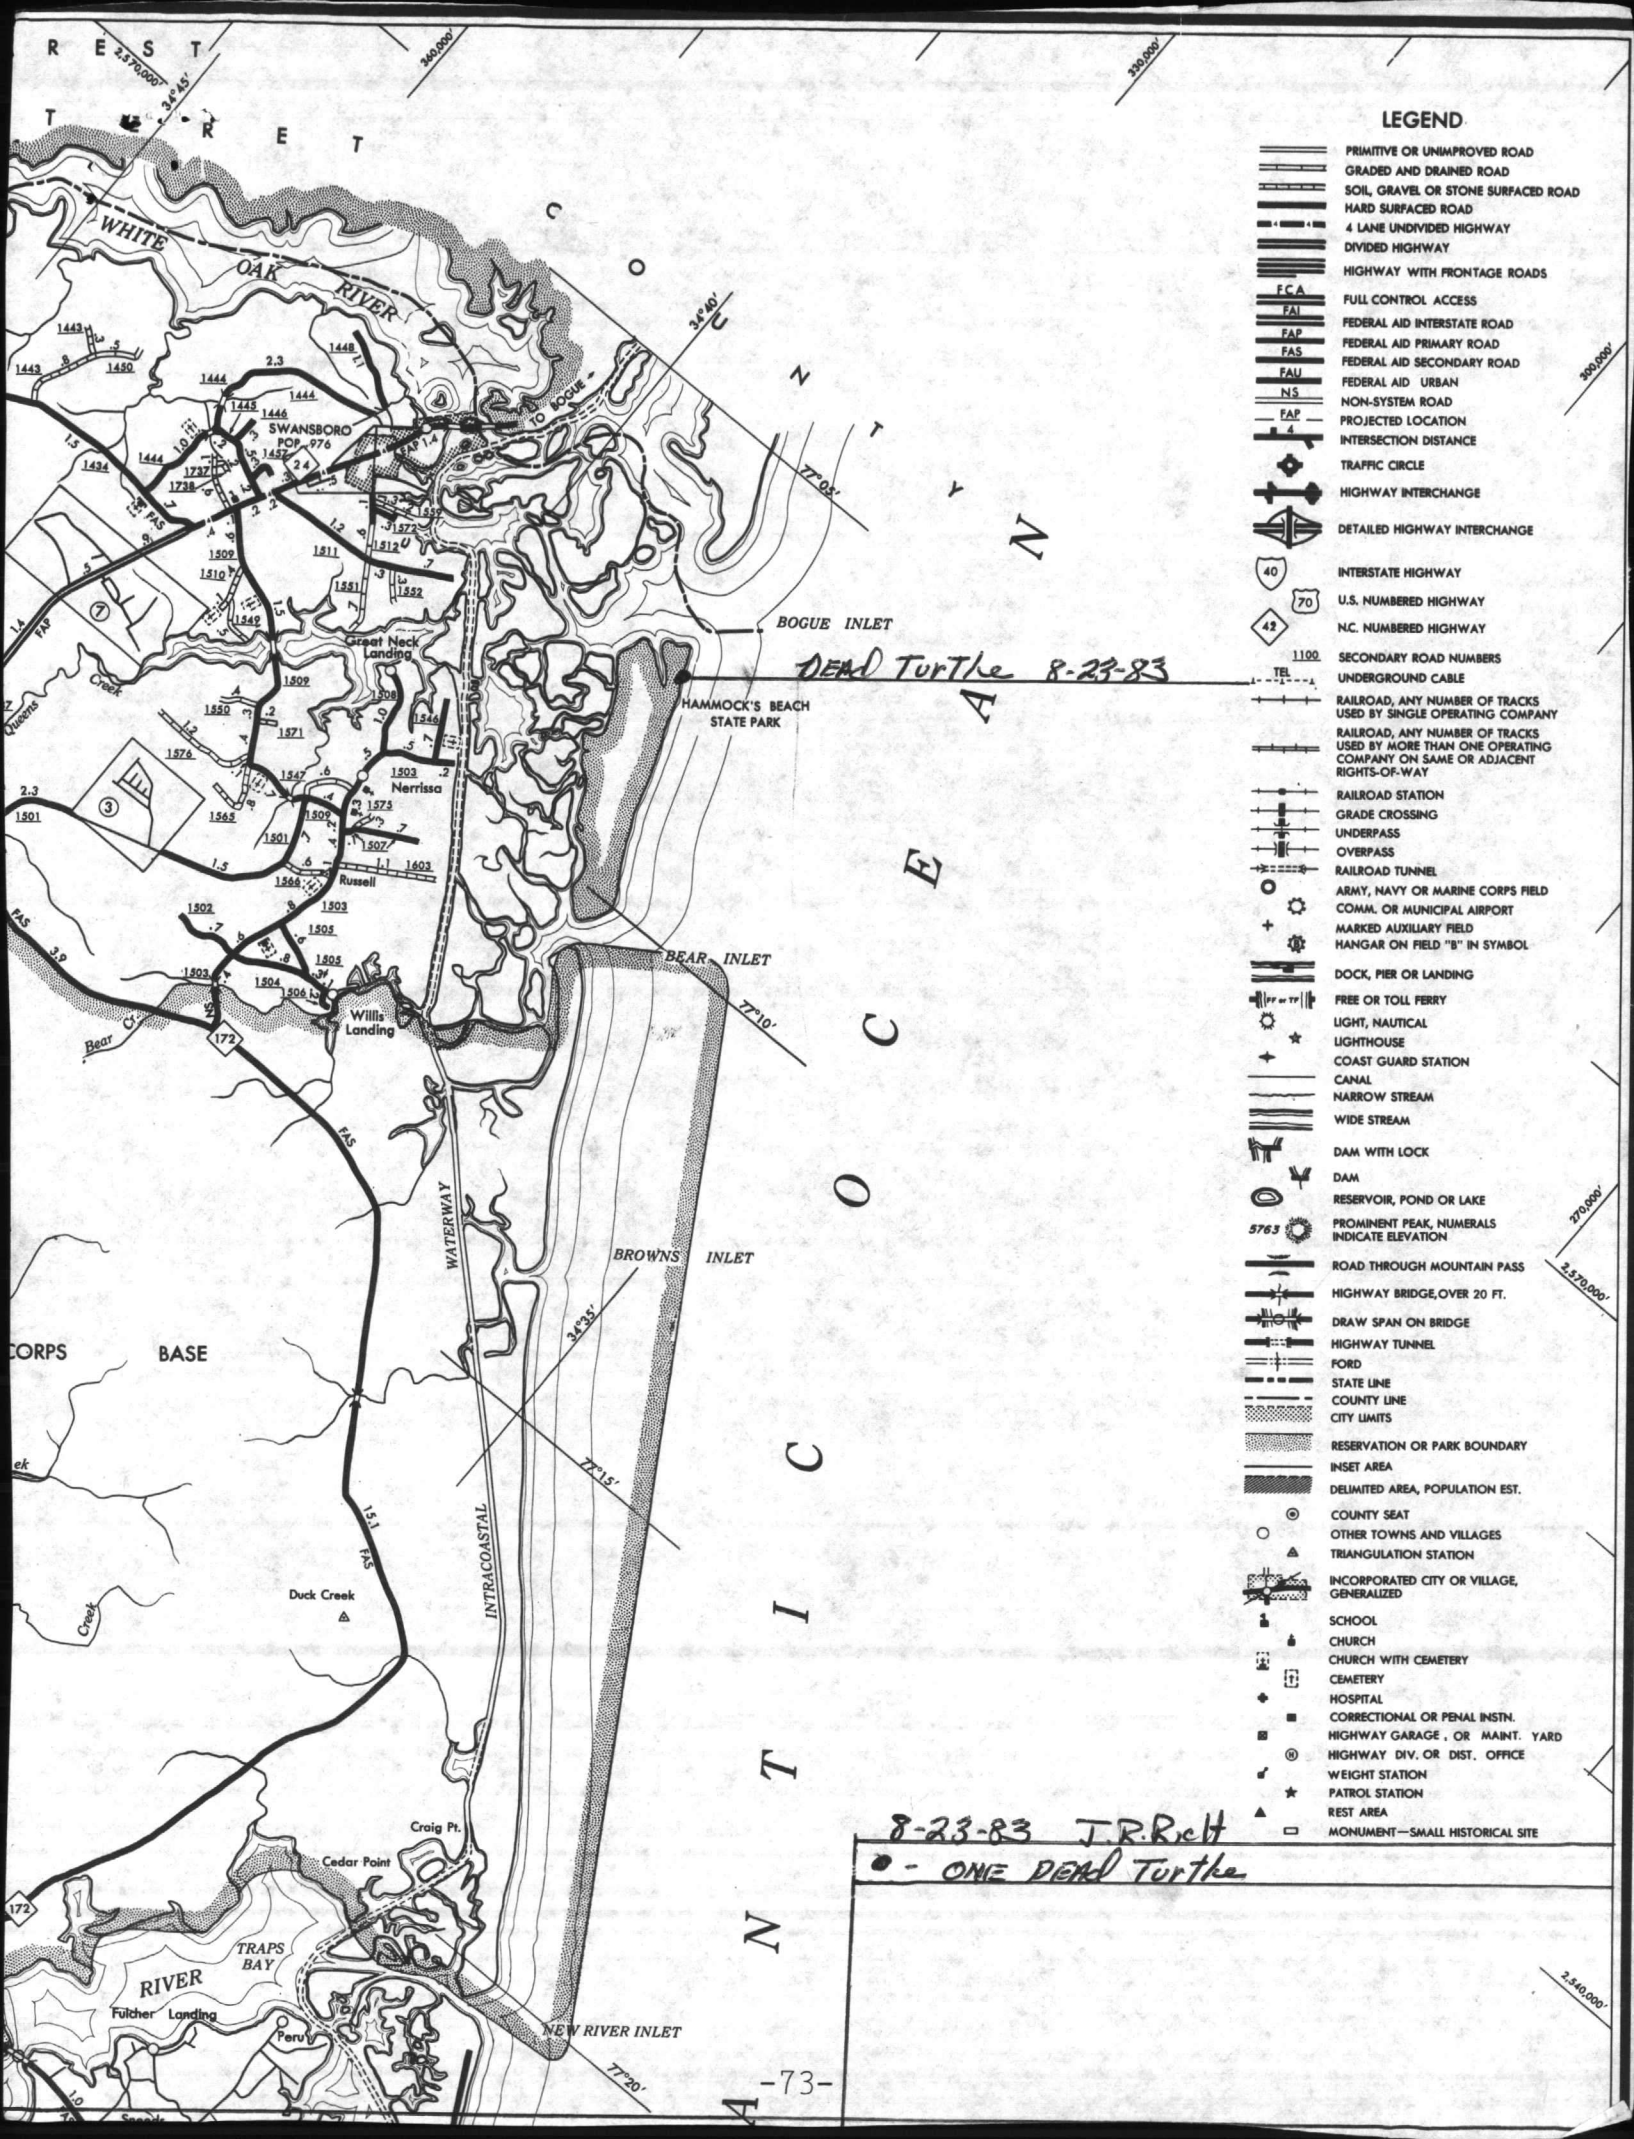

LEGEND

- PRIMITIVE OR UNIMPROVED ROAD
- GRADED AND DRAINED ROAD
- SOIL, GRAVEL OR STONE SURFACED ROAD
- HARD SURFACED ROAD
- 4 LANE UNDIVIDED HIGHWAY
- DIVIDED HIGHWAY
- HIGHWAY WITH FRONTAGE ROADS
- FCA FULL CONTROL ACCESS
- FAI FEDERAL AID INTERSTATE ROAD
- FAP FEDERAL AID PRIMARY ROAD
- FAS FEDERAL AID SECONDARY ROAD
- FAU FEDERAL AID URBAN
- NS NON-SYSTEM ROAD
- FAS PROJECTED LOCATION
- INTERSECTION DISTANCE
- TRAFFIC CIRCLE
- HIGHWAY INTERCHANGE
- DETAILED HIGHWAY INTERCHANGE
- INTERSTATE HIGHWAY
- U.S. NUMBERED HIGHWAY
- NC. NUMBERED HIGHWAY
- SECONDARY ROAD NUMBERS
- UNDERGROUND CABLE
- RAILROAD, ANY NUMBER OF TRACKS USED BY SINGLE OPERATING COMPANY
- RAILROAD, ANY NUMBER OF TRACKS USED BY MORE THAN ONE OPERATING COMPANY ON SAME OR ADJACENT RIGHTS-OF-WAY
- RAILROAD STATION
- GRADE CROSSING
- UNDERPASS
- OVERPASS
- RAILROAD TUNNEL
- ARMY, NAVY OR MARINE CORPS FIELD
- COMM. OR MUNICIPAL AIRPORT
- MARKED AUXILIARY FIELD
- HANGAR ON FIELD "B" IN SYMBOL
- DOCK, PIER OR LANDING
- FREE OR TOLL FERRY
- LIGHT, NAUTICAL
- LIGHTHOUSE
- COAST GUARD STATION
- CANAL
- NARROW STREAM
- WIDE STREAM
- DAM WITH LOCK
- DAM
- RESERVOIR, POND OR LAKE
- PROMINENT PEAK, NUMERALS INDICATE ELEVATION
- ROAD THROUGH MOUNTAIN PASS
- HIGHWAY BRIDGE, OVER 20 FT.
- DRAW SPAN ON BRIDGE
- HIGHWAY TUNNEL
- FORD
- STATE LINE
- COUNTY LINE
- CITY LIMITS
- RESERVATION OR PARK BOUNDARY
- INSET AREA
- DELIMITED AREA, POPULATION EST.
- COUNTY SEAT
- OTHER TOWNS AND VILLAGES
- TRIANGULATION STATION
- INCORPORATED CITY OR VILLAGE, GENERALIZED
- SCHOOL
- CHURCH
- CHURCH WITH CEMETERY
- CEMETERY
- HOSPITAL
- CORRECTIONAL OR PENAL INSTN.
- HIGHWAY GARAGE, OR MAINT. YARD
- HIGHWAY DIV. OR DIST. OFFICE
- WEIGHT STATION
- PATROL STATION
- REST AREA
- MONUMENT—SMALL HISTORICAL SITE

DEAD Turtle 8-23-83

8-23-83 J.R. Riehl
• - ONE DEAD Turtle

100

100

AERIAL SURVEY DATA

Date: August 31 1983 Time: S _____ F _____

Recorder Name: Jerry R. Rich

Crew Names: None Pilot: _____

Co-Pilot: None Crew Chief: _____

Others: None

Weather: General 200 Ft 1/4 mile fog Cloud Cover _____

Wind Speed _____ Sea Conditions _____

BEACH AERIAL SURVEYS Altitude _____
Air Speed _____

Location	Crawls		Nests		Nest Predation	
	New	Old	New	Old	New	Old
Onslow Beach	Unable to make flight due to weather, Kinston 200 ft. 1/4 miles fog from 05:00 thru 08:00. Check with range					
Browns Island	control about making flight after 08:00. Unable to					
Bear Beach	make flight after 08:00 because range in use from 08:00 thru 17:00. Cancel flight for 31 August 1983					
					J. R. Rich	

OCEAN AERIAL SURVEYS Altitude _____
Air Speed _____

Bell Buoy from Bogue Inlet to New River Inlet	Live Turtles		Dead Turtles
	Juvenile	Adults	

Comments: _____













SEA TURTLE INVENTORY
(Nesting Data)

Marine Corps Base
Camp Lejeune, North Carolina

Date Female Nested 6-8-83 Nest No. 001 Tag No. AAR 051 Time 0015

Date Eggs Hatched _____ Nest Location (Miles/tenths from Risley Pier) 1.6 S

Visibility Good Weather Conditions Fair

Wind Speed and direction S-10 knots NE Air Temperature 67° F

Water Temperature 70° F Time Ashore (Known or estimated) ~2315

Carapace Length 39½ Carapace width 35½

Carapace condition (Damages/barnacle infestation, etc.) 2 cuts above left h. Fl.

Head length/width 13/9 Right front flipper length 18½

Right rear flipper length 14½ Estimated weight 275-300

Flipper condition (cuts, missing portions, etc.) good


Body pit length/width 50"/48" Depth to egg chamber 12"

Time of nearest low ~6:00 or high tide _____

Distance of nest below _____ or above high tide line 60'

Comments: Tagged AAR 051, 052. Nestled 160 eggs - relocated up into dunes.

Summary of Instructions: Conduct tagging and collection of pertinent nesting data during peak nesting periods beginning approximately two nights prior to each full moon, June through August. Begin survey one-half hour after high tide. Attempt to tag nesting turtles after they have begun depositing eggs in egg chamber. Use lights only sparingly in accomplishing the operation.

 


SEA TURTLE INVENTORY
(Nesting Data)

Marine Corps Base
Camp Lejeune, North Carolina

3.1
Date Female Nested 6-15-83 Nest No. 005 Tag No. _____ Time 2400
Date Eggs Hatched _____ Nest Location (Miles/tenths from Risley Pier) 1.2 (S)
Visibility good Weather Conditions Fair
Wind Speed and direction 0-5 knots NNE Air Temperature 70°F
Water Temperature _____ Time Ashore (Known or estimated) 2330
Carapace Length _____ Carapace width _____
Carapace condition (Damages/barnacle infestation, etc.) _____
Head length/width _____ Right front flipper length _____
Right rear flipper length _____ Estimated weight _____
Flipper condition (cuts, missing portions, etc.) _____
Body pit length/width _____ Depth to egg chamber _____
Time of nearest low _____ or high tide ~2330
Distance of nest below _____ or above high tide line _____
Comments: 121 eggs relocated to 1.6(S) same
same as nest # 004

Summary of Instructions: Conduct tagging and collection of pertinent nesting data during peak nesting periods beginning approximately two nights prior to each full moon, June through August. Begin survey one-half hour after high tide. Attempt to tag nesting turtles after they have begun depositing eggs in egg chamber. Use lights only sparingly in accomplishing the operation.

 

SEA TURTLE INVENTORY
(Nesting Data)

Marine Corps Base
Camp Lejeune, North Carolina

3.1
Date Female Nested 6-15-83 Nest No. 005 Tag No. _____ Time 2400

Date Eggs Hatched _____ Nest Location (Miles/tenths from Risley Pier) 1.2 (S)

Visibility good Weather Conditions Fair

Wind Speed and direction 0-5 knots NE Air Temperature 70°F

Water Temperature _____ Time Ashore (Known or estimated) 2330

Carapace Length _____ Carapace width _____

Carapace condition (Damages/barnacle infestation, etc.) _____

Head length/width _____ Right front flipper length _____

Right rear flipper length _____ Estimated weight _____

Flipper condition (cuts, missing portions, etc.) _____

Body pit length/width _____ Depth to egg chamber _____


Time of nearest low _____ or high tide ~2330

Distance of nest below _____ or above high tide line _____

Comments: 121 eggs relocated to 1.6(S) same

case as nest #004

Summary of Instructions: Conduct tagging and collection of pertinent nesting data during peak nesting periods beginning approximately two nights prior to each full moon, June through August. Begin survey one-half hour after high tide. Attempt to tag nesting turtles after they have begun depositing eggs in egg chamber. Use lights only sparingly in accomplishing the operation.

 


SEA TURTLE INVENTORY
(Nesting Data)

Marine Corps Base
Camp Lejeune, North Carolina

Date Female Nested 6-16-83 Nest No. #008 Tag No. 055 056 Time 2330
Date Eggs Hatched _____ Nest Location (Miles/tenths from Risley Pier) 3.9 (N)
Visibility good Weather Conditions Fair
Wind Speed and direction 5-16 KNOTS NE Air Temperature 75°F
Water Temperature 79°F Time Ashore (Known or estimated) 2300
Carapace Length 39" Carapace width 36"
Carapace condition (Damages/barnacle infestation, etc.) good
Head length/width 9 1/7" Right front flipper length 18"
Right rear flipper length 12" Estimated weight 275 lbs
Flipper condition (cuts, missing portions, etc.) good
Body pit length/width _____ Depth to egg chamber _____
Time of nearest low _____ or high tide ~0030
Distance of nest below _____ or above high tide line _____
Comments: 142 eggs Relocated from 3.9 (N) to 3.7 (N)

4.2
1.5
26

Summary of Instructions: Conduct tagging and collection of pertinent nesting data during peak nesting periods beginning approximately two nights prior to each full moon, June through August. Begin survey one-half hour after high tide. Attempt to tag nesting turtles after they have begun depositing eggs in egg chamber. Use lights only sparingly in accomplishing the operation.

 

6.4
3.7

SEA TURTLE INVENTORY
(Nesting Data)

Marine Corps Base
Camp Lejeune, North Carolina

Date Female Nested 6-18-83 Nest No. 012 Tag No. Time 2300

Date Eggs Hatched Nest Location (Miles/tenths from Risley
Pier) 2.7 (N)

Visibility 9000 Weather Conditions CLEAR

Wind Speed and direction B-5 Air Temperature 77°-F

Water Temperature 78°-F Time Ashore (Known or estimated) 2300

Carapace Length 41" Carapace width 33 1/2"

Carapace condition (Damages/barnacle infestation, etc.) 9000

Head length/width 12" x 9" Right front flipper length 12"

Right rear flipper length 14" Estimated weight 220 (?)

Flipper condition (cuts, missing portions, etc.) NONE

Body pit length/width 10 1/2" x 11" Depth to egg chamber 18"


Time of nearest low 2100 or high tide 20/200

Distance of nest below or above high tide line 50'

Comments: 129 eggs Laid, NO TAGS

RELOCATED NEST 8' UP SAND DUNES

Summary of Instructions: Conduct tagging and collection of pertinent nesting data during peak nesting periods beginning approximately two nights prior to each full moon, June through August. Begin survey one-half hour after high tide. Attempt to tag nesting turtles after they have begun depositing eggs in egg chamber. Use lights only sparingly in accomplishing the operation.

 


SEA TURTLE INVENTORY
(Nesting Data)

Marine Corps Base
Camp Lejeune, North Carolina

Date Female Nested 6-28-83 Nest No. 002 Tag No. _____ Time 0200
Date Eggs Hatched _____ Nest Location (Miles/tenths from Risley
Pier) 1.0 (N)
Visibility Fair Weather Conditions Partly cloudy
Wind Speed and direction 5-10 knots S Air Temperature 75°F
Water Temperature 79°F Time Ashore (Known or estimated) 0300
Carapace Length _____ Carapace width _____
Carapace condition (Damages/barnacle infestation, etc.) _____
Head length/width _____ Right front flipper length _____
Right rear flipper length _____ Estimated weight _____
Flipper condition (cuts, missing portions, etc.) _____
Body pit length/width 4x5 Depth to egg chamber 10"
Time of nearest low _____ or high tide 2300
Distance of nest below _____ or above high tide line 40'
Comments: 11 eggs relocated to June

Summary of Instructions: Conduct tagging and collection of pertinent nesting data during peak nesting periods beginning approximately two nights prior to each full moon, June through August. Begin survey one-half hour after high tide. Attempt to tag nesting turtles after they have begun depositing eggs in egg chamber. Use lights only sparingly in accomplishing the operation.

 

SEA TURTLE INVENTORY
(Nesting Data)

Marine Corps Base
Camp Lejeune, North Carolina

81365

Date Female Nested 6-19-83 Nest No. 015 Tag No. 814^{RS} Time 2200

Date Eggs Hatched _____ Nest Location (Miles/tenths from Risley Pier) 2.7 (S)

Visibility Fair Weather Conditions Partly cloudy

Wind Speed and direction 0-5 SE Air Temperature _____

Water Temperature 80° F Time Ashore (Known or estimated) 2145

Carapace Length 42" Carapace width 37"

Carapace condition (Damages/barnacle infestation, etc.) good

Head length/width 12 x 8 Right front flipper length 18 1/2"

Right rear flipper length 12" Estimated weight 320 lbs

Flipper condition (cuts, missing portions, etc.) good

Body pit length/width 4 x 5 Depth to egg chamber 10"


Time of nearest low _____ or high tide 0430

Distance of nest below _____ or above high tide line 100'

Comments: Return 90 eggs. 2.7(S) relocated to

2.3(S) same nest (cage) as #007

Summary of Instructions: Conduct tagging and collection of pertinent nesting data during peak nesting periods beginning approximately two nights prior to each full moon, June through August. Begin survey one-half hour after high tide. Attempt to tag nesting turtles after they have begun depositing eggs in egg chamber. Use lights only sparingly in accomplishing the operation.

 

SEA TURTLE INVENTORY
(Nesting Data)

Marine Corps Base
Camp Lejeune, North Carolina

Date Female Nested 6-19-83 Nest No. 016 Tag No. 059 Time 0135

Date Eggs Hatched _____ Nest Location (Miles/tenths from Risley Pier) 2.0 (N)

Visibility good Weather Conditions Fair

Wind Speed and direction 0-5 knots SE Air Temperature _____

Water Temperature 86° Time Ashore (Known or estimated) 0100

Carapace Length 40 Carapace width 38

Carapace condition (Damages/barnacle infestation, etc.) good

Head length/width 11/8 Right front flipper length 18

Right rear flipper length 11 Estimated weight 320.165

Flipper condition (cuts, missing portions, etc.) good

Body pit length/width 4x5 Depth to egg chamber 10"


Time of nearest low _____ or high tide _____

Distance of nest below _____ or above high tide line 30'

Comments: 133 eggs relocated to 2.3(N), tagged

the turtle

Summary of Instructions: Conduct tagging and collection of pertinent nesting data during peak nesting periods beginning approximately two nights prior to each full moon, June through August. Begin survey one-half hour after high tide. Attempt to tag nesting turtles after they have begun depositing eggs in egg chamber. Use lights only sparingly in accomplishing the operation.

 

SEA TURTLE INVENTORY
(Nesting Data)

Marine Corps Base
Camp Lejeune, North Carolina

Date Female Nested 6-20-82 Nest No. 017 Tag No. 062 Time 2300

Date Eggs Hatched _____ Nest Location (Miles/tenths from Risley
Pier) 3.6 (2)

Visibility Fair, cloudy Weather Conditions Partly cloudy

Wind Speed and direction 0-5 knots SE Air Temperature 25.0 F

Water Temperature 80 °F Time Ashore (Known or estimated) 2245

Carapace Length 36 Carapace width 34

Carapace condition (Damages/barnacle infestation, etc.) good

Head length/width 10/7 Right front flipper length 18

Right rear flipper length 13 Estimated weight 275

Flipper condition (cuts, missing portions, etc.) good

Body pit length/width 3x4 Depth to egg chamber 9"


Time of nearest low 2330 or high tide _____

Distance of nest below _____ or above high tide line 10'

Comments: 165 eggs relocated to dunes

as #228

Summary of Instructions: Conduct tagging and collection of pertinent nesting data during peak nesting periods beginning approximately two nights prior to each full moon, June through August. Begin survey one-half hour after high tide. Attempt to tag nesting turtles after they have begun depositing eggs in egg chamber. Use lights only sparingly in accomplishing the operation.

 

SEA TURTLE INVENTORY
(Nesting Data)

mistake in
recording

Marine Corps Base
Camp Lejeune, North Carolina

Date Female Nested 6-20-83 Nest No. 019 Tag No. 768 ⁰⁶³ ~~769~~ ⁰⁶⁴ Time 0230

Date Eggs Hatched _____ Nest Location (Miles/tenths from Risley Pier) 2.2 (N)

Visibility Fair Weather Conditions good

Wind Speed and direction 0-5 knots SE Air Temperature 70°F

Water Temperature 80°F Time Ashore (Known or estimated) 0215

Carapace Length 39 1/2 Carapace width 38

Carapace condition (Damages/barnacle infestation, etc.) good

Head length/width 16/7 Right front flipper length 18

Right rear flipper length 17 Estimated weight 285

Flipper condition (cuts, missing portions, etc.) good

Body pit length/width _____ Depth to egg chamber _____

Time of nearest low _____ or high tide 0530


Distance of nest below _____ or above high tide line _____

Comments: 130 eggs - Relocated to dunes

Retagged #s 768, 769 - old tags

difficult to see. Originally tagged 8-1-81

Summary of Instructions: Conduct tagging and collection of pertinent nesting data during peak nesting periods beginning approximately two nights prior to each full moon, June through August. Begin survey one-half hour after high tide. Attempt to tag nesting turtles after they have begun depositing eggs in egg chamber. Use lights only sparingly in accomplishing the operation.

 

17.3

SEA TURTLE INVENTORY
(Nesting Data)

Marine Corps Base
Camp Lejeune, North Carolina

AAR 065

Date Female Nested 6-24-83 Nest No. 020 Tag No. AAR 066 Time 2200

Date Eggs Hatched - Nest Location (Miles/tenths from Risley Pier) 2.2 N

Visibility Good Weather Conditions Fair

Wind Speed and direction 5-10 SW Air Temperature 78°F

Water Temperature 78°F Time Ashore (Known or estimated) 1 1/2 hr

Carapace Length 39 Carapace width 35 1/2

Carapace condition (Damages/barnacle infestation, etc.) Many Barnacles

Head length/width 9 x 7 Right front flipper length 16

Right rear flipper length 10 1/2 Estimated weight 250

Flipper condition (cuts, missing portions, etc.) ok

Body pit length/width 5 x 4 Depth to egg chamber 10"


Time of nearest low _____ or high tide 2100

Distance of nest below _____ or above high tide line 5 m

Comments: Relocated Nest to top of

dunes - 107 Eggs

Summary of Instructions: Conduct tagging and collection of pertinent nesting data during peak nesting periods beginning approximately two nights prior to each full moon, June through August. Begin survey one-half hour after high tide. Attempt to tag nesting turtles after they have begun depositing eggs in egg chamber. Use lights only sparingly in accomplishing the operation.

 

SEA TURTLE INVENTORY
(Nesting Data)

Marine Corps Base
Camp Lejeune, North Carolina

AAR 071

Date Female Nested 7-1-83 Nest No. 023 Tag No. IMS 716 Time 2200

Date Eggs Hatched _____ Nest Location (Miles/tenths from Risley Pier) 2.6(N)

Visibility _____ Weather Conditions _____

Wind Speed and direction 5-10 knots E Air Temperature 75°F

Water Temperature 78°F Time Ashore (Known or estimated) 2145

Carapace Length 41 Carapace width 40

Carapace condition (Damages/barnacle infestation, etc.) _____

Head length/width _____ Right front flipper length _____

Right rear flipper length _____ Estimated weight 300+

Flipper condition (cuts, missing portions, etc.) _____

Body pit length/width _____ Depth to egg chamber _____


Time of nearest low _____ or high tide _____

Distance of nest below _____ or above high tide line _____

Comments: Turtle frightened by truck lights

Originally tagged 6-30-81

Summary of Instructions: Conduct tagging and collection of pertinent nesting data during peak nesting periods beginning approximately two nights prior to each full moon, June through August. Begin survey one-half hour after high tide. Attempt to tag nesting turtles after they have begun depositing eggs in egg chamber. Use lights only sparingly in accomplishing the operation.

 

SEA TURTLE INVENTORY
(Nesting Data)

Marine Corps Base
Camp Lejeune, North Carolina

Date Female Nesting 7-1-83 Nest No. 026 Tag No. AAR 069 Time 2200
NO NEST

Date Eggs Hatched _____ Nest Location (Miles/tenths from Risley
Pier) CO-2.7N

Visibility Good Weather Conditions Partly Cloudy

Wind Speed and direction 5-10 SW Air Temperature 78

Water Temperature 79 Time Ashore (Known or estimated) 15 min

Carapace Length 39 1/2 Carapace width 38

Carapace condition (Damages/barnacle infestation, etc.) many

Head length/width 9 x 7 Right front flipper length 19

Right rear flipper length 14 Estimated weight 300

Flipper condition (cuts, missing portions, etc.) all good


Body pit length/width X Depth to egg chamber X

Time of nearest low _____ or high tide 0100

Distance of nest below X or above high tide line X

Comments: Turtle just coming out of water
when spotted, which frightened her
back to sea -

Summary of Instructions: Conduct tagging and collection of pertinent nesting data during peak nesting periods beginning approximately two nights prior to each full moon, June through August. Begin survey one-half hour after high tide. Attempt to tag nesting turtles after they have begun depositing eggs in egg chamber. Use lights only sparingly in accomplishing the operation.

 

SEA TURTLE INVENTORY
(Nesting Data)

Marine Corps Base
Camp Lejeune, North Carolina

Return
813 IMS(?)
814

Date Female Nested 7-1-83 Nest No. 027 Tag No. 814 Time 2130

Date Eggs Hatched _____ Nest Location (Miles/tenths from Risley Pier) 4.0 N

Visibility good Weather Conditions Partly cloudy warm

Wind Speed and direction 5-10 SW Air Temperature 78

Water Temperature 79 Time Ashore (Known or estimated) 1 1/2 hr

Carapace Length _____ Carapace width _____

Carapace condition (Damages/barnacle infestation, etc.) _____

Head length/width _____ Right front flipper length _____

Right rear flipper length _____ Estimated weight 300

Flipper condition (cuts, missing portions, etc.) good


Body pit length/width _____ Depth to egg chamber 8"

Time of nearest low _____ or high tide 0100

Distance of nest below _____ or above high tide line 30 m

Comments: 138 Eggs moved to better spot

Summary of Instructions: Conduct tagging and collection of pertinent nesting data during peak nesting periods beginning approximately two nights prior to each full moon, June through August. Begin survey one-half hour after high tide. Attempt to tag nesting turtles after they have begun depositing eggs in egg chamber. Use lights only sparingly in accomplishing the operation.

 

SEA TURTLE INVENTORY
(Nesting Data)

Marine Corps Base
Camp Lejeune, North Carolina

Date Female Nested 7-2-83 Nest No. 028 Tag No. FMS 716 AAR 071 Time 2200

Date Eggs Hatched _____ Nest Location (Miles/tenths from Risley Pier) 2.3 (N)

Visibility good Weather Conditions Partly Cloudy

Wind Speed and direction 5-10 SW Air Temperature 78

Water Temperature 80 Time Ashore (Known or estimated) 45 min

Carapace Length _____ Carapace width _____

Carapace condition (Damages/barnacle infestation, etc.) _____

Head length/width _____ Right front flipper length _____

Right rear flipper length _____ Estimated weight _____

Flipper condition (cuts, missing portions, etc.) _____

Body pit length/width _____ Depth to egg chamber _____


Time of nearest low _____ or high tide 0100

Distance of nest below _____ or above high tide line _____

Comments: disturbed turtle when tagging

17 Eggs moved to share cage

Summary of Instructions: Conduct tagging and collection of pertinent nesting data during peak nesting periods beginning approximately two nights prior to each full moon, June through August. Begin survey one-half hour after high tide. Attempt to tag nesting turtles after they have begun depositing eggs in egg chamber. Use lights only sparingly in accomplishing the operation.

 


SEA TURTLE INVENTORY
(Nesting Data)

Marine Corps Base
Camp Lejeune, North Carolina

nest → 7-1-83
Date Female Nested 6-30-83 Nest No. 031 Tag No. 068 Time 0200
Date Eggs Hatched _____ Nest Location (Miles/tenths from Risley Pier) 2.1 (N) 0.0(S)
Visibility good Weather Conditions Partly Cloud
Wind Speed and direction 0-5 knots SE Air Temperature 75°F
Water Temperature 78°F Time Ashore (Known or estimated) 0200
Carapace Length 39" Carapace width 34"
Carapace condition (Damages/barnacle infestation, etc.) good
Head length/width 9/7 Right front flipper length 16
Right rear flipper length 13 Estimated weight 275
Flipper condition (cuts, missing portions, etc.) good
Body pit length/width _____ Depth to egg chamber _____
Time of nearest low _____ or high tide _____
Distance of nest below _____ or above high tide line _____
Comments: (6-10-83 C.O.) 134 eggs moved to 0.1 (N)

Summary of Instructions: Conduct tagging and collection of pertinent nesting data during peak nesting periods beginning approximately two nights prior to each full moon, June through August. Begin survey one-half hour after high tide. Attempt to tag nesting turtles after they have begun depositing eggs in egg chamber. Use lights only sparingly in accomplishing the operation.

 

SEA TURTLE INVENTORY
(Nesting Data)

Marine Corps Base
Camp Lejeune, North Carolina

1-2-83
Date Female Nested 7-3-83 Nest No. 036 Tag No. AAR-059
060 Time 2245

Date Eggs Hatched _____ Nest Location (Miles/tenths from Risley
Pier) 2-3(N) (0.7)

Visibility good Weather Conditions Fair

Wind Speed and direction 5-10 SW Air Temperature 82

Water Temperature 82 Time Ashore (Known or estimated) 1 hr

Carapace Length _____ Carapace width _____

Carapace condition (Damages/barnacle infestation, etc.) _____

Head length/width _____ Right front flipper length _____

Right rear flipper length _____ Estimated weight _____

Flipper condition (cuts, missing portions, etc.) _____


Body pit length/width 5x4 Depth to egg chamber 10"

Time of nearest low _____ or high tide 0100

Distance of nest below _____ or above high tide line 25m

Comments: 135 Eggs relocated

Summary of Instructions: Conduct tagging and collection of pertinent nesting data during peak nesting periods beginning approximately two nights prior to each full moon, June through August. Begin survey one-half hour after high tide. Attempt to tag nesting turtles after they have begun depositing eggs in egg chamber. Use lights only sparingly in accomplishing the operation.

 

SEA TURTLE INVENTORY
(Nesting Data)

1-2-83

Marine Corps Base
Camp Lejeune, North Carolina

64

Date Female ~~Nested~~ 7-3-83 Nest No. 037 Tag No. 817 Time 2315

Date Eggs Hatched _____ Nest Location (Miles/tenths from Risley Pier) 3.0 (N)

Visibility good Weather Conditions Fair

Wind Speed and direction 5-10 SW Air Temperature 82

Water Temperature 82 Time Ashore (Known or estimated) 30 min

Carapace Length 38 Carapace width 36

Carapace condition (Damages/barnacle infestation, etc.) _____

Head length/width 9x7 Right front flipper length 11 bitten off

Right rear flipper length 13 Estimated weight 275-300

Flipper condition (cuts, missing portions, etc.) RF


Body pit length/width 2 4x3 3x3 Depth to egg chamber X

Time of nearest low _____ or high tide _____

Distance of nest below _____ or above high tide line _____

Comments: Did not nest 2 body pits

Summary of Instructions: Conduct tagging and collection of pertinent nesting data during peak nesting periods beginning approximately two nights prior to each full moon, June through August. Begin survey one-half hour after high tide. Attempt to tag nesting turtles after they have begun depositing eggs in egg chamber. Use lights only sparingly in accomplishing the operation.

 

SEA TURTLE INVENTORY
(Nesting Data)

4-2-83

Marine Corps Base
Camp Lejeune, North Carolina

ARR 072
073

Date Female Nested 7-3-83 Nest No. 038 Tag No. 073 Time 2330

Date Eggs Hatched _____ Nest Location (Miles/tenths from Risley Pier) 1.5(S) rel to 0.6(N)

Visibility good Weather Conditions Fair

Wind Speed and direction 5-10 SW Air Temperature 81

Water Temperature 82 Time Ashore (Known or estimated) 1 hr

Carapace Length 43 Carapace width 41 1/2

Carapace condition (Damages/barnacle infestation, etc.) _____

Head length/width 10/9 Right front flipper length 17

Right rear flipper length 114 Estimated weight 325

Flipper condition (cuts, missing portions, etc.) _____

Body pit length/width 5x5 Depth to egg chamber 12"


Time of nearest low _____ or high tide 0100

Distance of nest below _____ or above high tide line 15m

Comments: 137 Eggs relocated to 0.6(N) in

same cage as 039

Summary of Instructions: Conduct tagging and collection of pertinent nesting data during peak nesting periods beginning approximately two nights prior to each full moon, June through August. Begin survey one-half hour after high tide. Attempt to tag nesting turtles after they have begun depositing eggs in egg chamber. Use lights only sparingly in accomplishing the operation.

 

SEA TURTLE INVENTORY
(Nesting Data)

Marine Corps Base
Camp Lejeune, North Carolina

Date Female Nested 7-3-83 Nest No. 039 Tag No. 716 AAZ-071 Time 0145

Date Eggs Hatched _____ Nest Location (Miles/tenths from Risley
Pier) 0.6(N)

Visibility good Weather Conditions Fair

Wind Speed and direction 5-10 SW Air Temperature 78

Water Temperature 82 Time Ashore (Known or estimated) 1 hr

Carapace Length _____ Carapace width _____

Carapace condition (Damages/barnacle infestation, etc.) _____

Head length/width _____ Right front flipper length _____

Right rear flipper length _____ Estimated weight _____

Flipper condition (cuts, missing portions, etc.) _____

Body pit length/width _____ Depth to egg chamber _____

Time of nearest low _____ or high tide 0100

Distance of nest below _____ or above high tide line 25 N

Comments: 99 Eggs relocated to nest 038 cage
turtle up to finish laying-

Summary of Instructions: Conduct tagging and collection of pertinent nesting data during peak nesting periods beginning approximately two nights prior to each full moon, June through August. Begin survey one-half hour after high tide. Attempt to tag nesting turtles after they have begun depositing eggs in egg chamber. Use lights only sparingly in accomplishing the operation.

12

SEA TURTLE INVENTORY
(Nesting Data)

Marine Corps Base
Camp Lejeune, North Carolina

Date Female Nested 7-8-83 Nest No. 045 Tag No. 074 Time 0035

Date Eggs Hatched _____ Nest Location (Miles/tenths from Risley
Pier) 0.4 (N)

Visibility _____ Weather Conditions _____

Wind Speed and direction _____ Air Temperature _____

Water Temperature _____ Time Ashore (Known or estimated) _____

Carapace Length 39 1/2 Carapace width 35

Carapace condition (Damages/barnacle infestation, etc.) _____

Head length/width 11" / 8 1/2" Right front flipper length 17"

Right rear flipper length 13" Estimated weight 200

Flipper condition (cuts, missing portions, etc.) — ✓

Body pit length/width 7x8 Depth to egg chamber 8"

Time of nearest low 01330 or high tide _____

Distance of nest below _____ or above high tide line 8'

Comments: _____

Summary of Instructions: Conduct tagging and collection of pertinent nesting data during peak nesting periods beginning approximately two nights prior to each full moon, June through August. Begin survey one-half hour after high tide. Attempt to tag nesting turtles after they have begun depositing eggs in egg chamber. Use lights only sparingly in accomplishing the operation.

Q. 3
8/10
1/5



SEA TURTLE INVENTORY
(Nesting Data)

Marine Corps Base
Camp Lejeune, North Carolina

Date Female Nested 7-11-87 Nest No. 049 Tag No. 065 ^{Return} 066 Time 0930

Date Eggs Hatched _____ Nest Location (Miles/tenths from Risley Pier) 2.3 (N)

Visibility Good Weather Conditions Partly Cloudy

Wind Speed and direction 0-5 knots E Air Temperature 78°F

Water Temperature 79°F Time Ashore (Known or estimated) 0100

Carapace Length _____ Carapace width _____

Carapace condition (Damages/barnacle infestation, etc.) _____

Head length/width _____ Right front flipper length _____

Right rear flipper length _____ Estimated weight _____

Flipper condition (cuts, missing portions, etc.) _____

Body pit length/width 4x5 Depth to egg chamber _____


Time of nearest low 0400 or high tide _____

Distance of nest below _____ or above high tide line 20'

Comments: 101 eggs Return 065, 066

put in same cage as nest #050

Summary of Instructions: Conduct tagging and collection of pertinent nesting data during peak nesting periods beginning approximately two nights prior to each full moon, June through August. Begin survey one-half hour after high tide. Attempt to tag nesting turtles after they have begun depositing eggs in egg chamber. Use lights only sparingly in accomplishing the operation.

 

Did not Tag

SEA TURTLE INVENTORY
(Nesting Data)

Marine Corps Base
Camp Lejeune, North Carolina

Date Female Nested 7-14-83 Nest No. 651 Tag No. 821 Time 8:30

Date Eggs Hatched _____ Nest Location (Miles/tenths from Risley Pier) 4.2N

Visibility good Weather Conditions clear

Wind Speed and direction _____ Air Temperature _____

Water Temperature _____ Time Ashore (Known or estimated) 0.100

Carapace Length 34 Carapace width 32

Carapace condition (Damages/barnacle infestation, etc.) good

Head length/width 8/6 Right front flipper length 15

Right rear flipper length 12 Estimated weight 175-200

Flipper condition (cuts, missing portions, etc.) _____

Body pit length/width _____ Depth to egg chamber _____


Time of nearest low _____ or high tide _____

Distance of nest below _____ or above high tide line _____

Comments: Did not tag turtle as correct

tags were not available (??)

Summary of Instructions: Conduct tagging and collection of pertinent nesting data during peak nesting periods beginning approximately two nights prior to each full moon, June through August. Begin survey one-half hour after high tide. Attempt to tag nesting turtles after they have begun depositing eggs in egg chamber. Use lights only sparingly in accomplishing the operation.

 

SEA TURTLE INVENTORY
(Nesting Data)

Marine Corps Base
Camp Lejeune, North Carolina

Date Female Nested 7-16-83 Nest No. 056 Tag No. 821 Time 2130

Date Eggs Hatched 9-11- Nest Location (Miles/tenths from Risley Pier) .8(N)

Visibility good Weather Conditions Fair

Wind Speed and direction 15 knots Air Temperature —

Water Temperature from S. Time Ashore (Known or estimated) —

Carapace Length 40" Carapace width 34"

Carapace condition (Damages/barnacle infestation, etc.) BARNACLES

Head length/width 10" - 8" Right front flipper length 173/4

Right rear flipper length 13" Estimated weight 190 lbs

Flipper condition (cuts, missing portions, etc.) NONE


Body pit length/width 4" x 3" Depth to egg chamber 15"

Time of nearest low 1900 or high tide —

Distance of nest below — or above high tide line ONTILINE

Comments: —
—
—

Summary of Instructions: Conduct tagging and collection of pertinent nesting data during peak nesting periods beginning approximately two nights prior to each full moon, June through August. Begin survey one-half hour after high tide. Attempt to tag nesting turtles after they have begun depositing eggs in egg chamber. Use lights only sparingly in accomplishing the operation.

 

SEA TURTLE INVENTORY
(Nesting Data)

Marine Corps Base
Camp Lejeune, North Carolina

Date Female Nested 7-16-88 Nest No. 057 Tag No. 822 833 Time 2400

Date Eggs Hatched _____ Nest Location (Miles/tenths from Risley Pier) 2.3(N)

Visibility 9000 Weather Conditions Clear

Wind Speed and direction 15 knots Air Temperature _____
(S-W)

Water Temperature _____ Time Ashore (Known or estimated) _____

Carapace Length 39" Carapace width 35 3/4"

Carapace condition (Damages/barnacle infestation, etc.) BARNACLES

Head length/width 13" - 8 1/2" Right front flipper length 18 1/2"

Right rear flipper length 16" Estimated weight 200

Flipper condition (cuts, missing portions, etc.) None

Body pit length/width 3 1/4" x 4" Depth to egg chamber 13"

Time of nearest low 1900 or high tide 0200

Distance of nest below _____ or above high tide line ON Tide
LINE


Comments: _____

117 eggs

Summary of Instructions: Conduct tagging and collection of pertinent nesting data during peak nesting periods beginning approximately two nights prior to each full moon, June through August. Begin survey one-half hour after high tide. Attempt to tag nesting turtles after they have begun depositing eggs in egg chamber. Use lights only sparingly in accomplishing the operation.

68.9
68.6

69.5

 

SEA TURTLE INVENTORY
(Nesting Data)

Marine Corps Base
Camp Lejeune, North Carolina

Date Female Nested 7-17-83 Nest No. 065 Tag No. IMS-766 (RAC-071) Time 2330

Date Eggs Hatched _____ Nest Location (Miles/tenths from Risley Pier) 0.40

Visibility Good Weather Conditions Partly cloudy

Wind Speed and direction 0-5 knots S Air Temperature 80° F

Water Temperature 80° F Time Ashore (Known or estimated) 2315

Carapace Length 40 Carapace width 39

Carapace condition (Damages/barnacle infestation, etc.) Good

Head length/width 11/9 Right front flipper length 18

Right rear flipper length 13 Estimated weight _____

Flipper condition (cuts, missing portions, etc.) _____


Body pit length/width 6.07 Depth to egg chamber 1 1/2'

Time of nearest low _____ or high tide 0300

Distance of nest below _____ or above high tide line 35'

Comments: 16L eggs relocated to dunes

Summary of Instructions: Conduct tagging and collection of pertinent nesting data during peak nesting periods beginning approximately two nights prior to each full moon, June through August. Begin survey one-half hour after high tide. Attempt to tag nesting turtles after they have begun depositing eggs in egg chamber. Use lights only sparingly in accomplishing the operation.

 

SEA TURTLE INVENTORY
(Nesting Data)

Marine Corps Base
Camp Lejeune, North Carolina

076; 078

Date Female Nested 7-21-83 Nest No. 067 Tag No. 076078 Time 2400

Date Eggs Hatched _____ Nest Location (Miles/tenths from Risley Pier) 1.8 mi (S)

Visibility Good Weather Conditions Fair

Wind Speed and direction 10-15 knots S Air Temperature 83°F

Water Temperature 80°F Time Ashore (Known or estimated) 2400

Carapace Length 42 Carapace width 39 1/2

Carapace condition (Damages/barnacle infestation, etc.) _____

Head length/width 11" x 8" Right front flipper length 20"

Right rear flipper length 16" Right Flipped Estimated weight 350

Flipper condition (cuts, missing portions, etc.) Missing Right Rear Flipper


Body pit length/width _____ Depth to egg chamber _____

Time of nearest low _____ or high tide _____

Distance of nest below _____ or above high tide line _____

Comments: Tagged turtle

Summary of Instructions: Conduct tagging and collection of pertinent nesting data during peak nesting periods beginning approximately two nights prior to each full moon, June through August. Begin survey one-half hour after high tide. Attempt to tag nesting turtles after they have begun depositing eggs in egg chamber. Use lights only sparingly in accomplishing the operation.

 


SEA TURTLE INVENTORY
(Nesting Data)

Marine Corps Base
Camp Lejeune, North Carolina

67
5.0

Date Female Nested 7-27-83 Nest No. 069 Tag No. 442 078 080 Time _____
Date Eggs Hatched _____ Nest Location (Miles/tenths from Risley Pier) 3.7(N)
Visibility Fair Weather Conditions Partly cloudy
Wind Speed and direction 10-15 knots E Air Temperature 77°F
Water Temperature 78°F Time Ashore (Known or estimated) 2:30
Carapace Length 33 Carapace width 32
Carapace condition (Damages/barnacle infestation, etc.) good
Head length/width 9/7 Right front flipper length 18
Right rear flipper length 12 Estimated weight _____
Flipper condition (cuts, missing portions, etc.) good
Body pit length/width _____ Depth to egg chamber _____
Time of nearest low _____ or high tide _____
Distance of nest below _____ or above high tide line _____
Comments: Tagged turtle 442 079, 080, - the wind appeared to bother the turtle

Summary of Instructions: Conduct tagging and collection of pertinent nesting data during peak nesting periods beginning approximately two nights prior to each full moon, June through August. Begin survey one-half hour after high tide. Attempt to tag nesting turtles after they have begun depositing eggs in egg chamber. Use lights only sparingly in accomplishing the operation.

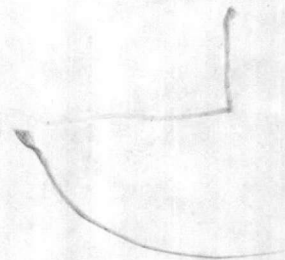

SEA TURTLE INVENTORY
(Nesting Data)

Marine Corps Base
Camp Lejeune, North Carolina

Date Female Nested 7-28-83 Nest No. 072 Tag No. JMS 817 Time 2215

Date Eggs Hatched _____ Nest Location (Miles/tenths from Risley Pier) 2.3 (N)

Visibility good Weather Conditions clear

Wind Speed and direction 5-10 knots E Air Temperature 80F

Water Temperature 80°F Time Ashore (Known or estimated) 2201

Carapace Length _____ Carapace width _____

Carapace condition (Damages/barnacle infestation, etc.) _____

Head length/width _____ Right front flipper length _____

Right rear flipper length _____ Estimated weight _____

Flipper condition (cuts, missing portions, etc.) _____


Body pit length/width 4x5 Depth to egg chamber _____

Time of nearest low _____ or high tide 2300

Distance of nest below _____ or above high tide line _____

Comments: CV. 1 body pit. A layer of shells
about 6-8" deep seemed to impede nest digging

Summary of Instructions: Conduct tagging and collection of pertinent nesting data during peak nesting periods beginning approximately two nights prior to each full moon, June through August. Begin survey one-half hour after high tide. Attempt to tag nesting turtles after they have begun depositing eggs in egg chamber. Use lights only sparingly in accomplishing the operation.

 

SEA TURTLE INVENTORY
(Nesting Data)

Marine Corps Base
Camp Lejeune, North Carolina

Date Female Nested 7-28-83 Nest No. 072 Tag No. JMS 817 Time 2235

Date Eggs Hatched _____ Nest Location (Miles/tenths from Risley Pier) 2.3 (N)

Visibility good Weather Conditions clear

Wind Speed and direction 5-10 knots E Air Temperature 80F

Water Temperature 80°F Time Ashore (Known or estimated) 2301

Carapace Length _____ Carapace width _____

Carapace condition (Damages/barnacle infestation, etc.) _____

Head length/width _____ Right front flipper length _____

Right rear flipper length _____ Estimated weight _____

Flipper condition (cuts, missing portions, etc.) _____

Body pit length/width 4x6 Depth to egg chamber _____

Time of nearest low _____ or high tide 2300

Distance of nest below _____ or above high tide line _____

Comments: CO. 1 body pit A layer of shells

about 6-8" deep seemed to impede nest digging


Summary of Instructions: Conduct tagging and collection of pertinent nesting data during peak nesting periods beginning approximately two nights prior to each full moon, June through August. Begin survey one-half hour after high tide. Attempt to tag nesting turtles after they have begun depositing eggs in egg chamber. Use lights only sparingly in accomplishing the operation.

SEA TURTLE INVENTORY
(Nesting Data)

Marine Corps Base
Camp Lejeune, North Carolina

Date Female Nested 7-29-83 Nest No. 077 Tag No. 081 Time 1230
Date Eggs Hatched _____ Nest Location (Miles/tenths from Risley Pier) 2.9(W)
Visibility poor Weather Conditions cldy
Wind Speed and direction 12 knots Air Temperature _____
Water Temperature 76° F Time Ashore (Known or estimated) 1 1/2 hr.
Carapace Length 38 1/2" Carapace width 36"
Carapace condition (Damages/barnacle infestation, etc.) Barnacles
Head length/width 9 1/2" - 7 3/4" Right front flipper length 17 3/4"
Right rear flipper length 12" Estimated weight 300
Flipper condition (cuts, missing portions, etc.) NONE
Body pit length/width 5 1/4" Depth to egg chamber 10"
Time of nearest low 6:00 or high tide 12:00
Distance of nest below _____ or above high tide line 12"
Comments: _____

Summary of Instructions: Conduct tagging and collection of pertinent nesting data during peak nesting periods beginning approximately two nights prior to each full moon, June through August. Begin survey one-half hour after high tide. Attempt to tag nesting turtles after they have begun depositing eggs in egg chamber. Use lights only sparingly in accomplishing the operation.

 

SEA TURTLE INVENTORY
(Nesting Data)

Marine Corps Base
Camp Lejeune, North Carolina

Date Female Nested 7-30-83 Nest No. 080 Tag No. 084 Time 2300

Date Eggs Hatched _____ Nest Location (Miles/tenths from Risley Pier) 2.2 N

Visibility 900ft Weather Conditions Fair

Wind Speed and direction 1DK SE Air Temperature 78°F

Water Temperature 76°F Time Ashore (Known or estimated) 1 hr.

Carapace Length 36" " Carapace width 28 1/2" "

Carapace condition (Damages/barnacle infestation, etc.) BARNACLES

Head length/width 8 1/2" / 6 1/2" " Right front flipper length 13 1/2" "

Right rear flipper length 10 1/2" " Estimated weight 180 lbs

Flipper condition (cuts, missing portions, etc.) Good


Body pit length/width 3 1/2" x 2 1/2" " Depth to egg chamber 14" "

Time of nearest low _____ or high tide 0100

Distance of nest below _____ or above high tide line 15'

Comments: _____

Summary of Instructions: Conduct tagging and collection of pertinent nesting data during peak nesting periods beginning approximately two nights prior to each full moon, June through August. Begin survey one-half hour after high tide. Attempt to tag nesting turtles after they have begun depositing eggs in egg chamber. Use lights only sparingly in accomplishing the operation.

 

SEA TURTLE INVENTORY
(Nesting Data)

Marine Corps Base
Camp Lejeune, North Carolina

Date Female Nested 8-5-83 Nest No. #084 Tag No. #086 ^{#085} Time 2210

Date Eggs Hatched _____ Nest Location (Miles/tenths from Risley Pier) _____

Visibility good Weather Conditions clear

Wind Speed and direction 15-20 knots Air Temperature 80°F

Water Temperature 74°F Time Ashore (Known or estimated) _____

Carapace Length 39 1/2" Carapace width 34"

Carapace condition (Damages/barnacle infestation, etc.) good, barnacles

Head length/width 9" x 7" Right front flipper length 17 1/4"

Right rear flipper length 15 1/4" Estimated weight 270

Flipper condition (cuts, missing portions, etc.) none


Body pit length/width 6" x 4" Depth to egg chamber 18"

Time of nearest low 2000 or high tide _____

Distance of nest below 40' or above high tide line _____

Comments: _____

Summary of Instructions: Conduct tagging and collection of pertinent nesting data during peak nesting periods beginning approximately two nights prior to each full moon, June through August. Begin survey one-half hour after high tide. Attempt to tag nesting turtles after they have begun depositing eggs in egg chamber. Use lights only sparingly in accomplishing the operation.

 

SEA TURTLE INVENTORY
(Nesting Data)

AAR06970
AAR070

Marine Corps Base
Camp Lejeune, North Carolina

Date Female Nested 8-12-83 Nest No. 088 Tag No. 70 Time 0130

Date Eggs Hatched _____ Nest Location (Miles/tenths from Risley Pier) 3.5 N

Visibility Fair Weather Conditions CLdy

Wind Speed and direction _____ Air Temperature _____

Water Temperature _____ Time Ashore (Known or estimated) 40 min.

Carapace Length 38" Carapace width 34"

Carapace condition (Damages/barnacle infestation, etc.) Barnacles

Head length/width 11"/7" Right front flipper length 17"

Right rear flipper length 13" Estimated weight 240

Flipper condition (cuts, missing portions, etc.) Good


Body pit length/width 4'/3' Depth to egg chamber 14"

Time of nearest low _____ or high tide 0030

Distance of nest below _____ or above high tide line 50'


Comments: _____

Summary of Instructions: Conduct tagging and collection of pertinent nesting data during peak nesting periods beginning approximately two nights prior to each full moon, June through August. Begin survey one-half hour after high tide. Attempt to tag nesting turtles after they have begun depositing eggs in egg chamber. Use lights only sparingly in accomplishing the operation.

 

HUGH PASSINGHAM
WORK SCHEDULE

<u>Date</u>	<u>Time</u>	<u>Duty</u>
21 June 1983	1000-1630	Check in, Physical, Driver's License issuance
23 June 1983	2000-0400	Beach Protecting nests and tagging turtles
24 June 1983	2000-0400	" " "
25 June 1983	2000-0400	" " "
30 June 1983	2000-0400	Beach Protecting nests and tagging turtles
1 July 1983	2000-0400	" " "
2 July 1983	2000-0400	" " "
14 July 1983	2000-0400	Beach Protecting nests and tagging turtles
15 July 1983	2000-0400	" " "
16 July 1983	2000-0400	" " "
21 July 1983	2000-0400	Beach Protecting nests and tagging turtles
22 July 1983	2000-0400	" " "
23 July 1983	2000-0400	" " "
28 July 1983	2000-0400	Beach Protecting nests and tagging turtles
29 July 1983	2000-0400	" " "
30 July 1983	2000-0400	" " "
4 August 1983	2000-0400	Beach Protecting nests and tagging turtles
5 August 1983	2000-0400	" " "
6 August 1983	2000-0400	" " "
11 August 1983	2000-0400	Beach Protecting nests and tagging turtles
12 August 1983	2000-0400	" " "
13 August 1983	2000-0400	" " "
15 August 1983		Office working on 1983 report
16 August 1983		" " "
17 August 1983		" " , Check out

 

CLIMATOLOGICAL DATA FOR THE MONTH OF JUNE 1983

1. TEMPERATURE
 - a. Mean monthly temperature.....76.0
 - b. Mean daily maximum temperature.....84.5
 - c. Mean daily minimum temperature.....67.1
 - d. Extreme maximum temperature recorded for June.....101 (1981)
 - e. Extreme minimum temperature recorded for June.....45 (1966)
2. HUMIDITY
 - a. Mean Relative Humidity.....72.8%
3. PRECIPITATION
 - a. Mean monthly rainfall.....5.94"
 - b. Mean no. days with .01" or more.....10 days
 - c. Maximum amount of rainfall recorded for June.....11.82" (1965)
 - d. Minimum amount of rainfall recorded for June.....2.39" (1968)
 - e. Maximum amount of rainfall recorded in 24 hours.....2.77" (1974)
4. THUNDERSTORMS
 - A. Percentage frequency of hourly occurrence.....2.5%
5. FOG
 - a. Percentage frequency of hourly occurrence.....17.2%
6. WIND
 - a. Prevailing direction.....SOUTHWEST
 - b. Mean speed.....4.7 knots
 - c. Peak gust recorded for June.....53 knots (1962)
7. CLOUD COVER AND VISIBILITY
 - a. Mean monthly cloud cover.....6.4 tenths
 - b. Percent ceiling greater than 500'.....98.4%
 - c. Percent ceiling greater than 1000'.....94.8%
 - d. Percent ceiling greater than 3000'.....76.8%
 - e. Percent ceiling greater than 5000'.....71.8%
 - f. Percent visibility greater than 1 mile.....98.7%
 - g. Percent visibility greater than 3 miles.....96.3%
 - h. Percent visibility greater than 5 miles.....87.7%
8. FIELD CONDITIONS
 - a. IFR-ceiling less than 1000' and/or visibility below 3 mi...7.2%
 - b. BELOW MINS-ceiling below 200' and/or visibility below ½mi...0.3%

WEATHER SERVICE DIVISION
 OPERATIONS DEPARTMENT
 MARINE CORPS AIR STATION
 (HELICOPTER)
 NEW RIVER, JACKSONVILLE
 NORTH CAROLINA 28545

214/JCW/adp
 3146
 10 DEC 1982

ASTRONOMICAL DATA FOR THE MONTH OF APRIL 1983

<u>DATE</u>	<u>SUNRISE</u>	<u>SUNSET</u>	<u>MOONRISE</u>	<u>MOONSET</u>	<u>PHASE</u>	<u>% OF ILLUM</u>
1	0558	1831	2227	0817		.88
2	0557	1832	2326	0854		.81
3	0555	1833		0935		.72
4	0554	1834	0024	1020	1/2	.63
5	0552	1834	0116	1110		.53
6	0551	1835	0205	1202		.44
7	0550	1836	0248	1257		.35
8	0548	1837	0326	1353	1/4	.26
9	0547	1837	0401	1451		.18
10	0546	1838	0432	1549		.11
11	0544	1839	0501	1648		.06
12	0543	1840	0530	1749	NEW	.02
13	0542	1841	0559	1851		.00
14	0540	1841	0630	1954		.01
15	0539	1842	0703	2100	1/4	.03
16	0538	1843	0742	2207		.08
17	0537	1844	0825	2313		.15
18	0535	1845	0926			.24
19	0534	1845	1016	0016	1/2	.35
20	0533	1847	1121	0114		.46
21	0532	1847	1229	0205		.57
22	0530	1848	1338	0251	3/4	.68
23	0529	1849	1446	0329		.78
24	0528	1849	1553	0404		.87
25	0527	1850	1659	0437		.94
26	0526	1851	1804	0508	FULL	.98
27	0525	1852	1908	0540		1.00
28	0524	1853	2011	0613		.99
29	0523	1853	2112	0648	3/4	.97
30	0521	1854	2211	0728		.92

ALL TIMES ARE EASTERN STANDARD TIME

NOTE: FOR BEGINNING OF MORNING CIVIL TWILIGHT, SUBTRACT 27 MINUTES FROM
 SUNRISE. FOR END OF EVENING CIVIL TWILIGHT, ADD 27 MINUTES TO SUNSET.

MARINE CORPS AIR STATION
(HELICOPTER)
NEW RIVER, JACKSONVILLE
NORTH CAROLINA 28545

214/JCW/adp
3146
10 DEC 1982

CLIMATOLOGICAL DATA FOR THE MONTH OF APRIL 1983

1. TEMPERATURE
 - a. Mean monthly temperature.....62.3
 - b. Mean daily maximum temperature.....73.2
 - c. Mean daily minimum temperature.....50.8
 - d. Mean no. days temperature 32 or less.....1 day
 - e. Extreme maximum temperature recorded for April.....93 (1967)
 - f. Extreme minimum temperature recorded for April.....26 (1972)
2. HUMIDITY
 - a. Mean Relative Humidity.....65.2%
3. PRECIPITATION
 - a. Mean monthly rainfall.....2.93"
 - b. Mean no. days with .01 or more.....9 days
 - c. Maximum amount of rainfall recorded for April.....6.53" (1978)
 - d. Minimum amount of rainfall recorded for April......50" (1976)
 - e. Maximum precipitation recorded in 24 hours.....4.33"
4. THUNDERSTORMS
 - a. Percentage frequency of hourly occurrence.....0.7%
5. FOG
 - a. Percentage frequency of hourly occurrence.....11.2%
6. WIND
 - a. Prevailing direction.....SOUTHWEST
 - b. Mean speed.....6.2 knots
 - c. Peak gust recorded for April.....46 knots (1960)
7. CLOUD COVER AND VISIBILITY
 - a. Mean monthly cloud cover.....4.5 tenths
 - b. Percent ceiling greater than 500'.....99.3%
 - c. Percent ceiling greater than 1000'.....96.0%
 - d. Percent ceiling greater than 3000'.....87.1%
 - e. Percent ceiling greater than 5000'.....80.9%
 - f. Percent visibility greater than 1 mile.....99.9%
 - g. Percent visibility greater than 3 miles.....98.0%
 - h. Percent visibility greater than 5 miles.....94.0%
8. FIELD CONDITIONS
 - a. IFR-ceiling less than 1000' and/or visibility below 3 mi...4.8%
 - b. BELOW MINS- ceiling less than 200' and/or visibility below ½mi...0.2%

OPERATIONS DEPARTMENT
MARINE CORPS AIR STATION
(HELICOPTER)
NEW RIVER, JACKSONVILLE
NORTH CAROLINA 28545

214/JCW/adp
3146
10 DEC 1982

CLIMATOLOGICAL DATA FOR THE MONTH OF MAY 1983

1. TEMPERATURE

- a. Mean monthly temperature.....69.9
- b. Mean daily maximum temperature.....79.6
- c. Mean daily minimum temperature.....59.7
- d. Extreme maximum temperature recorded for May.....98 (1962)
- e. Extreme minimum temperature recorded for May.....32 (1963)

2. HUMIDITY

- a. Mean relative humidity.....72.6%

3. PRECIPITATION

- a. Mean monthly rainfall.....4.15"
- b. Mean no. days with .01" or more.....10 days
- c. Maximum amount of rainfall recorded for May.....8.36" (1974)
- d. Minimum amount of rainfall recorded for May.....1.71" (1975)
- e. Maximum amount of rainfall recorded in 24 hours.....3.87" (1977)

4. THUNDERSTORMS

- a. Percentage frequency of hourly occurrence.....1.4%

5. FOG

- a. Percentage frequency of hourly occurrence.....16.3%

6. WIND

- a. Prevailing direction.....SOUTHWEST
- b. Mean speed.....5.3 knots
- c. Peak gust recorded for May.....48 (1968)

7. CLOUD COVER AND VISIBILITY

- a. Mean monthly cloud cover.....6.1 tenths
- b. Percent ceiling greater than 500'.....98.1%
- c. Percent ceiling greater than 1000'.....95.2%
- d. Percent ceiling greater than 3000'.....80.1%
- e. Percent ceiling greater than 5000'.....71.3%
- f. Percent visibility greater than 1 mile.....98.7%
- g. Percent visibility greater than 3 miles.....96.6%
- h. Percent visibility greater than 5 miles.....88.9%

8. FIELD CONDITIONS

- a. IFR-ceiling less than 1000' and/or visibility below 3 mi...6.5%
- b. BELOW MINS-ceiling less than 200' and/or visibility below 1/2 mi...1.4%

WEATHER SERVICES DIVISION
 OPERATIONS DEPARTMENT
 MARINE CORPS AIR STATION
 (HELICOPTER)
 NEW RIVER, JACKSONVILLE
 NORTH CAROLINA 28545

214/JCW/adp
 3146
 10 DEC 1982

ASTRONOMICAL DATA FOR THE MONTH OF JUNE 1983

<u>DATE</u>	<u>SUNRISE</u>	<u>SUNSET</u>	<u>MOONRISE</u>	<u>MOONSET</u>	<u>PHASE</u>	<u>% OF ILLUM</u>
1	0458	1918	2359	0931		.76
2	0458	1919		1028	1/2	.68
3	0458	1919	0032	1125		.58
4	0458	1920	0102	1222		.49
5	0457	1920	0131	1319		.39
6	0457	1921	0158	1418	1/4	.30
7	0457	1921	0227	1521		.21
8	0457	1922	0258	1625		.13
9	0457	1922	0332	1733		.06
10	0457	1923	0411	1842	NEW	.02
11	0457	1923	0457	1952		.00
12	0456	1923	0553	2058		.01
13	0456	1924	0658	2156	1/4	.05
14	0457	1924	0807	2247		.11
15	0457	1925	0919	2332		.20
16	0457	1925	1029		1/2	.30
17	0457	1926	1137	0009		.41
18	0457	1926	1242	0043		.52
19	0457	1926	1346	0113		.63
20	0457	1926	1448	0144	3/4	.73
21	0457	1927	1550	0214		.82
22	0458	1927	1651	0247		.89
23	0458	1927	1751	0322		.95
24	0458	1927	1849	0402	FULL	.98
25	0458	1927	1944	0445		1.00
26	0459	1927	2034	0535		1.00
27	0459	1927	2119	0628		.97
28	0459	1927	2158	0723	3/4	.94
29	0500	1927	2233	0819		.88
30	0500	1927	2303	0916		.81

ALL TIMES ARE EASTERN STANDARD TIME

NOTE: FOR BEGINNING OF MORNING CIVIL TWILIGHT, SUBTRACT 27 MINUTES FROM SUNRISE. FOR END OF EVENING CIVIL TWILIGHT, ADD 27 MINUTES TO SUNSET.

WEATHER SERVICES DIVISION
 OPERATIONS DEPARTMENT
 MARINE CORPS AIR STATION
 (HELICOPTER)
 NEW RIVER, JACKSONVILLE
 NORTH CAROLINA 18545

214/JCW/adp
 3146
 10 DEC 1982

ASTRONOMICAL DATA FOR THE MONTH OF MAY 1983

<u>DATE</u>	<u>SUNRISE</u>	<u>SUNSET</u>	<u>MOONRISE</u>	<u>MOONSET</u>	<u>PHASE</u>	<u>% OF ILLUM</u>
1	0520	1855	2307	0812		.86
2	0519	1856	2358	0859		.78
3	0518	1857		0951	1/2	.70
4	0517	1857	0044	1045		.61
5	0516	1858	0124	1142		.51
6	0515	1859	0200	1239		.42
7	0514	1900	0232	1336	1/4	.33
8	0513	1901	0302	1434		.24
9	0513	1901	0330	1534		.16
10	0512	1902	3059	1636		.09
11	0511	1903	0429	1739	NEW	.04
12	0510	1904	0501	1845		.01
13	0509	1904	0522	1953		.00
14	0508	1905	0620	2102		.02
15	0508	1905	0709	2209	1/4	.06
16	0507	1907	0808	2309		.13
17	0506	1908	0912	0003		.22
18	0505	1908	1021		1/2	.32
19	0505	1909	1130	0051		.43
20	0504	1910	1238	0131		.55
21	0504	1911	1344	0207		.66
22	0503	1911	1449	0239	3/4	.76
23	0502	1912	1552	0310		.85
24	0502	1913	1655	0341		.92
25	0501	1913	1758	0412	FULL	.96
26	0501	1914	1900	0446		.99
27	0500	1915	2000	0523		1.00
28	0500	1915	2057	0605		.98
29	0459	1916	2151	0651	3/4	.95
30	0459	1917	2249	0742		.90
31	0459	1917	2327	0835		.84

ALL TIMES ARE EASTERN STANDARD TIME

NOTE: FOR BEGINNING OF MORNING CIVIL TWILIGHT, SUBTRACT 27 MINUTES FROM
 SUNRISE. FOR END OF EVENING CIVIL TWILIGHT, ADD 27 MINUTES TO SUNSET.

WEATHER SERVICES DIVISION
 OPERATIONS DEPARTMENT
 MARINE CORPS AIR STATION
 NEW RIVER, JACKSONVILLE
 NORTH CAROLINA 28545

214/JCW/adp
 3146
 10 DEC 1982

MONTH OF APRIL
TIDAL DATA FOR NEW RIVER INLET N.C.

<u>DATE</u>	<u>TIME</u>	<u>HT.</u>	<u>TIME</u>	<u>HT.</u>	<u>TIME</u>	<u>HT.</u>	<u>TIME</u>	<u>HT.</u>
1	0413	0.0	1019	2.9	1618	0.0	2244	3.3
2	0501	0.2	1103	2.7	1701	0.2	2331	3.1
3	0552	0.3	1153	2.6	1749	0.4		
4	0019	2.9	0646	0.4	1245	2.4	1840	0.5
5	0115	2.8	0745	0.5	1349	2.3	2141	0.5
6	0213	2.7	0842	0.4	1450	2.3	2043	0.4
7	0313	2.7	0938	0.3	1546	2.3	2143	0.3
8	0405	2.7	1026	0.2	1635	2.4	2236	0.2
9	0454	2.7	1108	0.0	1720	2.6	2324	0.0
10	0538	2.7	1147	-0.1	1802	2.7		
11	0006	-0.2	0619	2.7	1224	-0.2	1835	-2.9
12	0048	-0.3	0657	2.8	1259	-0.3	1916	3.0
13	0128	-0.3	0737	2.8	1334	-0.3	1956	3.2
14	0207	-0.3	0814	2.8	1410	-0.3	2034	3.3
15	0249	-0.2	0853	2.8	1449	-0.2	2116	3.4
16	0334	-0.1	0937	2.8	1531	-0.1	2202	3.4
17	0422	0.1	1026	2.8	1619	0.1	2254	3.4
18	0517	0.2	1119	2.8	1717	0.2	2353	3.3
19	0618	0.3	1224	2.9	1823	0.4		
20	0059	3.3	0725	0.4	1334	2.8	1937	0.4
21	0209	3.2	0834	0.4	1447	2.9	2053	0.4
22	0318	3.3	0939	0.3	1554	3.1	2201	0.2
23	0423	3.3	1036	0.1	1653	3.3	2303	0.1
24	0520	3.3	1127	0.0	1746	3.4	2359	-0.1
25	0610	3.3	1216	-0.1	1836	3.6		
26	0049	-0.2	0700	3.2	1301	-0.2	1923	3.6
27	0137	-0.2	0745	3.2	1343	-0.2	2006	3.6
28	0223	-0.2	0827	3.0	1423	-0.1	2047	3.5
29	0307	-0.1	0909	2.9	1504	0.0	2128	3.4
30	0350	0.0	0951	2.8	1544	0.1	2212	3.2

ALL TIMES ARE IN EASTERN STANDARD TIME

BOUGE INLET TIDES: SUBTRACT 3 MIN. FOR HIGH TIDE. SUBTRACT 0.8 FT. FROM HIGH TIDE HT. SUBTRACT 2 MIN. FOR LOW TIDE, NO HT. CORRECTION FOR LOW TIDE.

NEW TOPSAIL TIDES: ADD 4 MIN. FOR HIGH TIDE. ADD 43 MIN. FOR LOW TIDE. NO HT. CORRECTION FOR HIGH OR LOW TIDE.

WEATHER SERVICES DIVISION
 OPERATIONS DEPARTMENT
 MARINE CORPS AIR STATION
 (HELICOPTER)
 NEW RIVER, JACKSONVILLE
 NORTH CAROLINA 28545

214/JCW/adp
 3146
 10 DEC 1982

MONTH OF MAY
TIDAL DATA FOR NEW RIVER INLET N.C.

<u>DATE</u>	<u>TIME</u>	<u>HT.</u>	<u>TIME</u>	<u>HT.</u>	<u>TIME</u>	<u>HT.</u>	<u>TIME</u>	<u>HT.</u>
1	0434	0.2	1036	2.6	1627	0.3	2256	3.1
2	0520	0.3	1124	2.5	1714	0.4	2341	2.9
3	0607	0.3	1214	2.4	1804	0.5		
4	0032	2.8	0700	0.4	1309	2.4	1901	0.5
5	0122	2.7	0754	0.4	1408	2.4	2001	0.5
6	0222	2.6	0846	0.3	1502	2.4	2101	0.4
7	0318	2.6	0933	0.2	1552	2.6	2156	0.2
8	0408	2.6	1017	0.0	1637	2.7	2246	0.0
9	0454	2.6	1059	-0.1	1722	2.9	2332	-0.1
10	0540	2.6	1140	-0.2	1803	3.0		
11	0019	-0.2	0622	2.7	1218	-0.3	1835	3.2
12	0101	-0.3	0706	2.8	1301	-0.3	1928	3.4
13	0147	-0.3	0749	2.8	1343	-0.3	2012	3.5
14	0232	-0.3	0835	2.8	1428	-0.2	2058	3.5
15	0322	-0.2	0925	2.9	1518	-0.1	2149	3.5
16	0411	0.0	1017	2.9	1611	0.1	2244	3.5
17	0507	0.1	1115	2.9	1712	0.2	2342	3.4
18	0607	0.2	1218	3.0	1818	0.3		
19	0048	3.3	0710	0.3	1327	3.0	2930	0.4
20	0155	3.2	0813	0.3	1435	3.1	2043	0.4
21	0229	3.2	0914	0.2	1536	3.2	2149	0.3
22	0401	3.1	1009	0.1	1635	3.3	2249	0.1
23	0458	3.1	1101	0.0	1726	3.4	2342	0.0
24	0549	3.0	1148	-0.1	1815	3.5		
25	0032	-0.1	0636	2.9	1232	-0.1	1859	3.5
26	0119	-0.1	0721	2.8	1314	-0.1	1940	3.4
27	0204	-0.1	0804	2.7	1355	-0.1	2024	3.3
28	0246	-0.1	0845	2.6	1437	0.0	2104	3.2
29	0326	-0.1	0927	2.6	1517	0.1	2143	3.1
30	0408	0.0	1009	2.5	1559	0.2	2226	3.0
31	0451	0.1	1055	2.4	1643	0.3	2308	2.8

ALL TIMES ARE IN EASTERN STANDARD TIME
 BOUGE INLET TIDES: SUBTRACT 3 MIN. FOR HIGH TIDE. SUBTRACT 0.8 FT. FROM HIGH TIDE HT. SUBTRACT 2 MIN. FOR LOW TIDE, NO HT. CORRECTION FOR LOW TIDE.
 NEW TOPSAIL TIDES: ADD 4 MIN. FOR HIGH TIDE. ADD 43 MIN. FOR LOW TIDE. NO HT. CORRECTION FOR HIGH OR LOW TIDE.

WEATHER SERVICES DIVISION
 OPERATIONS DEPARTMENT
 MARINE CORPS AIR STATION
 (HELICOPTER)
 NEW RIVER, JACKSONVILLE
 NORTH CAROLINA 28545

214/JCW/adp
 3146
 10 DEC 1982

MONTH OF JUNE
TIDAL DATA FOR NEW RIVER INLET N.C.

<u>DATE</u>	<u>TIME</u>	<u>HT.</u>	<u>TIME</u>	<u>HT.</u>	<u>TIME</u>	<u>HT.</u>	<u>TIME</u>	<u>HT.</u>
1	0533	0.2	1140	2.4	1730	0.4	2332	2.7
2	0617	0.2	1230	2.4	1823	0.4		
3	0042	2.6	0703	0.2	1322	2.4	1920	0.4
4	0133	2.5	0749	0.2	1414	2.5	2018	0.3
5	0226	2.5	0838	0.1	1503	2.6	2115	0.2
6	0319	2.4	0924	0.0	1552	2.8	2207	0.1
7	0411	2.5	1011	-.1	1640	3.0	2258	-.1
8	0501	2.5	1058	-.2	1730	3.1	2350	-.2
9	0550	2.6	1143	-.3	1816	3.3		
10	0039	-.3	0639	2.7	1232	-.4	1906	3.5
11	0126	-.4	0729	2.8	1322	-.4	1955	3.5
12	0217	-.3	0820	2.9	1414	-.3	2046	3.5
13	0307	-.3	0913	3.0	1508	-.2	2138	3.5
14	0400	-.2	1009	3.0	1606	-.1	2234	3.5
15	0455	-.1	1107	3.1	1707	0.1	2331	3.4
16	0551	0.1	1208	3.1	1810	0.2		
17	0032	3.3	0650	0.2	1310	3.2	1919	0.3
18	0134	3.1	0748	0.2	1414	3.2	2026	0.3
19	0236	3.0	0846	0.2	1516	3.3	2132	0.3
20	0336	2.9	0940	0.1	1614	3.3	2233	0.2
21	0432	2.8	1033	0.1	1704	3.3	2326	0.1
22	0525	2.7	1121	0.0	1752	3.3		
23	0016	0.0	0613	2.6	1207	0.0	1837	3.3
24	0101	-.1	0659	2.6	1249	-.1	1920	3.2
25	0143	-.1	0743	2.5	1331	-.1	2000	3.1
26	0223	-.2	0824	2.5	1412	-.1	2039	3.1
27	0302	-.1	0904	2.5	1452	0.0	2116	3.0
28	0339	-.1	0943	2.4	1534	0.1	2154	2.9
29	0416	-.1	1023	2.4	1614	0.1	2234	2.8
30	0456	0.0	1105	2.4	1658	0.2	2314	2.7

ALL TIMES ARE IN EASTERN STANDARD TIME

BOUCE INLET TIDES: SUBTRACT 3 MIN. FOR HIGH TIDE. SUBTRACT 0.8 FT. FROM HIGH TIDE HT. SUBTRACT 2 MIN. FOR LOW TIDE, NO HT. CORRECTION FOR LOW TIDE.


NEW TOPSAIL TIDES: ADD 4 MIN FOR HIGH TIDE. ADD 43 MIN. FOR LOW TIDE. NO HT. CORRECTION FOR HIGH OR LOW TIDE.


First ~~copies~~
ORIGINALS - collected data
at Beach -

→ 2nd copy - Peterson
From Log for
COOP - Turtle Project -
cooperative marine turtle Tagging
Program Tagging data
(Nesting Turtles)

 

Statement of - Sam F. Poole, Wildlife Biologist, Civilian GS-7

Nest number 022, was checked for hatching success on 2 September 1983 and no eggs were present. Seventy-one days after the female laid 111 eggs at 1.0(N) of Risley Pier. The final hatching success check was made on 7 September 1983. This final check revealed no eggs in the nest cavity, the pit was dug out and the hole enlarged to approximately 4' x 4'; with still no eggs, turtle egg shells, or young turtles found. A search was conducted at the next dune, and up and down the beach, for egg fragments or young turtles of the season and none were found. The protective wire nest cover had been moved.

Sam F. Poole

SAM F. POOLE

9-22-83

DATE



Statement of - Sam F. Poole, Wildlife Biologist, Civilian GS-7

Nest number 022, was checked for hatching success on 2 September 1983 and no eggs were present. Seventy-one days after the female laid 111 eggs at 1.0(N) of Risley Pier. The final hatching success check was made on 7 September 1983. This final check revealed no eggs in the nest cavity, the pit was dug out and the hole enlarged to approximately 4' x 4'; with still no eggs, turtle eggs shells, or young turtles found. A search was conducted at the next dune, and up and down the beach, for egg fragments or young turtles of the season and none were found. The protective wire nest cover had been moved.

SAM F. POOLE
14 Sep 1983



Page 1 of 1



Statement of Sam F. Poole, Wildlife Biologist, Civilian GS-7. Nest

#022, was checked for hatching success 9-7-83. Seventy one days after ^{which was checked}

the female laid 111 eggs at 1.0(N) of Risley's Pier. ^{by} This female was ^{Brian} tagged with return No. IMS 716. The ^{hatching} hatching success check revealed

no eggs in the nest cavity on ~~9-7-83~~ ⁹⁻⁷⁻⁸³ the pit was dug out and the hole ^{spanned}

enlarged to approximately 4' x 4' with still no eggs located or ^{Turtle} Turtle

egg shells. A search was conducted at the next dune and up and down ^{at the} the beach for egg fragments or dead turtles, none were found. This ^{nest}

same nest was checked earlier and no eggs were present. (9-2983) ⁹⁻²⁹⁻⁸³

The last check was the final check on nest #022 was to determine the ¹⁹⁸³

percent of hatching success.

SAM F. POOLE
SIGNATURE DATE

















needs typing

9-9-83

CP

~~Status of nest number, 022~~

Statement of Sam F. Poole, Wildlife Biologist, Civilian GS-7.

Nest # 022, was checked for hatching success

9-7-83. Seventy one days after the female laid 111 the eggs at 1.0(N) of Riskey's Pier. This female was tagged with return no. I.M.S. 716. The

% % Hatching success check revealed no eggs in the nest cavity on 9-7-83. The pit was dug out and the hole enlarged to approximately 4'x4' with still no eggs located or shells. A search was conducted at the next dome and up and down the beach for egg fragments on dead turtles, none were found. This


same nest was checked, 9-2-83

~~earlier~~ earlier and no eggs were present 9-2-83

The last check was the final ^{check on nest} hatching

~~Success check~~ #022 was ~~to determine the percent of hatching success~~

Seems to me - the last # should be first

 

Revised - 9-14-83
L.F.P.

OK
J.W. please
type

Statement of Sam F. Poole, Wildlife Biologist, civilian GS-7
Nest # 022, was checked for hatchling success
ON 9-2-83 and no eggs were present. Seventy-one
days after the female laid 111 eggs at 1.0(N)
of Riskey's Pier the final hatchling success check
was made ~~on~~ 9-7-83. This final check
revealed no eggs in the nest cavity, the
pit was dug out and the hole enlarged to
approximately 4'x4', with still no eggs, turtle,
egg shells, or young turtles found. A search
was conducted at the next duke, and up
and down the beach, for egg fragments or
dead young turtles of the season, and none
were found. The protective wire nest cover ^{one the} had
been moved.

Signature - Sam F. Poole
9-14-83

