

DEPARTMENT OF THE NAVY

# Memorandum

DATE: 22 October 1980

FROM : Foreman, Water Treatment

TO : Natural Resources Div.

SUBJ : Raw Water Wells, plotting of; request for

1. As requested by your office all raw water wells located aboard Camp Lejeune have been plotted; dotted in red, on sheets attached.
2. Wells that are no longer in use and slated for replacement have been omitted.
3. Please feel free to contact us for any further assistance.


  
B. M. FRAZETTE

CLW

0000005444

CLW

0000005445

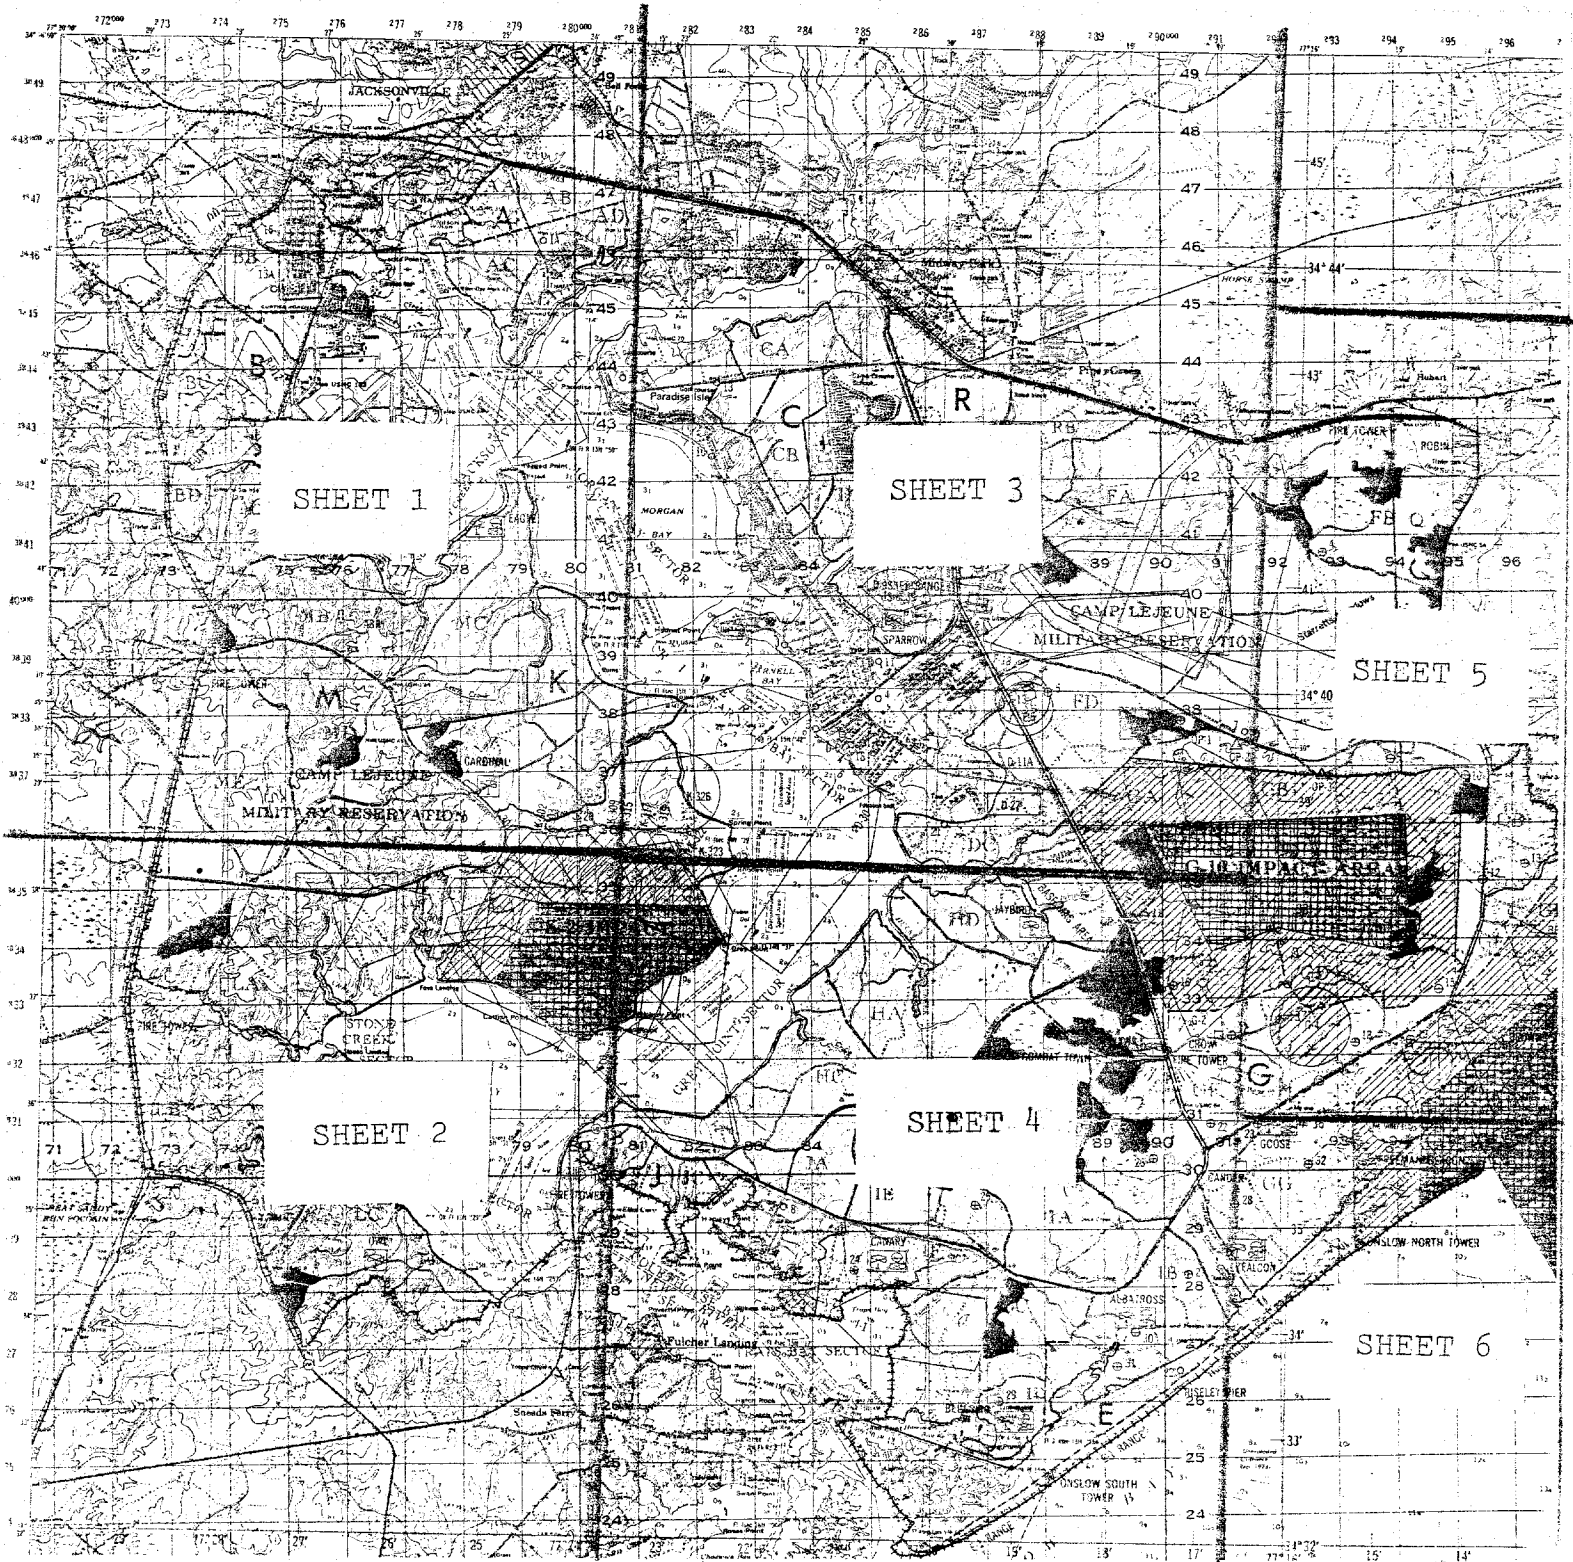

SHEET 1

SHEET 3

SHEET 5

SHEET 2

SHEET 4

SHEET 6