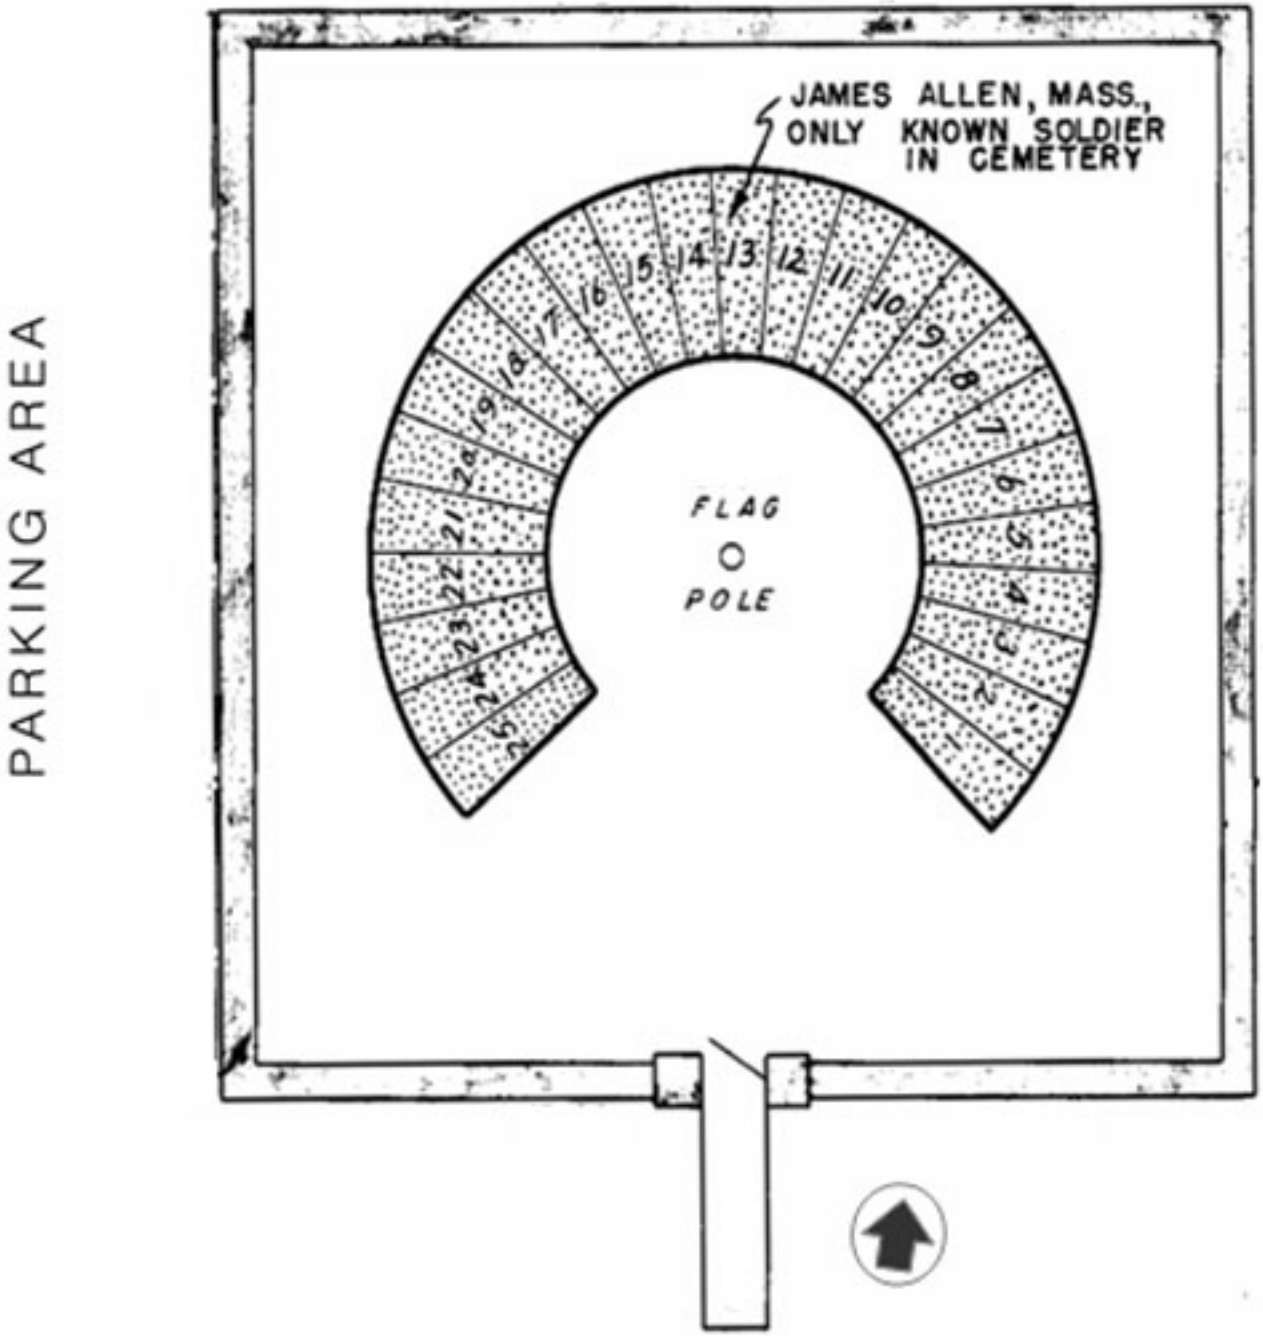
PARKING AREA
JAMES ALLEN, MASS., ONLY KNOWN SOLDIER IN CEMETERY
1
2
3
4
5
6
7
8
9
10
11
12
13
14
15
16
17
18
19
20
21
22
23
24
25
FLAG POLE